

INDEX OF SHEETS	
SHEETS	
1	TITLE SHEET
2	QUANTITY SHEET
3-4	R.O.W. DETAIL SHEETS
5	PLAN AND PROFILE
6	PLAN AND SLAB DETAILS
7	ABUTMENT #1
8	ABUTMENT #2
9	UPSTREAM WINGWALLS
10	REINFORCING STEEL SCHEDULE
11-20	ROADWAY SECTIONS
21-22	CHANNEL SECTIONS
23	SCB-D1-67
24	SCB-D6-67
25	E33-BRIDGE CONSTRUCTION APPROACH SIGNS
26	E34-ON PROJECT CONSTRUCTION SIGNS
27	G.I.


STATE OF VERMONT DEPARTMENT OF HIGHWAYS

PROPOSED IMPROVEMENT

VILLAGE OF MARSHFIELD

U.S. ROUTE 2

WASHINGTON COUNTY MONTPELIER - ST. JOHNSBURY ROAD

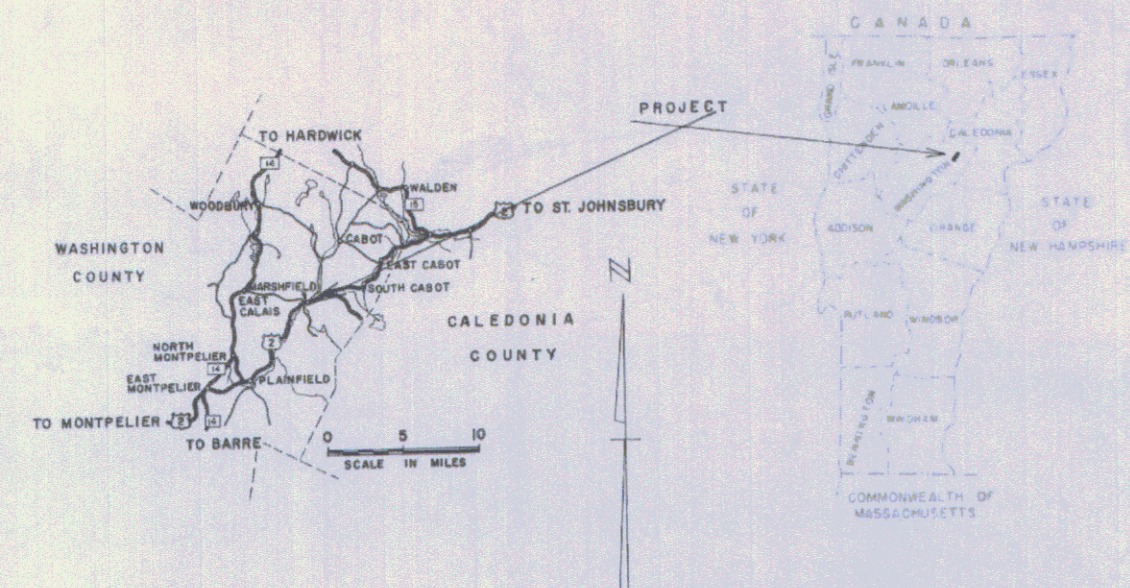


BEGINNING AT A POINT 1.815 MILES WEST OF THE
MARSHFIELD - CABOT TOWN LINE AND EXTENDING
EASTERLY 0.094 MILES.


LENGTH OF ROADWAY 475.4 FEET + 0.090 MILES
LENGTH OF BRIDGE 24.6 FEET + 0.004 MILES

LENGTH OF PROJECT 500 FEET + 0.094 MILES.


PROJECT **MARSHFIELD**
NUMBER **BB 028-3-6661** LENGTH **0.094 MI.**
TYPE *Widen Concrete slab bridge construct approach*
CONTRACTOR **PINELLO ENGR & BRIDGE CONSTR**
YEAR **1968**
LOCATION *Beginning at a point 1.815 miles west of the Marshfield-Cabot Town Line and extending Easterly 0.094 miles*

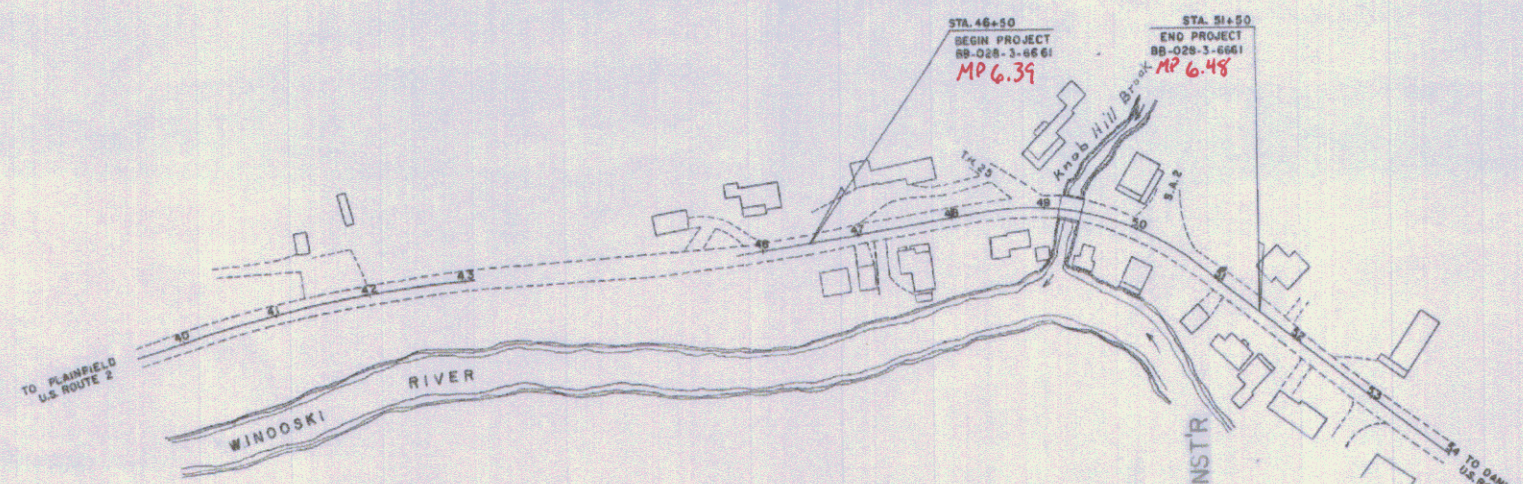

CONVENTIONAL SIGNS

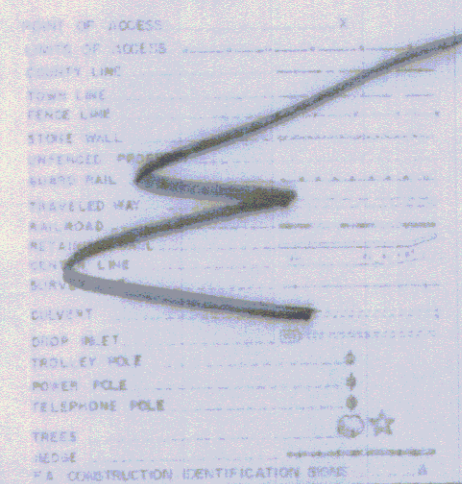

SLOPE RIGHTS

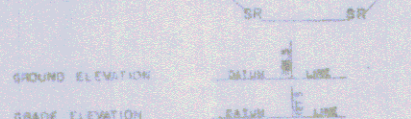

GROUND ELEVATION	CLAVE DATA	
GRADE ELEVATION	DEFLECTION OF ANGLE	D
	DEGREE OF CURVE	D
	RADIUS OF CURVE	R
	TANGENT DISTANCE	T
	LENGTH OF CURVE	L
	EXTERNAL DISTANCE	E
	POINT OF INTERSECTION	P.I.
	POINT OF CURVE	P.O.
	POINT ON TANGENT	P.T.
	POINT ON SUB-TANGENT	P.D.T.
	POST	POST

Kelly J. J. J. J.
Pinello Engineers
R. Comi
H. L. B. W. H.

April 30, 1968
May 7, 1968
Oct 1, 1968
Oct 1, 1968

MARSHFIELD BB 028-3-6661
CONTRACTOR: PINELLO ENGR & BRIDGE CONSTR
RESENGR R. COMI
RECORD PLANS H. LEWIN

THESE PLANS ARE SUBJECT TO SUCH REVISIONS AS MAY BE
REQUIRED BY THE BUREAU OF PUBLIC ROADS OR THE COMMISSIONER
OF HIGHWAYS.
CONSTRUCTION IS TO BE CARRIED ON IN ACCORDANCE WITH
THESE PLANS AND THE STANDARD SPECIFICATIONS FOR HIGHWAY AND BRIDGE
CONSTRUCTION DATED APRIL 1964, AS APPROVED BY THE BUREAU OF
PUBLIC ROADS ON OCTOBER 12, 1964, INCLUDING ALL SUBSEQUENT
APPROVED REVISIONS AND SUCH REVISED SPECIFICATIONS AND SPECIAL
PROVISIONS AS ARE INCORPORATED IN THESE PLANS.

P.m. # 99R124

DEPARTMENT OF COMMERCE
BUREAU OF PUBLIC ROADS

APPROVED **7/20/67**
DIVISION ENGINEER DATE

PROJECT **BB** **028-3-6661**

SHEET **1** OF 27 SHEETS

APPROVED <i>[Signature]</i> DISTRICT ENGINEER DATE <i>7/20/67</i>	APPROVED <i>[Signature]</i> CONSTRUCTION ENGINEER DATE <i>7/20/67</i>	APPROVED <i>[Signature]</i> CHIEF ENGINEER DATE <i>7/20/67</i>	APPROVED <i>[Signature]</i> CHIEF ENGINEER DATE <i>7/20/67</i>
---	---	--	--