

INDEX OF SHEETS	
SHEET NO.	TITLE PAGE
1	TYPICAL CROSS-SECTION OF IMPROVEMENT (2 1/2" CRUSHED GRAVEL M.P. SURFACE COURSE WITH REFINED TAR)
2-4	BANKING AND WIDENING TABLES
5	PLAN AND PROFILE
6-23	DETAILS OF 7'6" R.C. BOX
24	STANDARD STRUCTURE SHEET S-28 PIPE CULVERTS
25	S-30 GUARD RAIL
26	S-30-A UNDERDRAIN & CATCH BASINS
27	S-31 CONCRETE CURB
28	S-40 BARRICADES, SIGNS & LIGHTS
29	S-41 ROUNDING OF SLOPES
30	RCCPI 4.5 X 6 R.C. BOX
31	
32-99	CROSS SECTION SHEETS

STANDARD STRUCTURE SHEETS APPROVED
BY THE CHIEF ENGINEER, VT. ST. DEPT. OF HWYS.

S-28 APRIL 26, 1941
S-30 MAY 12, 1941
S-30-A APRIL 19, 1941
S-40 DEC. 18, 1945

STATE OF VERMONT STATE HIGHWAY DEPARTMENT PLAN AND PROFILE OF PROPOSED STATE HIGHWAY FEDERAL AID PROJECT

TOWN OF CONCORD
ROUTE U.S. 2


ST. JOHNSBURY - LANCASTER N.H. ROAD
BEGINNING AT A POINT 0.503 MI. SOUTH OF THE KIRBY - CONCORD TOWN LINE
AND EXTENDING SOUTH EASTERLY 2.140 MILES

LENGTH OF PROJECT 11,299.2 FT. = 2.140 MILES

Pin # 99R152


Project No F 31(2)

FED. ROAD DIST. NO.	STATE	PROJ. NO.	FISCAL YEAR	SHEET NO.	TOTAL SHEETS
9	VT.	F31(2)	1946	1	99

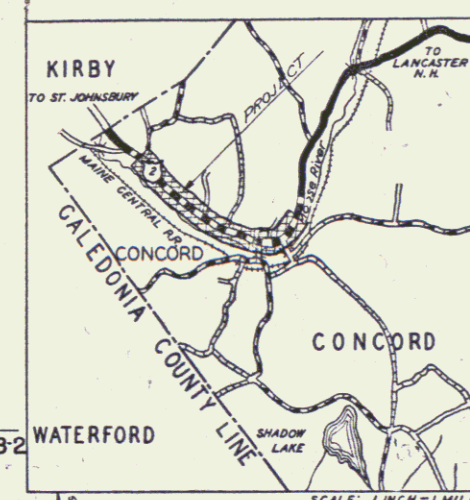

STA 342+948
END F 31(10)

STA 0+00
BEGINNING OF F 31(2)
0+00 OF F.A.P. 31

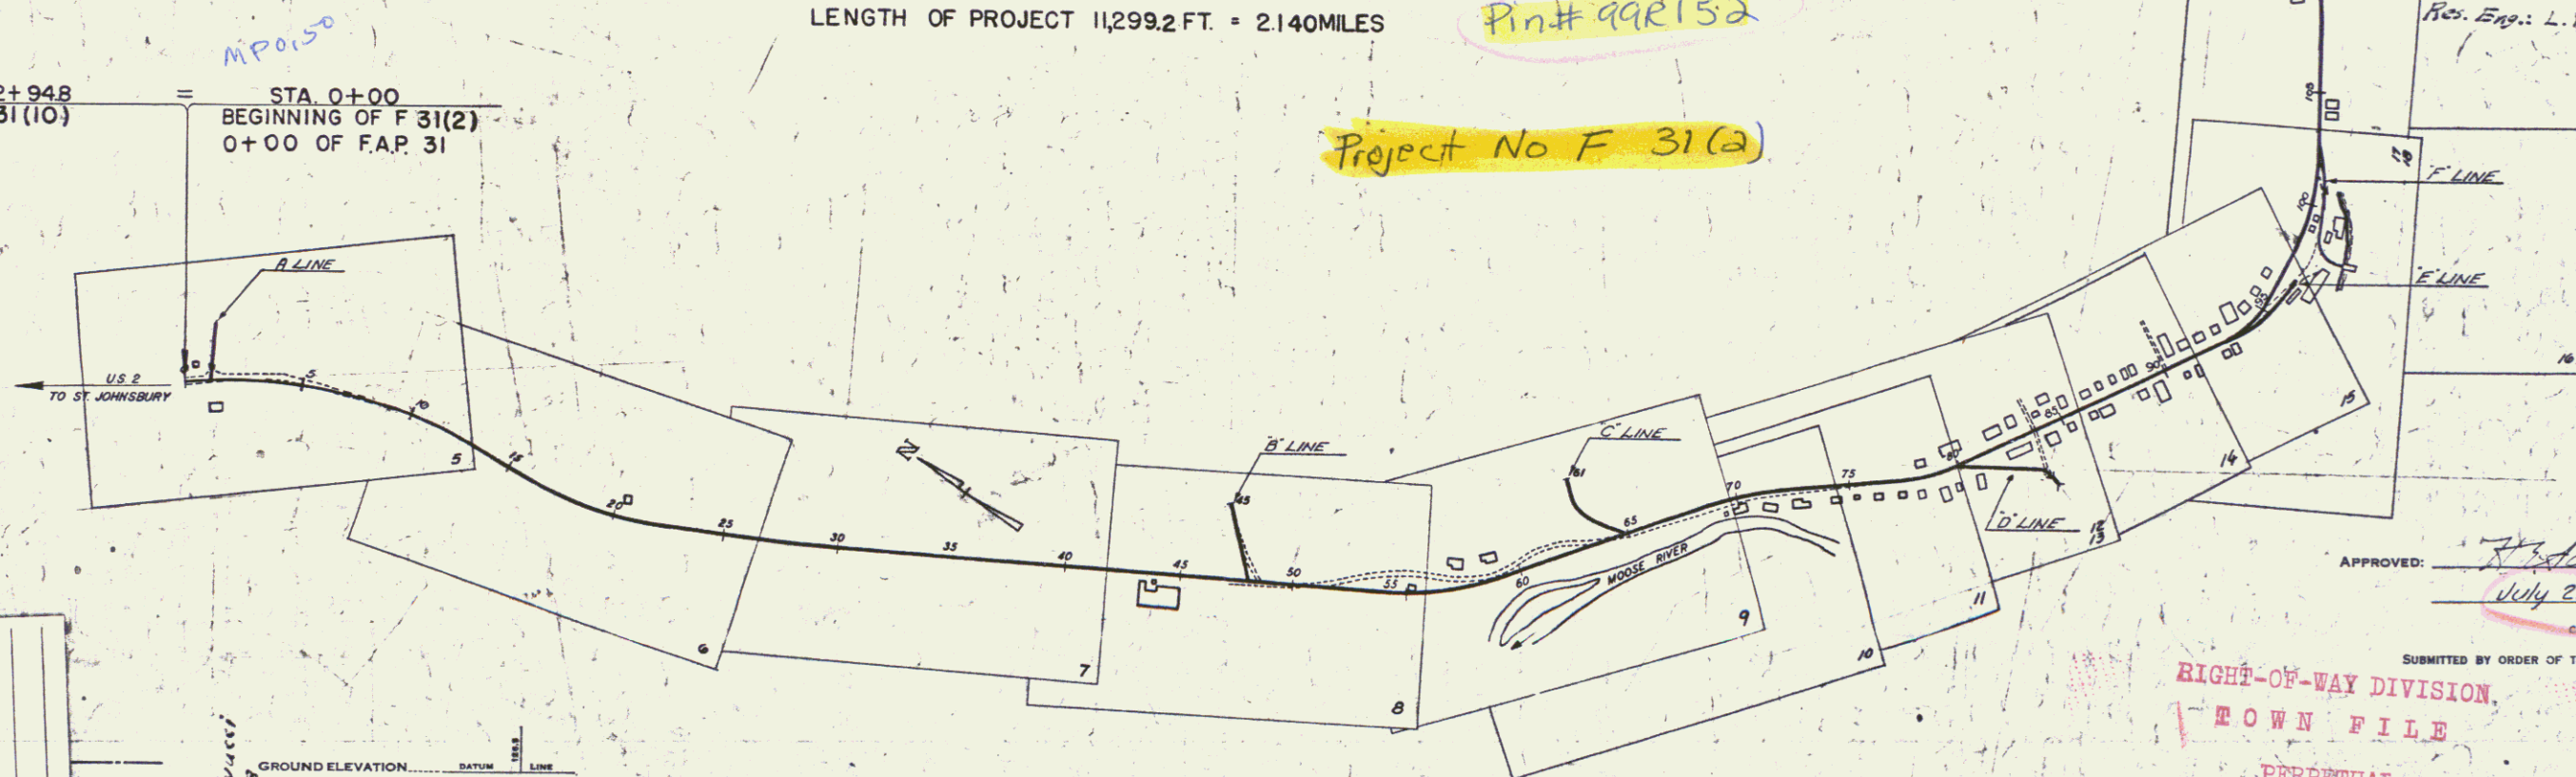

PROJECT	CONCORD
NUMBER	F 31(2)
TYPE	2 1/2" CRUSHED GRAVEL M.P.
CONTRACTOR	See Note
LOCATION	See Note
YEAR	1945

RECORD PLANS
Concord F 31(2)
Constructed by Peter Salvendy
Aug 31, 1945

GROUND ELEVATION DATUM
GRADE ELEVATION DATUM

CURVE DATA
DEFLECTION ANGLE
DEGREE OF CURVE
RADIUS OF CURVE
TANGENT DISTANCE
LENGTH OF CURVE
EXTERNAL DISTANCE
POINT OF INTERSECTION
POINT OF CURVE
POINT OF TANGENT
POINT ON TANGENT

SCALES
TITLE 1" = 400'
TYPICAL 1" = 2'
PLAN 1" = 50' & 1" = 20'
PROFILE HORIZONTAL 1" = 50' & 1" = 20'
VERTICAL 1" = 10'
CROSS SECTIONS 1" = 5'

STA 112+98.9
END F 31(2)
113+50 OF F.A.P. 31

STA 113+50
BEGINNING OF F.A.P. 131-B-2

M.P. 2.65

RECORD PLANS
By
D.R. Loring & G.E. Guidi
Feb. 1945
Res. Eng. L.W. Brownell

APPROVED: *[Signature]*
July 29, 1946

RIGHT-OF-WAY DIVISION
TOWN FILE
PERPETUAL



RECOMMENDED FOR APPROVAL
Town of US 2
(To Be Returned To R.O.W.)

THESE PLANS ARE SUBJECT TO SUCH REVISIONS AS MAY BE
REQUIRED BY THE PUBLIC ROADS ADMINISTRATION OR THE COM-
MISSIONER OF HIGHWAYS.


CONSTRUCTION IS TO BE CARRIED ON IN ACCORDANCE WITH
THE PLANS AND THE STANDARD ROAD AND BRIDGE SPECIFICATIONS
OF 1936, AS APPROVED DECEMBER 29TH, 1936 BY THE PUBLIC
ROADS ADMINISTRATION, INCLUDING ALL SUBSEQUENT APPROVED
REVISIONS AND SUCH REVISED SPECIFICATIONS AND SPECIAL
PROVISIONS AS ARE SUBMITTED WITH THE PLANS.

APPROVED: *[Signature]* HIGHWAY ENGINEER
APPROVED: *[Signature]* DISTRICT HIGHWAY COMMISSIONER
SERIES F No 31(2) FILED
SHEET 1 OF 99

FED. ROAD DIST. NO.	STATE	FISCAL YEAR	NO.
9	VI.	F31-Q1946	7 99

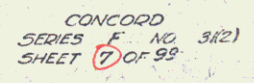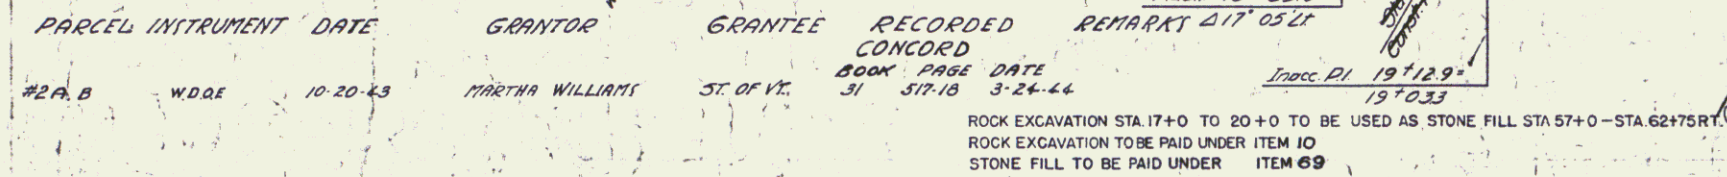


U.S. ROAD DIST. NO. STATE F31-2 1946 8 99

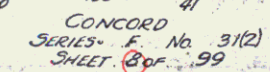


POOR ORIGINAL COPY

GENERAL NOTE: The present road surface left of Sta 50+00 to 57+00 and 60+00-63+00 is to be covered with approved excavation or borrow as per cross-sections. This work is not to be done until the relocation is open to travel.

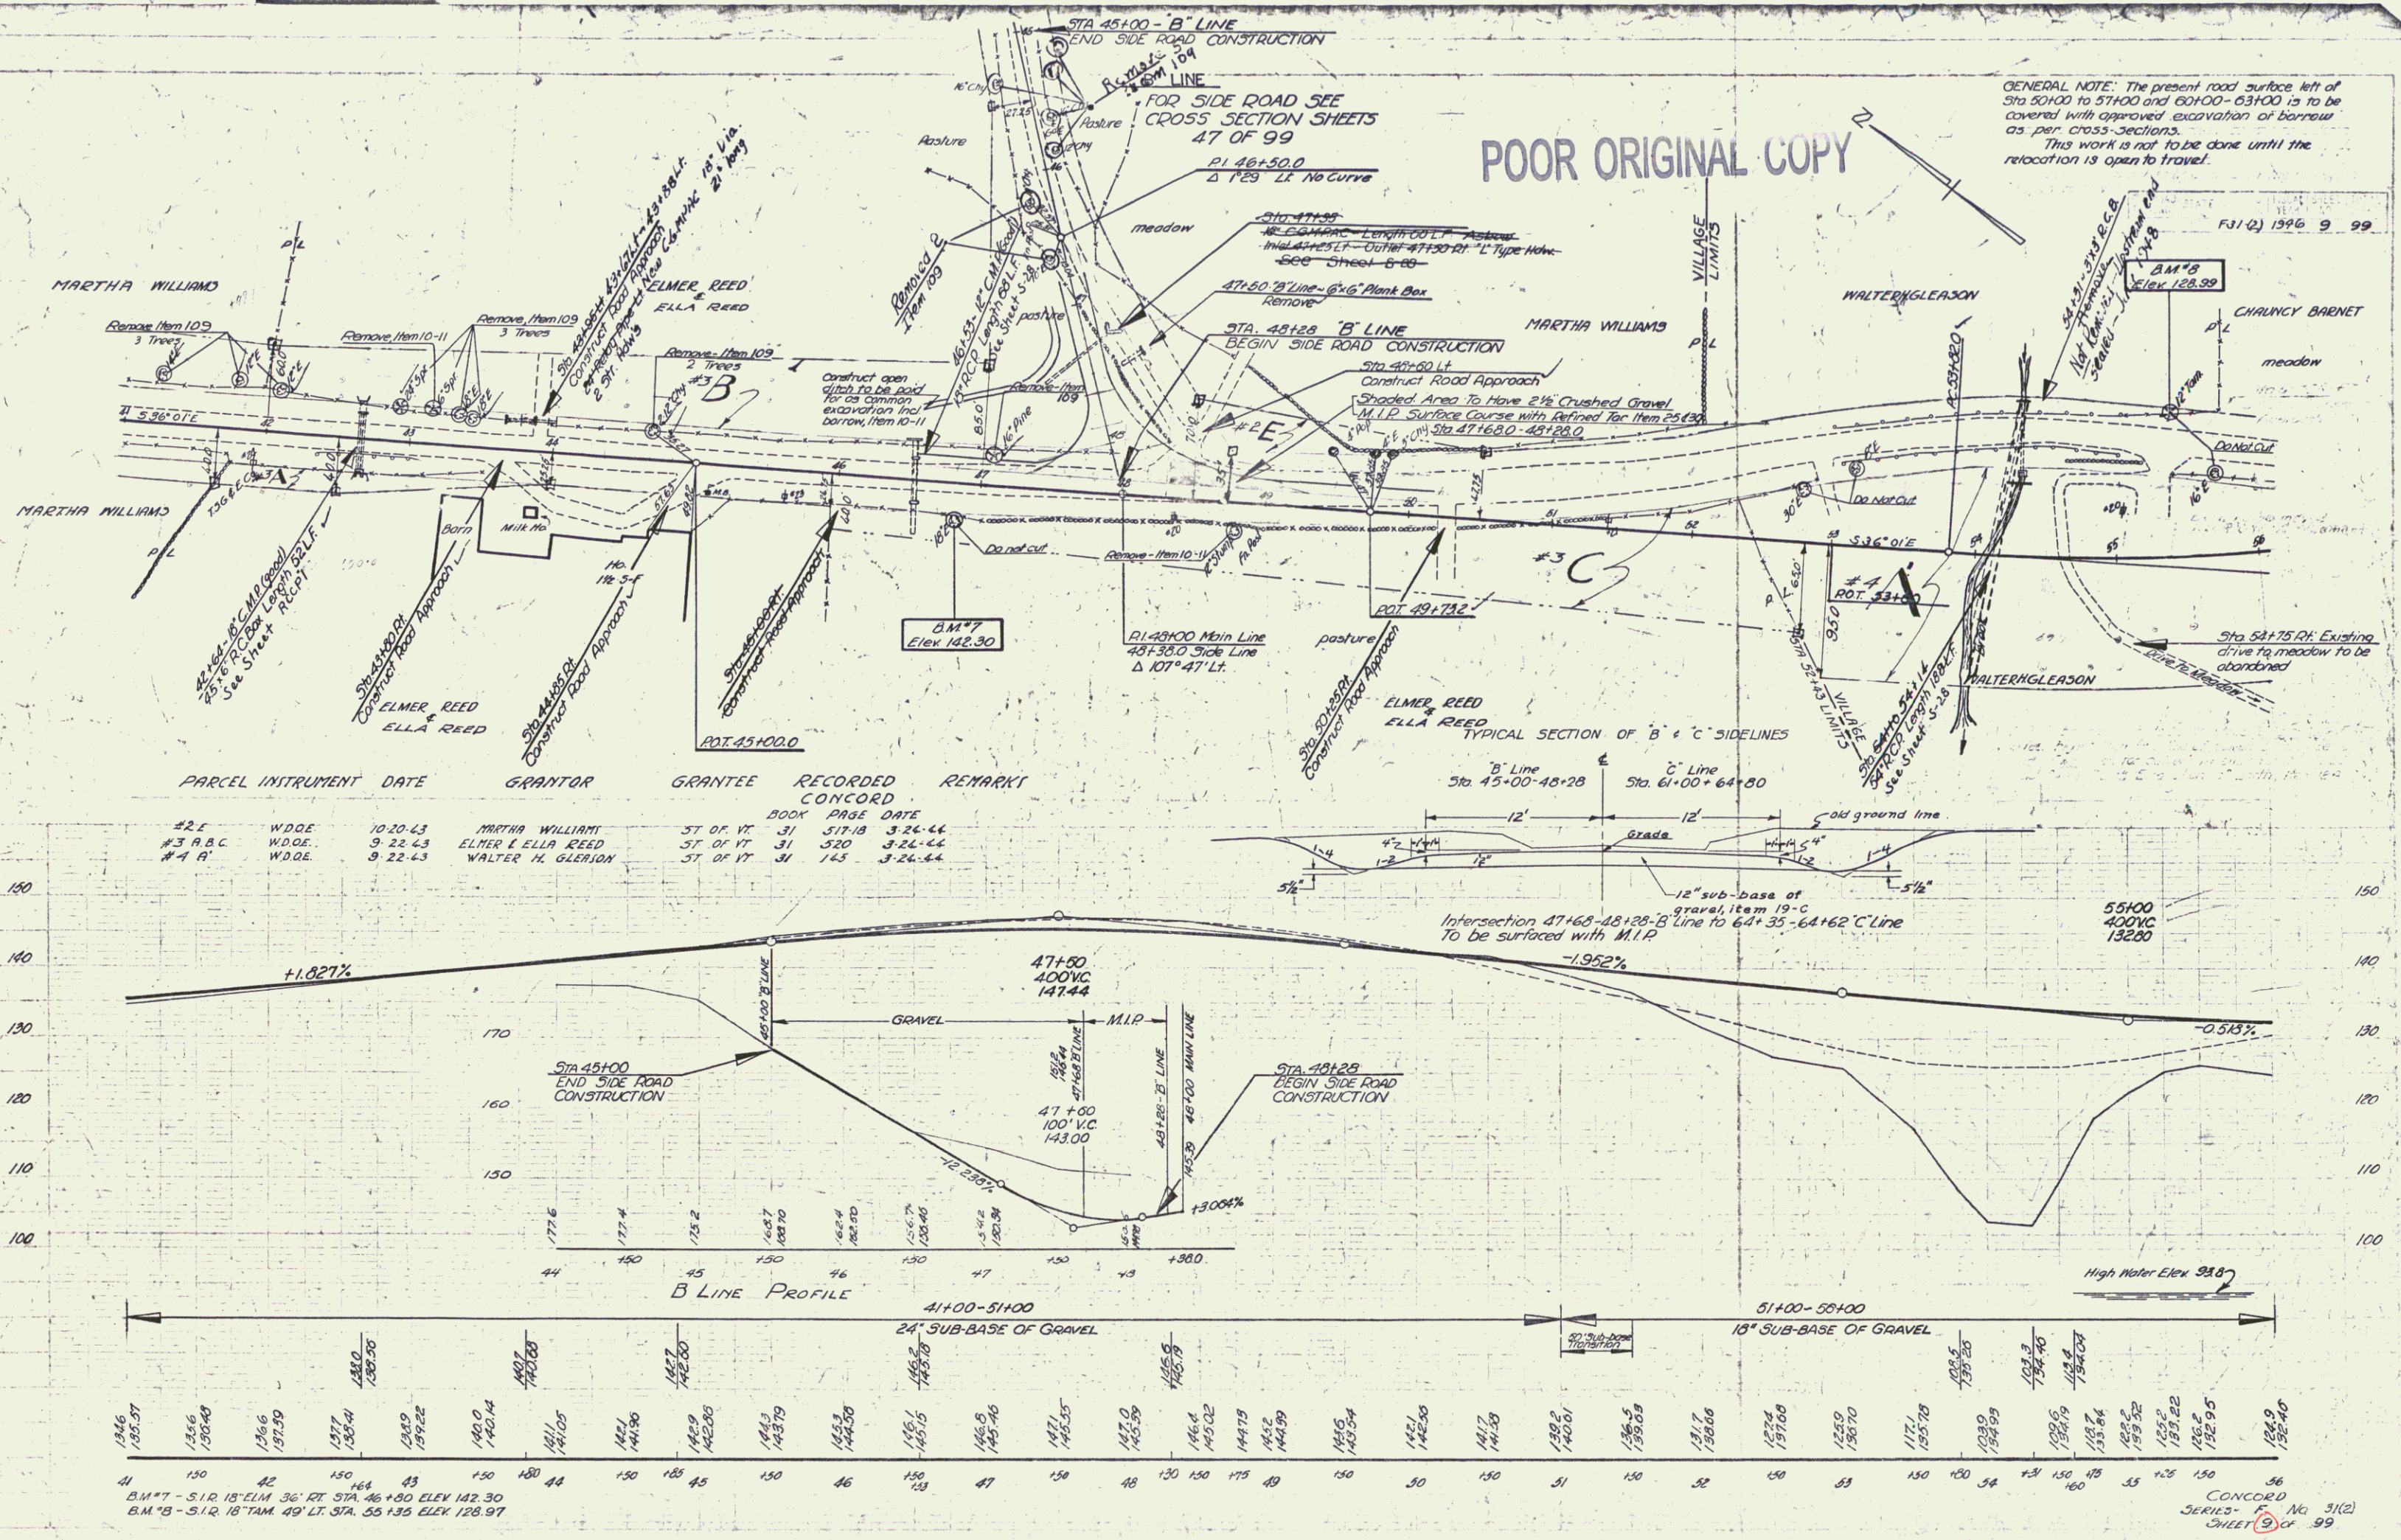



CONCORD SERIES - F No. 51(2) SHEET 9 OF 99


5

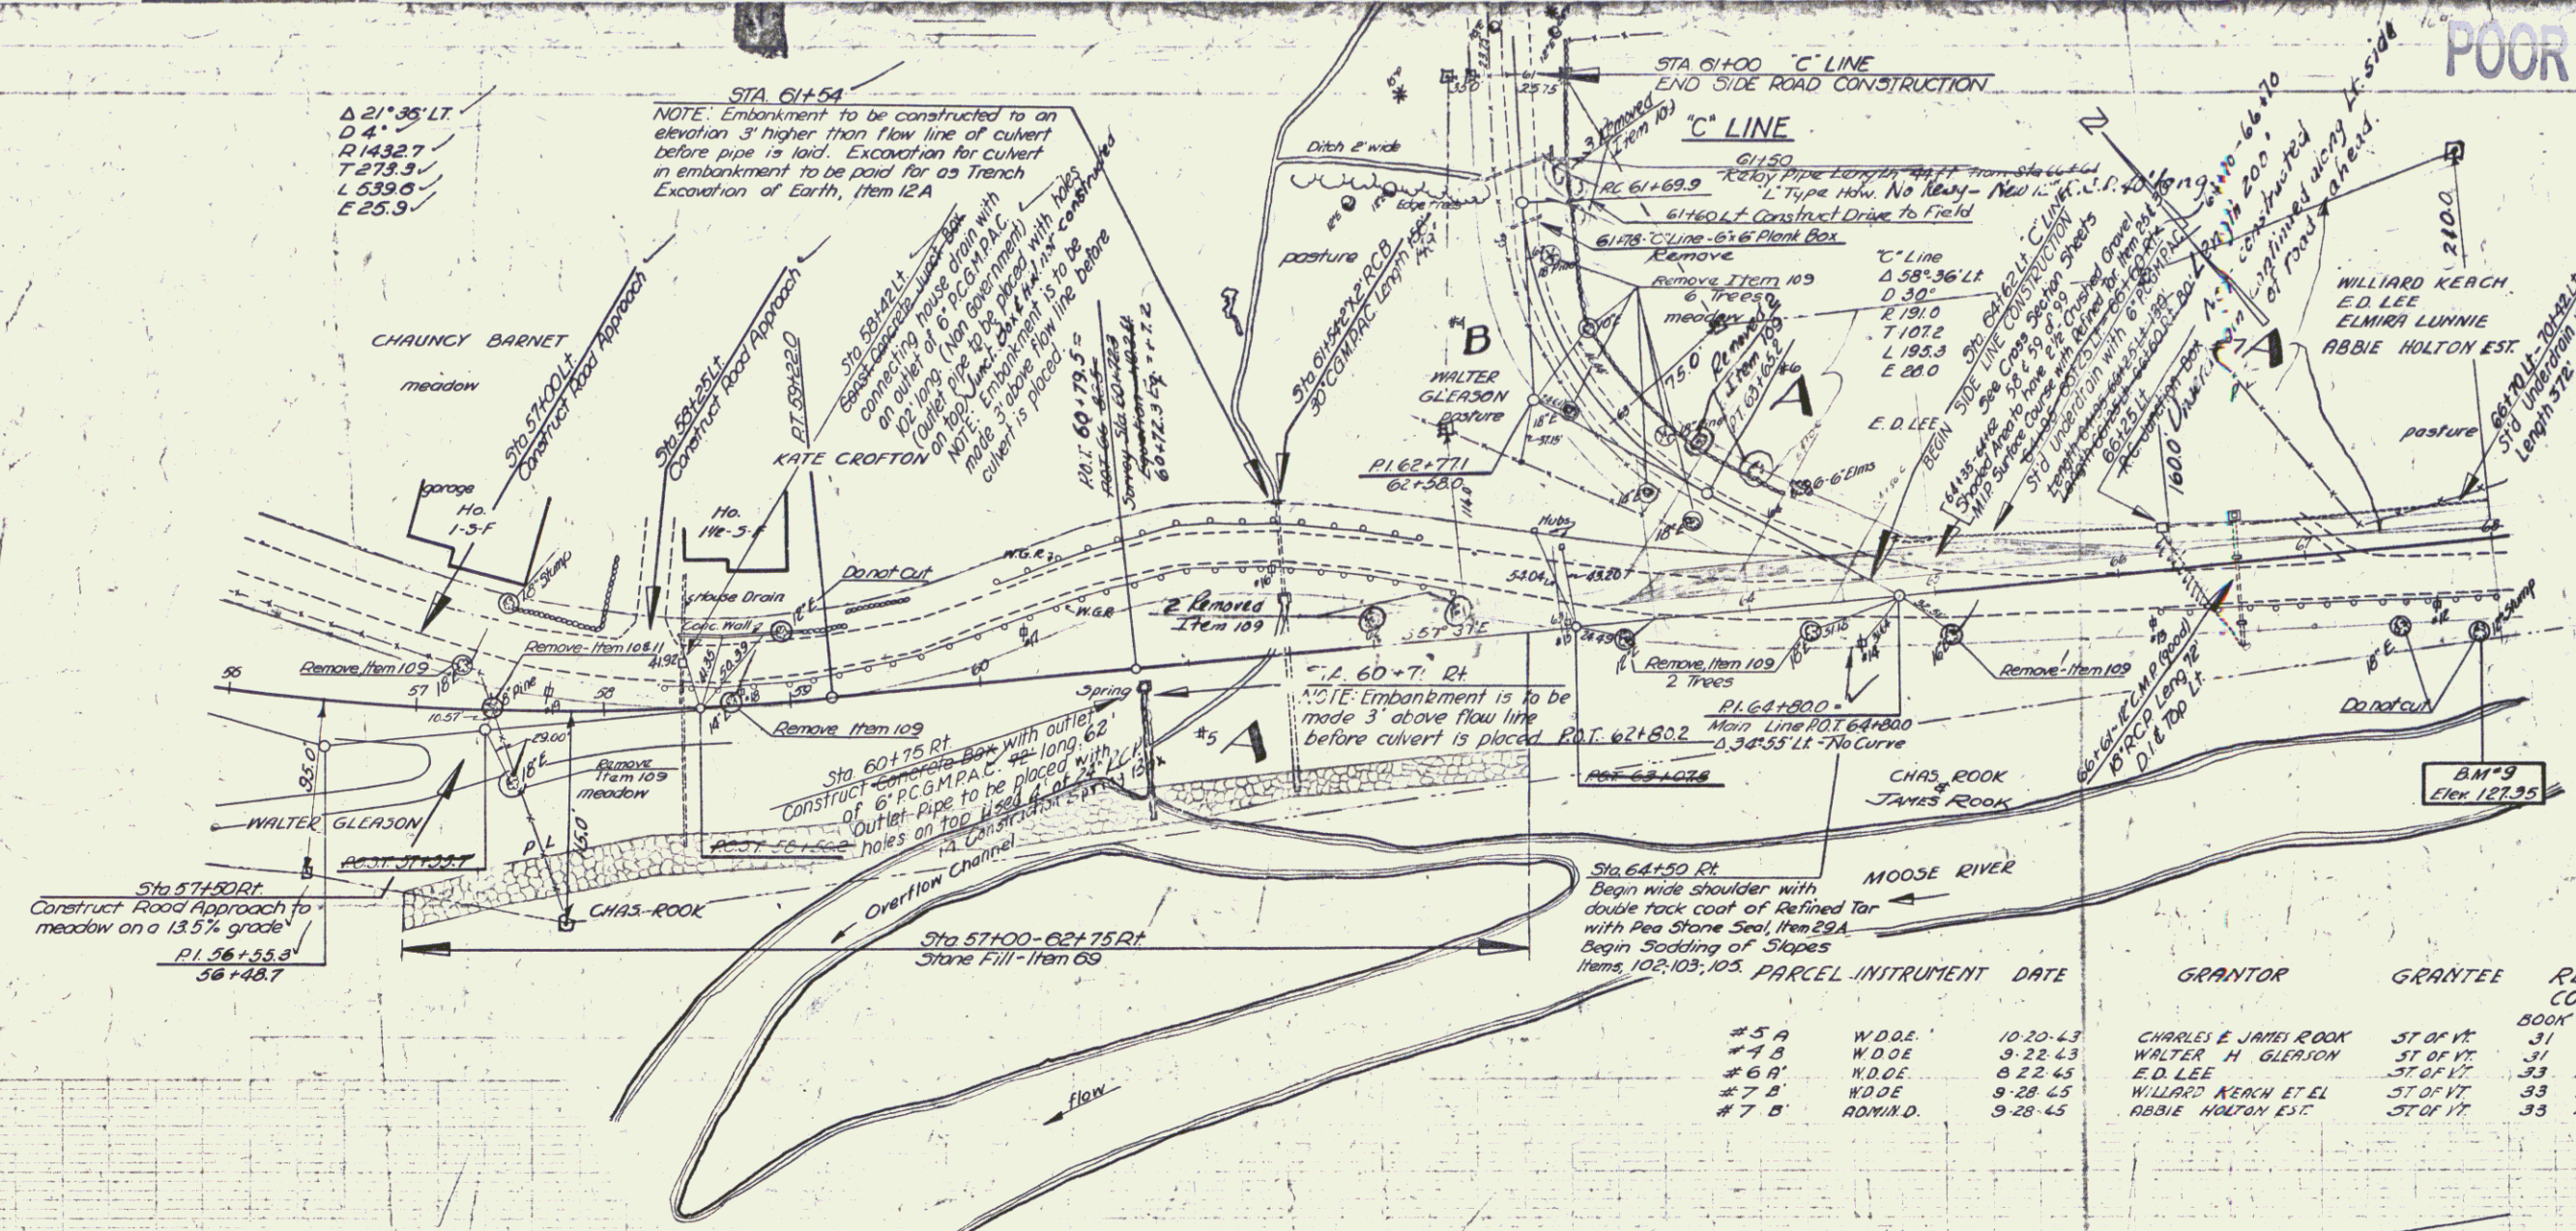


GRANTOR	GRANTEE	RECORDED	REMARKS
CHARLES JAMES ROOK	ST OF VT	BOOK PAGE DATE	
WALTER H. GLEASON	ST OF VT	31 144 3-24-44	
E.D. LEE	ST OF VT	33 237 10-25-45	
WILLARD KERCH ET AL	ST OF VT	33 230 10-25-45	
ABBIE HOLTAN EST.	ST OF VT	33 231 10-25-45	

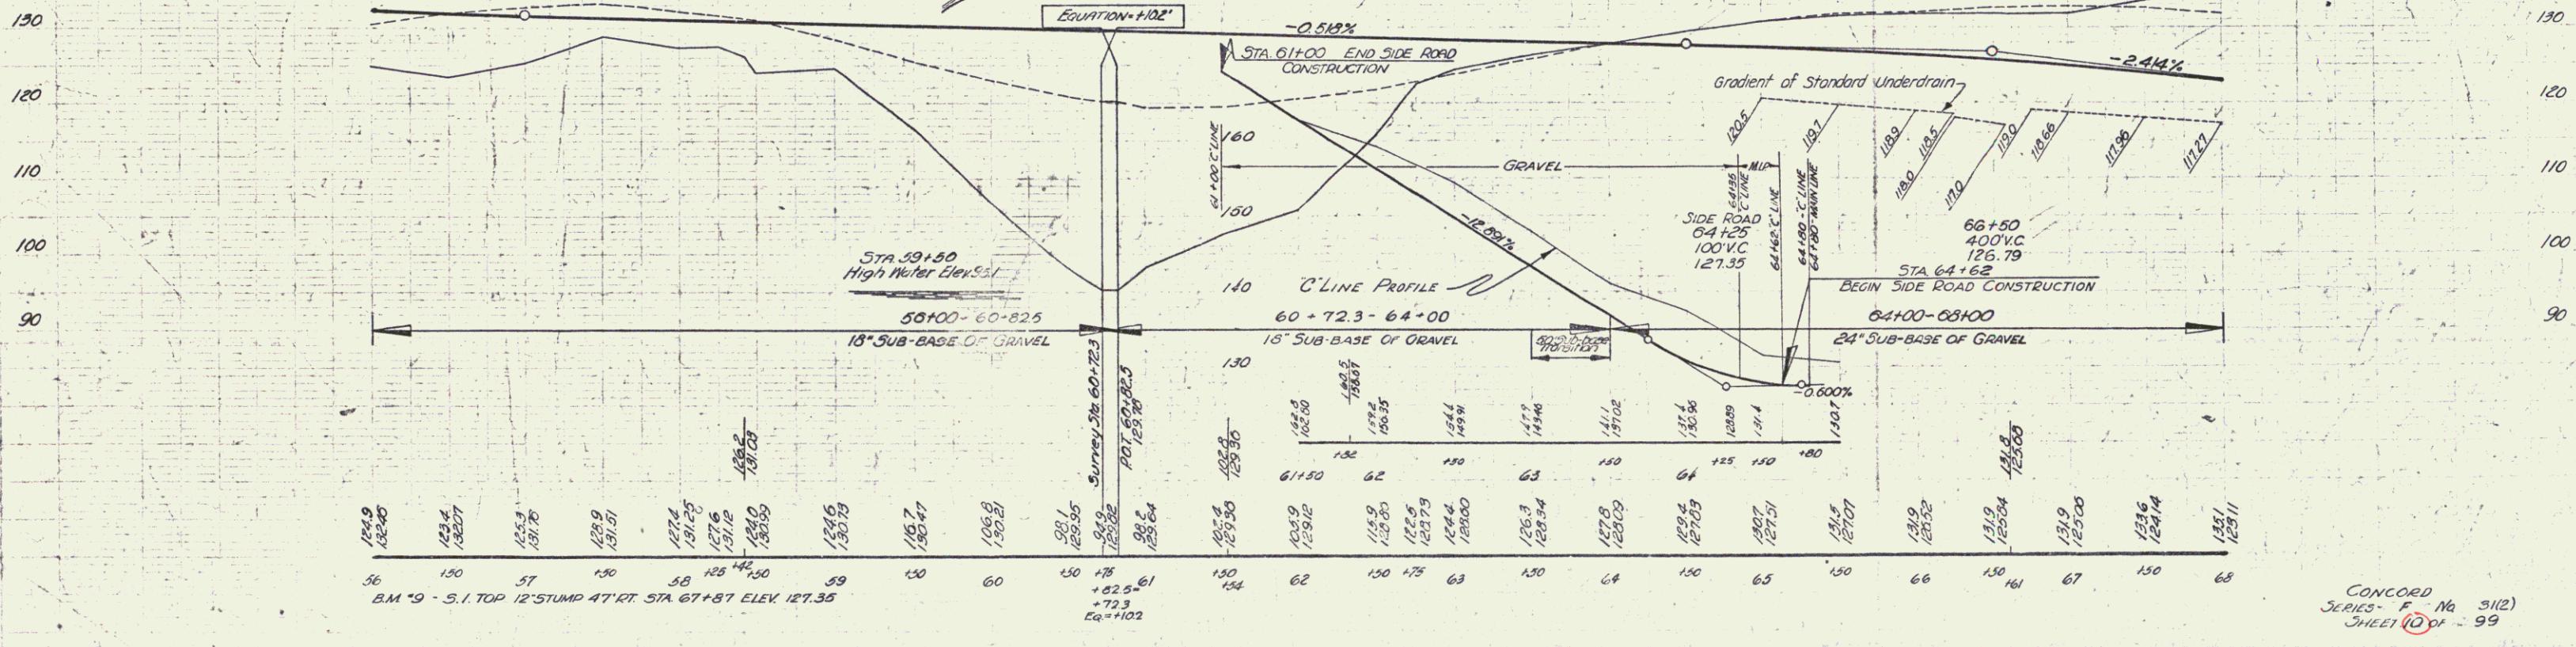

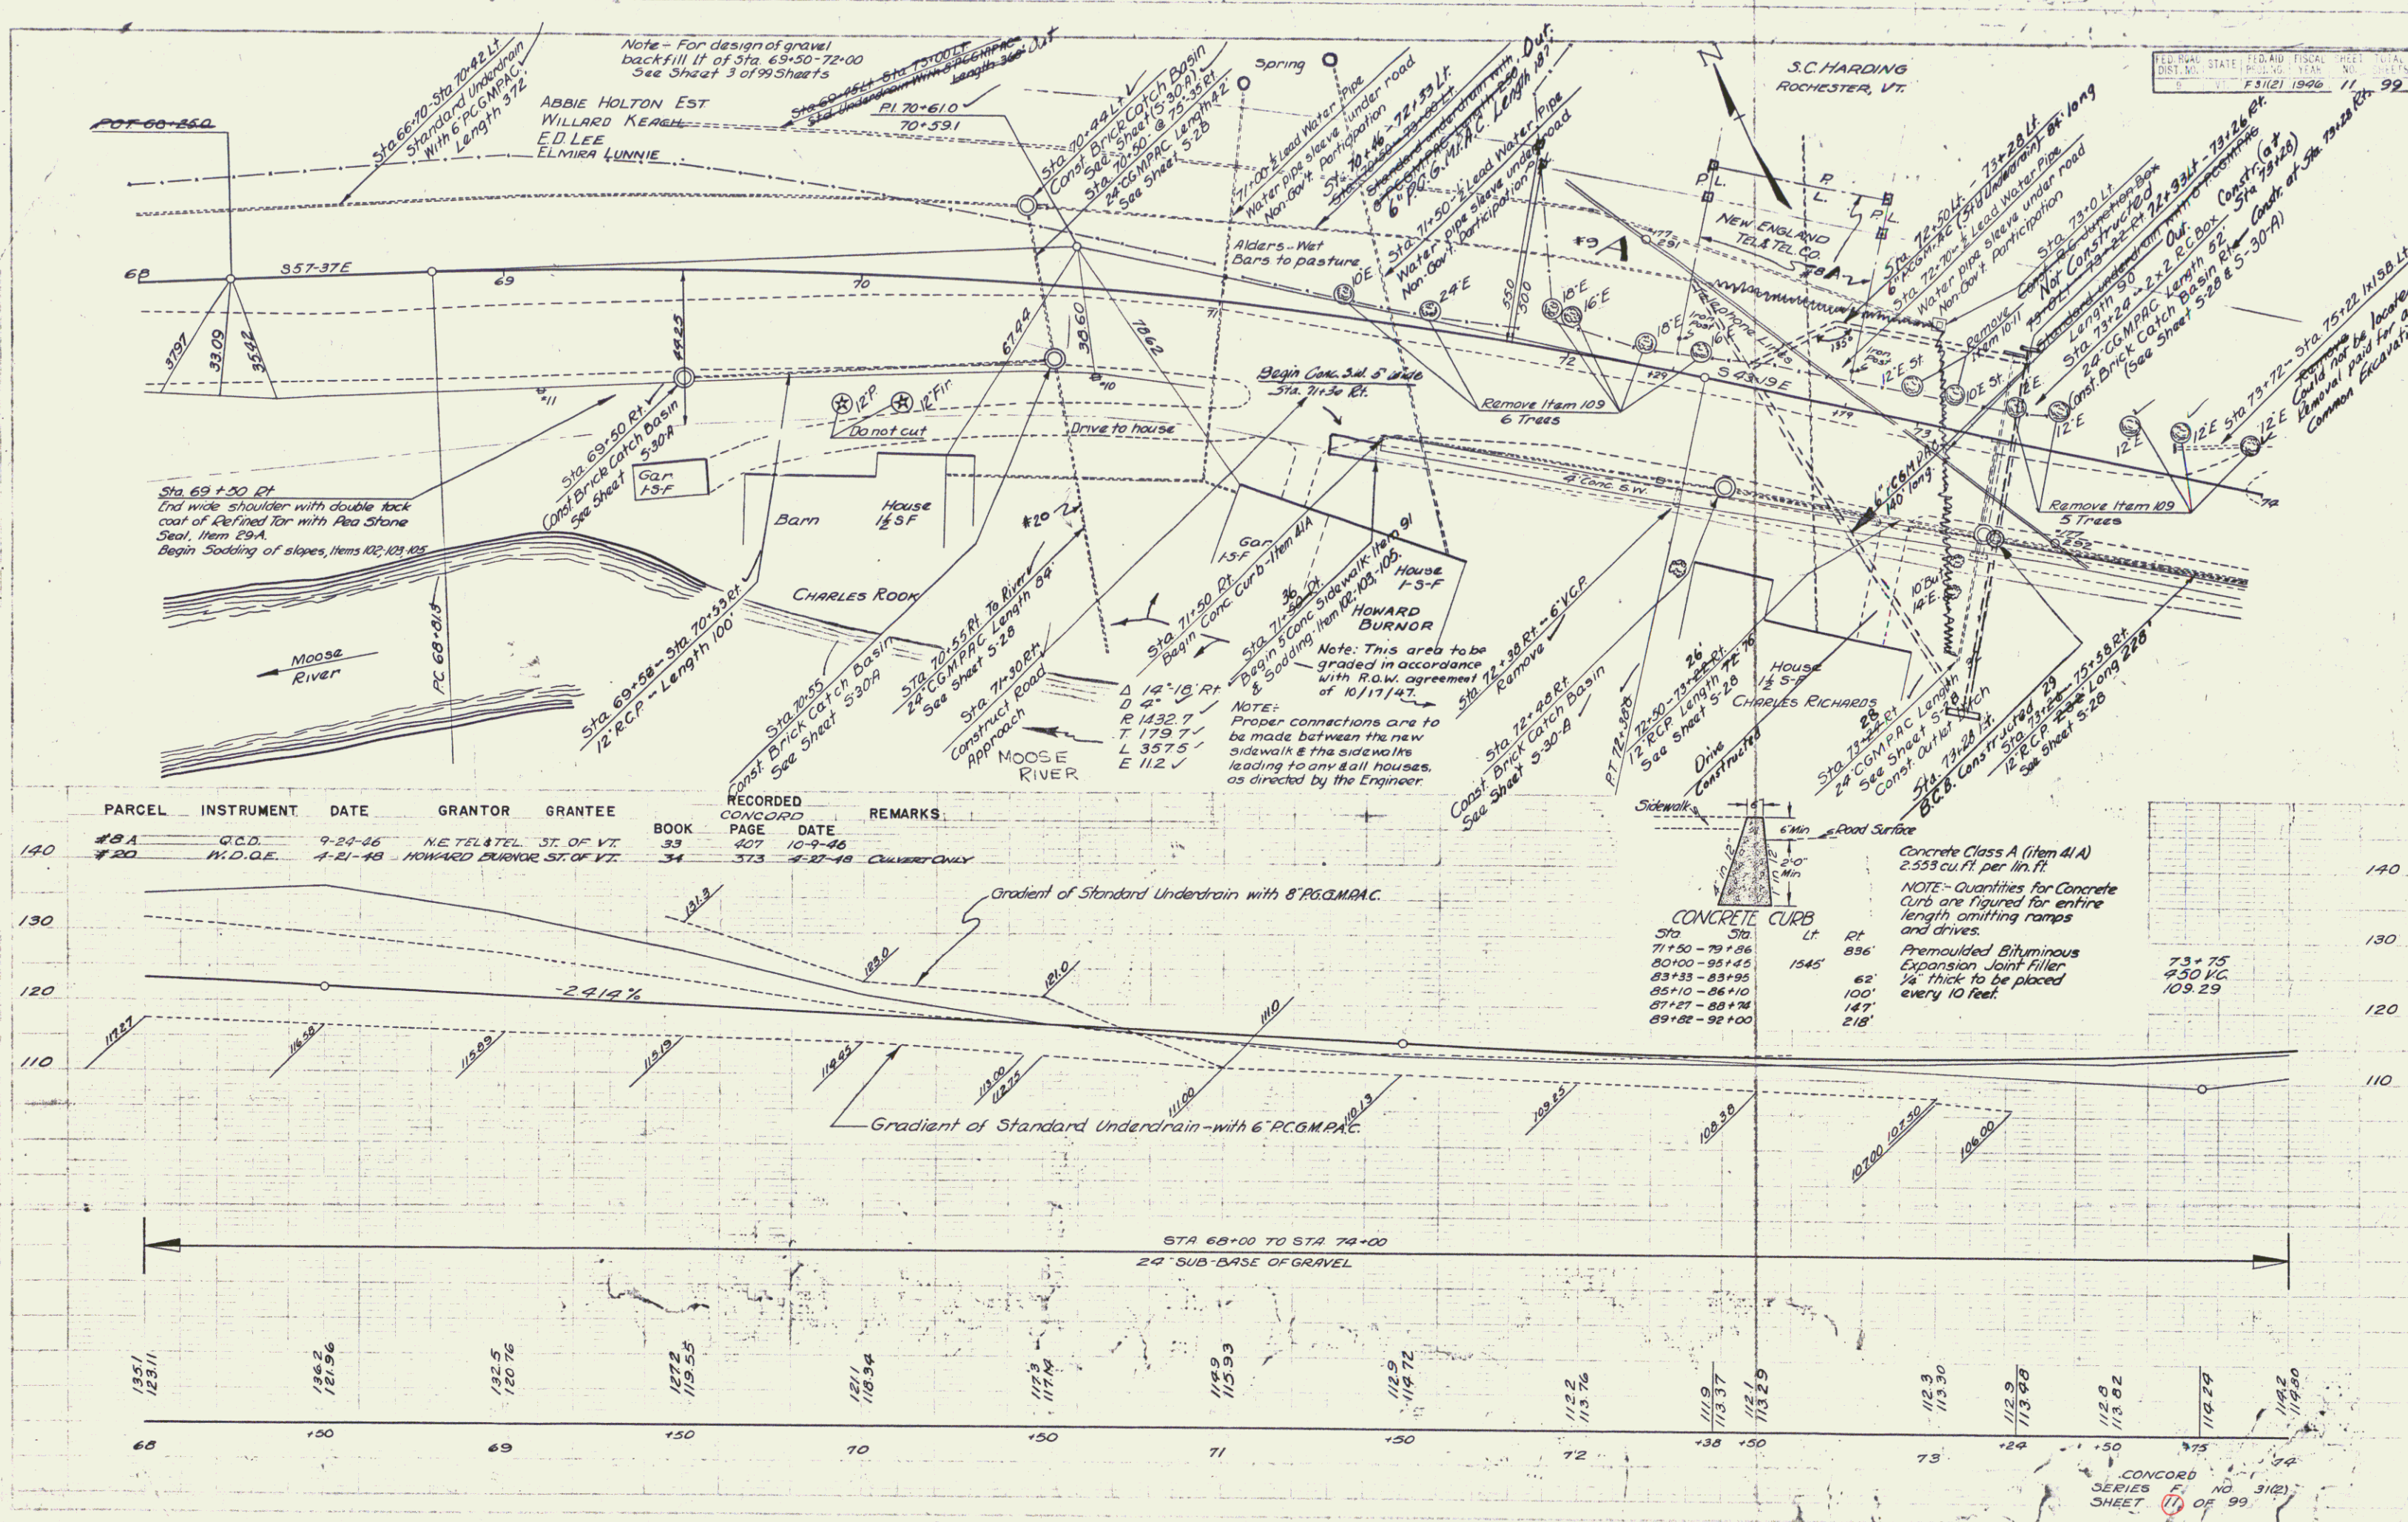

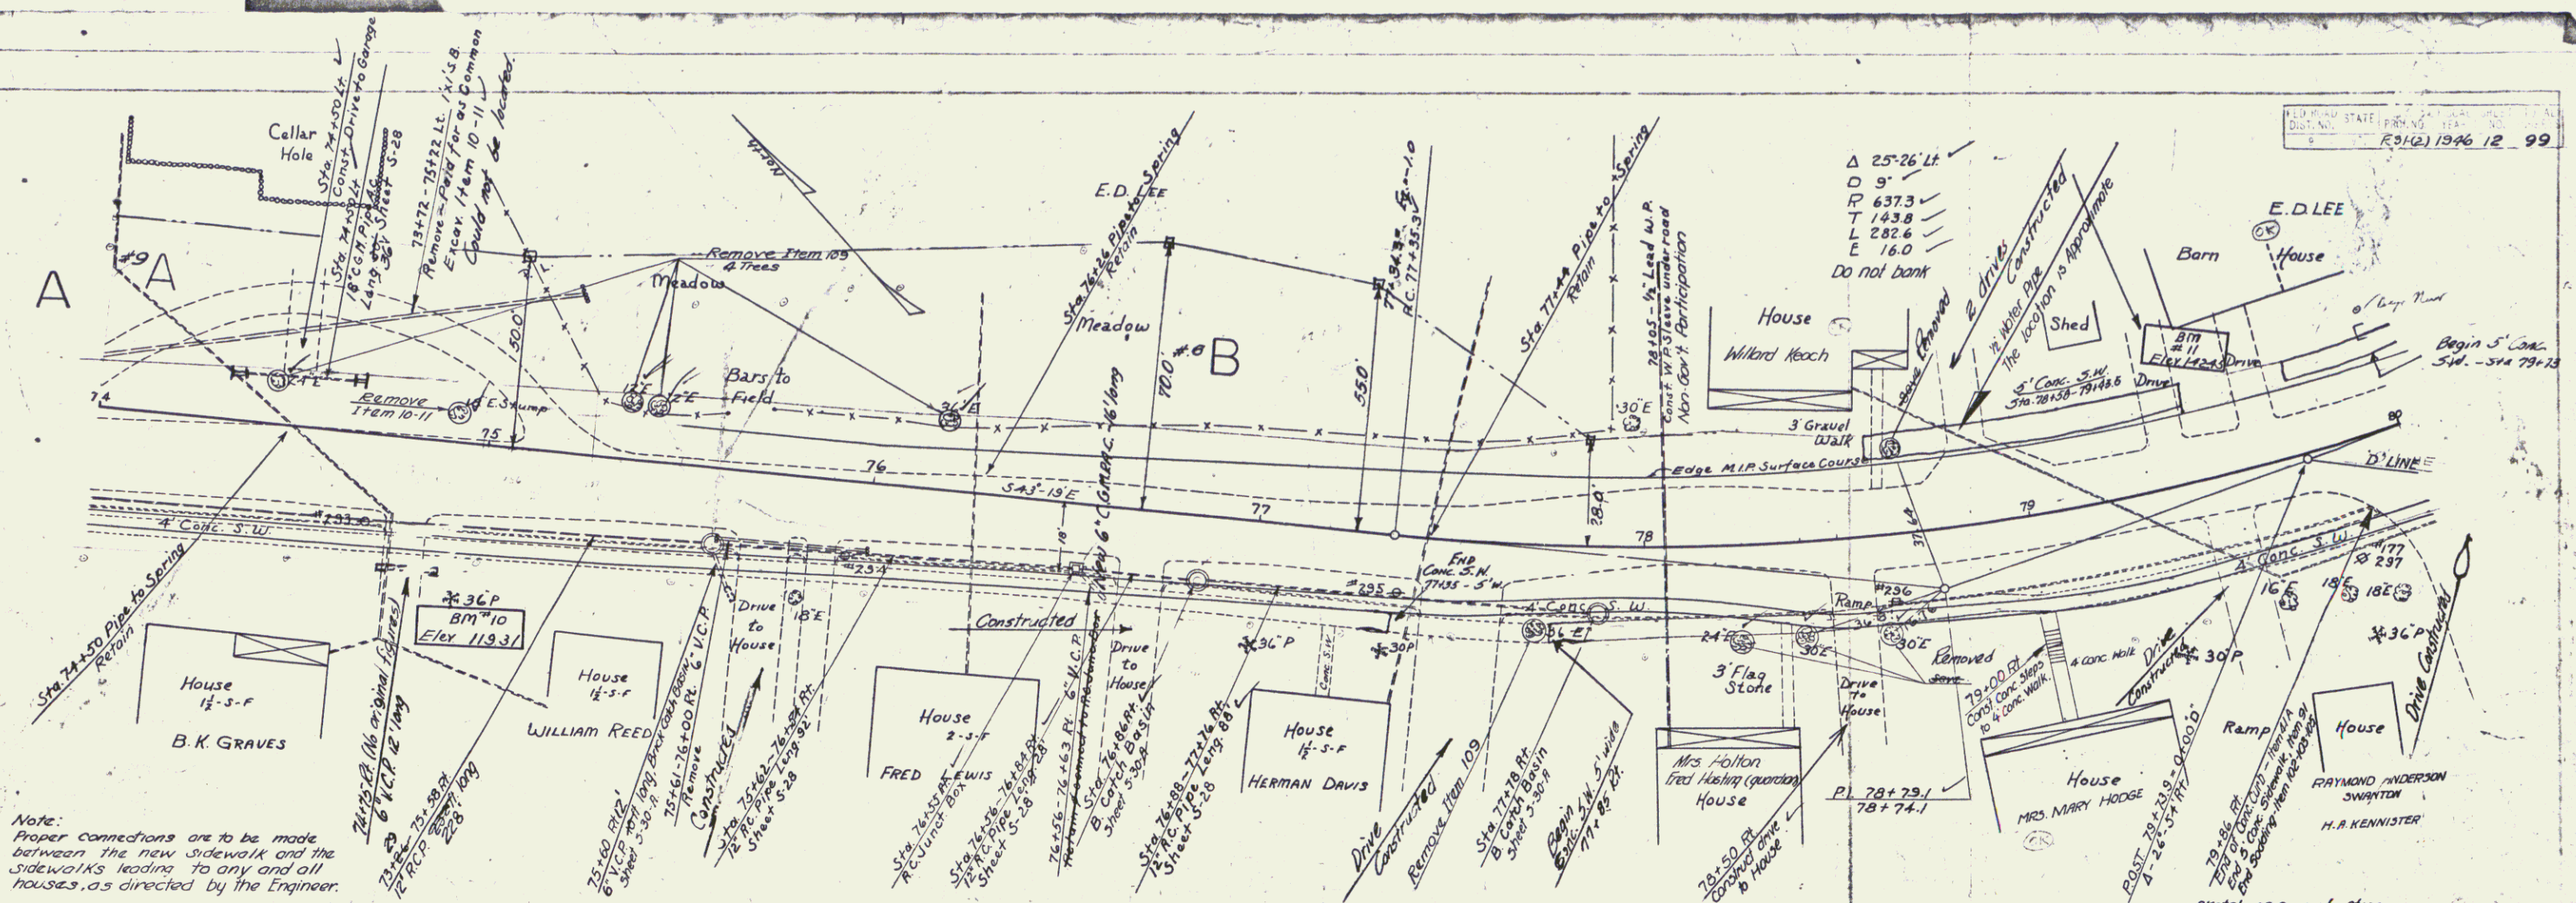


PARCEL	INSTRUMENT	DATE	GRANTOR	GRANTEE	RECORDED	CONCORD	REMARKS
#9A	W.D.O.E.	9-7-45	S. C. HARDING	ST. OF VT.	BOOK 33	PAGE 232	10-25-45
#6B	W.D.O.E.	8-22-45	E. D. LEE	ST. OF VT.	BOOK 33	PAGE 237	10-25-45

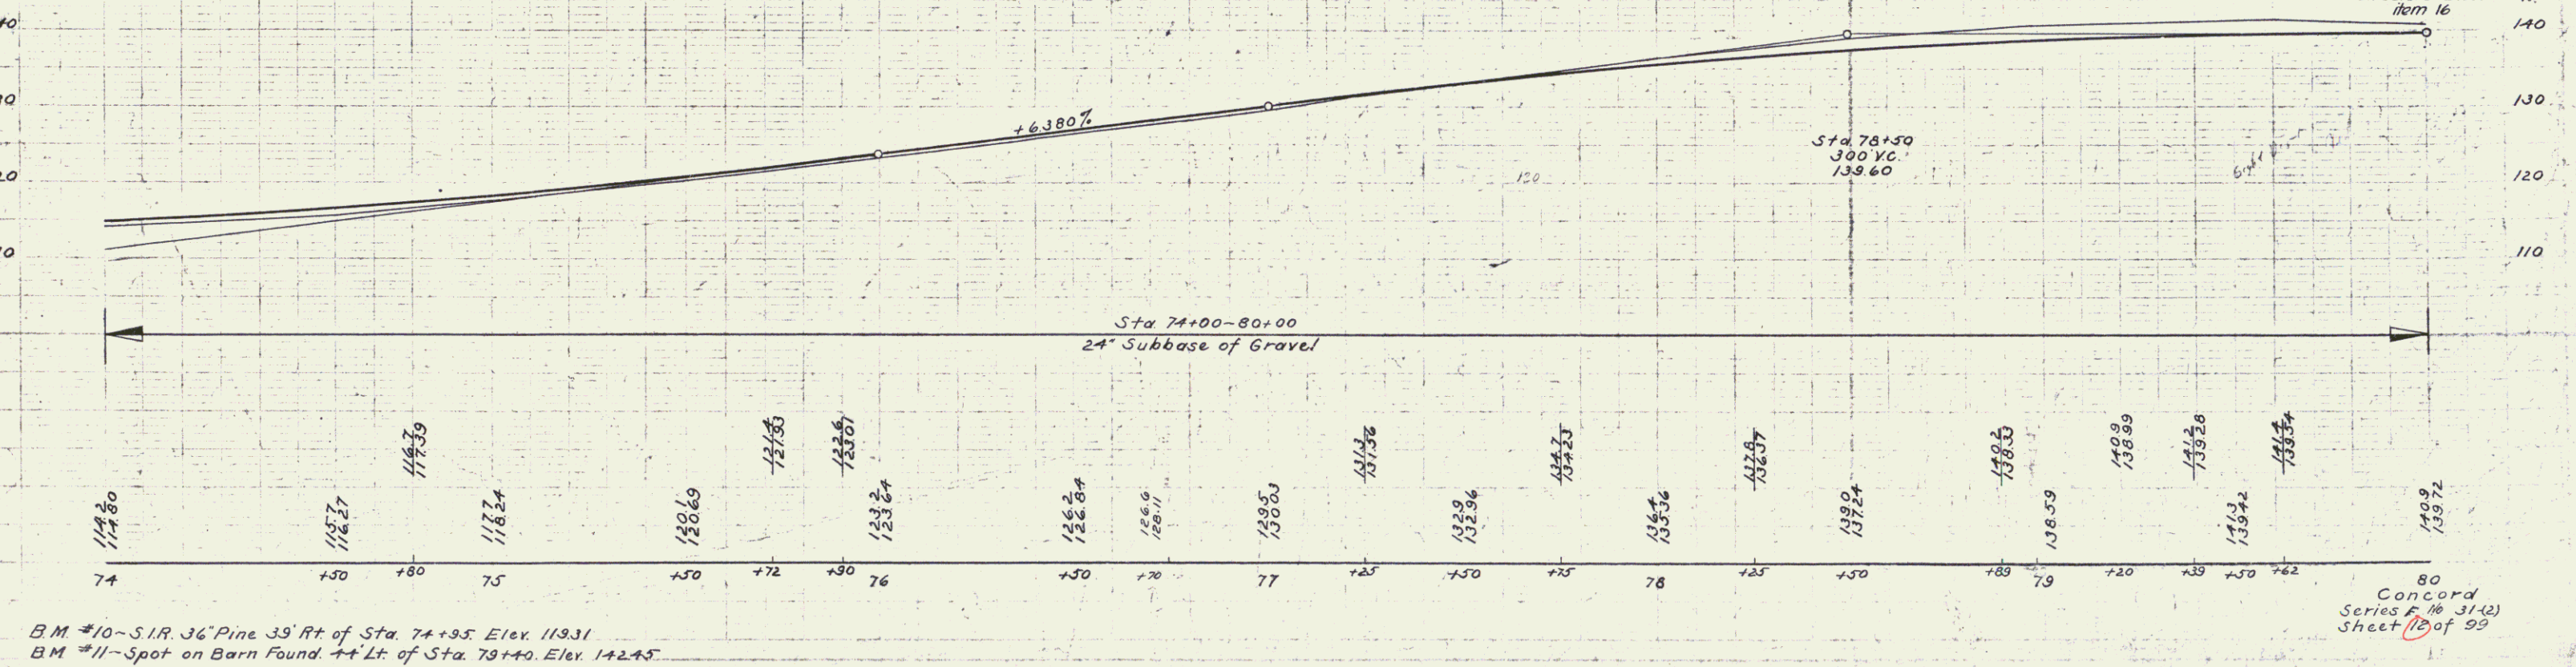

B.M. #10-S.I.R. 36" Pine 39' Rt of Sta. 74+95. Elev. 119.31
 B.M. #11-Spot on Barn Found. 44' Lt. of Sta. 79+40. Elev. 142.45
 Concord Series # 31-12 Sheet 18 of 99


POOR ORIGINAL COPY

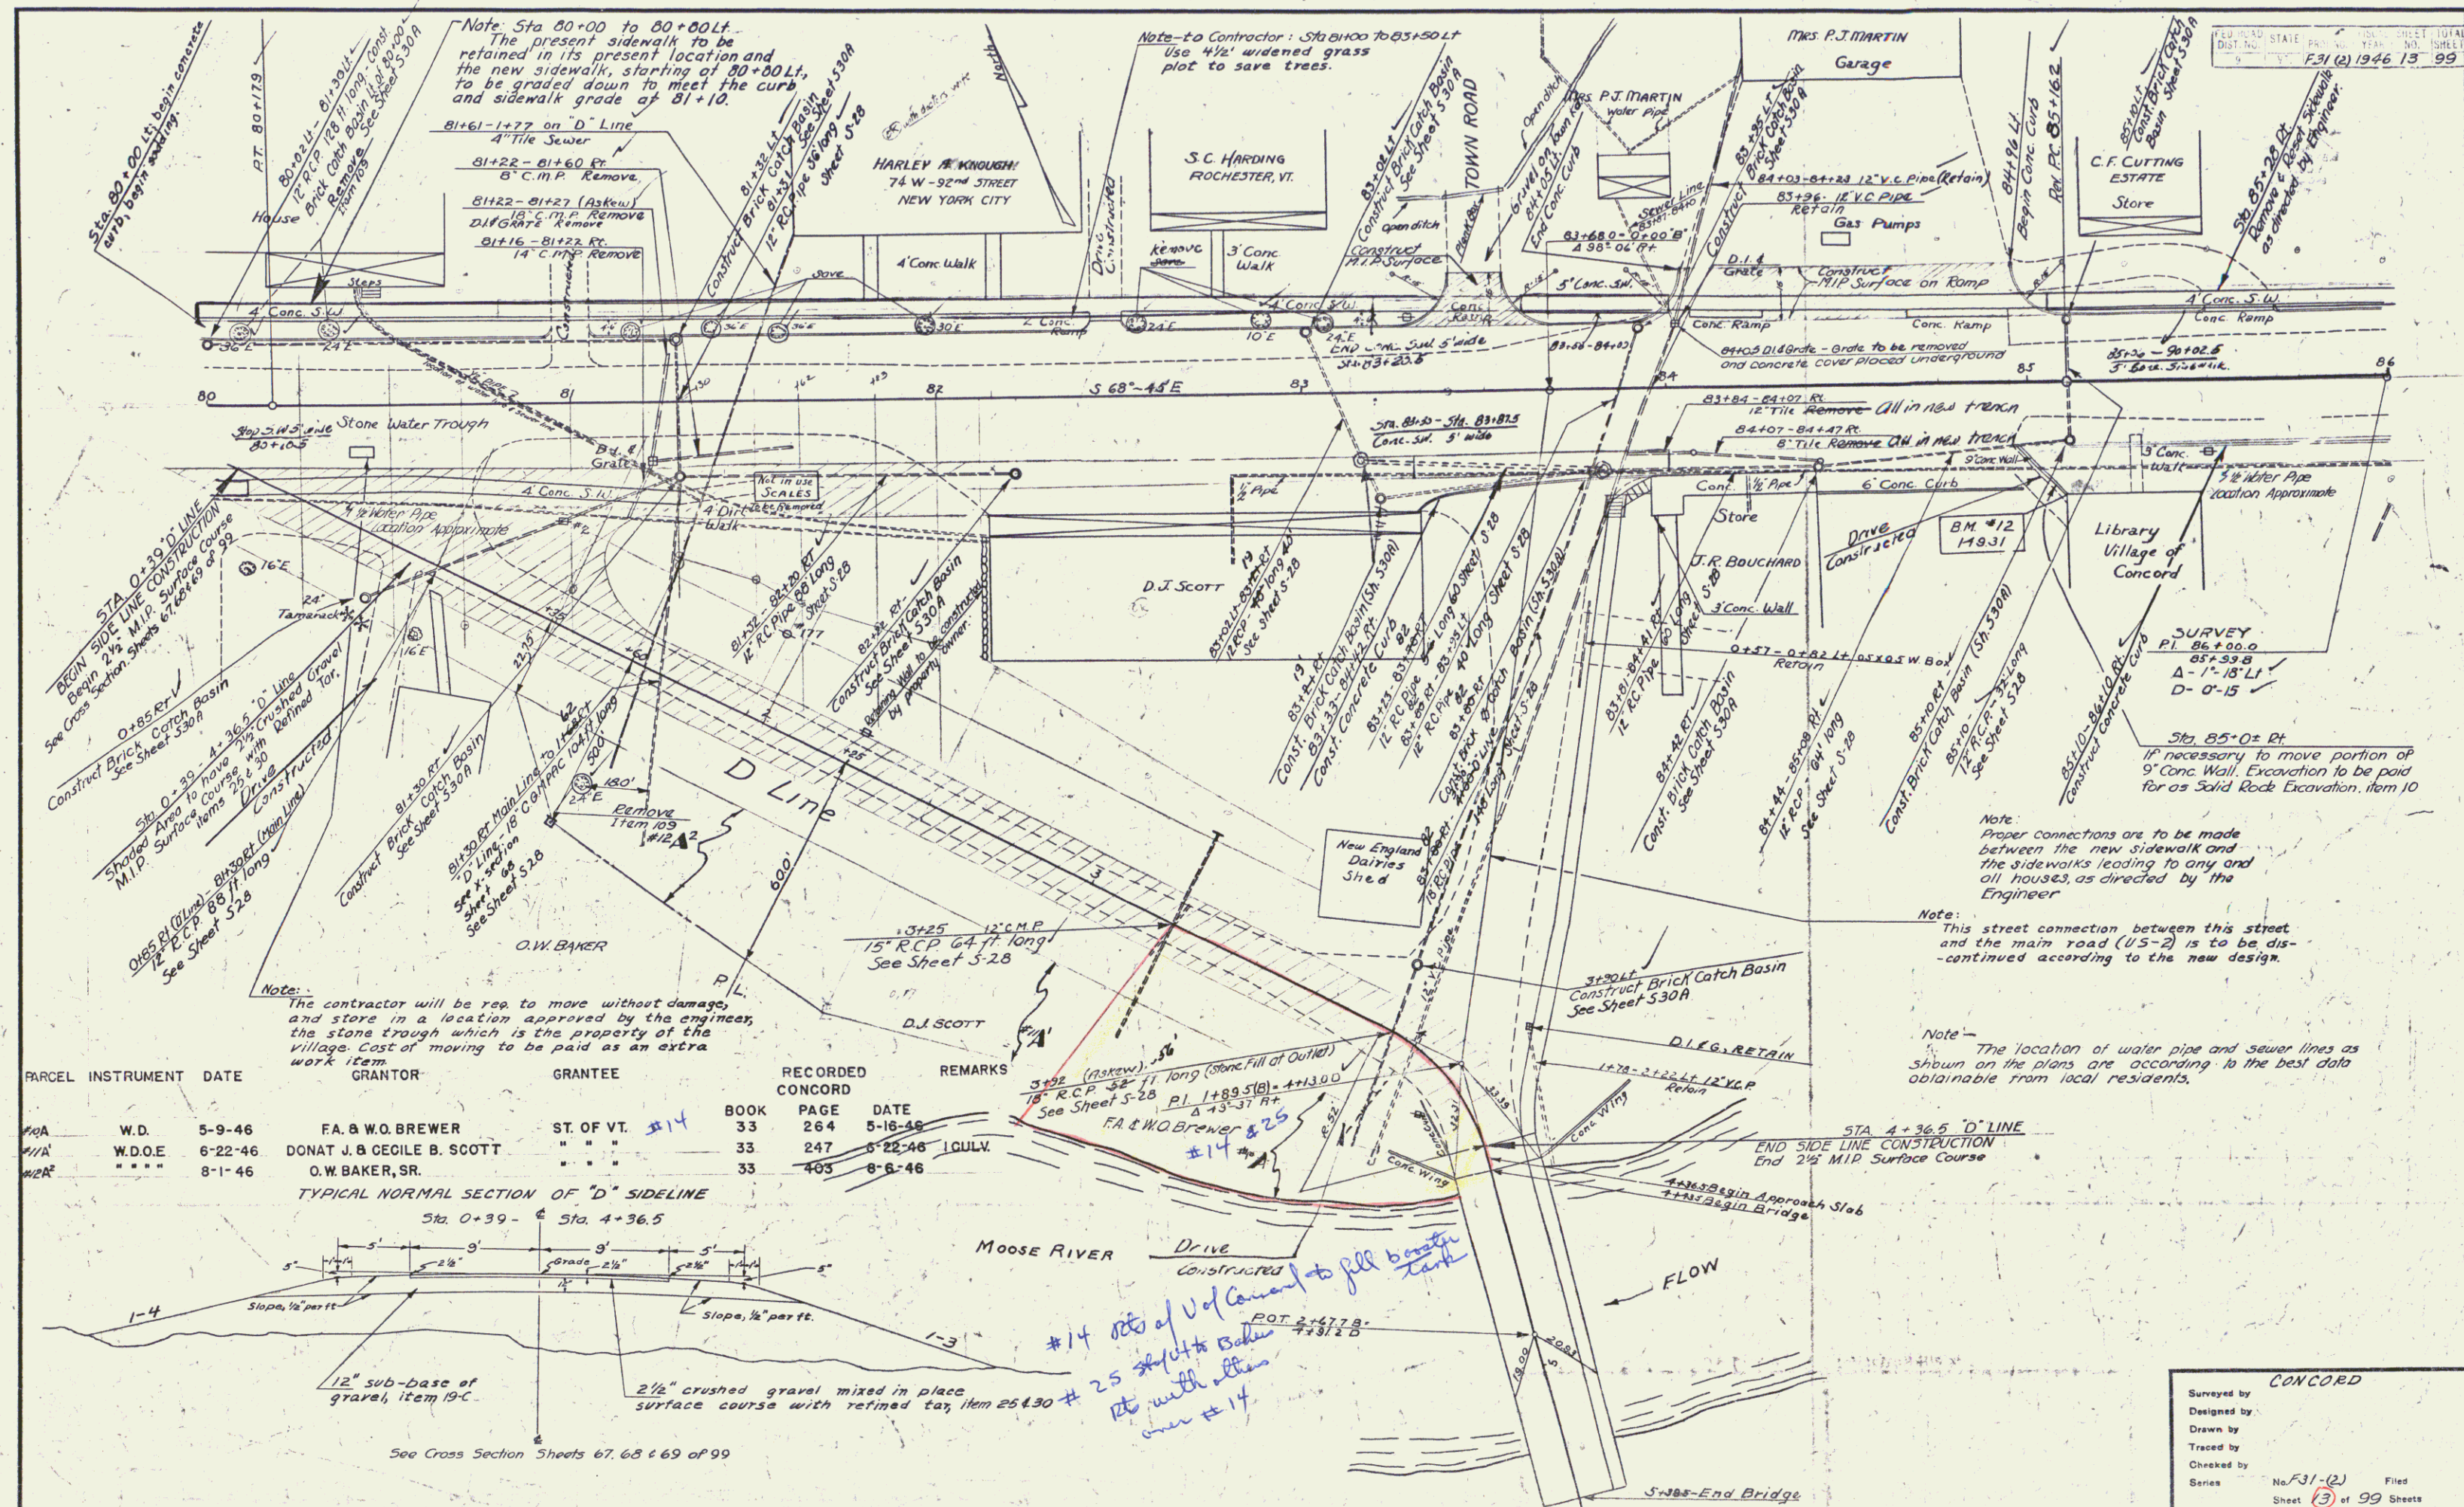

CONCORD
Surveyed by
Designed by
Drawn by
Traced by
Checked by
Series No. 31-22 Filed
Sheet 3 of 99 Sheets

BEING ALL AND THE SAME LAND AND PREMISES ACQUIRED BY THE STATE OF VERMONT FROM JOHN E., JR. & MARION JOHNSON, ALBERT E. & DOROTHY D. GORHAM, AND GILFORD WELL CO., INC. BY W.D. DATED APR. 23, 1981. AND RECORDED IN BK. 45, PGS. 404-406 OF THE CONCORD LAND RECORDS.

MA 0218

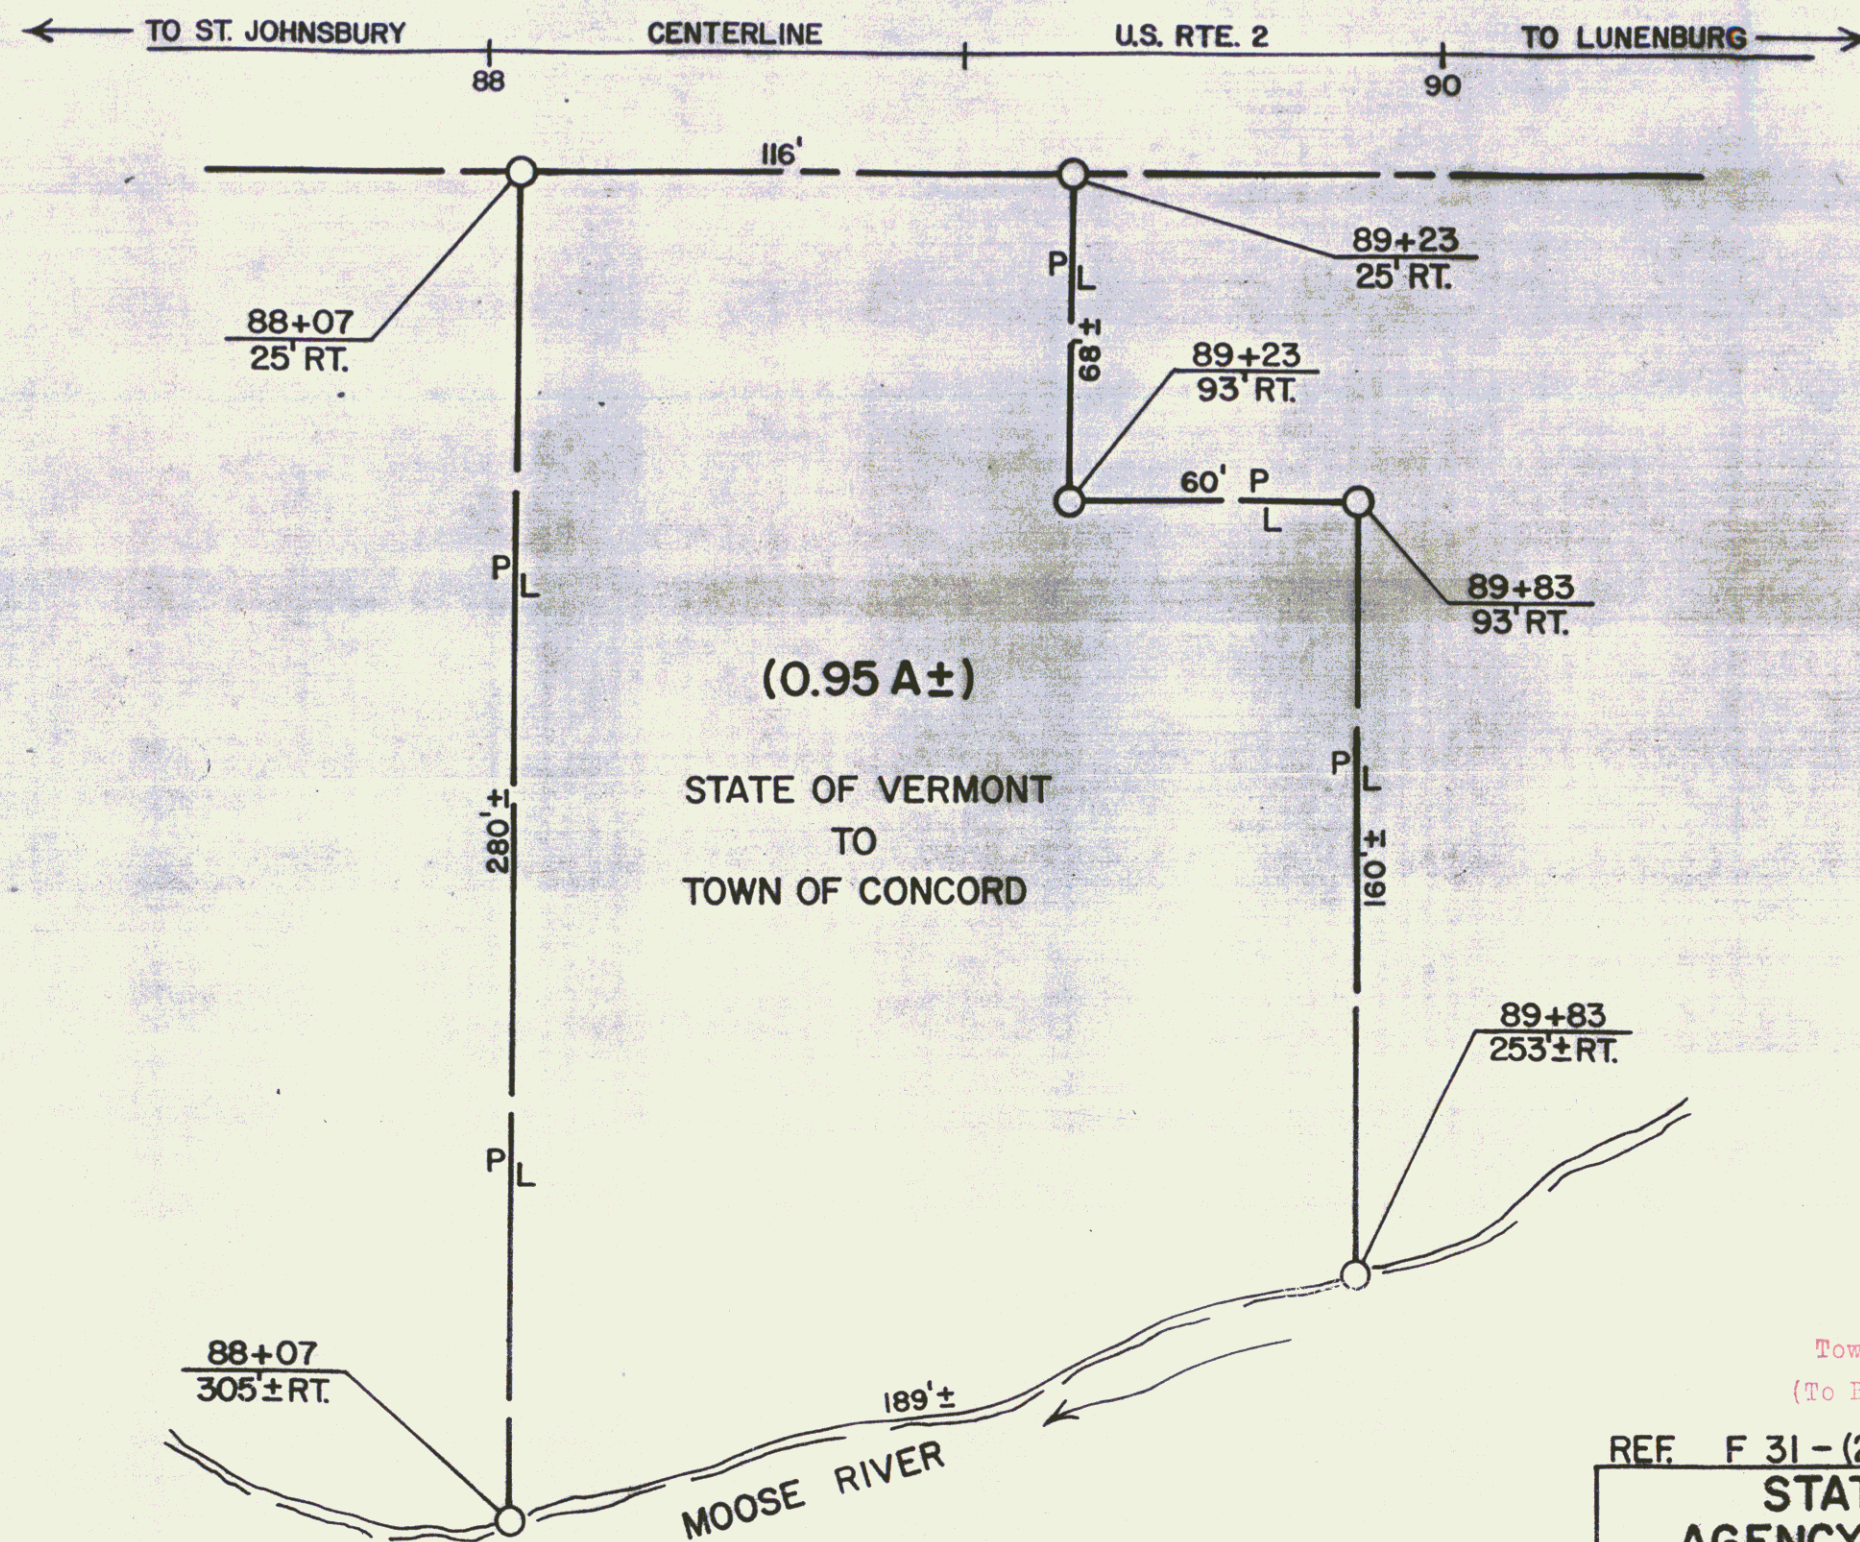

RIGHT-OF-WAY DIVISION
TOWN FILE
PERPETUAL

Town of Concord (US 2 MM 2.20)
(To Be Returned To R.O.W. Division)

REF. F 31-(2) SHEET 15A OF 99


STATE OF VERMONT
AGENCY OF TRANSPORTATION

TOWN OF CONCORD

SCALE: 1"=40'
0 40 80 120 160 200

APPROX SCALE 1"=40' DATE 10-25-84 DRAWN BY DEM.


BEING ALL OF THE SAME LAND AND PREMISES CONVEYED TO
JOHN E. JOHNSON Jr. & MARION JOHNSON BY ALBERT E. GORHAM
& DOROTHY D. GORHAM BY WARRANTY DEED DATED APRIL 22, 1977
AND RECORDED MAY 17, 1977 IN BOOK 43 PAGES 153-155 OF THE
TOWN OF CONCORD LAND RECORDS
ACQUIRED BY W.D. DATED MAY 7, 1981 REC. MAY 30,
1981 IN BK. 45 PG. 404-407 IN THE TOWN OF
CONCORD LAND RECORDS.

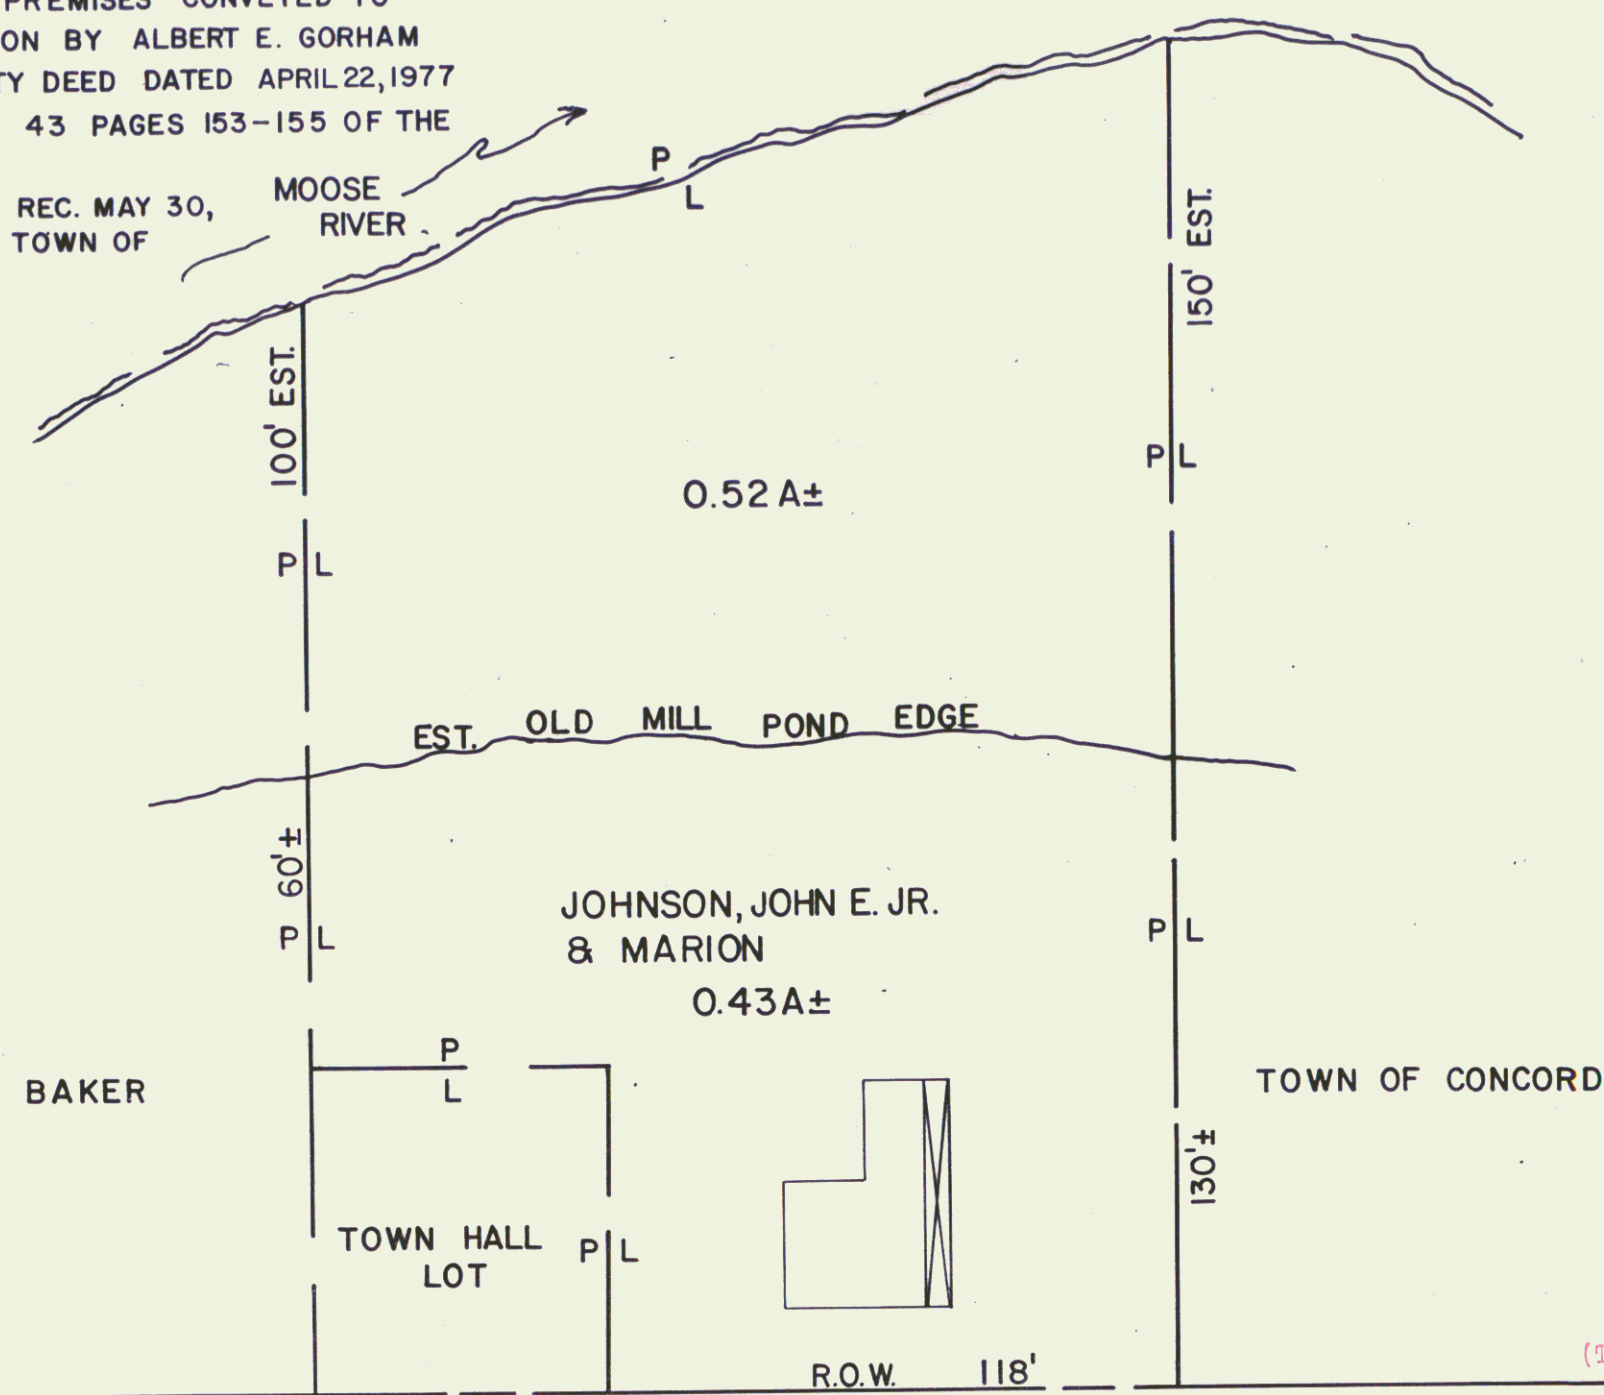

RIGHT-OF-WAY DIVISION
TOWN FILE

PERPETUAL
Town of Concord U.S. 2 MM 2.20
(To Be Returned To R.O.W. Division)

← TO LUNENBURG 90 89 88 → TO ST. JOHNSBURY →
RTE. 2 C

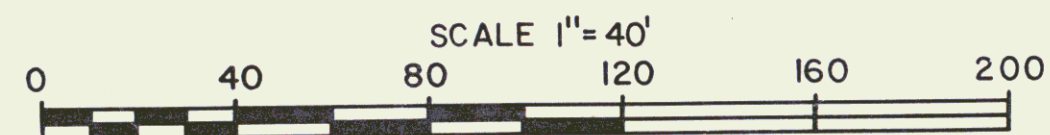


REF F 31-(2) SHEET OF 99 (15B)

STATE OF VERMONT
AGENCY OF TRANSPORTATION


TOWN OF CONCORD

PROJECT JOHNSON PROPERTY 12
APPROX. SCALE 1"=40' DATE 4-1-81 DRAWN BY FJM

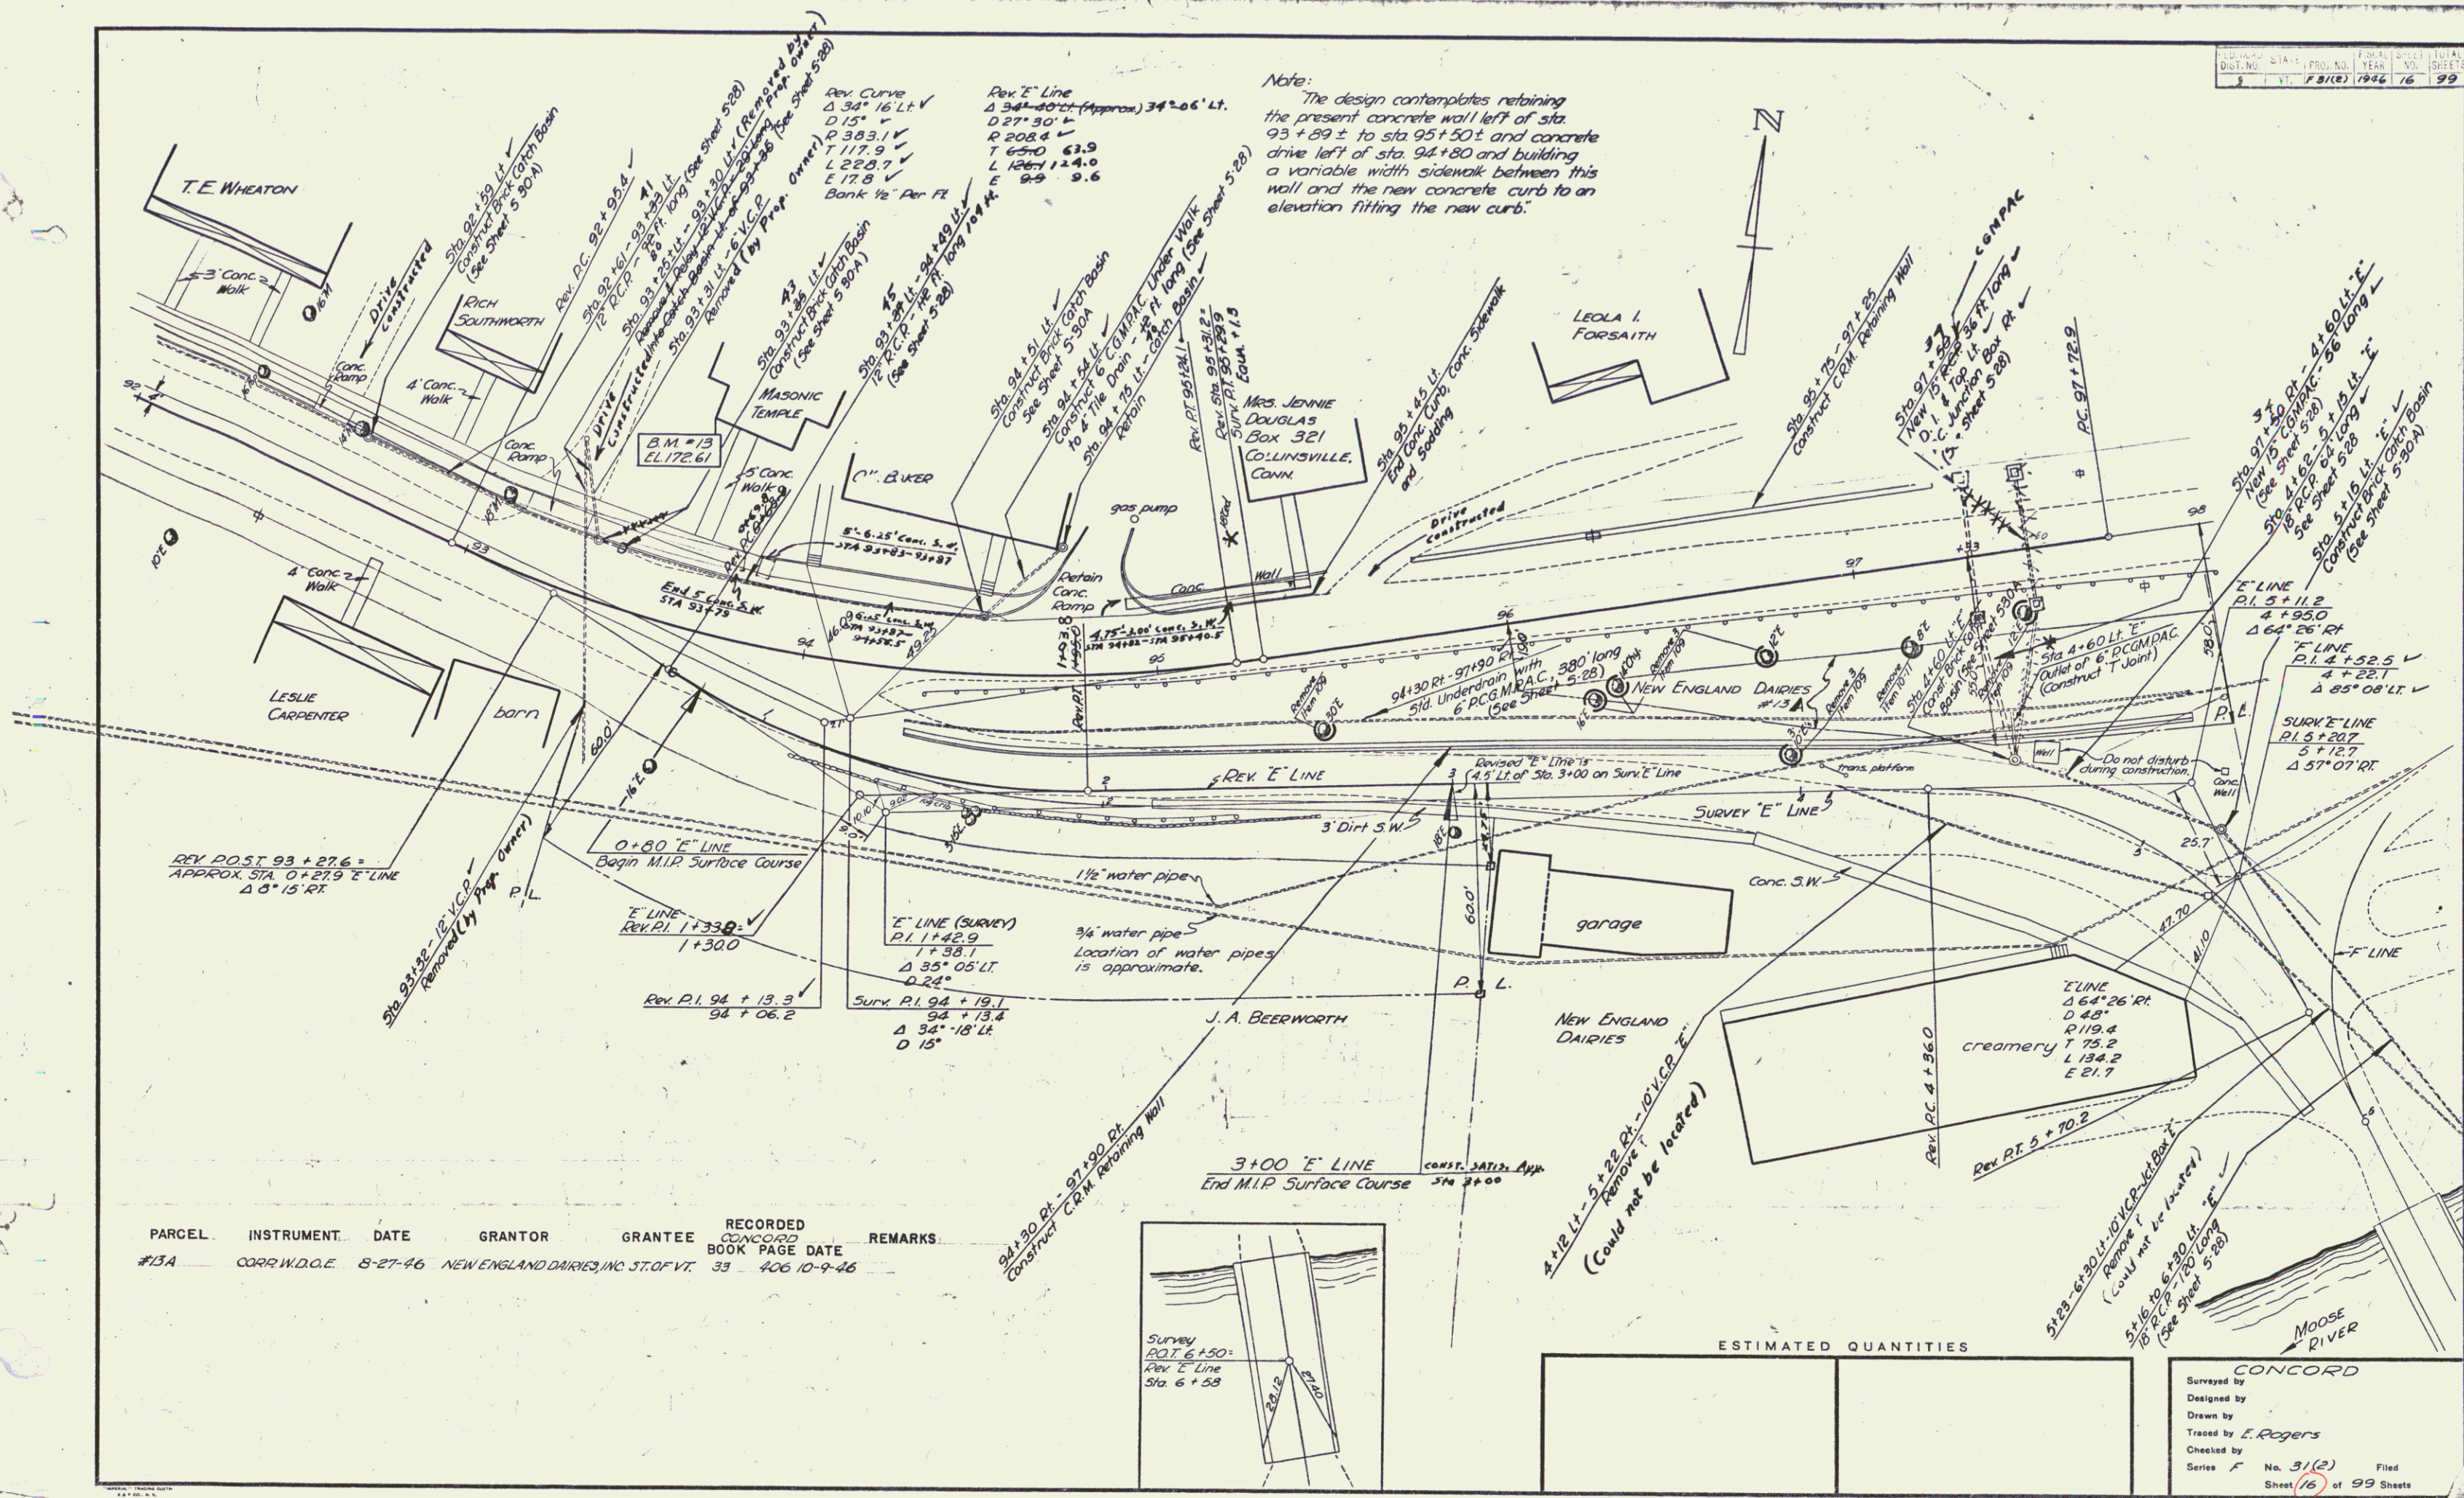

POOR ORIGINAL COPY


ED. QUAD	STA. NO.	FR.	TO.	TOTAL
18	1246	18	99	

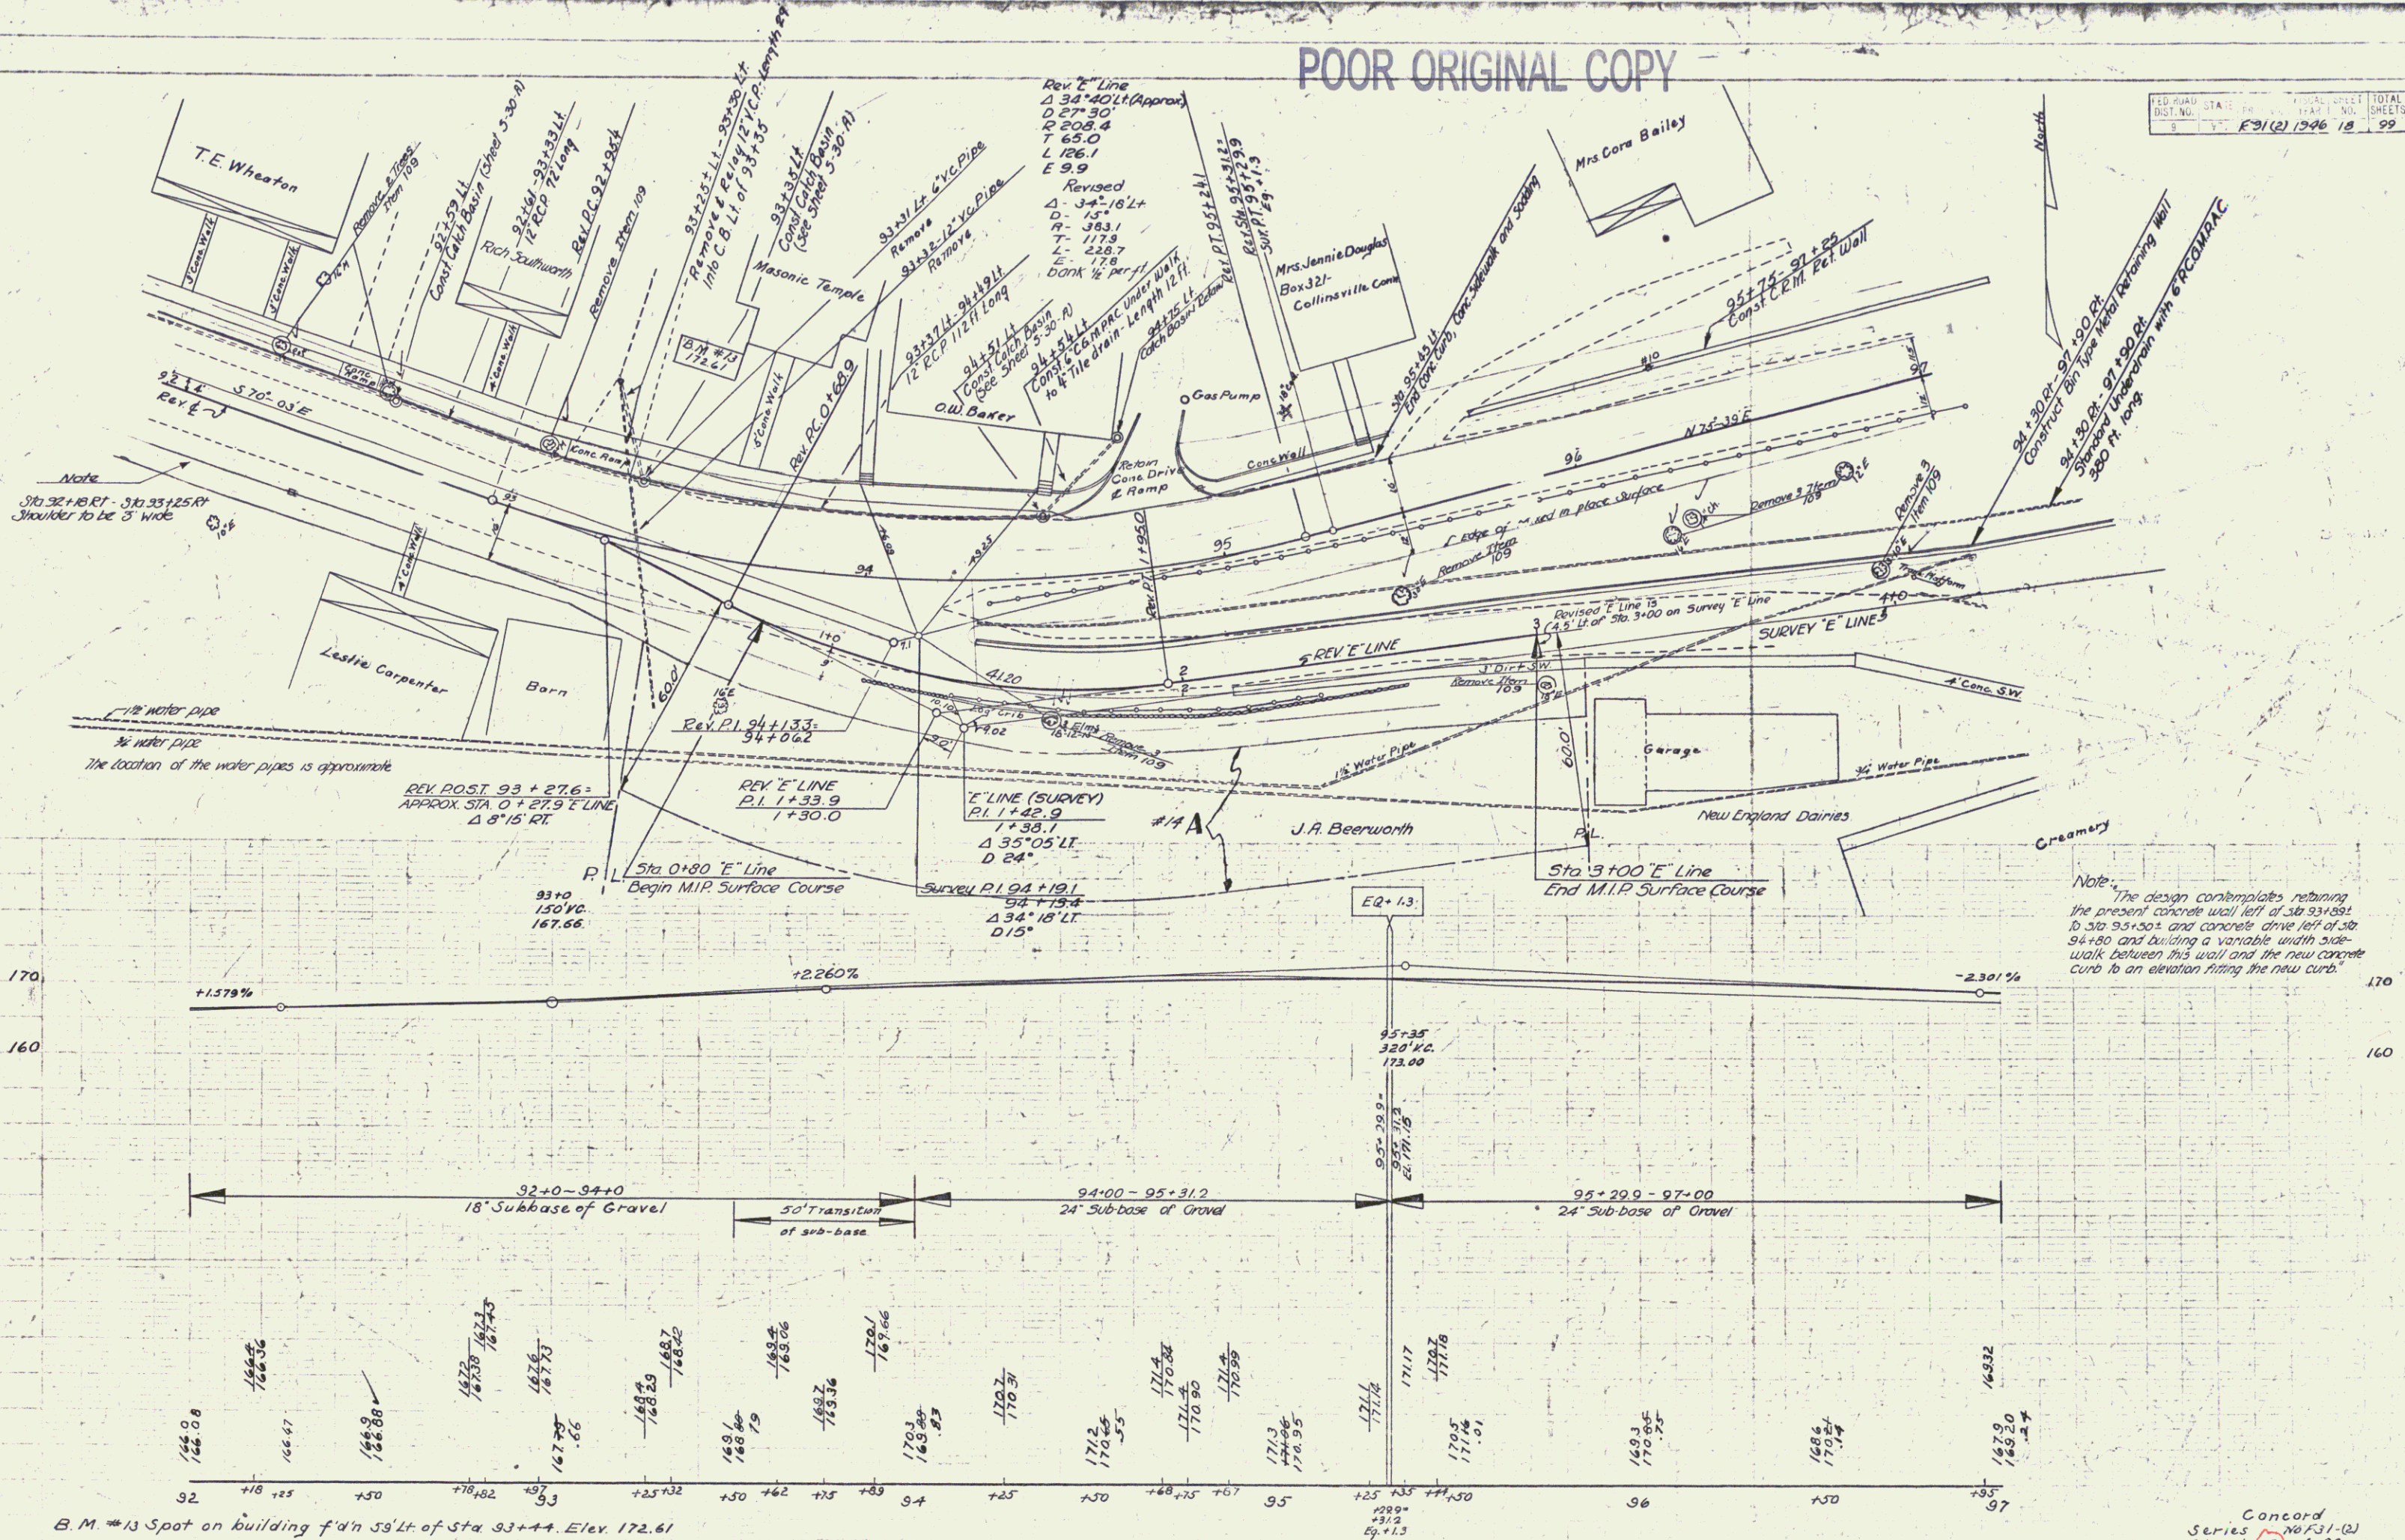

Concord Series No. F31-12 Sheet 18 of 99


PARCEL	INSTRUMENT	DATE	GRANTOR	GRANTEE	BOOK	PAGE	CONCORD	DATE	REMARKS
#14 A B SEE S-18	W.D.O.E.	5-22-46	J.A. BEERWORTH	ST. OF VT.	33	245-246	6-22-46		
#15 A	****	5-20-46	LEOLA I. FORSAITH	****	33	246	6-22-46		

POOR ORIGINAL COPY

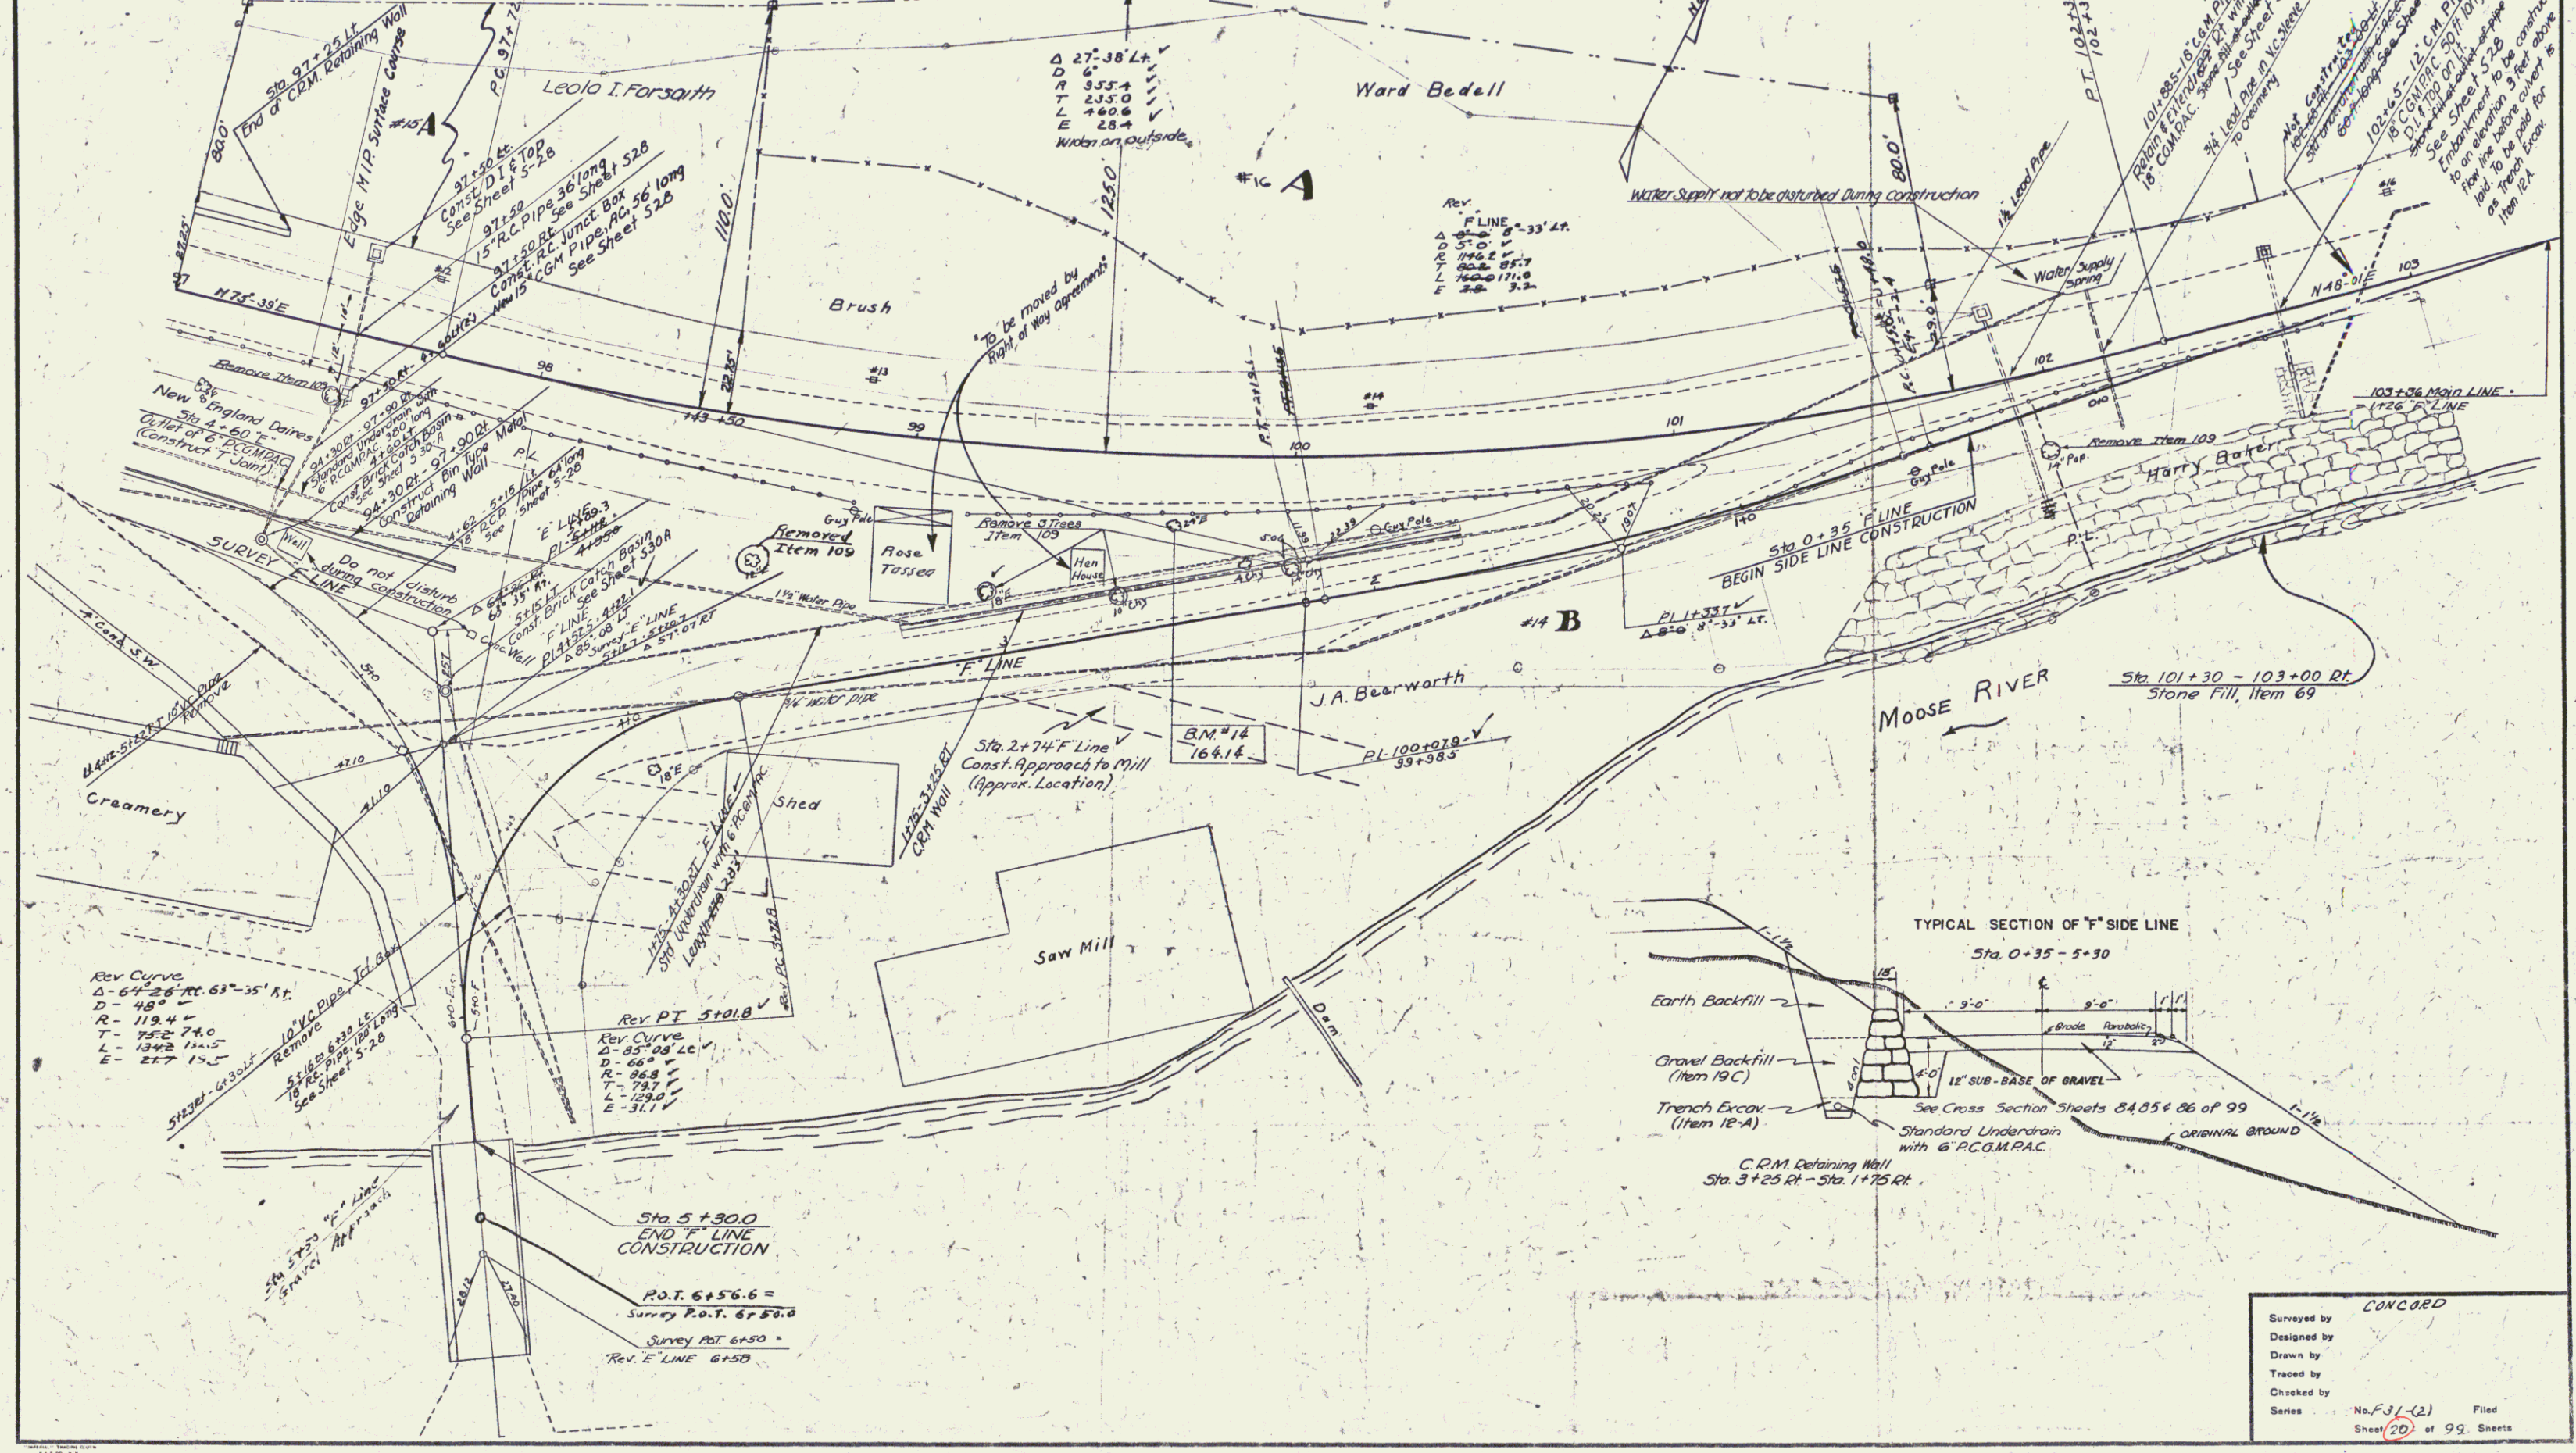


CONCORD	
Surveyed by	
Designed by	
Drawn by	
Traced by	
Checked by	
Series	No. F-31-2
Sheet	20 of 99 Sheets

POOR ORIGINAL COPY

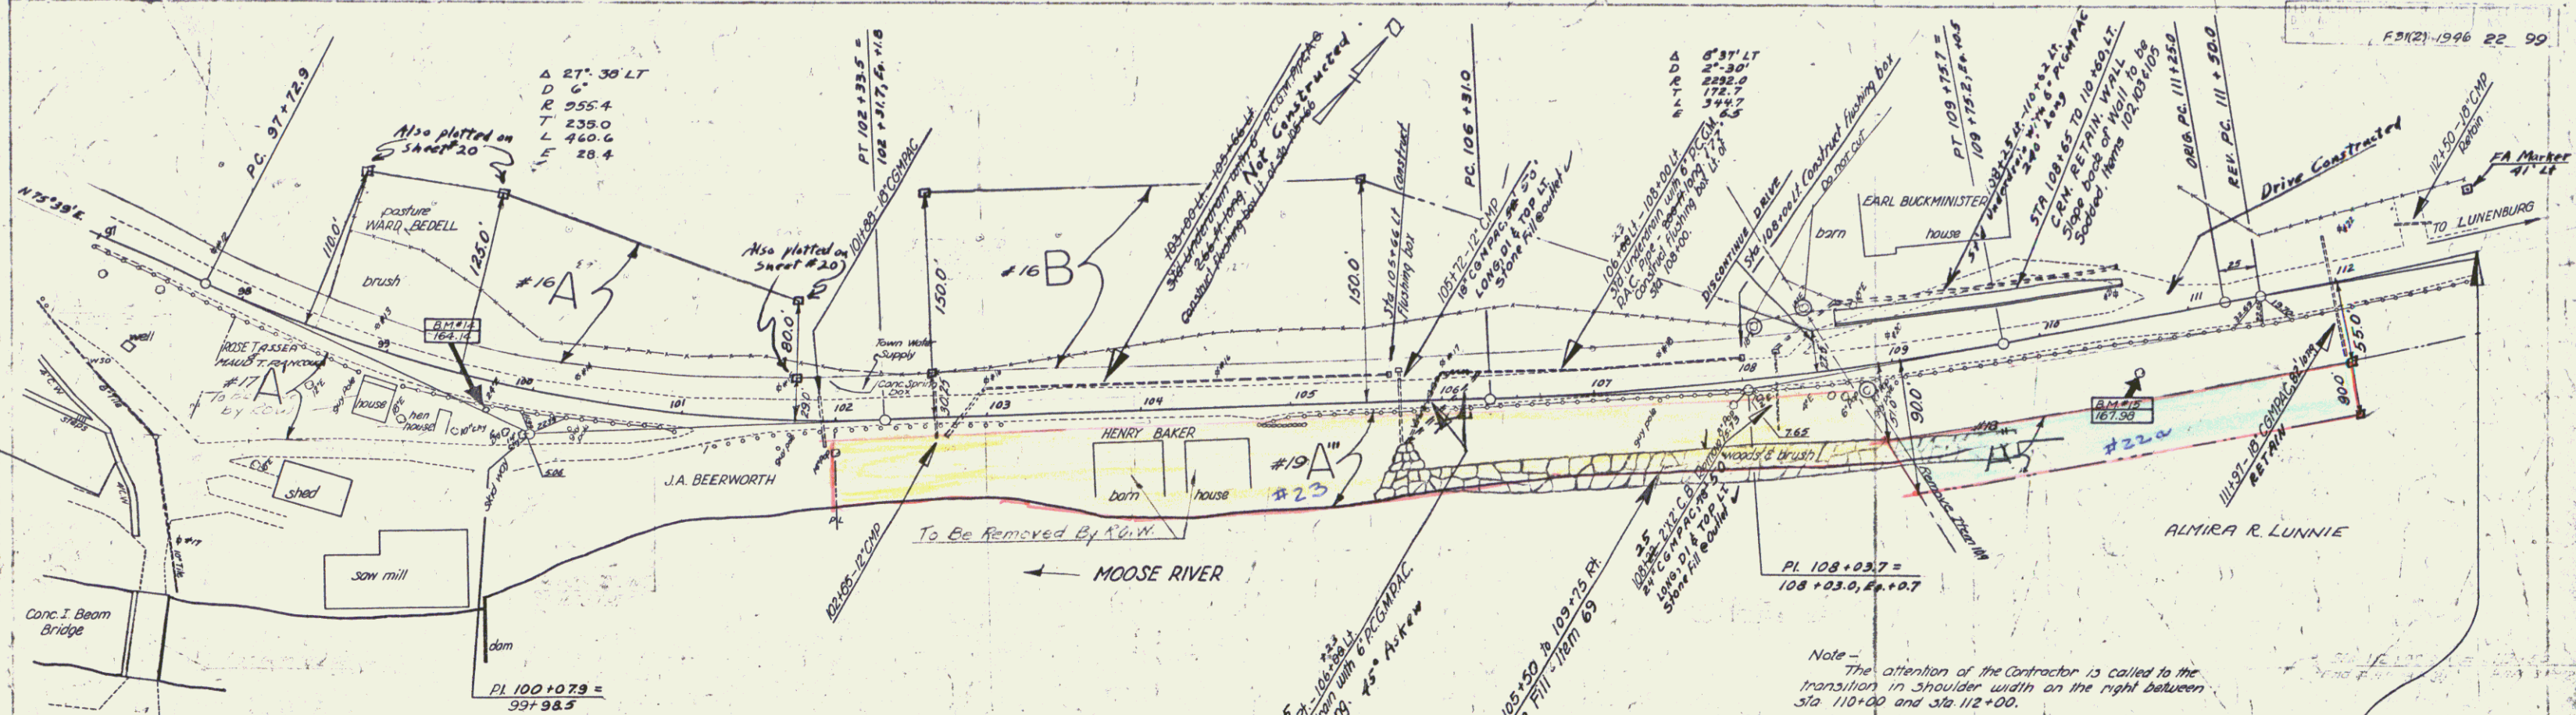


PARCEL	INSTRUMENT	DATE	GRANTOR	GRANTEE	RECORDED	REMARKS
#16 A,B	W.D.O.E.	8-1-45	WARD BEDELL	ST. OF VT.	BOOK 33 PAGE 233 DATE 10-25-45	
#17 A	W.D.	8-1-45	ROSE TASSEA & MAUD T. RANCOUR	ST. OF VT.	BOOK 33 PAGE 85 DATE 11-30-45	
#18 A	W.D.O.E.	9-11-45	ALMIRA R. LUNNIE	ST. OF VT.	BOOK 33 PAGE 235 DATE 10-25-45	#22 a
#19 A	W.D.	8-28-45	HENRY & ALICE BAKER	ST. OF VT.	BOOK 33 PAGE 234 DATE 10-25-45	#23

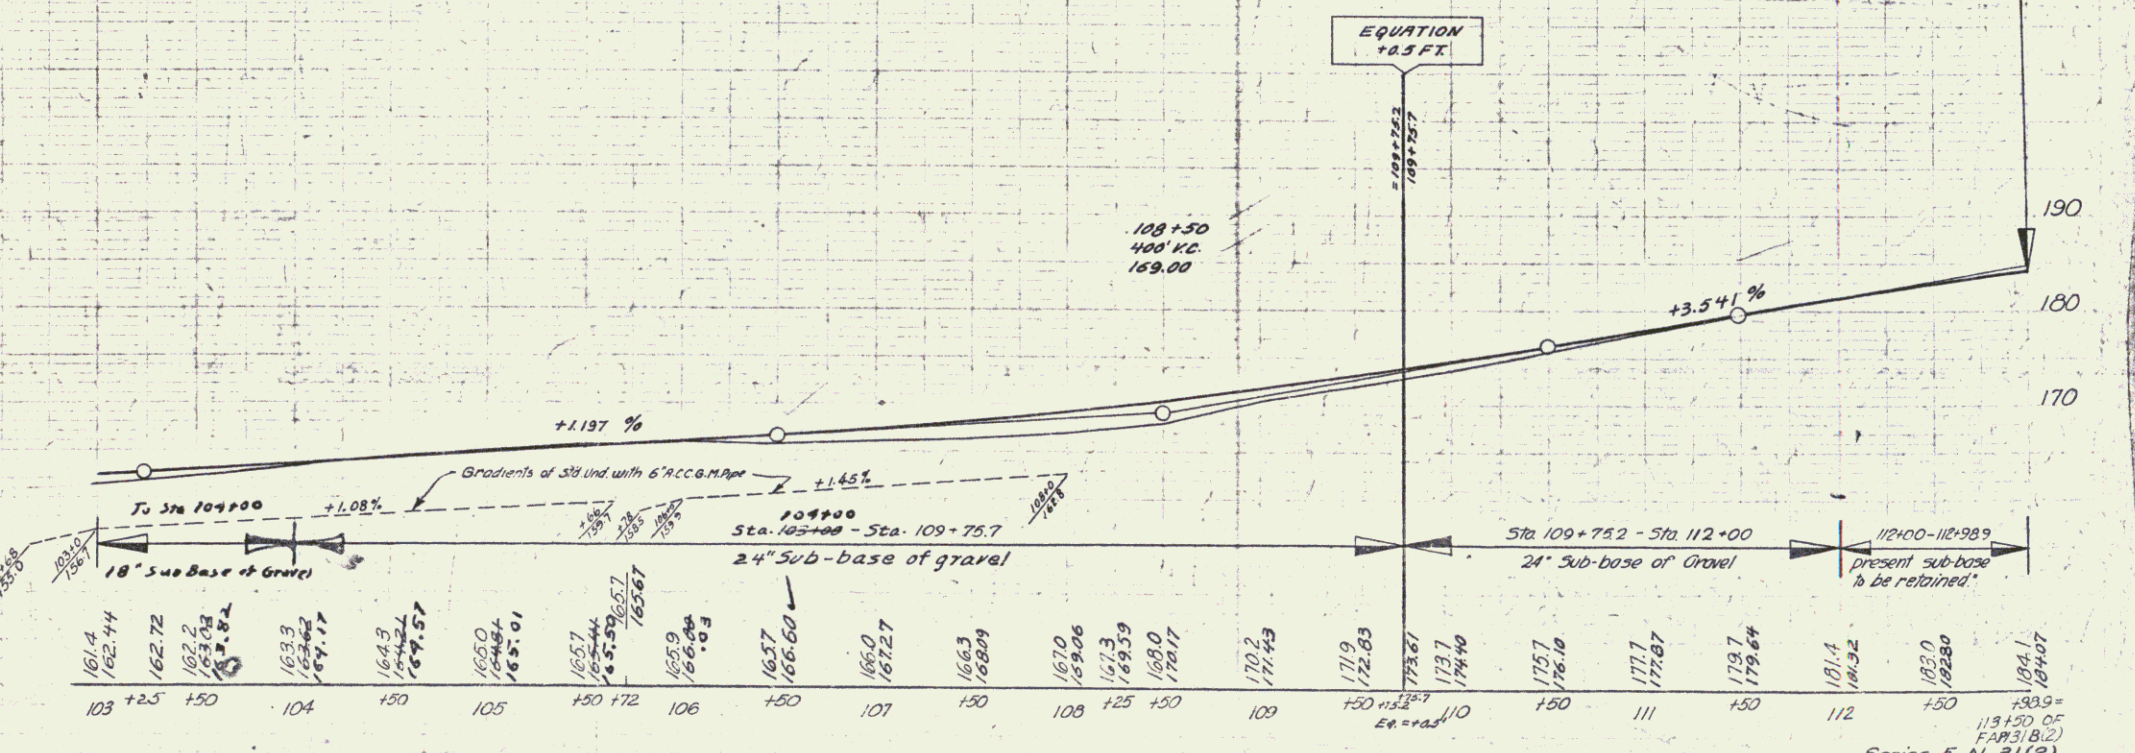

B.M. #14 S.I.R. 24" Elm 23' RI Sta 99+70. elev. 164.14 B.M. #15 S.I.R. 12" Elm 34' RI Sta 110+62. elev. 167.90

Series N 31(2) Sheet 22 OF 99 Sheets

$\Delta-11^{\circ}00'4t$
 $D-1^{\circ}45'$
 $R-3274.2$
 $T-315.3$
 $L-628.6$
 $E-132$

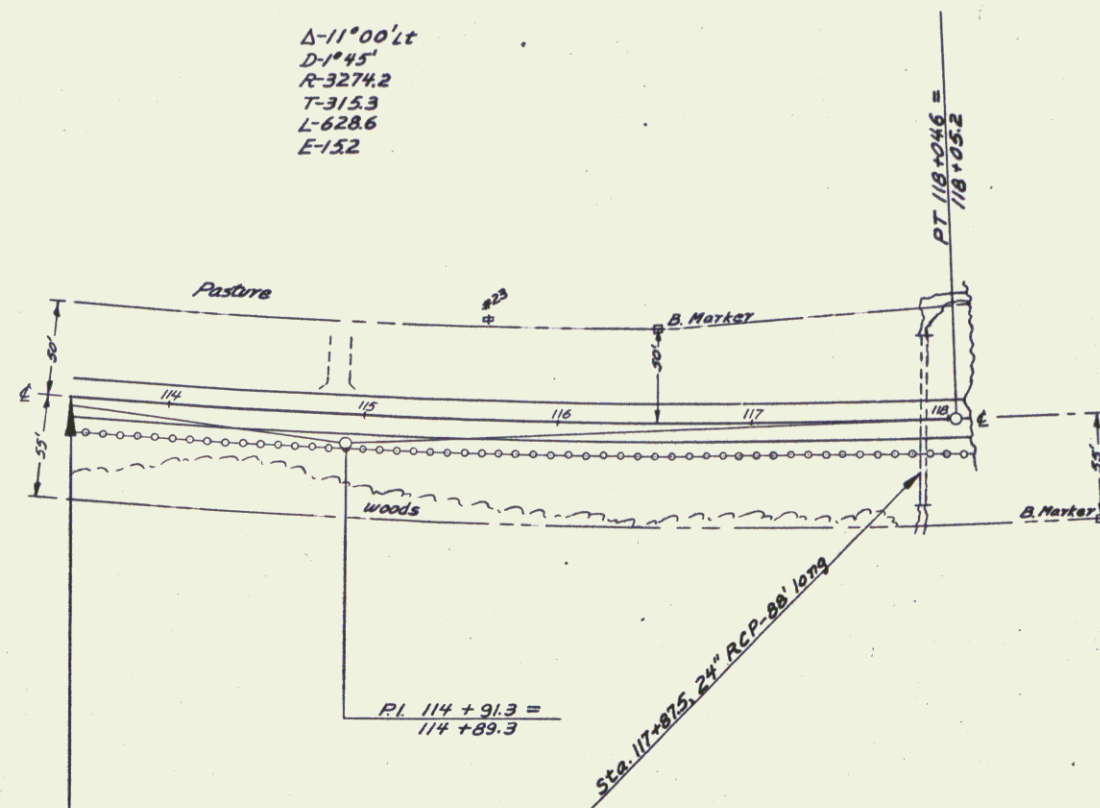

Sta. 112+98.9 = Sta. 113+50
 End F. 31(2) FAP 131-B(2)

