

INDEX OF SHEETS	
SHEET NO. 1	TITLE PAGE
" 2-4	TYPICAL CROSS-SECTION OF IMPROVEMENT {2 1/2" CRUSHED GRAVEL MIXED IN PLACE SURFACE COURSE WITH REFINED TAR ITEMS 25 & 30
" 5	BANKING AND WIDENING TABLES
" 6-14	PLAN AND PROFILE
" 15	PIPE CULVERTS S-28
" 16	GUARD RAIL S-30
" 17	STANDARD UNDERDRAIN S-30A
" 18	BARRICADES, SIGNS, LIGHTS (ROAD) S-40
" 19	TYPICAL GRADING CROSS SECTIONS S-41
" 20	BARRICADES, SIGNS, LIGHTS (BRIDGE) S-41
" 21-22	CULVERT DETAILS
" 23-61	CROSS SECTIONS

STANDARD STRUCTURE SHEETS APPROVED
BY THE CHIEF ENGINEER

S-28 4-26-41
S-30 5-12-41
S-30A 4-19-41
S-40 9-5-40

STATE OF VERMONT STATE HIGHWAY DEPARTMENT

PLAN AND PROFILE OF PROPOSED STATE HIGHWAY

FEDERAL AID PROJECT


TOWN OF CONCORD

ROUTE U.S. 2


BEGINNING AT THE EASTERN END OF FEDERAL AID
PROJECT 31 (1923) AND EXTENDING NORTHEASTERLY
1.643 MILES TO THE SOUTHERN END OF CONCRETE
T BEAM BRIDGE OVER THE MOOSE RIVER
LENGTH OF PROJECT 8679.8 FEET=1.643 MILES

Project No SNFAP 131B(2)

FED. ROAD DIST. NO.	STATE	FED. AID PROJ. NO.	FISCAL YEAR	SHEET NO.	TOTAL SHEETS
9	Vt.	131 B(2)	1942	1	61

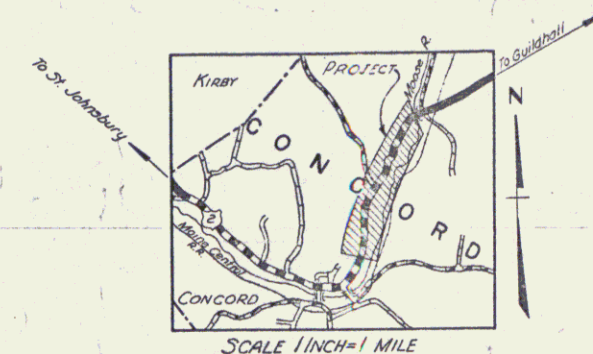

RECORD PLANS
By: W.H. Chase

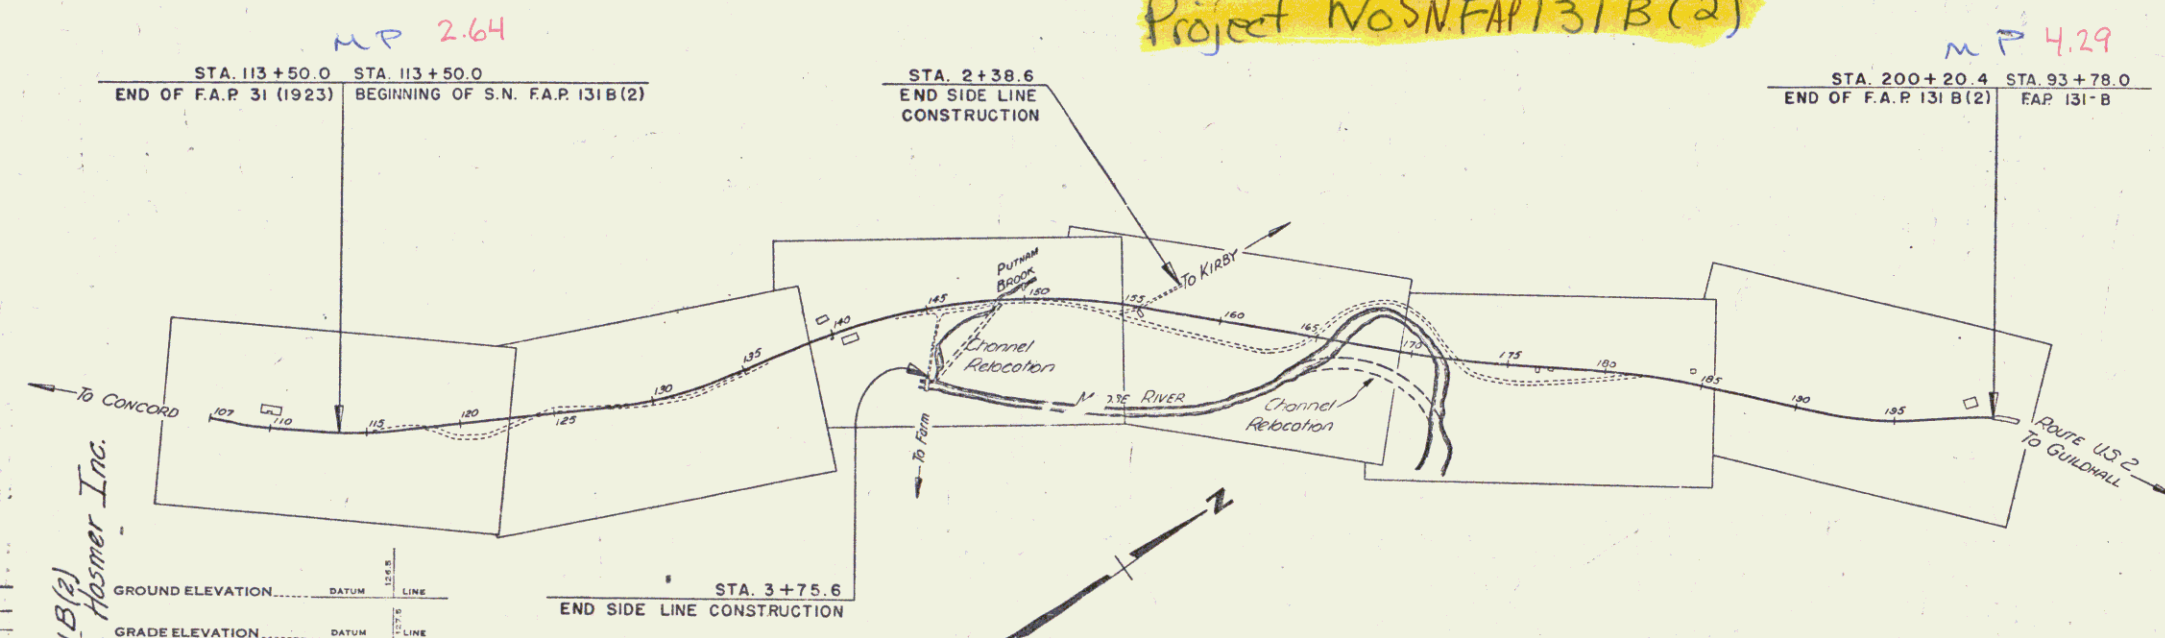

RIGHT-OF-WAY DIVISION
TOWN FILE

PERPETUAL
Rte of US 2
Town of Concord
(To Be Returned To R.O.W. Division)

APPROVED: May 26, 1941
H. J. Laugel
COMMISSIONER OF HIGHWAYS
SUBMITTED BY ORDER OF THE STATE HIGHWAY BOARD

COUNTY LINE	
TOWN LINE	
FENCE LINE	
STONE WALL	
UNFENCED PROPERTY	
GUARD RAIL	
TRAVELED WAY	
RAILROAD	
RETAINING WALL	
CENTER LINE	
SURVEY LINE	
CULVERT	
DROP INLET	
TROLLEY POLE	
POWER POLE	
TELEPHONE POLE	
TREES	
HEDGE	

CURVE DATA	
DEFLECTION ANGLE	Δ
DEGREE OF CURVE	D
RADIUS OF CURVE	R
TANGENT DISTANCE	T
LENGTH OF CURVE	L
EXTERNAL DISTANCE	E
POINT OF INTERSECTION	P. I.
POINT OF CURVE	P. C.
POINT OF TANGENT	P. T.
POINT ON TANGENT	P. O. T.

SCALES	
TITLE	1"=500'
TYPICAL	1"=2'
PLAN	1"=50'
PROFILE HORIZONTAL	1"=50'
PROFILE VERTICAL	1"=10'
CROSS SECTIONS	1"=5'

THESE PLANS ARE SUBJECT TO SUCH REVISIONS AS MAY BE
REQUIRED BY THE PUBLIC ROADS ADMINISTRATION OR THE COM-
MISSIONER OF HIGHWAYS.
CONSTRUCTION IS TO BE CARRIED ON IN ACCORDANCE WITH
THE PLANS AND THE STANDARD ROAD AND BRIDGE SPECIFICATIONS
OF 1936, AS APPROVED DECEMBER 29TH, 1936 BY THE PUBLIC
ROADS ADMINISTRATION, INCLUDING ALL SUBSEQUENT APPROVED
REVISIONS AND SUCH REVISED SPECIFICATIONS AND SPECIAL
PROVISIONS AS ARE SUBMITTED WITH THE PLANS.

RECOMMENDED FOR APPROVAL	
DISTRICT ENGINEER	PUBLIC ROADS ADMINISTRATION
FEDERAL WORKS AGENCY	
APPROVED	
COMMISSIONER OF HIGHWAYS	PUBLIC ROADS ADMINISTRATION
FEDERAL WORKS AGENCY	

APPROVED: <u>May 26, 1941</u> <u>H. J. Laugel</u> ROAD ENGINEER	APPROVED: <u>May 26, 1941</u> <u>H. J. Laugel</u> DISTRICT HIGHWAY COMMISSIONER	SERIES F.A.P. NO. 131B(2) FILED SHEET <u>1</u> OF 61
---	---	---

DIST. # 7 PLANS

PARCEL	INSTRUMENT	DATE	GRANTOR	GRANTEE	RECORDED	REMARKS
A	WDOE	6-11-41	ALMIRA R. LUNNIE	ST. OF VT.	BOOK 31 PAGE 441 DATE 7-4-41	
B	WDOE	6-26-41	EARL & GERTRUDE BUCKMINSTER	ST. OF VT.	BOOK 31 PAGE 442 DATE 7-4-41	

$\Delta 11^{\circ}00' Lt$
 $D 1^{\circ}45'$
 $R 3274.2$
 $T 315.3$
 $L 628.6$
 $E 152$

EARL BUCKMINSTER


ALMIRA LUNNIE

EARL BUCKMINSTER

ALMIRA LUNNIE

STA 113+50.0
END FAP 31 (1923)


STA 113+50.0
BEGINNING S.N. FAP 131 B (2)

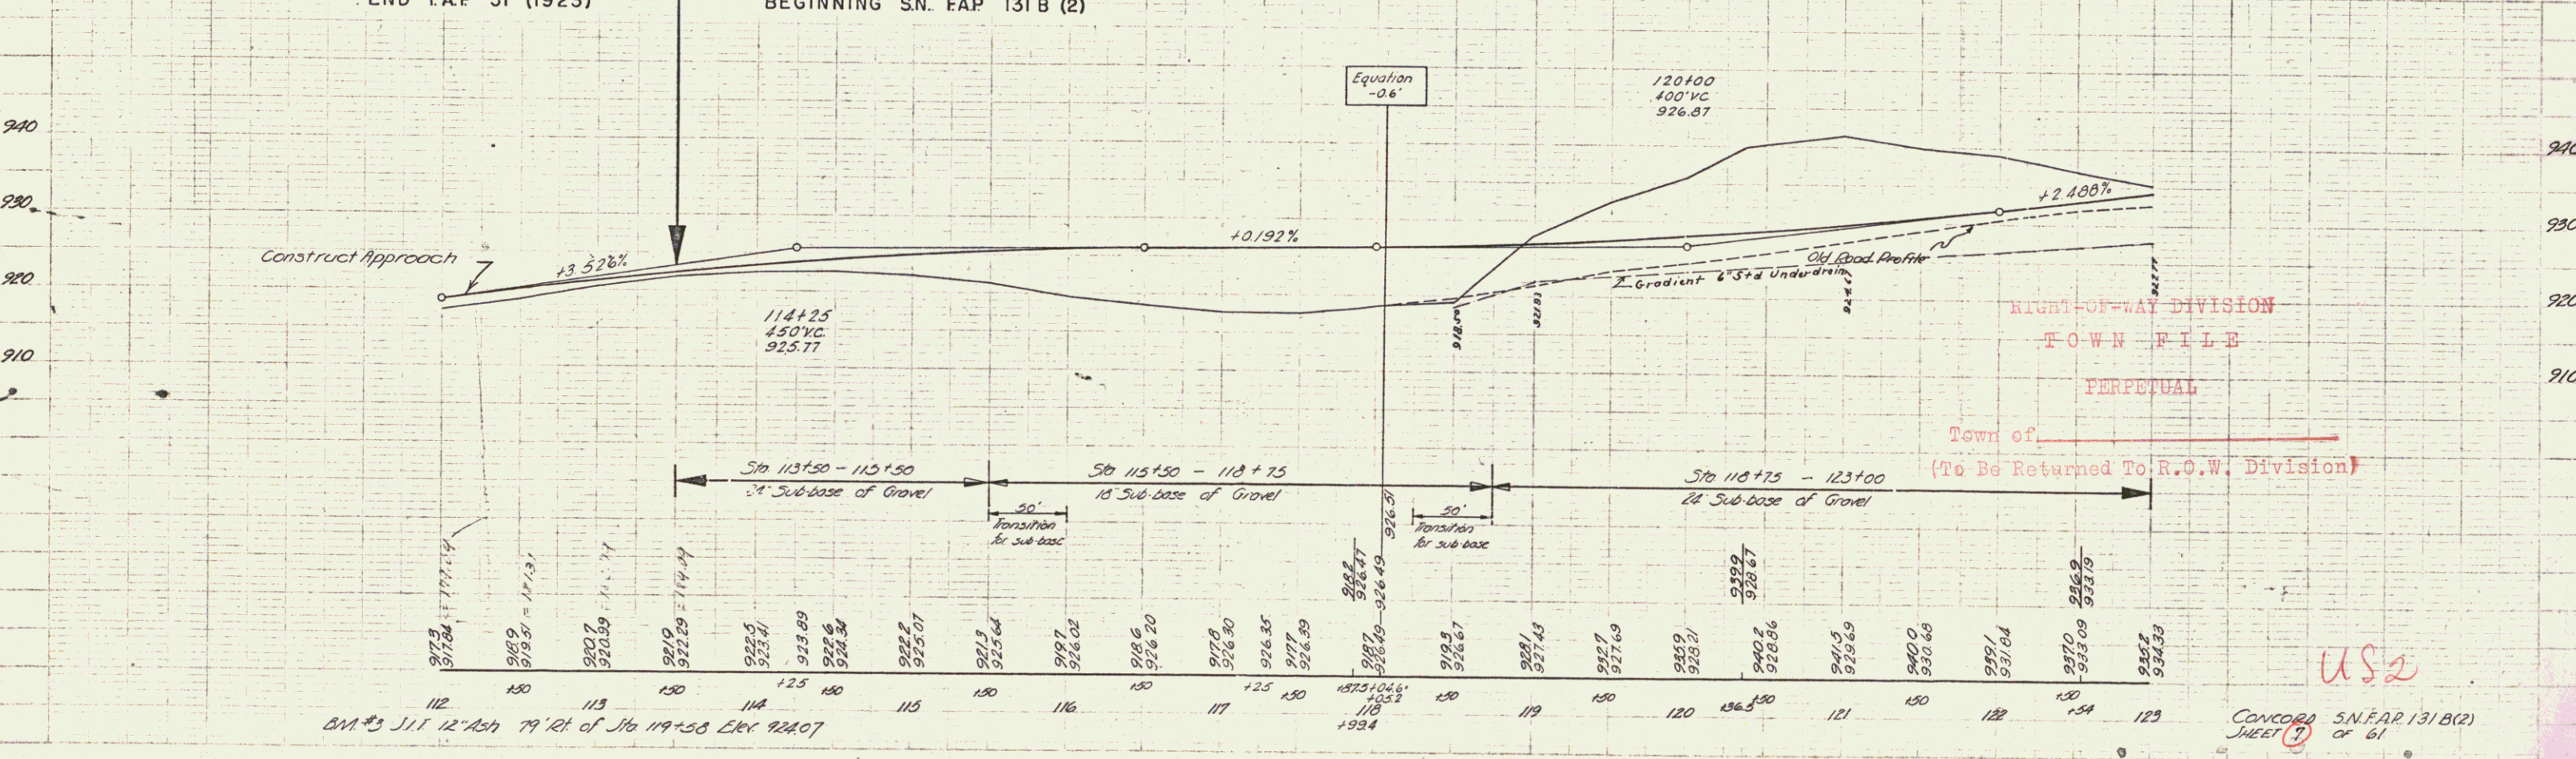


US 2

CONCORD S.N. FAP 131 B (2)
SHEET 2 of 61


FED. ROAD STATE		FED. AID FITC		STATE		DATE	
DIST. NO.		PROJ. NO.		YEAR		NO. 152678	
9 VT.		131 B(2)		1942		7 61	

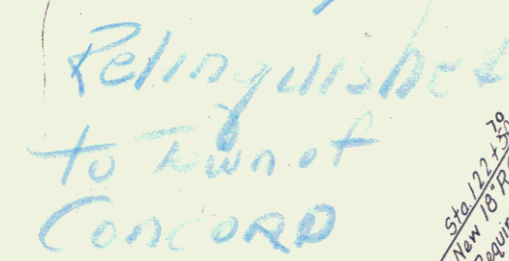


FILE NO.	STATE	FISCAL YEAR	SHEET NO.	TOTAL SHEETS
9	VT.	1942	8	61

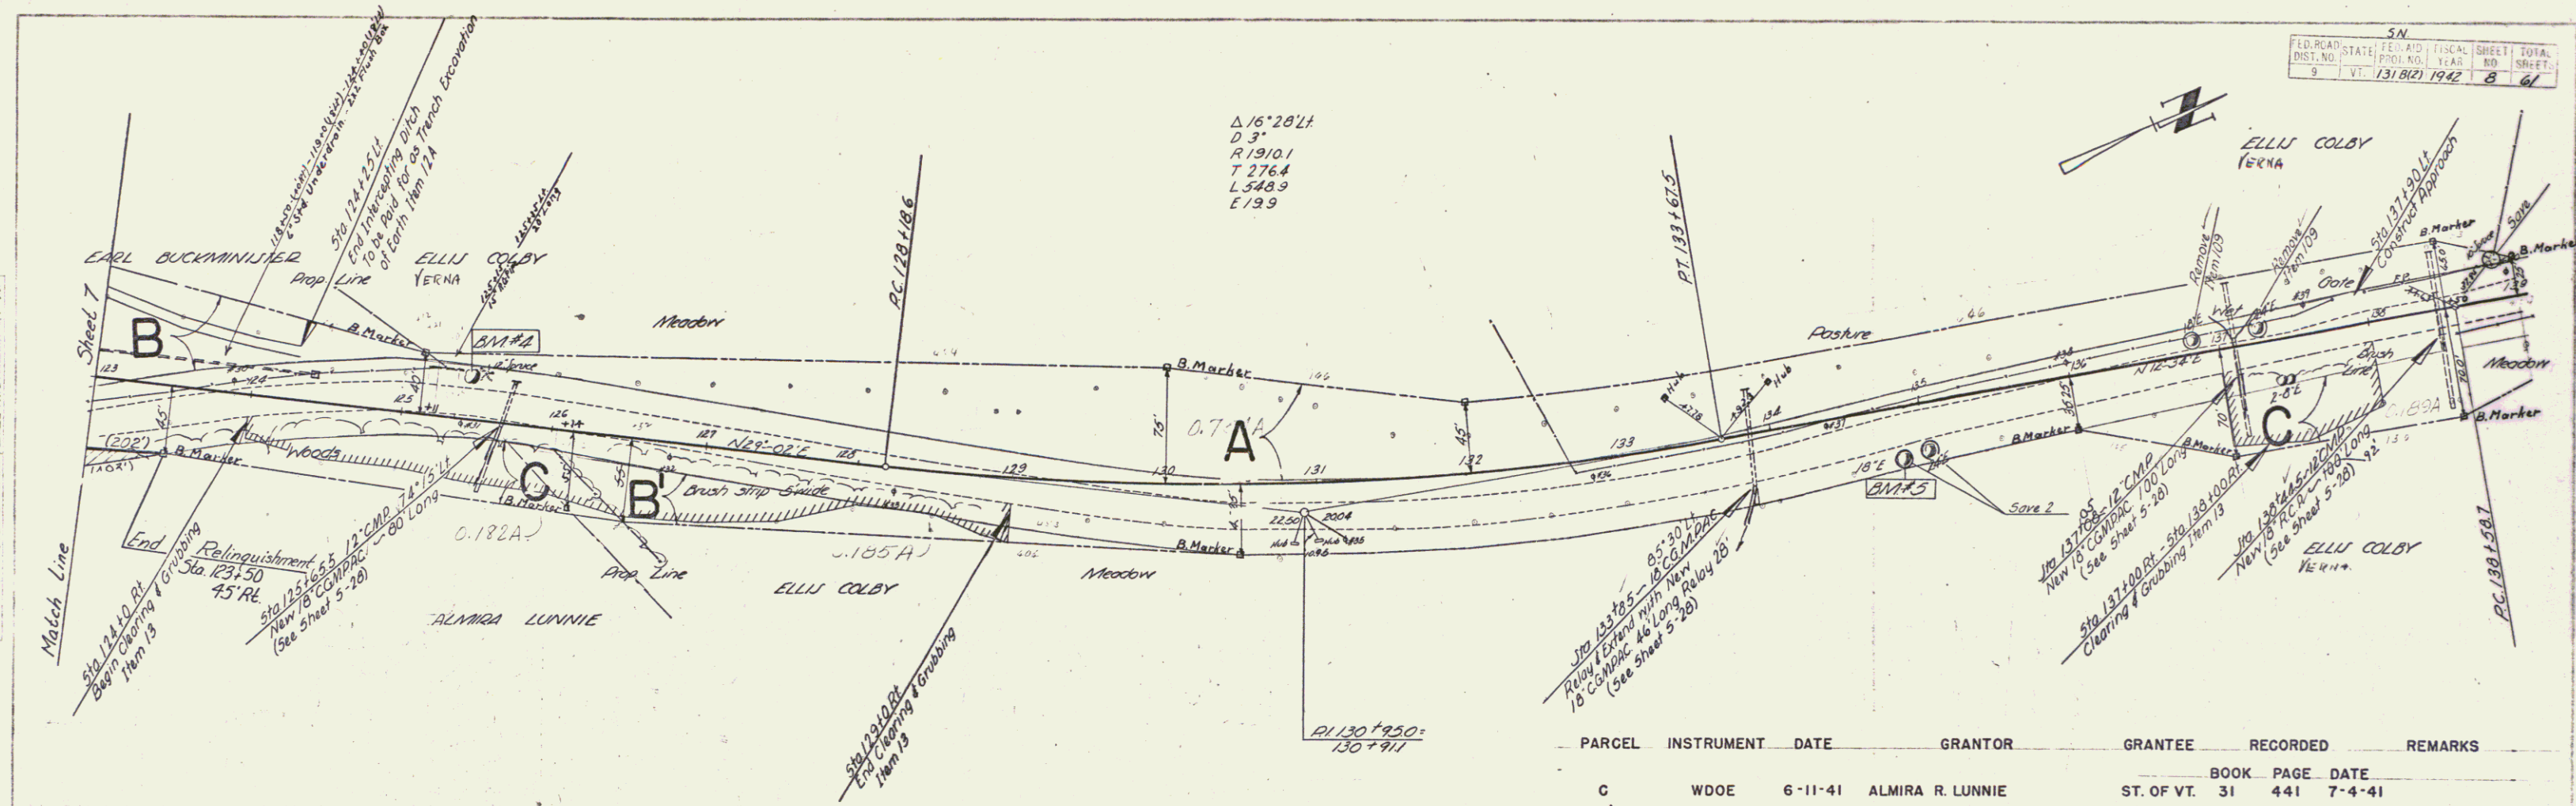


PARCEL	INSTRUMENT	DATE	GRANTOR	GRANTEE	RECORDED	REMARKS
C	WDOE	6-11-41	ALMIRA R. LUNNIE	ST. OF VT.	BOOK 31 PAGE 441	DATE 7-4-41
A'	WDOE	6-26-41	ELLIS S. & VERA COLBY	ST. OF VT.	BOOK 31 PAGE 443-4	DATE 7-4-41

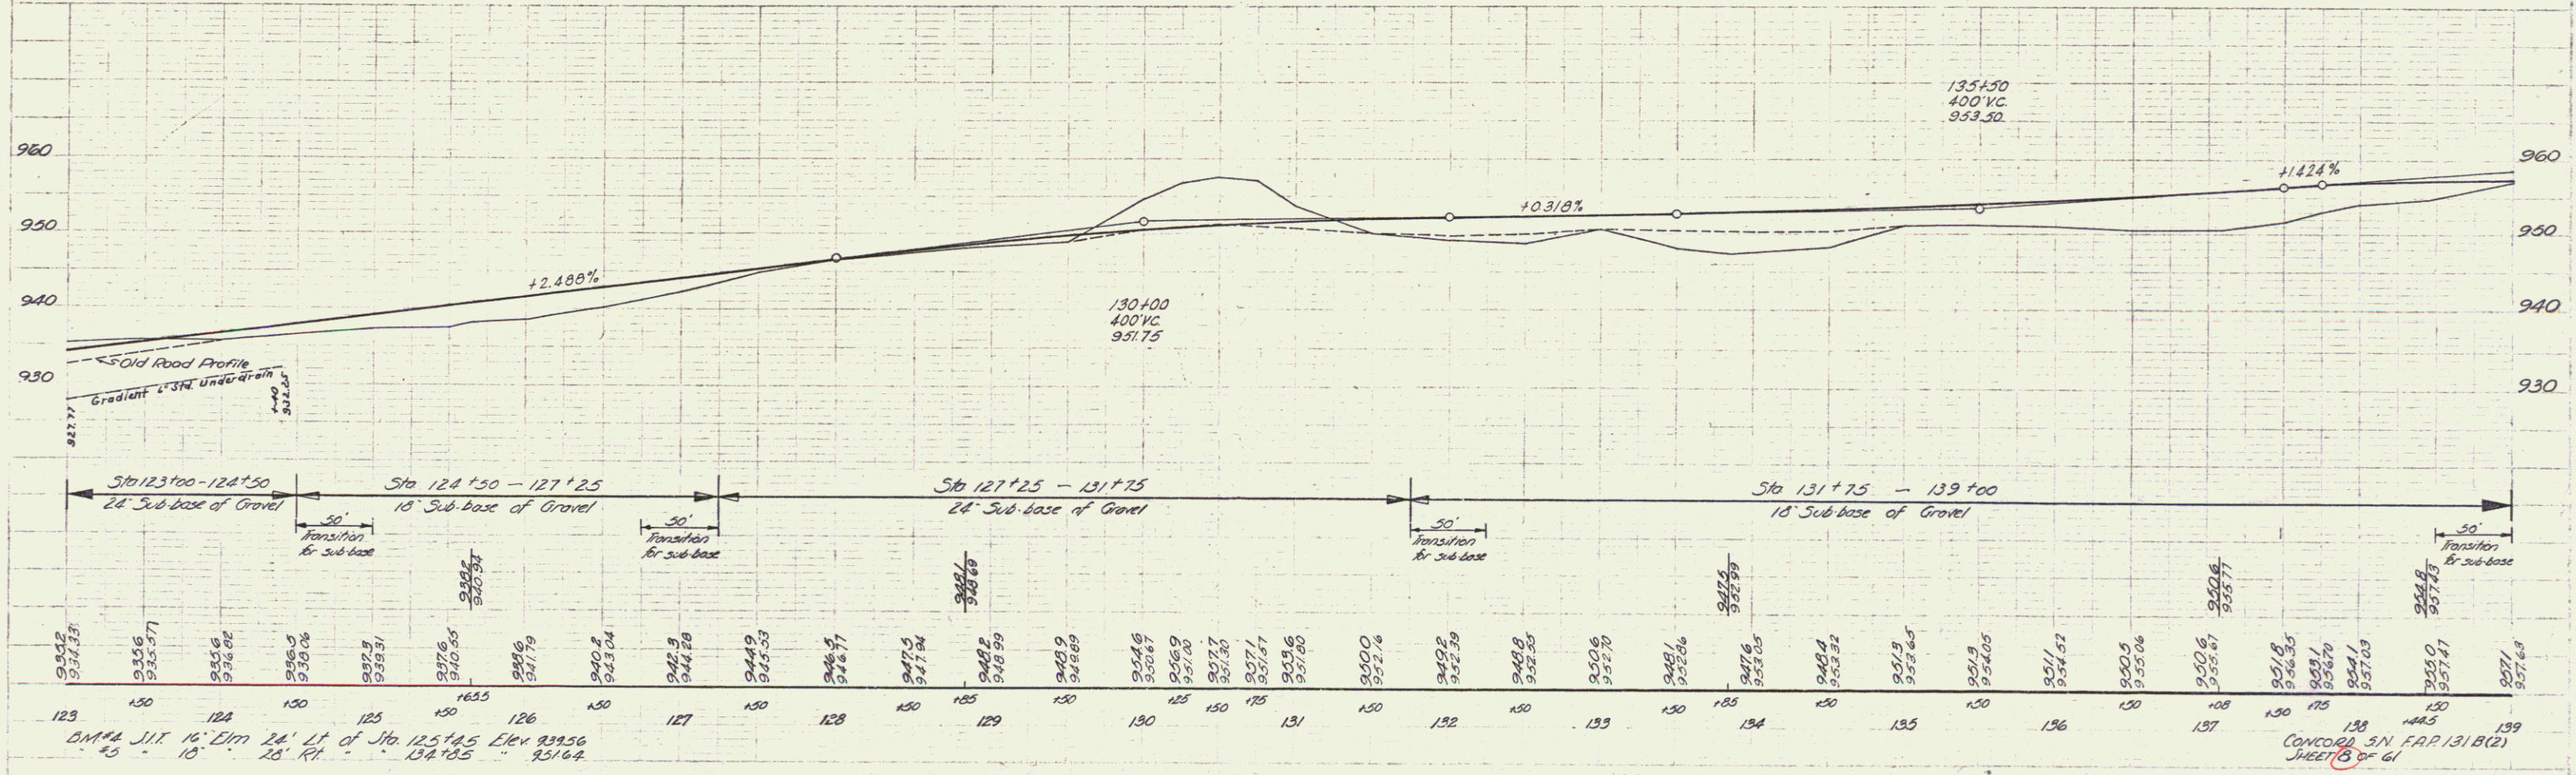



CONCORD, N.H. MAR 13/1942
SHEET 8 OF 61

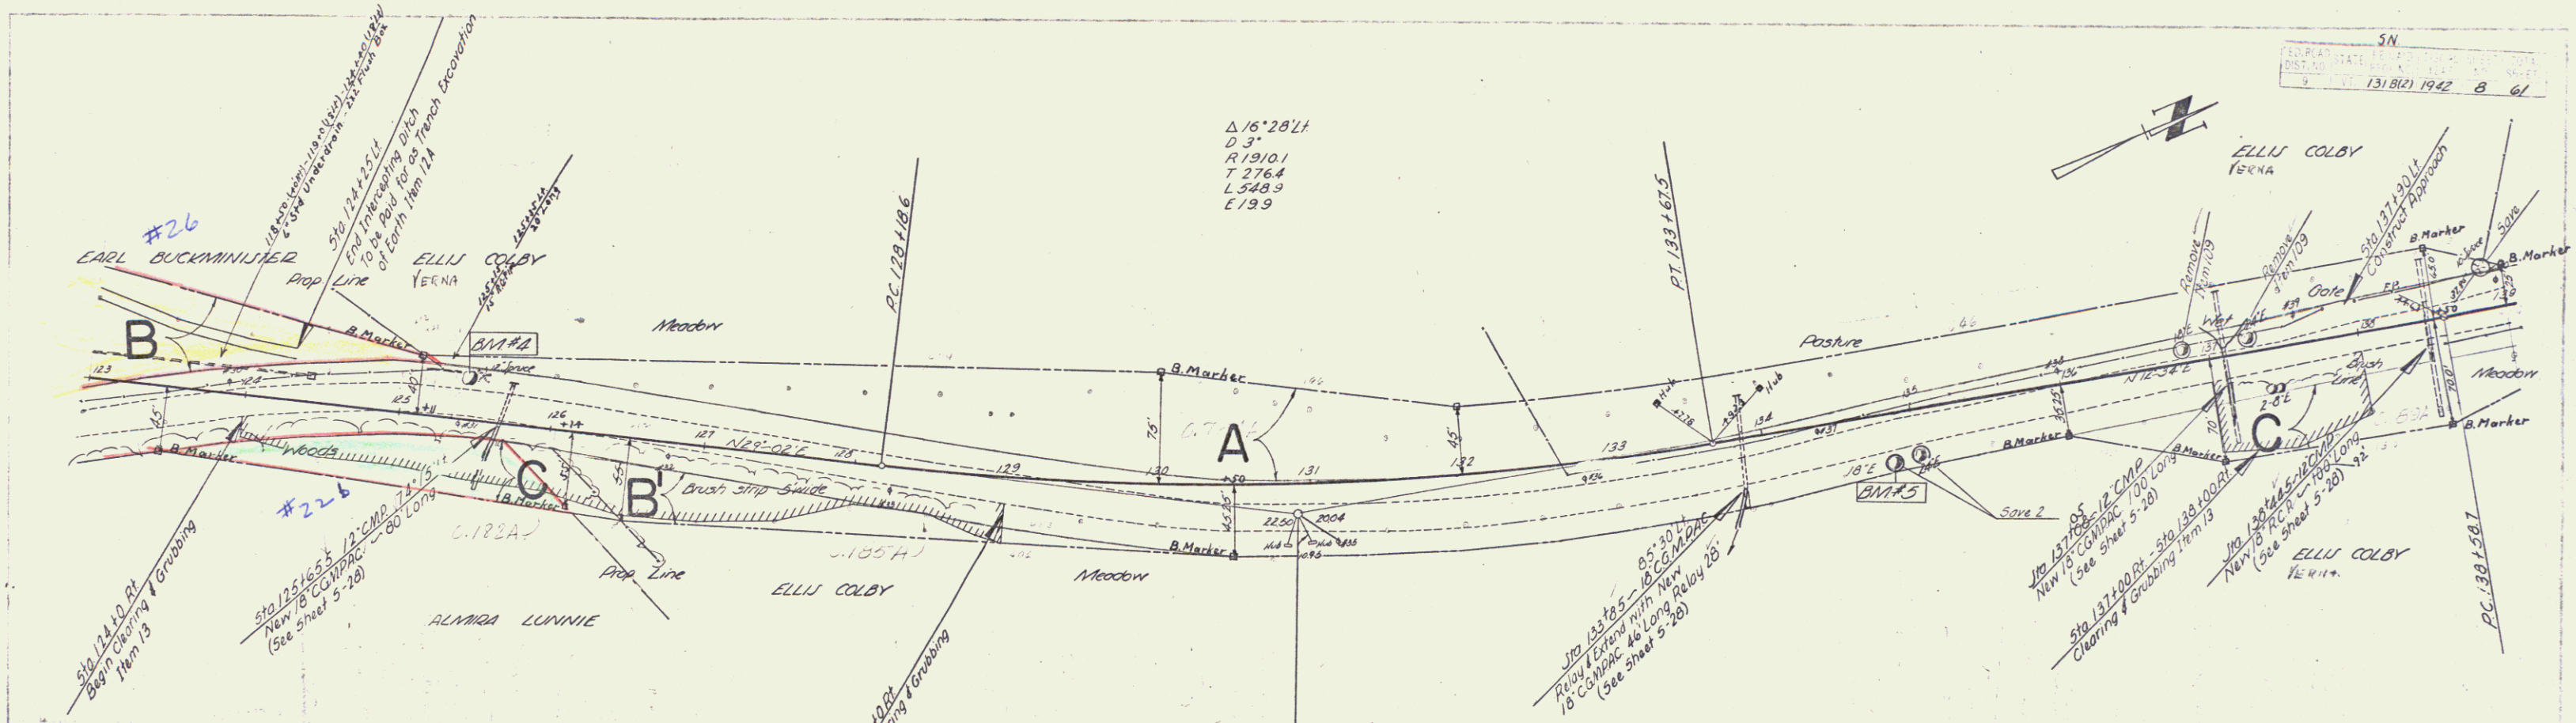


PARCEL	INSTRUMENT	DATE	GRANTOR	GRANTEE	RECORDED	REMARKS
C	WDOE	6-11-41	ALMIRA R. LUNNIE	ST. OF VT.	BOOK 31	PAGE 441
A'	WDOE	6-26-41	ELLIS S. & Verna COLBY	ST. OF VT.	BOOK 31	PAGE 443-4

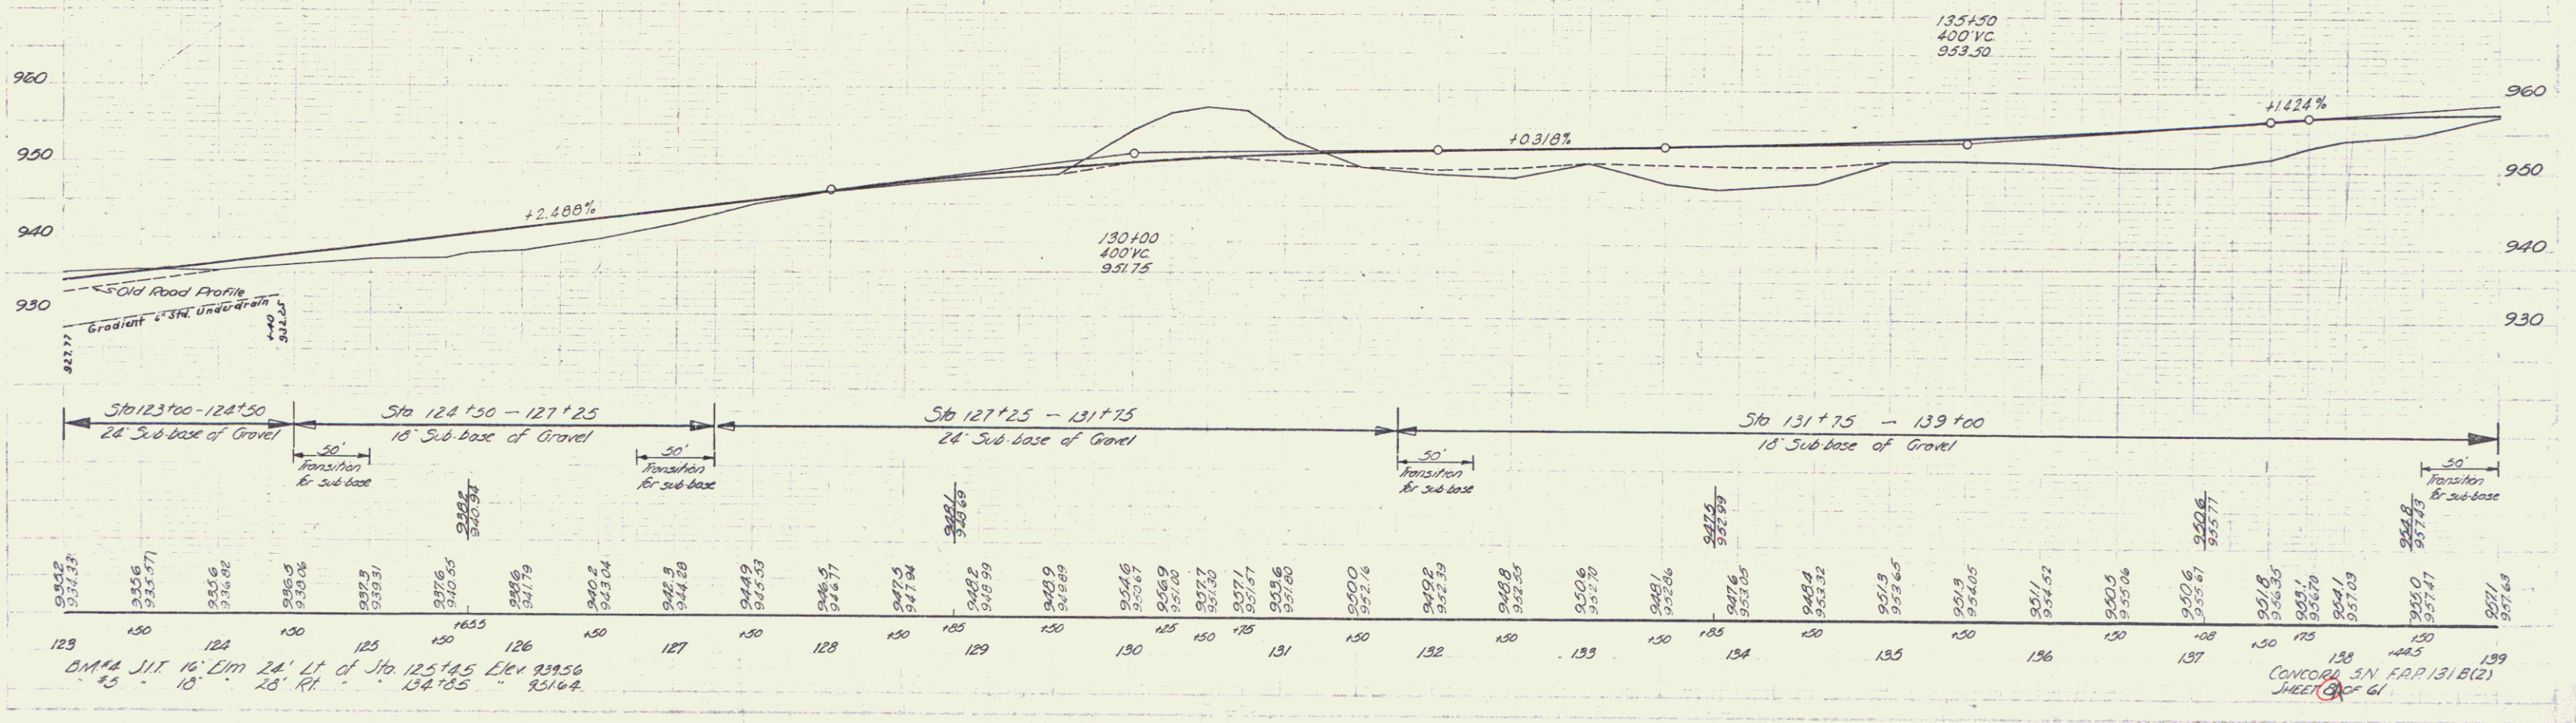


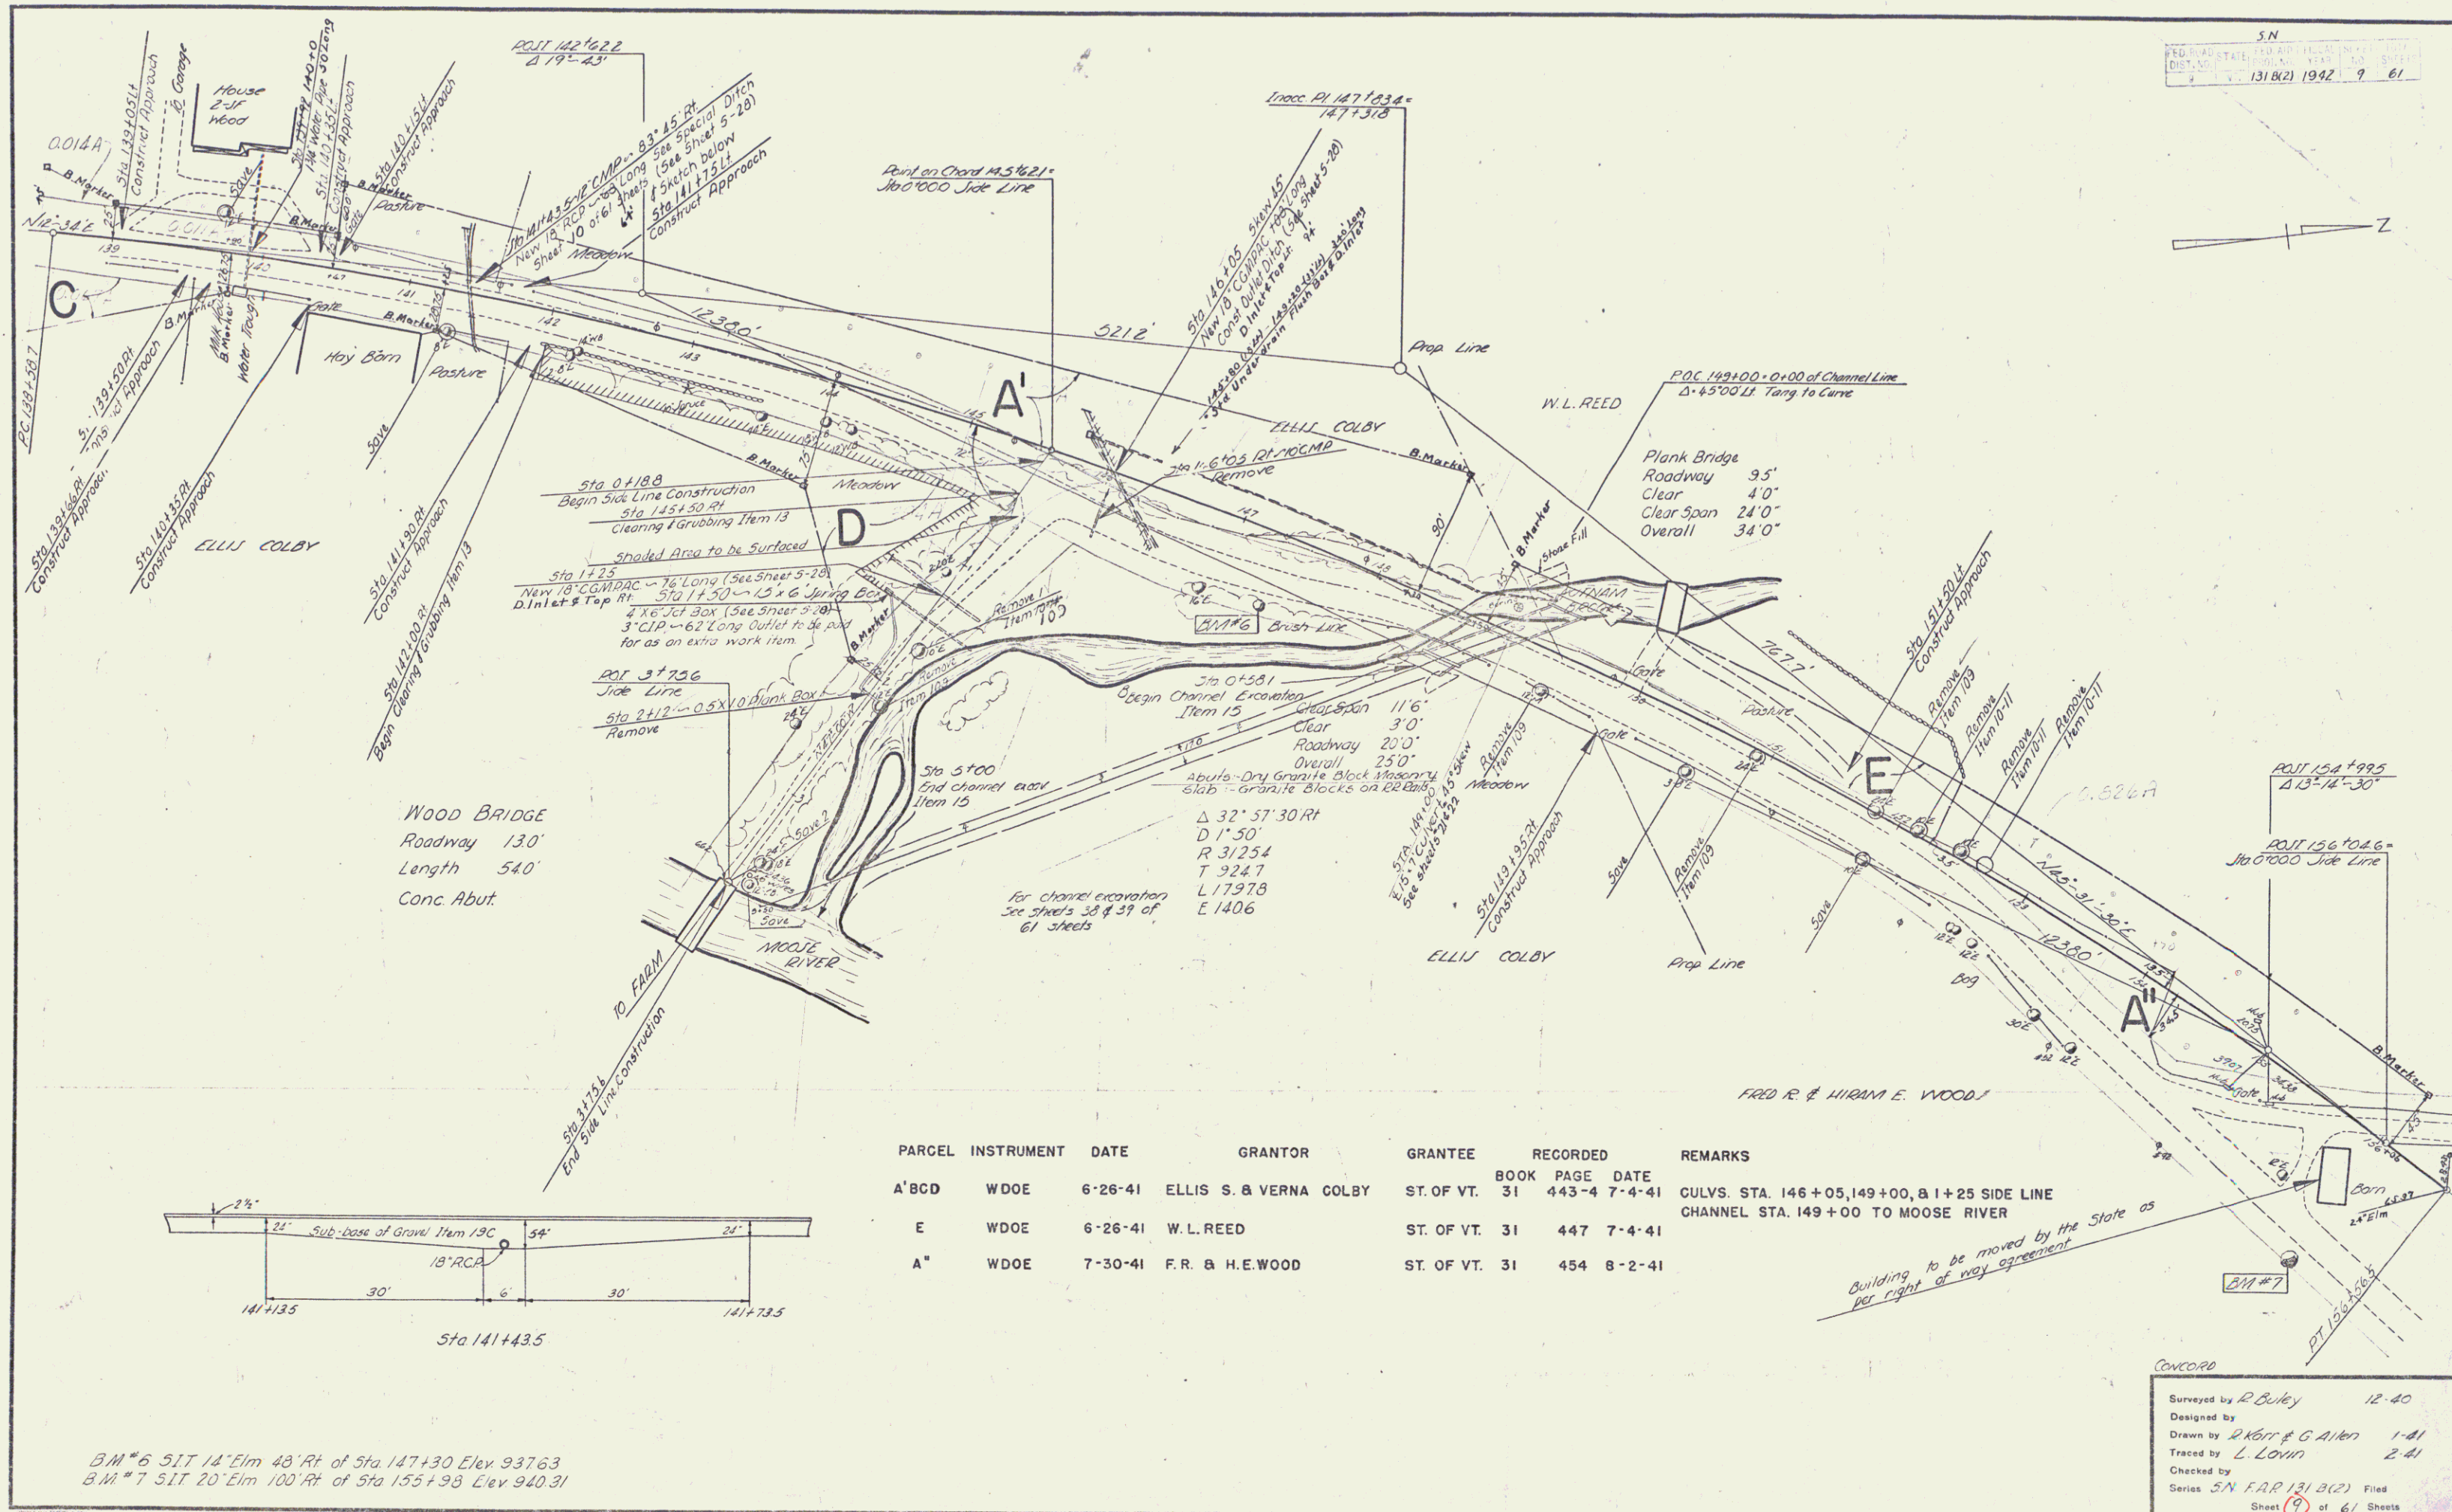

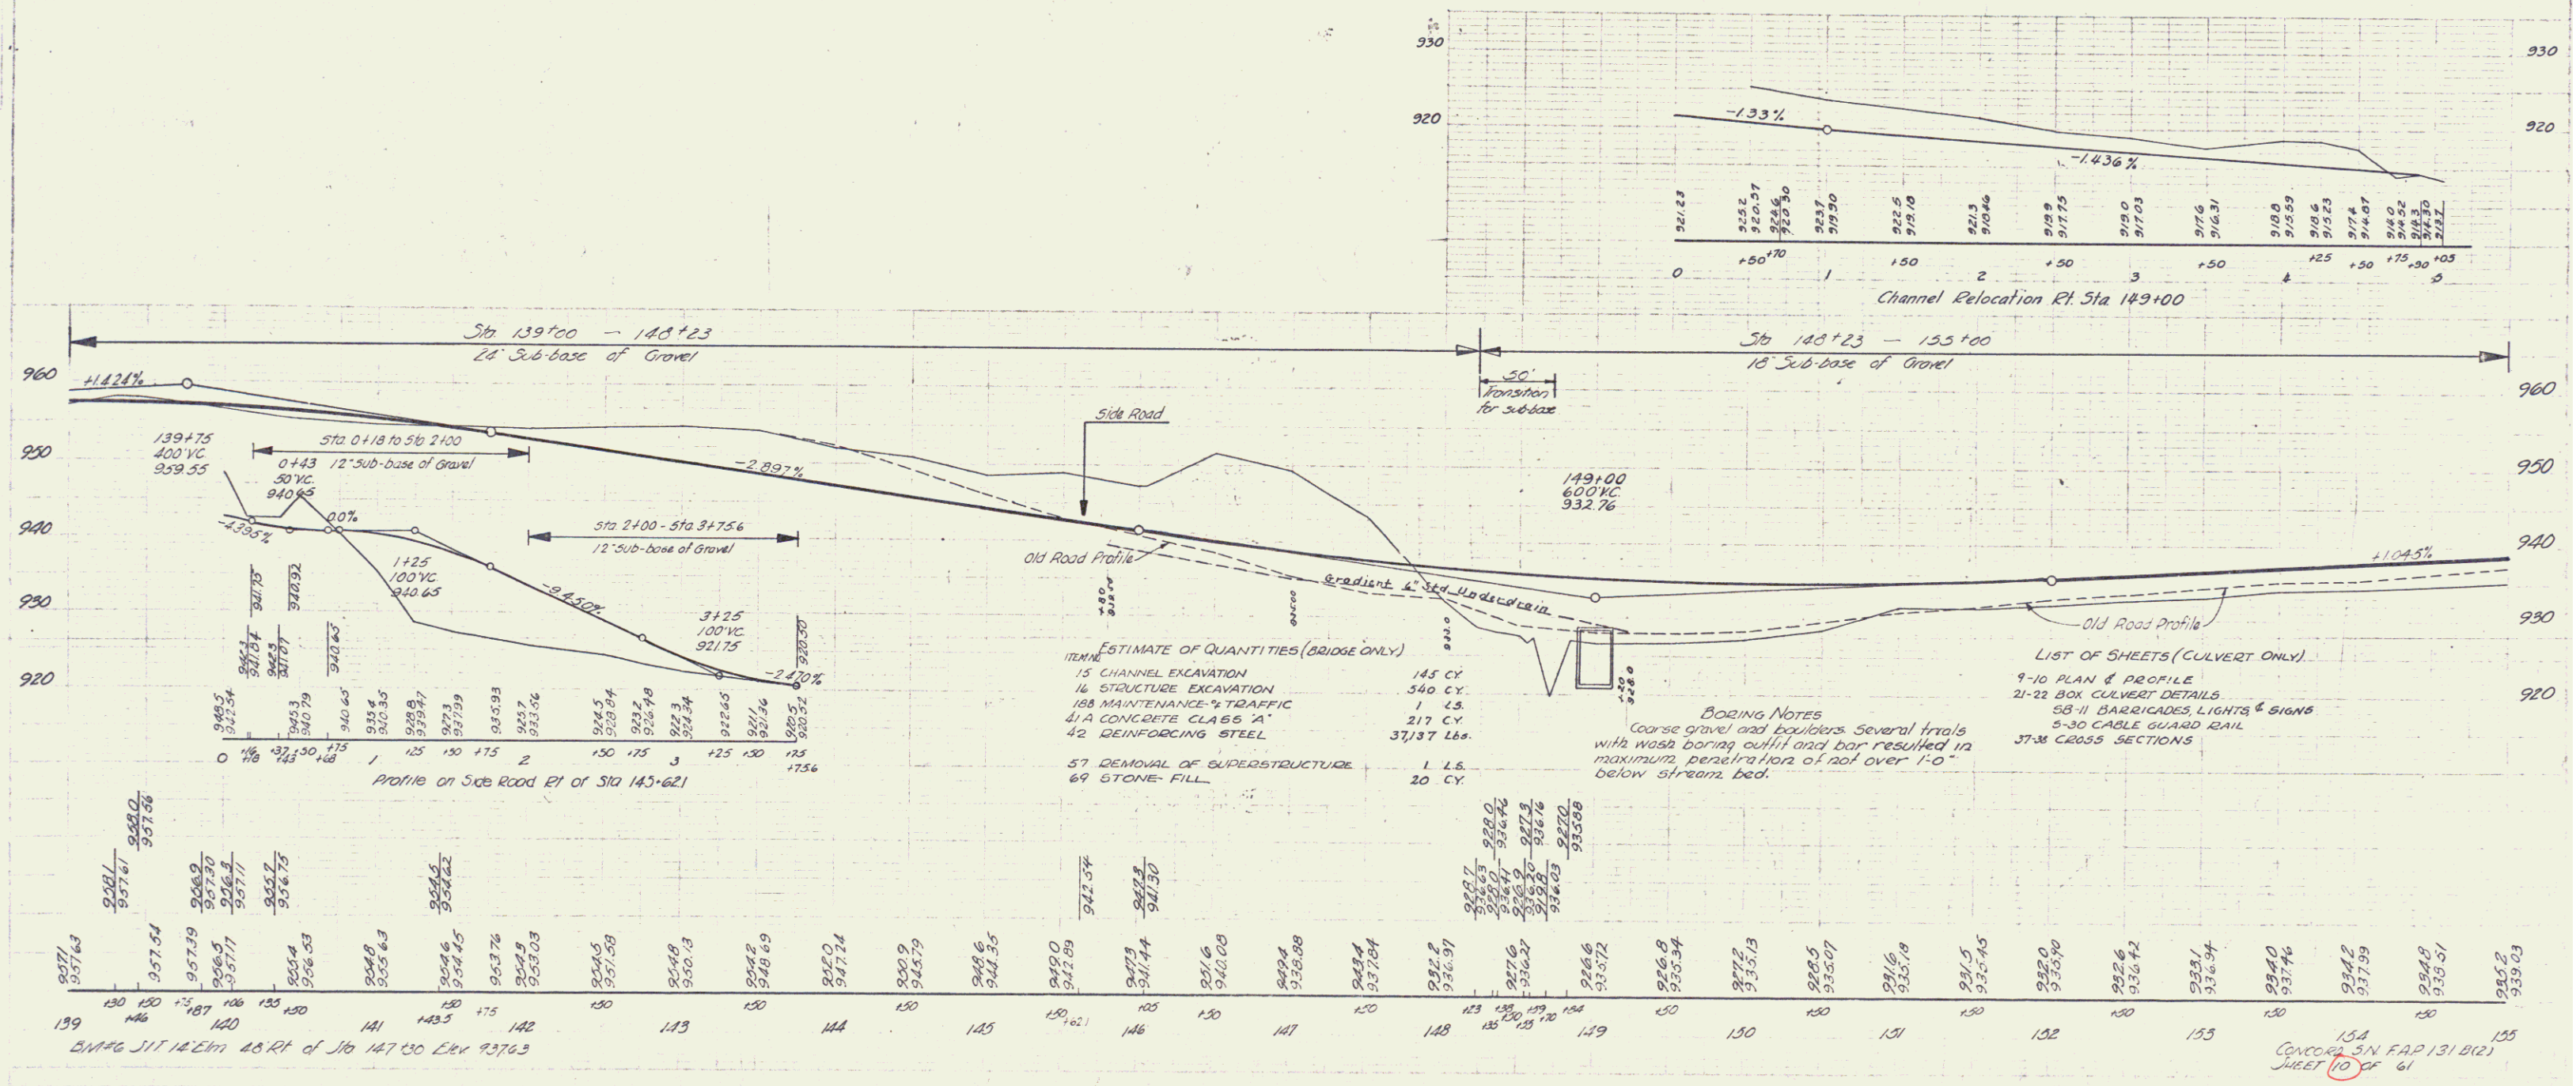

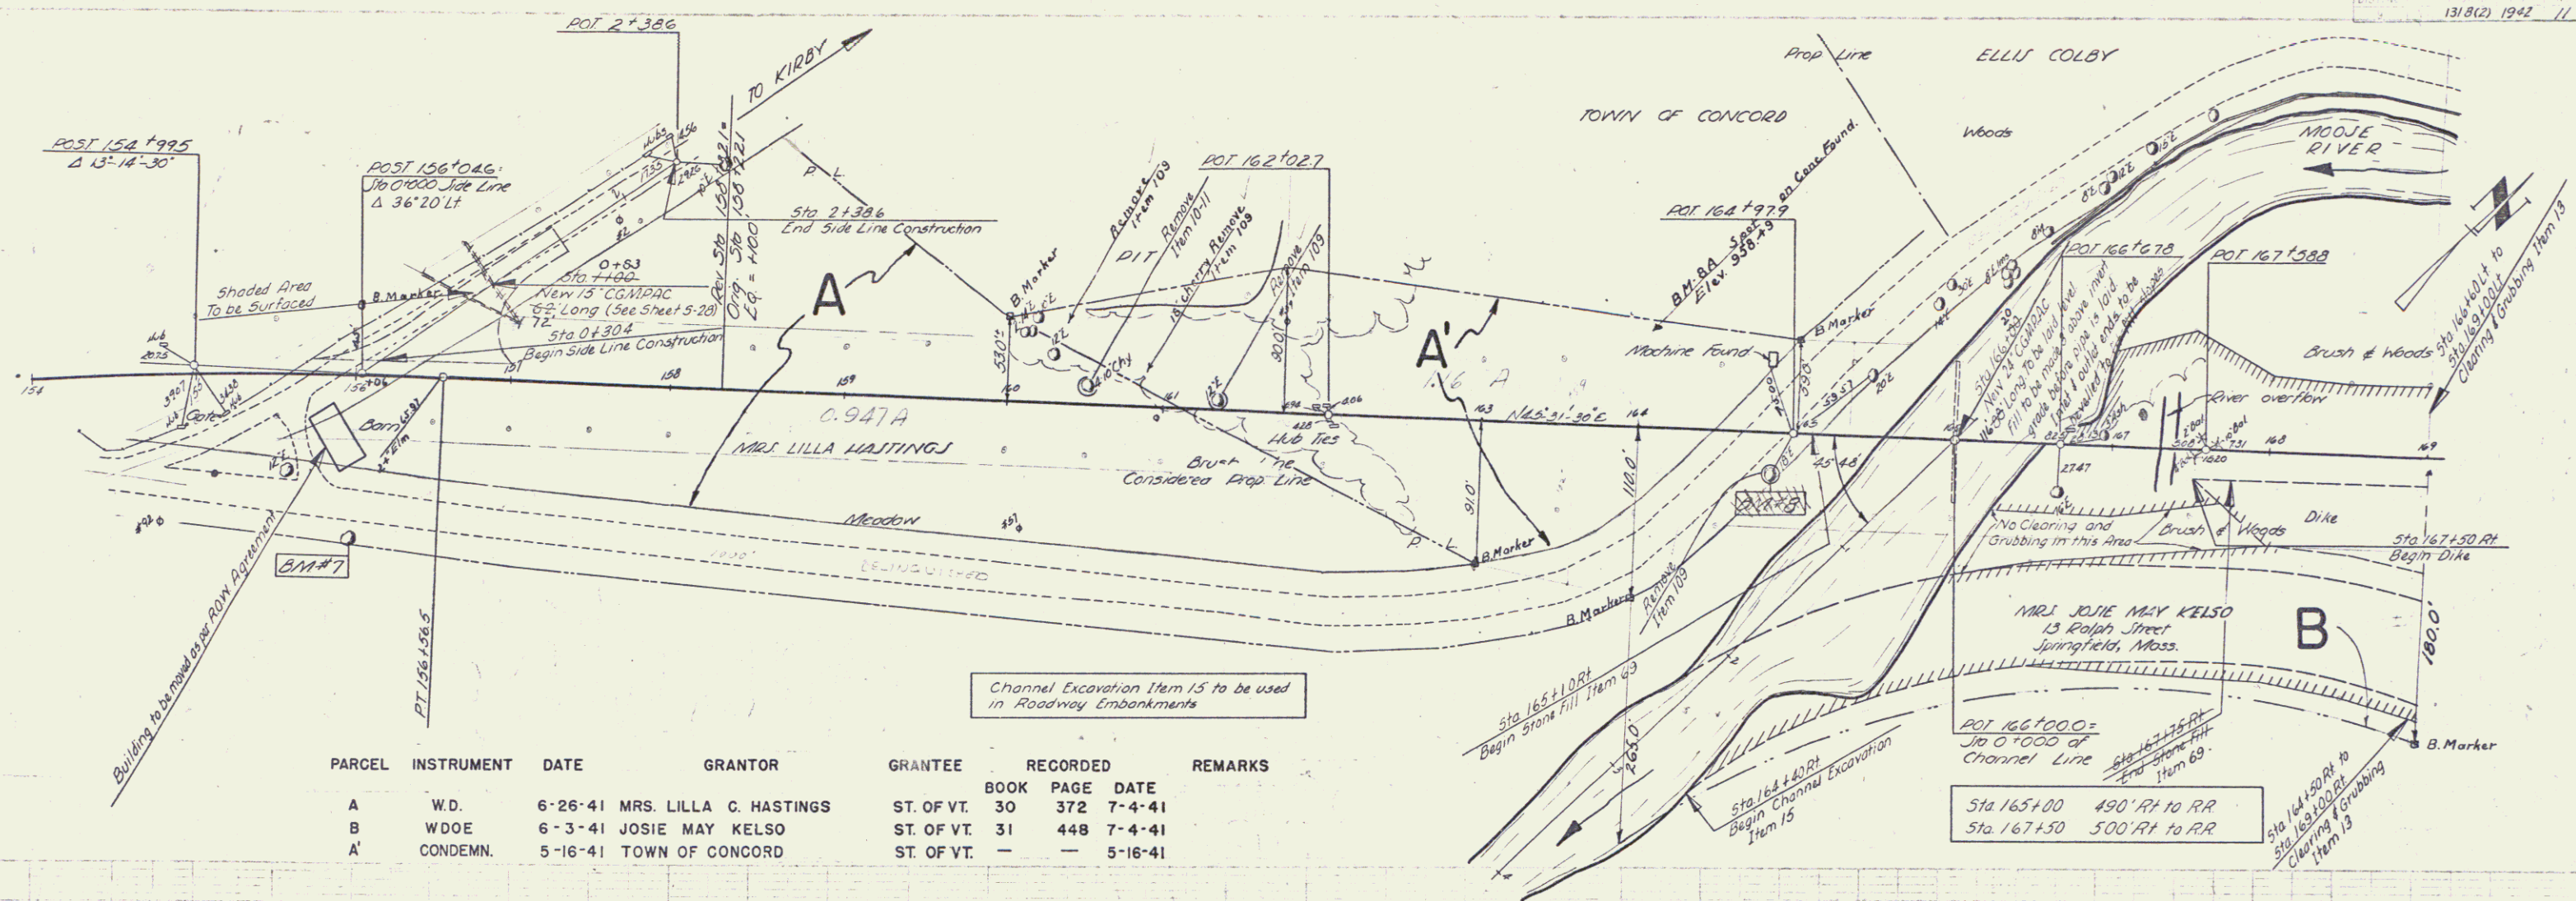


PARCEL	INSTRUMENT	DATE	GRANTOR	GRANTEE	RECORDED	REMARKS
A	W.D.	6-26-41	MRS. LILLA C. HASTINGS	ST. OF VT.	30 372 7-4-41	
B	WDOE	6-3-41	JOSIE MAY KELSO	ST. OF VT.	31 448 7-4-41	
A'	CONDEMN.	5-16-41	TOWN OF CONCORD	ST. OF VT.	- - 5-16-41	

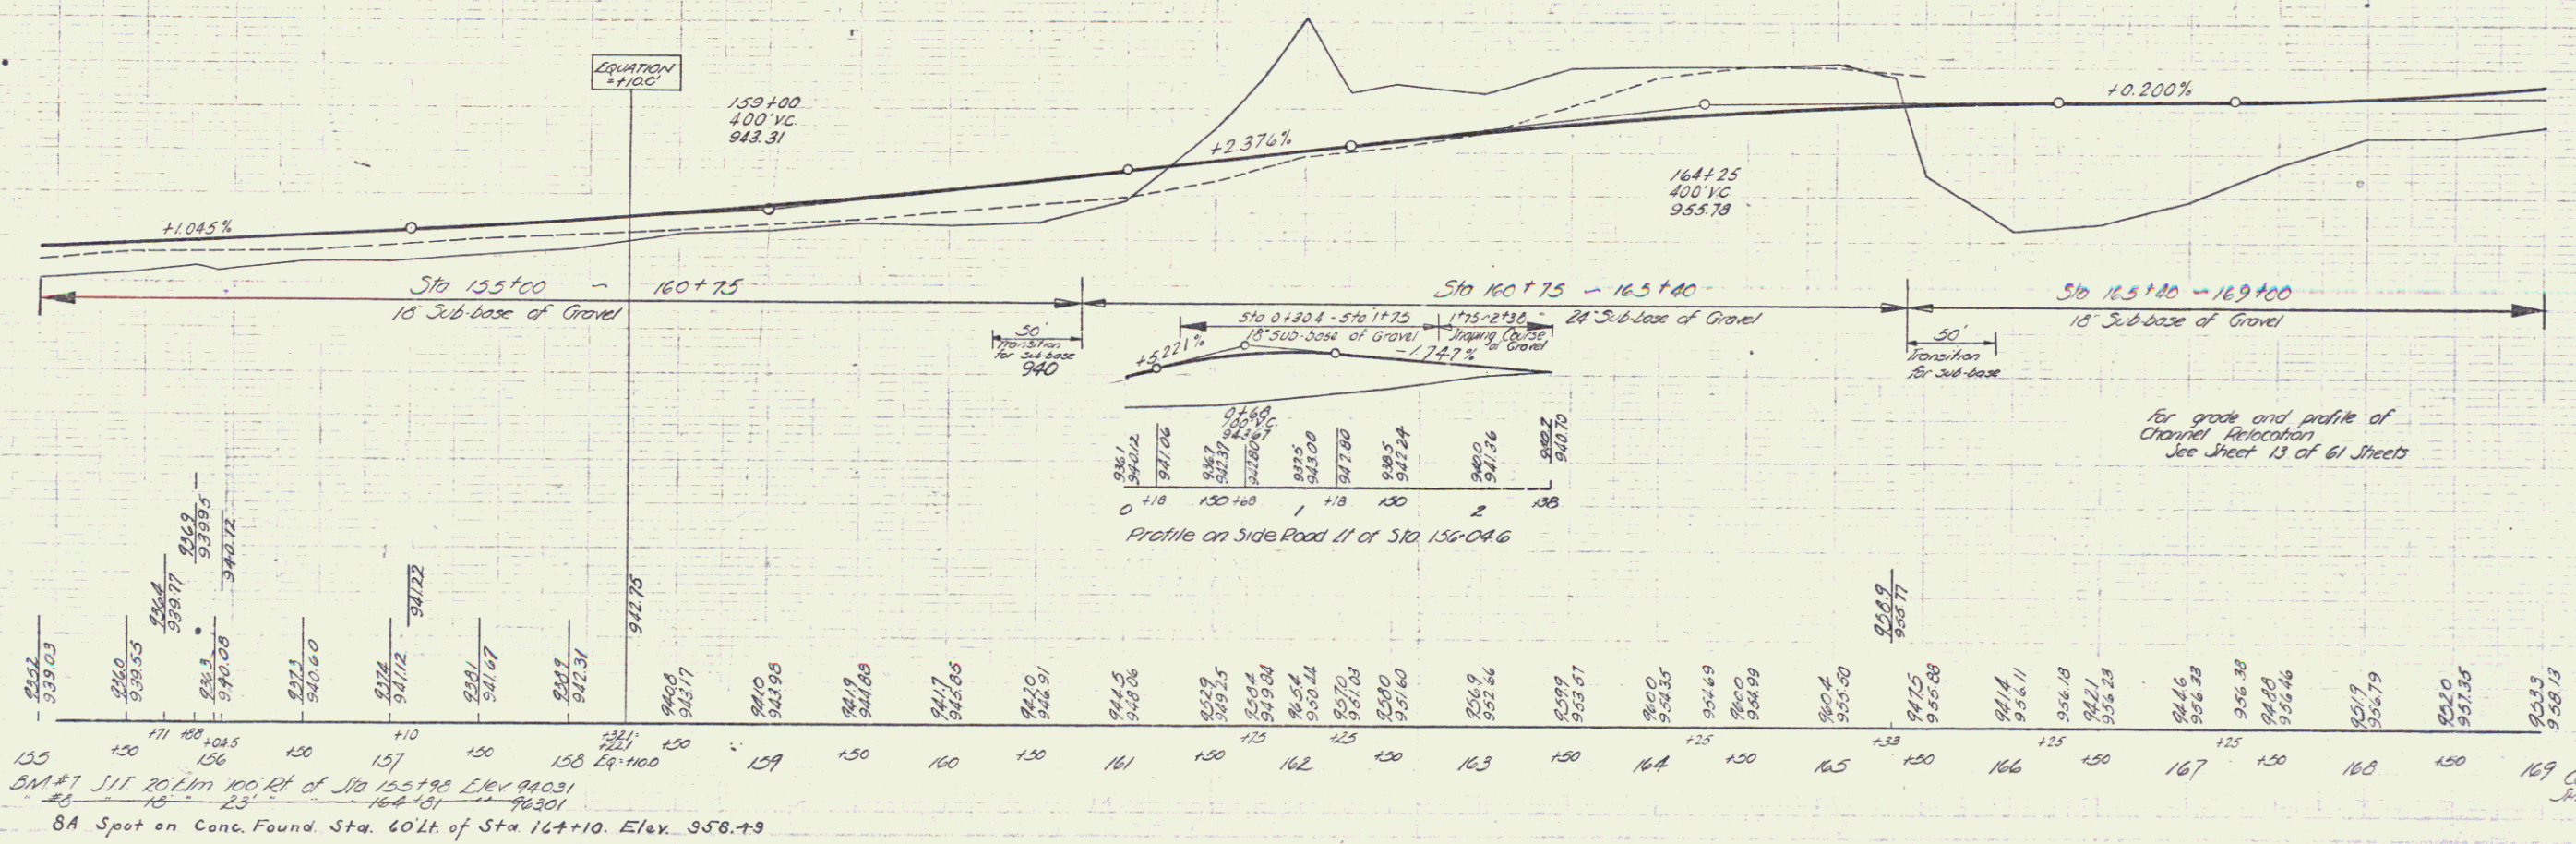


8A Spot on Conc. Found. Sta. 60' Lt. of Sta 164+10. Elev. 958.19

PART OF THE SAME LAND AND PREMISES ACQUIRED BY THE STATE OF VERMONT
FROM LILLIAN C. HASTINGS BY WARRANTY DEED DATED JUNE 26, 1941 AND RECORDED
IN BOOK 30 PAGE 72 OF THE CONCORD LAND RECORDS.

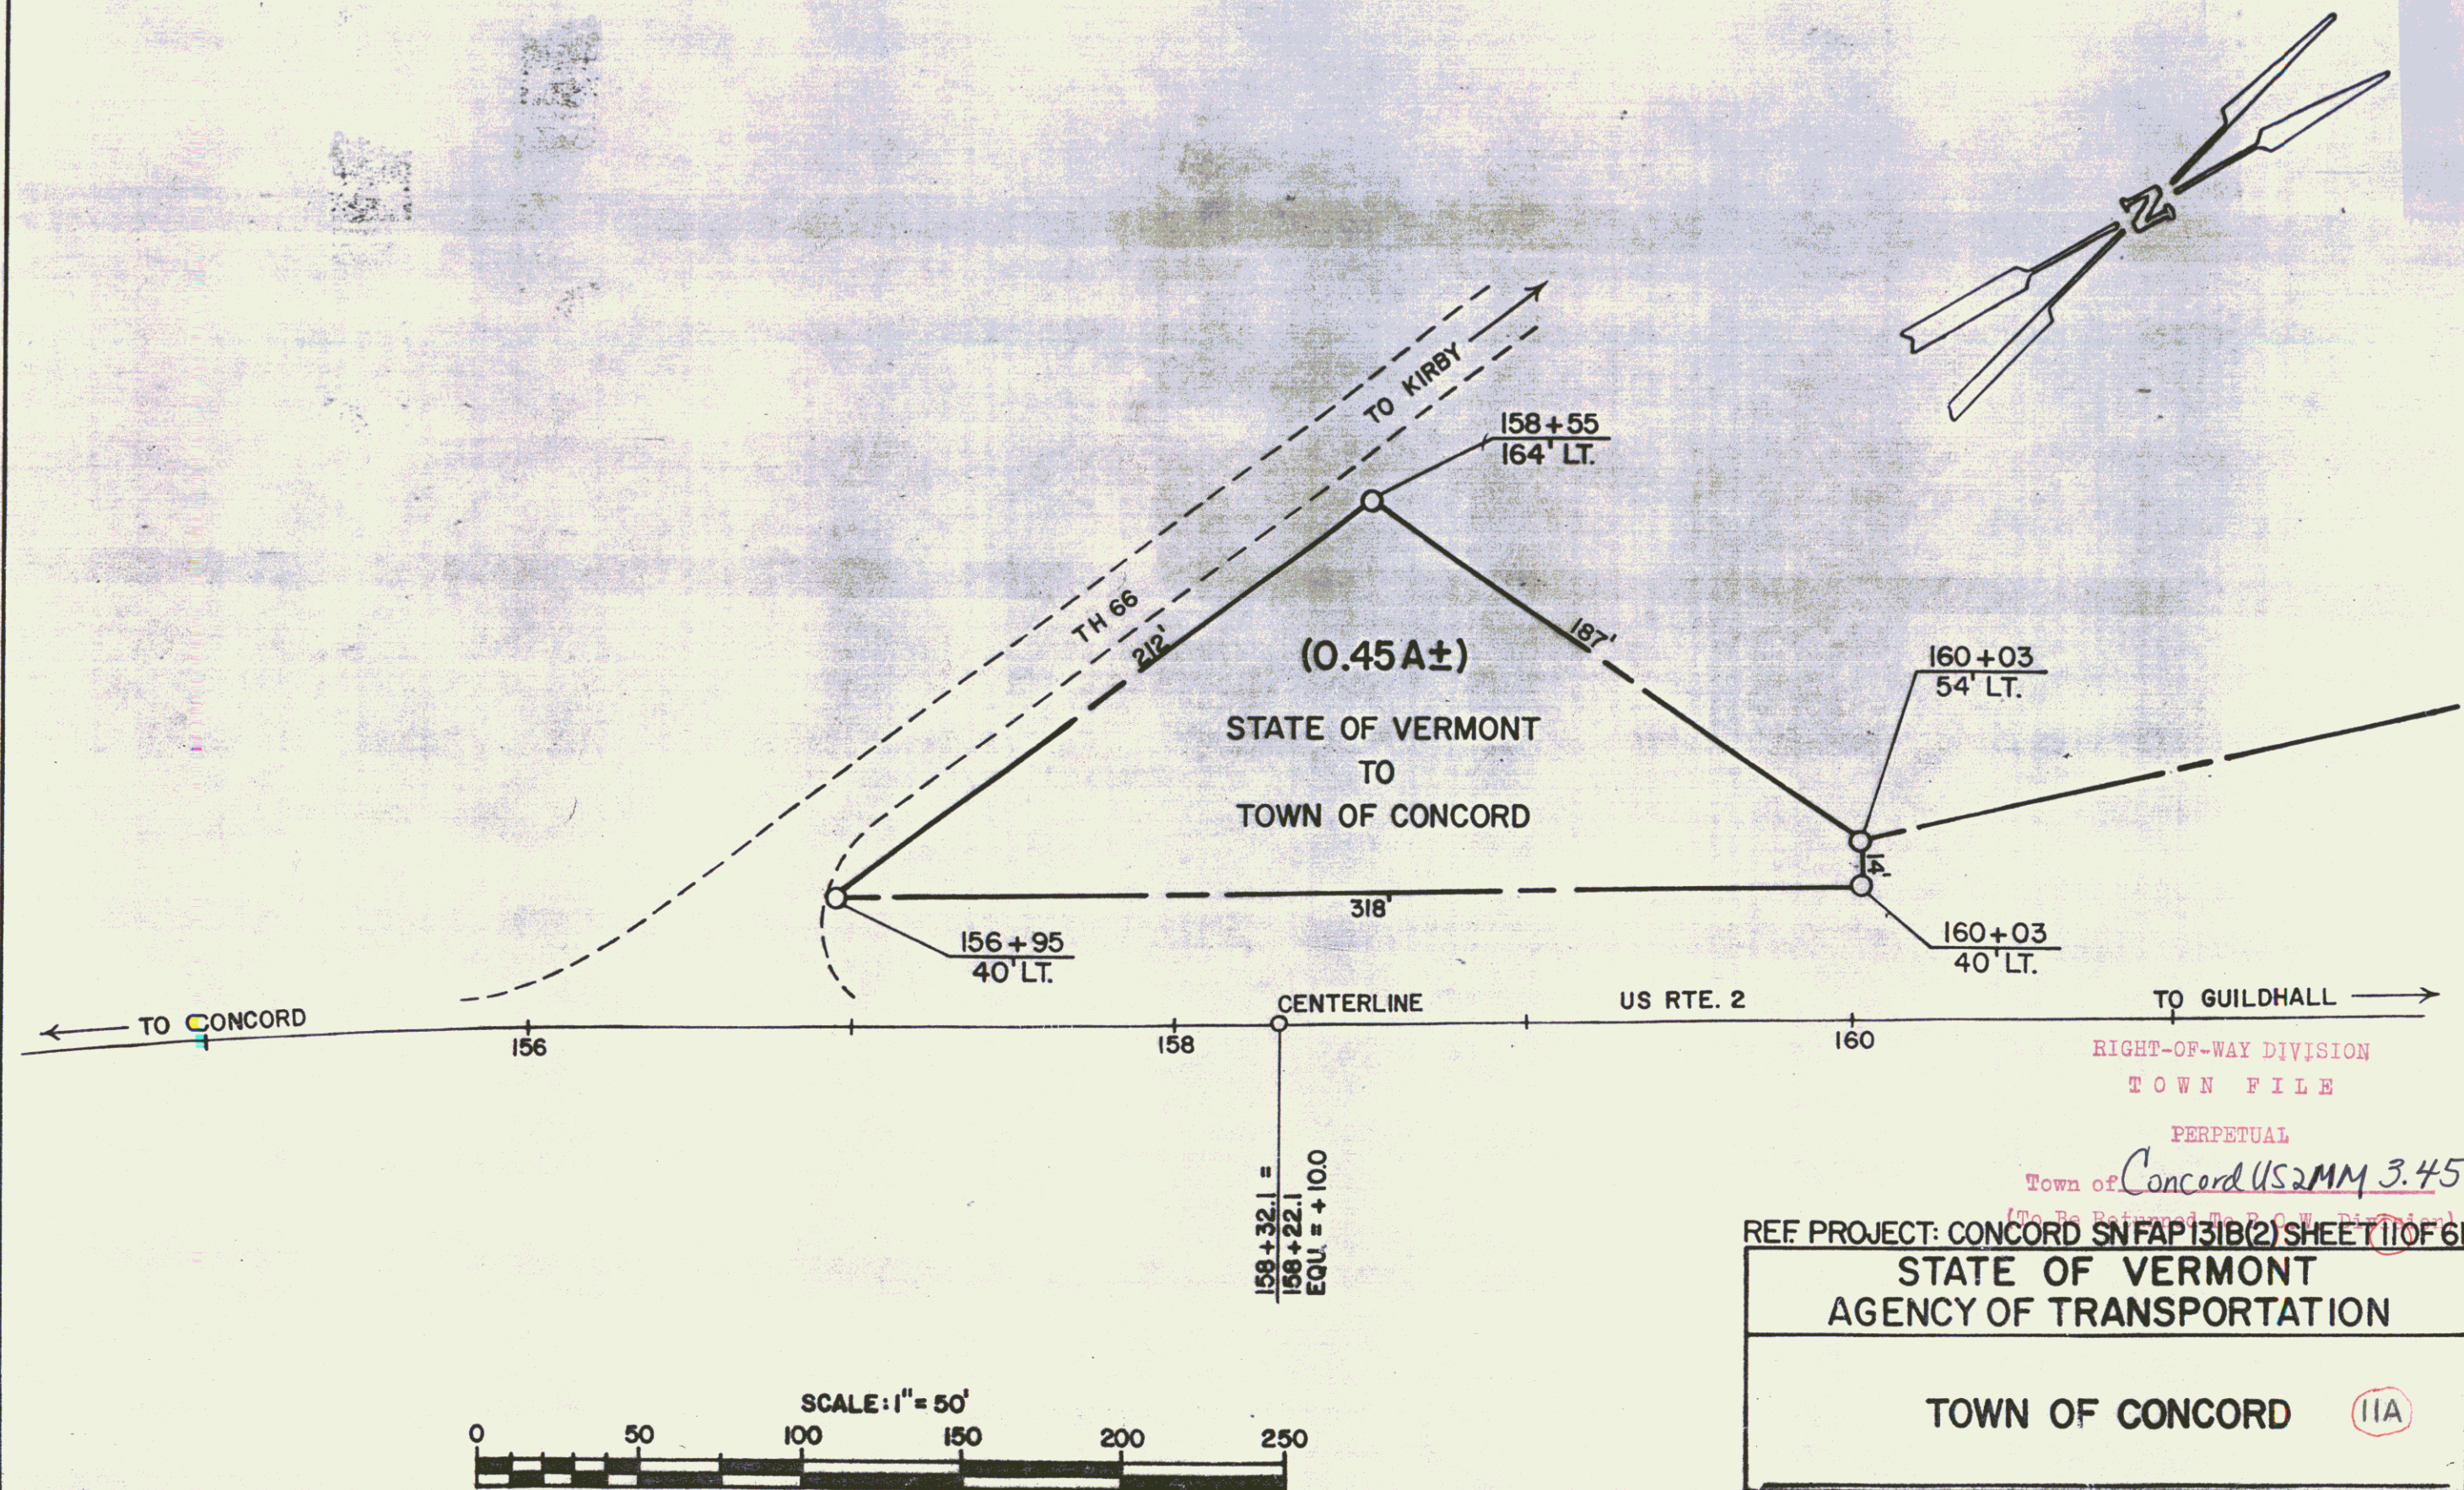

DATE	STATE	NO.	YEAR	SHEET	TOTAL
13180	VT	1746	12	61	

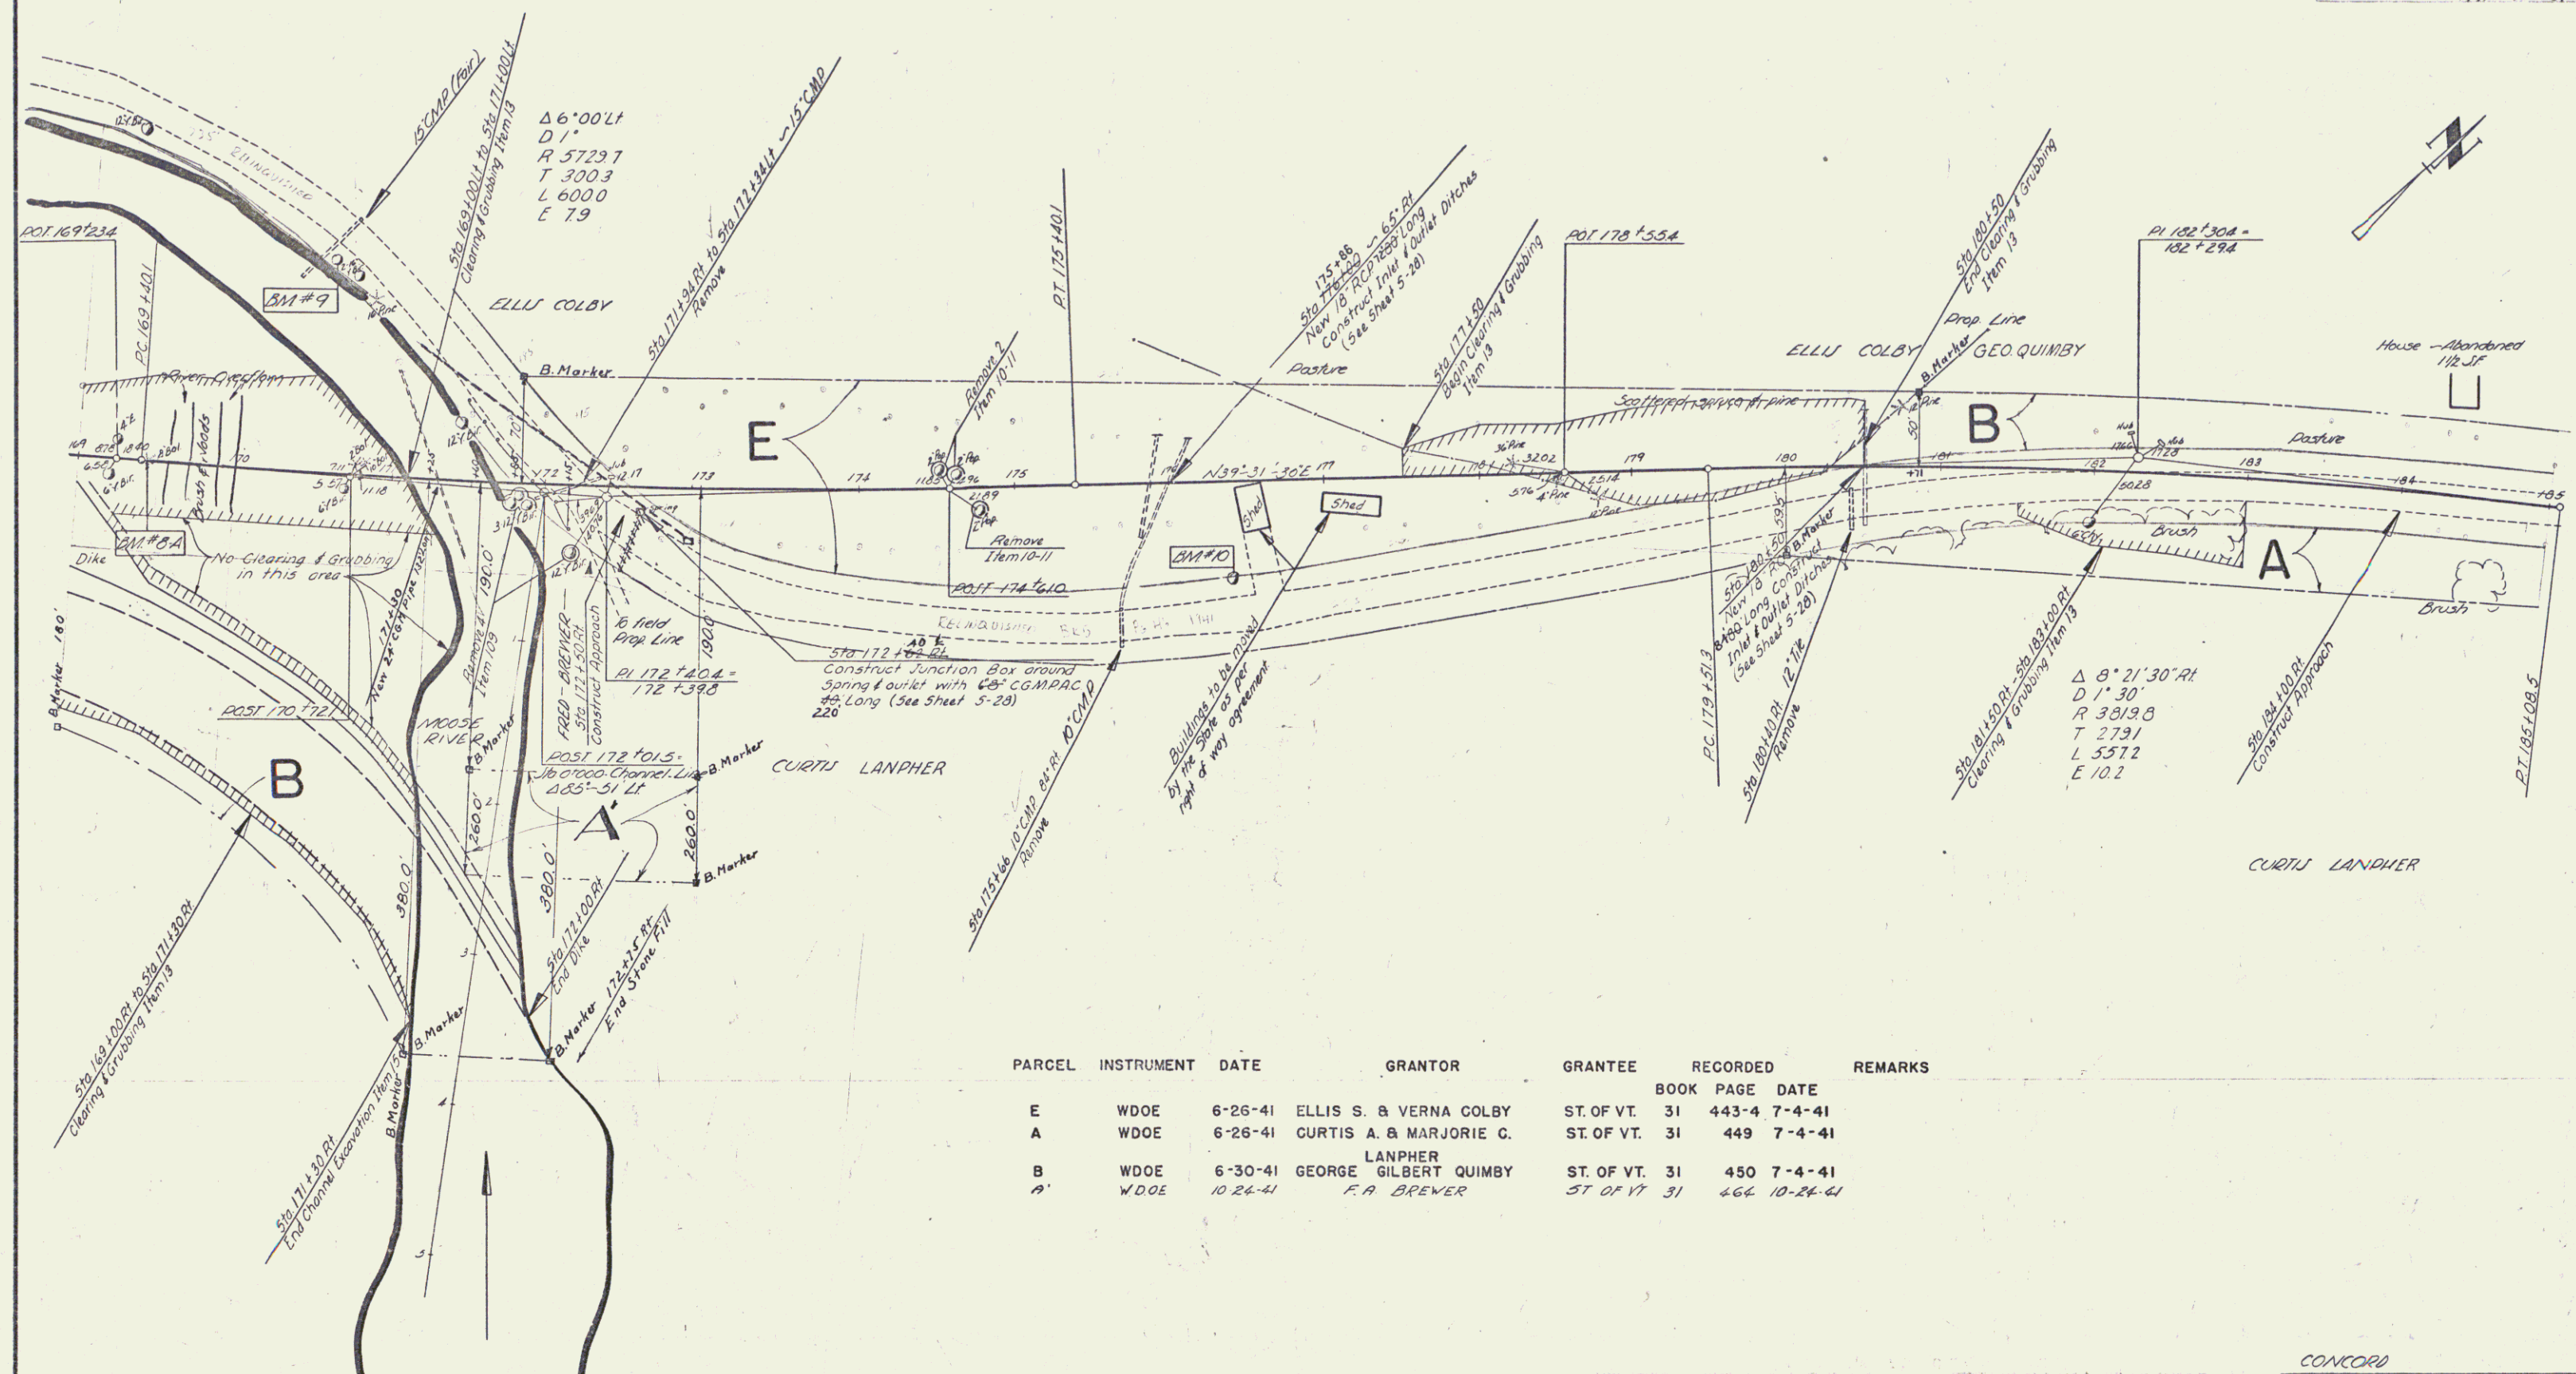

PARCEL	INSTRUMENT	DATE	GRANTOR	GRANTEE	BOOK	PAGE	RECORDED DATE	REMARKS
E	WDOE	6-26-41	ELLIS S. & VERA COLBY	ST. OF VT.	31	443-4	7-4-41	
A	WDOE	6-26-41	CURTIS A. & MARJORIE C. LANPHER	ST. OF VT.	31	449	7-4-41	
B	WDOE	6-30-41	GEORGE GILBERT QUIMBY	ST. OF VT.	31	450	7-4-41	
A'	WDOE	10-24-41	F. A. BREWER	ST. OF VT.	31	464	10-24-41	

BM#8A SIT 8" Balsam on E of Sta 169+45 Elev 951.88
 BM#9 SIT 14" Elm 139' Lt of Sta 170+56 Elev 958.53
 BM#10 SIT 20" Elm 69' Rt of Sta 176+41 Elev 983.30

CONCORD
 Surveyed by R. Bailey 12-40
 Designed by
 Drawn by R. G. Allen 1-41
 Traced by L. Lavin 2-41
 Checked by
 Series 3.N.E.A.P. 1318 (2) Filed
 Sheet 12 of 61 Sheets

