

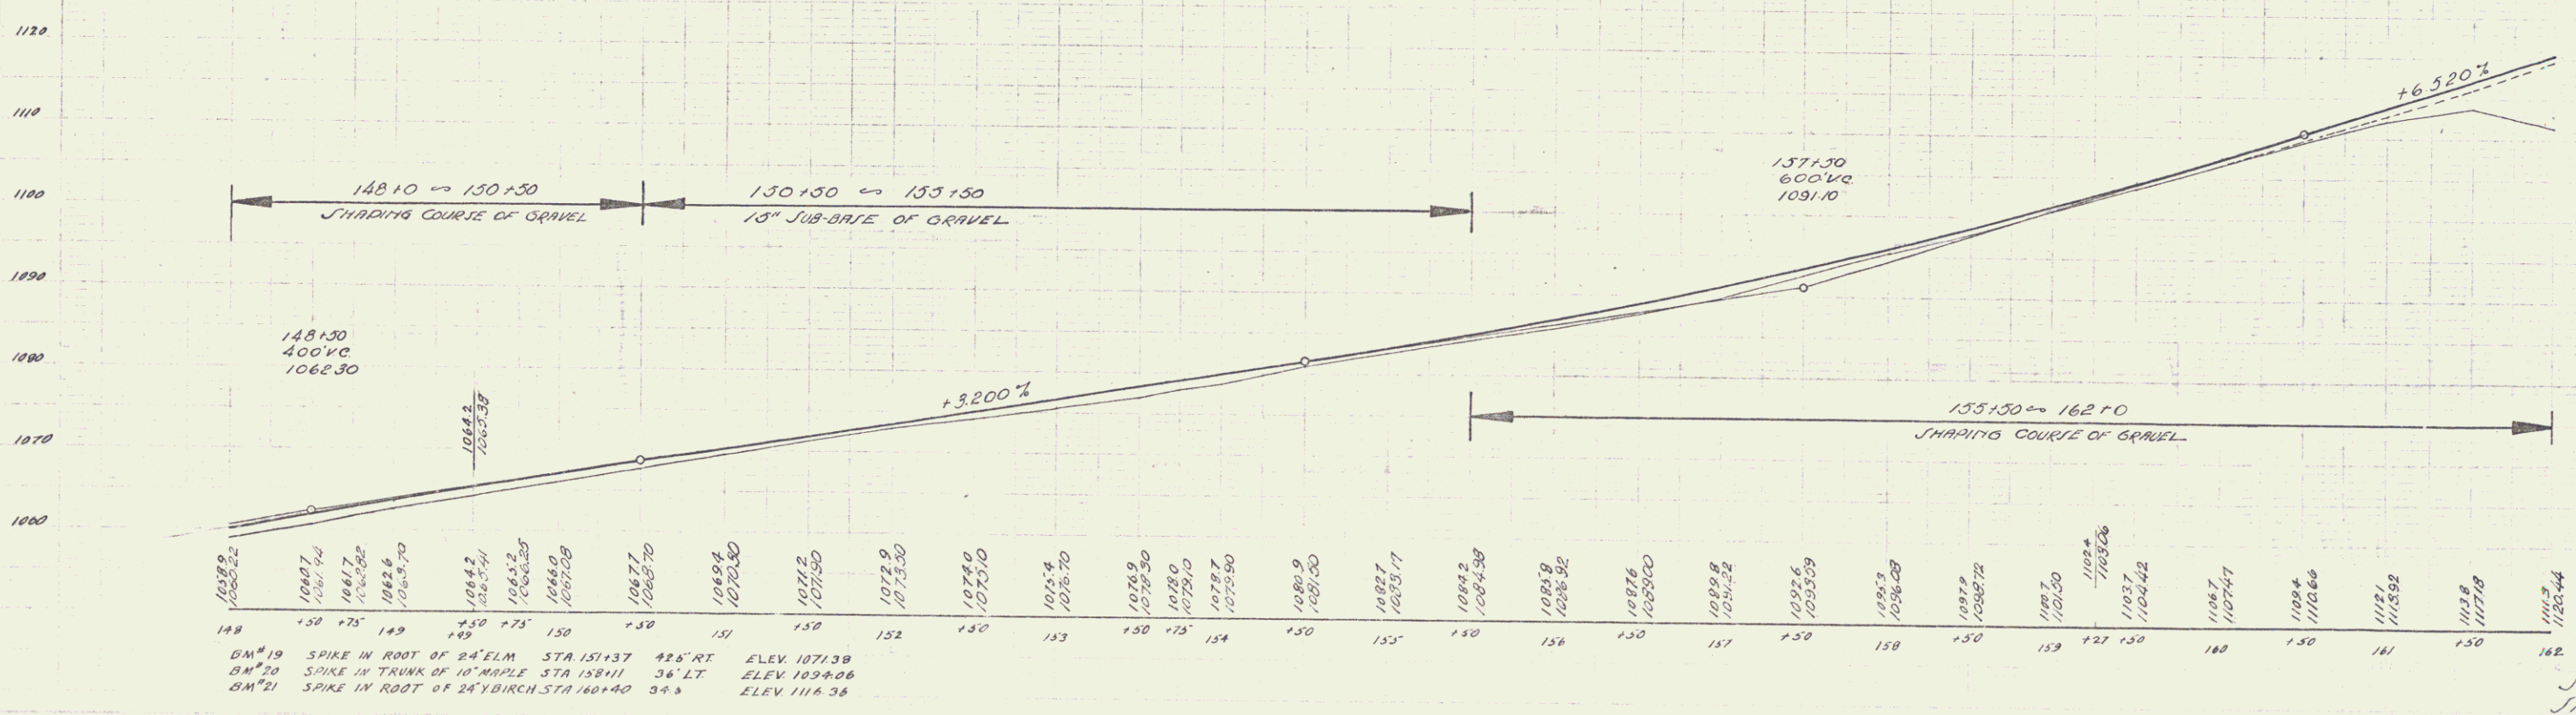
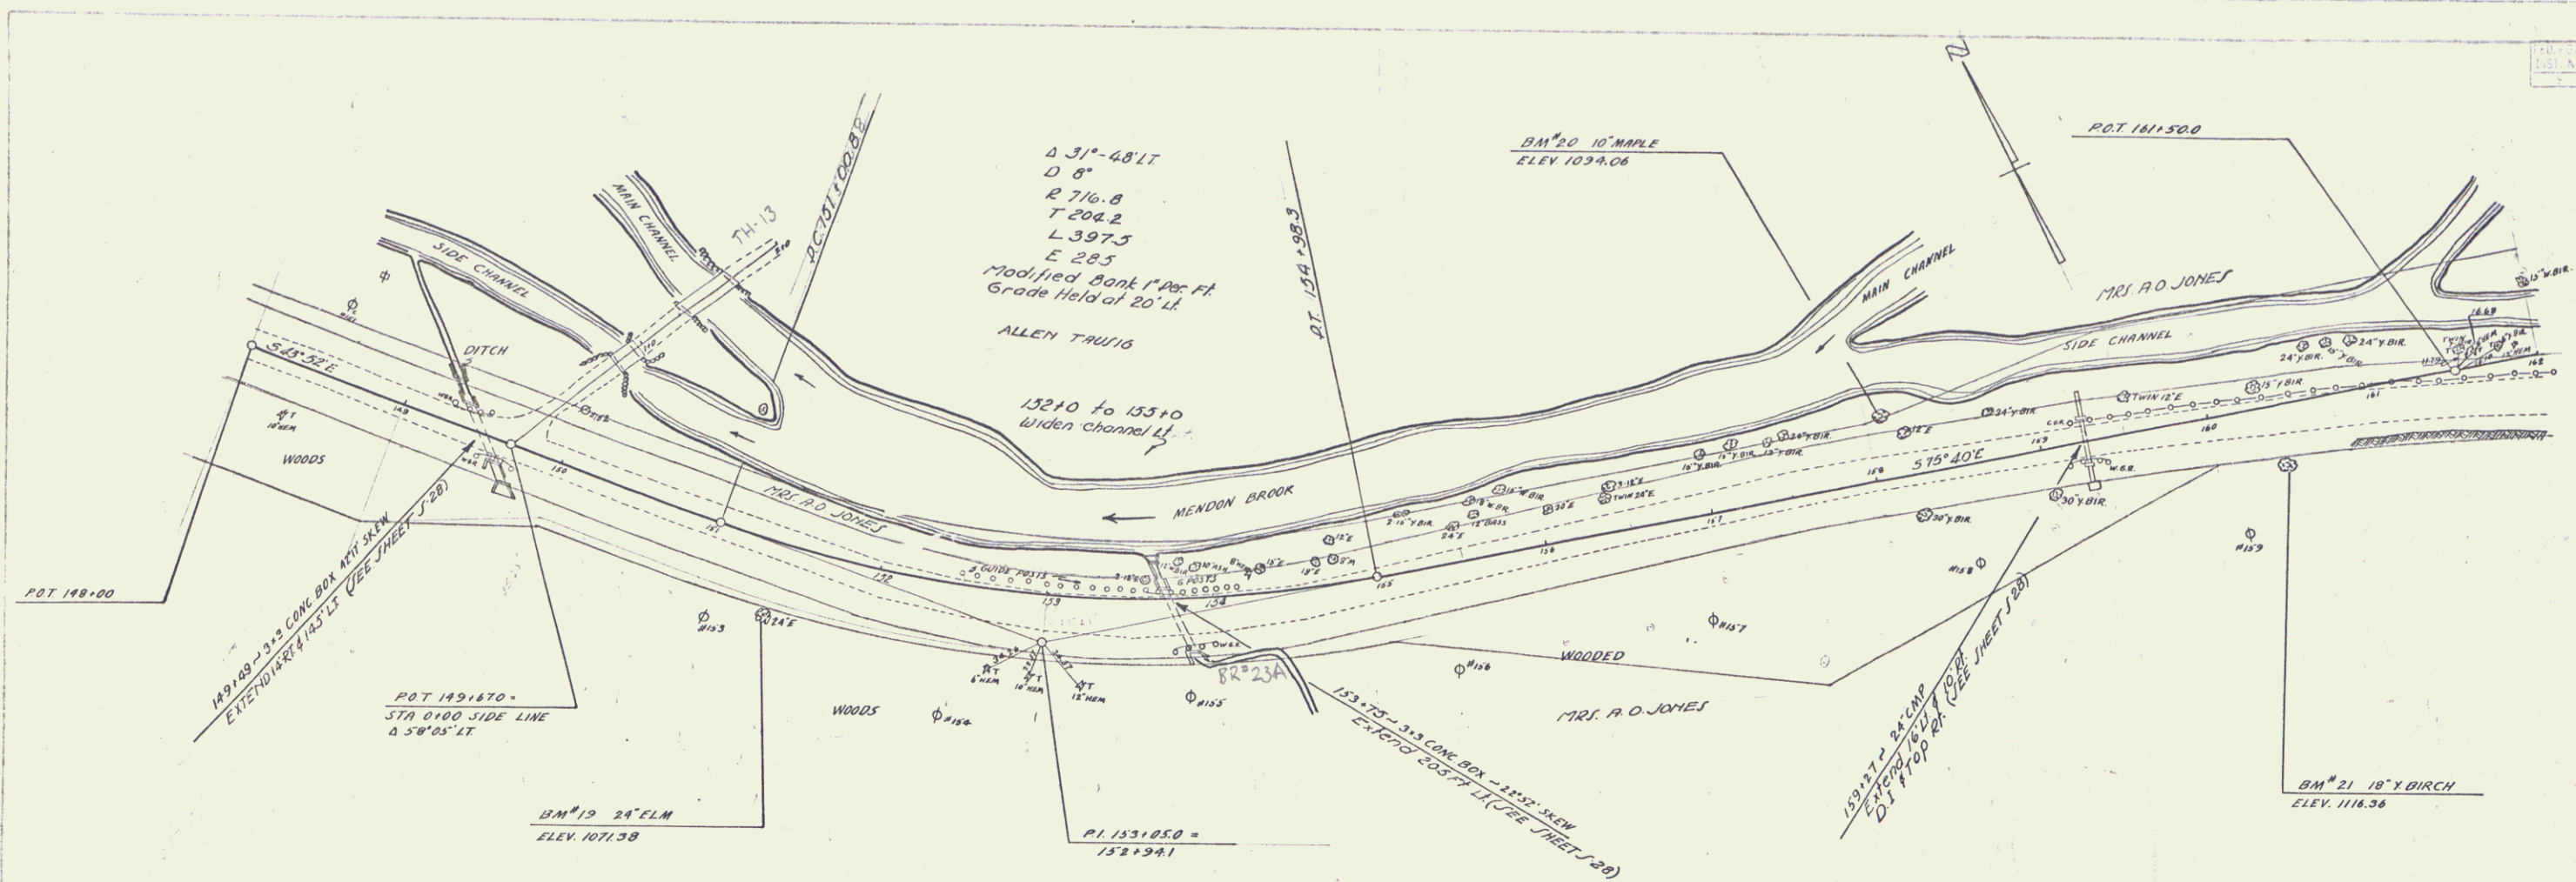


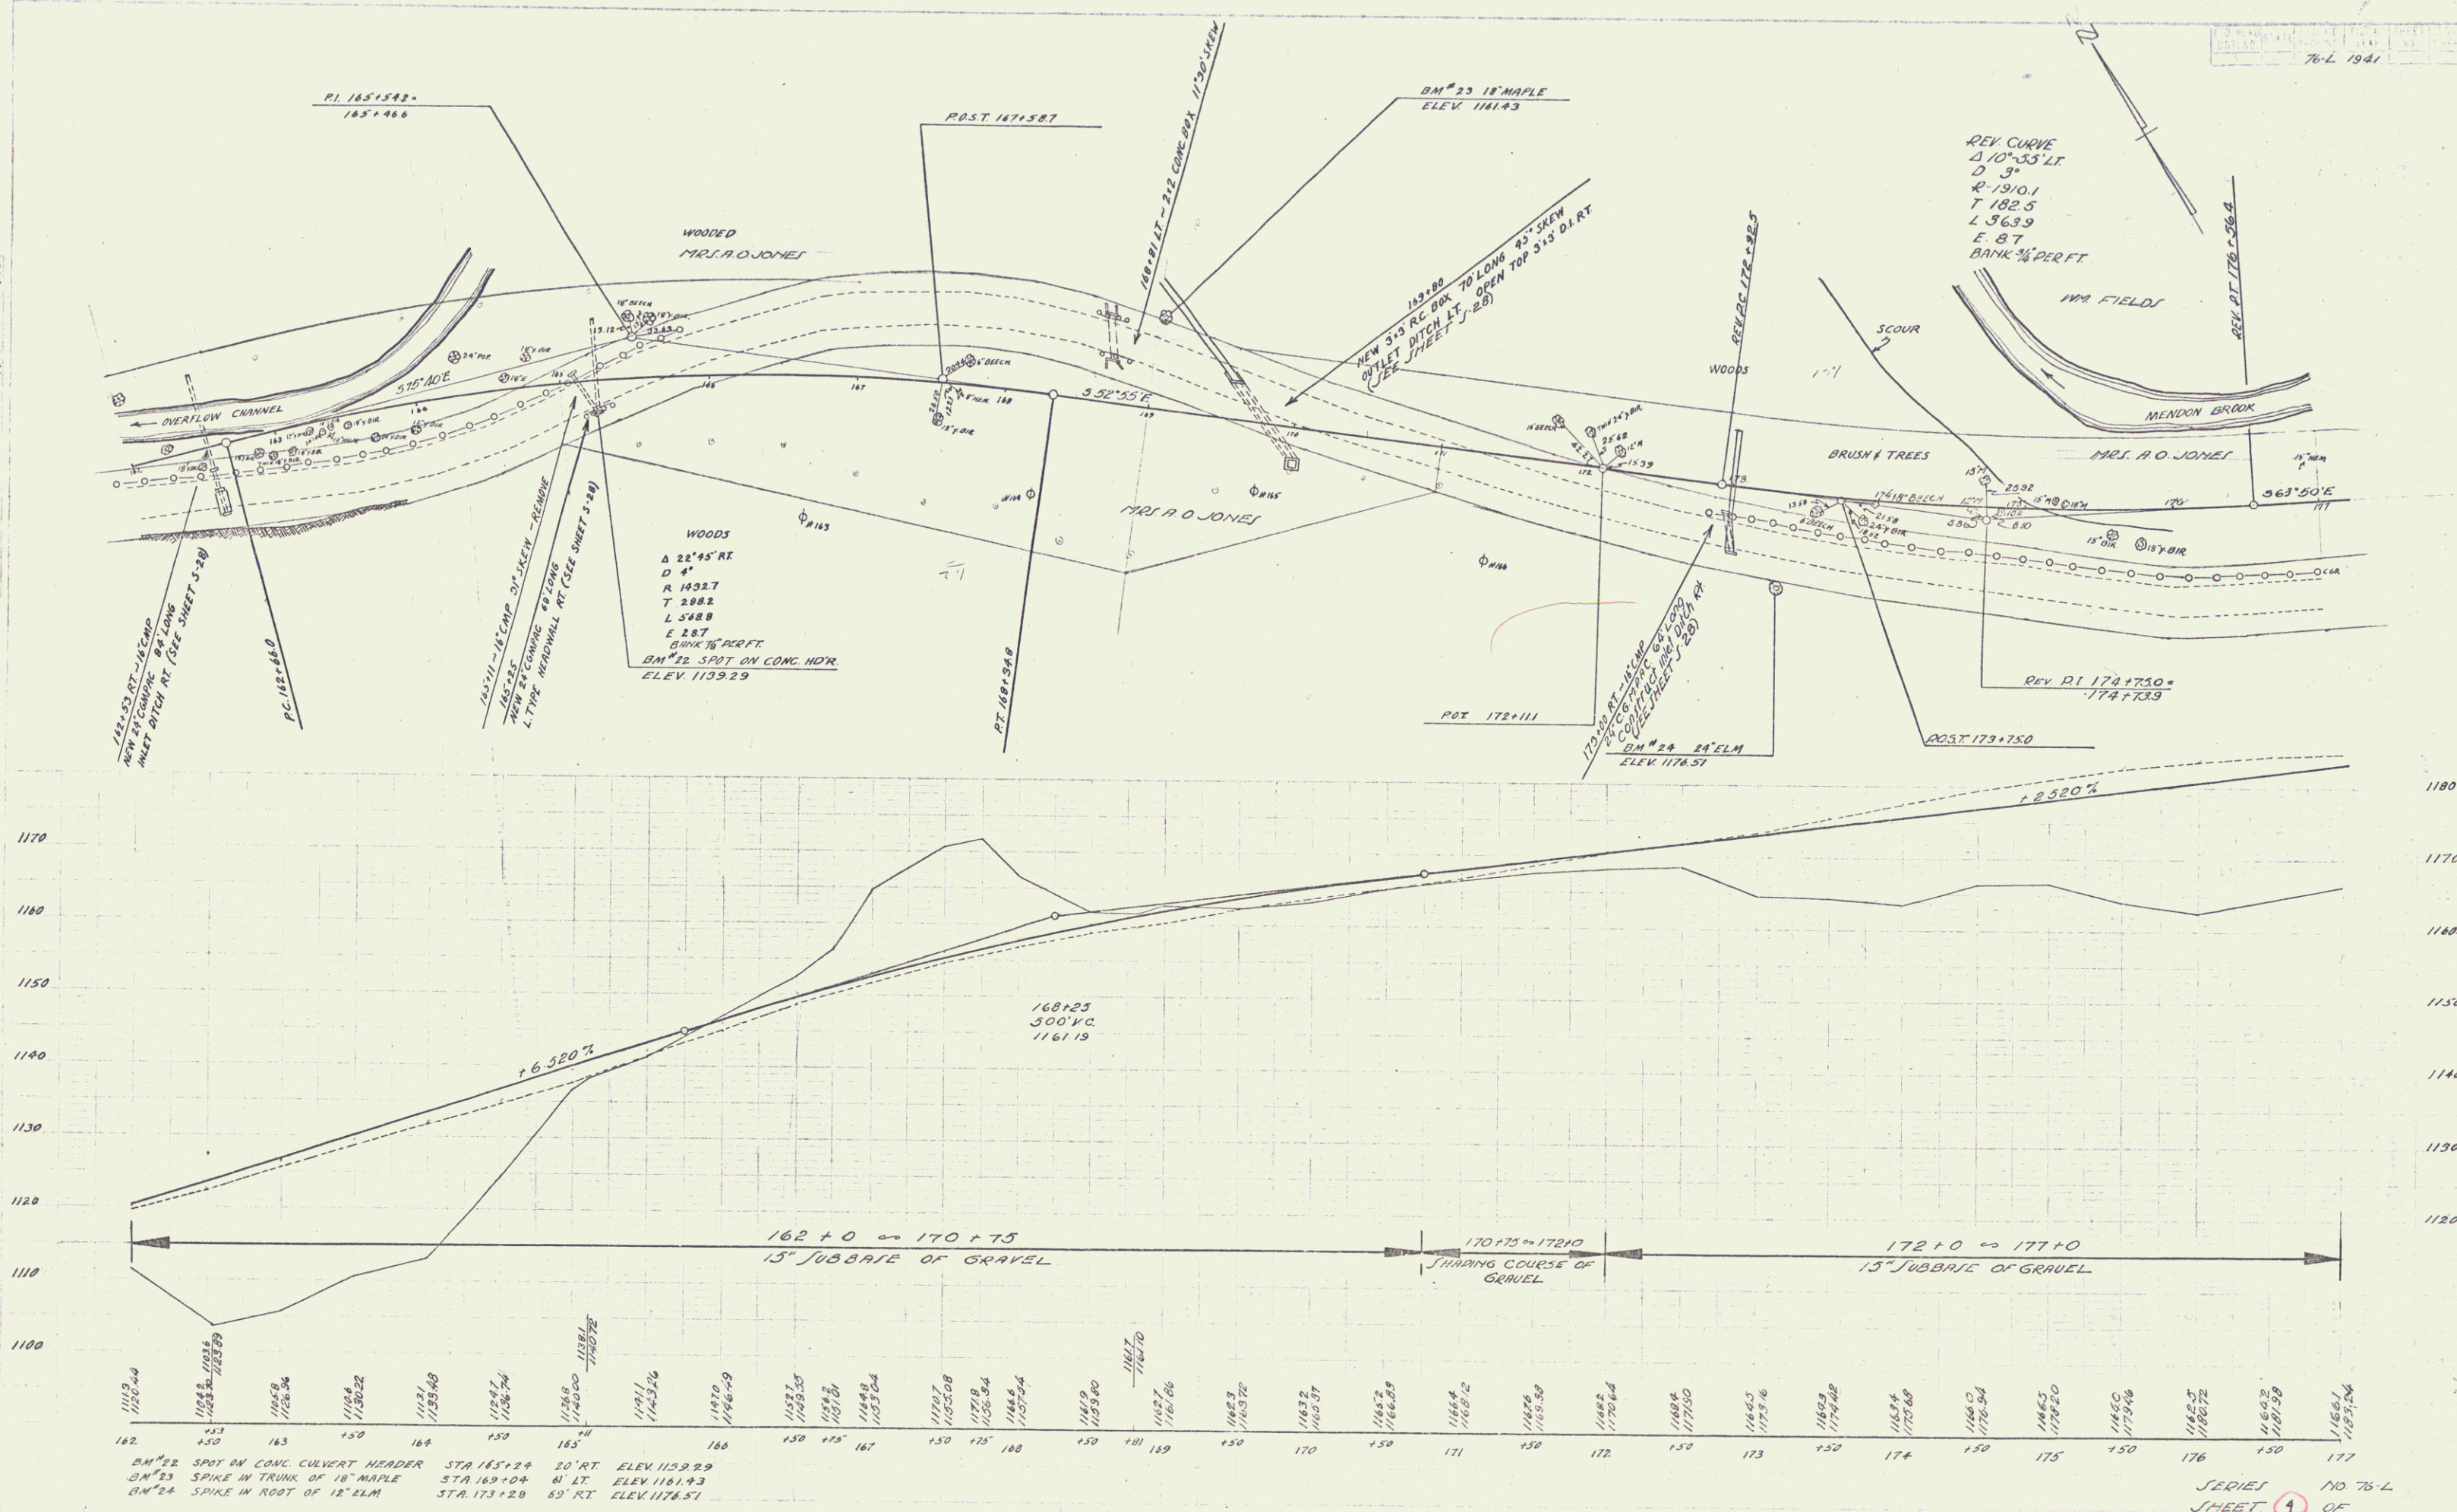

GALENE
JACKSON
JACKSON
JACKSON

GALENE
CEPATIAN
JACKSON

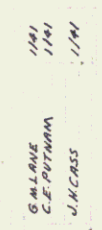

SERIES NO. 76-L
SHEET 4 OF

G.M. LANE
 J.H. CASE
 T.H. COOKE
 J.M. CASE

G.M. LANE
 C.E. PATTERSON
 J.H. CASE

