


1840
342+00
600' V.C.
1821.52

1850

1820

+3.500%

343+00 ~ 352+00 ✓
18" Base ✓

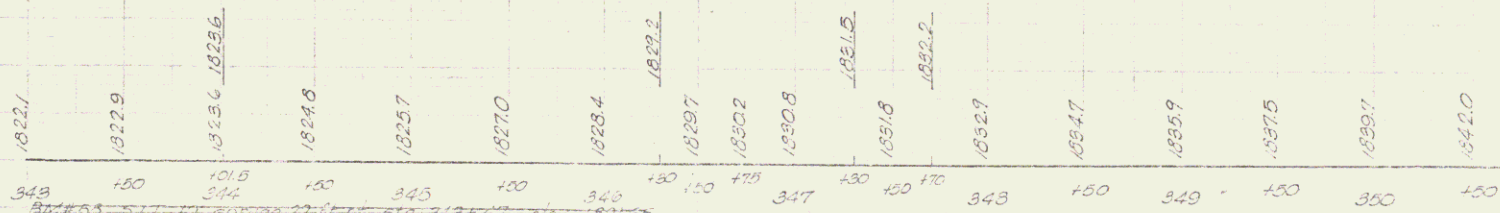

BM#55 S.I.T. 12" spruce 22 ft rt sta 342+47 elev 1821.52
BM#59 S.I.T. 12" spruce 38 ft rt sta 349+70 elev 1836.53
BM#60 S.I.R. 15" spruce 50 ft rt sta 355+94 elev 1859.50