


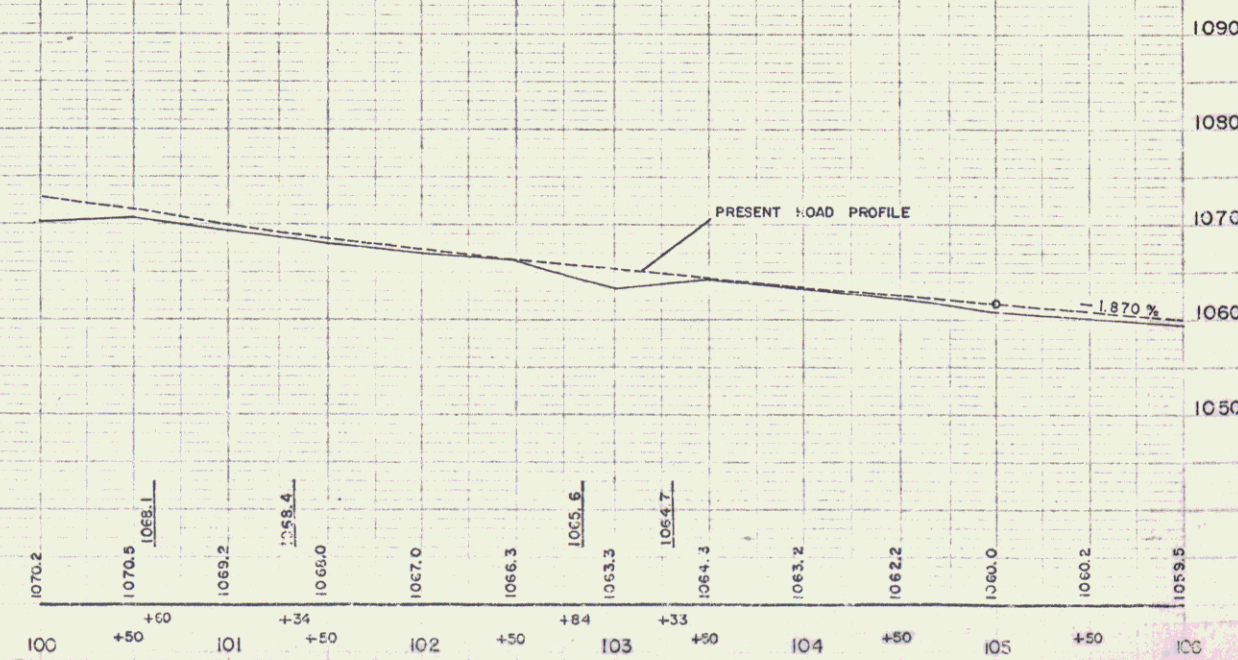


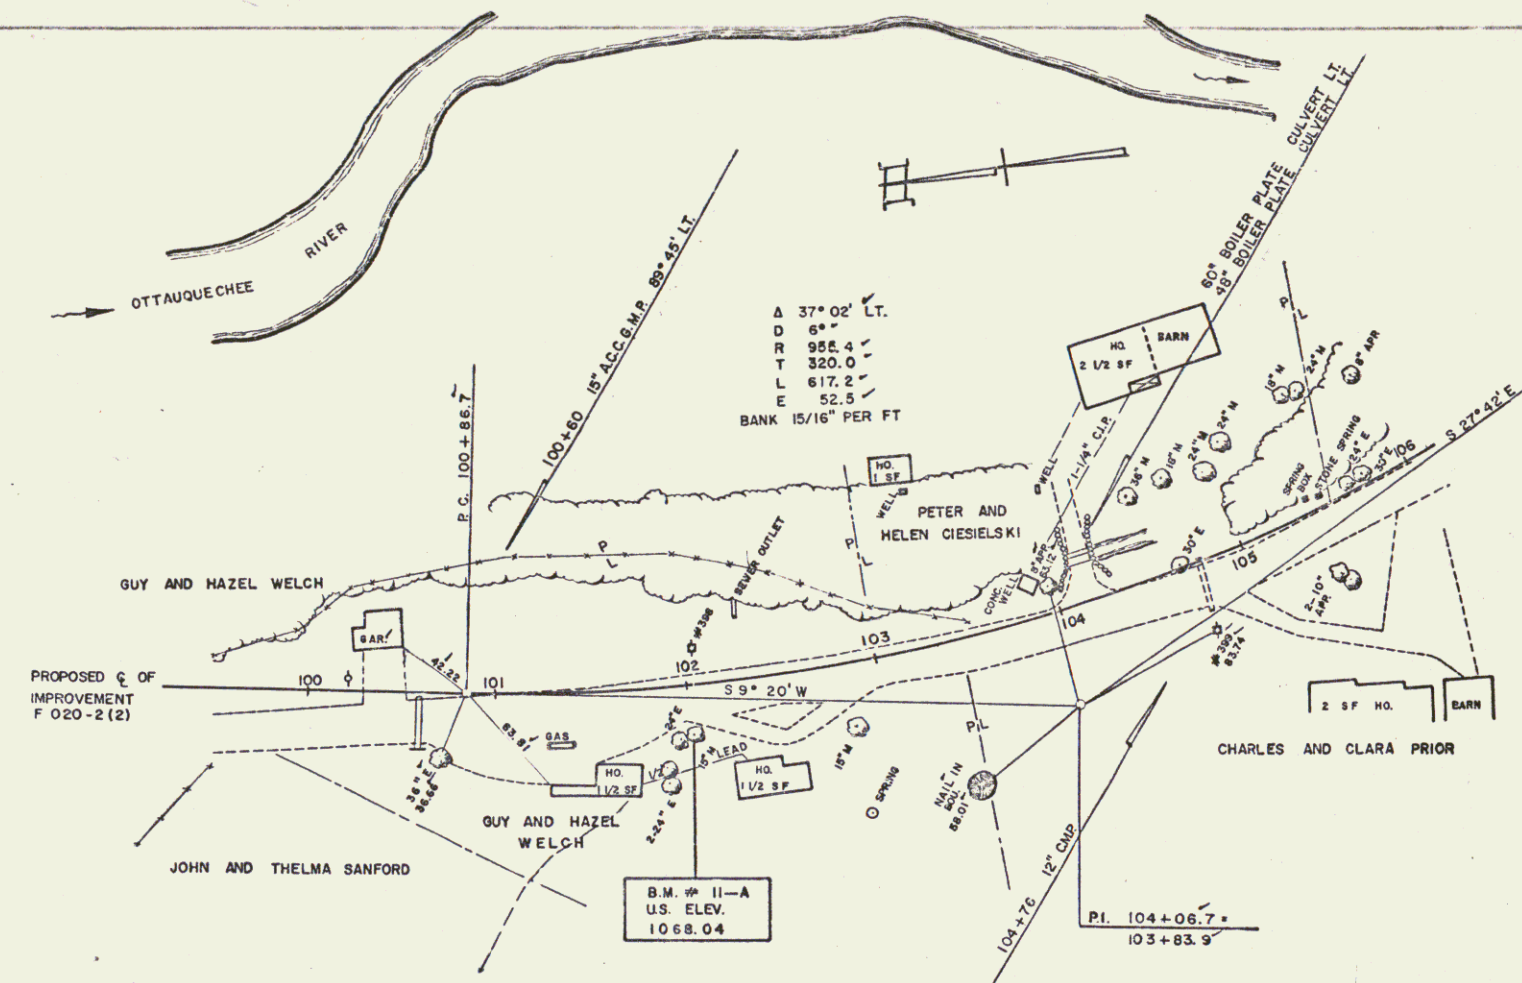

BRIDGEWATER
PROJECT F NO. 020-2 (2)
SHEET 10 OF 101

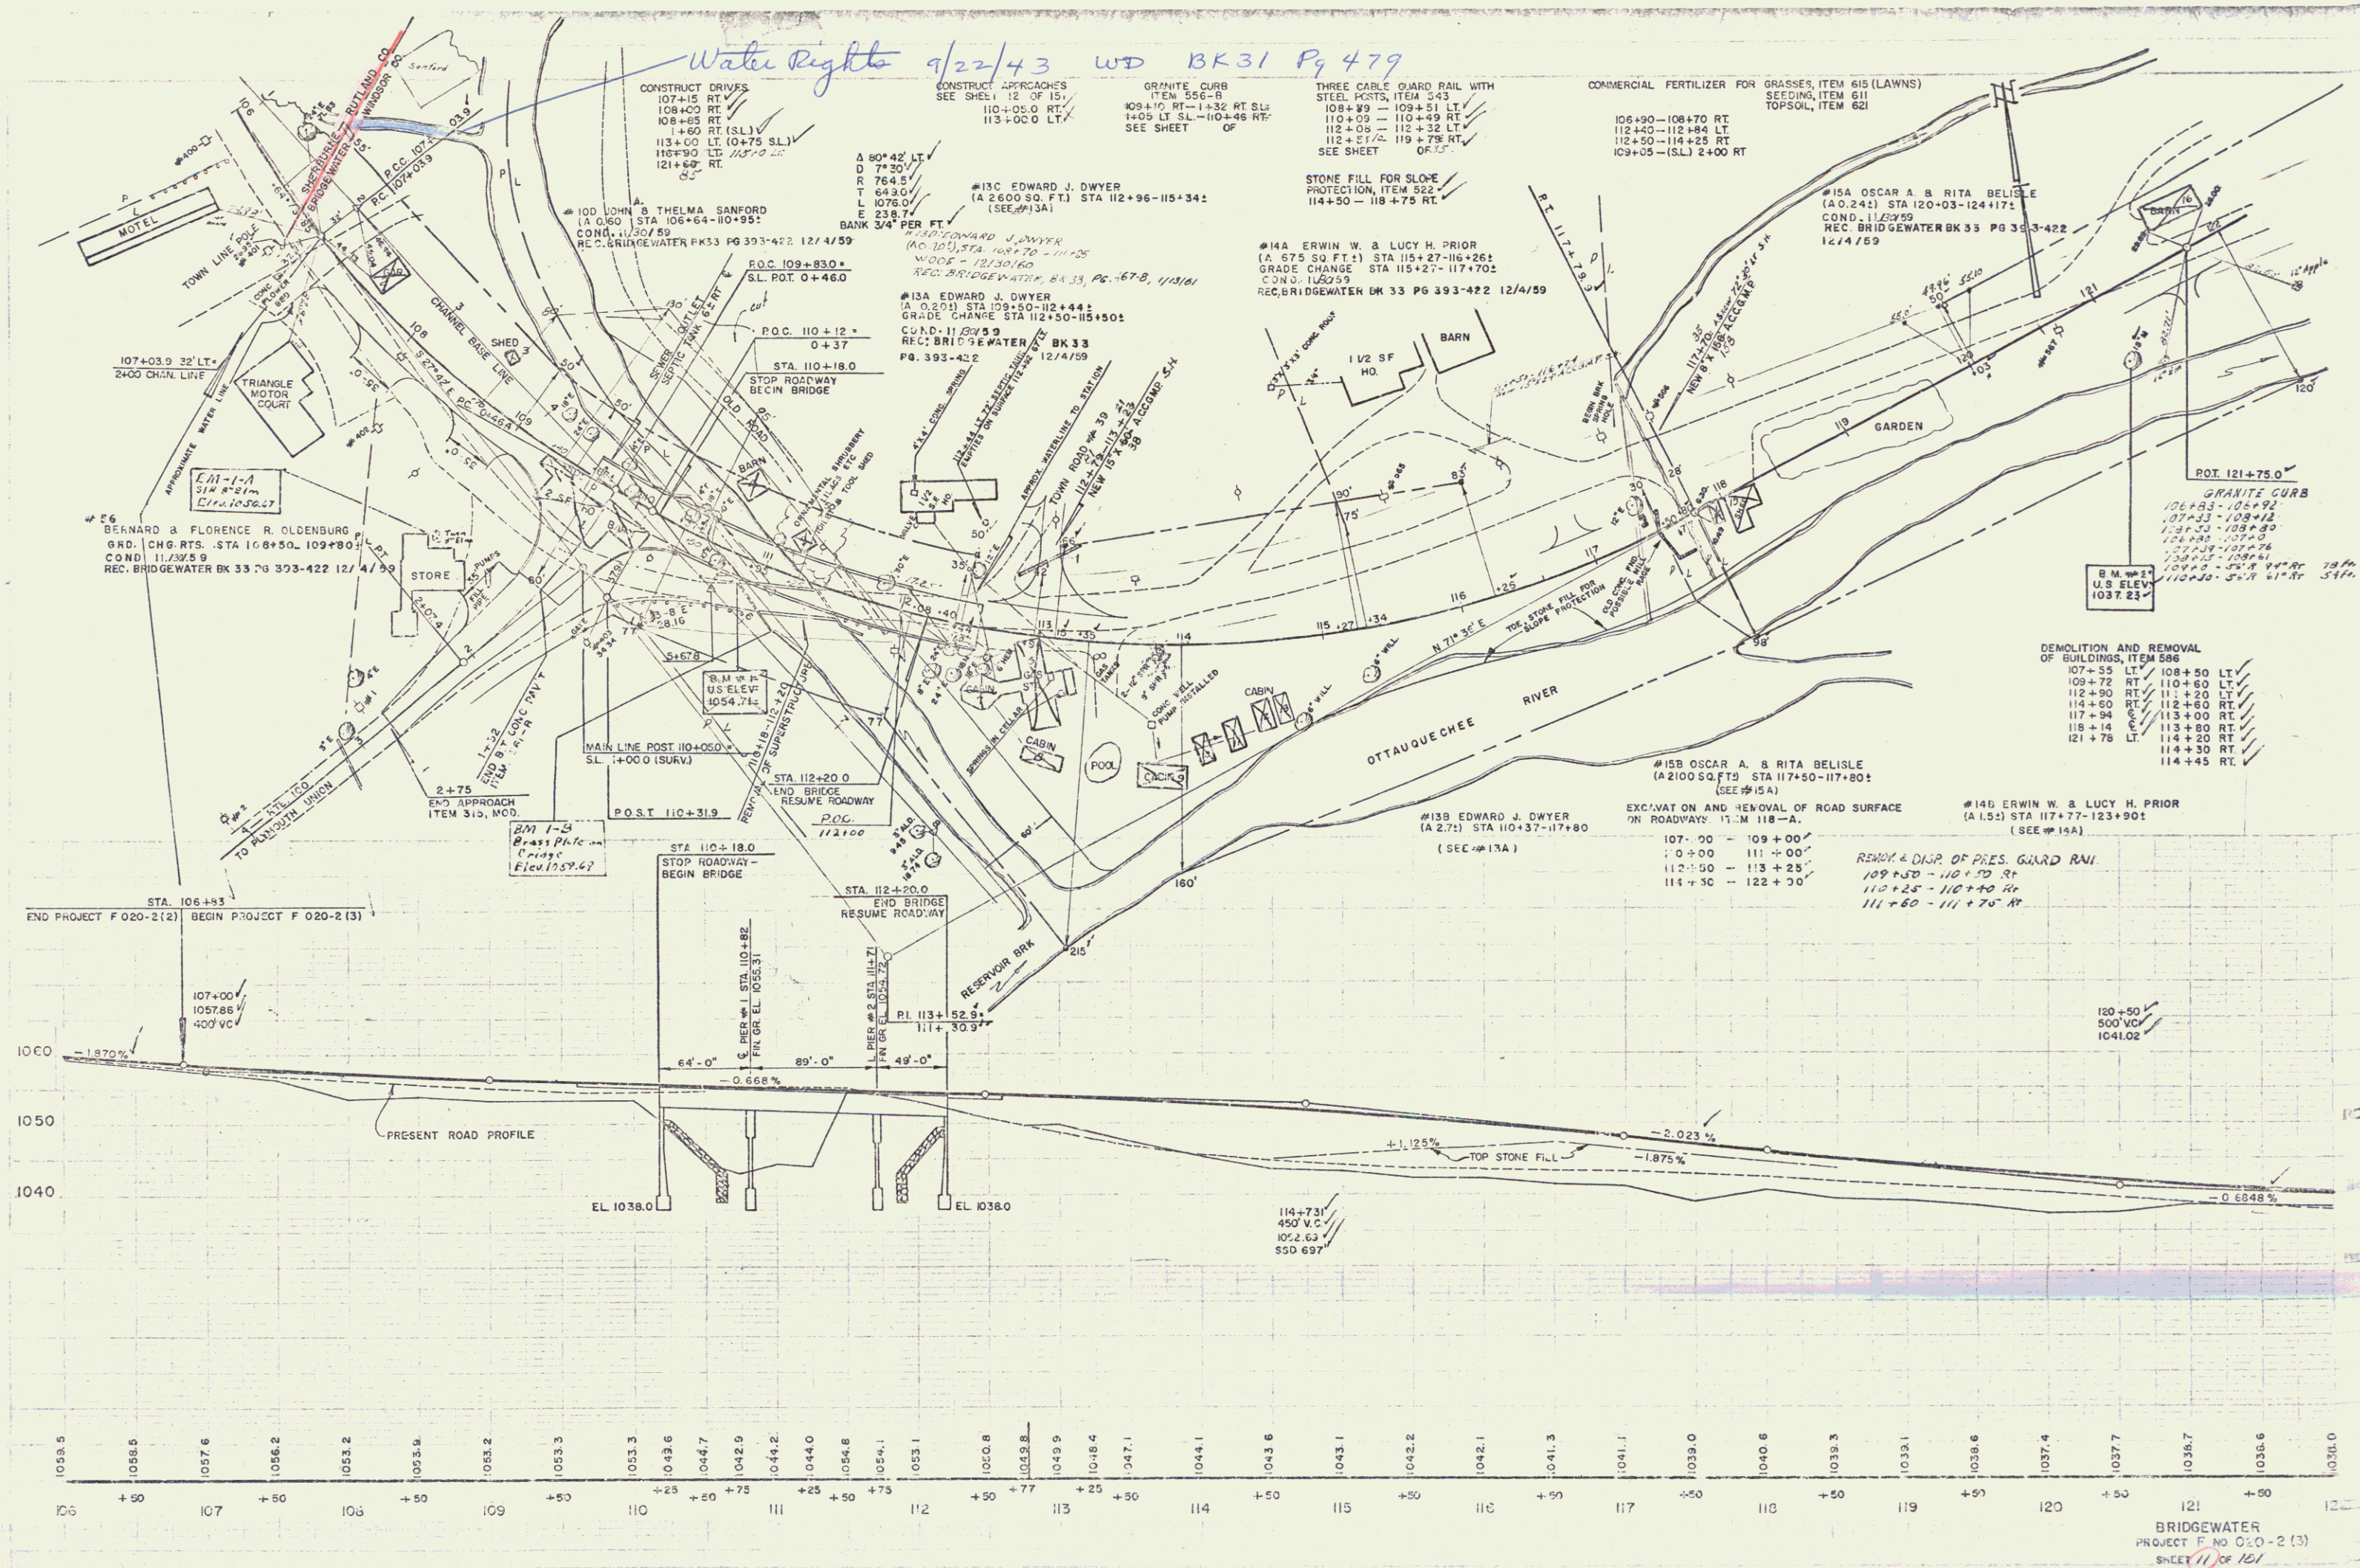

Surveyed by - Dr. J. J. ...
Plotted by - Conley

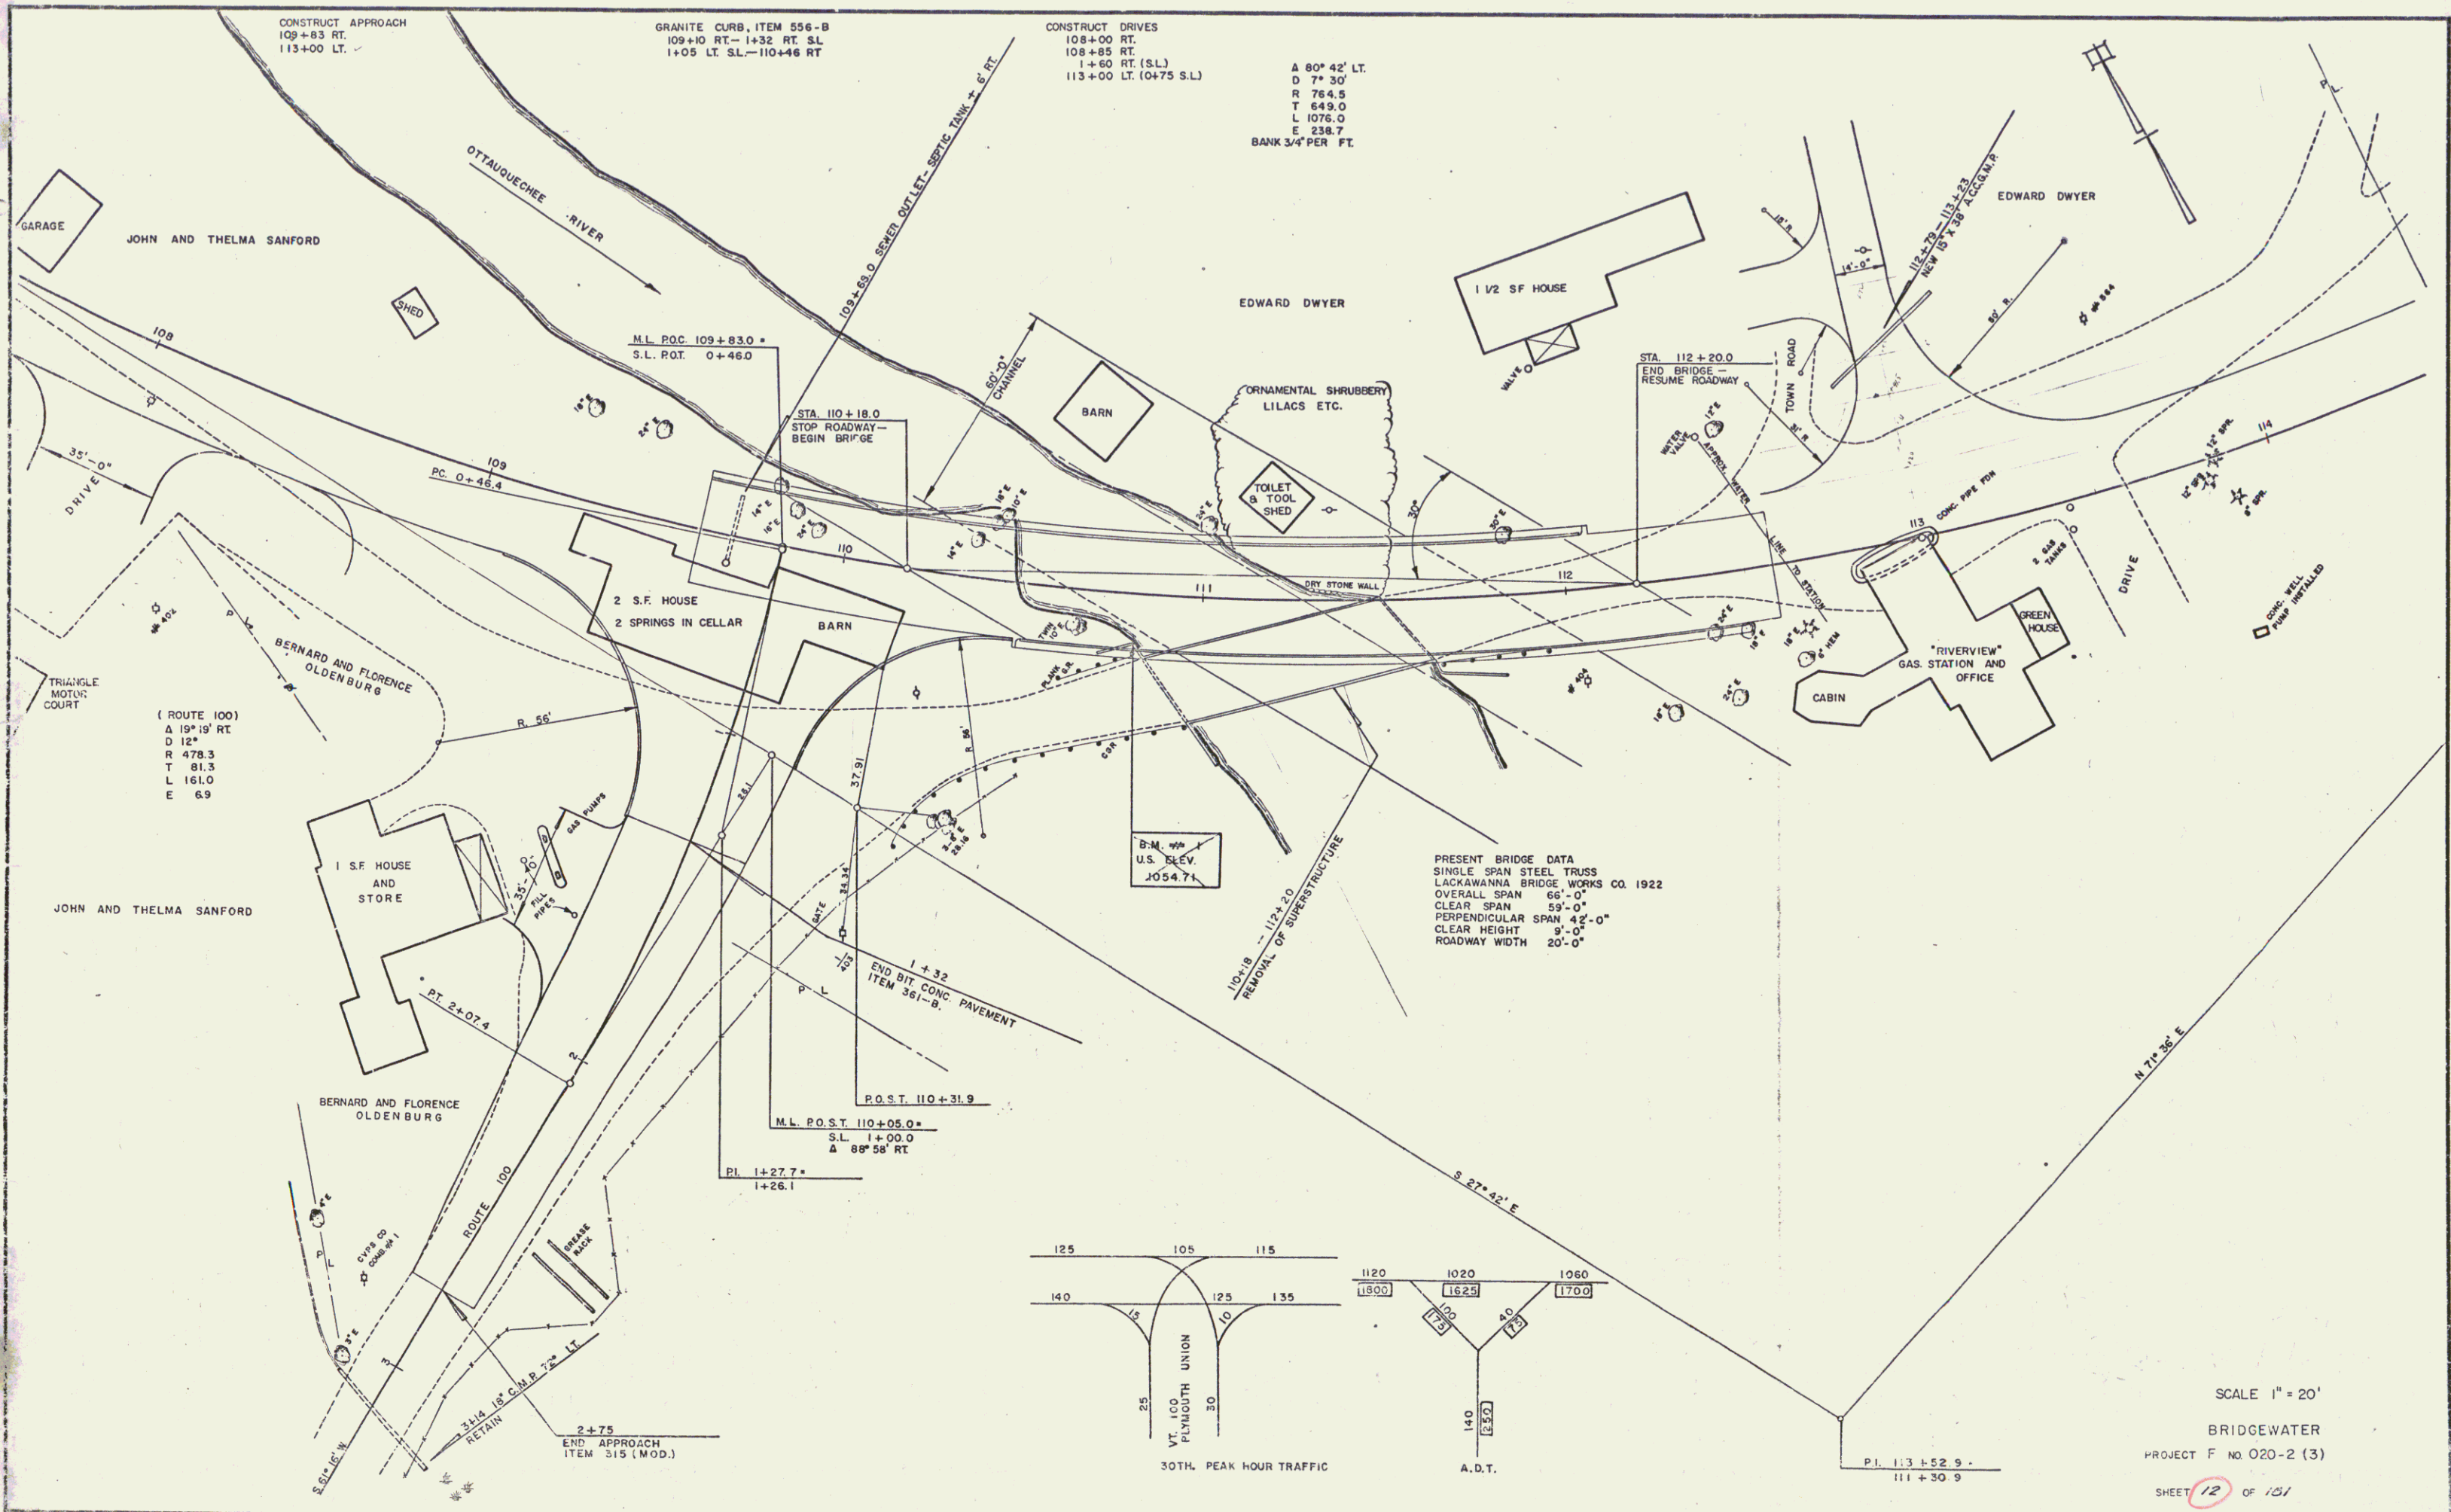



SCALE 1" = 20'

BRIDGEWATER

PROJECT F No. 020-2 (3)

SHEET 12 OF 101

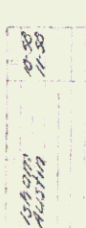

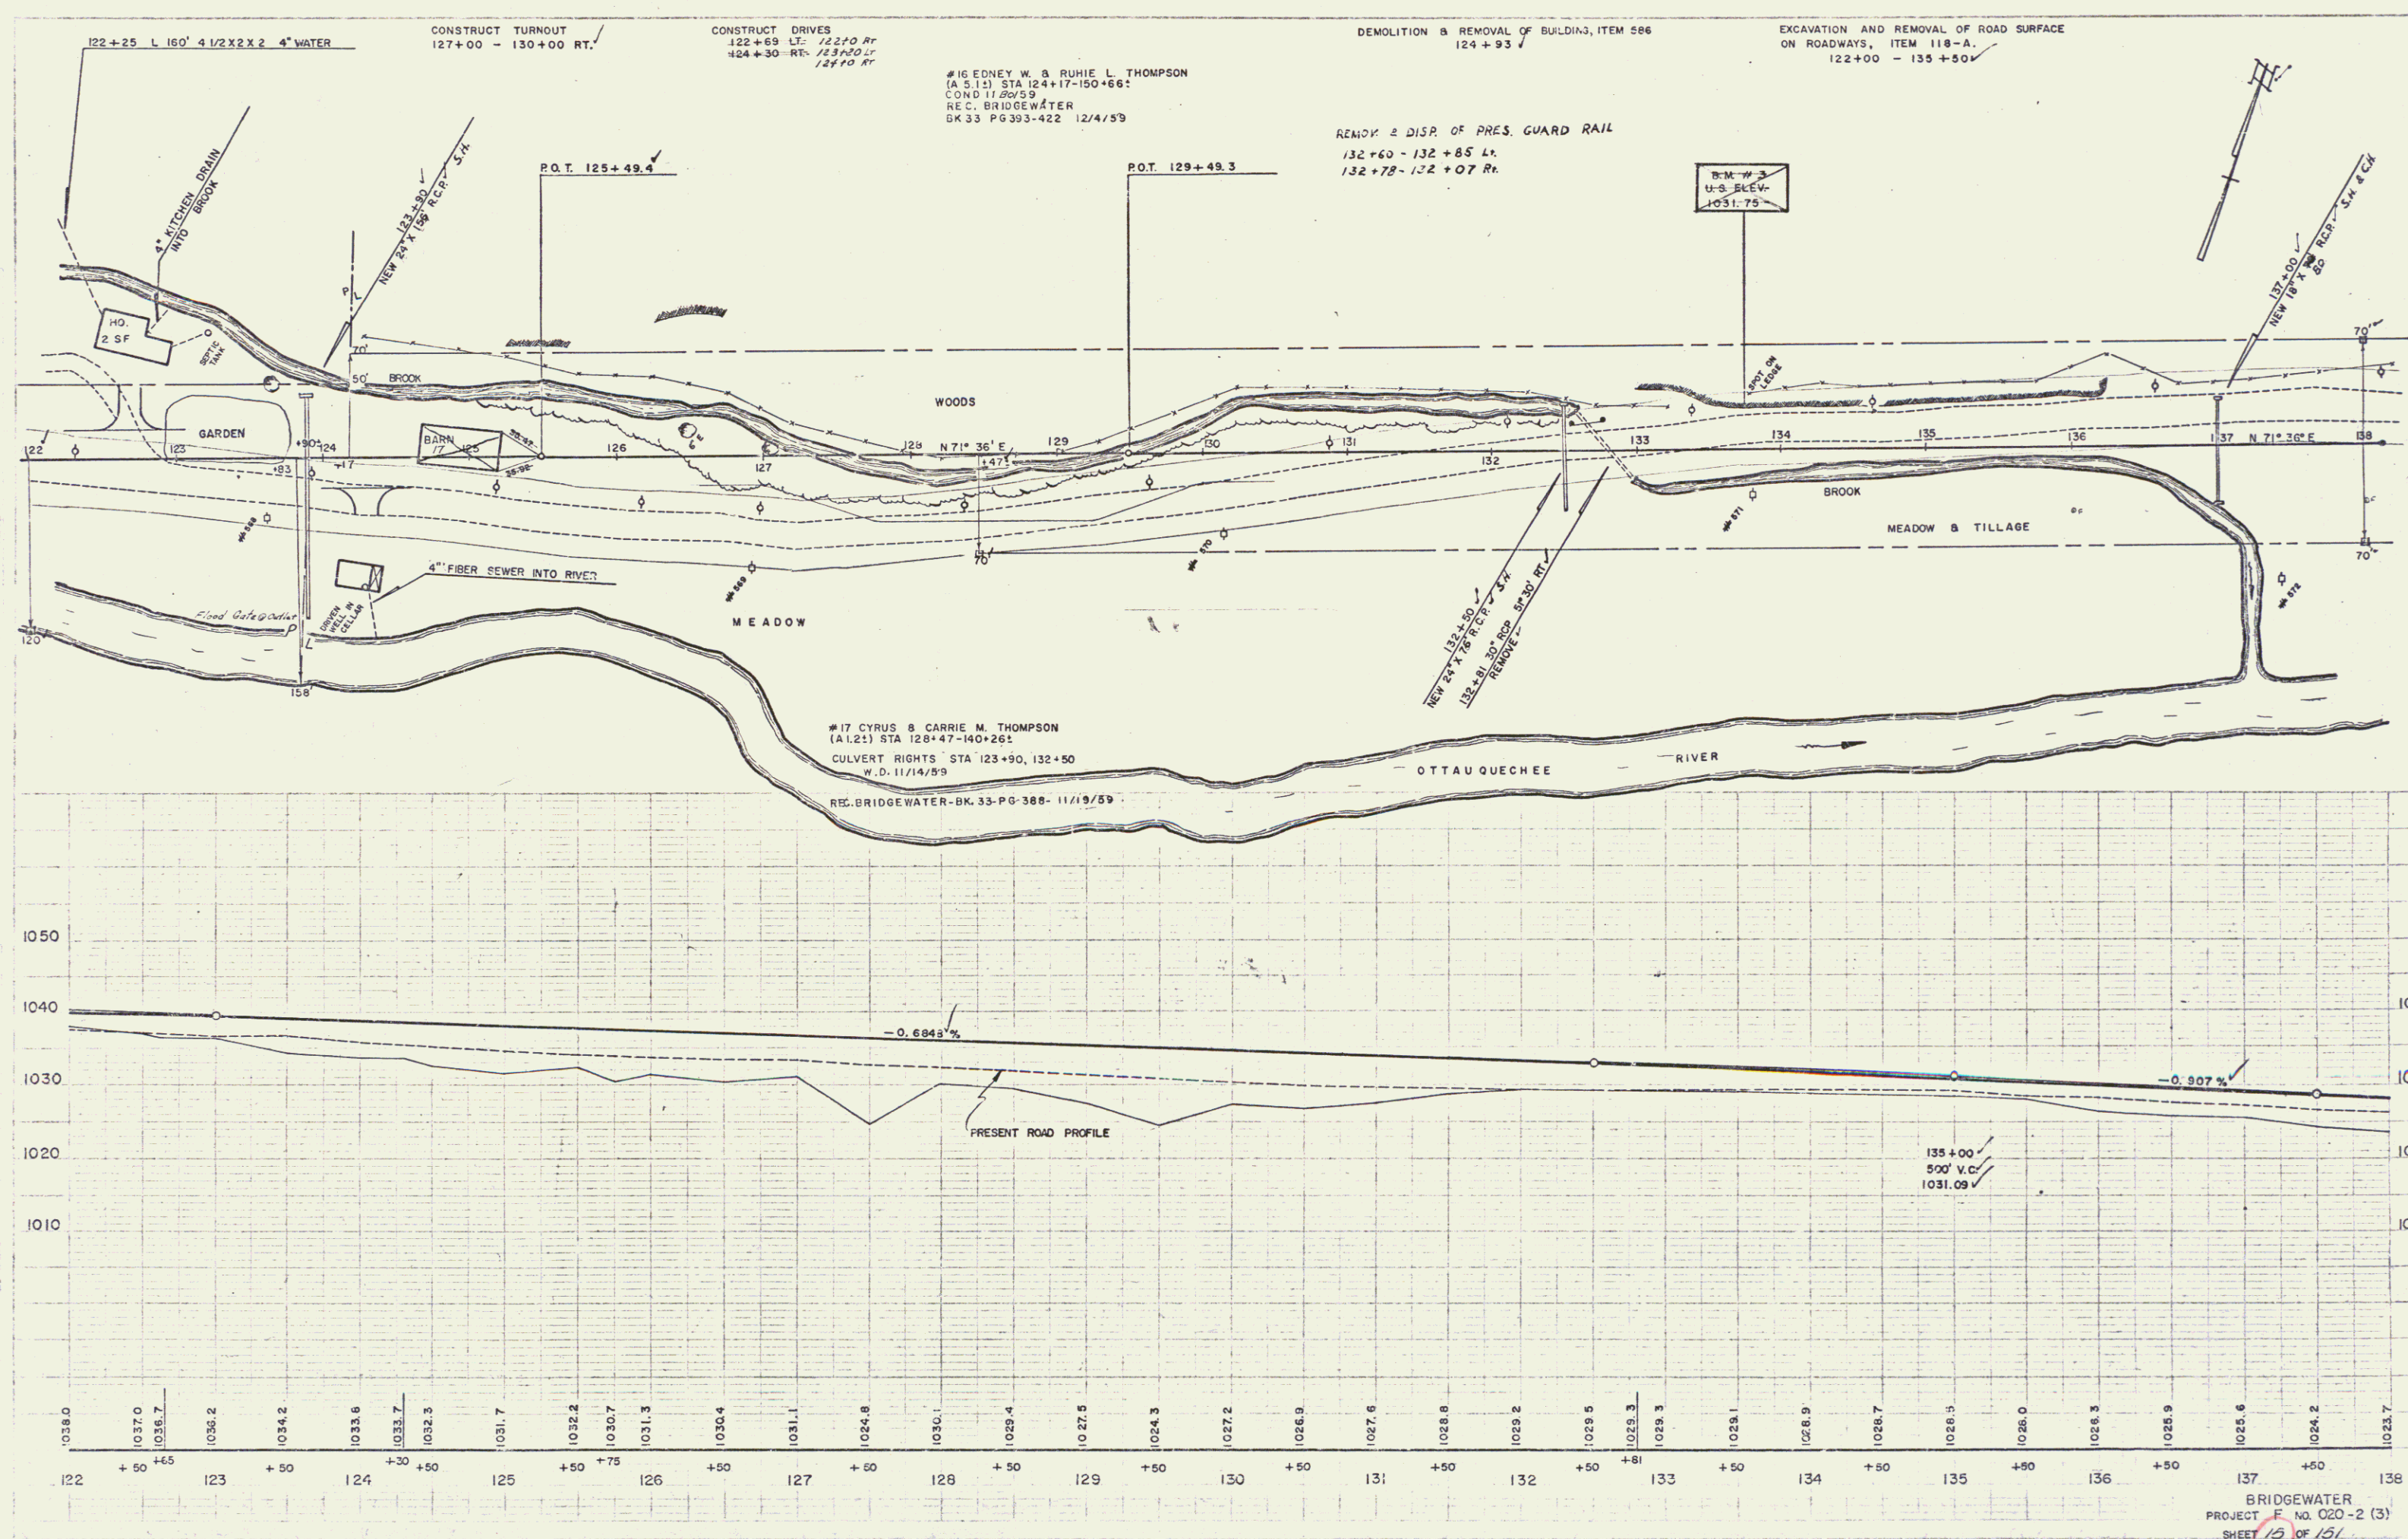

BRIDGEWATER
PROJECT F. NO. 020-2 (3)
SHEET 13 OF 151



DEMOLITION & REMOVAL OF
BUILDINGS, ITEM 586
174+35 RTV
182+50 L

CONSTRUCT DRIVE
175+50 LT & RT
183+00 RT
182+50 L


THREE CABLE GUARD RAIL WITH
STEEL POSTS, ITEM 543
170+00-171+50 RT
171+34-171+66 LT
172+26-172+38 RT
173+08-173+32 LT
174+55-174+79 RT
174+91-176+27 LT
176+71-184+80 LT

PLANK GUARD RAIL
176+50 LT 16'

#20 GEORGE H. & SARAH E. STEVENS
(A 271) STA 173+53-184+32
CULVERT RIGHTS STA 182+00, 178+50
COND 12/4/59
REC BRIDGEWATER BX 33-P4 358-422 12/4/59

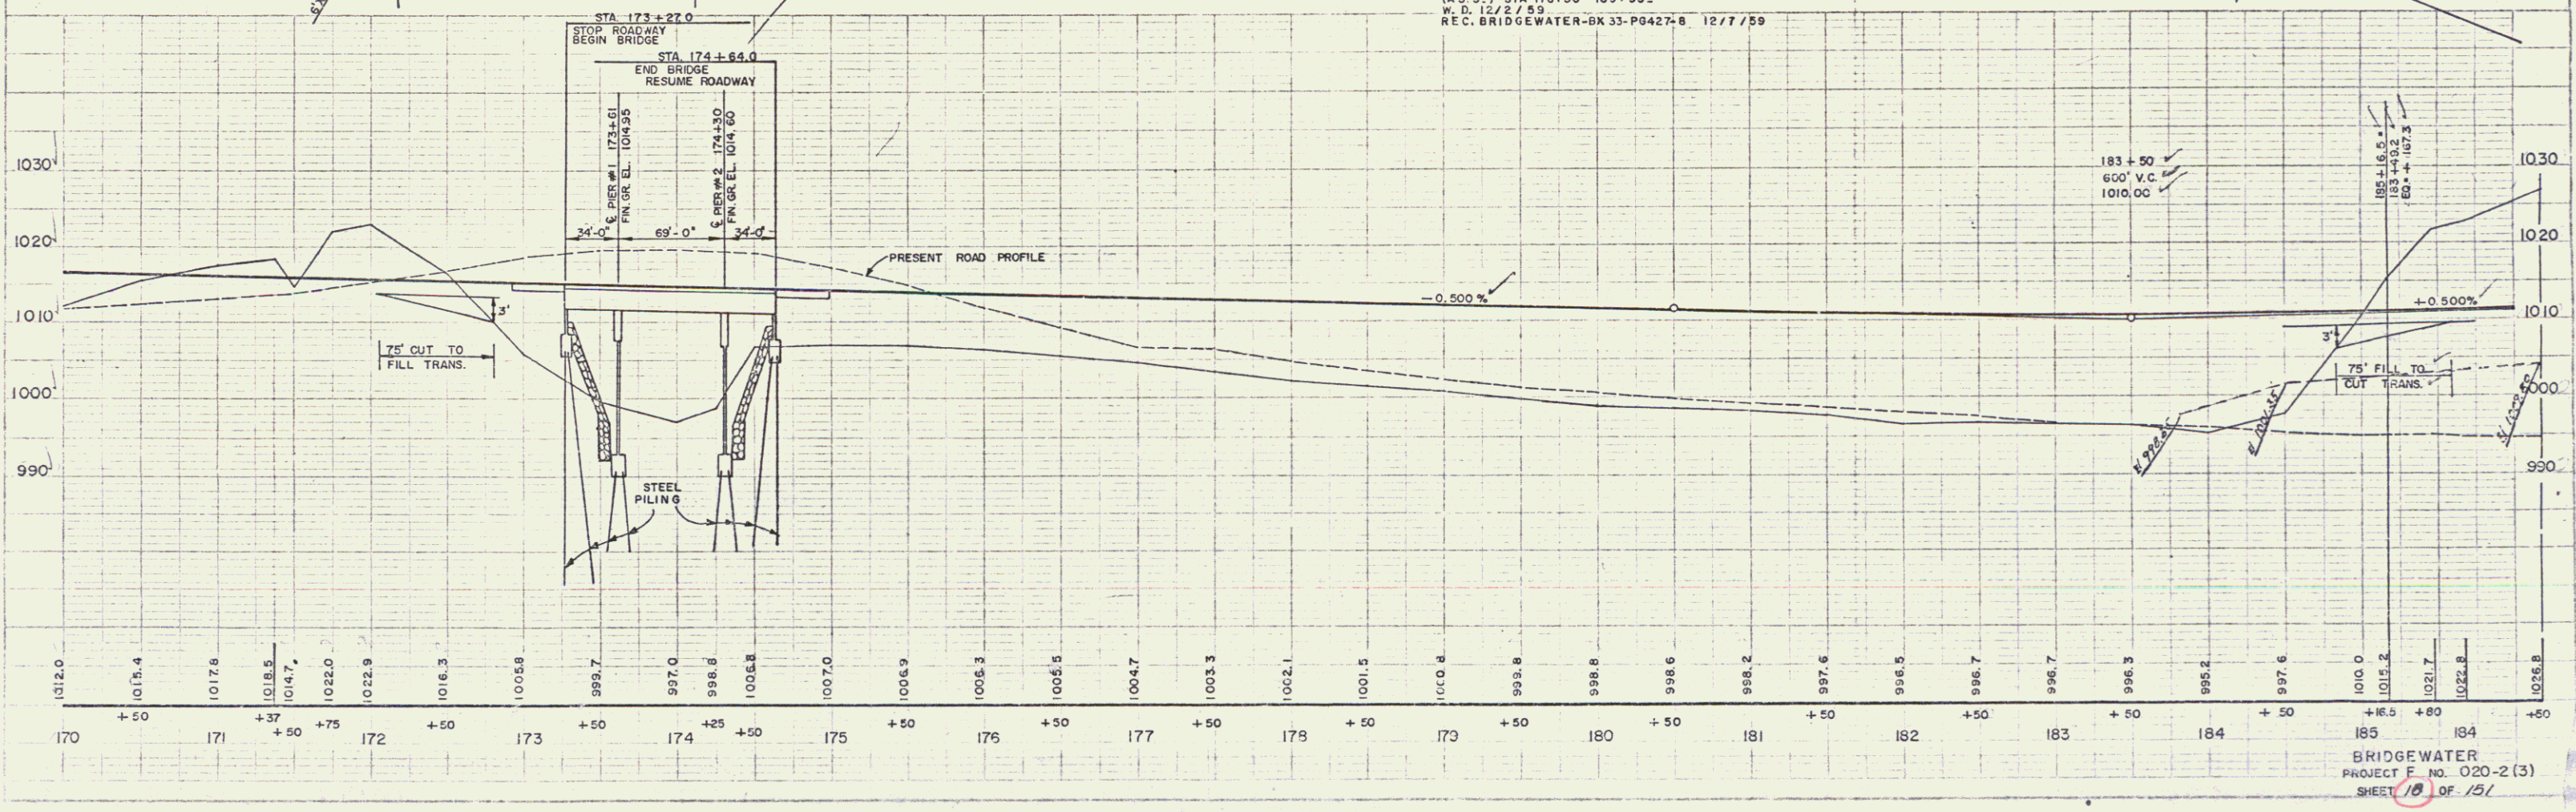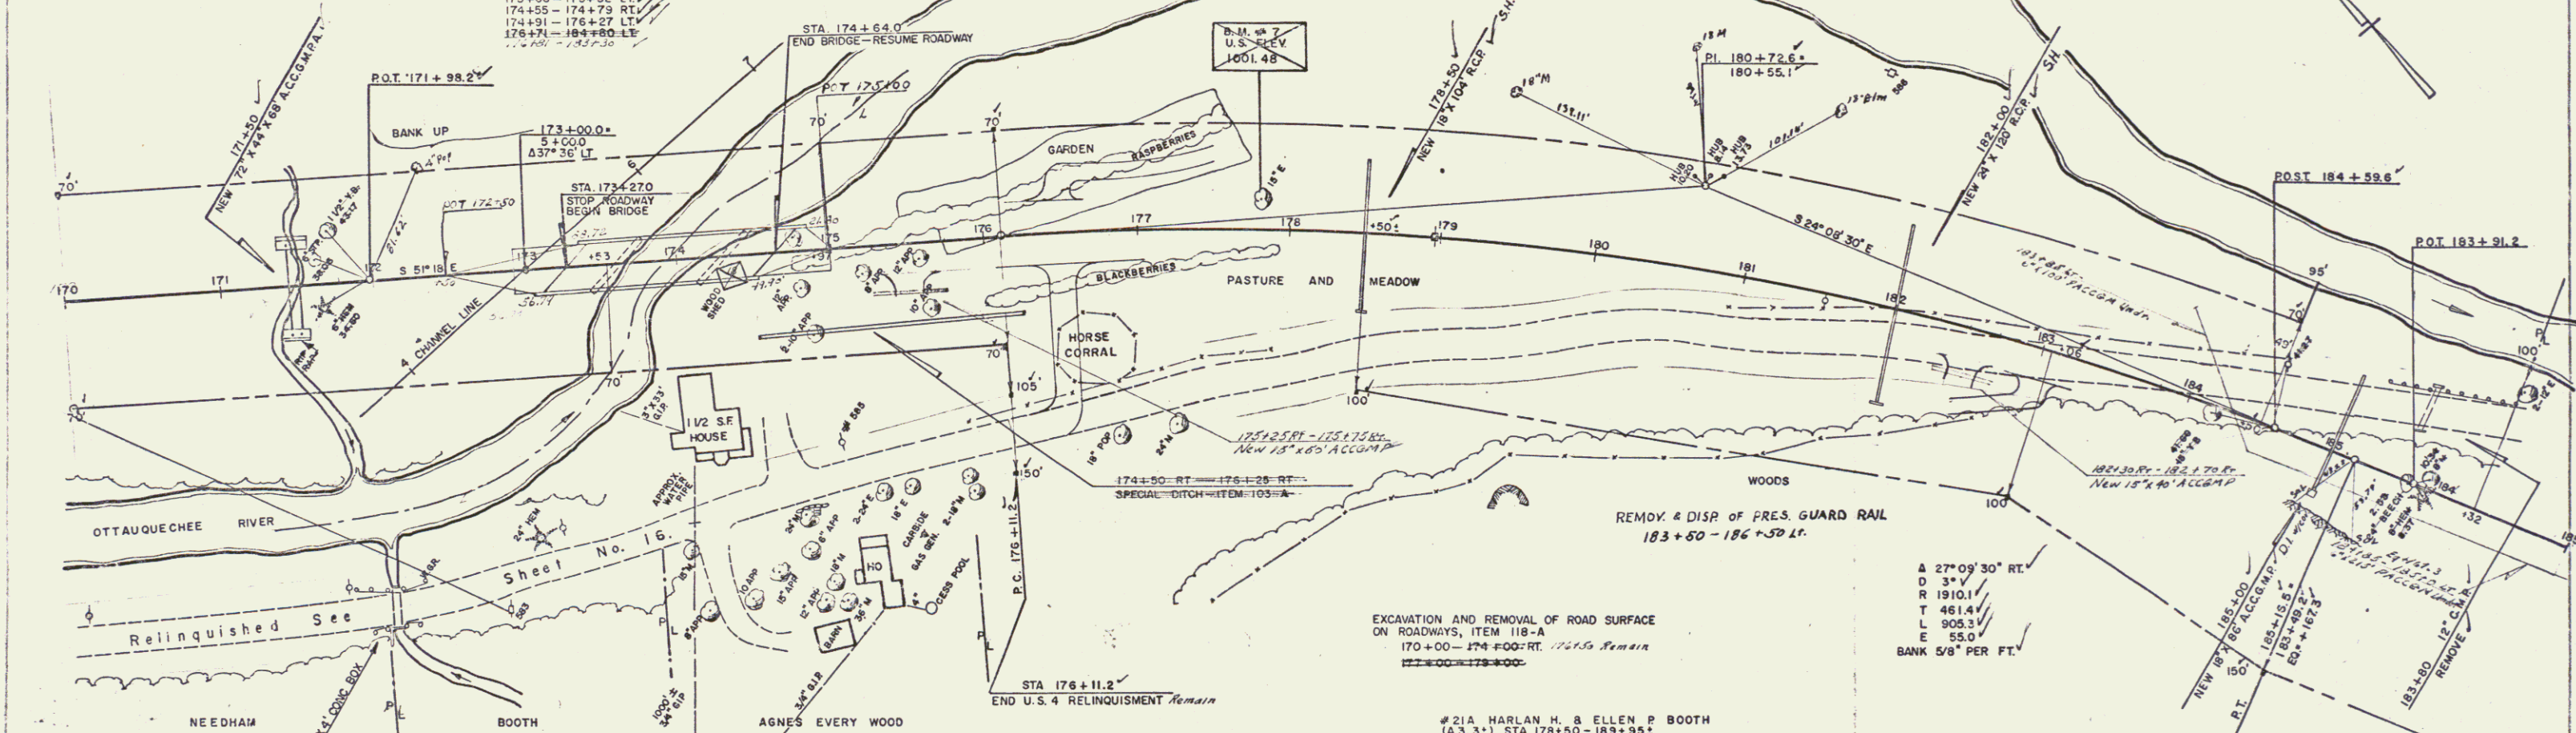

BRIDGEWATER
PROJECT E. NO. 020-2(3)
SHEET 10 OF 15

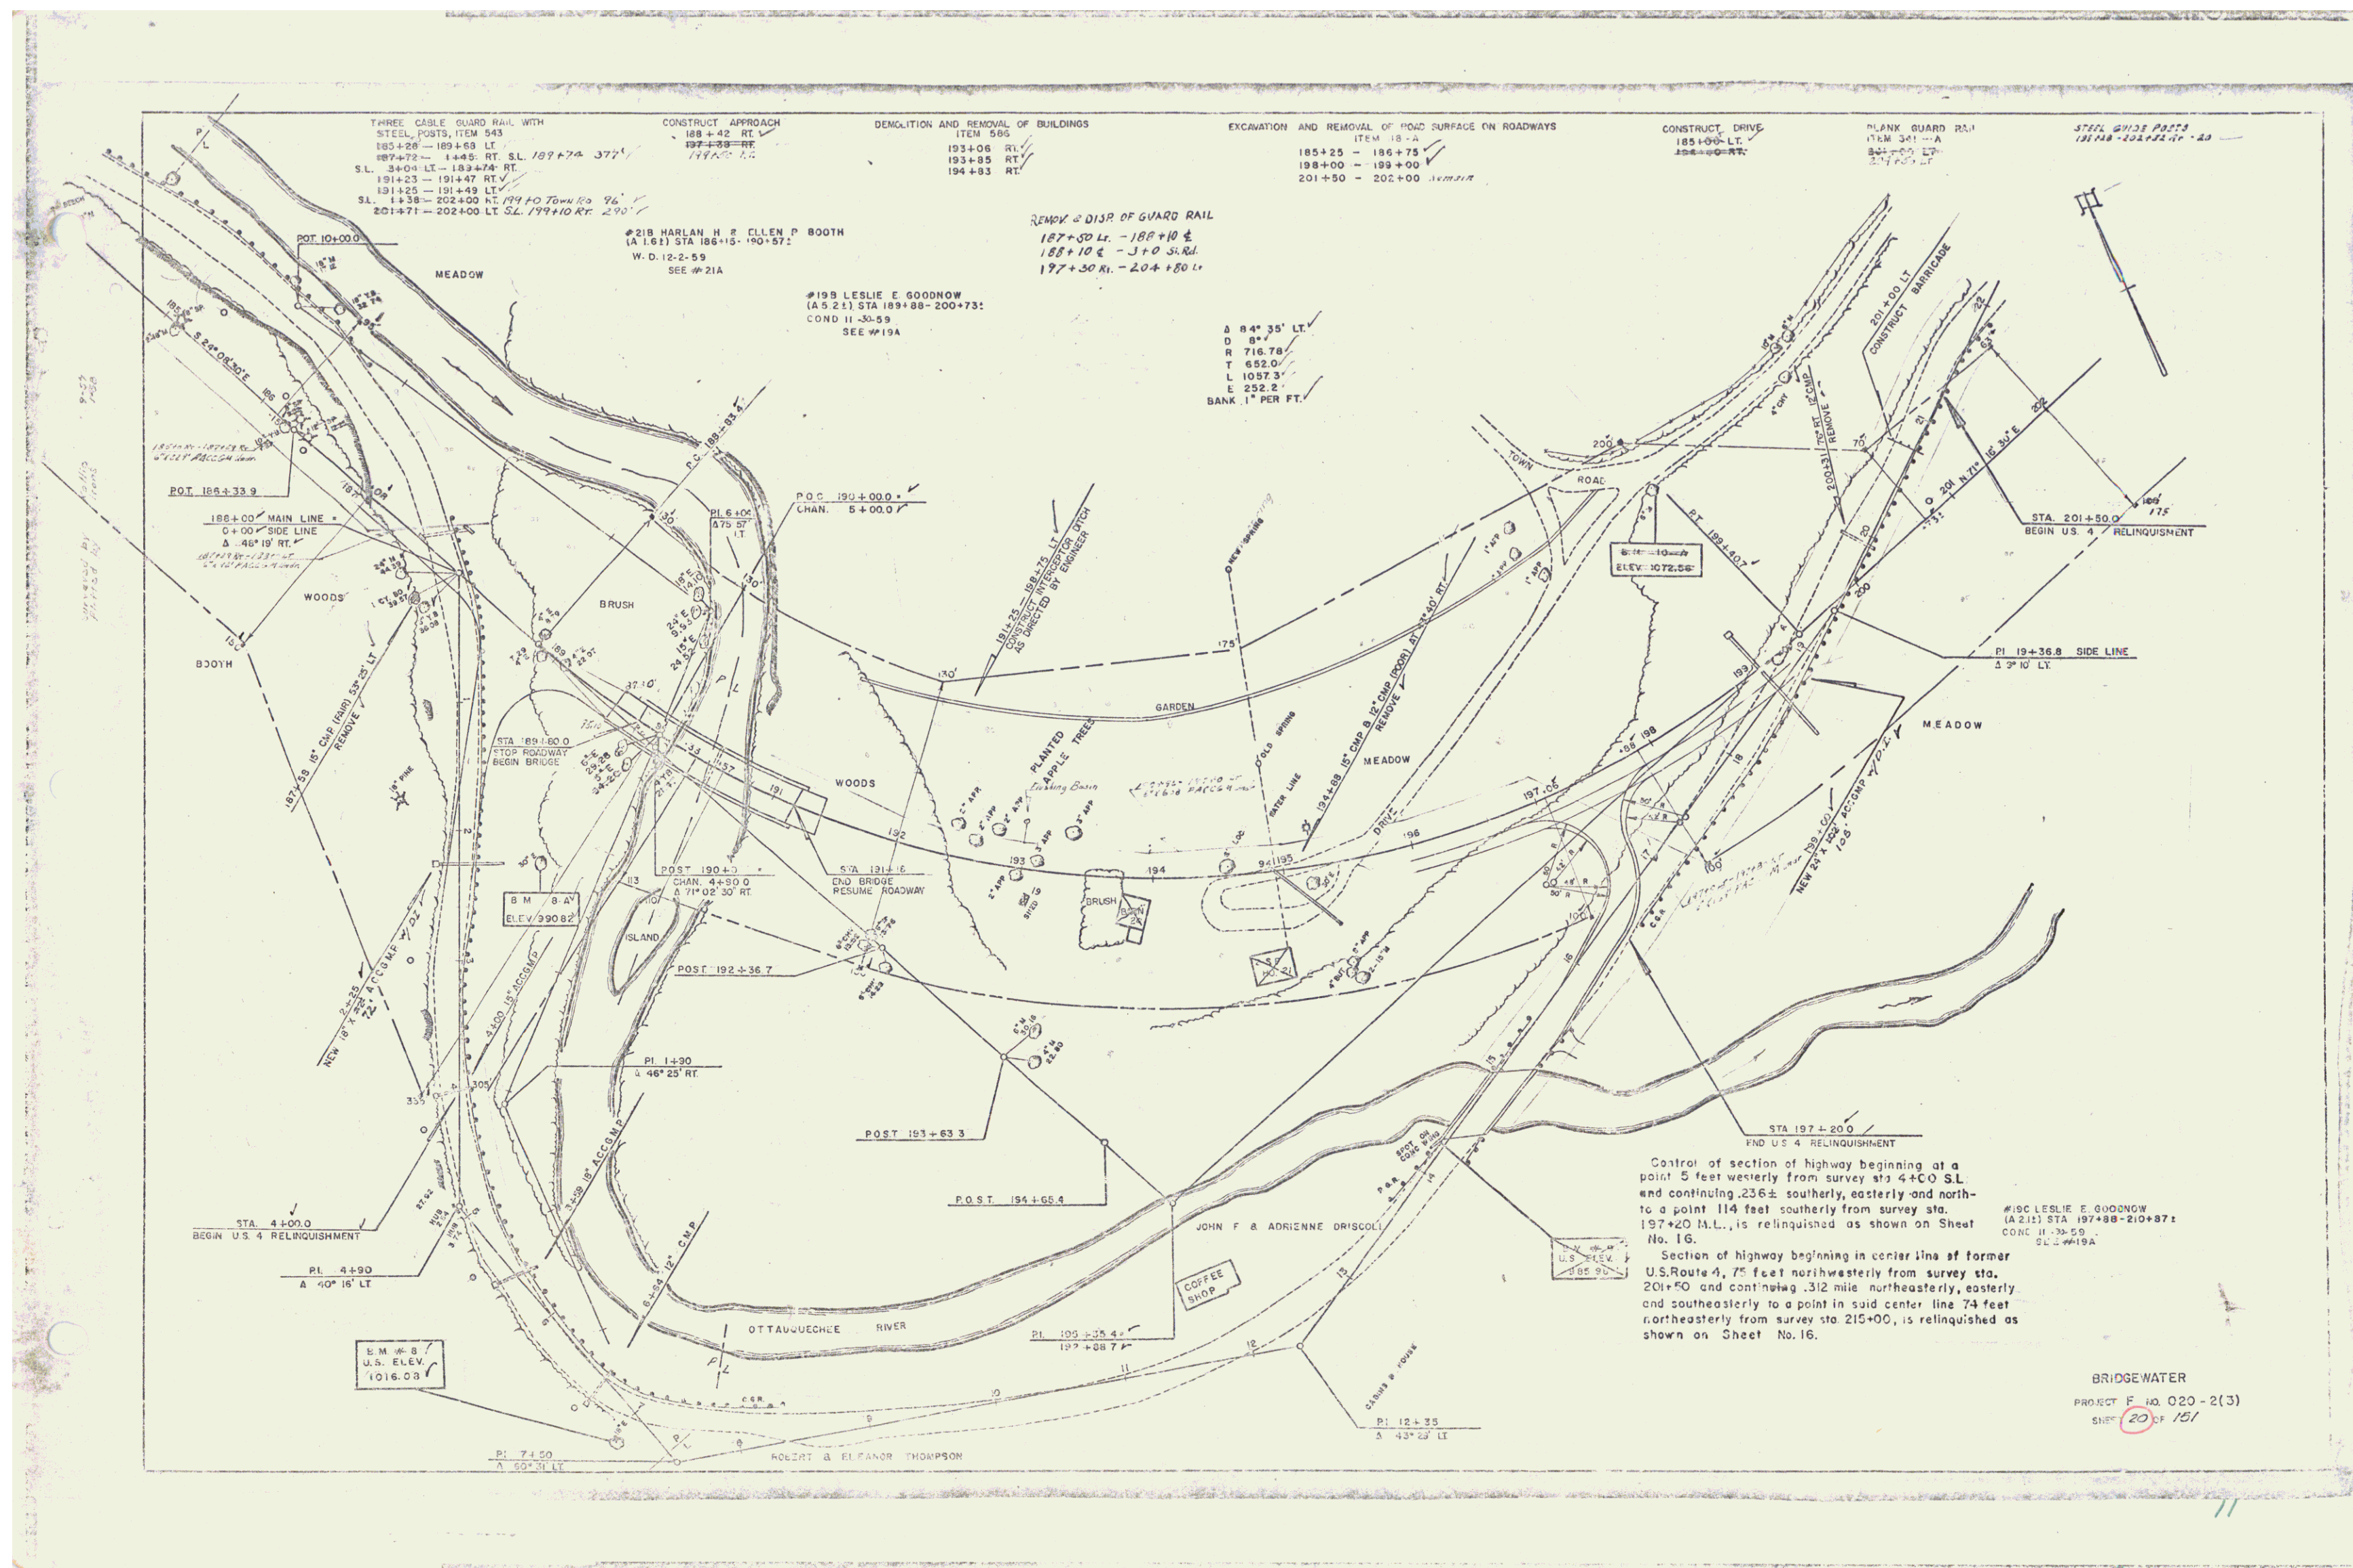

UNCLASSIFIED CHANNEL EXCAVATION, ITEM 106
203+00 - 216+25 RT.

EXCAVATION AND REMOVAL OF ROAD SURFACE ON ROADWAYS
ITEM 119-A
202+00 - 212+00 LT.

THREE CABLE GUARD RAIL WITH STEEL POSTS
ITEM 543
202+00 - 216+00 RT.
202+00 - 204+00 LT.
203+00 - 213+05 LT.
GOODNOW


PLANK GUARD RAIL, ITEM 541-A
203+00 - 216+00 RT.
204+00 - 216+00 LT.
204+00 - 217+00 RT.

STONE FILL FOR SLOPE PROTECTION
ITEM 522
202+00 - 216+25 RT.
209+75 - 213+25 RT. (BACK SIDE)
214+00 - 217+00 RT.

HARLEY E. & ANNE M. HESELTON

CONSTRUCT APPROACH
214+25 LT.



STEEL GUIDE POSTS
203+15 - 213+05 LT. - 60

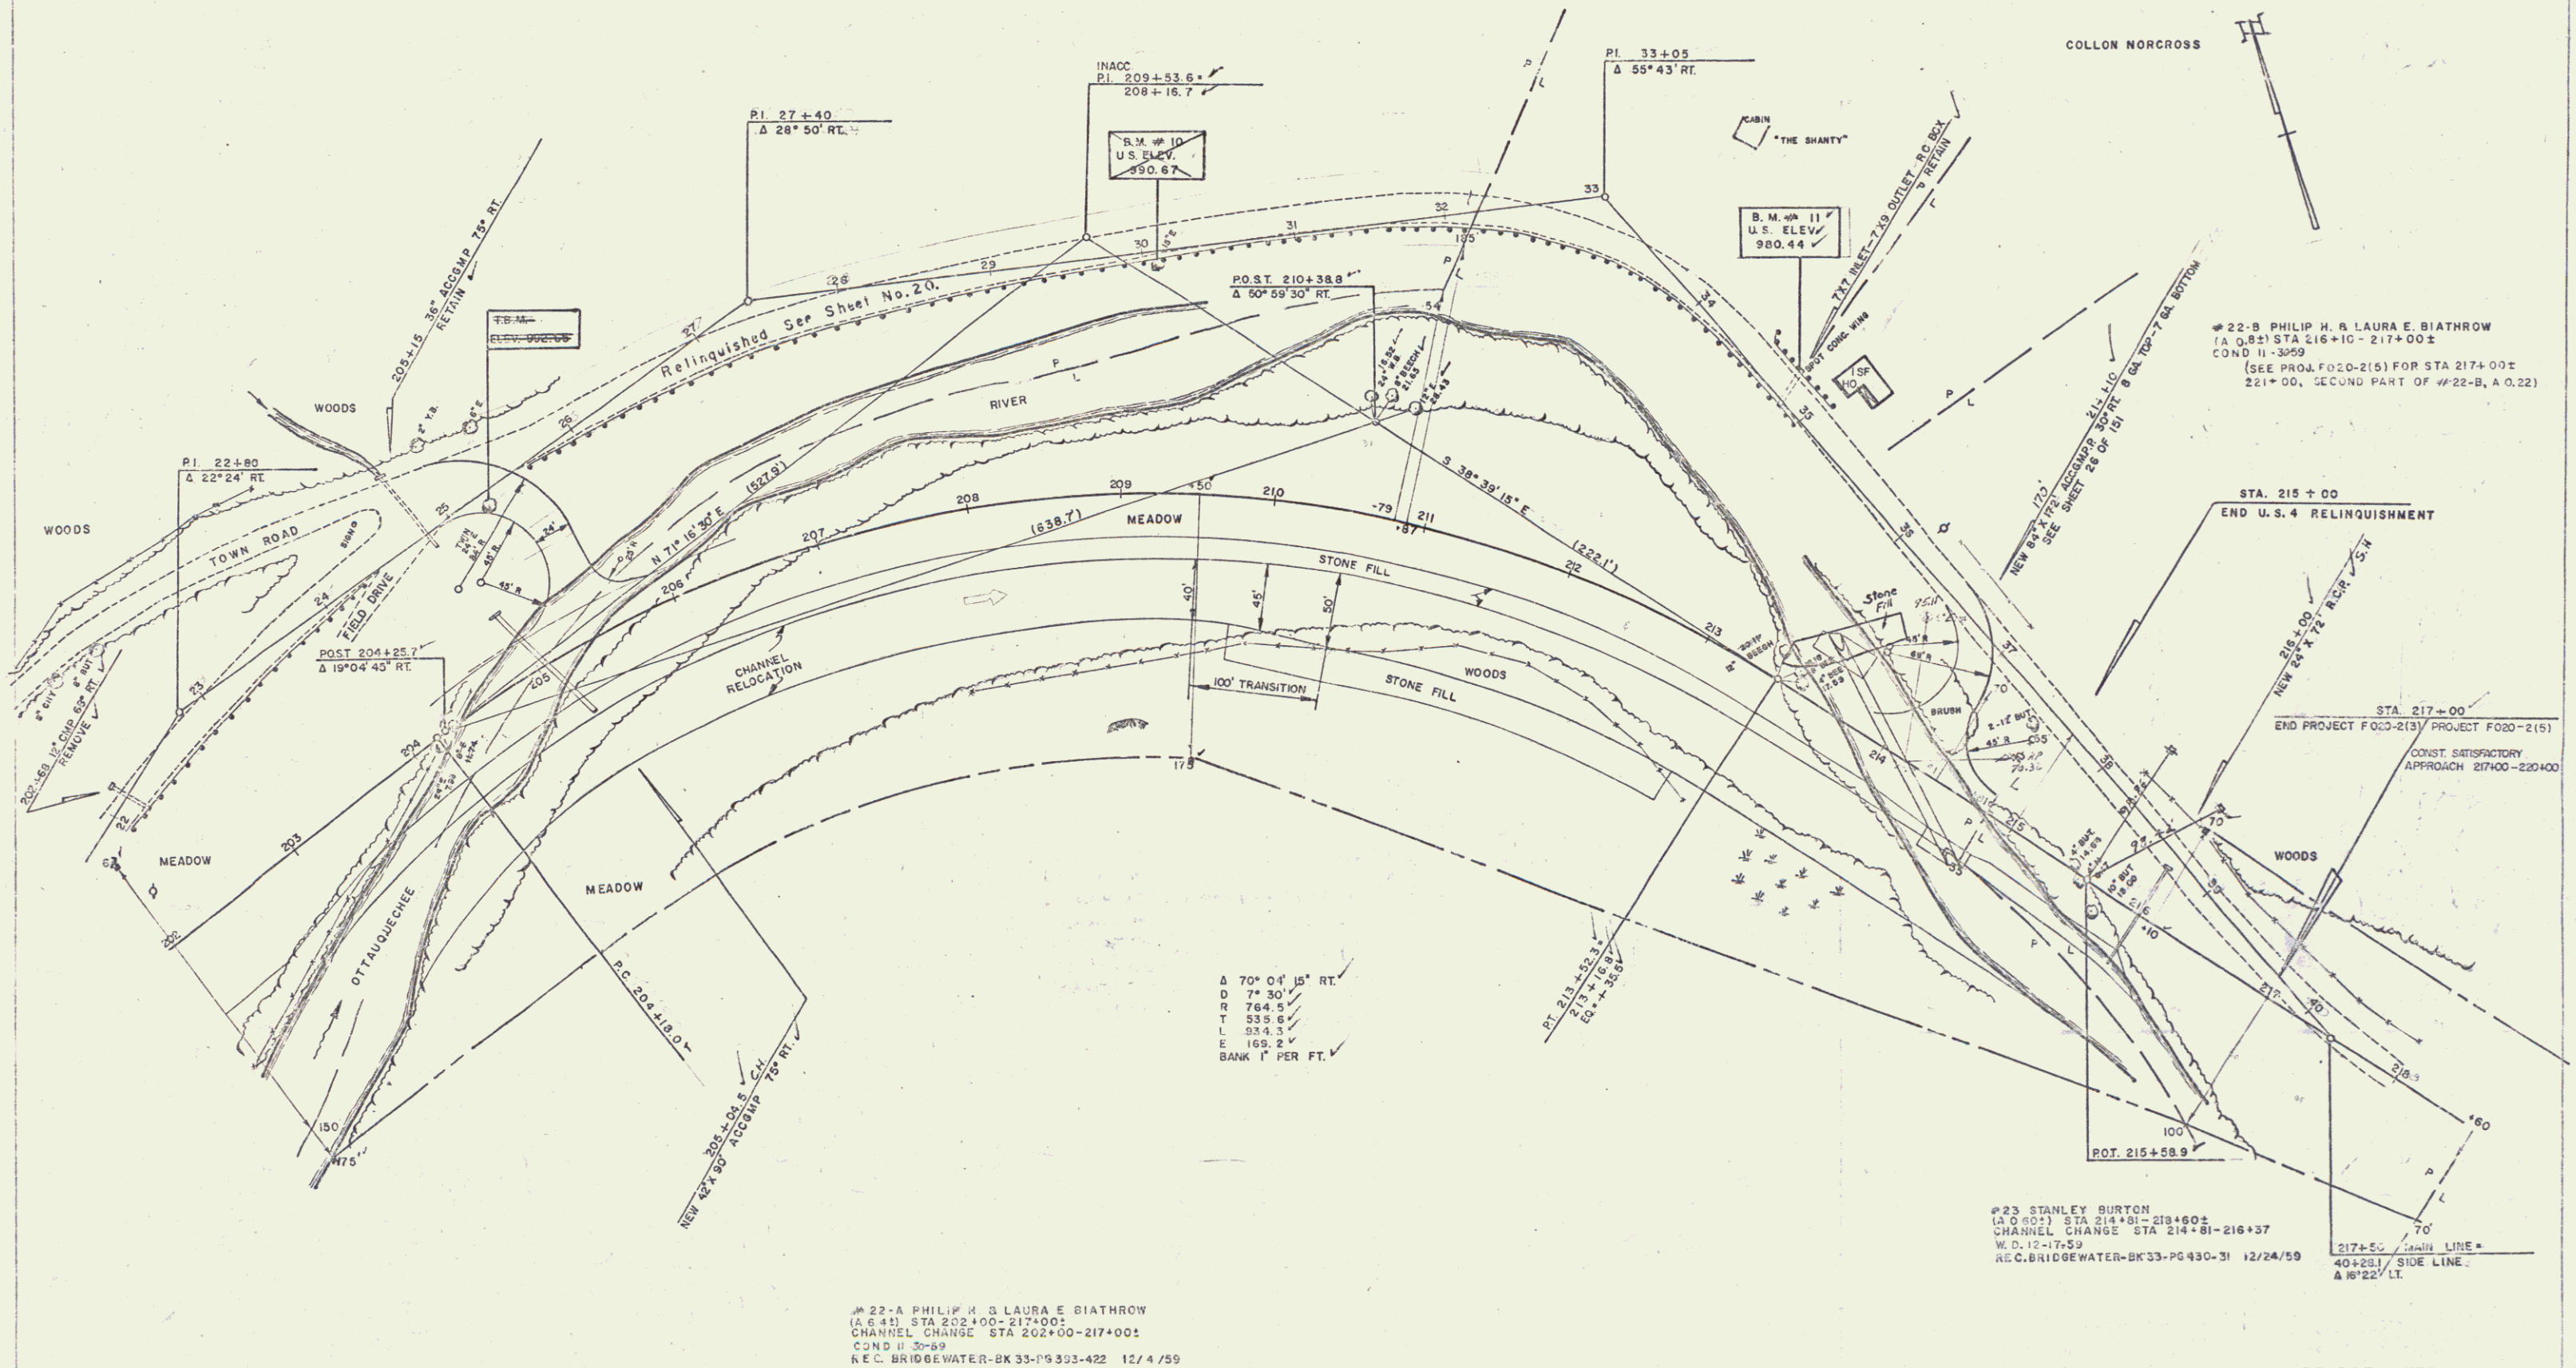

#22-A PHILIP H. & LAURA E. BIATHROW
(A 644) STA 202+00 - 217+00
CHANNEL CHANGE STA 202+00 - 217+00
COND II 3099
REC. BRIDGEWATER-BK 33-PG 333-422 12/4/59

#23 STANLEY BURTON
(A 644) STA 214+81 - 218+80
CHANNEL CHANGE STA 214+81 - 218+37
W.D. 12-17-59
REC. BRIDGEWATER-BK 33-PG 430-31 12/24/59

BRIDGEWATER
PROJECT F NO. 020-2(3)
SHEET 22 OF 151

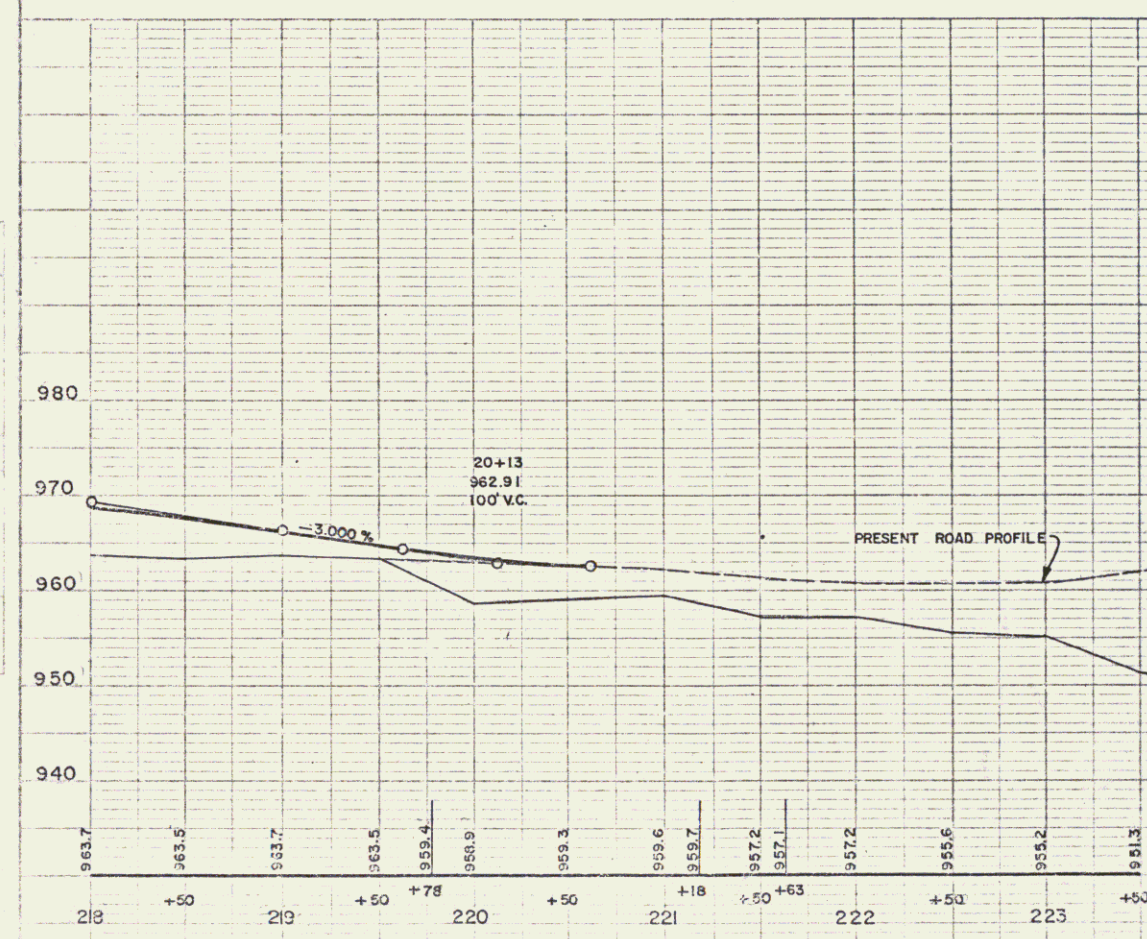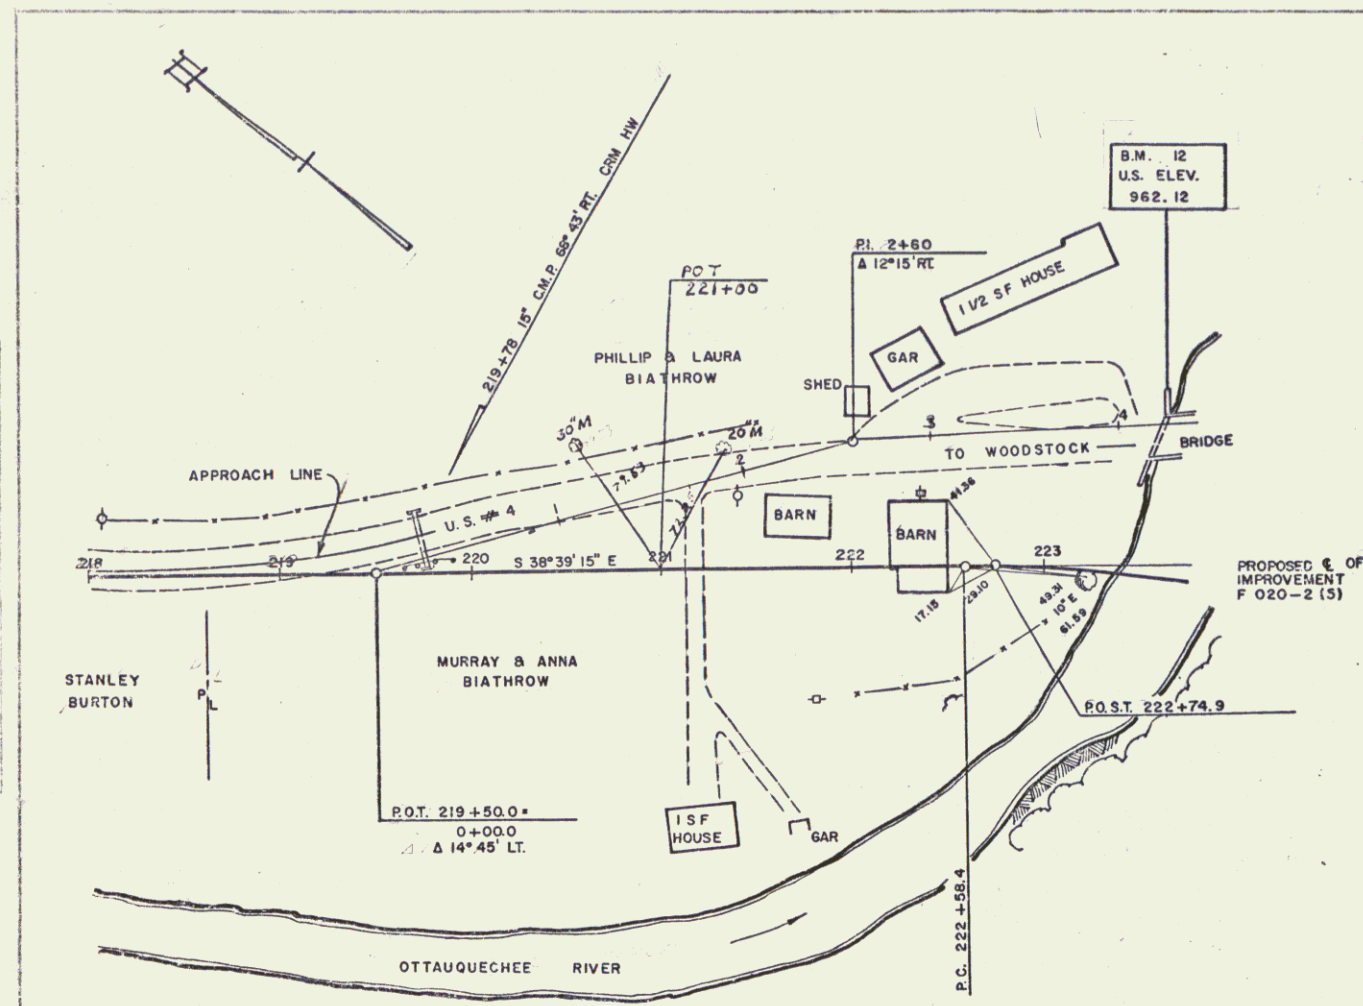

BRIDGEWATER
PROJECT F NO. 020-2 (3)
SHEET 24 OF 151