

SHT.	TITLE	PAGE
2 BR 101	PLAN AND PROFILE	
3	102 QUANTITY SHEET	
4	103 PLAN AND ELEVATION	
5	104 SUPERSTRUCTURE DETAILS	
6	105 ABUTMENT #1	
7	106 ABUTMENT #2	
8	107 REINFORCING SCHEDULE	
9-10	108-9 CHANNEL SECTIONS	
11-14	110-13 ROADWAY SECTIONS	


15	200 PLAN AND PROFILE
16	201 QUANTITY SHEET
17	202 PLAN AND ELEVATION
18	203 SUPERSTRUCTURE DETAILS
19	204 ABUTMENTS #1 & #2
20	205 REINFORCING SCHEDULE
21-22	206-7 CHANNEL SECTIONS
23-24	208-9 ROADWAY SECTIONS
25	STD. SHT. G-3 9-1-66 R
26	STD. SHT. E-33 1-6-67
27	STD. SHT. SCB-D6-67 1-24-68
28	STD. SHT. E-36 1-24-68
29-31	RIGHT OF WAY SHEETS

STATE OF VERMONT DEPARTMENT OF HIGHWAYS



PROPOSED IMPROVEMENT

BRIDGE PROJECT TOWN OF WOODSTOCK COUNTY OF WINDSOR US RTE. 4

PROJECT CONSISTS OF TWO SEPARATE STRUCTURES LOCATED AS FOLLOWS: BEGINNING AT A POINT 1.20 MILES EAST OF THE INTERSECTION OF US RTE. 4 AND THE BRIDGEWATER-WOODSTOCK TOWN LINE EXTENDING WESTERLY 0.198 MILES ALONG US RTE 4 IN THE TOWN OF WOODSTOCK AND BEGINNING AT A POINT 3.40 MILES EAST OF THE INTERSECTION OF U.S. RTE. 4 AND THE BRIDGEWATER-WOODSTOCK TOWN LINE EXTENDING EASTERLY 0.038 MILES ALONG US RTE. 4 IN THE TOWN OF WOODSTOCK.

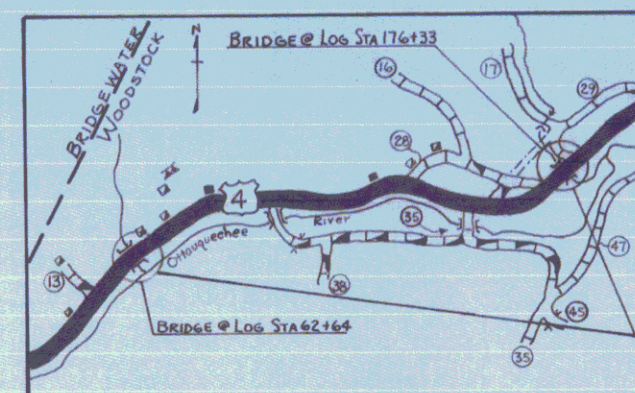

Log Sta. 62+64	LENGTH OF CONTRACT: 50.0 FT. = 0.009 MI.
	LENGTH OF ROADWAY: 1000.0 FT. = 0.189 MI.
	LENGTH OF PROJECT: 1050.0 FT. = 0.198 MI.
Log Sta. 176+33	LENGTH OF CONTRACT: 50.0 FT. = 0.009 MI.
	LENGTH OF ROADWAY: 150.0 FT. = 0.028 MI.
	LENGTH OF PROJECT: 200.0 FT. = 0.038 MI.

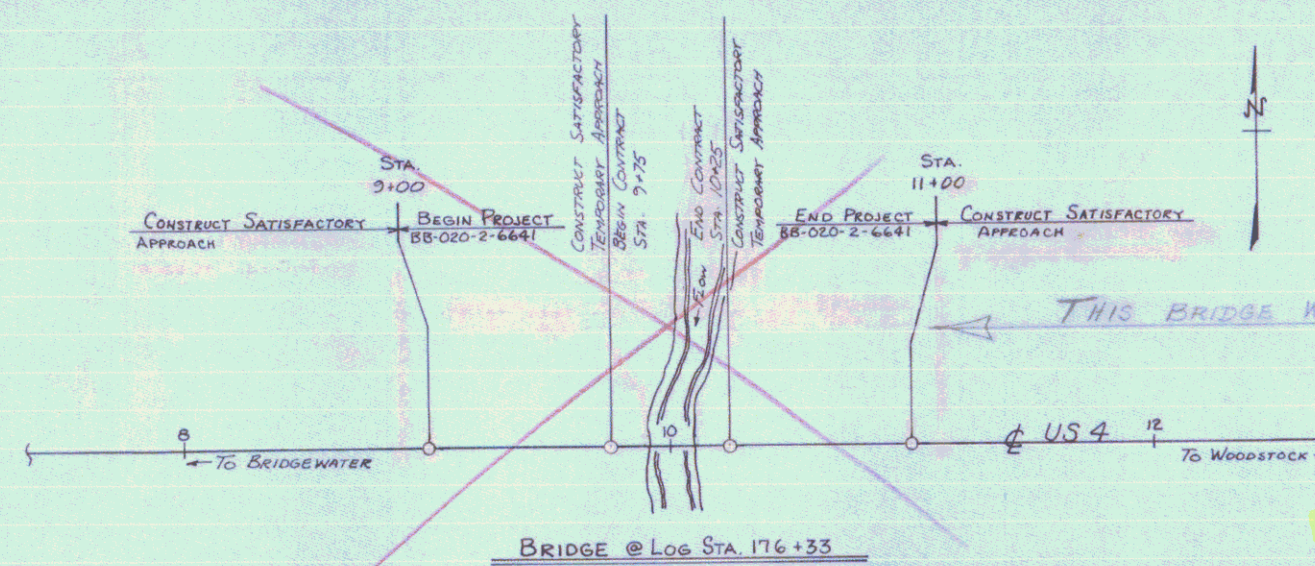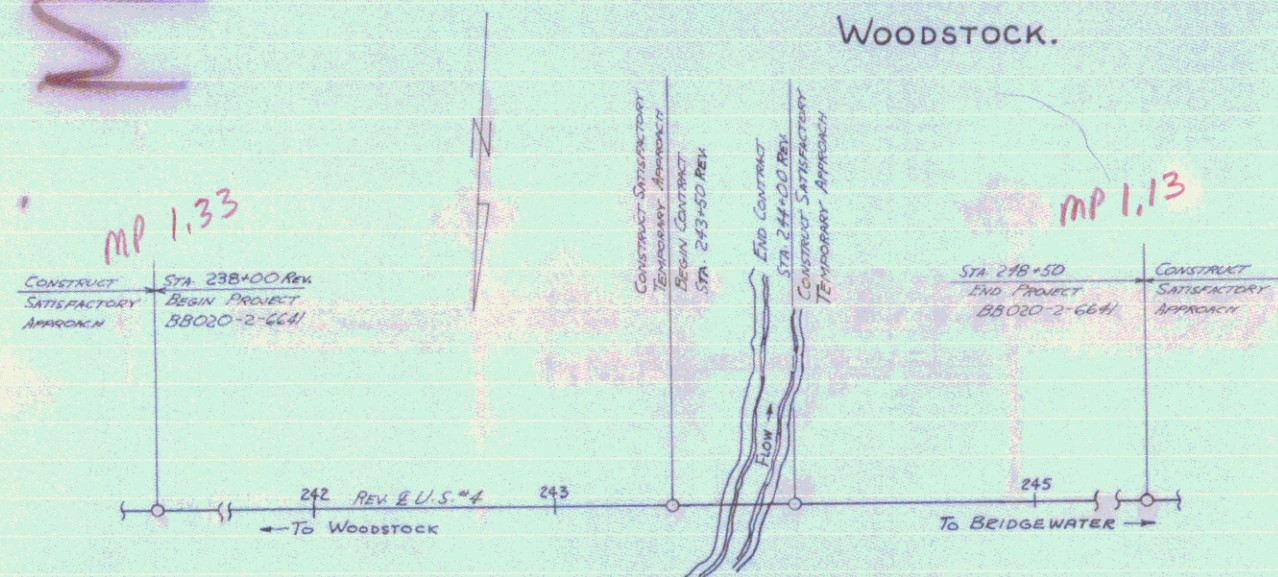

CONVENTIONAL SIGNS

POINT OF ACCESS	SR
LIMITS OF ACCESS	SR
COUNTY LINE	SR
TOWN LINE	SR
FENCE LINE	SR
STONE WALL	SR
UNFENCED PROPERTY	SR
GUARD RAIL	SR
TRAVELED WAY	SR
RAILROAD	SR
RETAINING WALL	SR
CENTER LINE	SR
SURVEY LINE	SR
CULVERT	SR
DROP BEET	SR
TROLLEY POLE	SR
POWER POLE	SR
TELEPHONE POLE	SR
TRUCK	SR
WATER	SR

TOP OF CUT
TOE OF FILL
SLOPE RIGHTS

GROUND ELEVATION
GRADE ELEVATION

CURVE DATA	SR
DEFLECTION OF ANGLE	SR
DEGREE OF CURVE	SR
RADIUS OF CURVE	SR
TANGENT DISTANCE	SR
LENGTH OF CURVE	SR
EXTERNAL DISTANCE	SR
POINT OF INTERSECTION	SR
POINT OF CURVE	SR
POINT OF TANGENT	SR
POINT ON SUB-TANGENT	SR
POINT ON CURVE	SR

FOR RIGHT OF WAY DETAILS,
SEE RIGHT OF WAY PLANS FOR THIS PROJECT

THESE PLANS ARE SUBJECT TO SUCH REVISIONS AS MAY BE REQUIRED BY THE COMMISSIONER OF HIGHWAYS.
CONSTRUCTION IS TO BE CARRIED ON IN ACCORDANCE WITH THESE PLANS AND THE STANDARD SPECIFICATIONS FOR HIGHWAY AND BRIDGE CONSTRUCTION DATED JANUARY, 1964, AS APPROVED BY THE BOARD OF PUBLIC ROADS ON OCTOBER 15, 1964, INCLUDING ALL SUBSEQUENT APPROVED REVISIONS AND SUCH OTHER SPECIFICATIONS AND SPECIAL PROVISIONS AS ARE INCORPORATED IN THESE PLANS.

APPROVED DISTRICT ENGINEER DATE 3/26/68	APPROVED CONSTRUCTION ENGINEER DATE 4/10/68	APPROVED CHIEF ENGINEER DATE 4/10/68	APPROVED SUPERVISOR DATE 4/10/68	APPROVED DATE 6/26/68	APPROVED DATE 6/26/68	APPROVED DATE 6/26/68	APPROVED DATE 6/26/68
---	---	--	--	--------------------------	--------------------------	--------------------------	--------------------------

APPROVED
BMA 6324
PROJECT BB-020-2-6641
SHEET 1 OF 31 SHEETS
DATE June 28 1968