


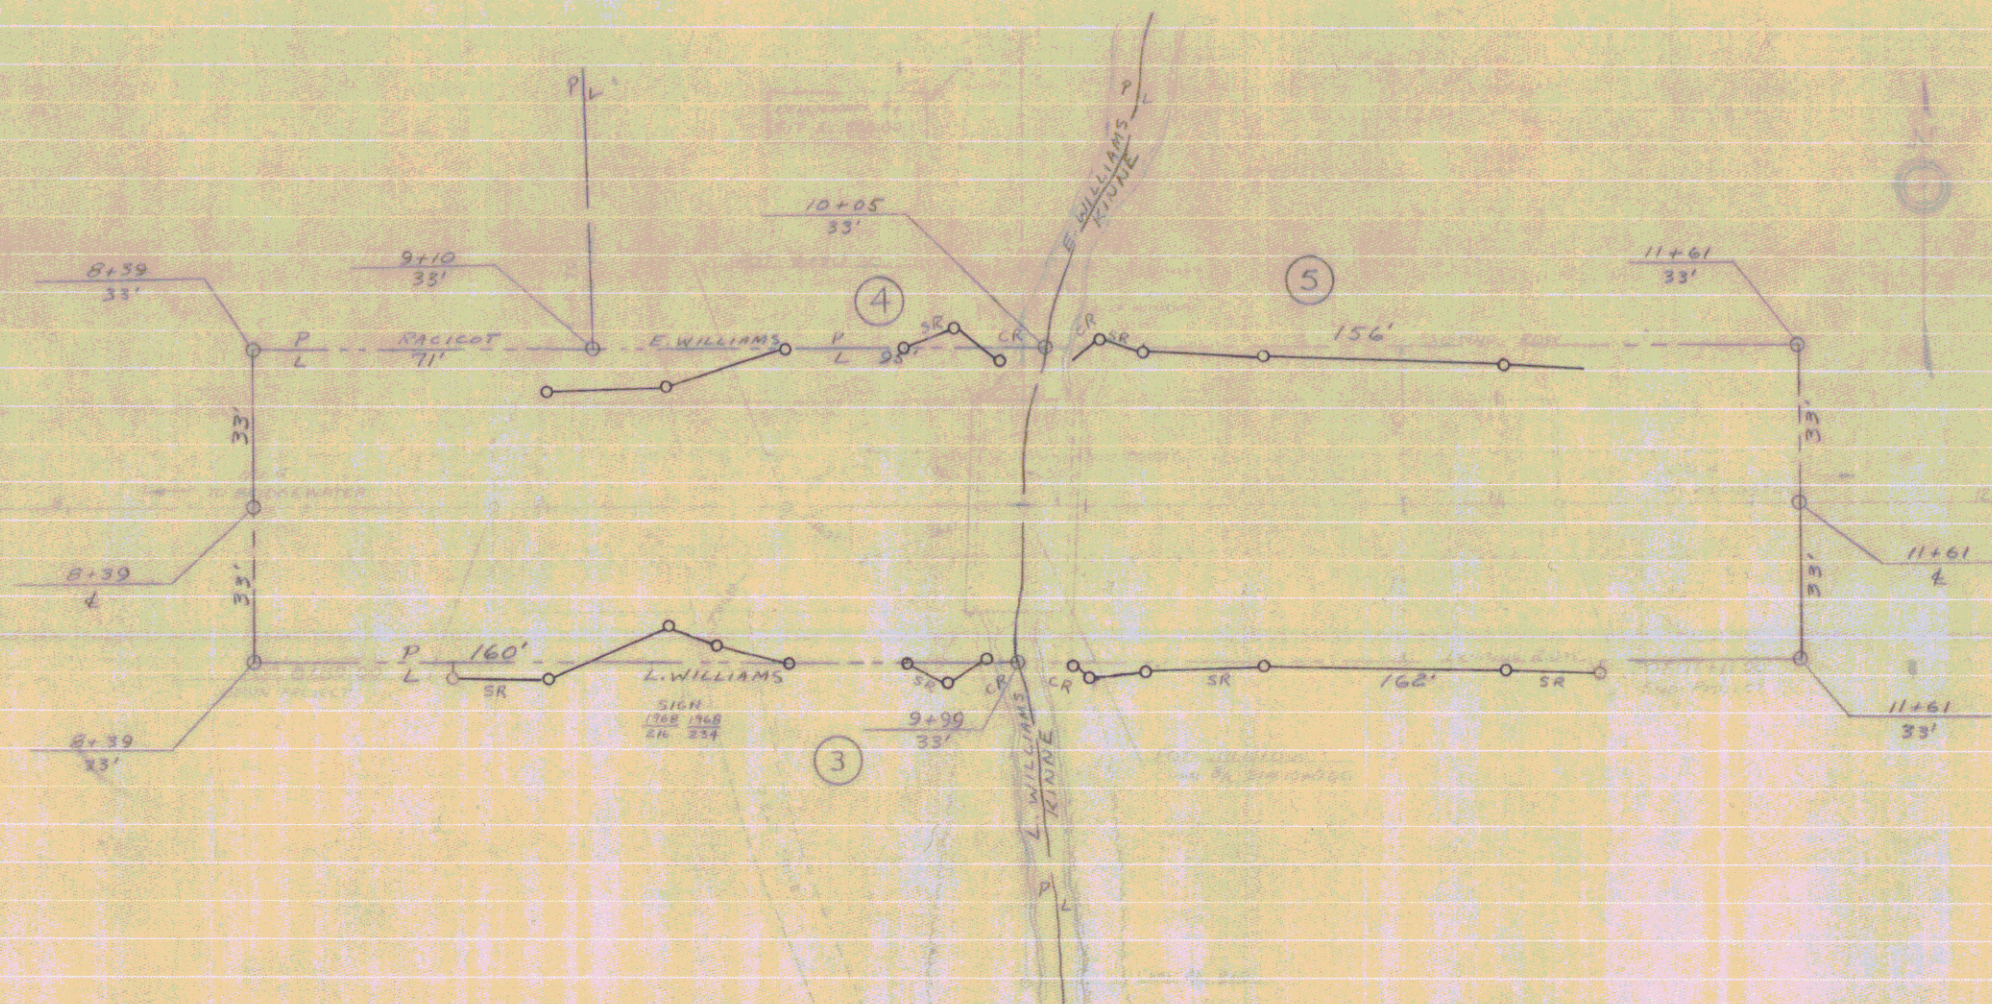

PLAN SCALE - 1" = 20'

SHEET 31 OF 31

PRIME WATER & WOODSTOCK

SR 020-2-663