


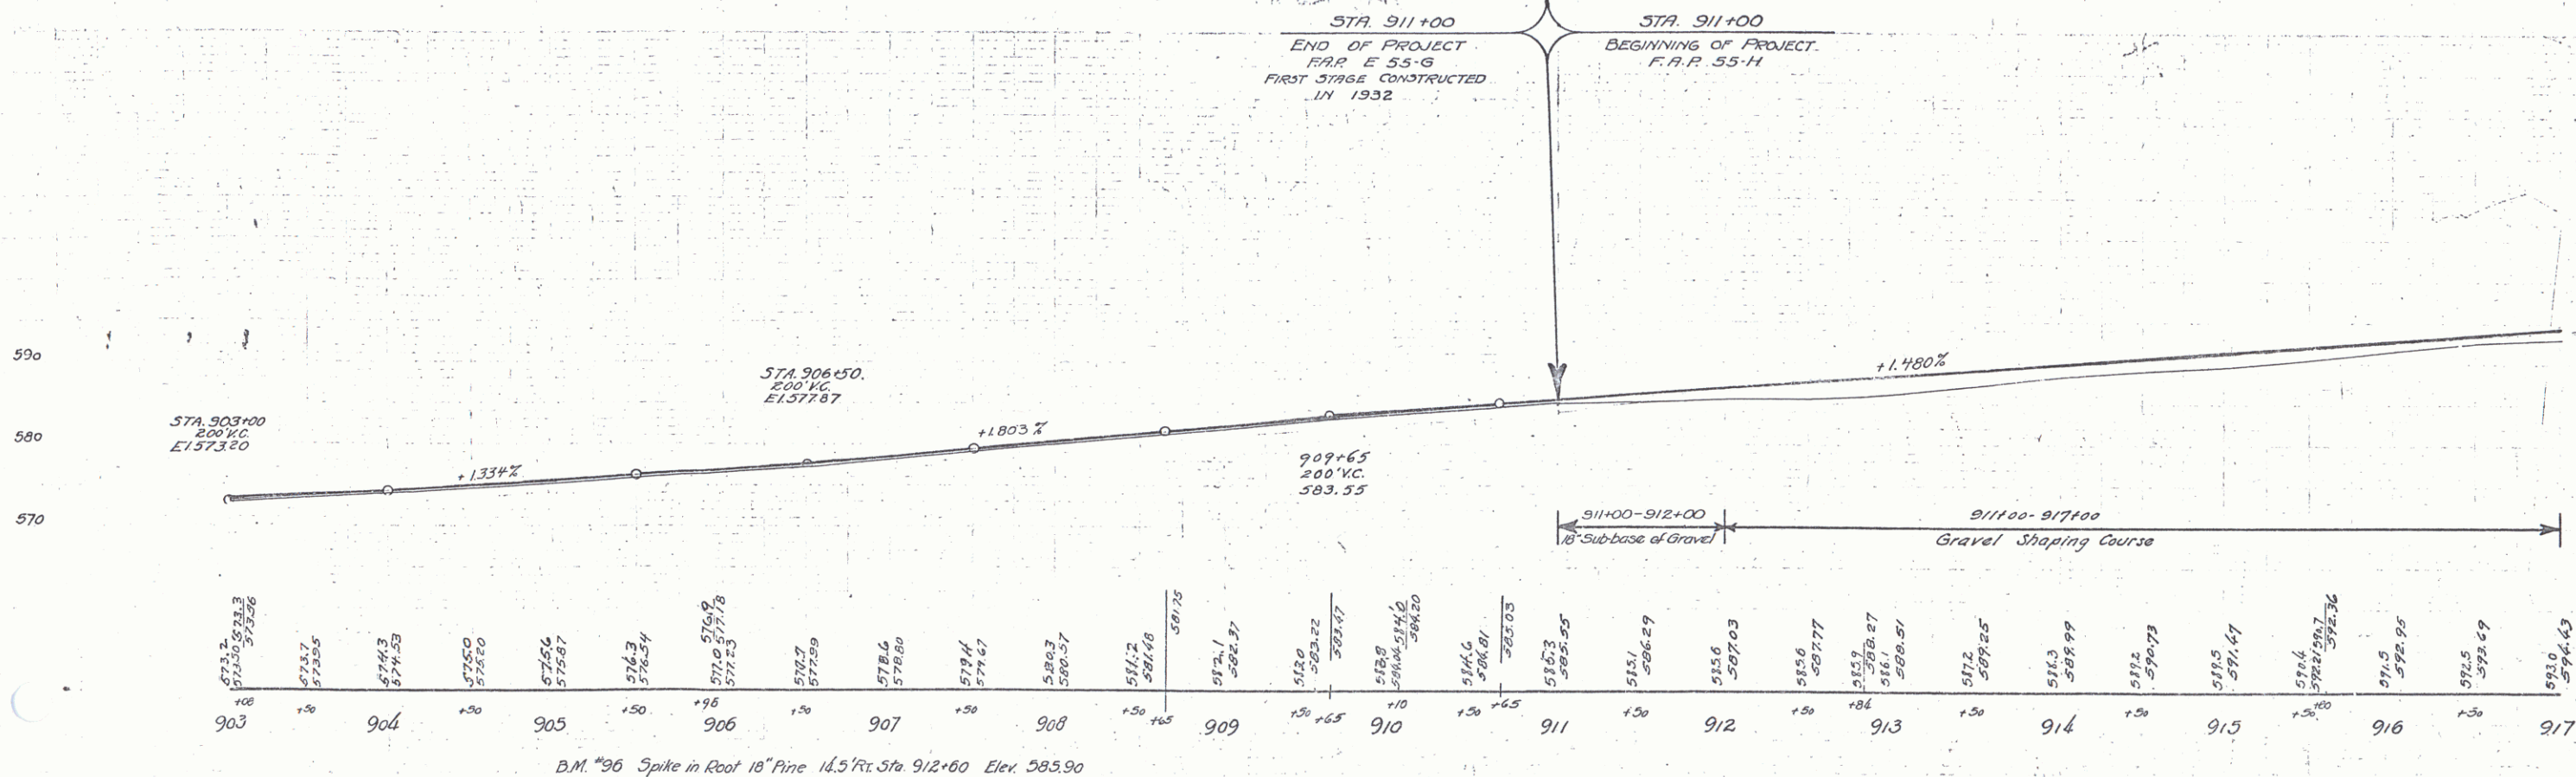
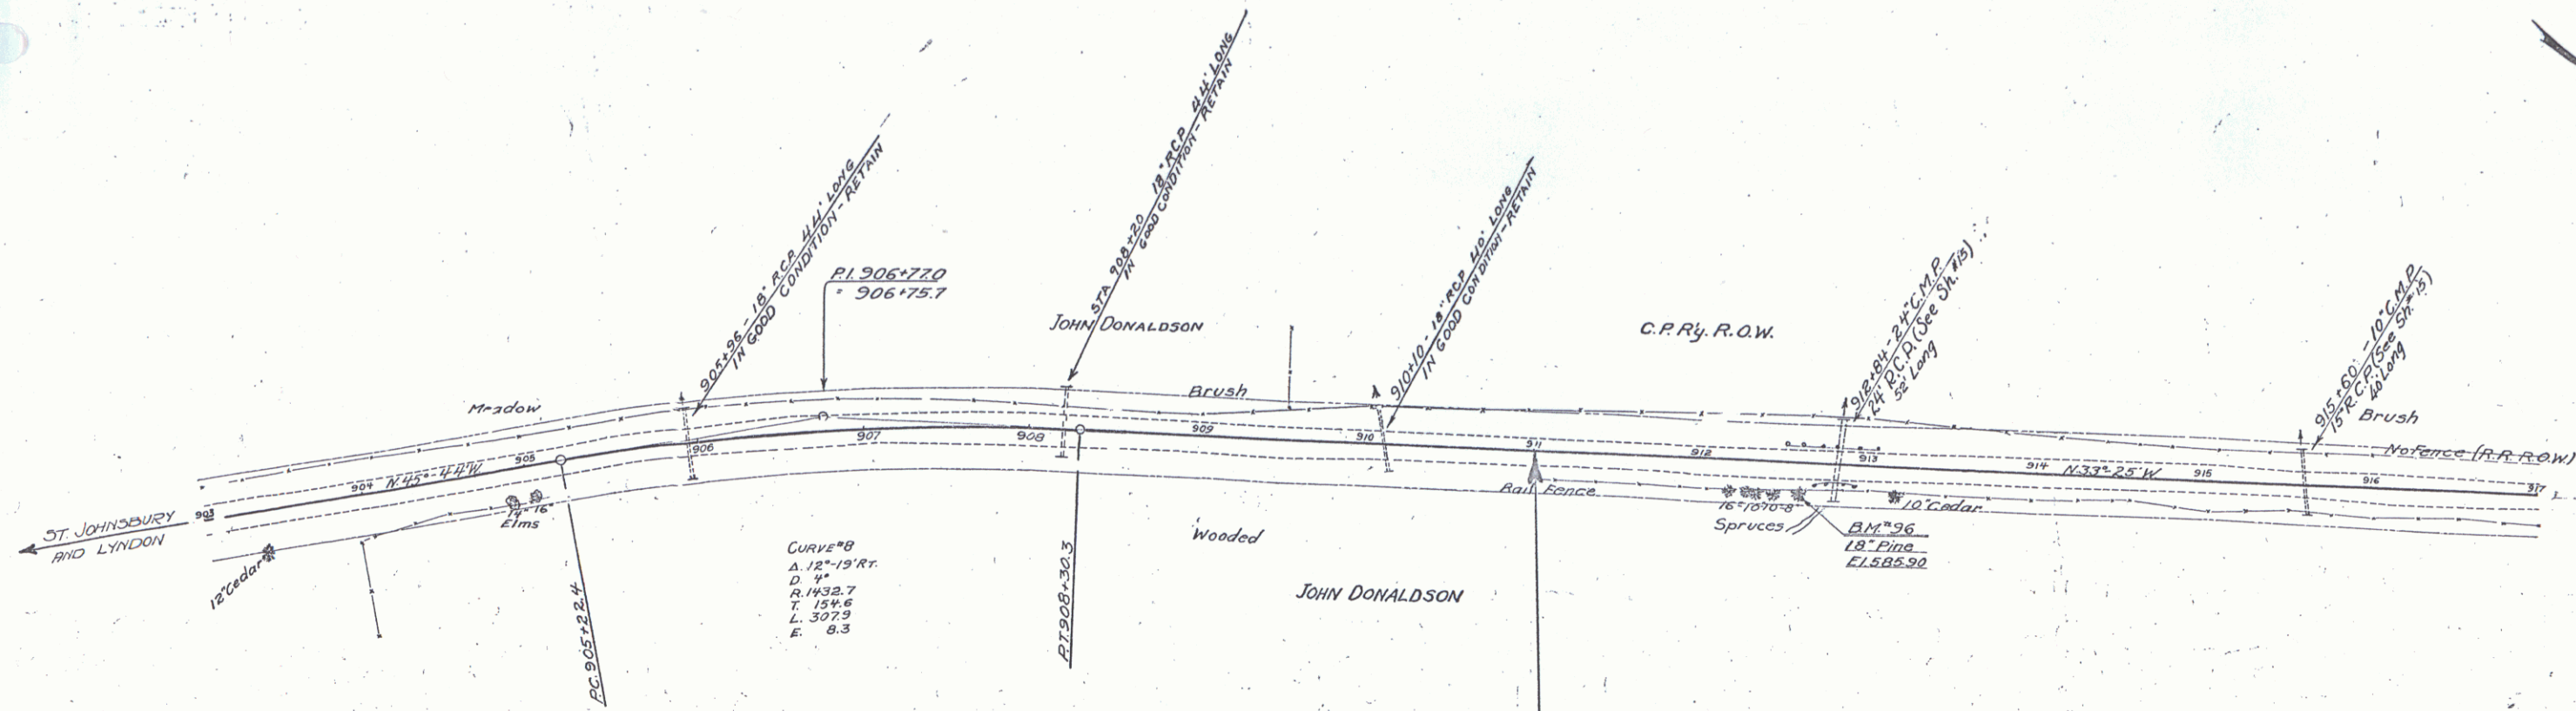


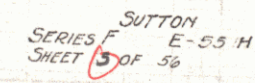

B.M. #96 Spike in Root 18" Pine 14.5' Rt. Sta. 912+60 Elev. 585.90


SUTTON

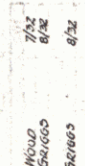

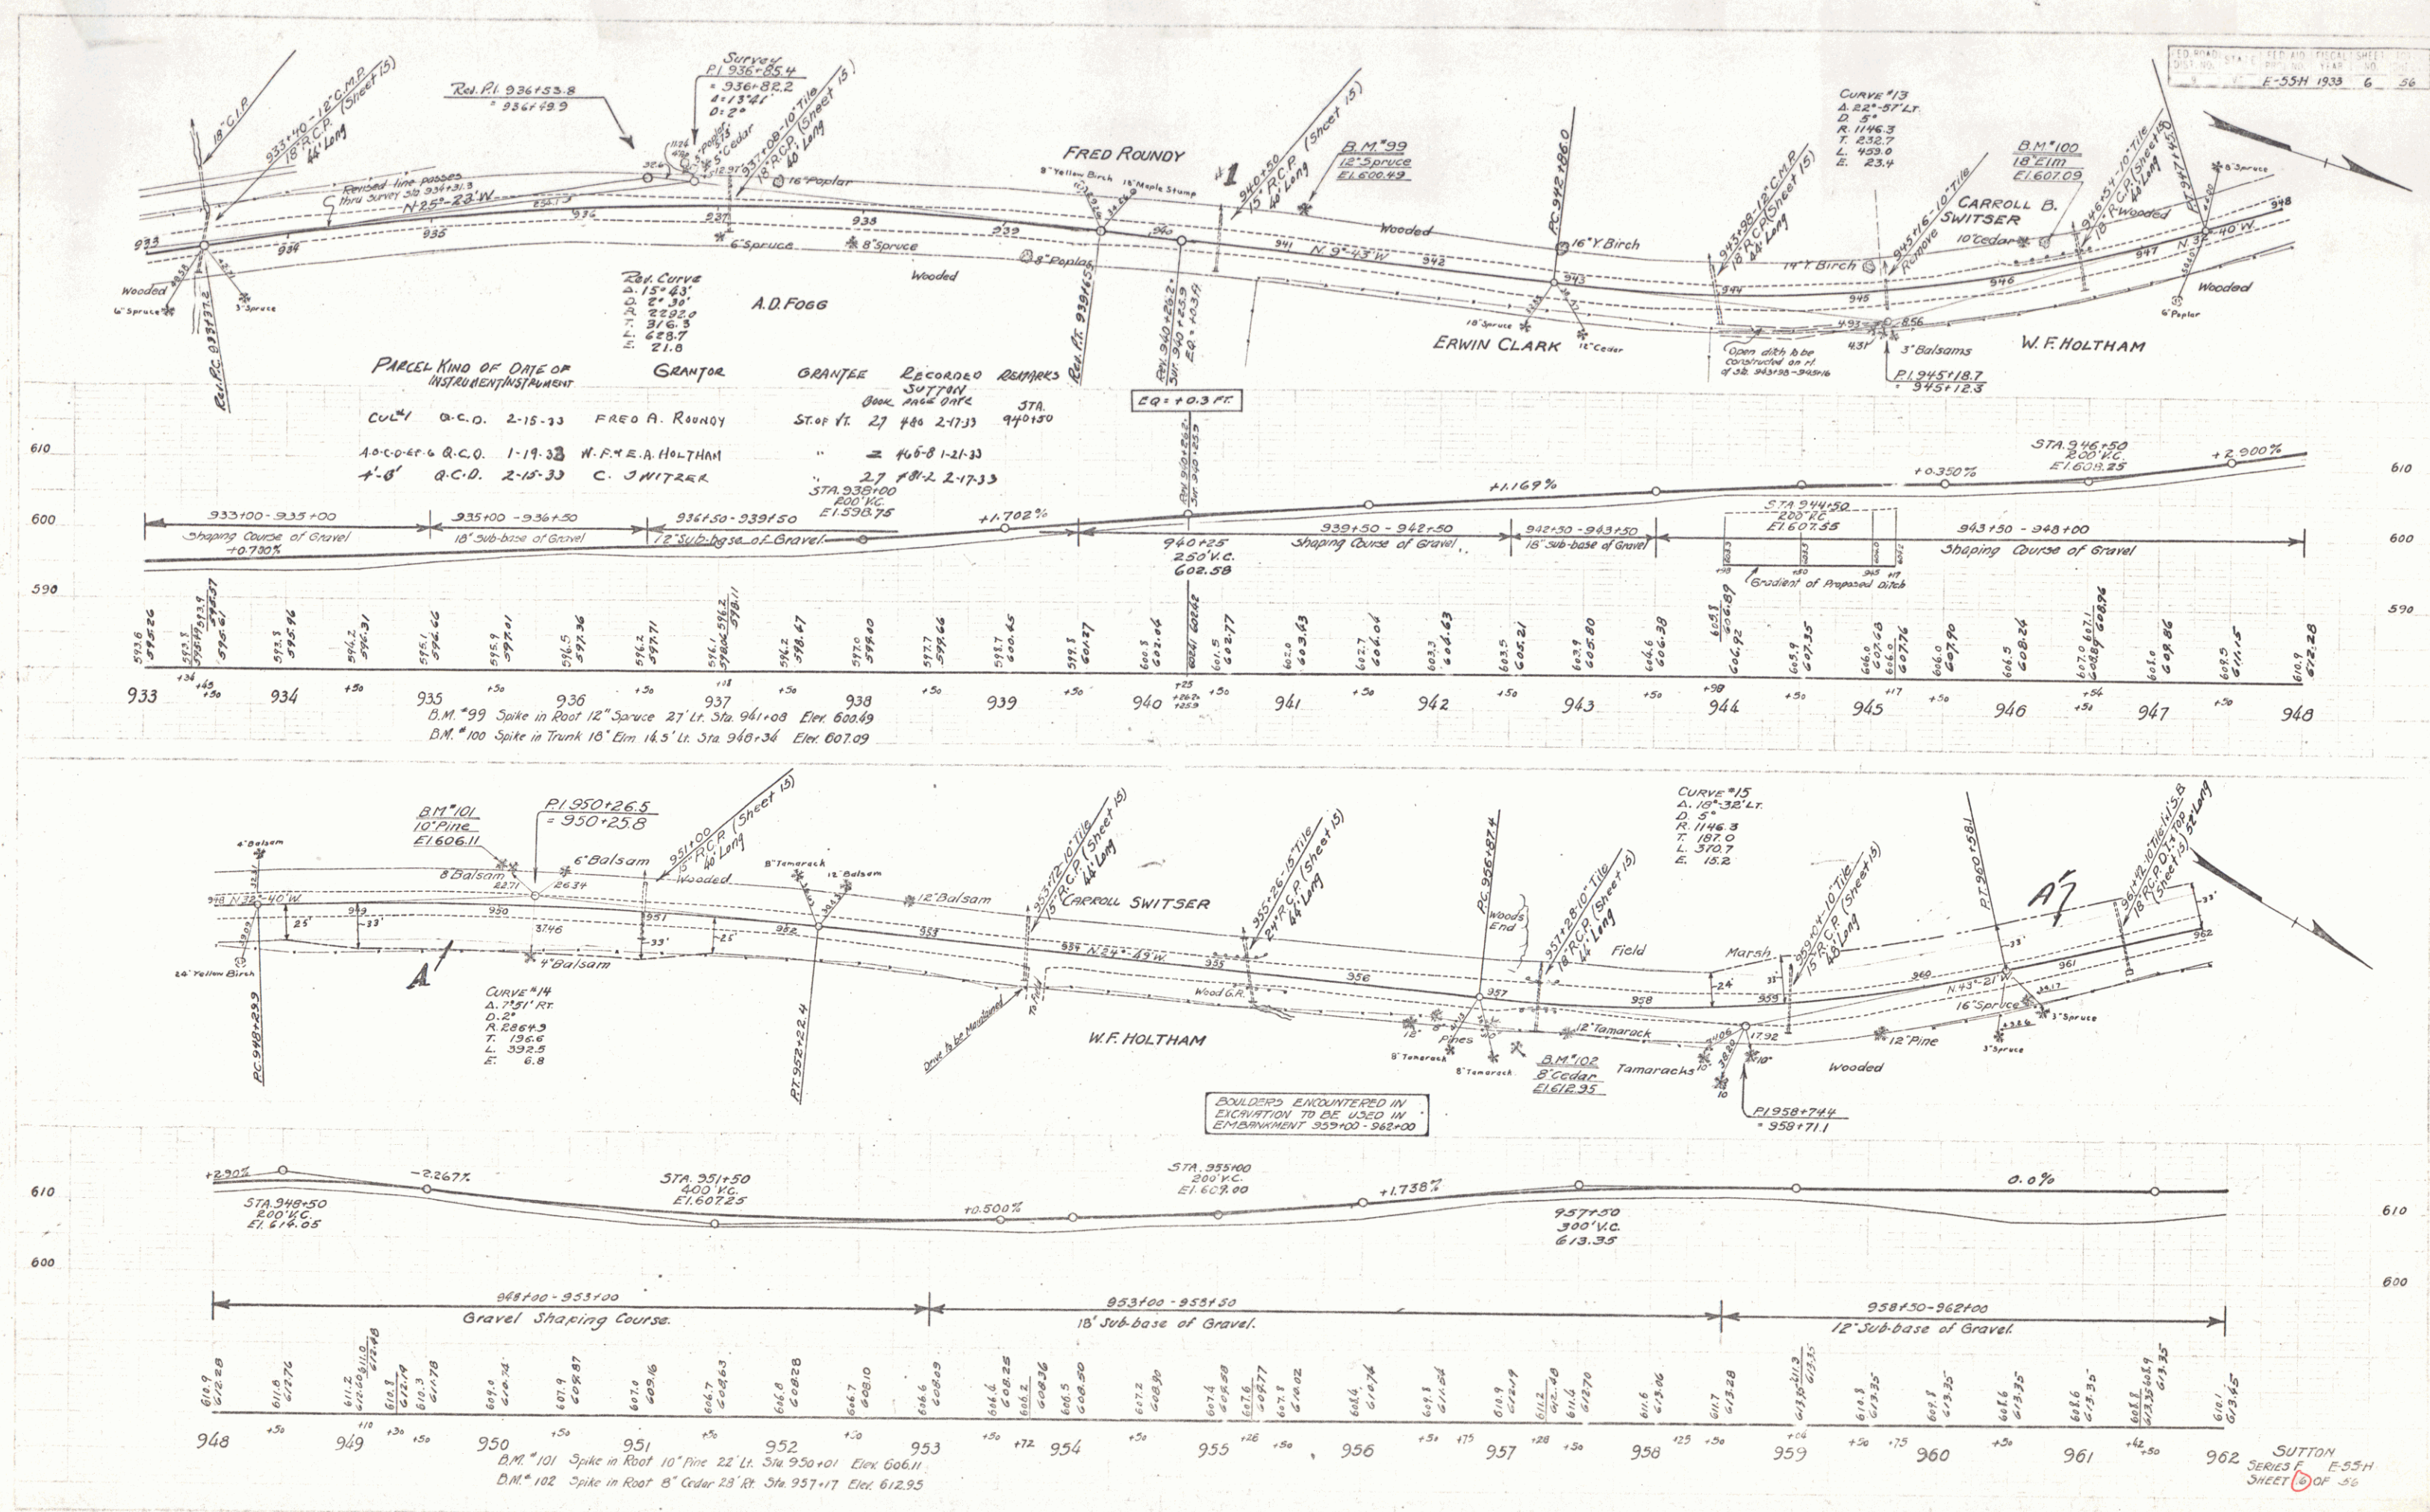


E-55H 1933 6 56


SUTTON SERIES E-55H SHEET 6 OF 56

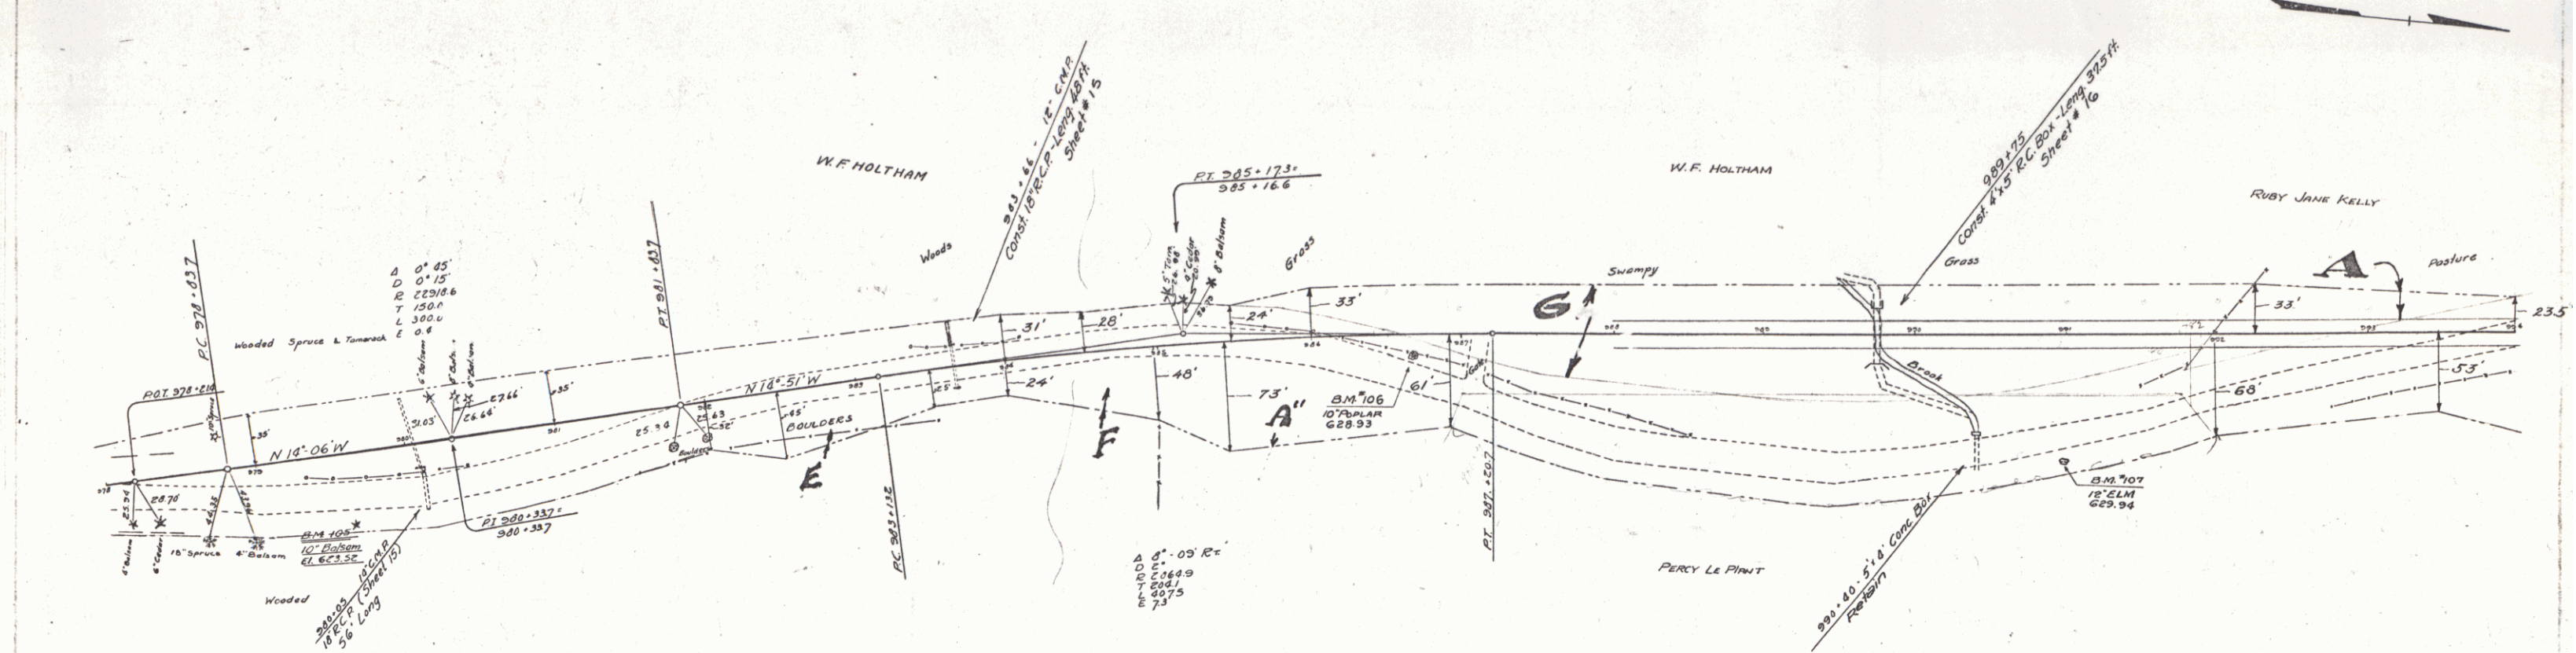


PARCEL	KIND OF INSTRUMENT	DATE OF INSTRUMENT	GRANTOR	GRANTEE	RECORDED	REMARKS
A-B-C-D	N.D.	7-15-33	RUBY JANE KELLEY	JOINT	BOOK ARE ONE	
A-B-C-D-E	Q.C.D.	1-19-33	W. HOLTHAM	"	2 107	8-7-33
A"	Q.C.D.	1-17-32	P. LA PLANT	"	2 465-8	1-21-33
				"	2 470-1	2-7-33

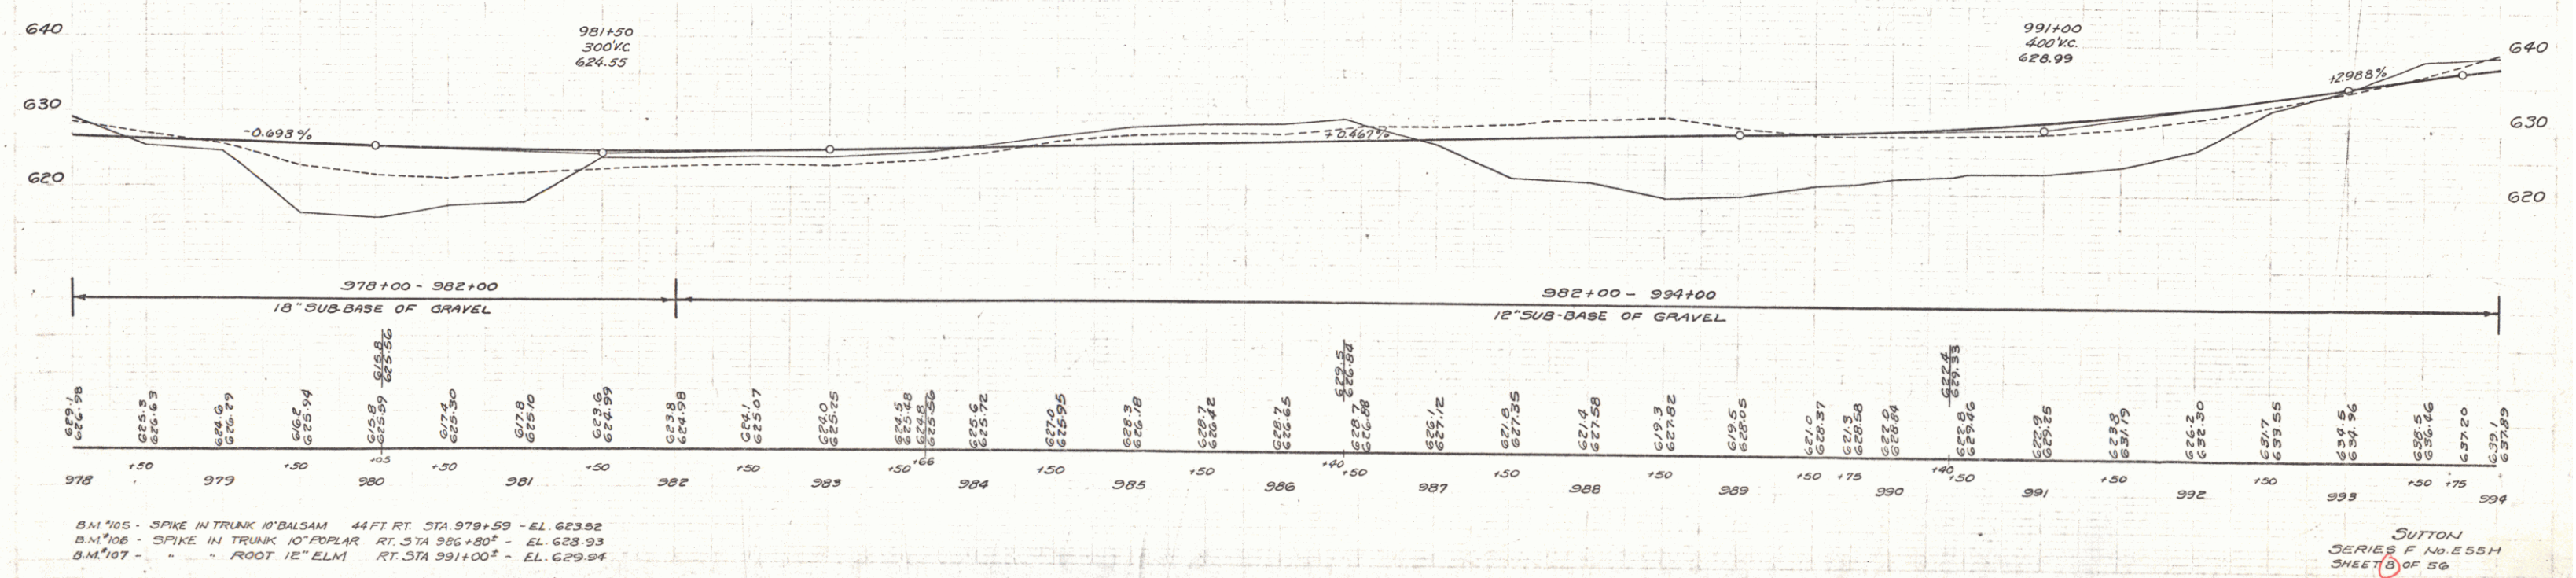

B.M. 105 - SPIKE IN TRUNK 10' BALSAM 44 FT RT. STA 979+59 - EL. 623.52
 B.M. 106 - SPIKE IN TRUNK 10' POPLAR RT. STA 986+80 - EL. 628.93
 B.M. 107 - " " ROOT 12" ELM RT. STA 991+00 - EL. 629.94

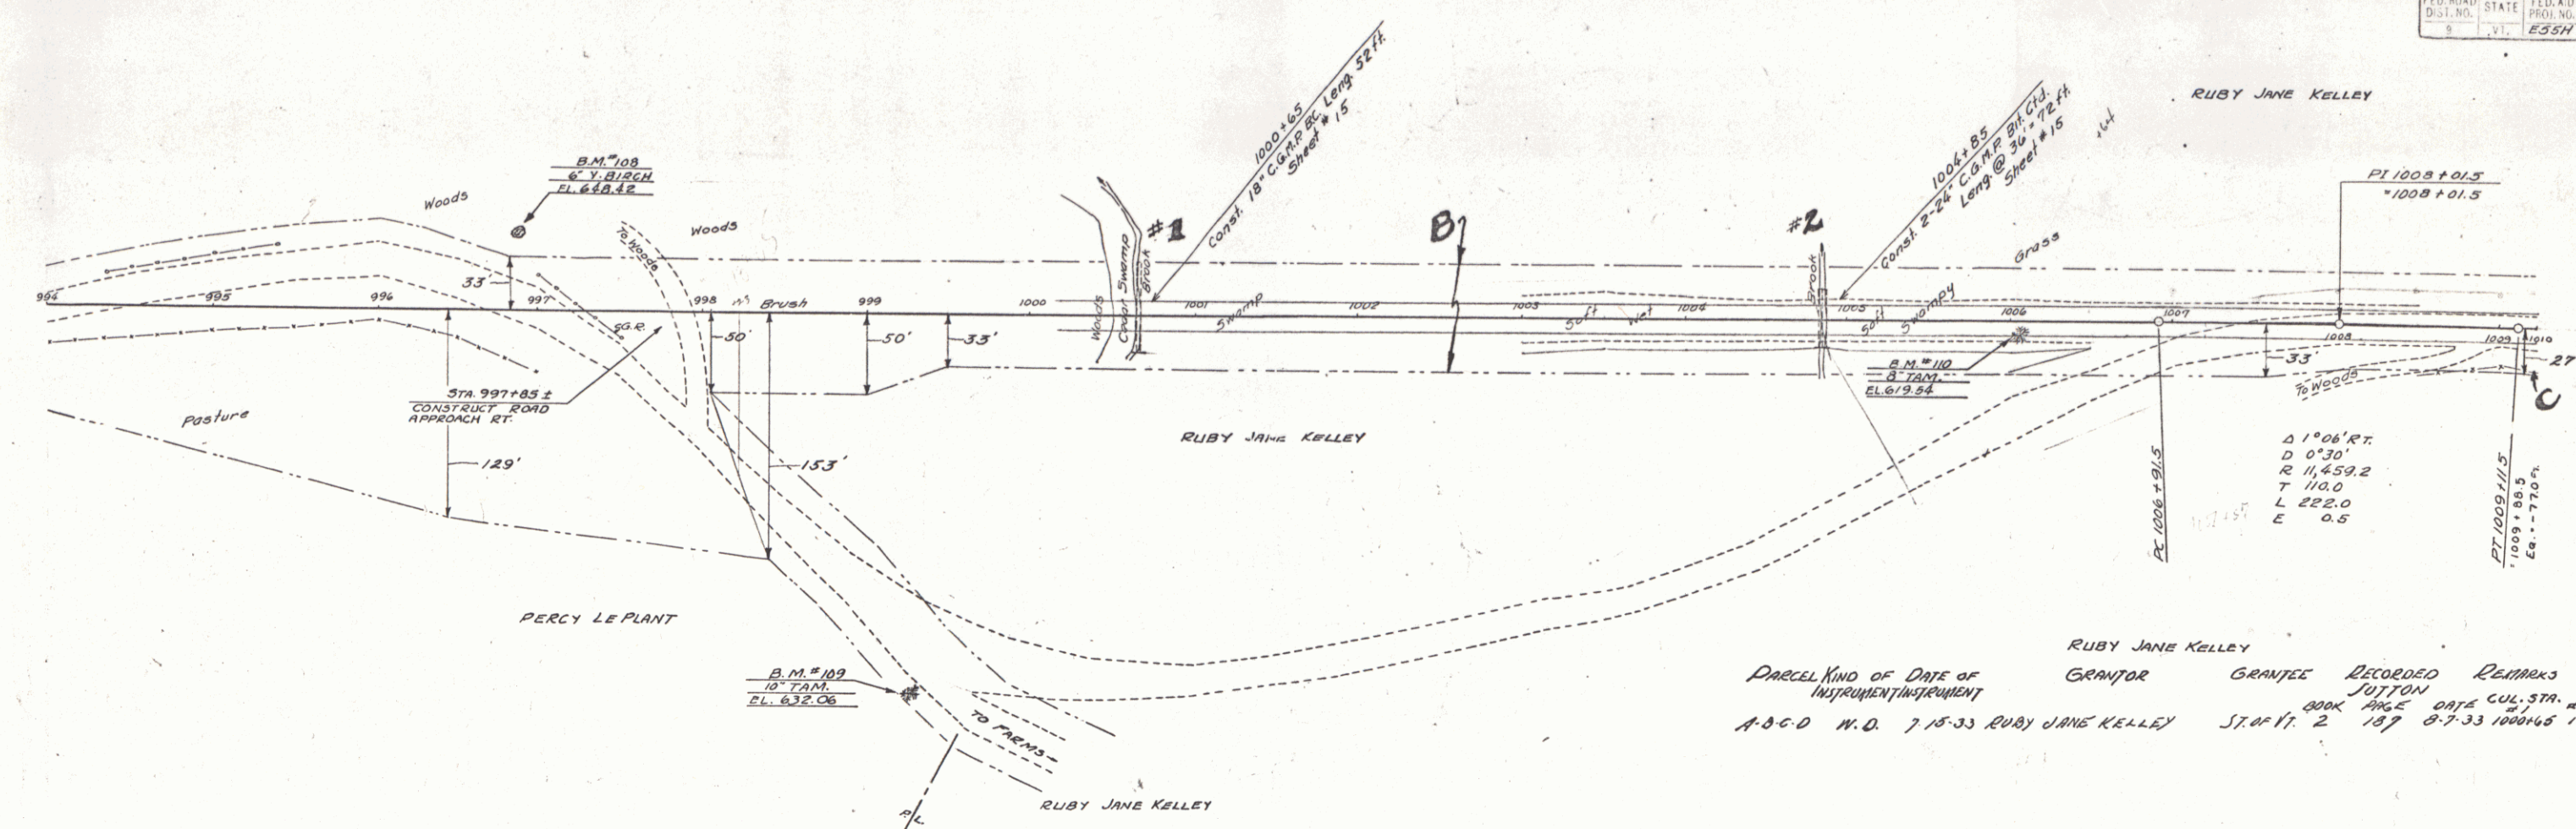






PARCEL	KIND OF INSTRUMENT	DATE OF INSTRUMENT	GRANTOR	GRANTEE	RECORDED	REMARKS
A-3-C-D	W.D.	7-15-33	RUBY JANE KELLEY	ST. AF. 2	187	8-7-33 1000+65 1004+85

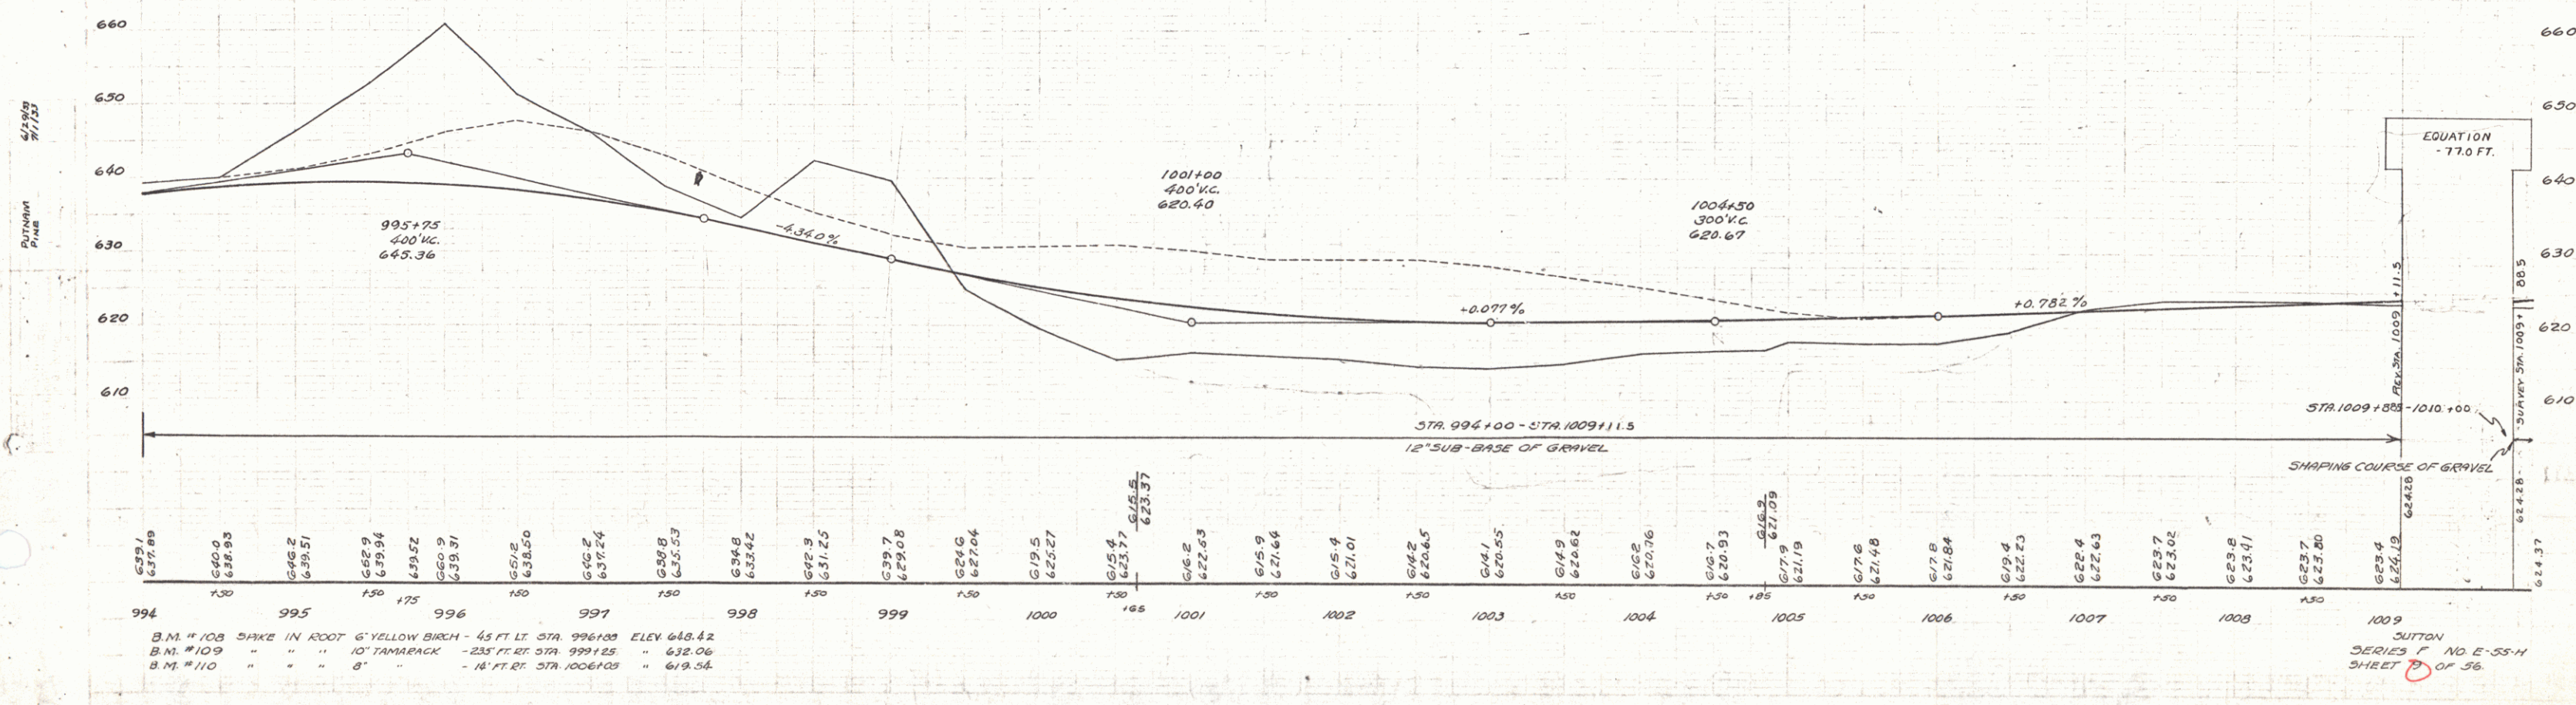

B.M. #108 SHARK IN ROOT 6" YELLOW BIRCH - 43 FT. LT. STA. 994+00 ELEV. 648.42
 B.M. #109 " " " 10" TAMARACK - 235 FT. RT. STA. 999+25 ELEV. 632.06
 B.M. #110 " " " 8' " " 18' RT. STA. 1006+00 ELEV. 619.54



SUITON
 SERIES NO. E-55-H
 SHEET 9 OF 56

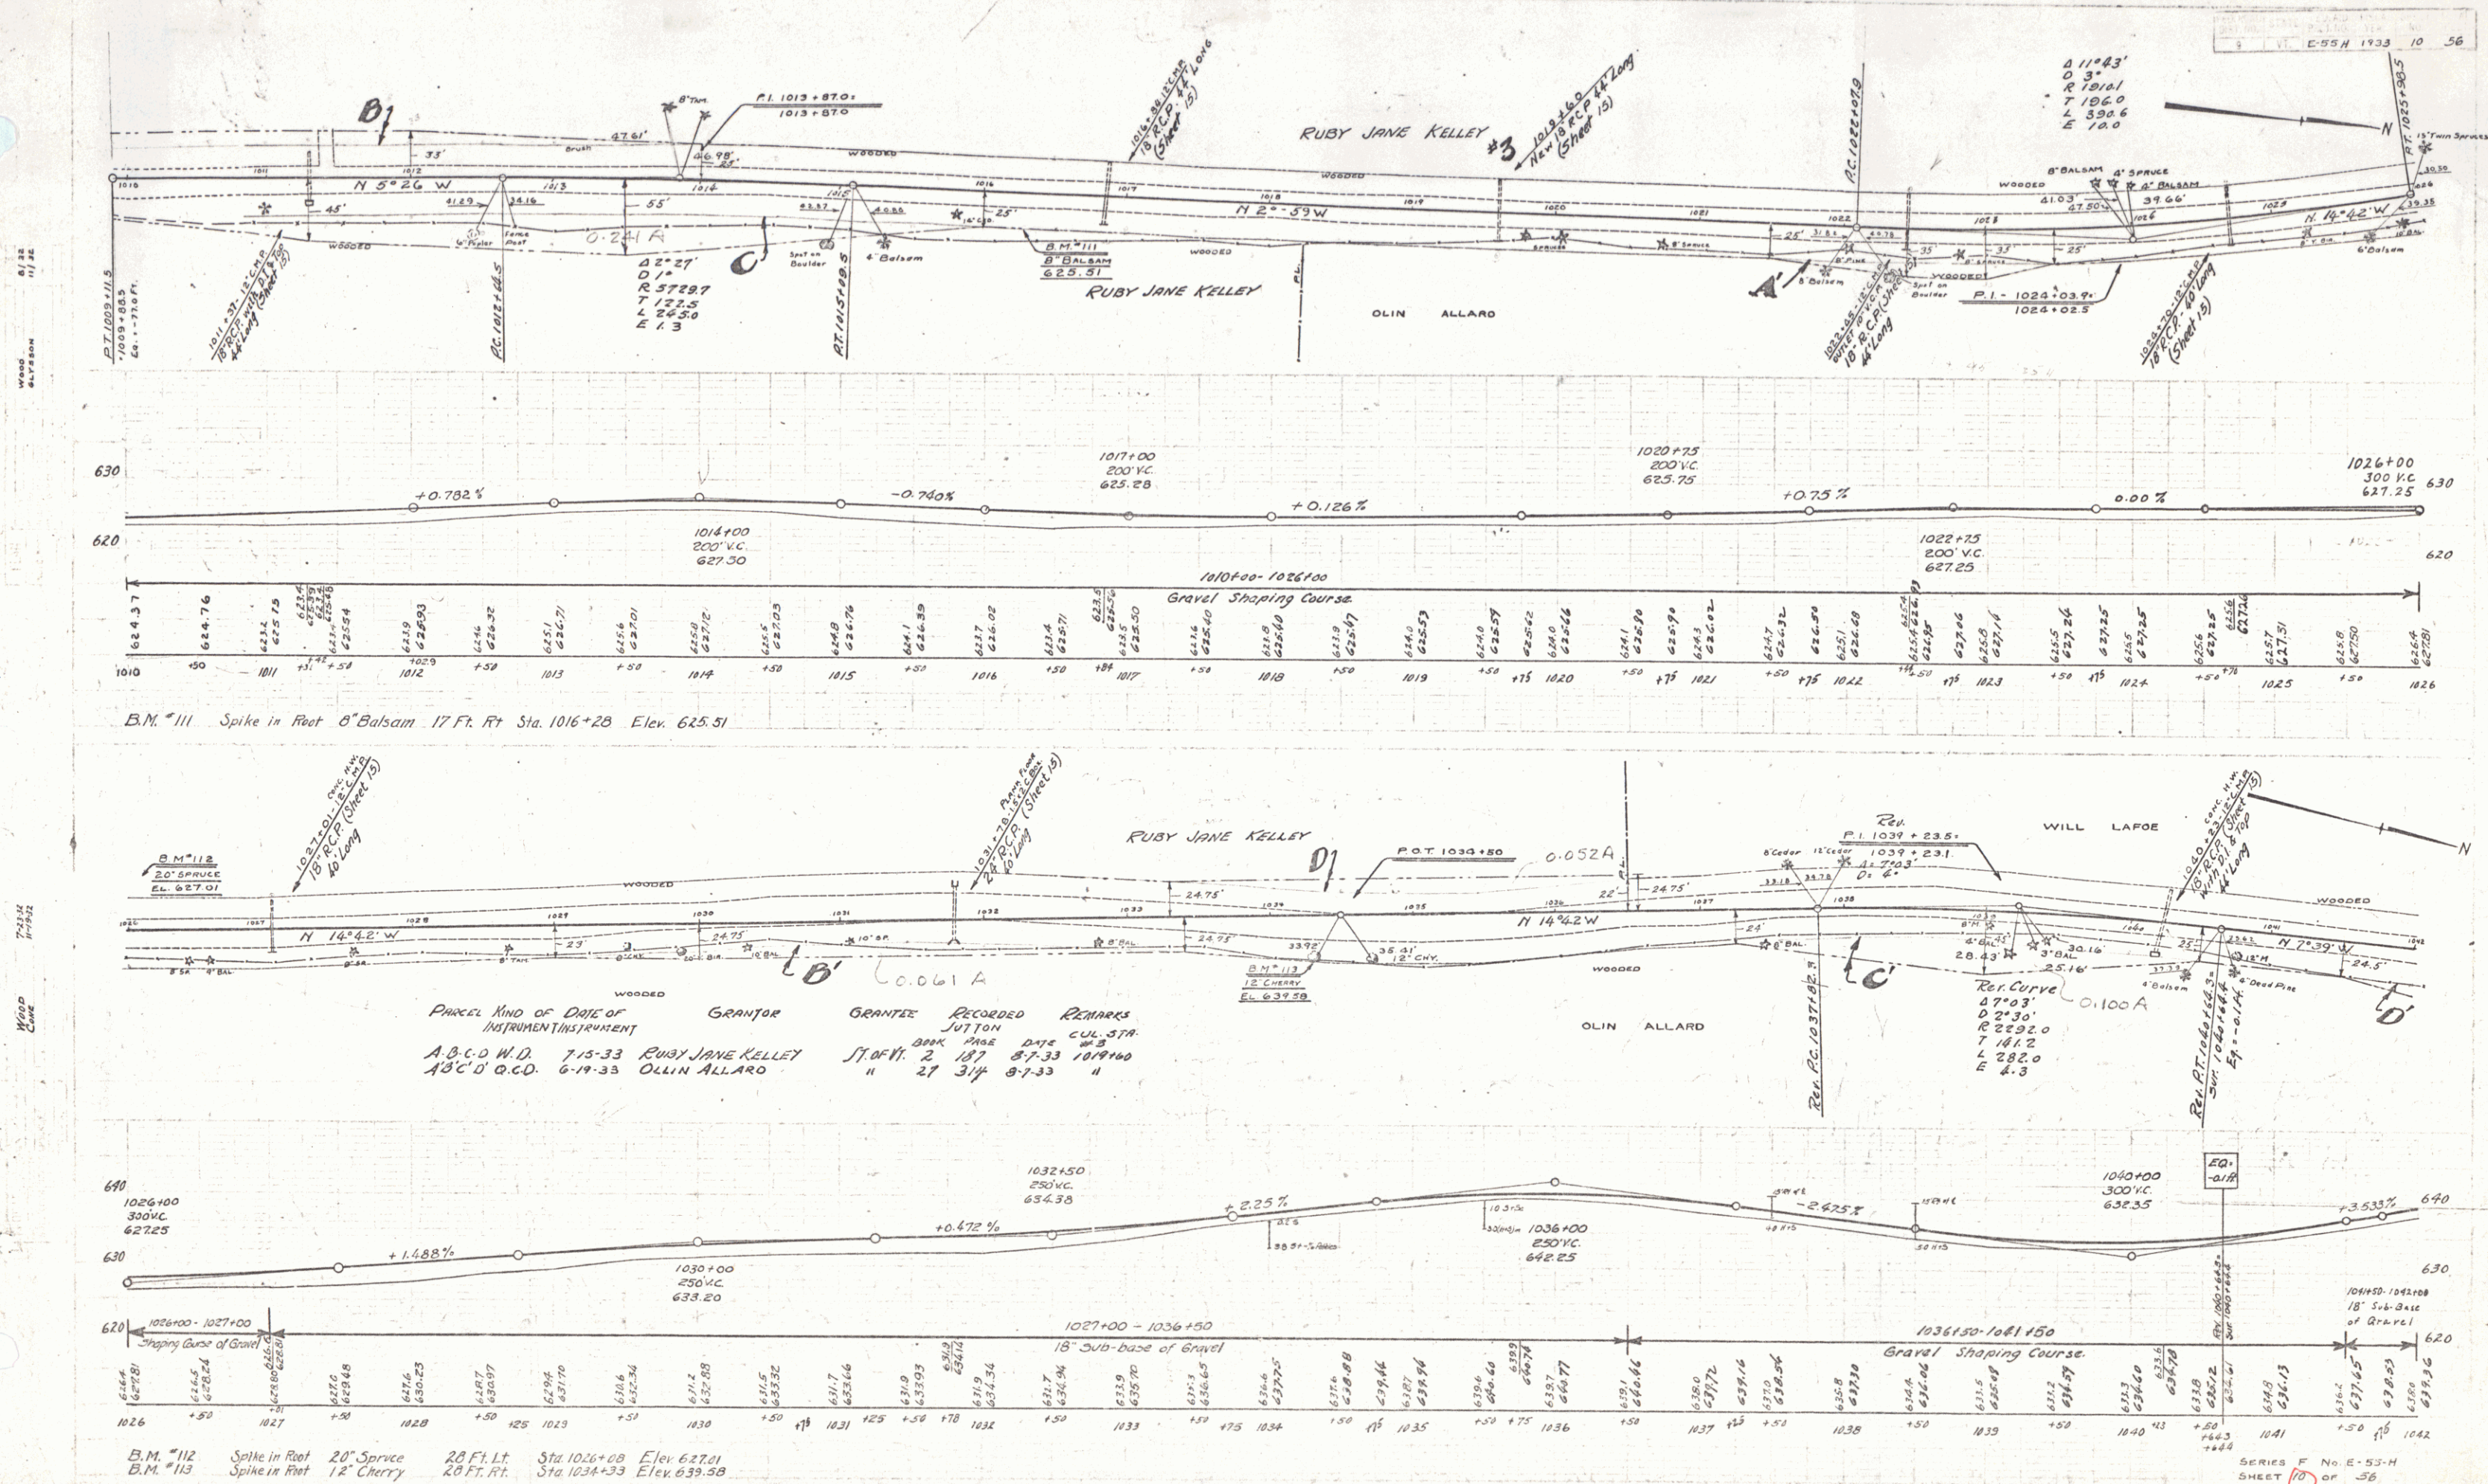

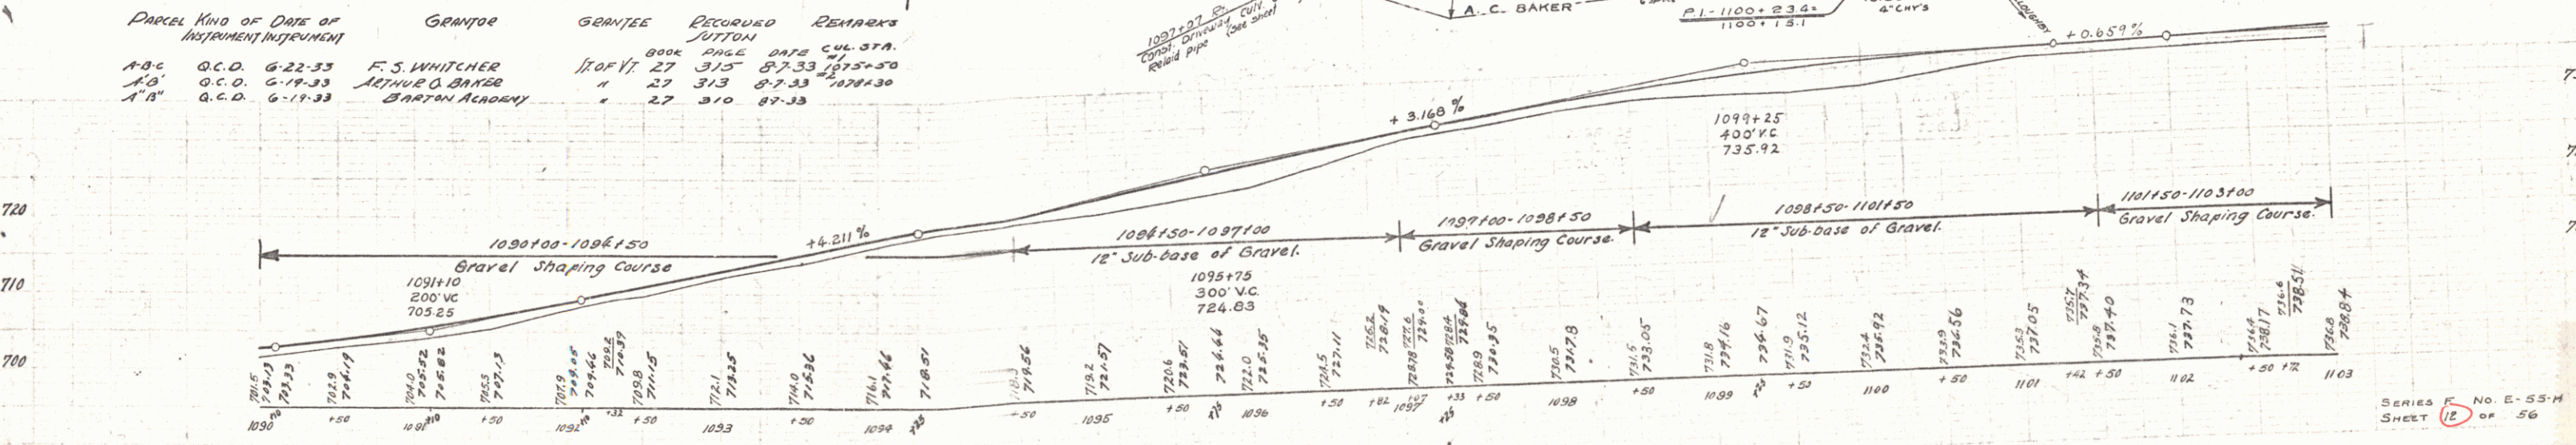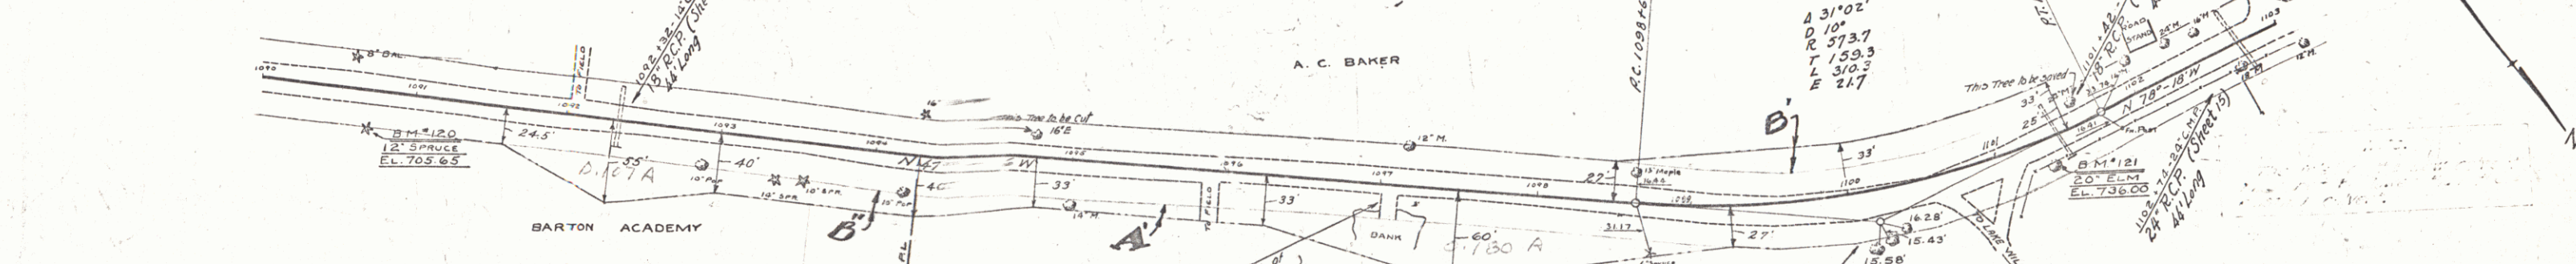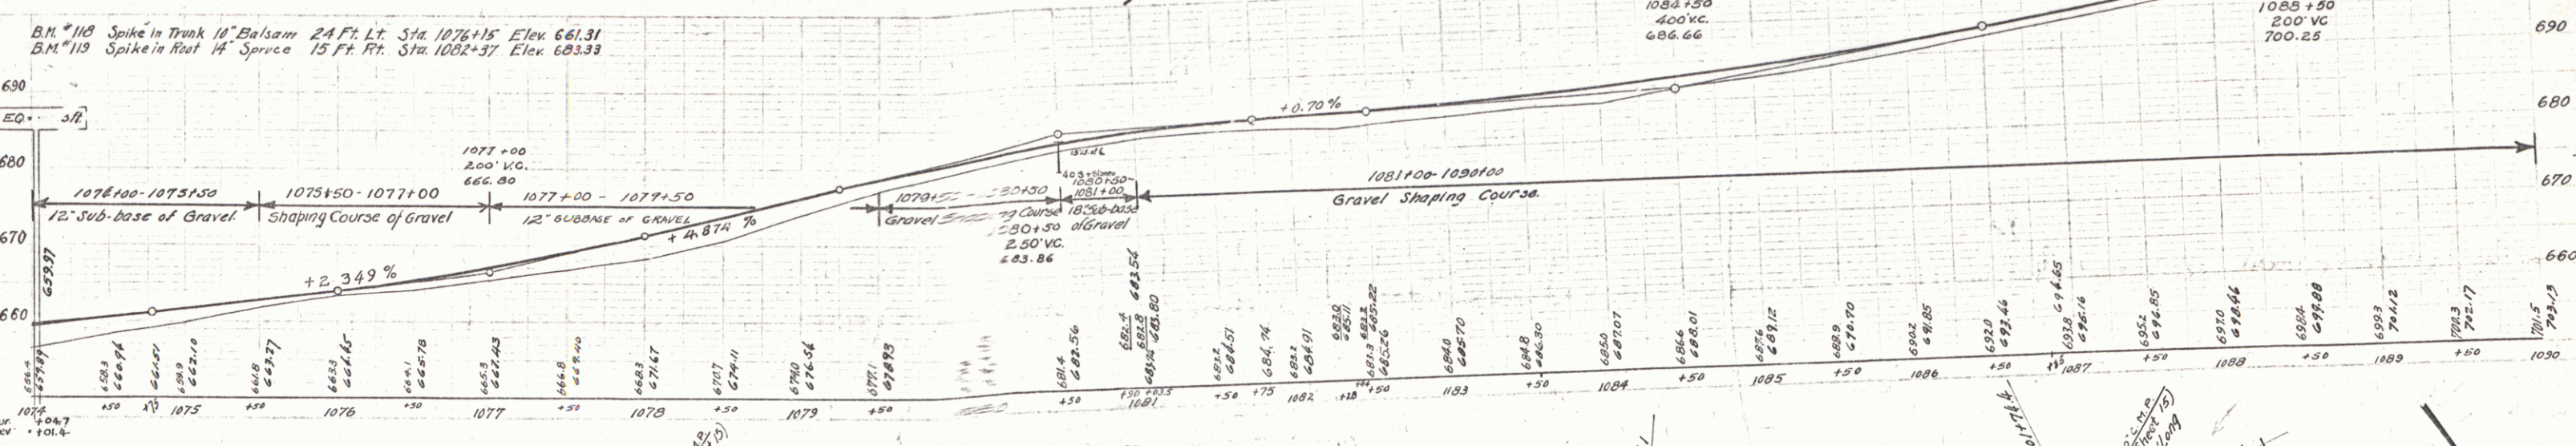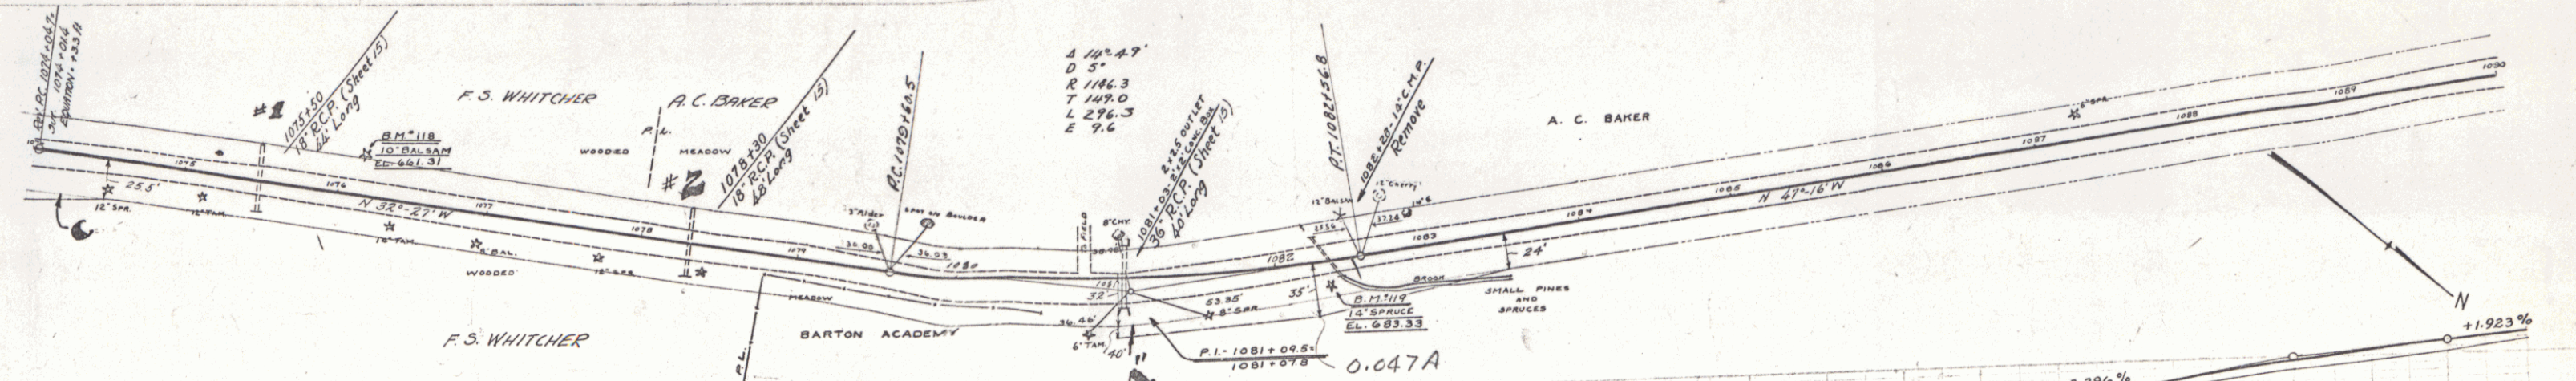

PARCEL	KIND OF INSTRUMENT	DATE OF INSTRUMENT	GRANTOR	GRANTEE	RECORDED	REMARKS
A-B-C	O.C.D.	6-22-33	F.S. WHITCHER	100' V	BOOK 27 PAGE 313	DATE 8-7-33
A-D	O.C.D.	6-19-33	ARTHUR O. BAKER	"	27 313	8-7-33
A-E	O.C.D.	6-19-33	BARTON ACADEMY	"	27 310	8-7-33

B.M. #120 Spike in Root 12" Spruce 24 Ft. Rt. Sta. 1090+70 Elev. 705.65
 B.M. #121 Spike in Root 20" Elm 18.5 Ft. Rt. Sta. 1101+31 Elev. 736.00

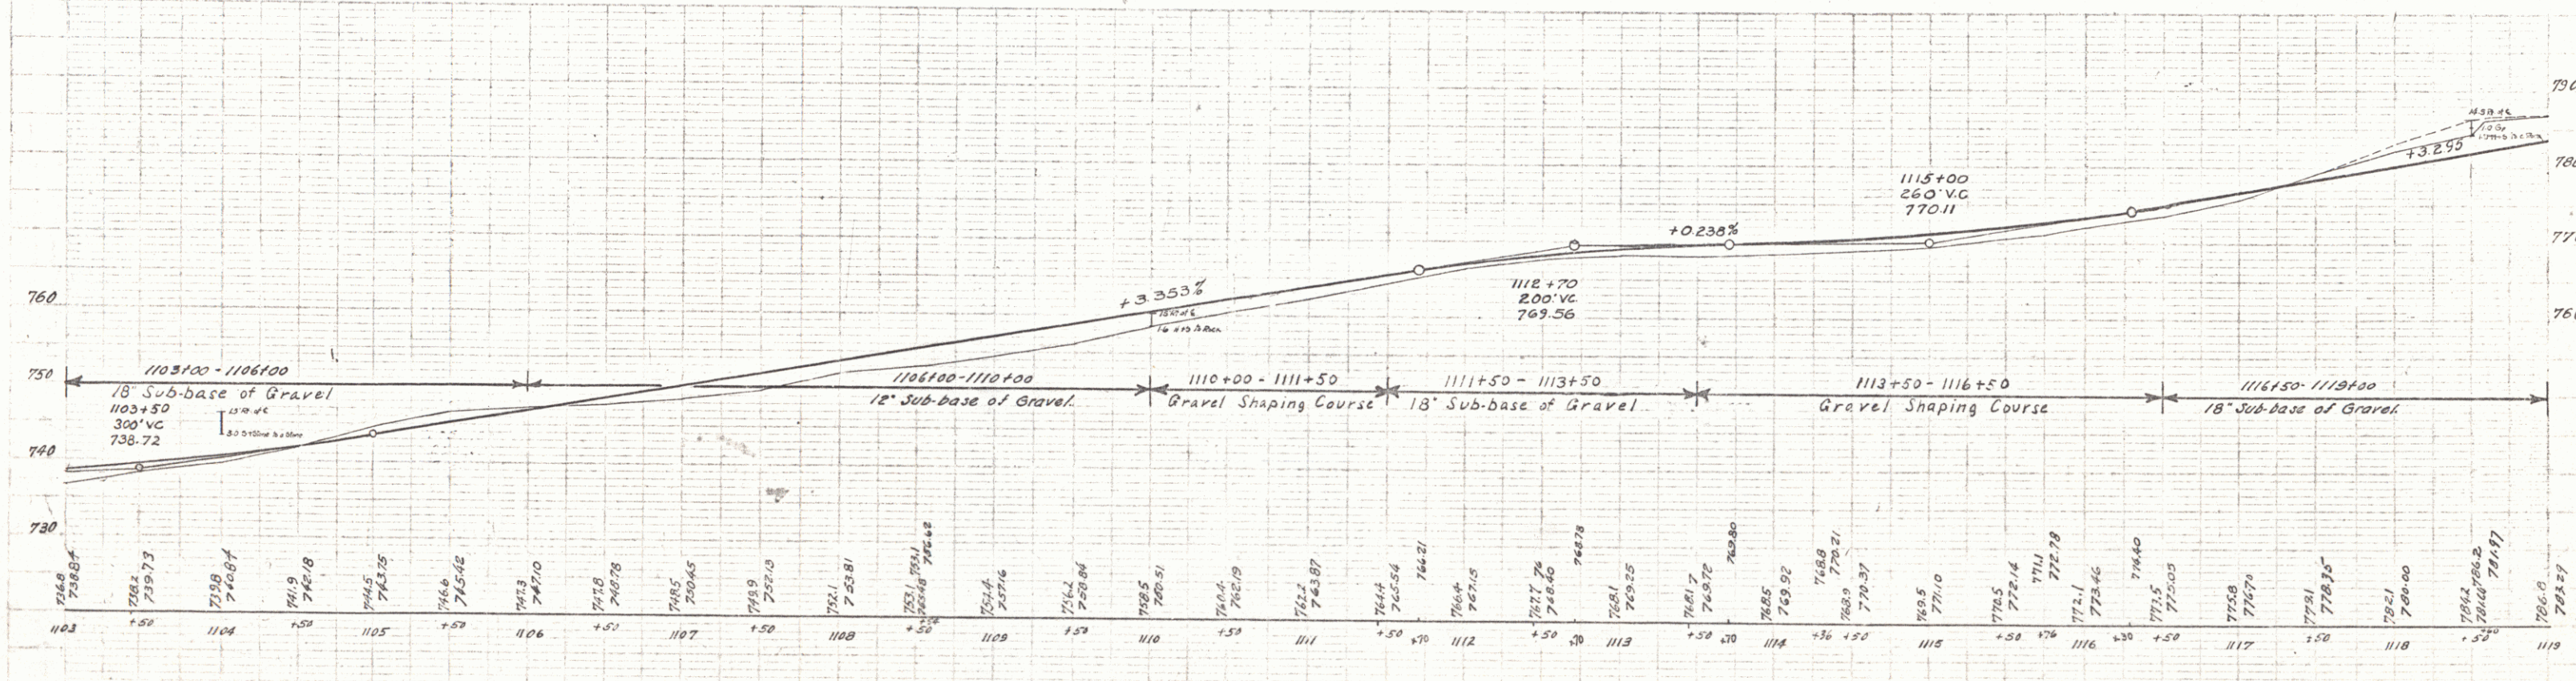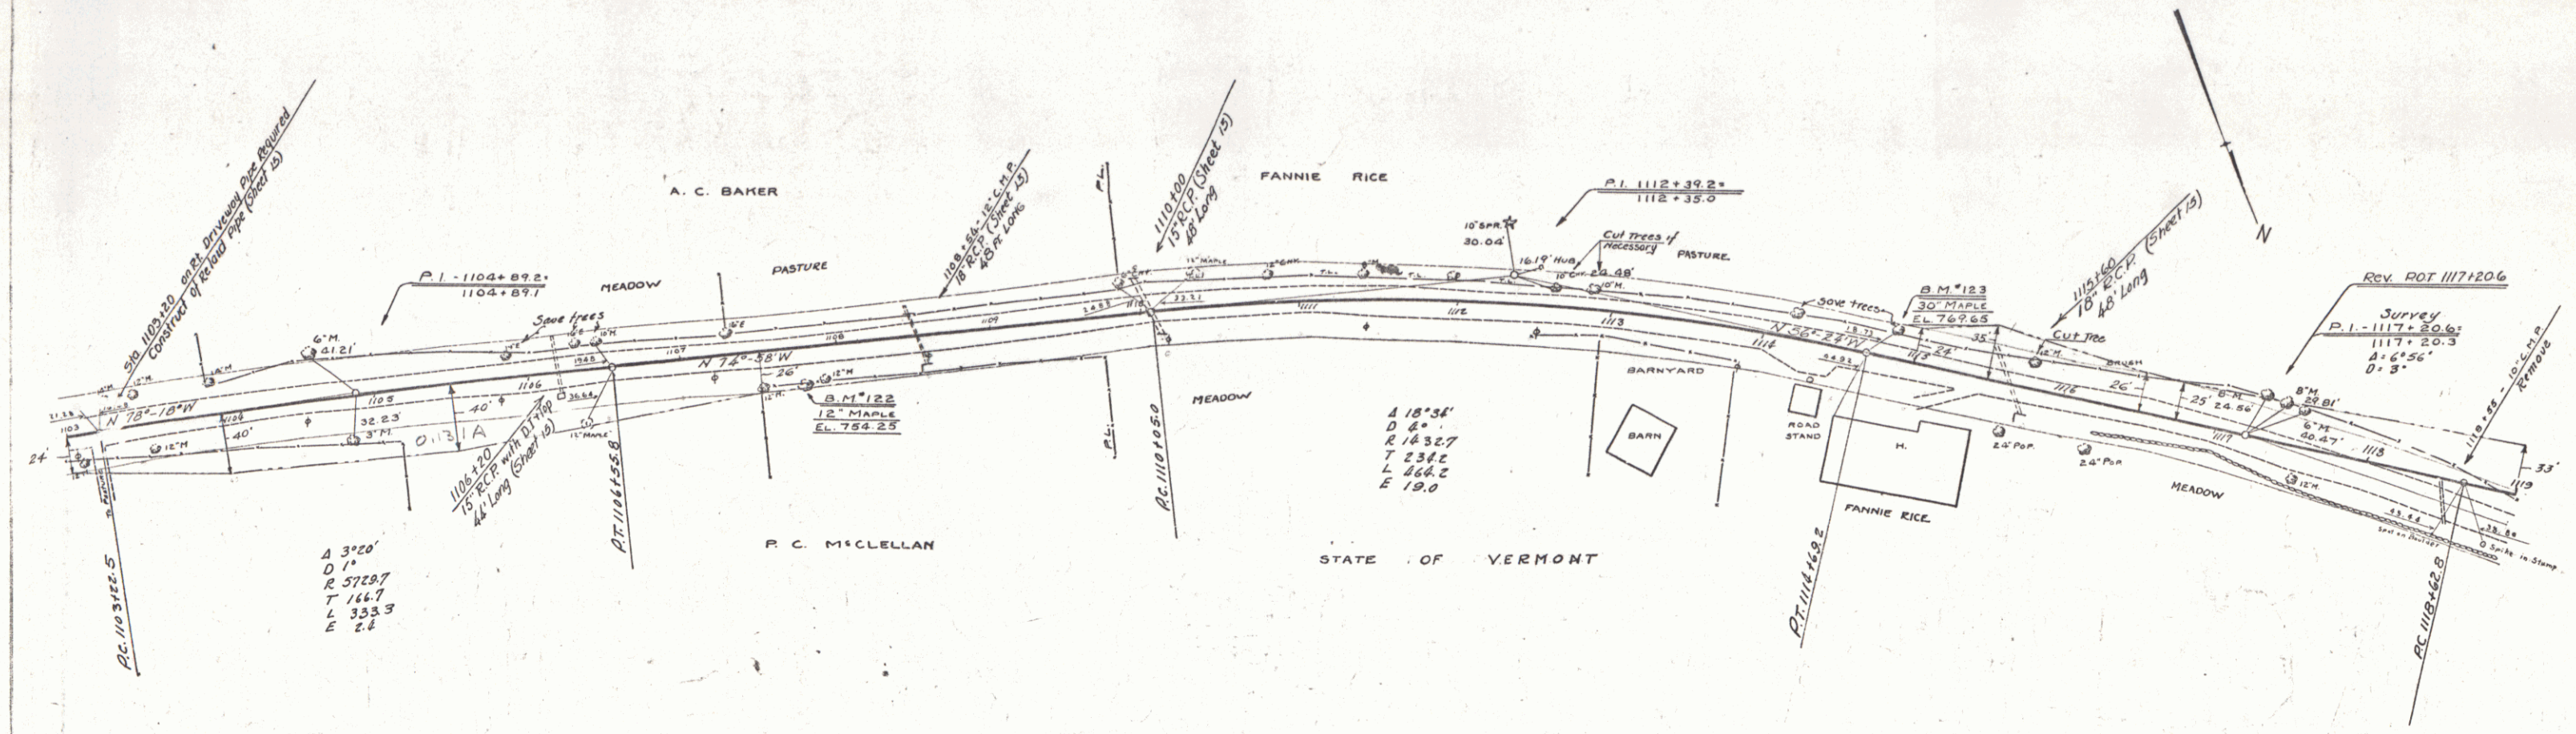

B.M. #122 Spike in Root 12" Maple 20 Ft. R.Y. Sta. 1107+70 Elev. 754.25
 B.M. #123 Spike in Root 30" Maple 12 Ft. L.T. Sta. 1114+05 Elev. 769.65

