

INDEX OF SHEETS

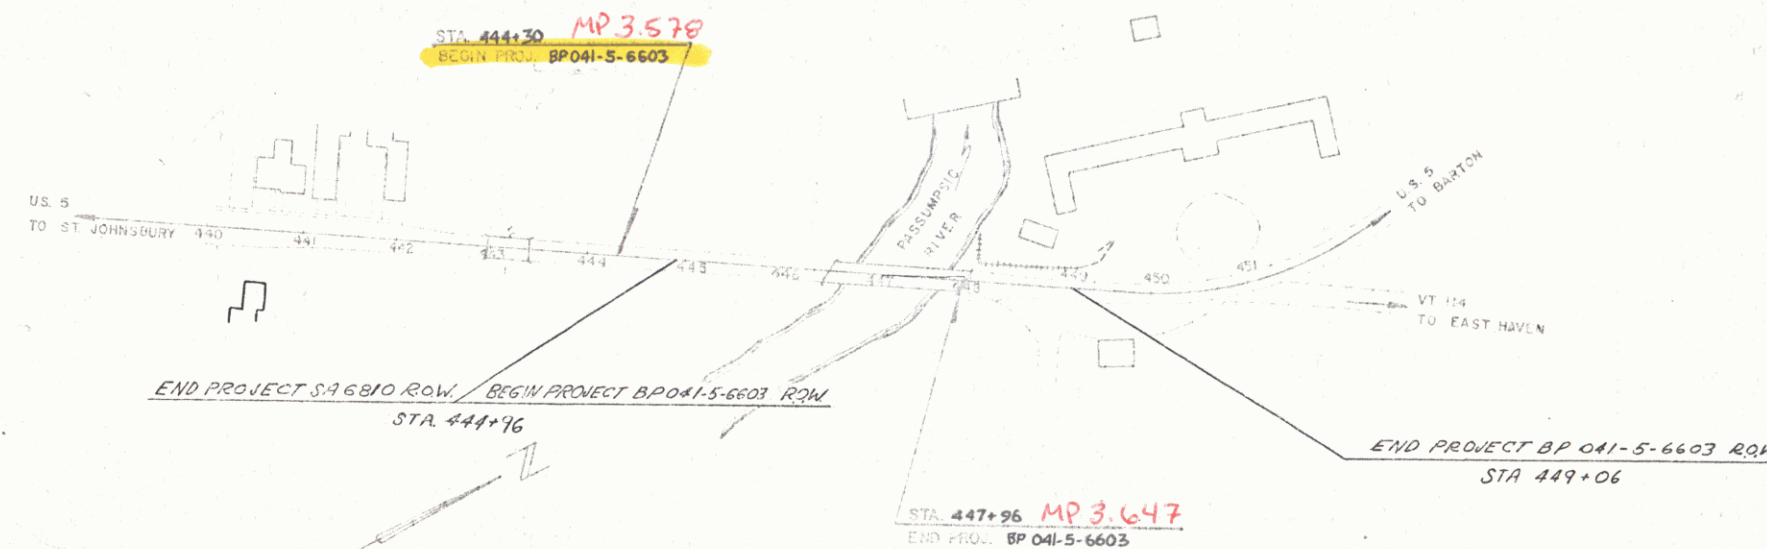
TOWN OF LYNDON
COUNTY OF CALEDONIA
U.S. ROUTE 5
ST. JOHNSBURY-NEWPORT RD.

Pin# 99R240

BEGINNING AT A POINT APPROXIMATELY 670 FT. SOUTHWESTERLY OF THE
PRESENT INTERSECTION OF OF U.S. ROUTE 5 AND VT. 114 IN THE
TOWN OF LYNDON AND EXTENDING NORTHEASTERLY 366 FT

BRIDGE TOTAL 1470 FT.
ROADWAY TOTAL 219.0 FT.
PROJECT TOTAL 3660 FT.

ROW PLANS

DEPARTMENT OF TRANSPORTATION
BUREAU OF PUBLIC ROADS

APPROVED

PROJ. LYNDON BP 041-5-6603

① 4