

INDEX OF SHEETS	
SHEET NO.	1 TITLE PAGE
2	TYPICAL CROSS-SECTION OF IMPROVEMENT (CRUSHED GRAVEL MIXED-IN-PLACE SURFACE COURSE WITH CUTBACK ASPHALT AND PRIME COAT OF REFINED TAR (CLASS C) ITEM 342)
3	BANKING AND WIDENING TABLES
4	QUANTITY SHEET - SUMMARY
5	QUANTITY SHEET - DRAINAGE
6-10	EARTHWORK SHEETS
11-20	PLAN AND PROFILE
21-23	PIPE CULVERTS 2-180" 368+42 & 368+75.1
24	FARM UNDERPASS 342+75
25	STANDARD STRUCTURE SHEET
26	"
27	"
28	"
29	"
30-71	CROSS SECTIONS
S-40	BARRICADES, SIGNS & LIGHTS
S-41	TYPICAL GRADING
S-46-45	MARKERS
S-47-45	PIPE CULVERTS
S-48-46	THREE CABLE GUARD RAIL WITH STEEL POSTS

STANDARD STRUCTURE SHEETS APPROVED BY THE CHIEF ENGINEER, VERMONT STATE DEPT OF HIGHWAYS

S-40	DEC. 18, 1945
S-41	DEC. 3, 1941
S-46-45	OCT. 6, 1945
S-47-45	OCT. 6, 1945
S-48-46	MAY. 13, 1946


STATE OF VERMONT STATE HIGHWAY DEPARTMENT

PLAN AND PROFILE OF PROPOSED STATE HIGHWAY FEDERAL INTERSTATE PROJECT

TOWN OF DUMMERSTON Pin # 99R 254
COUNTY OF WINDHAM
BRATTLEBORO-BELLOWS FALLS ROAD
U.S. ROUTE 5

BEGINNING AT A POINT 2,968 MILES NORTHERLY OF THE BRATTLEBORO-DUMMERSTON TOWN LINE AND EXTENDING NORTHERLY 7,144.7 FEET

LENGTH OF PROJECT 7,144.7 FEET = 1.353 MILES

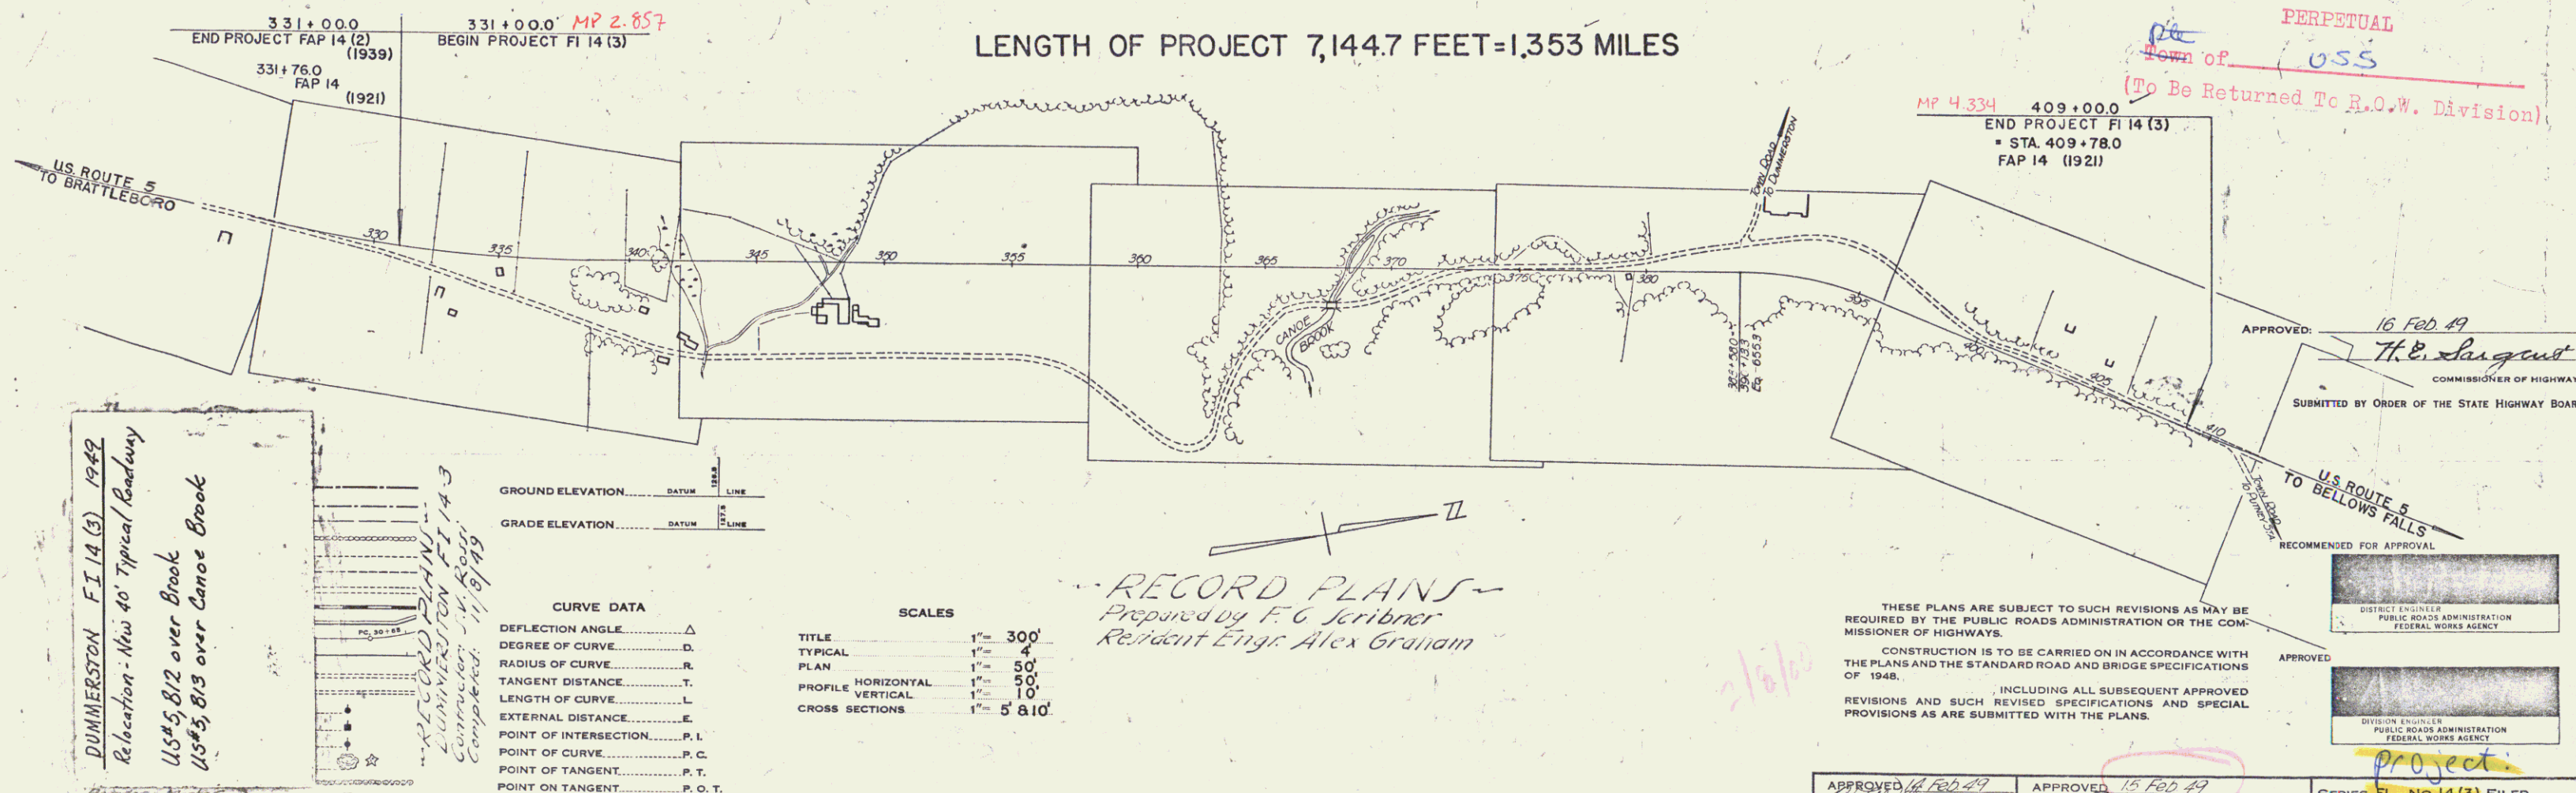

DUMMERSTON FI 14 (3) 1949
Relocation - New 40' Typical Roadway
US# 5, 812 over Brook
US# 5, 813 over Canoe Brook

RECORD PLAN
DUMMERSTON FI 14 (3)
Completed 11/8/49


GROUND ELEVATION	DATUM	LINE
GRADE ELEVATION	DATUM	LINE
CURVE DATA		
DEFLECTION ANGLE	Δ	
DEGREE OF CURVE	D	
RADIUS OF CURVE	R	
TANGENT DISTANCE	T	
LENGTH OF CURVE	L	
EXTERNAL DISTANCE	E	
POINT OF INTERSECTION	P. I.	
POINT OF CURVE	P. C.	
POINT OF TANGENT	P. T.	
POINT ON TANGENT	P. O. T.	

TITLE	1" = 300'
TYPICAL	1" = 4'
PLAN	1" = 50'
PROFILE HORIZONTAL	1" = 50'
PROFILE VERTICAL	1" = 10'
CROSS SECTIONS	1" = 5' & 10'

RECORD PLANS
Prepared by F. G. Scribner
Resident Engr. Alex Graham

THESE PLANS ARE SUBJECT TO SUCH REVISIONS AS MAY BE REQUIRED BY THE PUBLIC ROADS ADMINISTRATION OR THE COMMISSIONER OF HIGHWAYS.
CONSTRUCTION IS TO BE CARRIED ON IN ACCORDANCE WITH THE PLANS AND THE STANDARD ROAD AND BRIDGE SPECIFICATIONS OF 1948.
INCLUDING ALL SUBSEQUENT APPROVED REVISIONS AND SUCH REVISED SPECIFICATIONS AND SPECIAL PROVISIONS AS ARE SUBMITTED WITH THE PLANS.

APPROVED 16 Feb 49 District Highway Engineer	APPROVED 16 Feb 49 District Highway Commissioner	SERIES FI No. 14 (3) FILED SHEET (1) OF 71
---	---	---

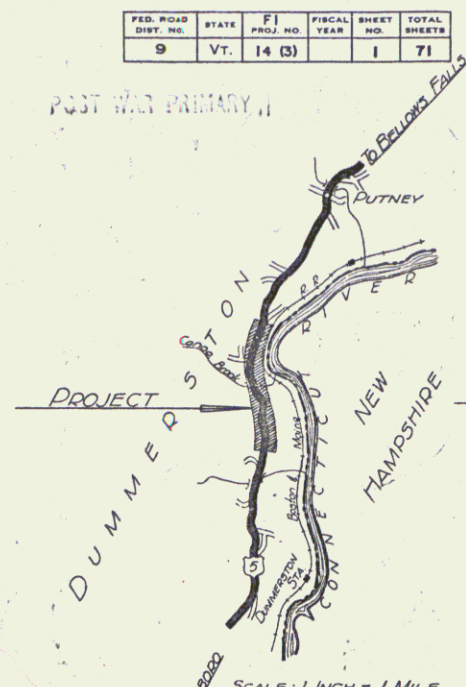


RIGHT-OF-WAY DIVISION
TOWN FILE
PERPETUAL
Town of Dummerston
(To Be Returned To R.O.W. Division)

APPROVED 16 Feb 49
H. E. Sargent
COMMISSIONER OF HIGHWAYS
SUBMITTED BY ORDER OF THE STATE HIGHWAY BOARD

RECOMMENDED FOR APPROVAL
DISTRICT ENGINEER
PUBLIC ROADS ADMINISTRATION
FEDERAL WORKS AGENCY
APPROVED
DIVISION ENGINEER
PUBLIC ROADS ADMINISTRATION
FEDERAL WORKS AGENCY

PARCEL	INSTRUMENT	DATE	GRANTOR	GRANTEE	RECORDED DUMMERSTON	REMARKS
#					BOOK PAGE DATE	
#1 A	W.D.O.E.	4-6-49	JOHN L. WILLIAMS	ST OF VT.	33 191 1-9-49	
#2 A		4-7-49	CHARLES G. FLORENCE CAMARL TOWNSHEND		195-196 1-12-49	
#3 A		3-19-49	GEORGE E. ISABELLE S. RANNEY	T.M. OF DUMMERSTON	487-489 1-1-49	#3 B/C ON SHEET 18
#3 A		3-29-49			489-490	

POST WAR PRIMARY

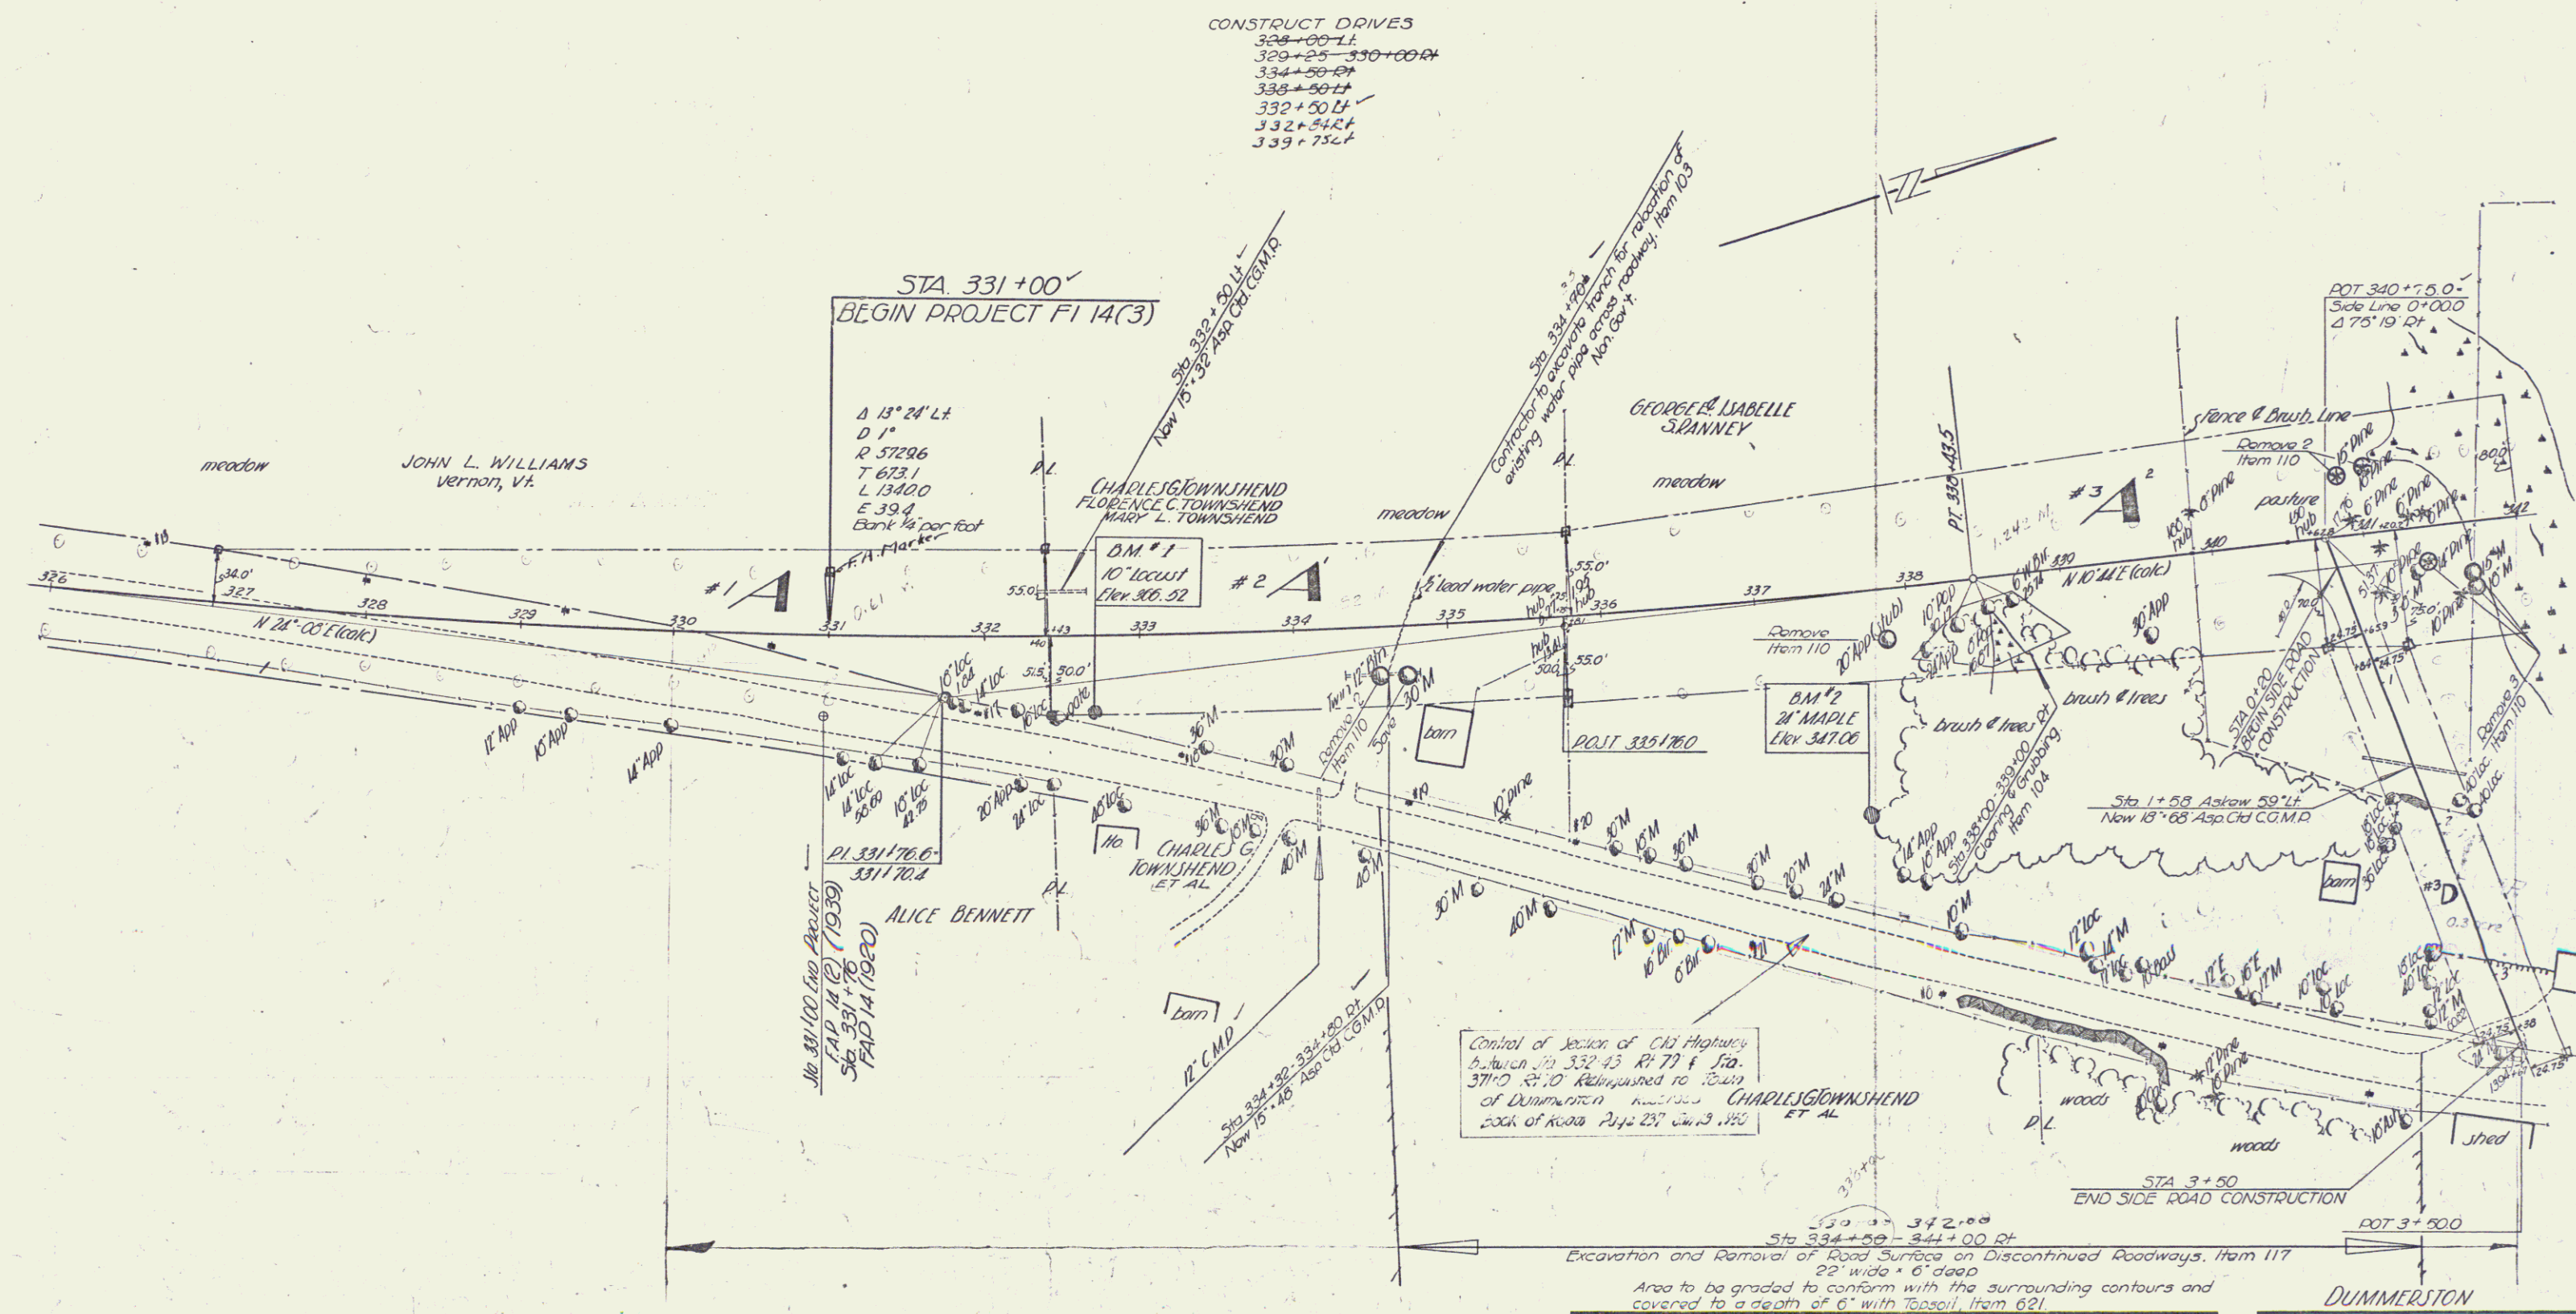


DUMMERSTON	
Surveyed by LANE 11-47	Designed by LANE
Drawn by LANE	Traced by AVERILL
Checked by	Series FI No. 14(5)
	Sheet 12 of 71

PARCEL	INSTRUMENT	DATE	GRANTOR	GRANTEE	RECORDED DUMMERSTON	REMARKS	CONSTRUCT DRIVES
#39 & C	W.D.O.E.	3-29-49	GEORGE E. & ISABELLE S. RANNEY	STORVIT	BOOK	DATE	
#40 & C	X	4-5-49	WILLIAM HICKIN	---	33	487-489	4-1-49 #3A ON SH 12
SCHOOL HOUSE	Q.C.D.	5-31-49	TOWN OF DUMMERSTON	---	---	492-494	4-9-49 #4A ON SH. 16-14 D.E. ON SH. 12
					---	499	5-31-49

Sta 391+58
Sta 392+00±
Install 6" iron pipe for barn drain.
under fill, Item 103, New Govt.
Dips to be furnished by Property Owner.
Exact location to be determined in field.

Sta 392+00±
Install 6" iron pipe for house sewer.
under fill, Item 103, New Govt.
Dips to be furnished by Property Owner.
Exact location to be determined in field.

POST WAR-PRIMARY

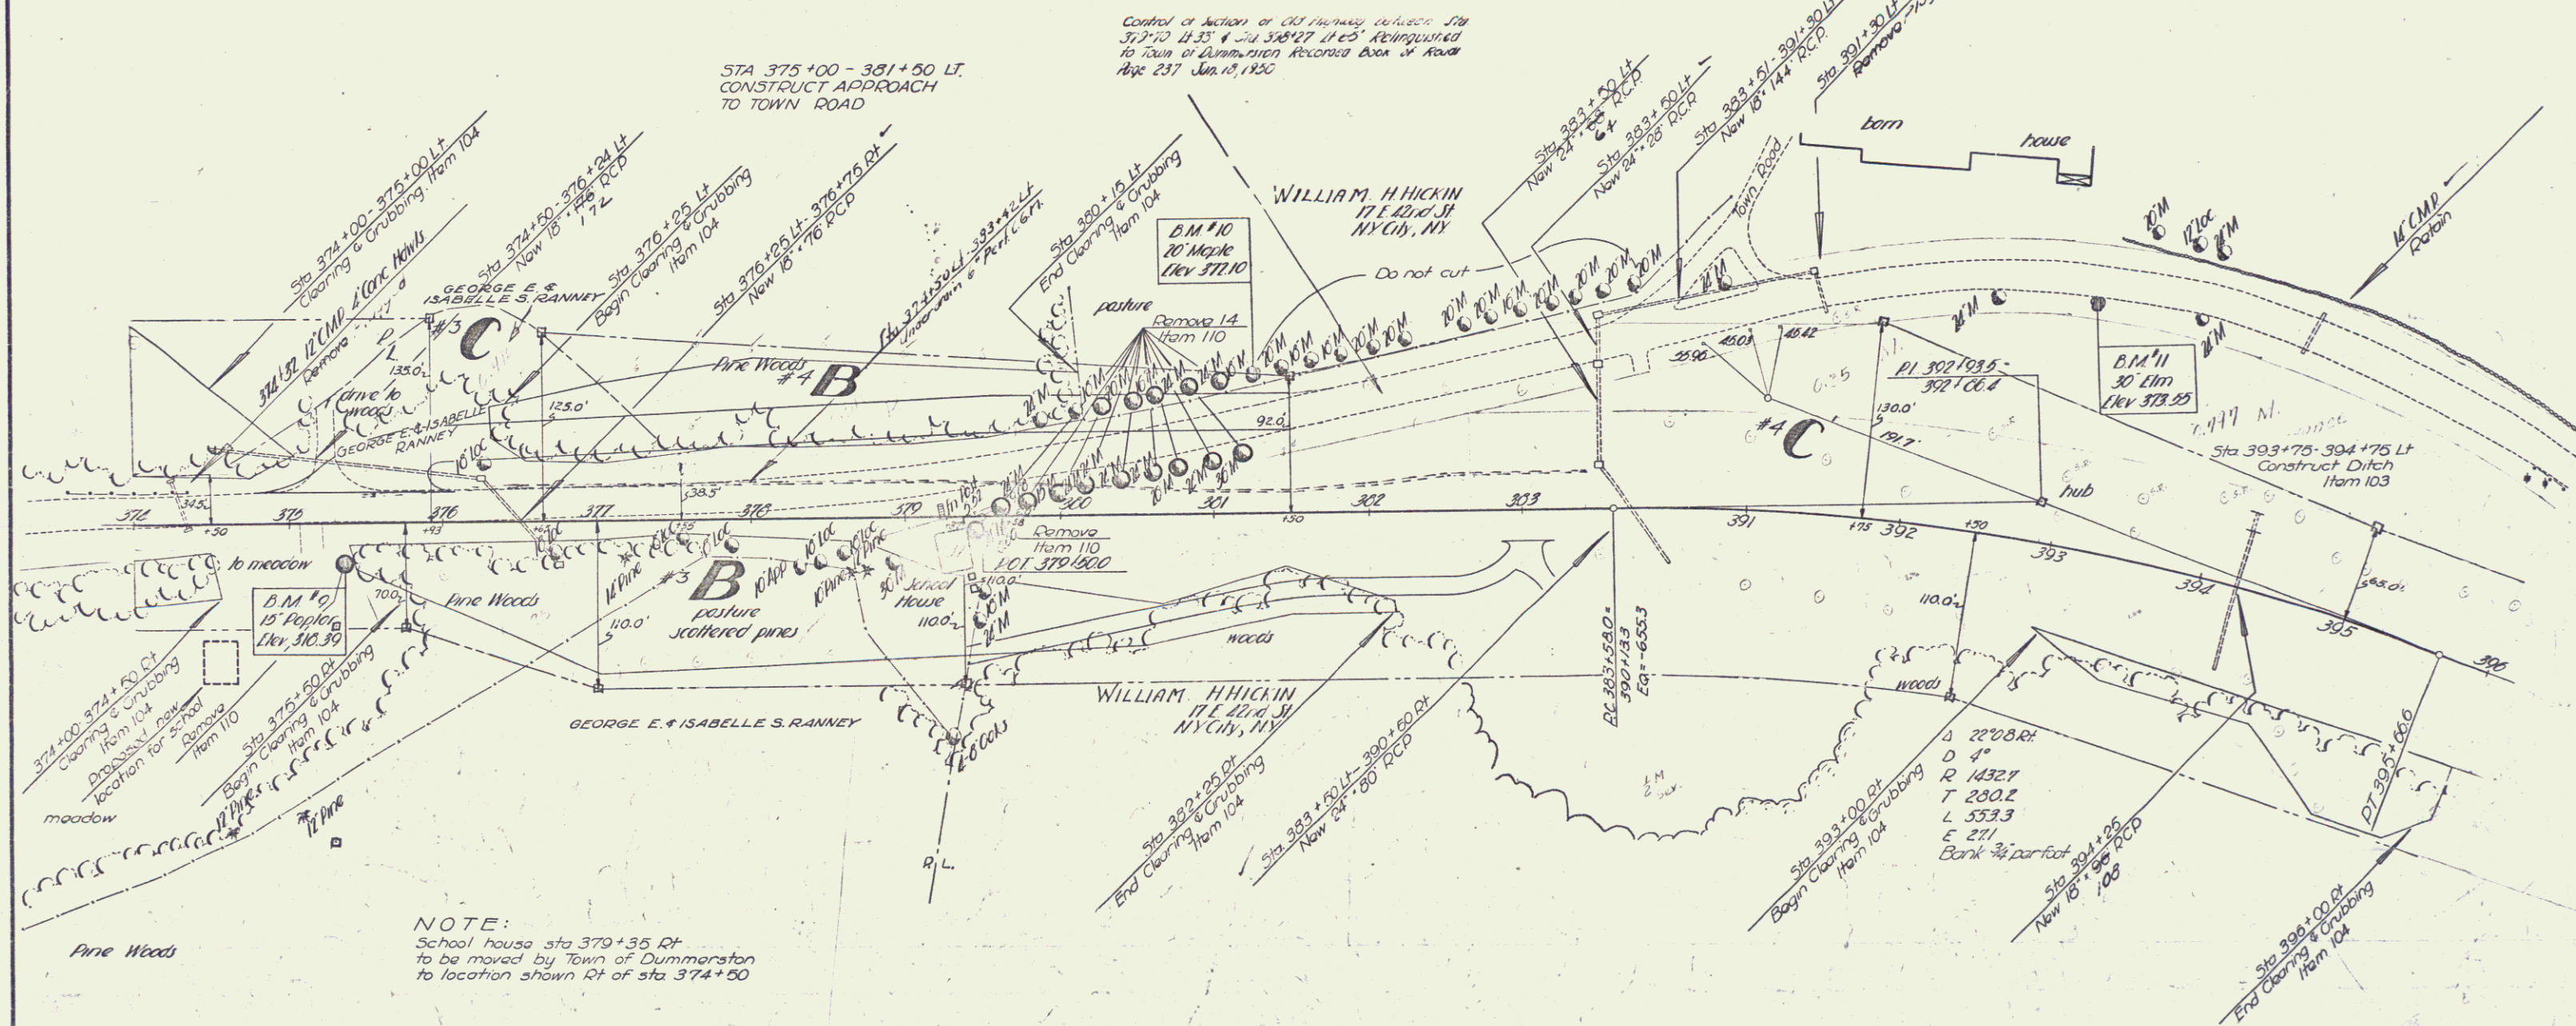

DUMMERSTON

Surveyed by LANE 11 47
Designed by LANE
Drawn by LANE
Traced by AVERILL
Checked by
Series F1 No. 14(3) Filed
Sheet 15 of 11 Sheets

FED. ROAD DIST. NO.	STATE	F1	FISCAL YEAR	SHEETS	TOTAL SHEETS
9	V	14(3)	20	71	

POST WAR PRIMARY

