


POOR ORIGINAL COPY

(To Be Returned to H.O.W. Division)

RIGHT-OF-WAY DIVISION
TOWN OF
PERPETUAL
W.P. 5.9 ±

PLAN	DATE
DESIGNED BY	
CHECKED BY	
APPROVED BY	
DATE	

PROFILE	DATE
DESIGNED BY	
CHECKED BY	
APPROVED BY	
DATE	

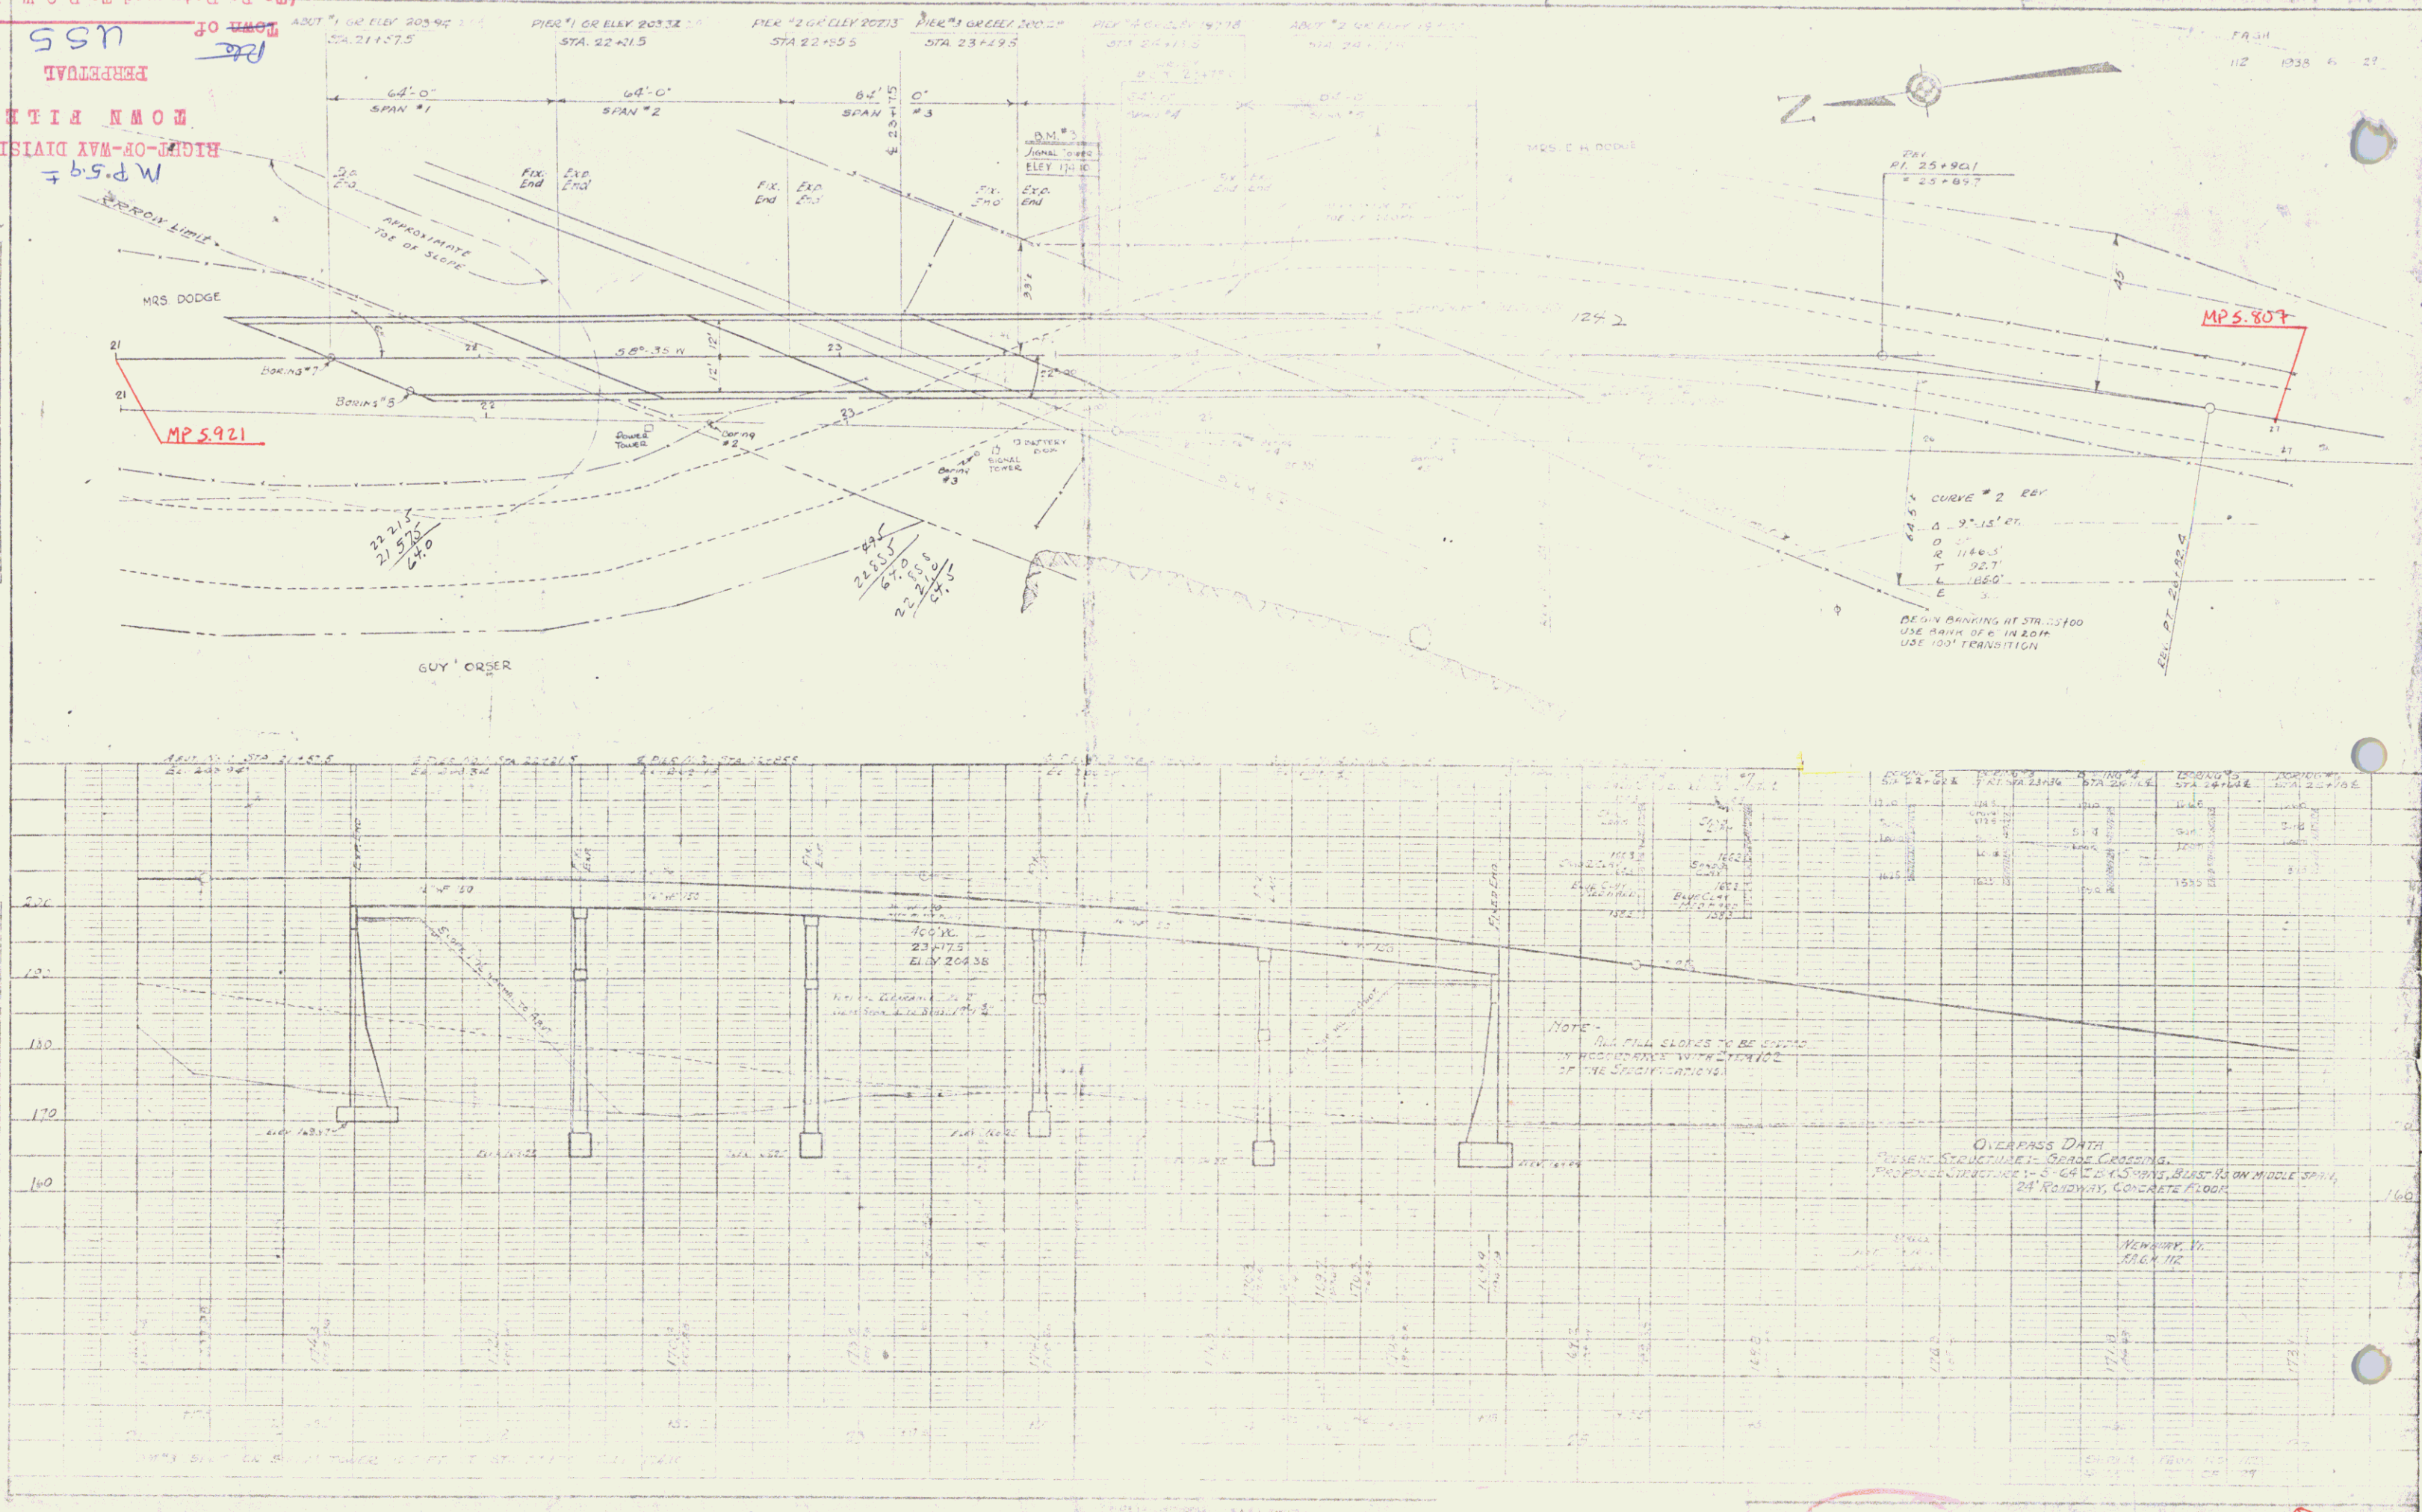

NEWBURY PR 181