


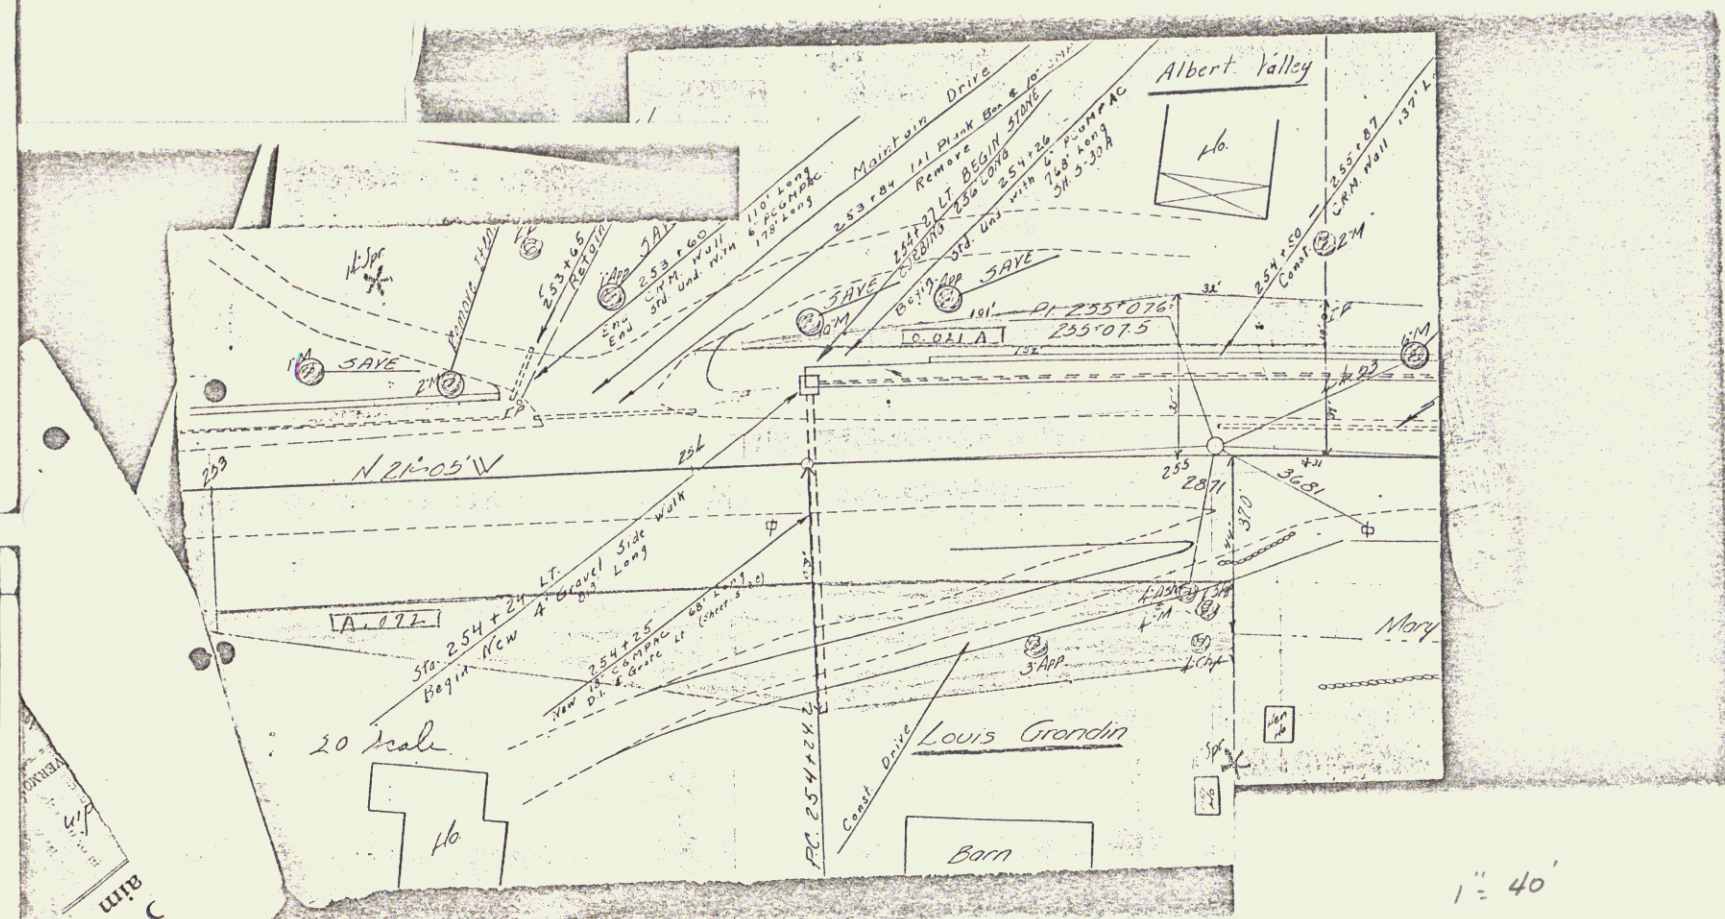

Barton US5

3

3