

PLAN	DATE	BY
DATE	BY	
NO.	NO.	NO.

PROFILE	DATE	BY
DATE	BY	
NO.	NO.	NO.

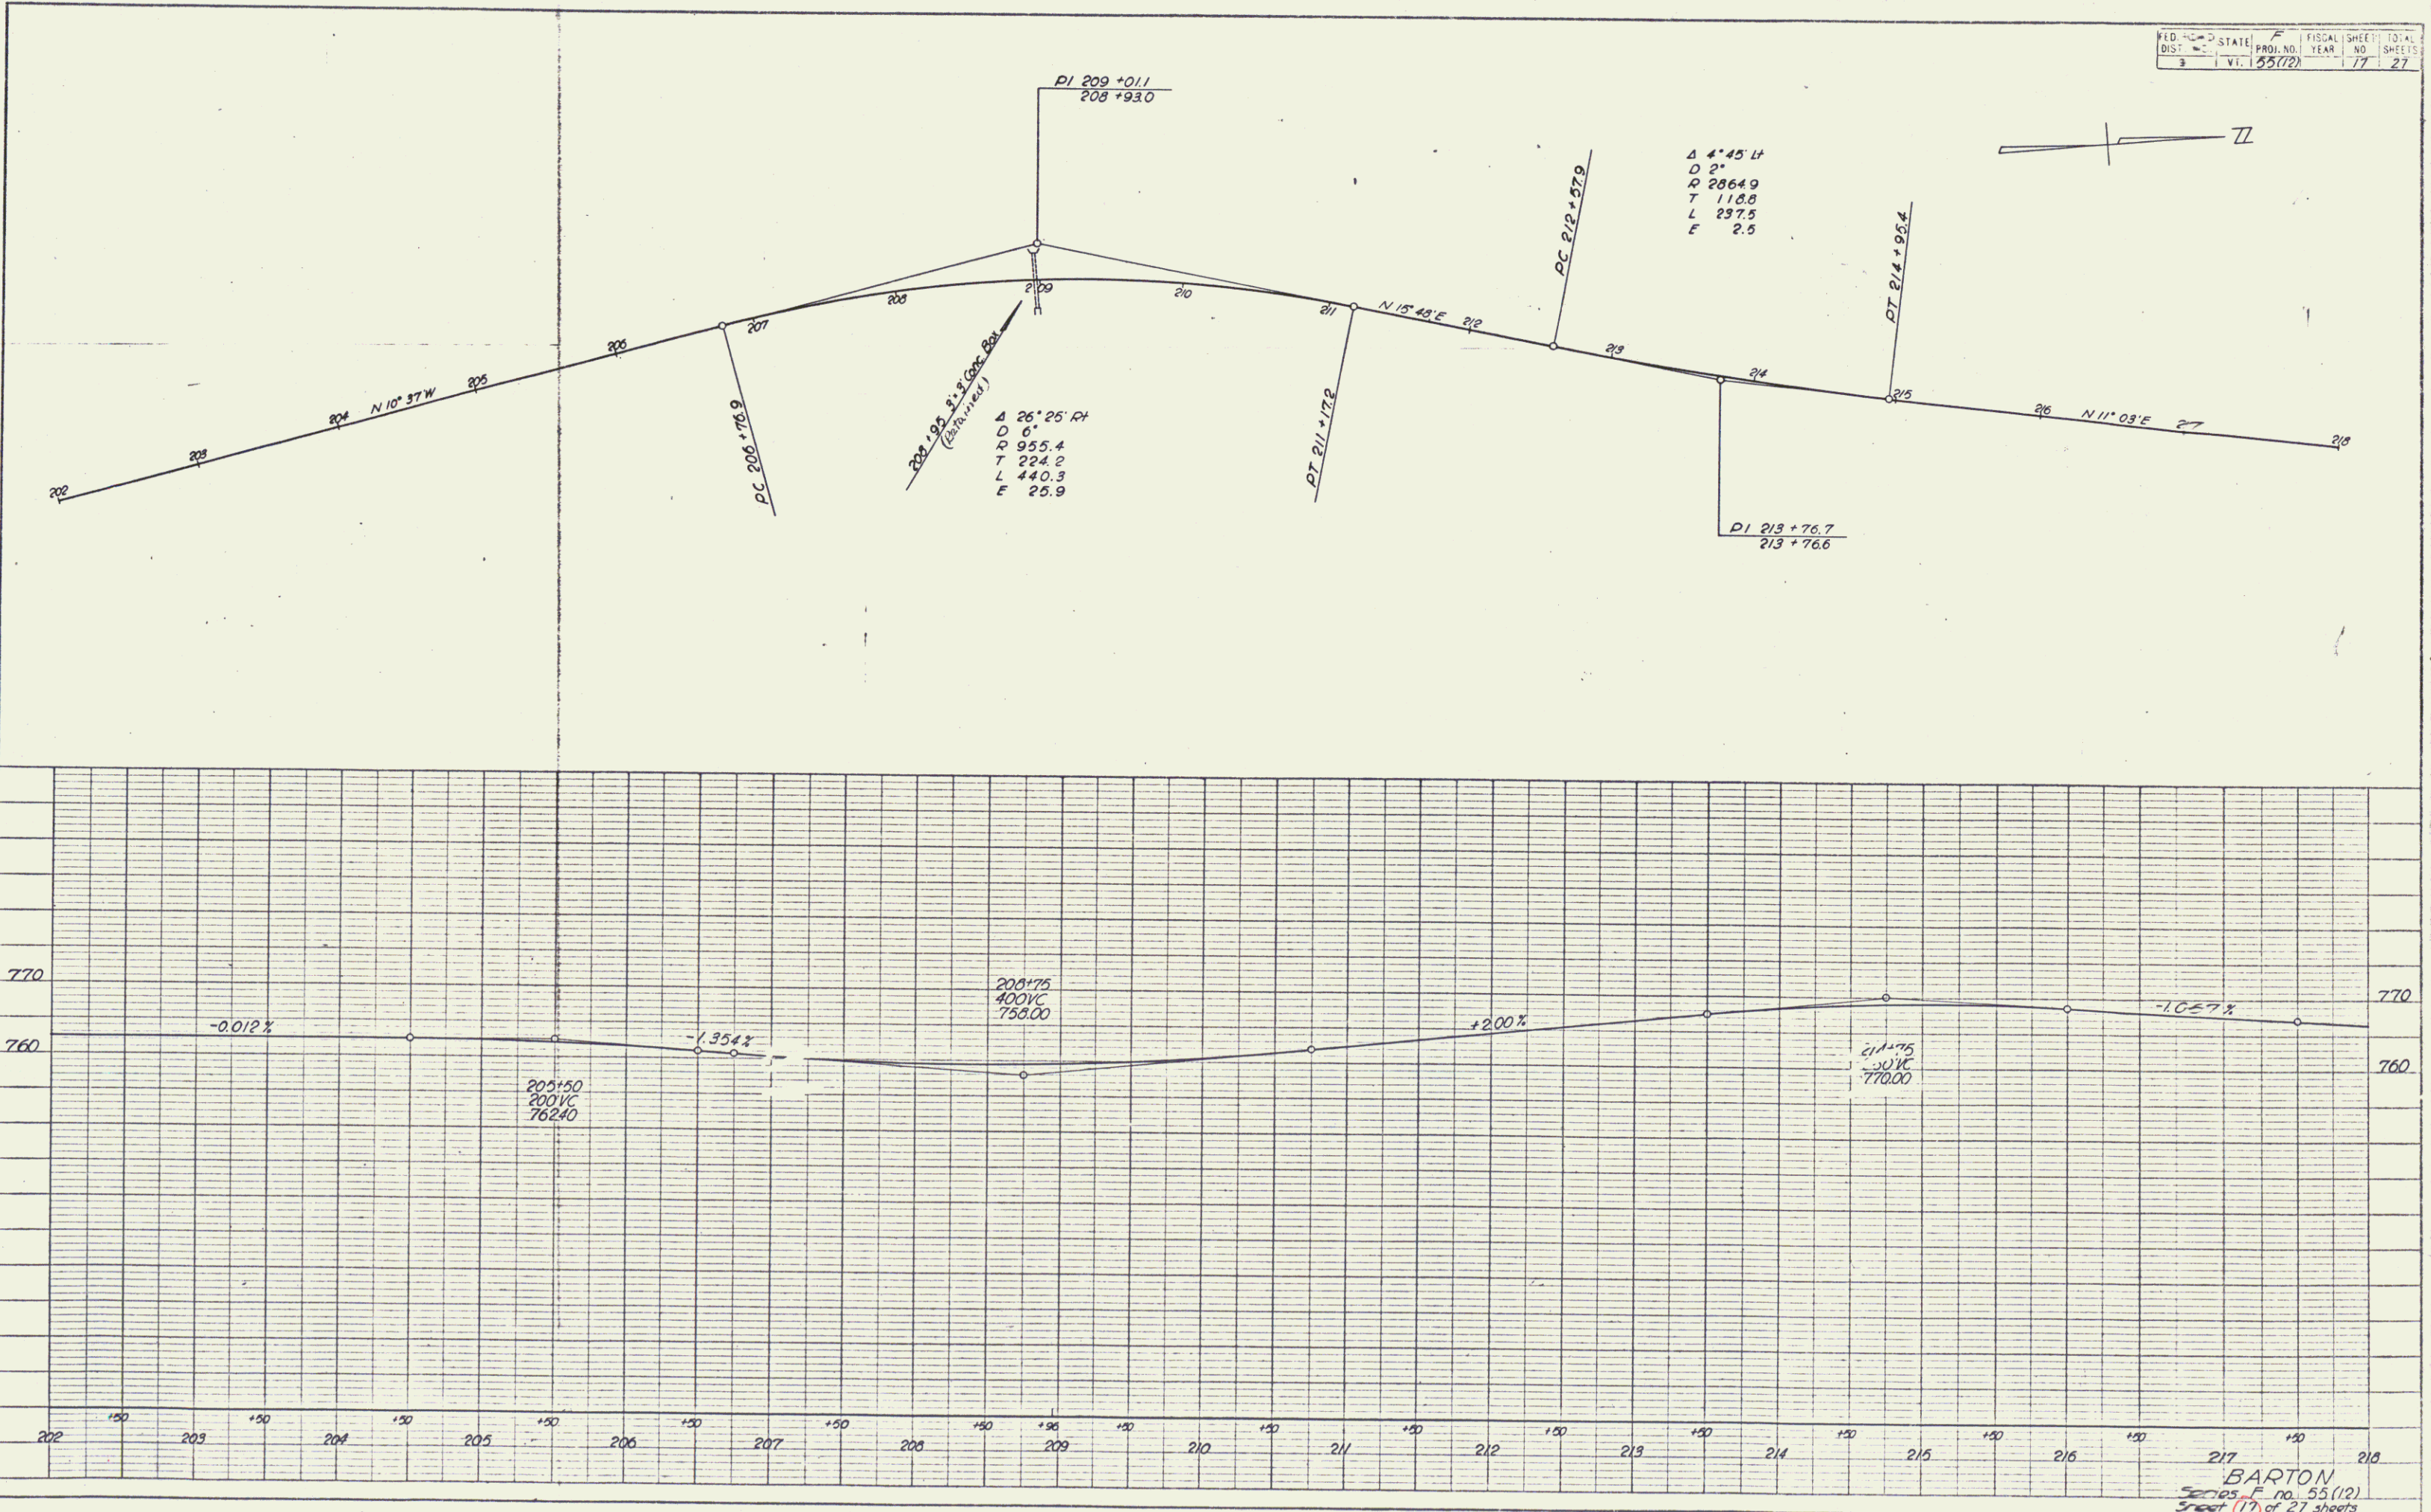


PLATE 1 - PLAN-PROFILE OF P & R K STANDARD

K & E Co. No. 348-10

BARTON
Series F no. 55(12)
Sheet 17 of 27 sheets