

INDEX OF SHEETS	
SHEET NO	TITLE PAGE
1	TITLE PAGE
2	TYPICAL CROSS-SECTION OF IMPROVEMENT (BITUMINOUS CONCRETE PAVEMENT, ITEM 361-B)
3	BANKING & WIDENING TABLES
4	QUANTITY SHEET (ITEMS)
5	QUANTITY SHEET (DRAINAGE)
6-9	EARTHWORK SHEETS
10-21	PLAN AND PROFILE SHEETS
22	CONSTRUCTION DETAILS CD (DRAINAGE AND MARKERS)
23	CONSTRUCTION DETAILS CD-2 (TYPICAL GRADING)
24	STANDARD STRUCTURE SHEET S-40 (BARRICADES, SIGNS, AND LIGHTS)
25	STANDARD STRUCTURE SHEET S-48-46 (THREE CABLE GUARD RAIL)
26	STANDARD STRUCTURE SHEET S-53-48 (PRECAST CONCRETE PIPE DROP INLET)
27	PRELIMINARY INFORMATION SHEET
28	PLAN
29	PROFILE
30	EARTHWORK SHEET
31	ABUTMENTS 1 AND 2-PLAN, ELEVATION AND DETAILS
32	PIER ELEVATIONS
33	PIER DETAILS
34	SUPERSTRUCTURE LAYOUT
35	SUPERSTRUCTURE DETAILS
36	DETAIL SHEET-RAILING, SOUPERS, CURB AND END PARTS
37	REINFORCING STEEL DETAILS
38	STANDARD SHEET 98-20 (DETAILS L1 AND L2)
39	STANDARD SHEET 98-11 (BARRICADES, SIGNS, AND LIGHTS) FOR BRIDGES
40-42	CHANNEL SECTIONS
43-103	CROSS-SECTIONS

STATE OF VERMONT DEPARTMENT OF HIGHWAYS

PROPOSED IMPROVEMENT

FEDERAL INTERSTATE PROJECT

TOWN OF NORWICH COUNTY OF WINDSOR WHITE RIVER JCT. - THETFORD ROAD U.S. ROUTE 5


BEGINNING AT A POINT APPROXIMATELY 6500 FEET
NORTH OF THE HARTFORD-NORWICH TOWN LINE AND
EXTENDING NORTHEASTERLY 11,553.7 FEET.

LENGTH OF ROADWAY 11,375.7 FT. • 2.154 MILES
LENGTH OF BRIDGE 178.0 FT. • 0.034 MILE

LENGTH OF PROJECT 11,553.7 FT • 2.188 MILES


Project: FI 114(15)

Pin# 99R311

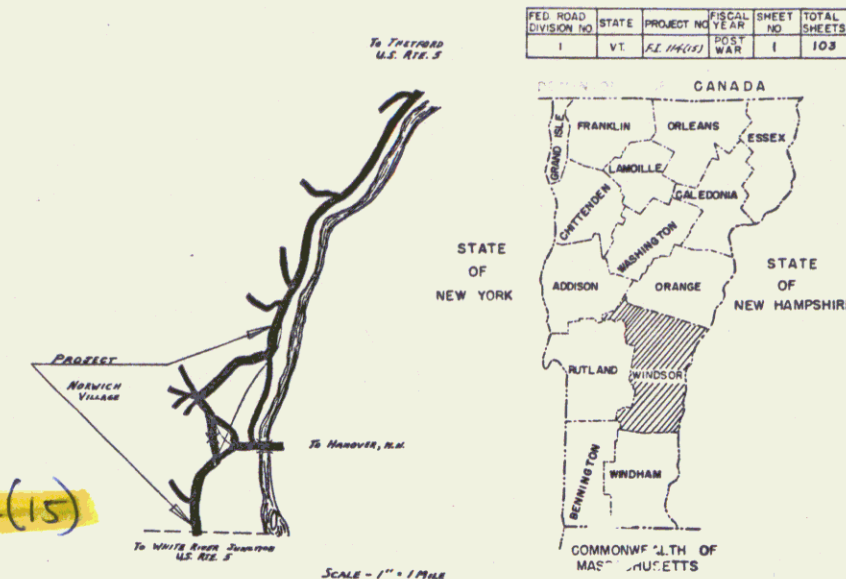

Historical
RIGHT-OF-WAY DIVISION
TOWN FILE

PERPETUAL
Town of U.S.
(To Be Returned To R.O.W. Division)

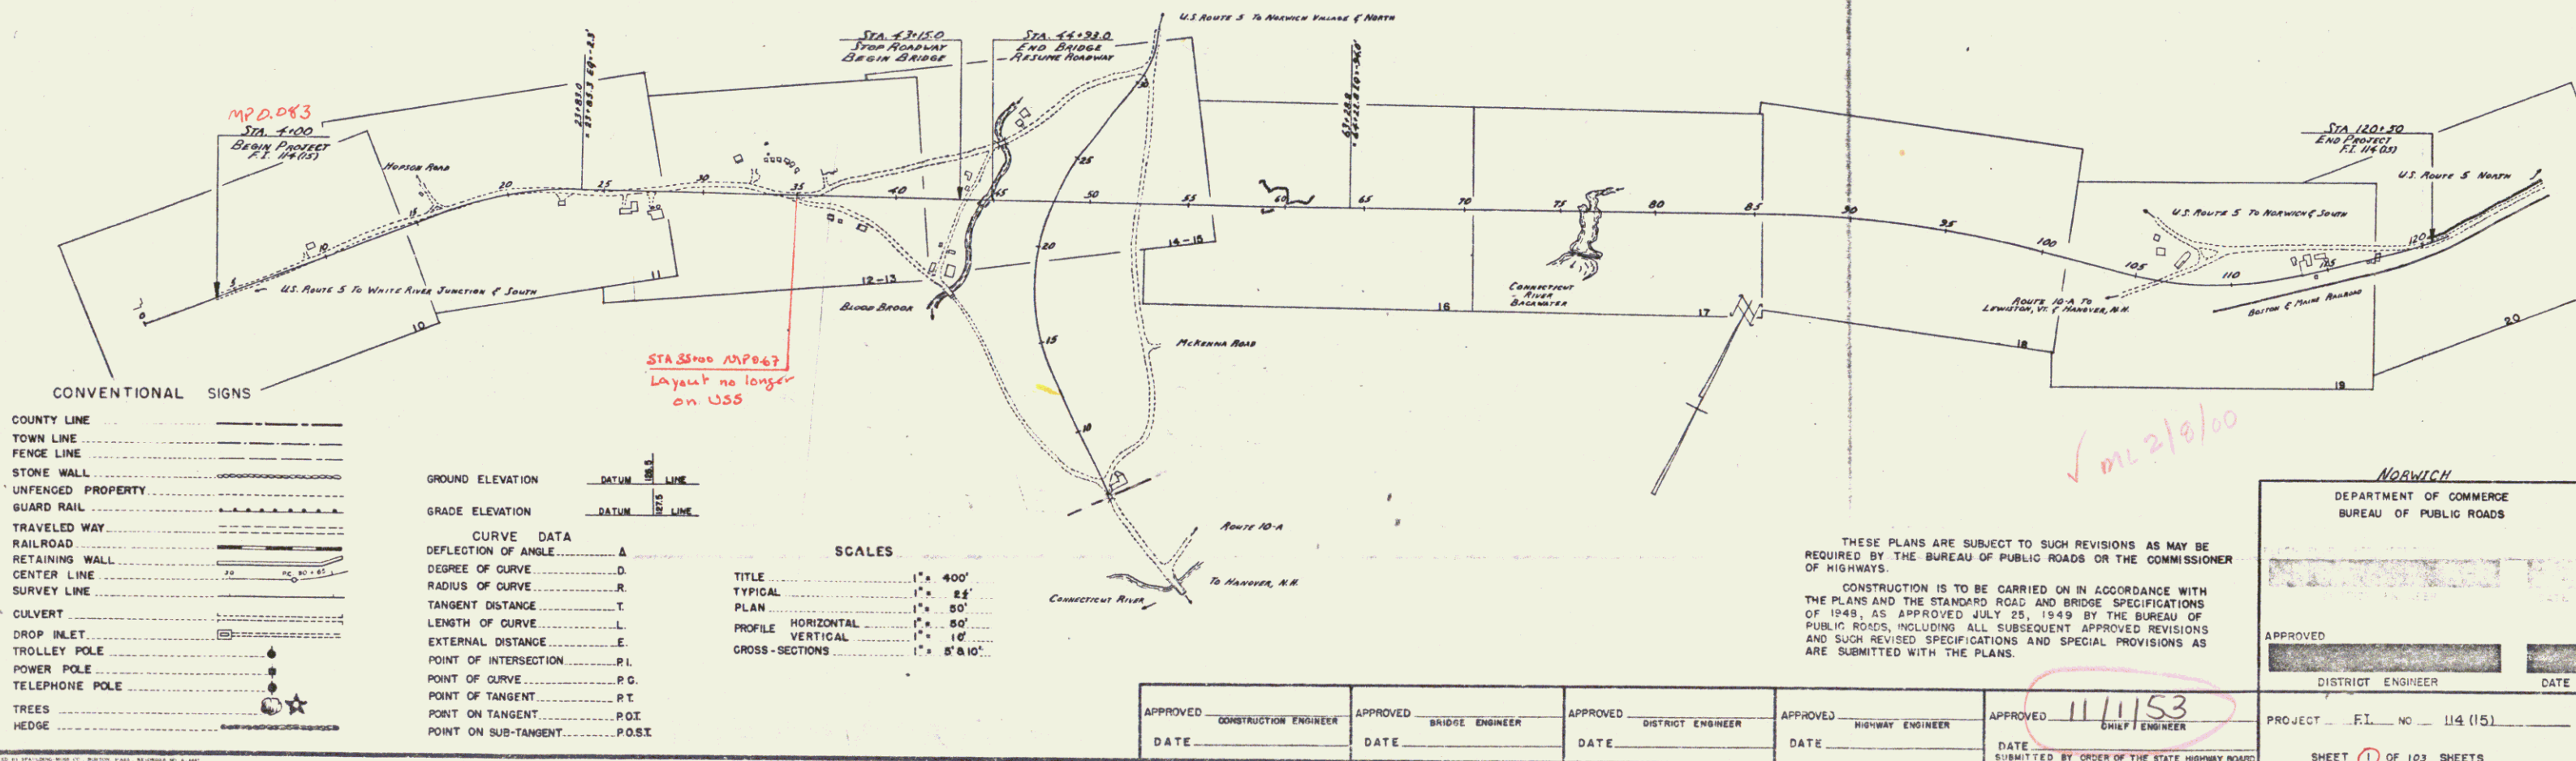

THESE PLANS ARE SUBJECT TO SUCH REVISIONS AS MAY BE
REQUIRED BY THE BUREAU OF PUBLIC ROADS OR THE COMMISSIONER
OF HIGHWAYS.


CONSTRUCTION IS TO BE CARRIED ON IN ACCORDANCE WITH
THE PLANS AND THE STANDARD ROAD AND BRIDGE SPECIFICATIONS
OF 1948, AS APPROVED JULY 25, 1949 BY THE BUREAU OF
PUBLIC ROADS, INCLUDING ALL SUBSEQUENT APPROVED REVISIONS
AND SUCH REVISED SPECIFICATIONS AND SPECIAL PROVISIONS AS
ARE SUBMITTED WITH THE PLANS.

APPROVED CONSTRUCTION ENGINEER DATE	APPROVED BRIDGE ENGINEER DATE	APPROVED DISTRICT ENGINEER DATE	APPROVED HIGHWAY ENGINEER DATE	APPROVED 11/1/53 CHIEF ENGINEER DATE
---	-------------------------------------	---------------------------------------	--------------------------------------	---

NORWICH DEPARTMENT OF COMMERCE BUREAU OF PUBLIC ROADS	
APPROVED DISTRICT ENGINEER DATE	PROJECT FI NO 114(15) SHEET (1) OF 103 SHEETS

PLAN	PROJECT	DATE
NOTE BOOK	NOTE BOOK	NOTE BOOK
BY	BY	BY
BY	BY	BY


PROFILE	PROJECT	DATE
NOTE BOOK	NOTE BOOK	NOTE BOOK
BY	BY	BY
BY	BY	BY

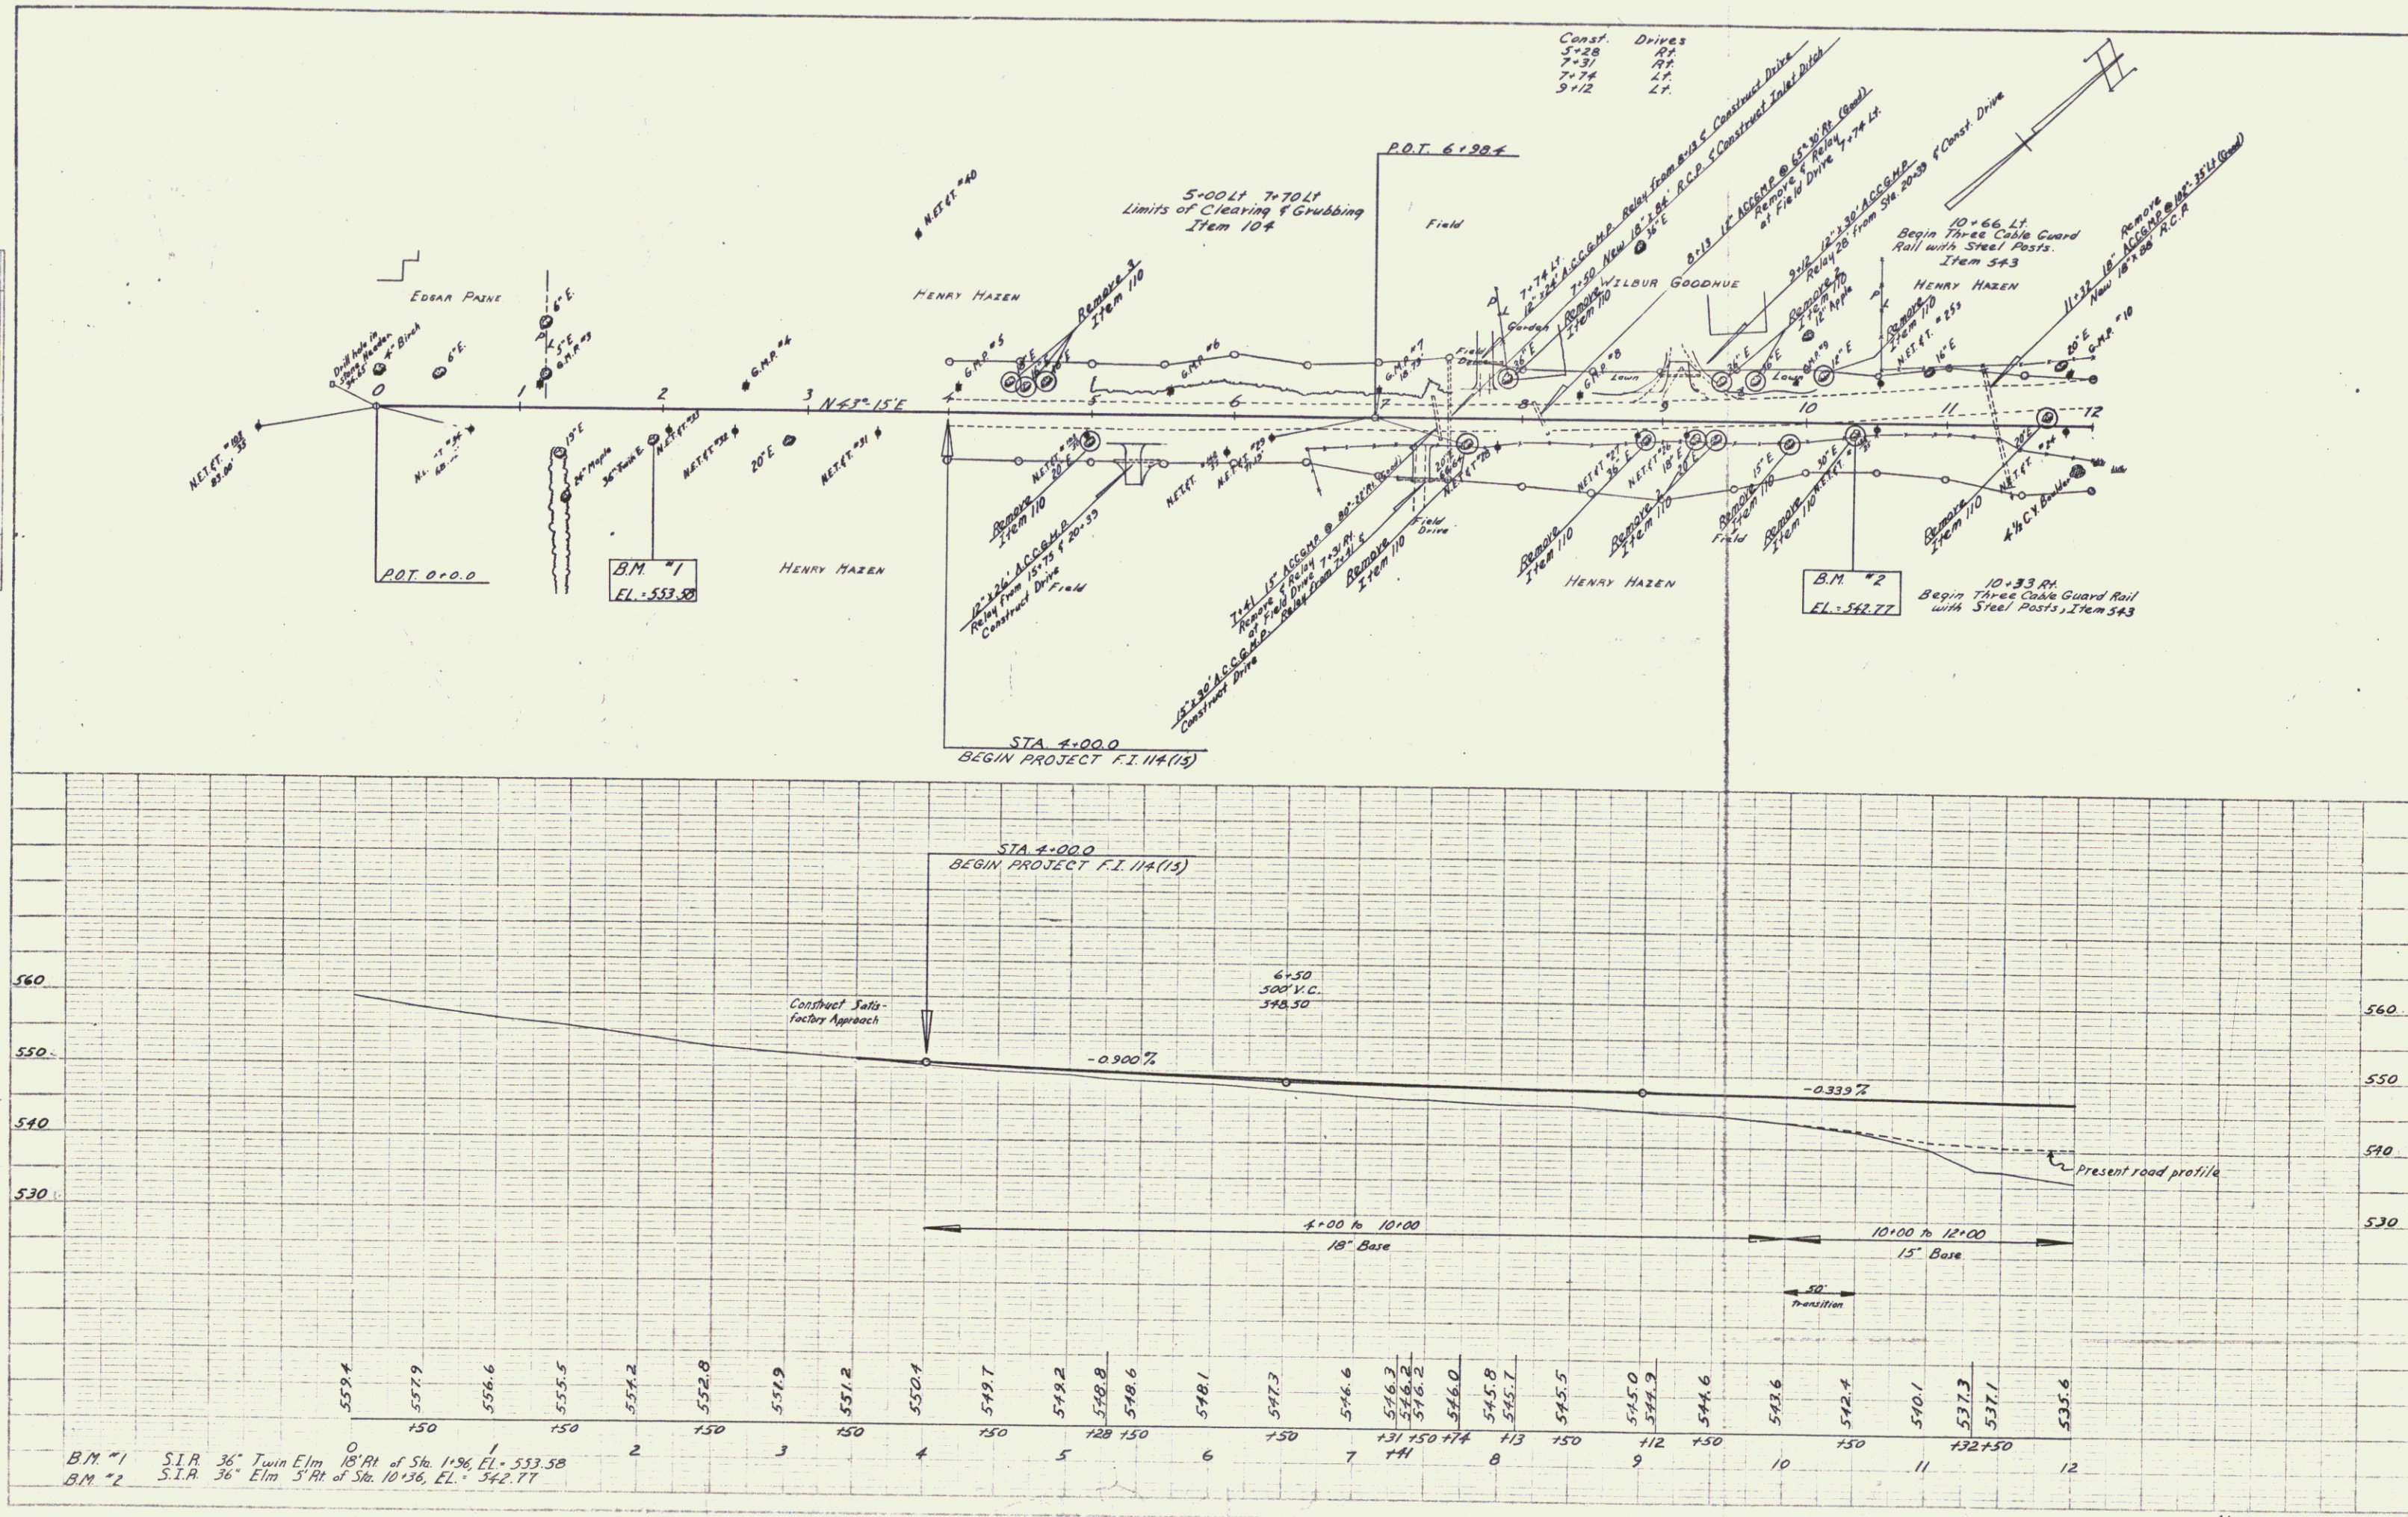



NORWICH
Project F.I. No 114(15)
Sheet 10 of 103

PLAN
 DRAWN BY
 CHECKED BY
 DATE
 SCALE
 1" = 40'

PROFILE
 DRAWN BY
 CHECKED BY
 DATE
 SCALE
 1" = 10'

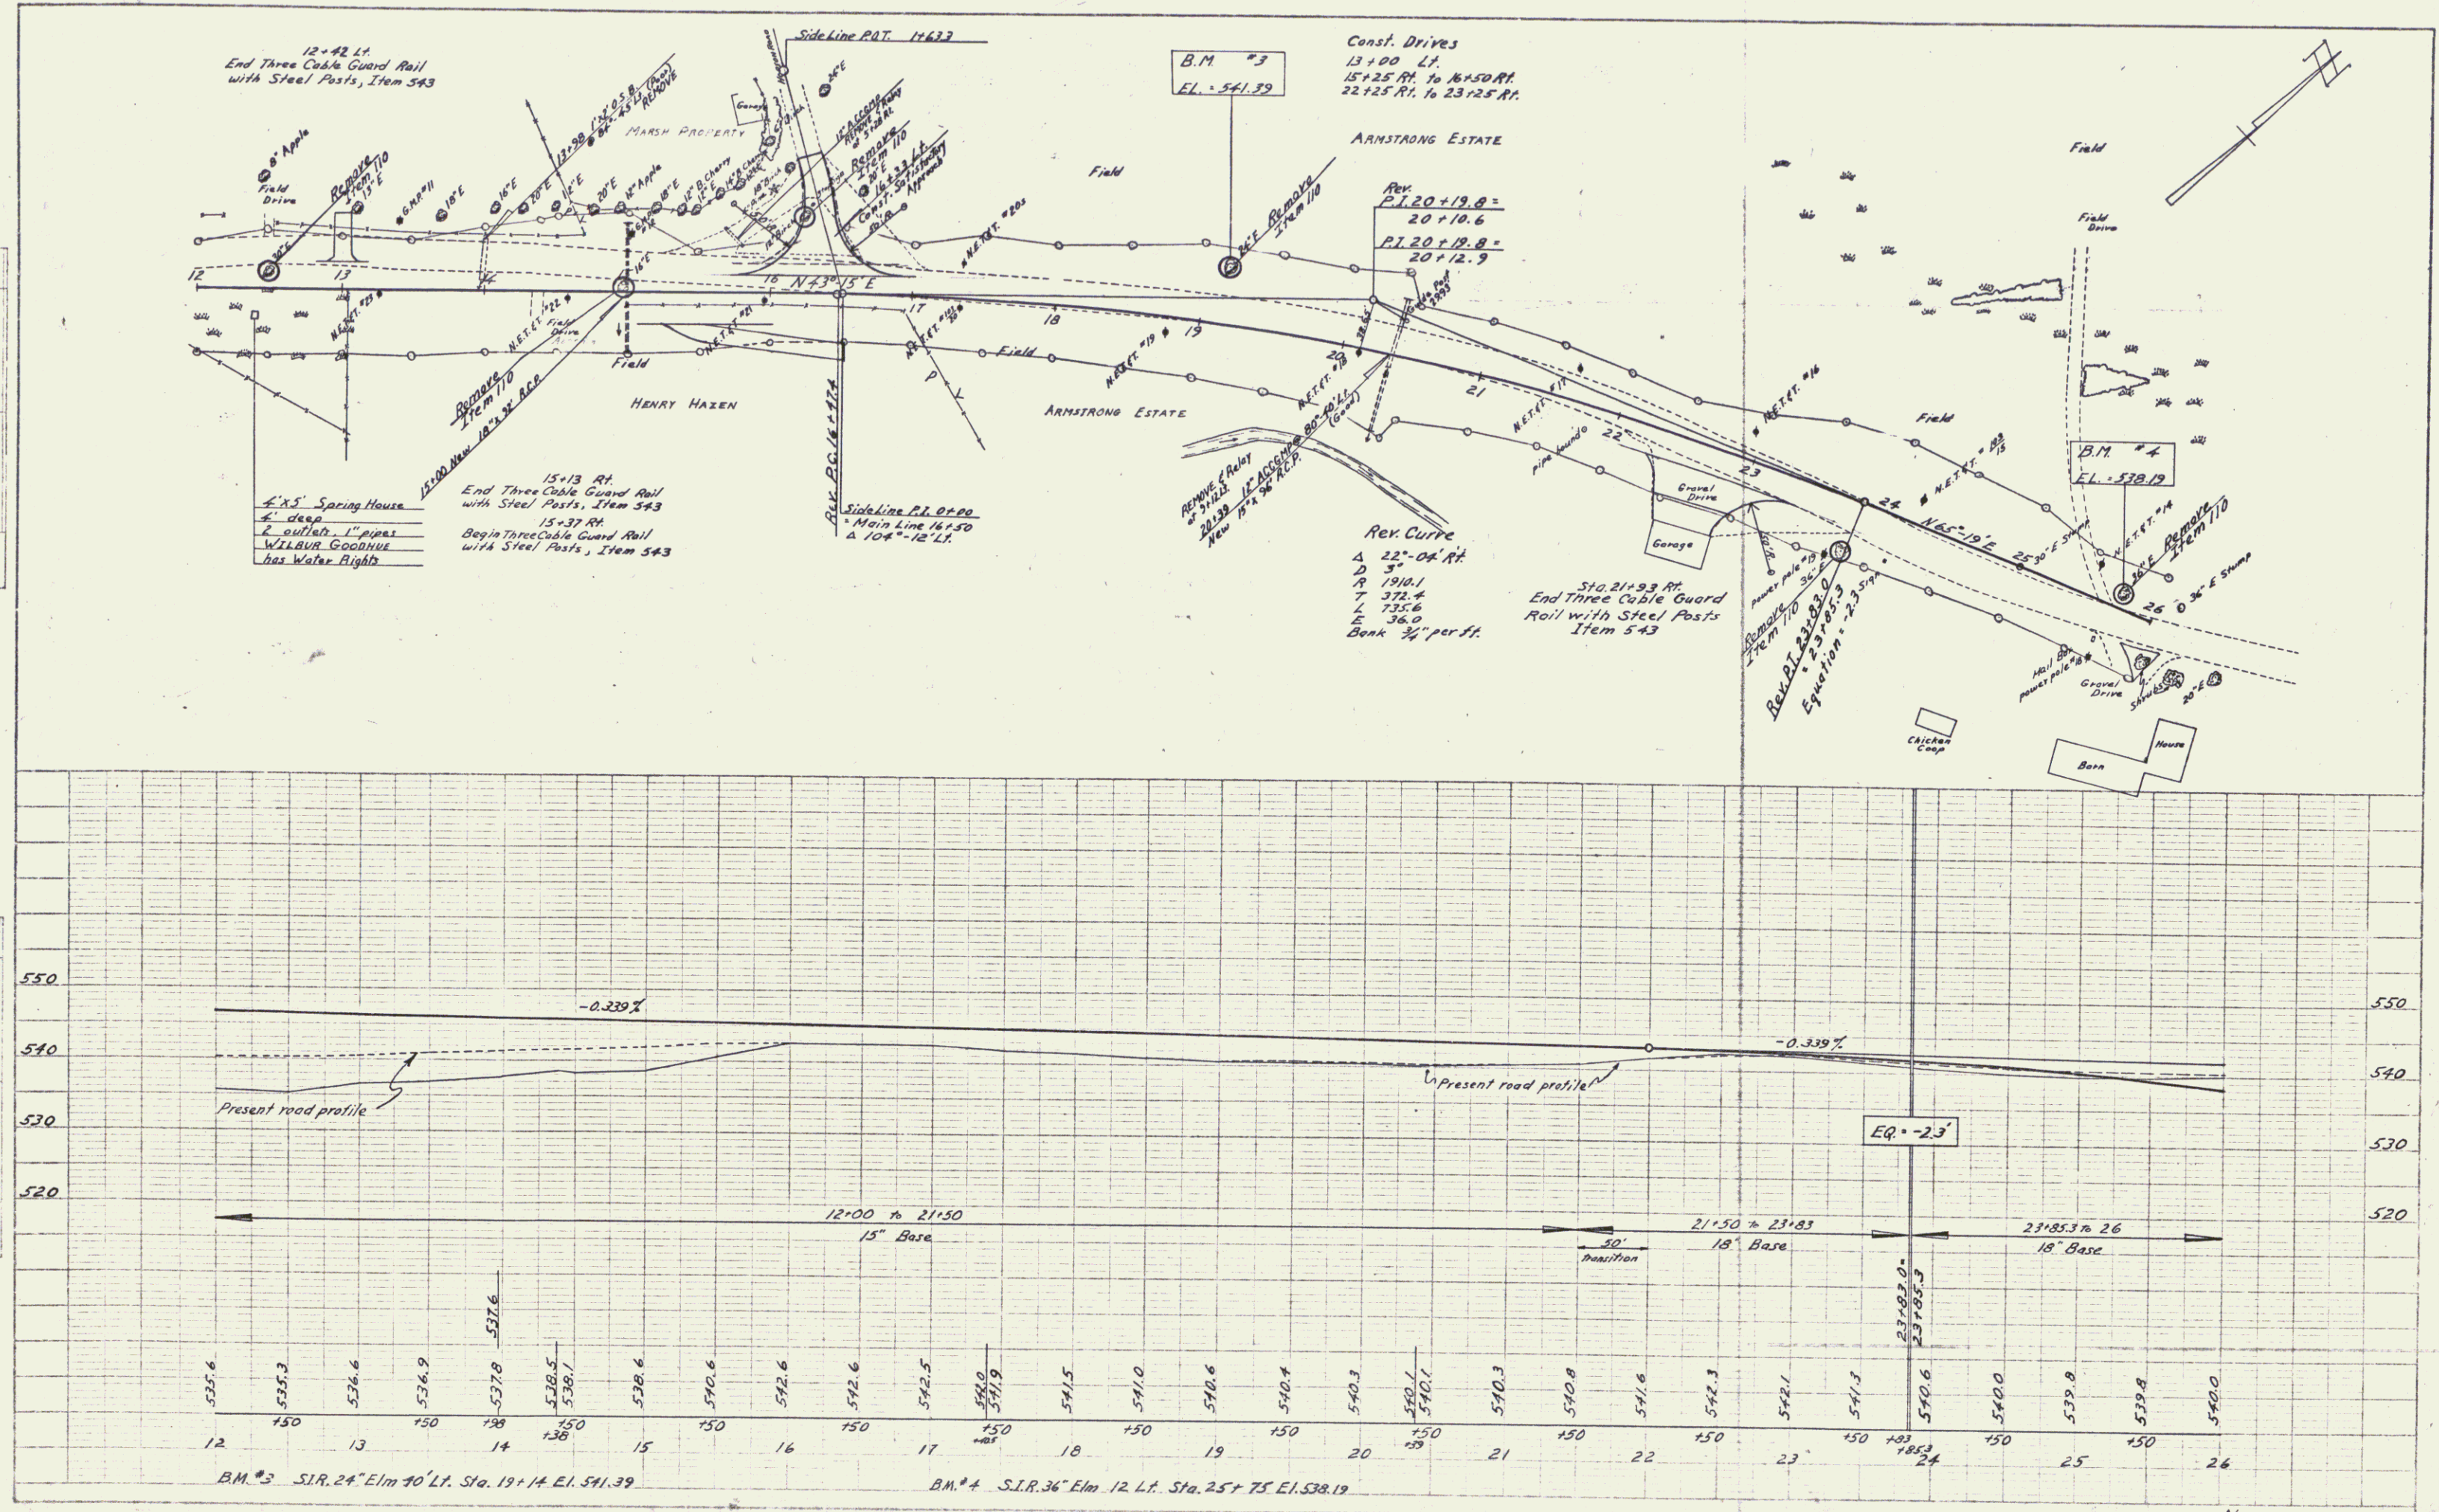



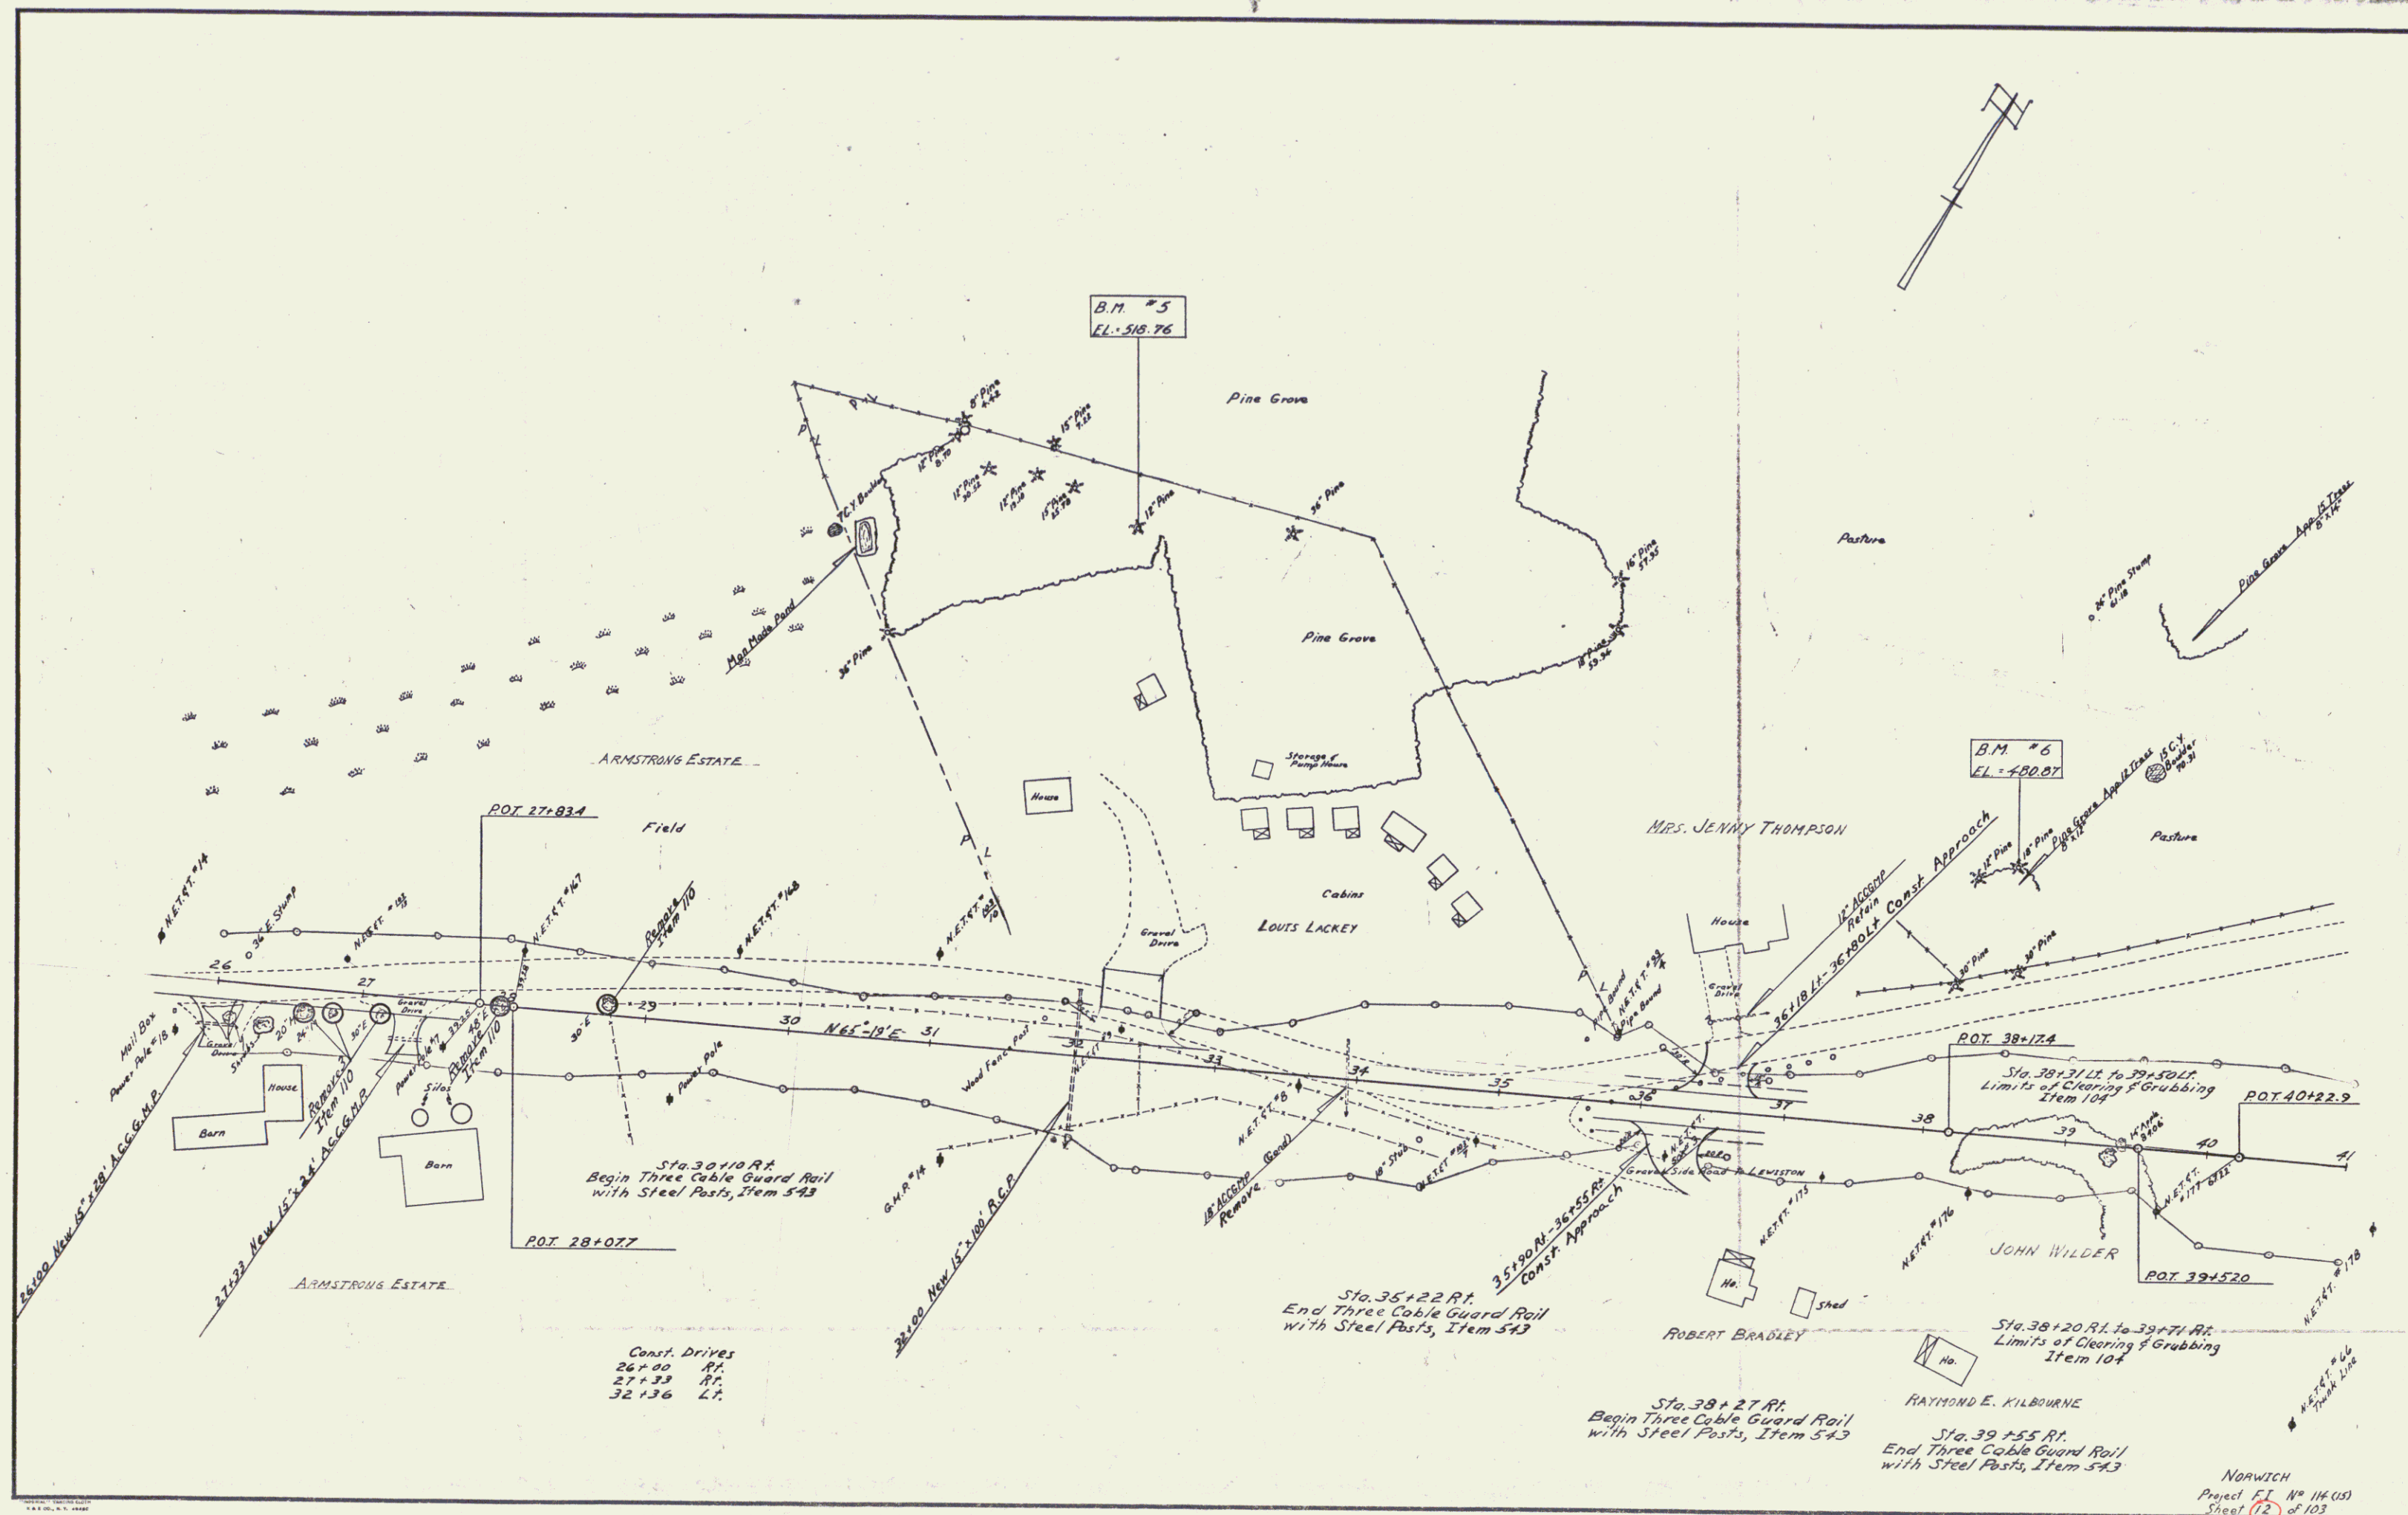



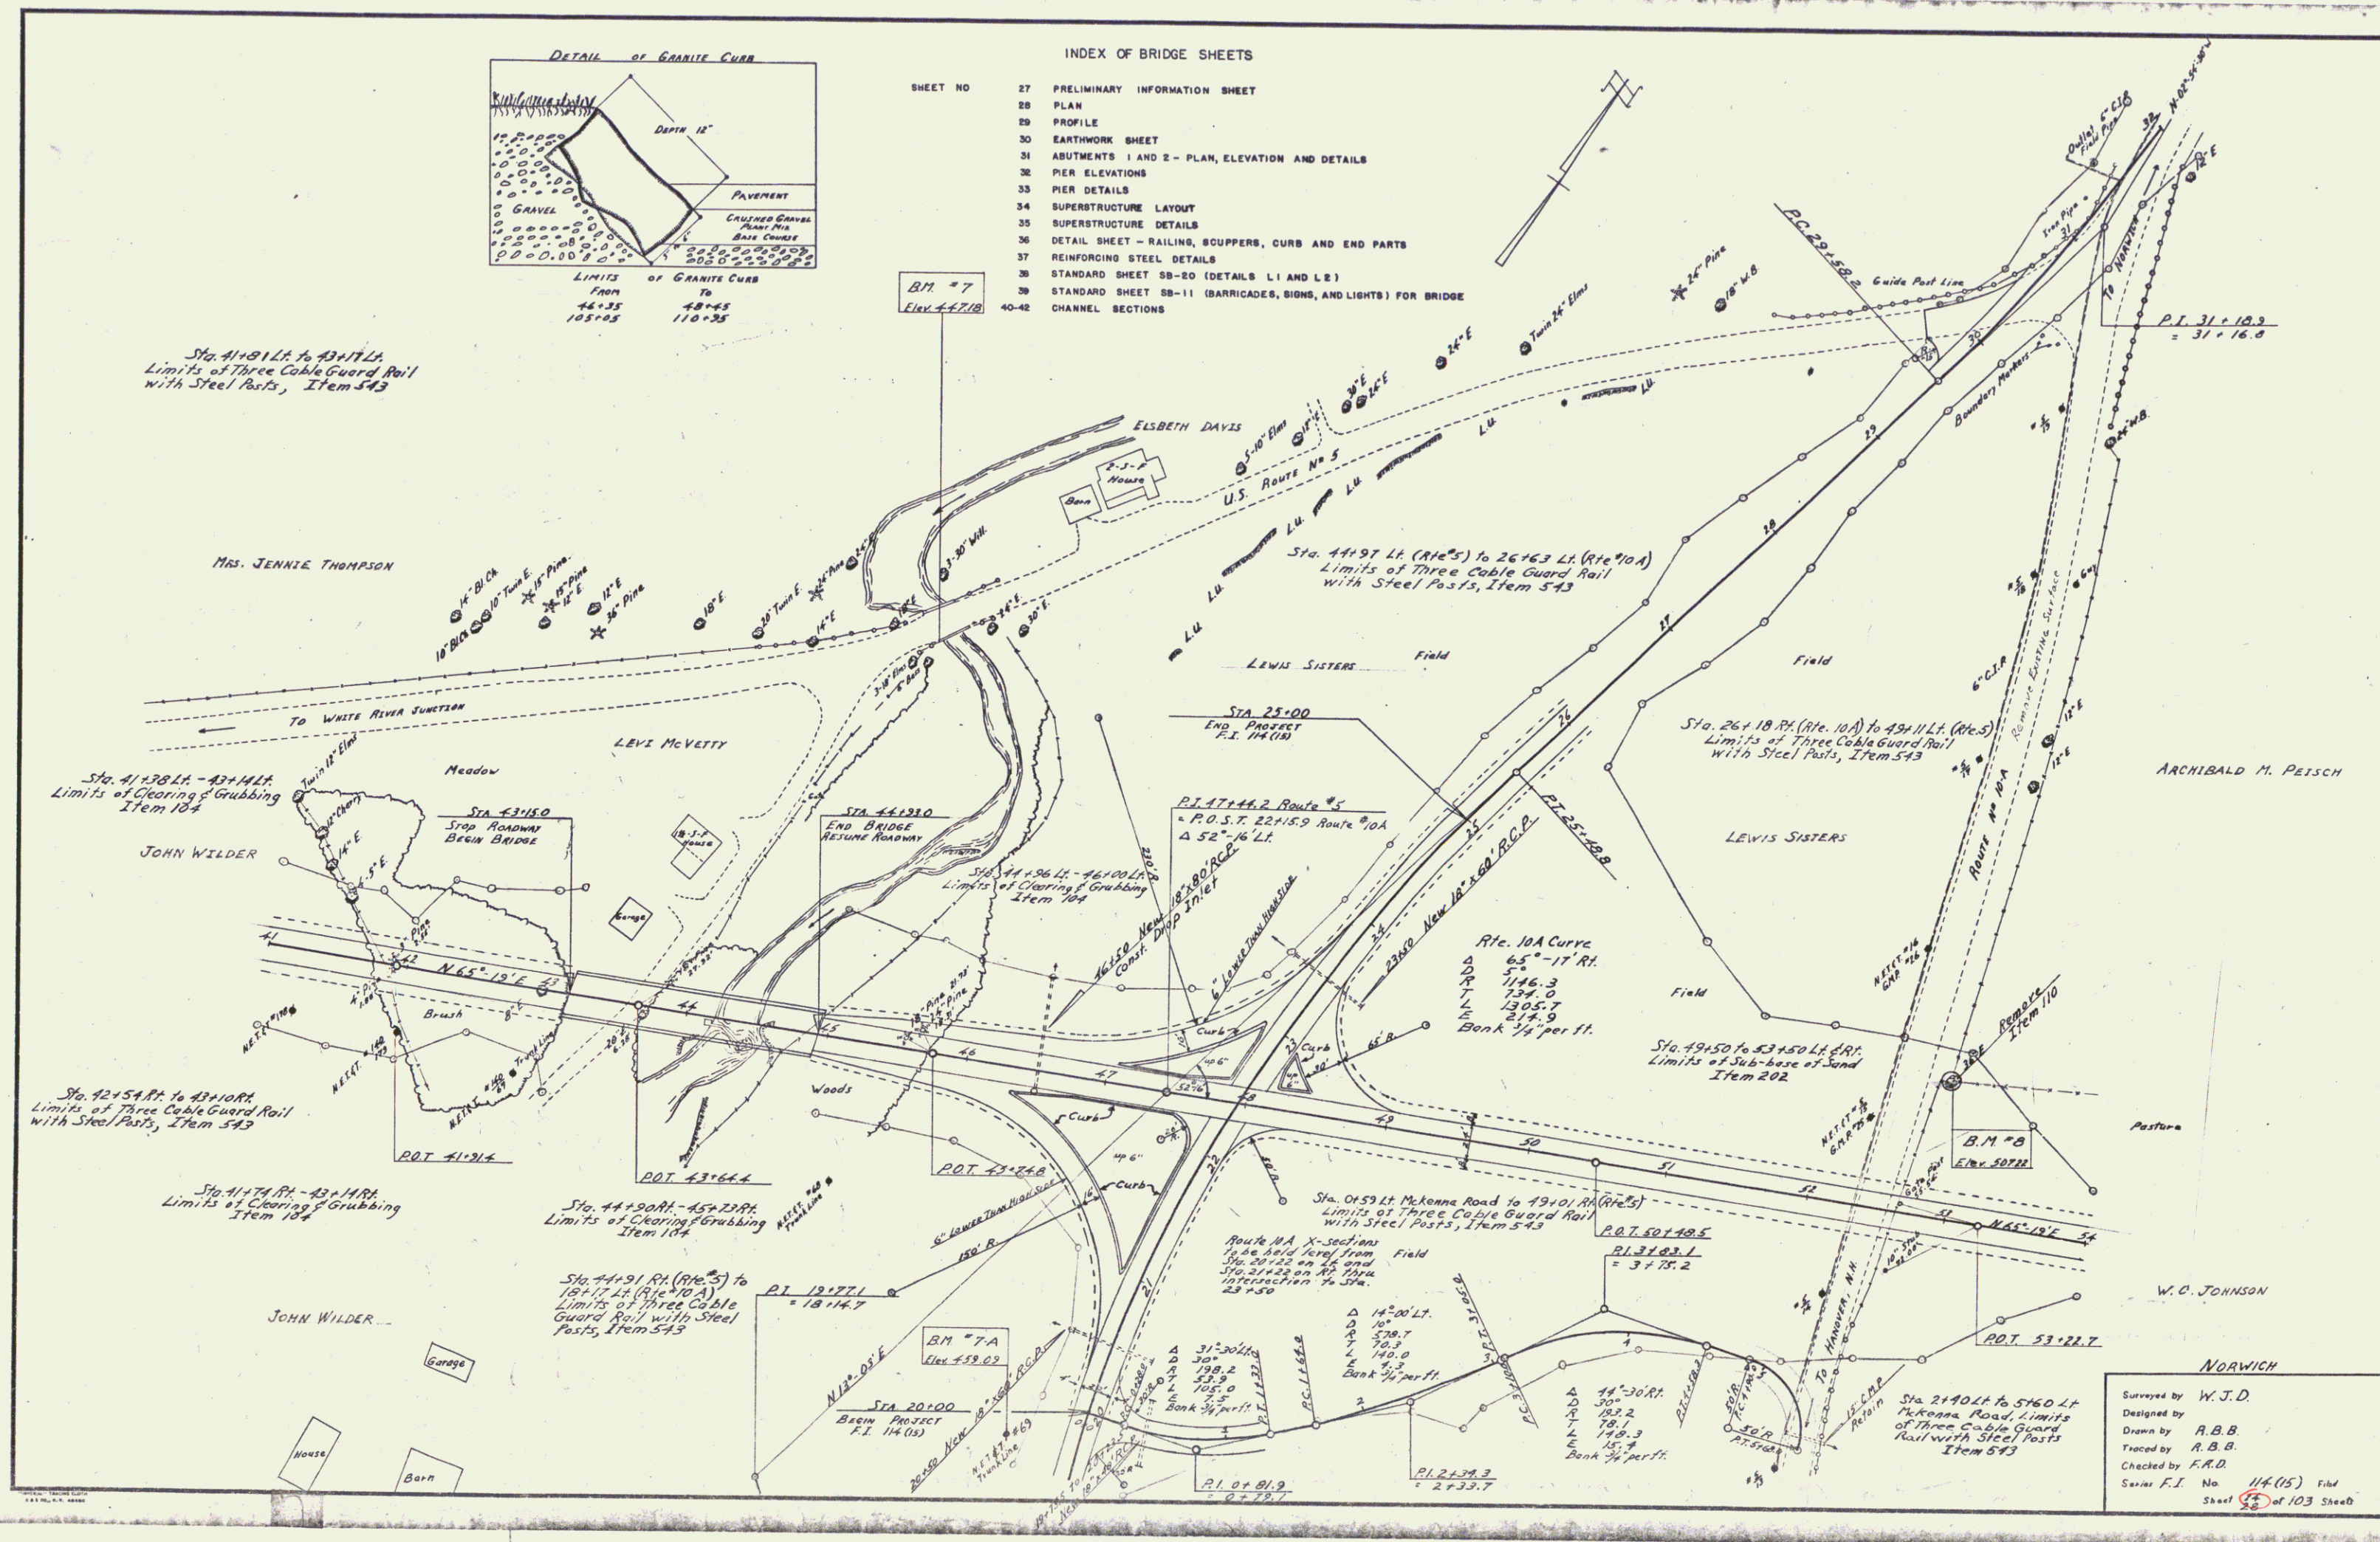


PLAN
 DATE: 11/1/54
 DRAWN BY: D. J. B. B. B.
 CHECKED BY: D. J. B. B. B.
 PROJECT: 114 (15)
 SHEET: 48 of 103

PROFILE
 DATE: 11/1/54
 DRAWN BY: D. J. B. B. B.
 CHECKED BY: D. J. B. B. B.
 PROJECT: 114 (15)
 SHEET: 48 of 103


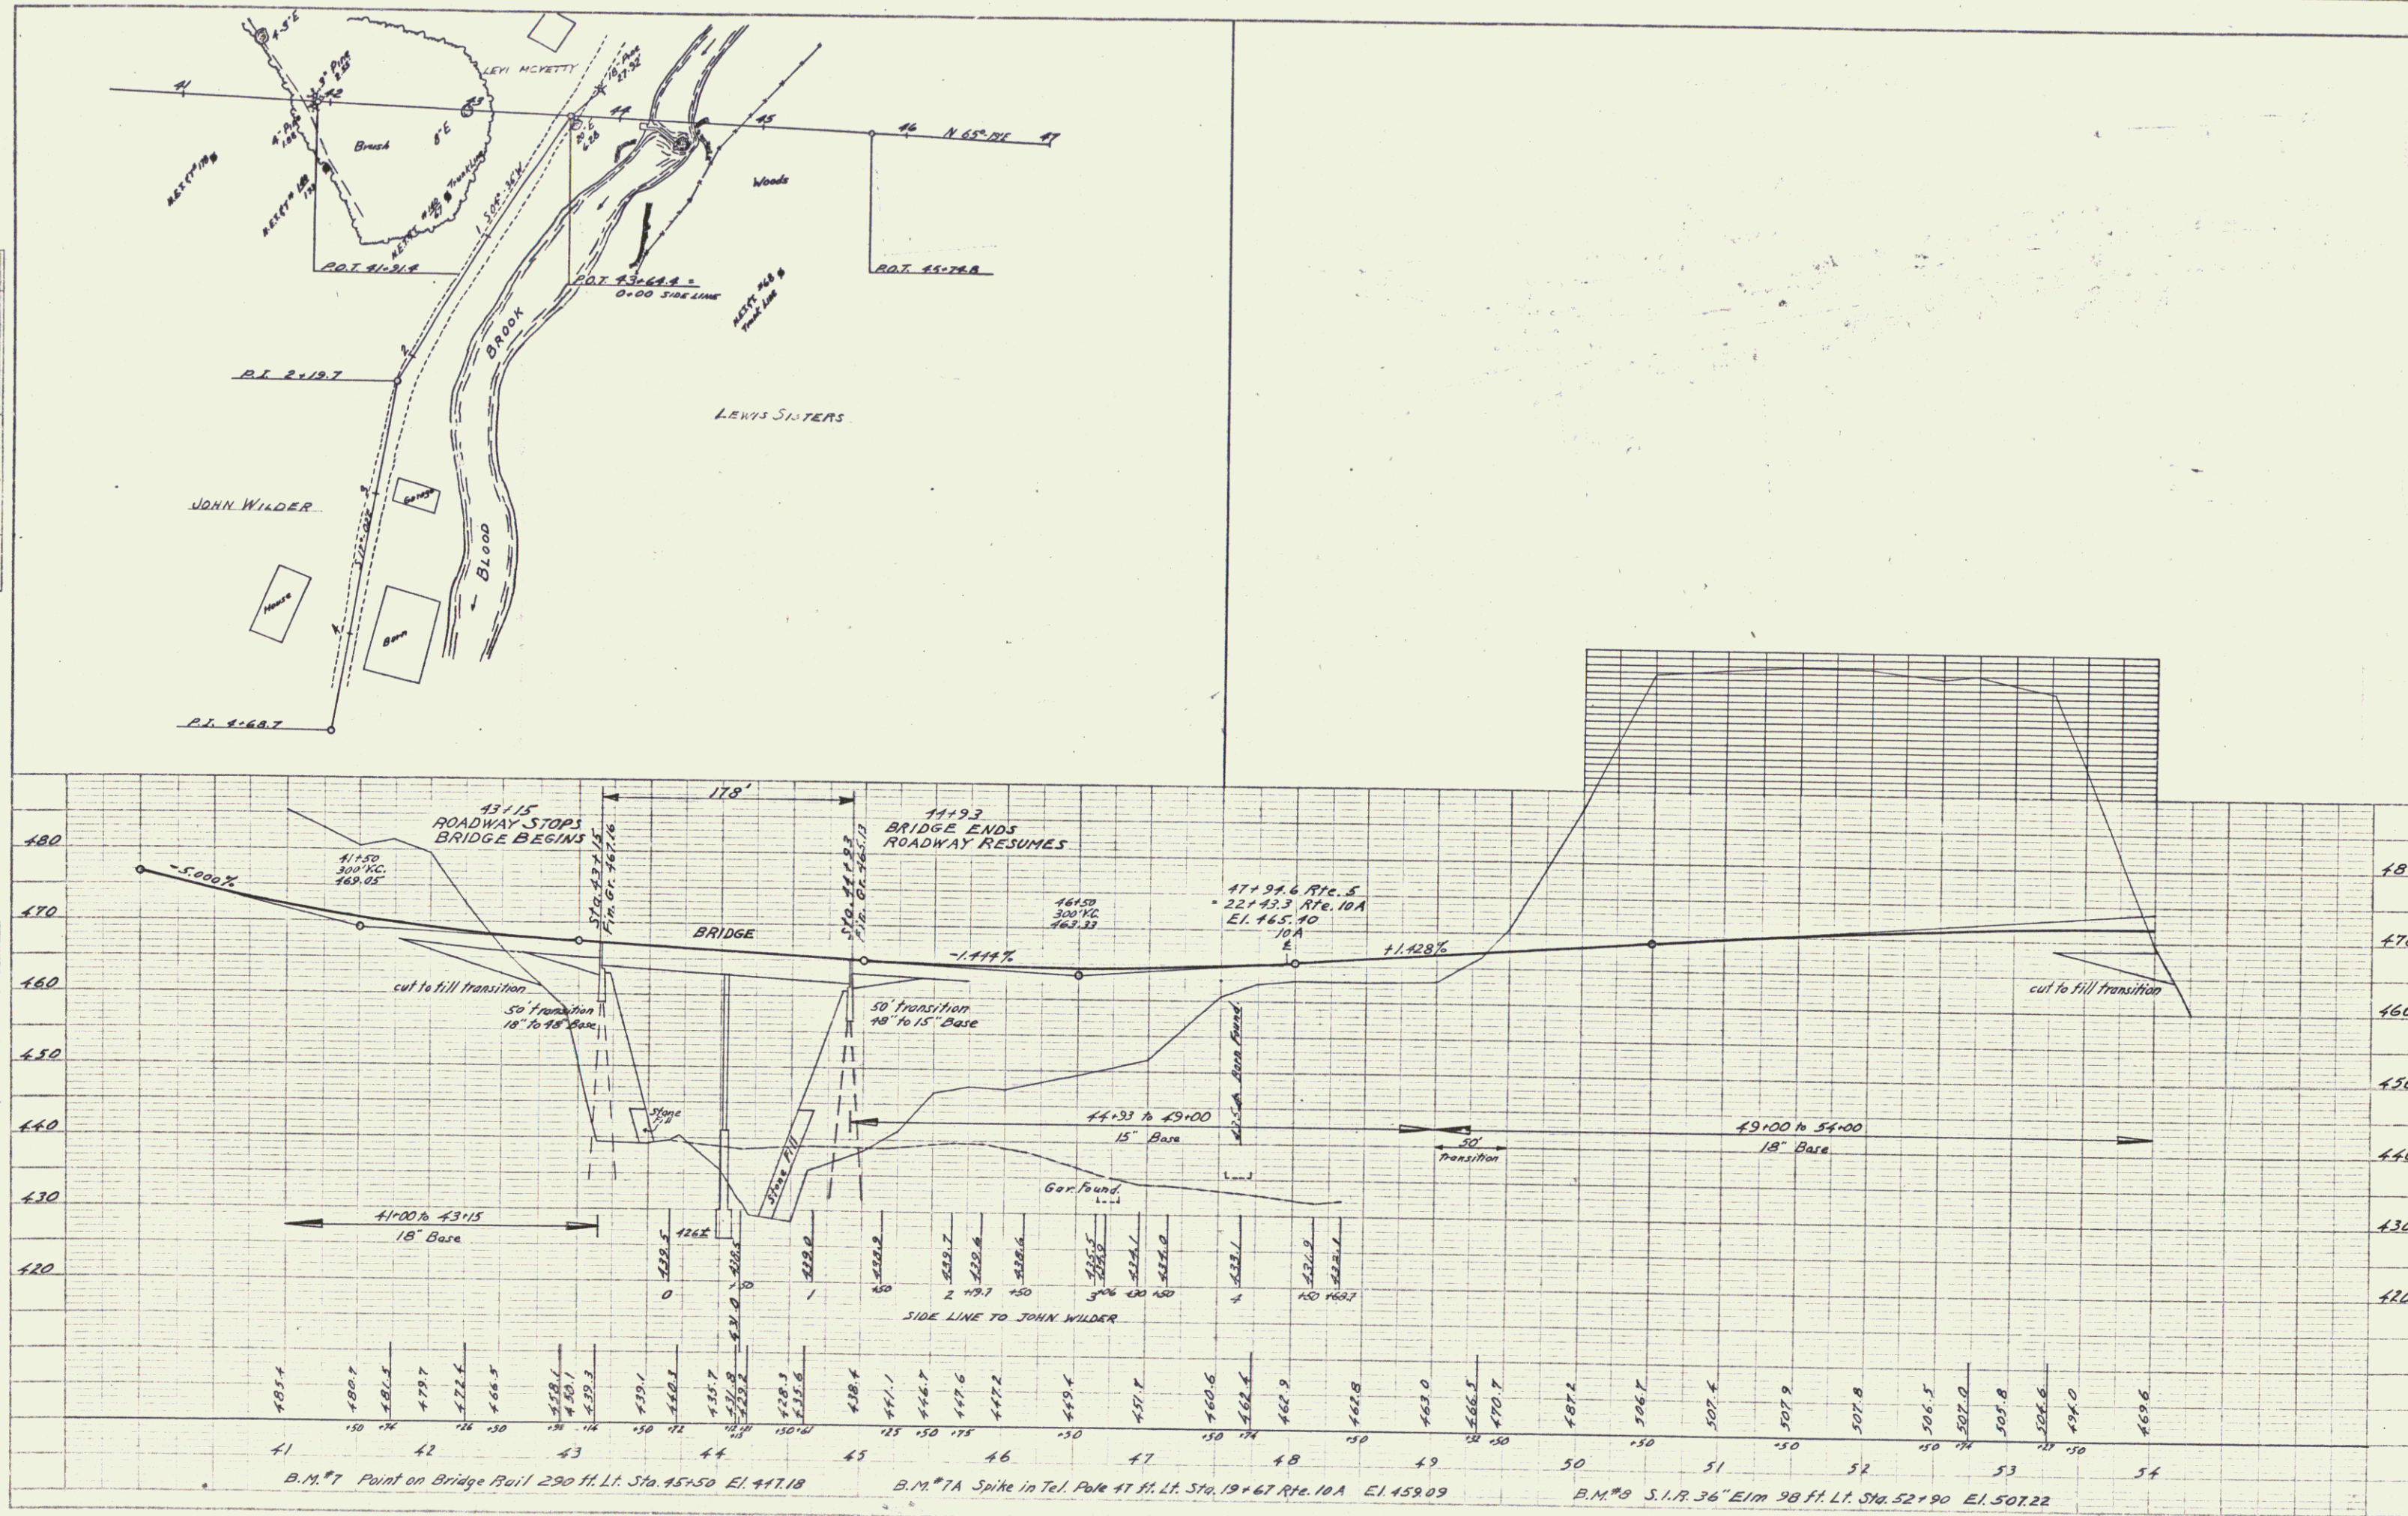


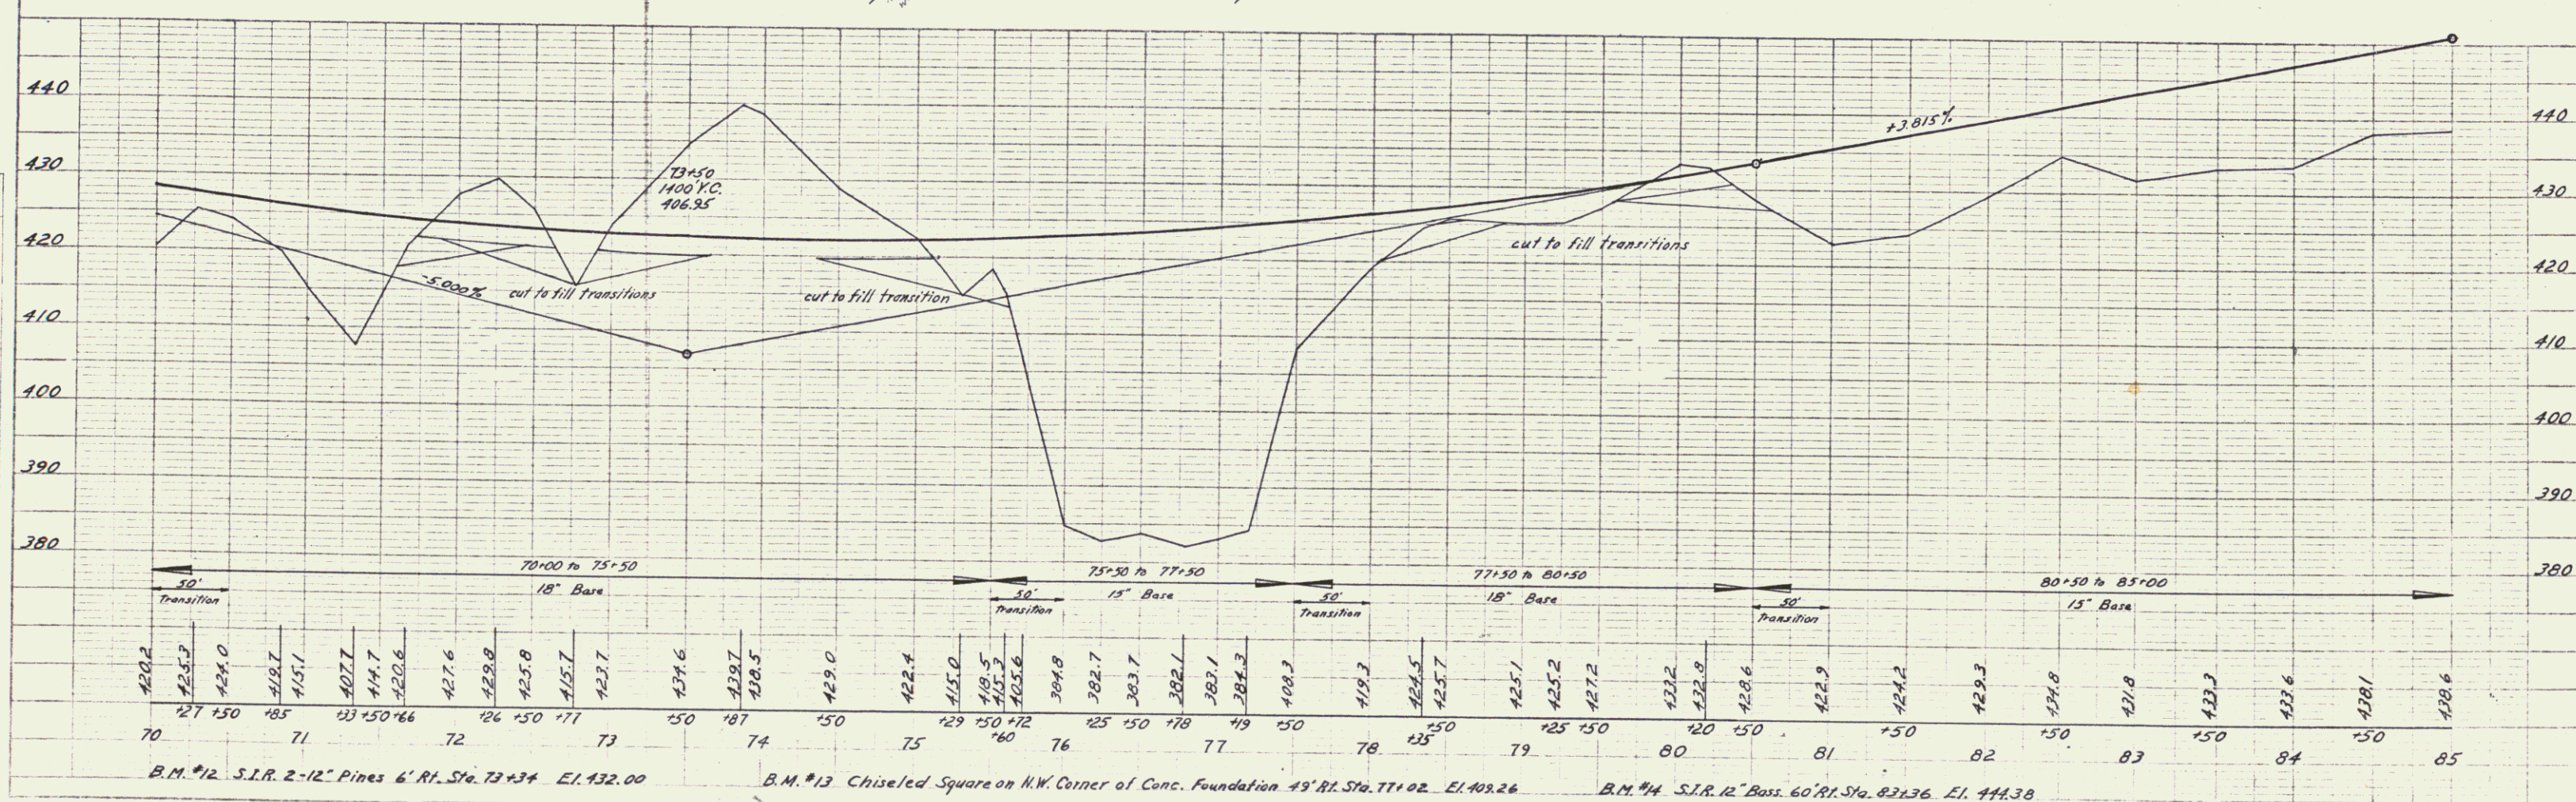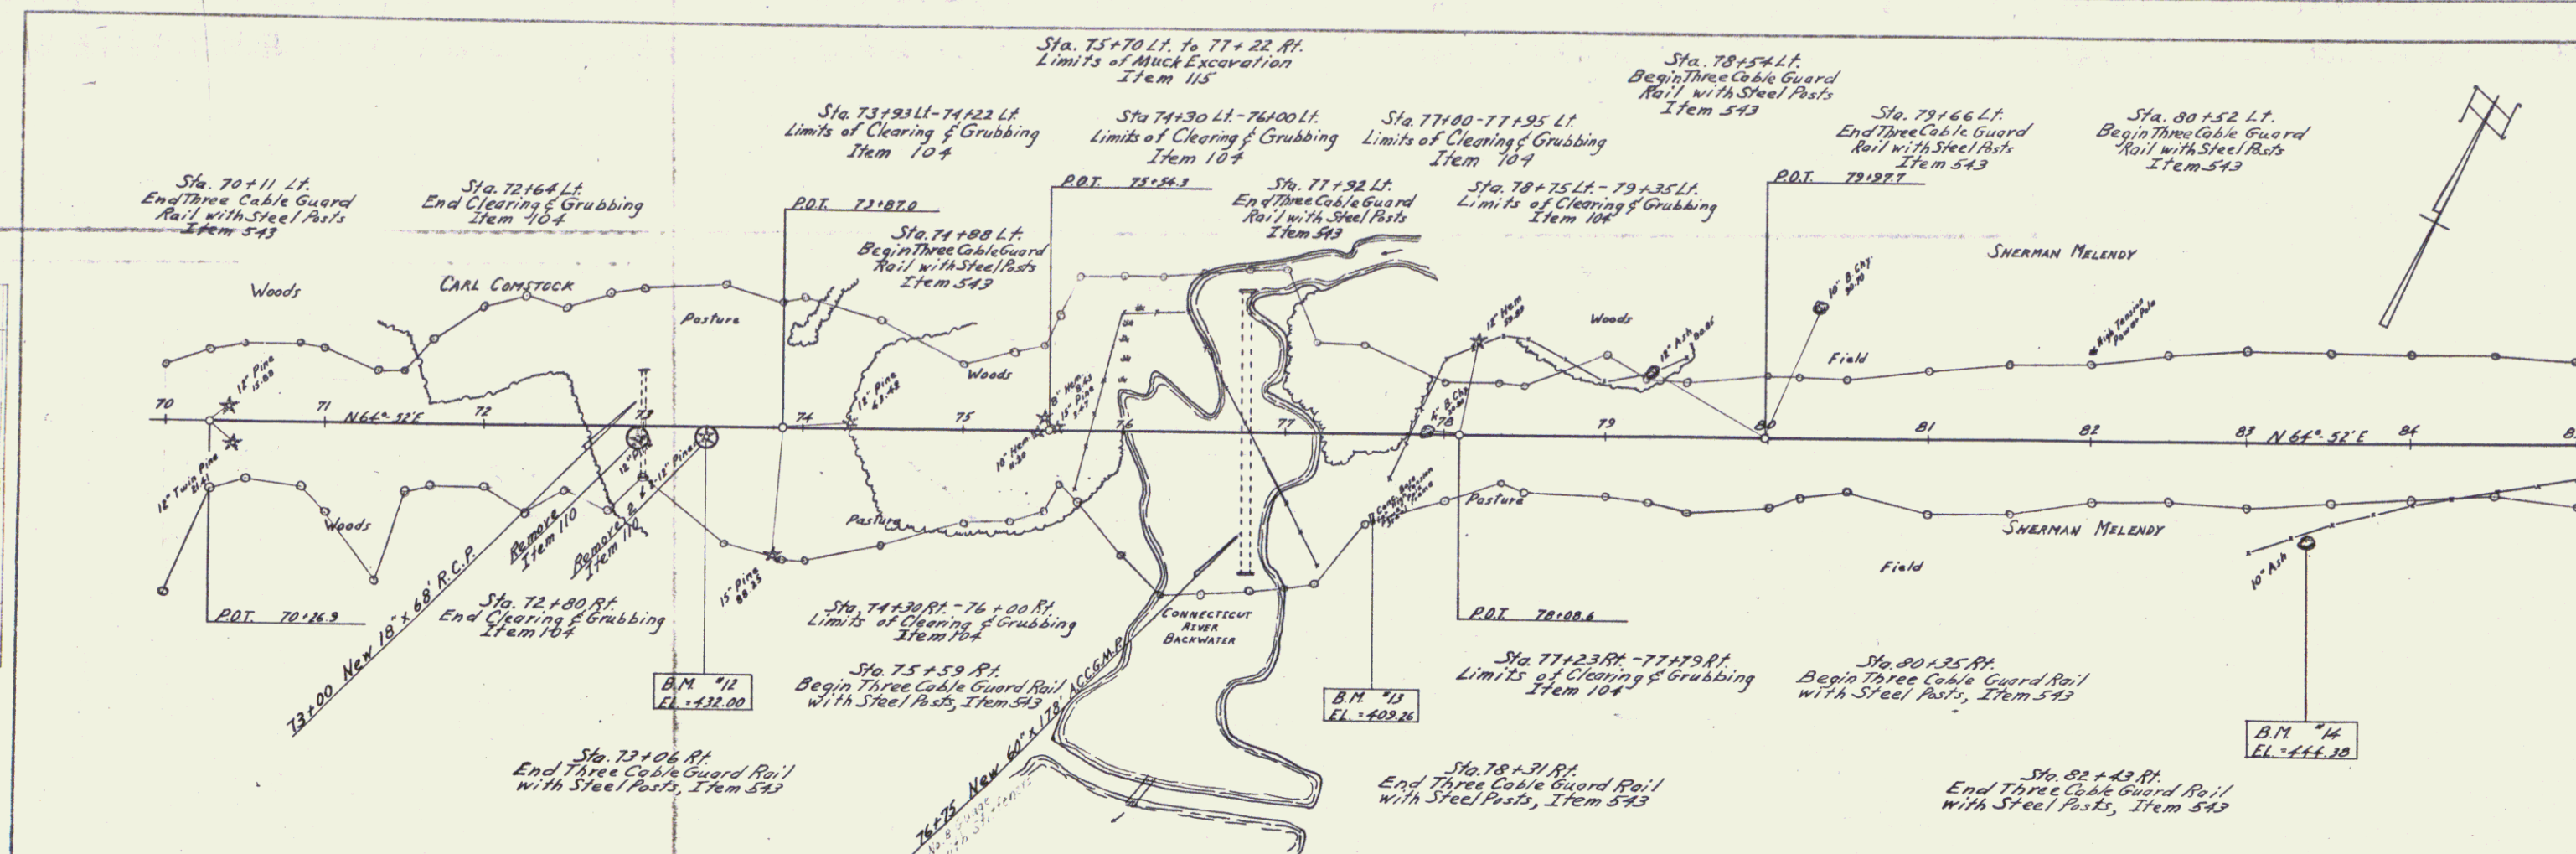

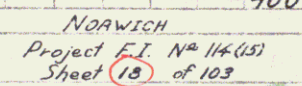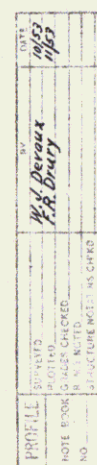


PLAN
 W. G. Deane
 11/23

PROFILE
 W. G. Deane
 11/23

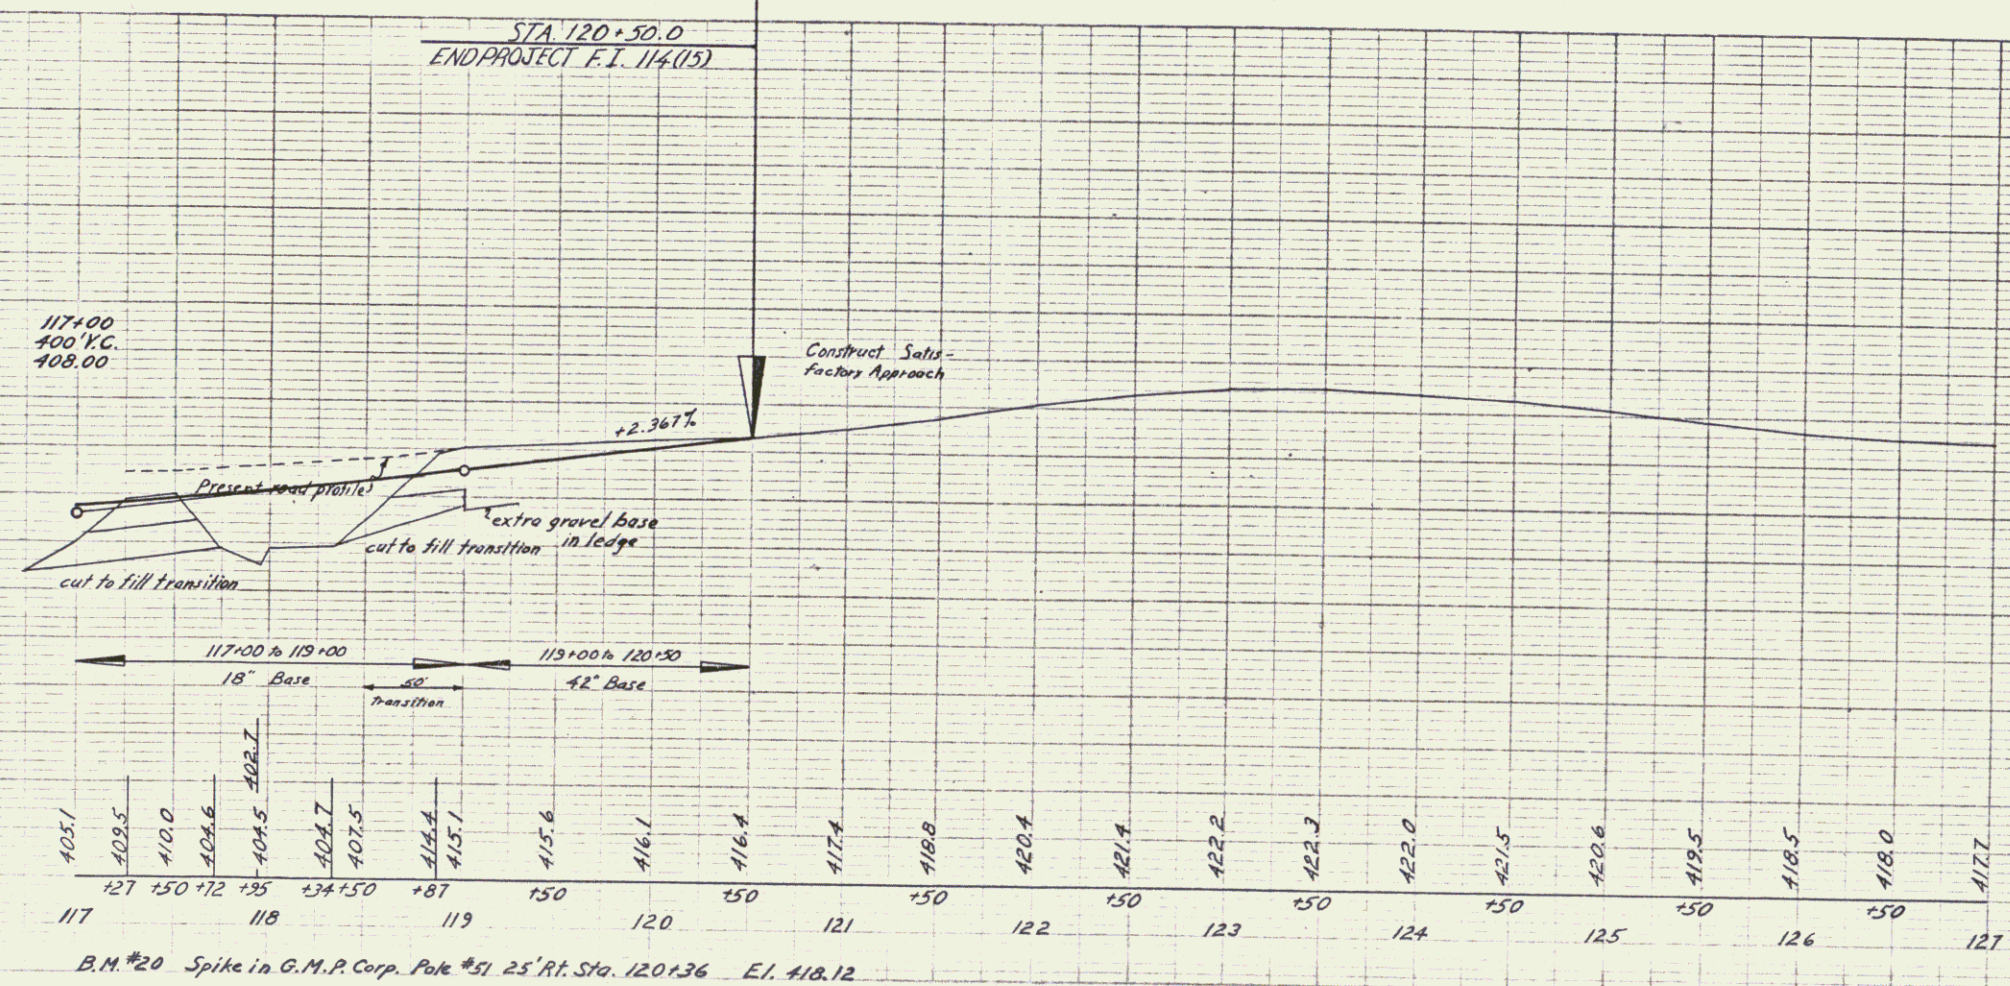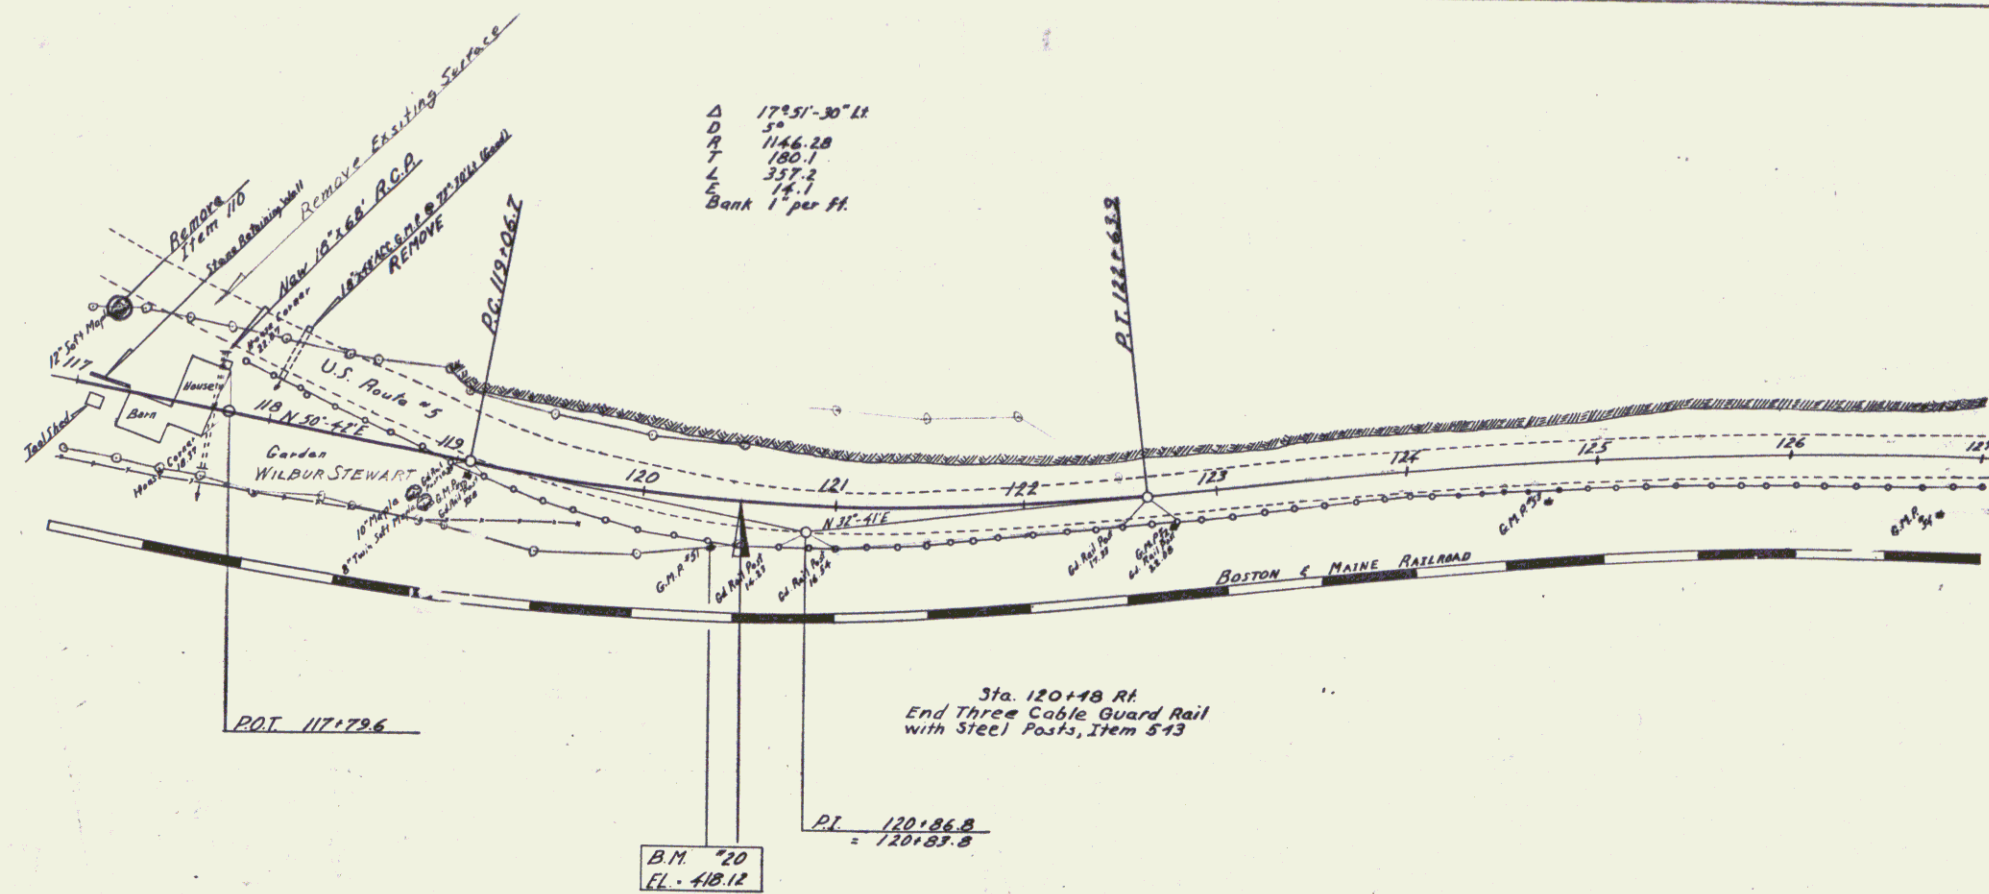

PROFILE	BY	DATE
	Spaulding	1-31
	Pomer	8-31
NOTE BOOK	CHARACTERISTICS	
NO.	8 MS NOTED	
	STRUCTURE NOTATIONS CHECKED.	

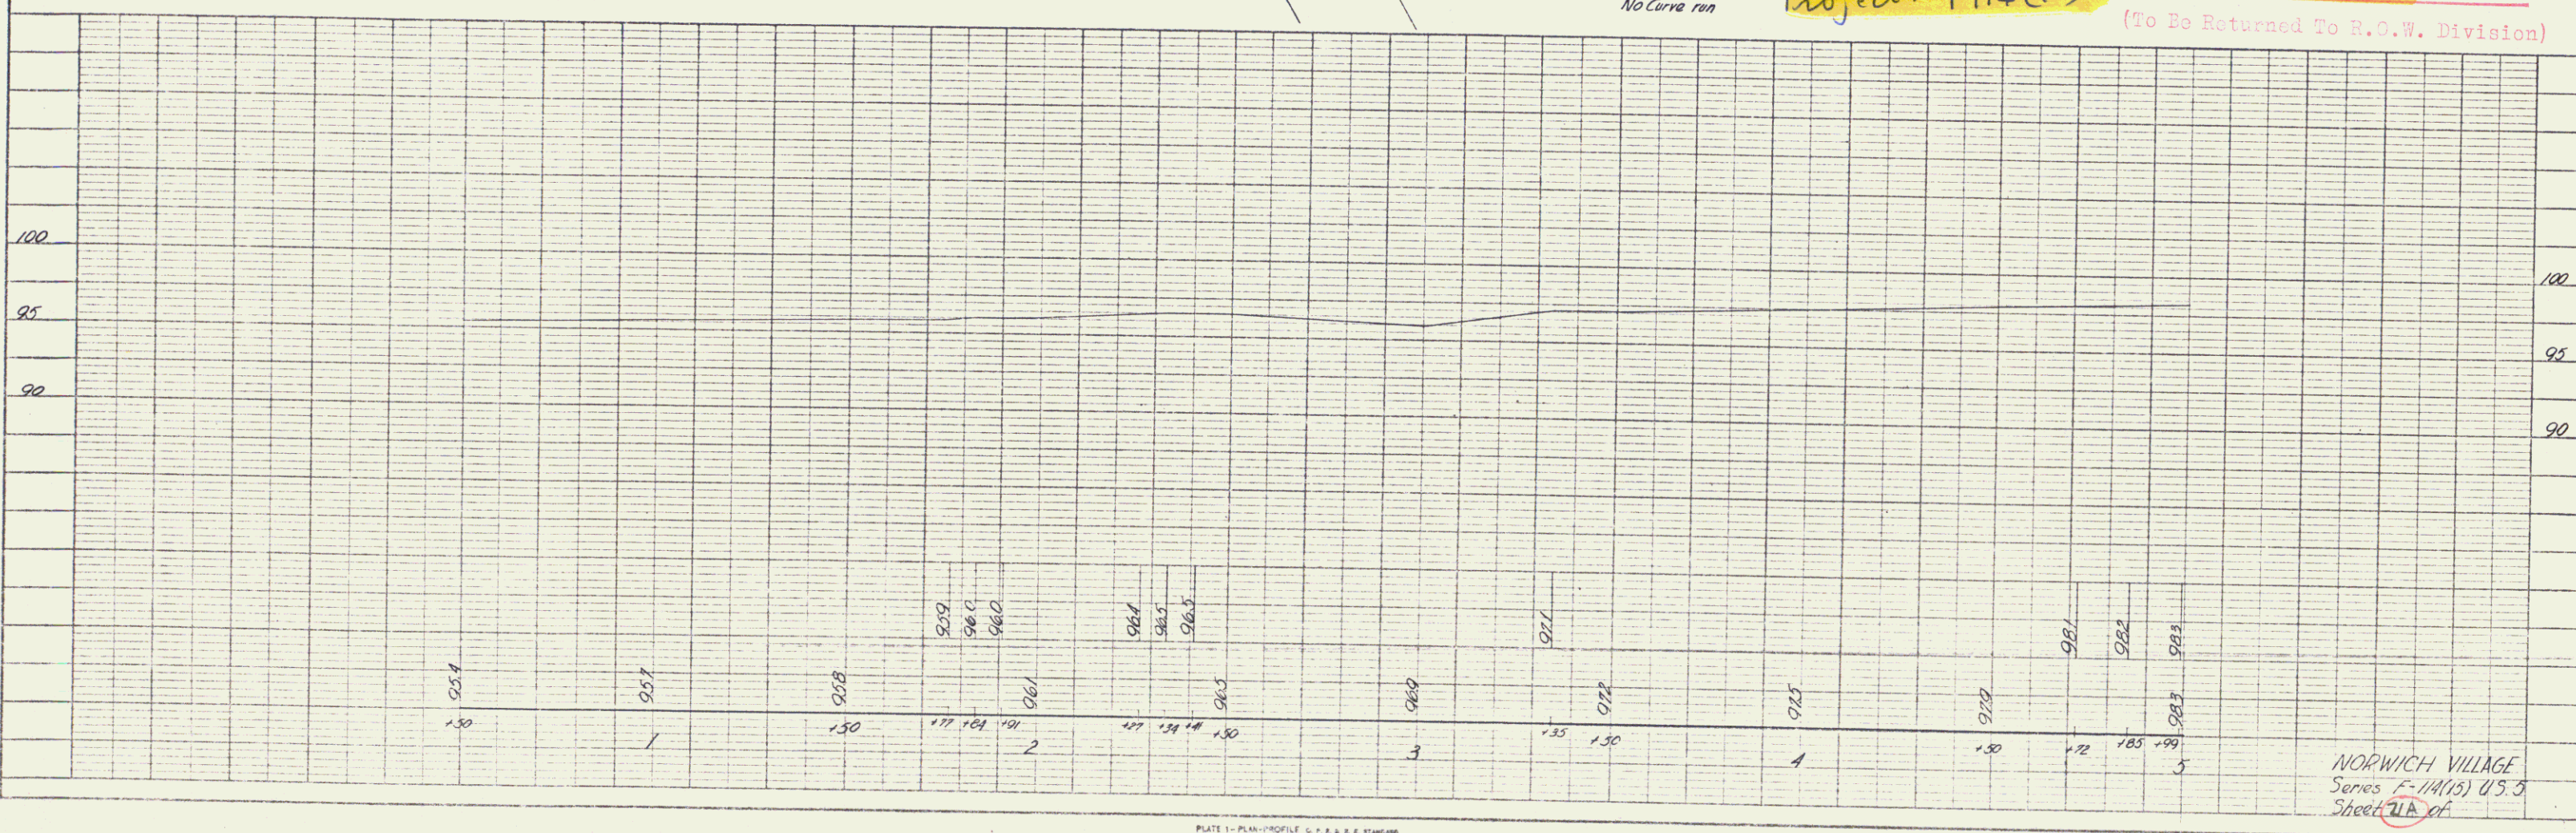

RIGHT-OF-WAY DIVISION
TOWN FILE
PERPETUAL
Date of US 5
(To Be Returned To R.O.W. Division)

NORWICH VILLAGE
Series F-114(15) U.S.S
Sheet 71A of

PLAN	SURVEYED	BY	DATE
NOTE BOOK	PLOTTED	<i>Spaulding</i>	<i>7-31</i>
NO.	ALIGNMENT CHECKED	<i>Pallmer</i>	<i>8-31</i>
	RT. OF WAY CHECKED	<i>Pallmer</i>	<i>8-31</i>
		<i>Traced</i>	

DATE	7-51
BY	Spaulding Palmer
QUANTITY	
PLOTTED	
GRADES CHECKED	
B. M. NOTED	
STRUCTURE NOTATIONS CH'NG.	

