
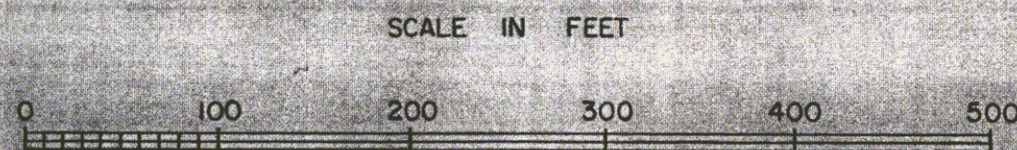
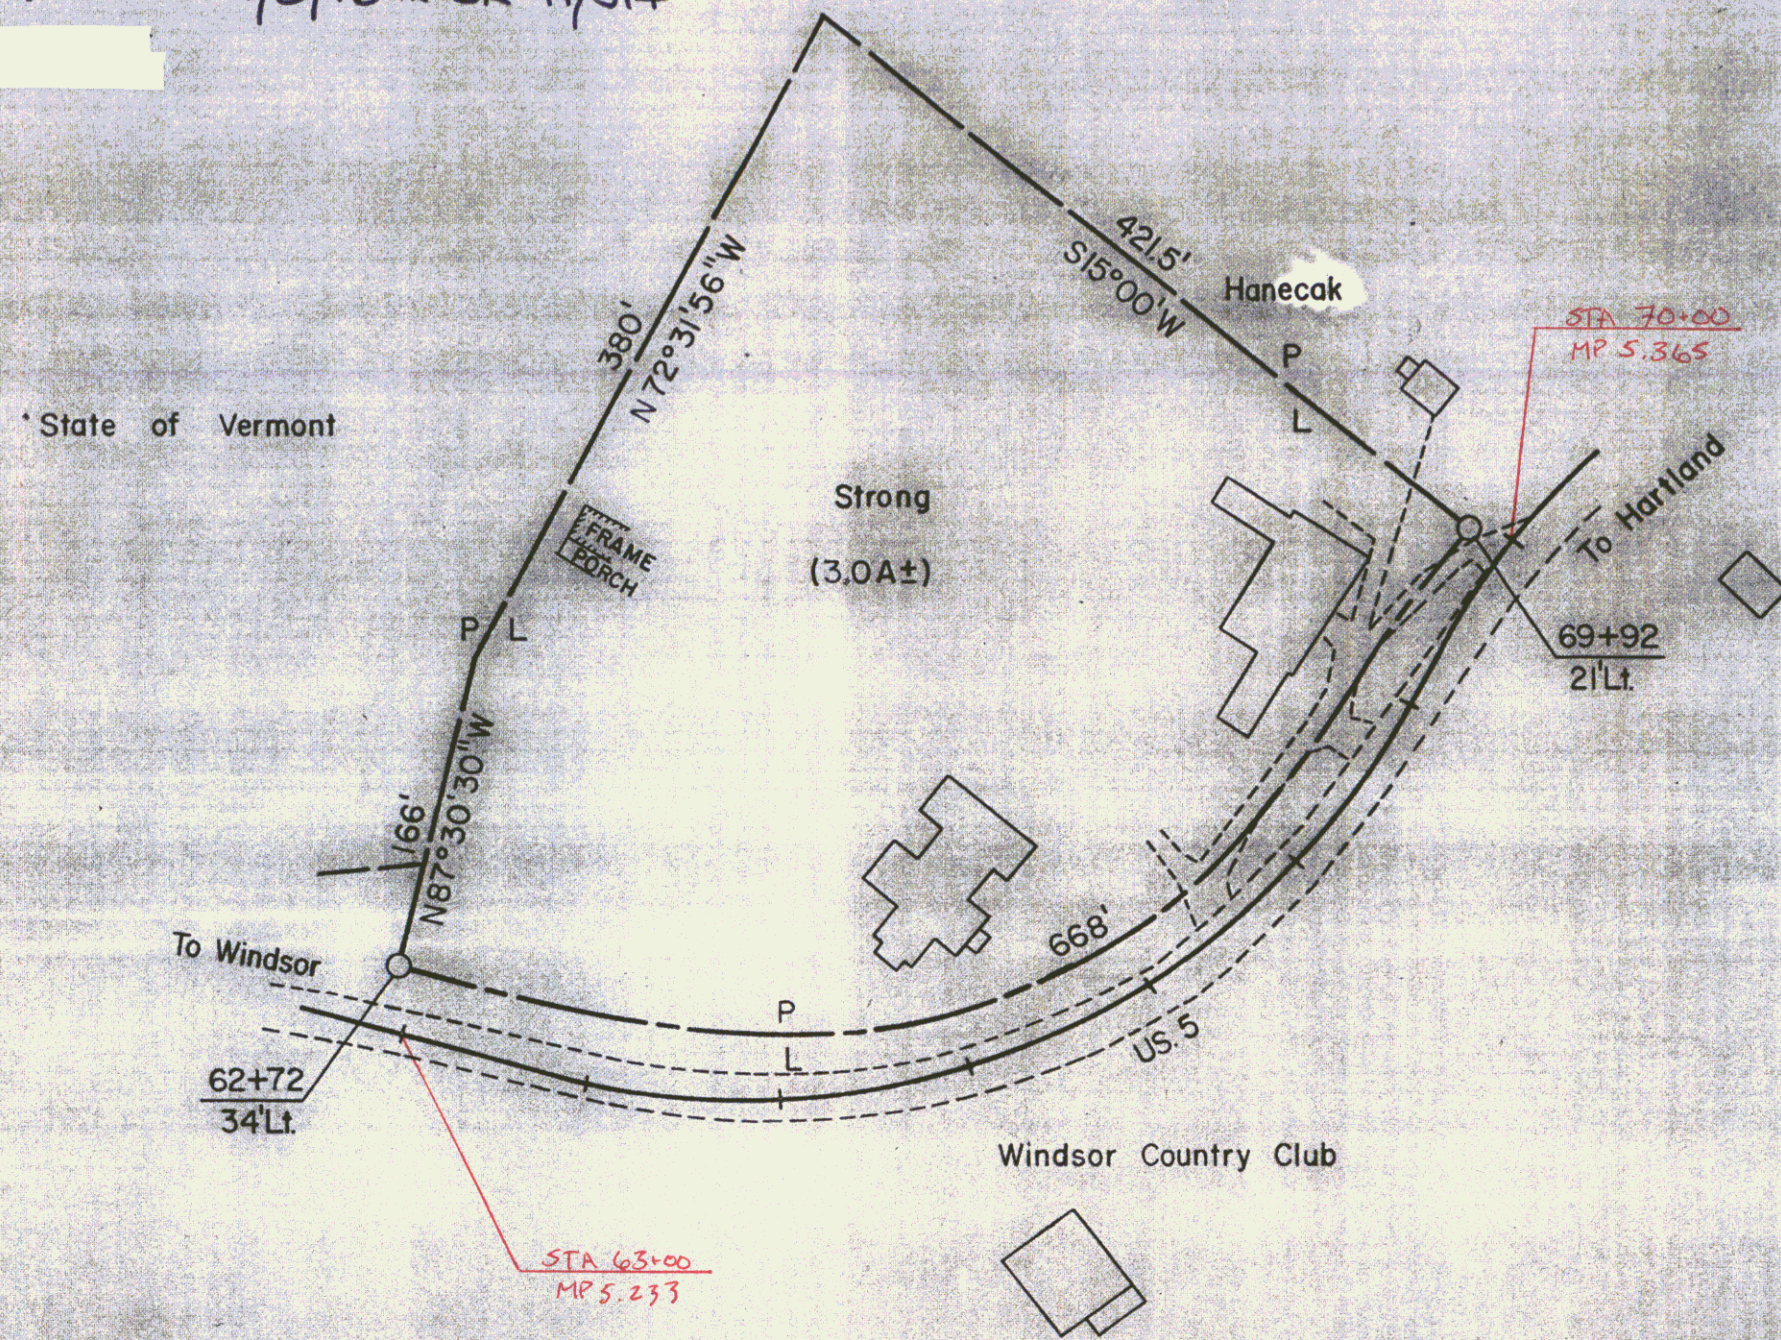


STUART STRONG TO STATE OF VERMONT
BY OPTION OF 12/5/74 IN BK 70/317-18
AND BY WAIVER OF 1/8/76 IN BK 71/314
MP = [REDACTED]

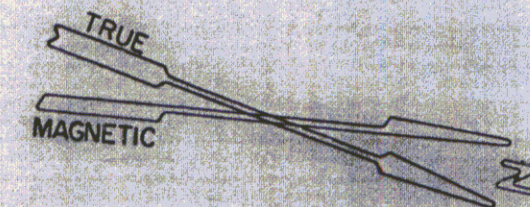

Reference: Windsor BP 041-2-7121
BP 041-2-7308

SHEET 1

STATE OF VERMONT
DEPT. OF HIGHWAYS

TOWN OF WINDSOR
Route: US 5

PROJECT WINDSOR BP 041-2-7549

APPROX. SCALE 1" = 100' DATE 12-19-75 DRAWN BY ROD S.

214