
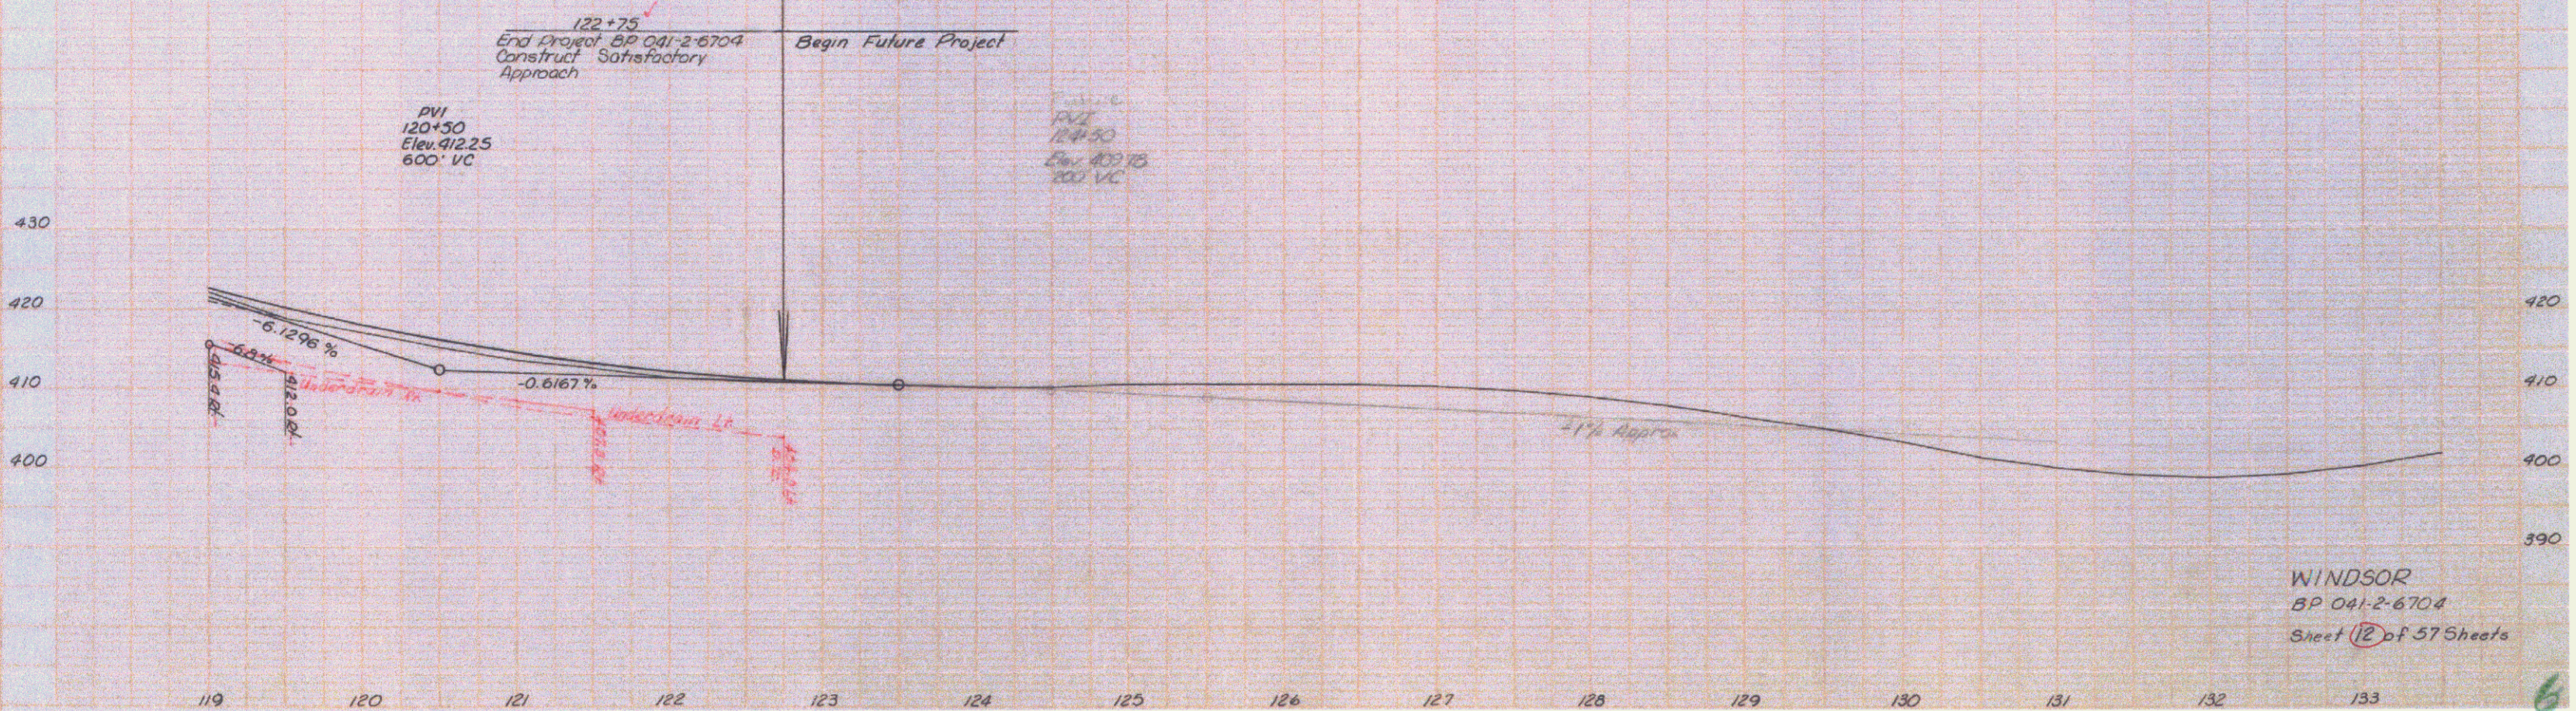


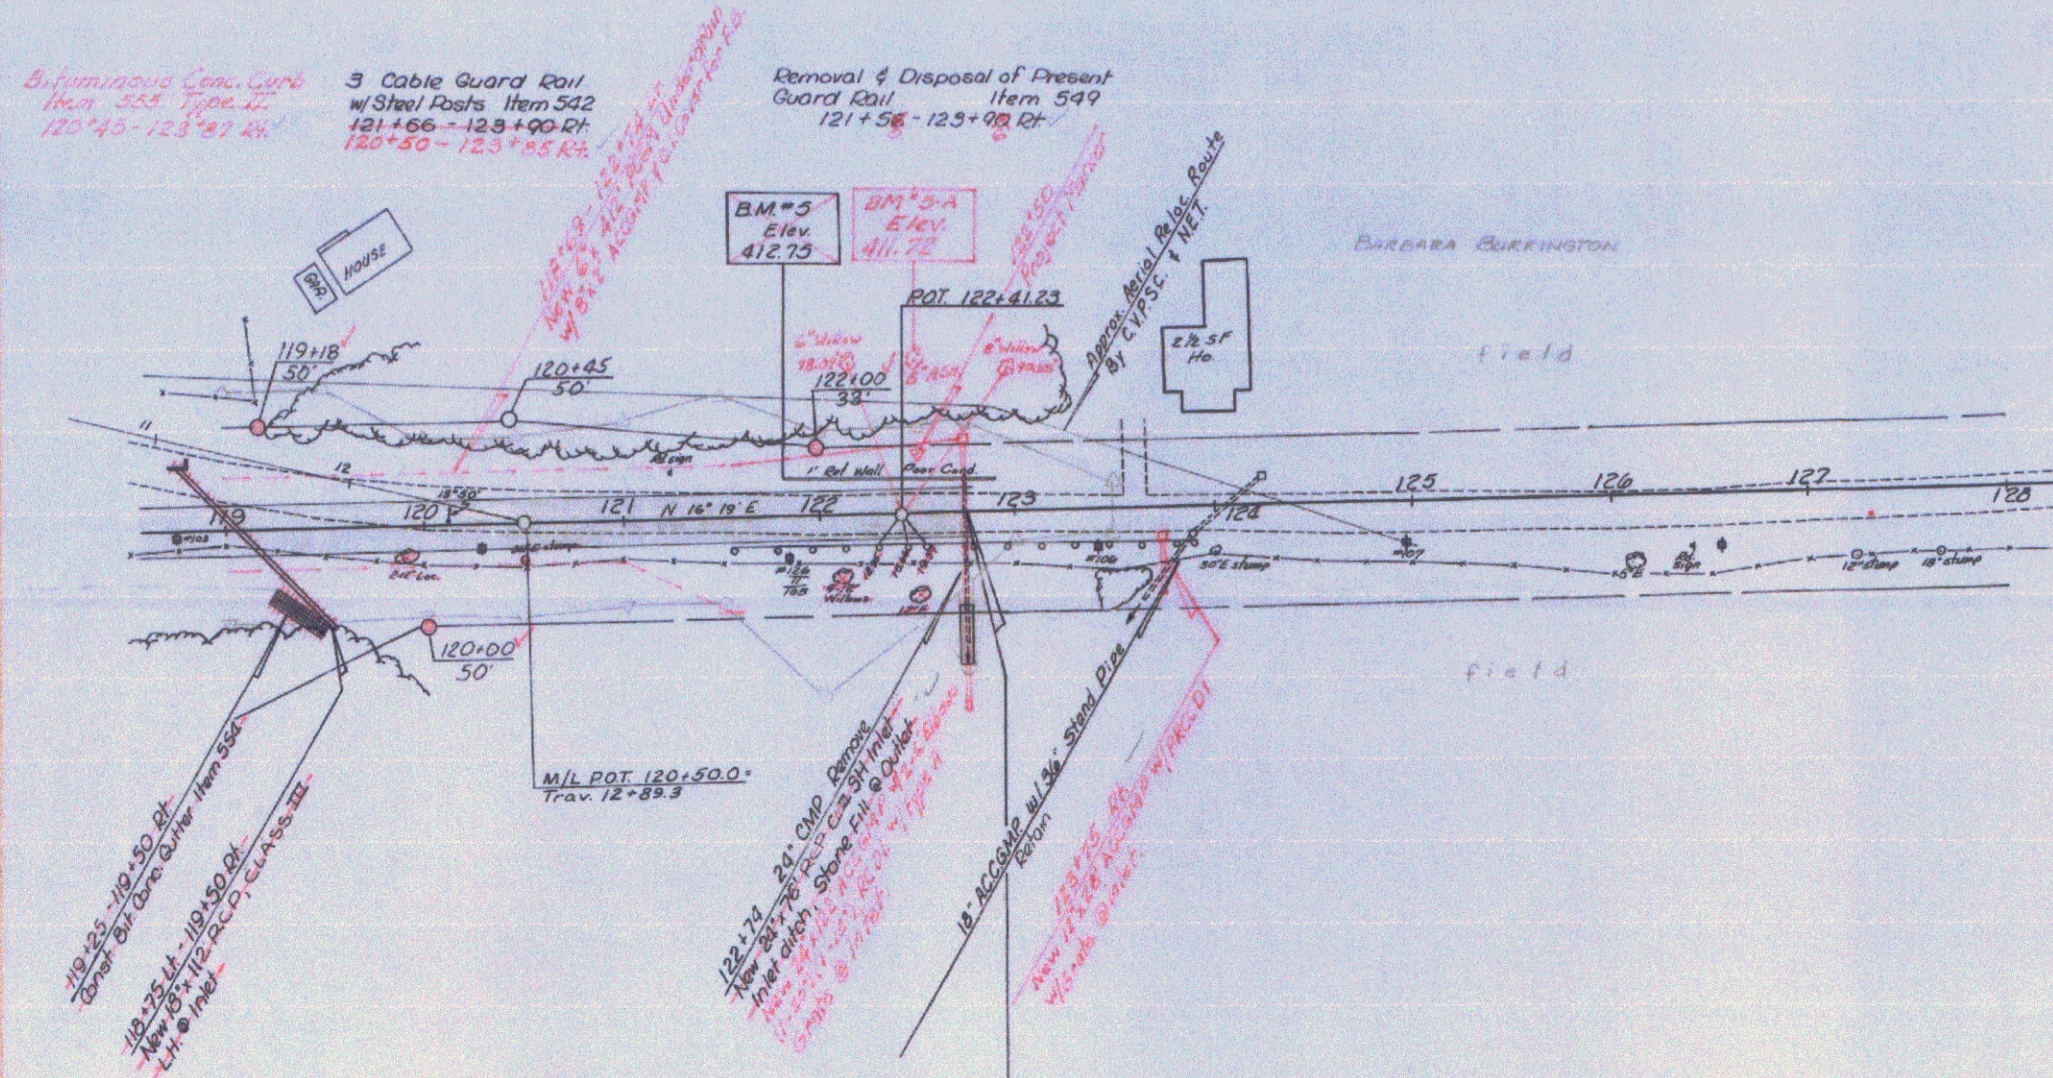

WINDSOR
BP 041-2-6704
Sheet 12 of 57 Sheets