

STATE OF VERMONT
DEPARTMENT OF HIGHWAYS

PROPOSED IMPROVEMENT

TOWN OF WATERFORD



U.S. ROUTE 5

PASSUMPSIC-ST. JOHNSBURY ROAD

BEGINNING AT A POINT 0.1537 MILE NORTHERLY OF THE BARNET-
WATERFORD TOWN LINE AND EXTENDING NORTHEASTERLY 0.2928 MILE.

LENGTH OF PROJECT 1,545.76 FEET=0.2928 MILE

ADT 1967	2700
ADT 1987	1600
DHV 1987	245
D	62
T	6.1%
V	50 MPH

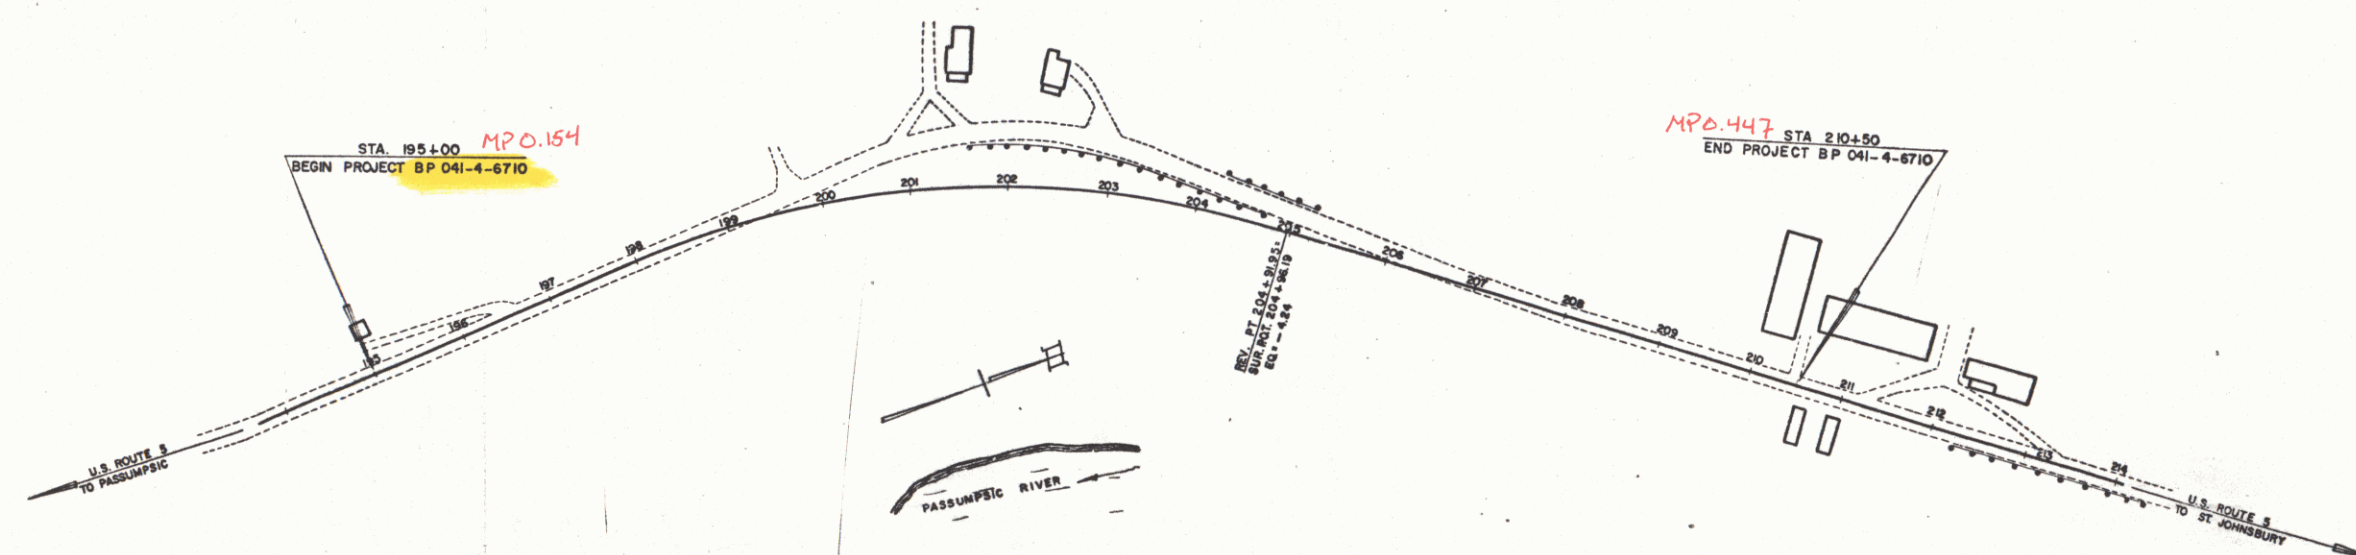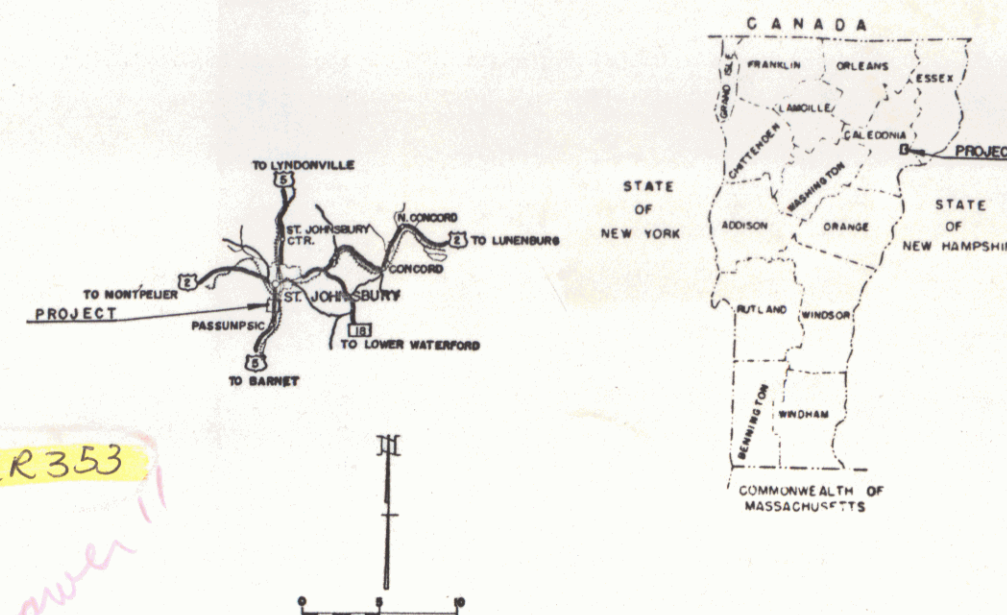

Not Constructed

RIGHT-OF-WAY DIVISION
TOWN FILE

PERPETUAL


Pla
Town of U.S.

[To Be Returned To R.O.W. Division]


CONVENTIONAL SIGNS

- POINT OF ACCESS _____ X
LIMITS OF ACCESS _____
COUNTY LINE _____
TOWN LINE _____
FENCE LINE _____
STONE WALL _____
UNFENCED PROPERTY _____
GUARD RAIL _____
TRAVELED WAY _____
RAILROAD _____
RETAINING WALL _____
CENTER LINE _____
SURVEY LINE _____
CULVERT _____
DROP INLET _____
TRUCK POLE _____
POWER POLE _____
TELEPHONE POLE _____
TREES _____
HEDGE _____
F.A. CONSTRUCTION IDENTIFICATION SIGNS _____ A

SLOPE RIGHTS

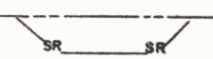

GROUND ELEVATION

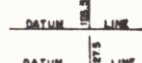

CURVE DATA

- | | |
|-----------------------------|----------|
| DEFLECTION OF ANGLE | A |
| DEGREE OF CURVE | D |
| RADIUS OF CURVE | R |
| TANGENT DISTANCE | T |
| LENGTH OF CURVE | L |
| EXTERNAL DISTANCE | E |
| POINT OF INTERSECTION | P.I. |
| POINT OF CURVE | P.C. |
| POINT OF TANGENT | P.T. |
| POINT ON TANGENT | P.O.T. |
| POINT ON SUB-TANGENT | P.O.S.T. |
| R.C.W. LIMITS | |

FOR RIGHT OF WAY DETAILS,
SEE RIGHT OF WAY PLANS FOR THIS PROJECT.

THESE PLANS ARE SUBJECT TO SUCH REVISIONS AS MAY BE
REQUIRED BY THE BUREAU OF PUBLIC ROADS OR THE COMMISSIONER
OF HIGHWAYS

CONSTRUCTION IS TO BE CARRIED ON IN ACCORDANCE WITH THESE PLANS AND THE STANDARD SPECIFICATIONS FOR HIGHWAY AND BRIDGE CONSTRUCTION DATED APRIL, 1964, AS APPROVED BY THE BUREAU OF PUBLIC ROADS ON OCTOBER 12, 1964, INCLUDING ALL SUBSEQUENT APPROVED REVISIONS AND SUCH REVISED SPECIFICATIONS AND SPECIAL PROVISIONS AS ARE INCORPORATED IN THESE PLANS.

DEPARTMENT OF COMMERCE
BUREAU OF PUBLIC ROADS

APPROVED

DIVISION ENGINEER DATE

BP NO 041-4-6710

INTERFUR

SHEET 1 OF SHEETS *WR*

PLAN
 DRAWN BY
 SURVEYED BY
 11/88
 11/88

PROFILE
 DRAWN BY
 SURVEYED BY
 11/88
 11/88

Three Cable Guard Rail w/Steel Posts Item 542
 190+92.8-200+00.00

Bituminous Concrete Surface for
 Gutters & Traffic Islands Item 554
 194+25-199+25.11

Construct Drive
 199+71.7 Lt


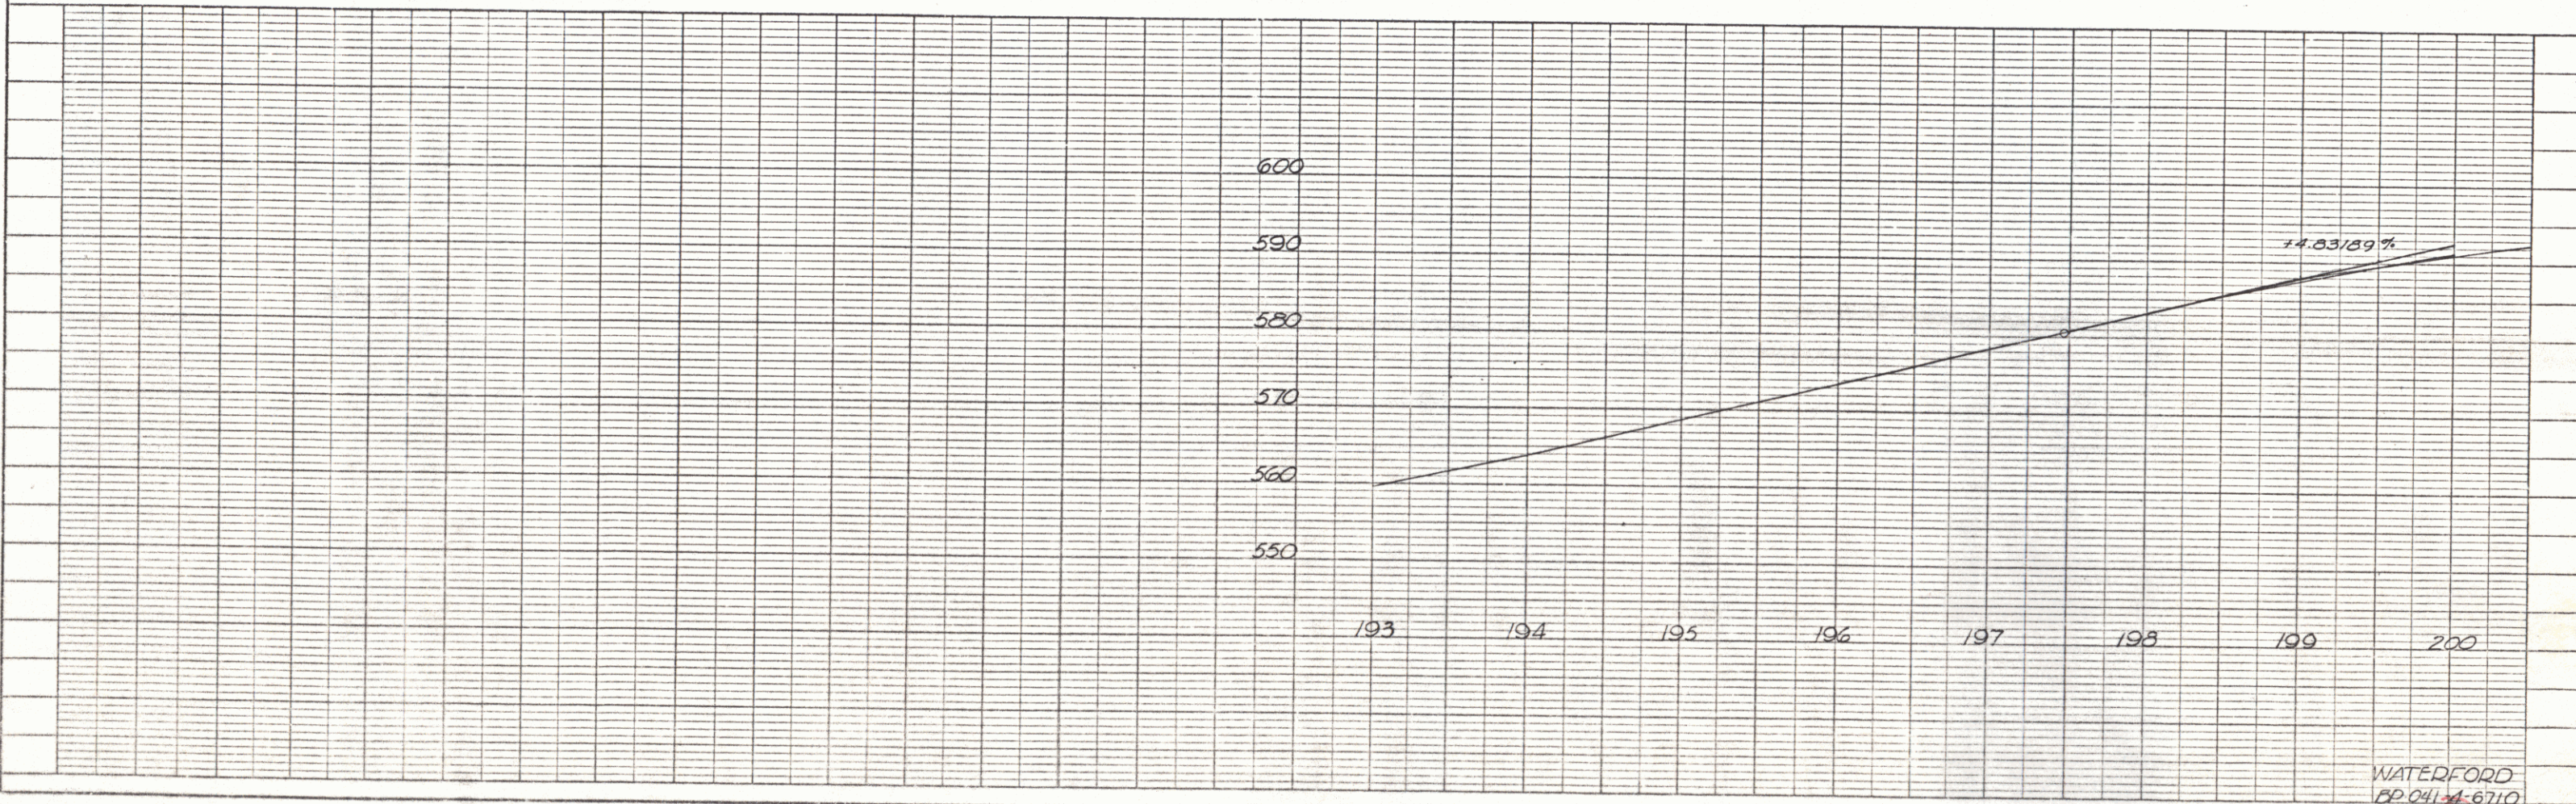


PLATE 1, PLANS/PROFILE
 48 7012 IMPERIAL™ TACING PLATE 1101

WATERFORD
 199 04/11/67/10
 Sheet 1A of 1

POOR ORIGINAL COPY

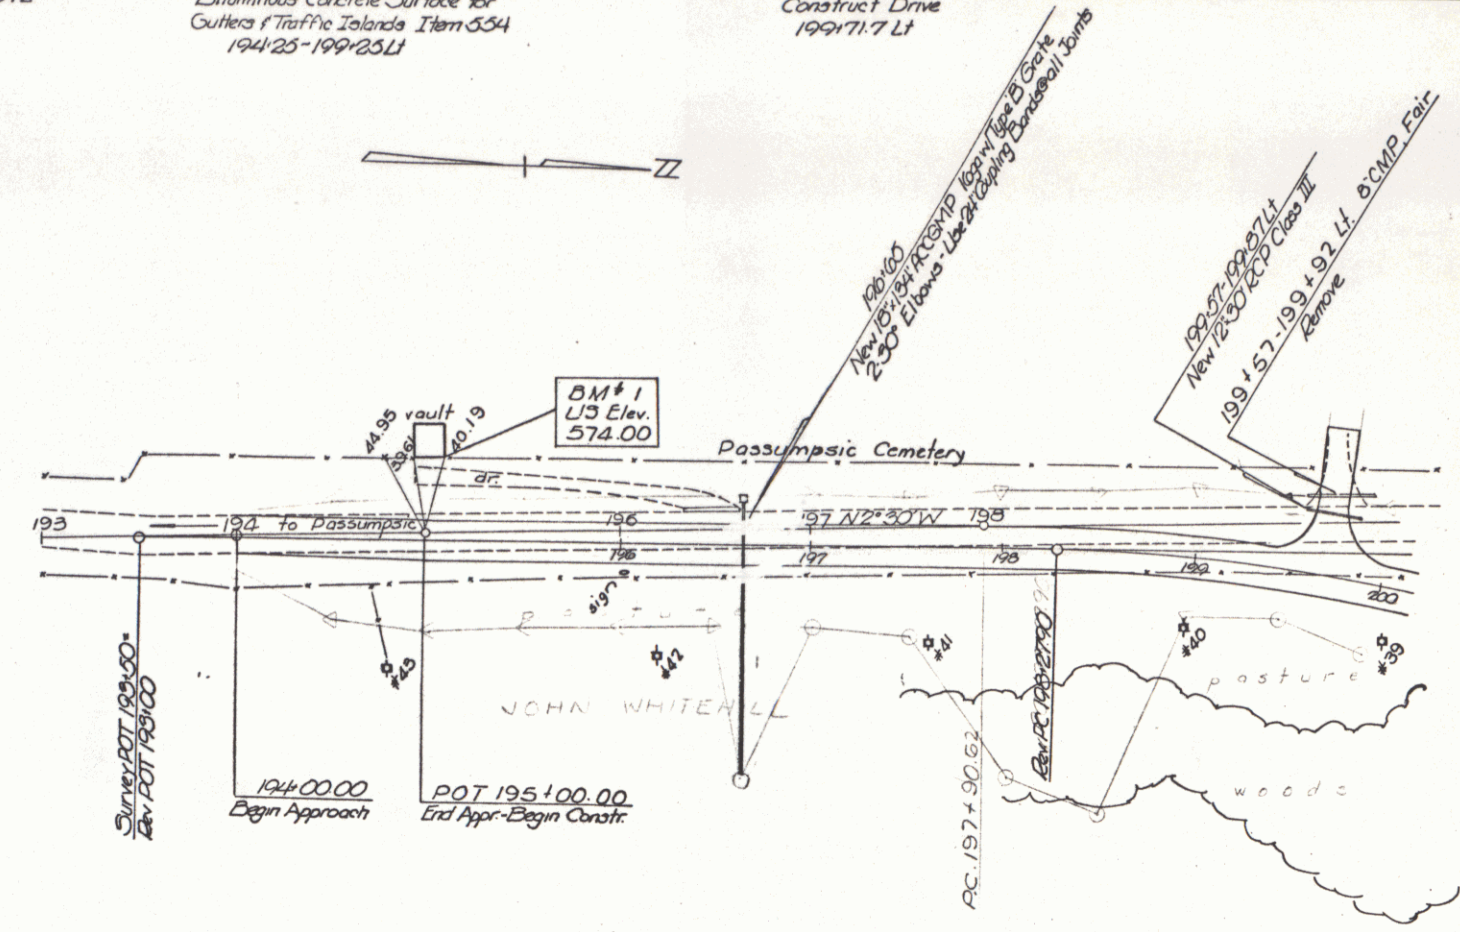