


NOTE:


THERE ARE WATER PIPE LINES CROSSING THE HIGHWAY FROM WEST TO EAST AND SERVING THE RESIDENCES OF M.F. DOWNING AND MISS E.C. BUCKMAN AND W.F. HUME.

PROPER CARE TO BE TAKEN BY THE CONTRACTOR DURING CONSTRUCTION SO AS NOT TO DAMAGE THESE PIPE LINES. ANY DAMAGE TO DAMAGE THESE PIPE LINES. ANY DAMAGE THAT HE MAY DO MUST BE REPAIRED AT HIS EXPENSE.

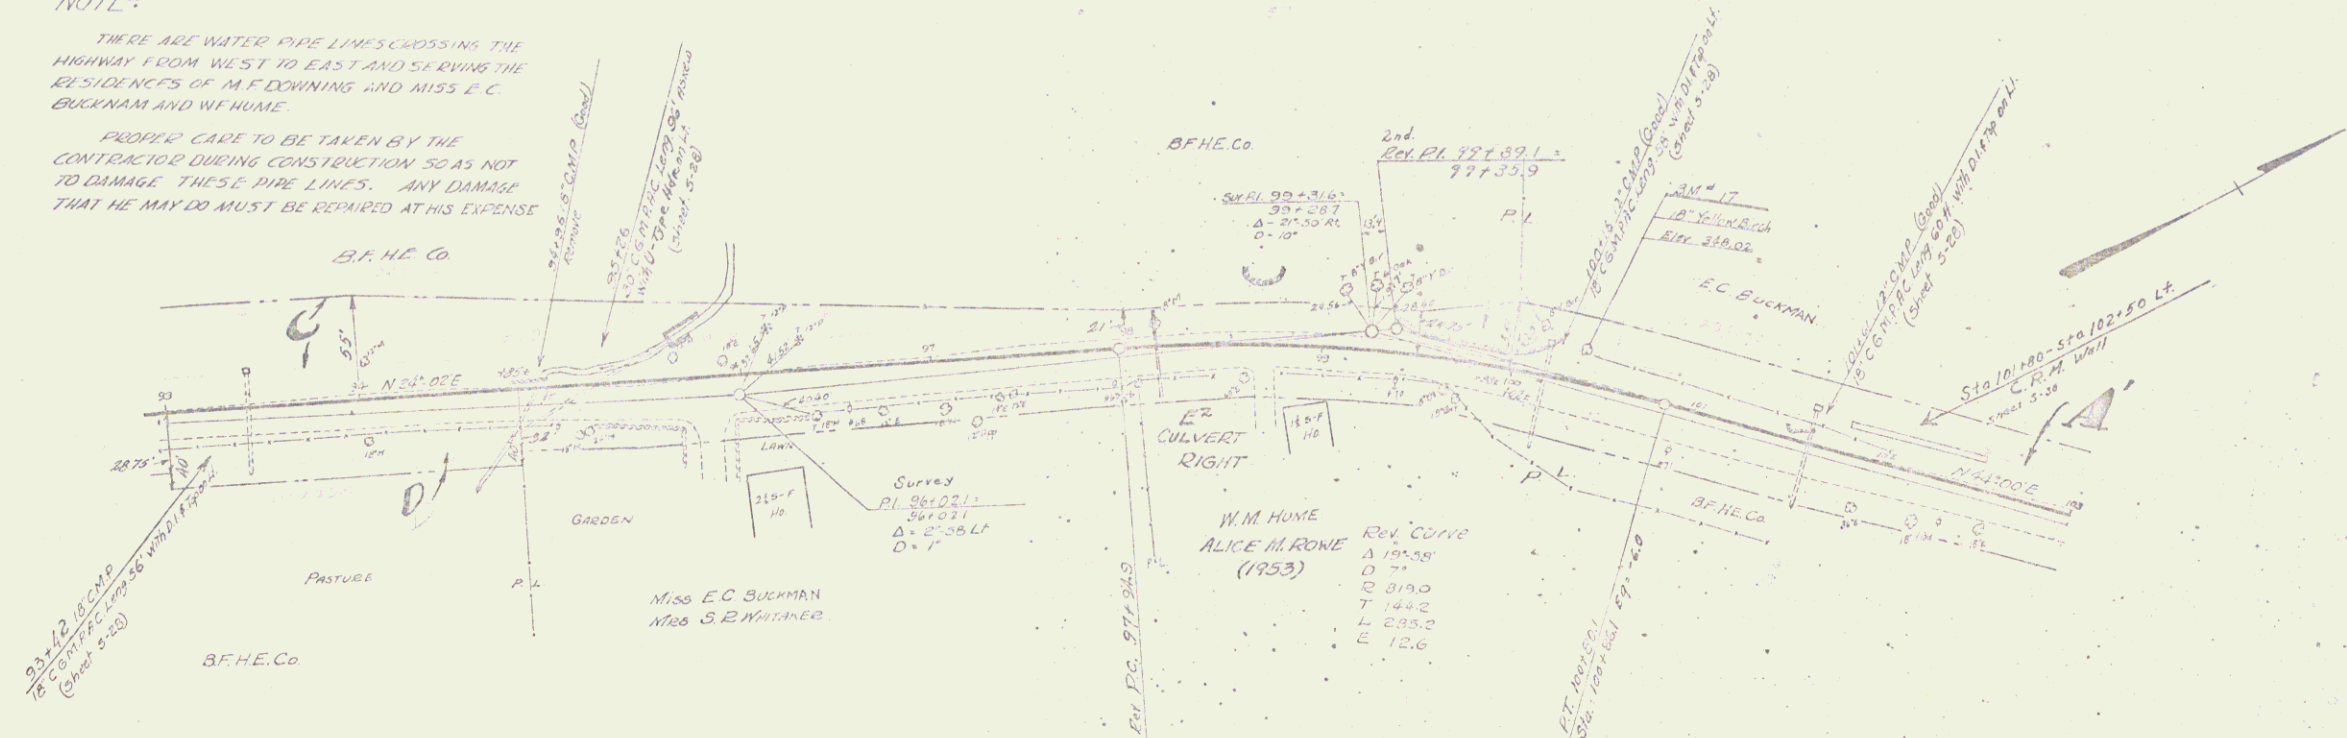

PARCEL	KIND OF INSTRUMENT	DATE OF INSTRUMENT	GRANTOR	GRANTEE	RECORDED BOOK PAGE	DATE
A'	W.D.	2-17-36	ETHEL C. BUCKMAN	ST. OF VT. 87	10	2-24-36
C-D-E	A.C.D.	2-6-36	Bellows Falls Hydro-Elec. Corp.	"	75	2-14-36
E2	W.D.G.E.	8-14-53	ALICE M. ROWE	"	117	8-24-53

NOTE: Approximately 505 cu yd of fill between Sta. 99+80 - 100+80 10.75 cu yds from each end would be between Sta. 99+00 - 89+00, Part of F.R. 135-D.

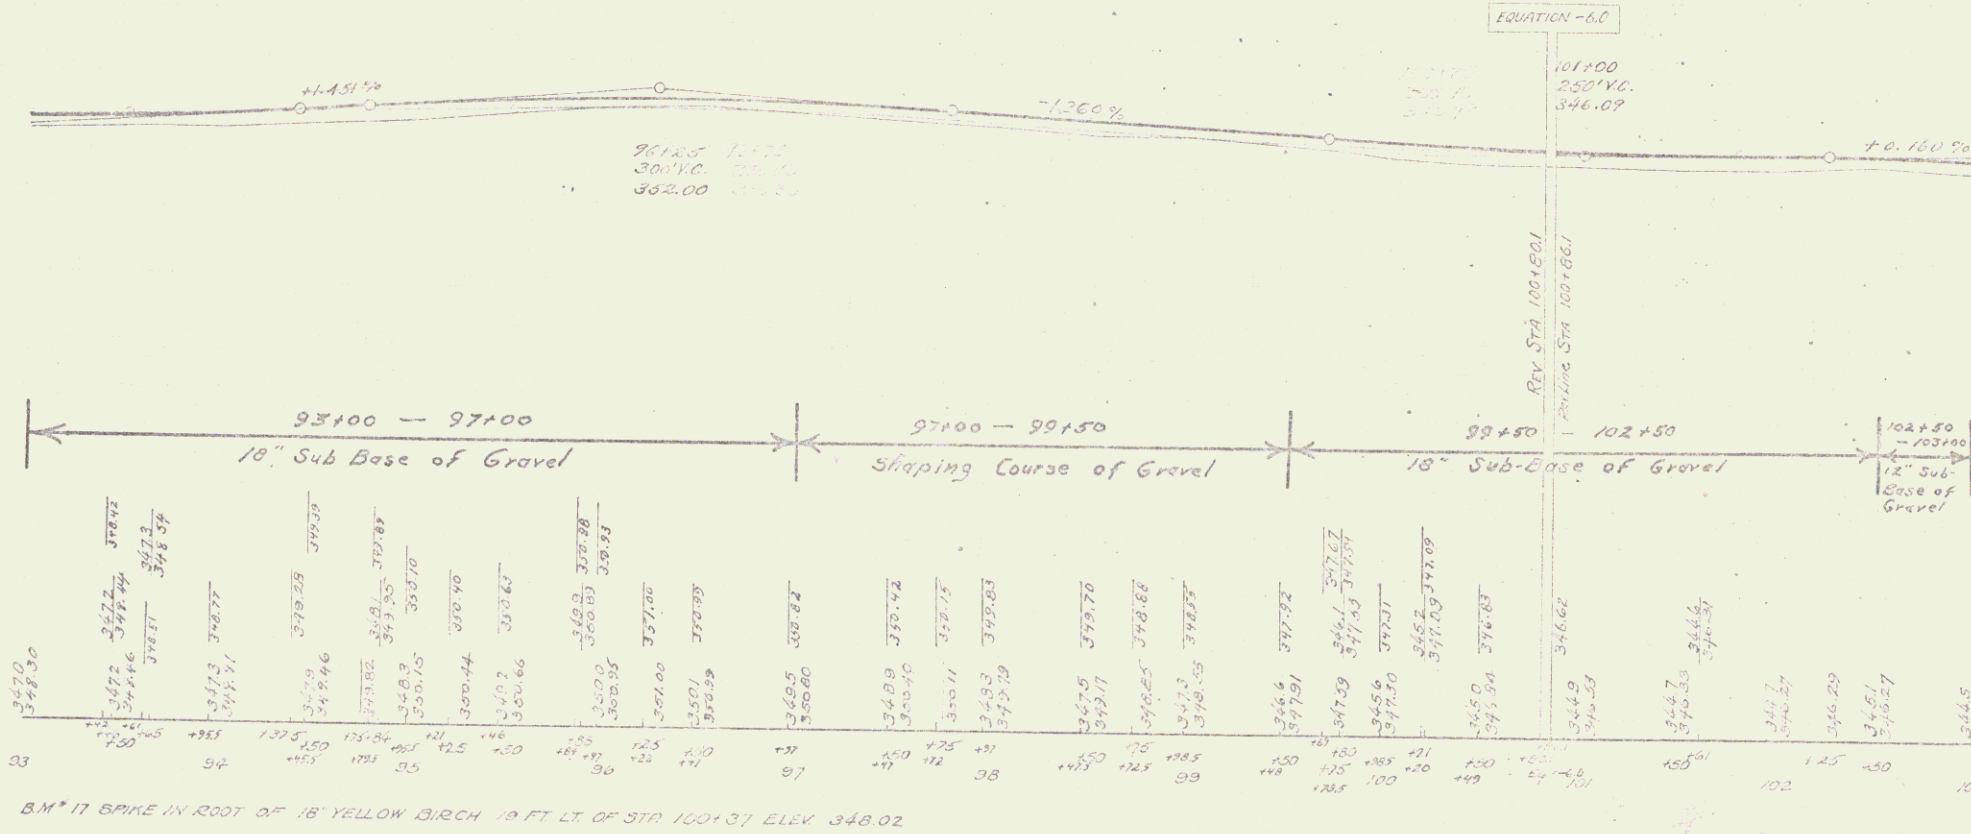

BM #17 SPRING IN ROOT OF 18" YELLOW BIRCH 10 FT. LT. OF STA 100+37 ELEV. 348.02