
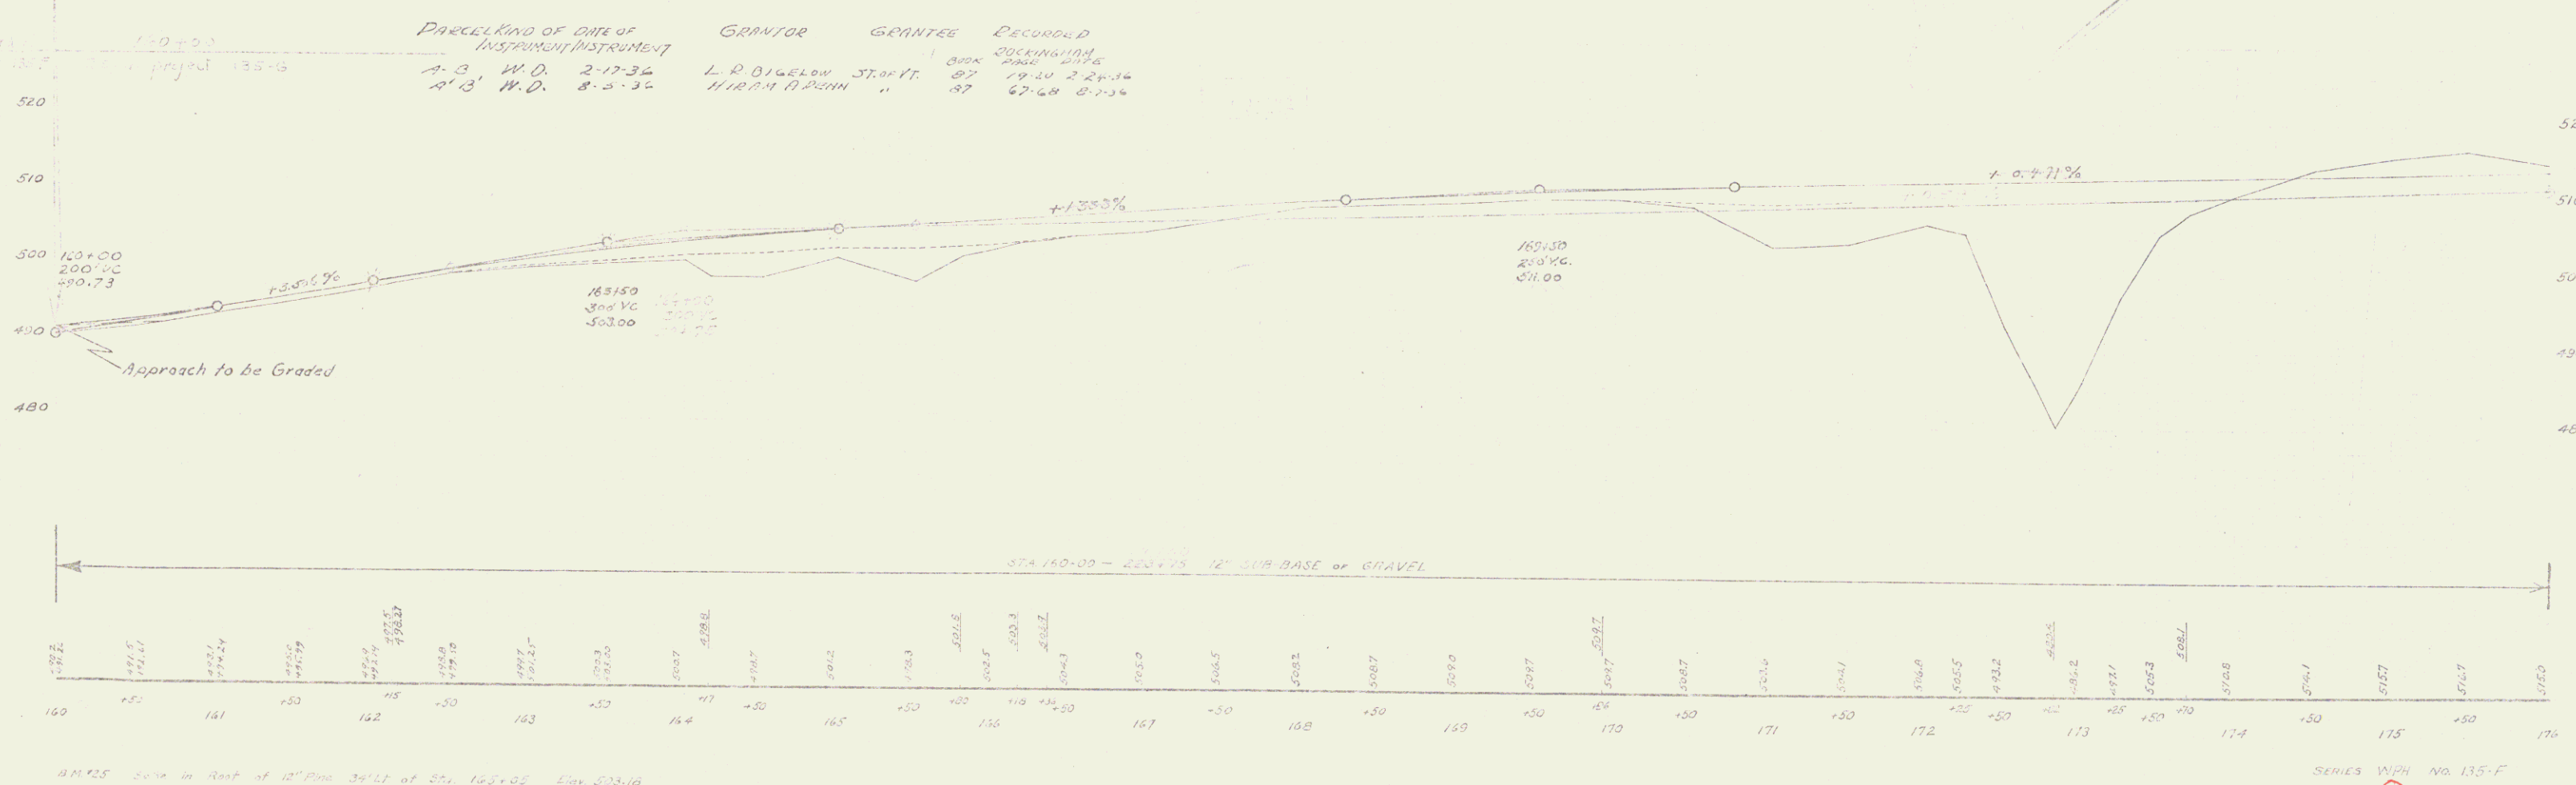


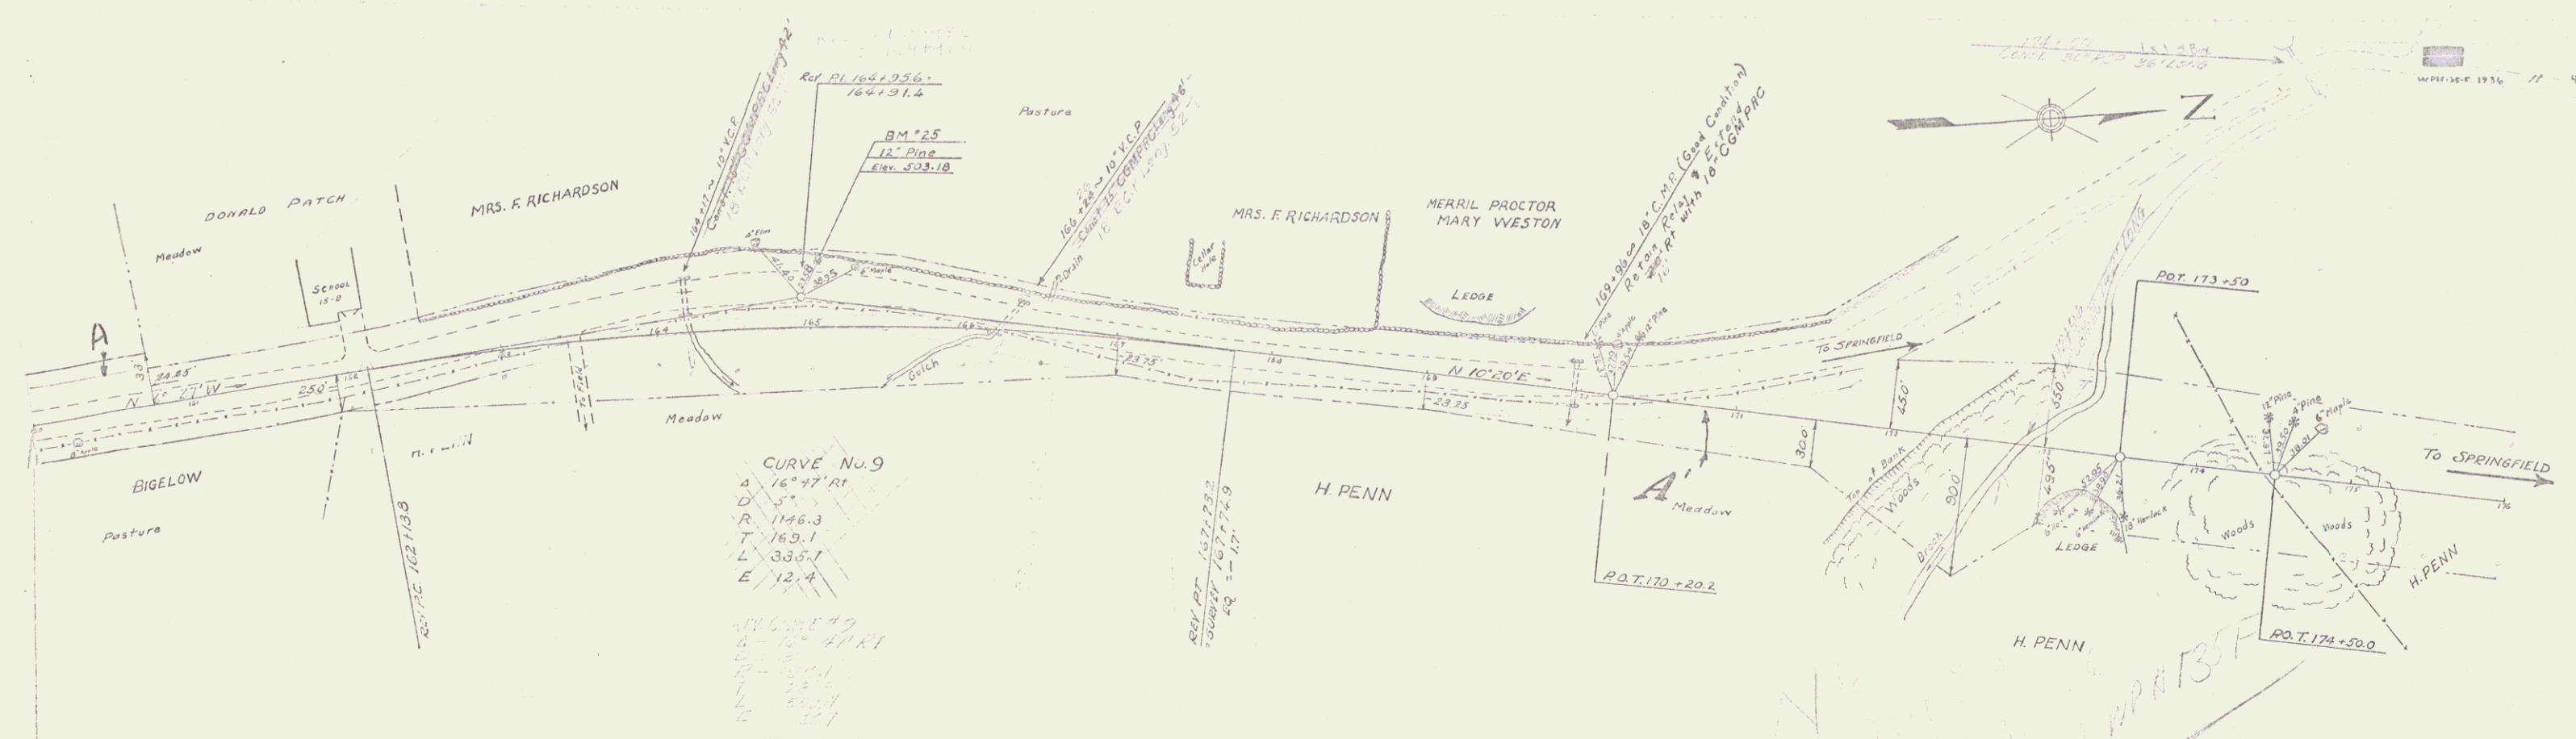

SERIES WITH NO. 135-F  
SHEET II OF 49 SHEETS