
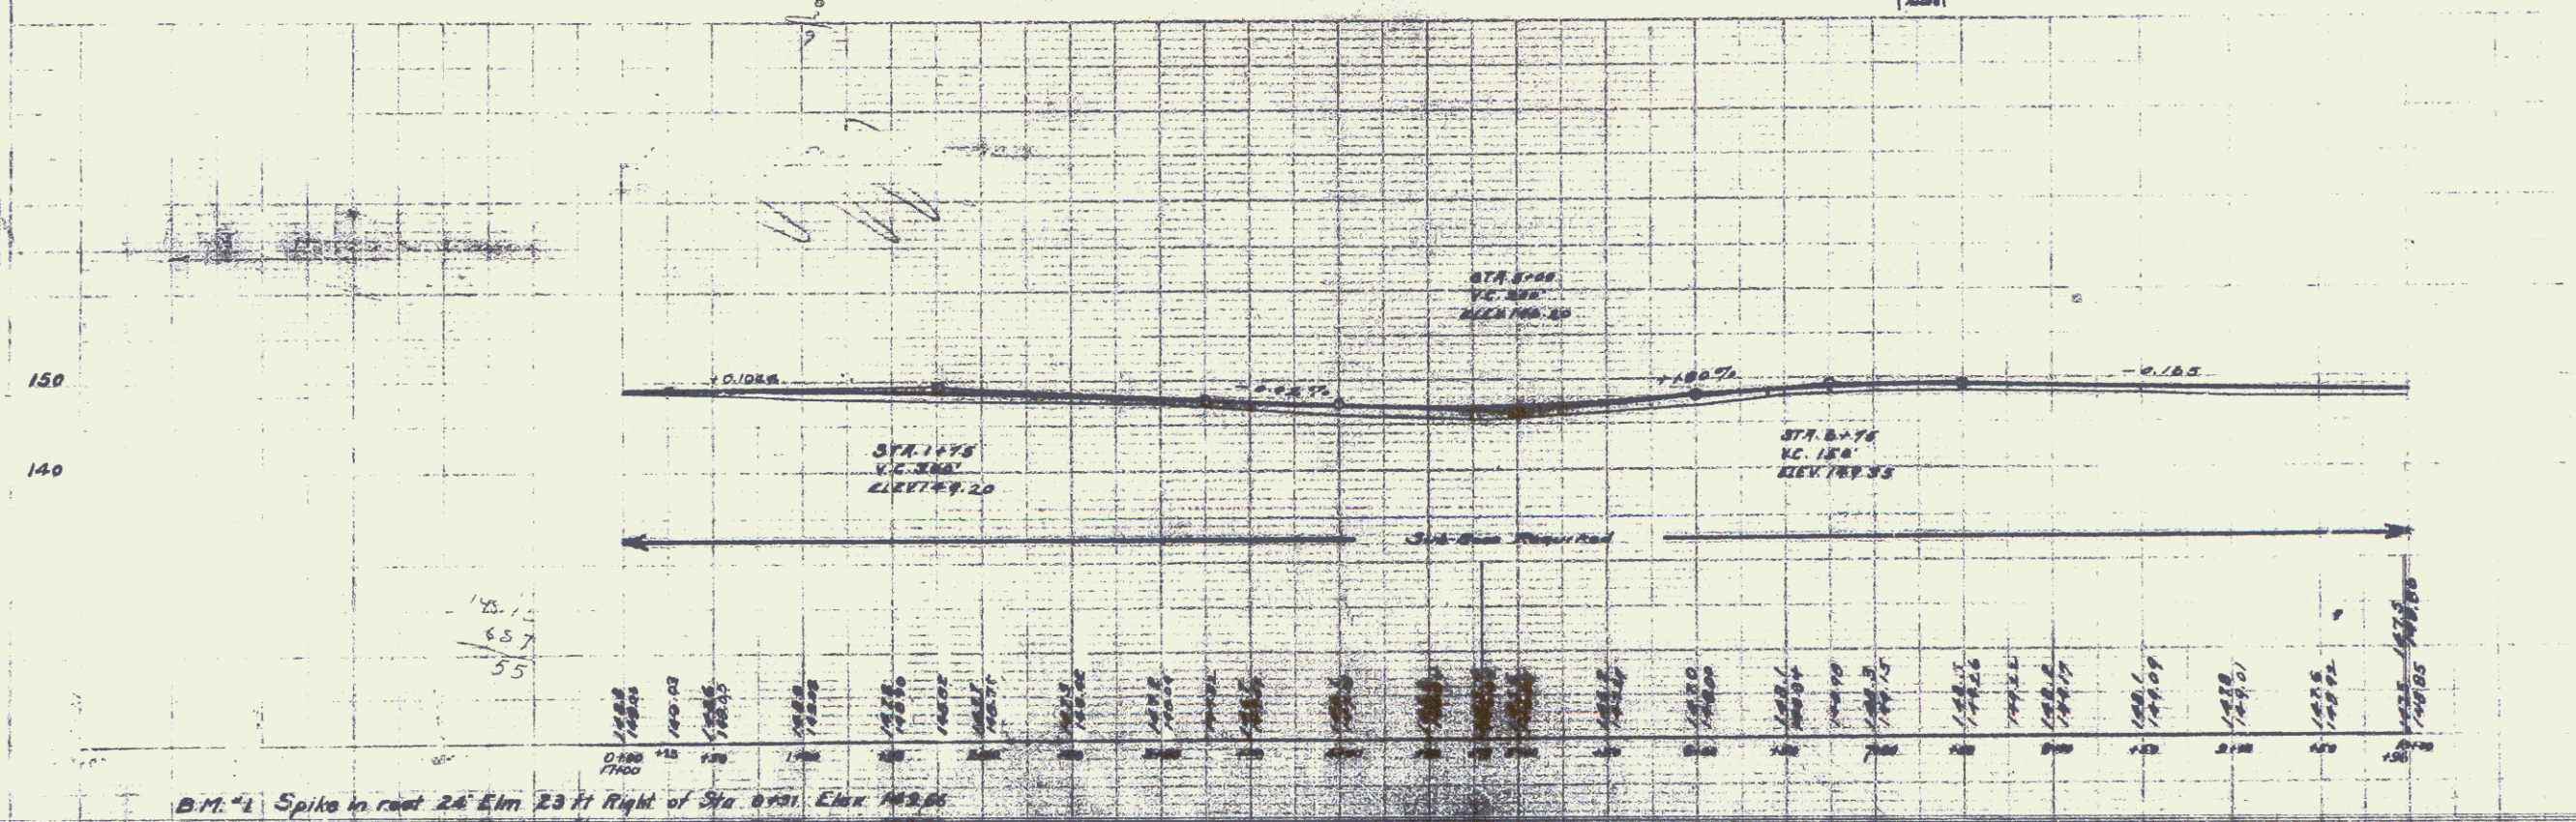


FED. ROAD DIST. NO.	STATE	FED. AID PROJ. NO.	FED. AID YEAR	FED. AID PERCENT	SHEET NO.	TOTAL SHEETS
5	VT	6	1927	50	27	

Sta 4167 to 4181 Right of Way Length 247' 18"
 Sta 4167 to 4181 Left of Way Length 247' 18"

Sta reset at Village/Town Line

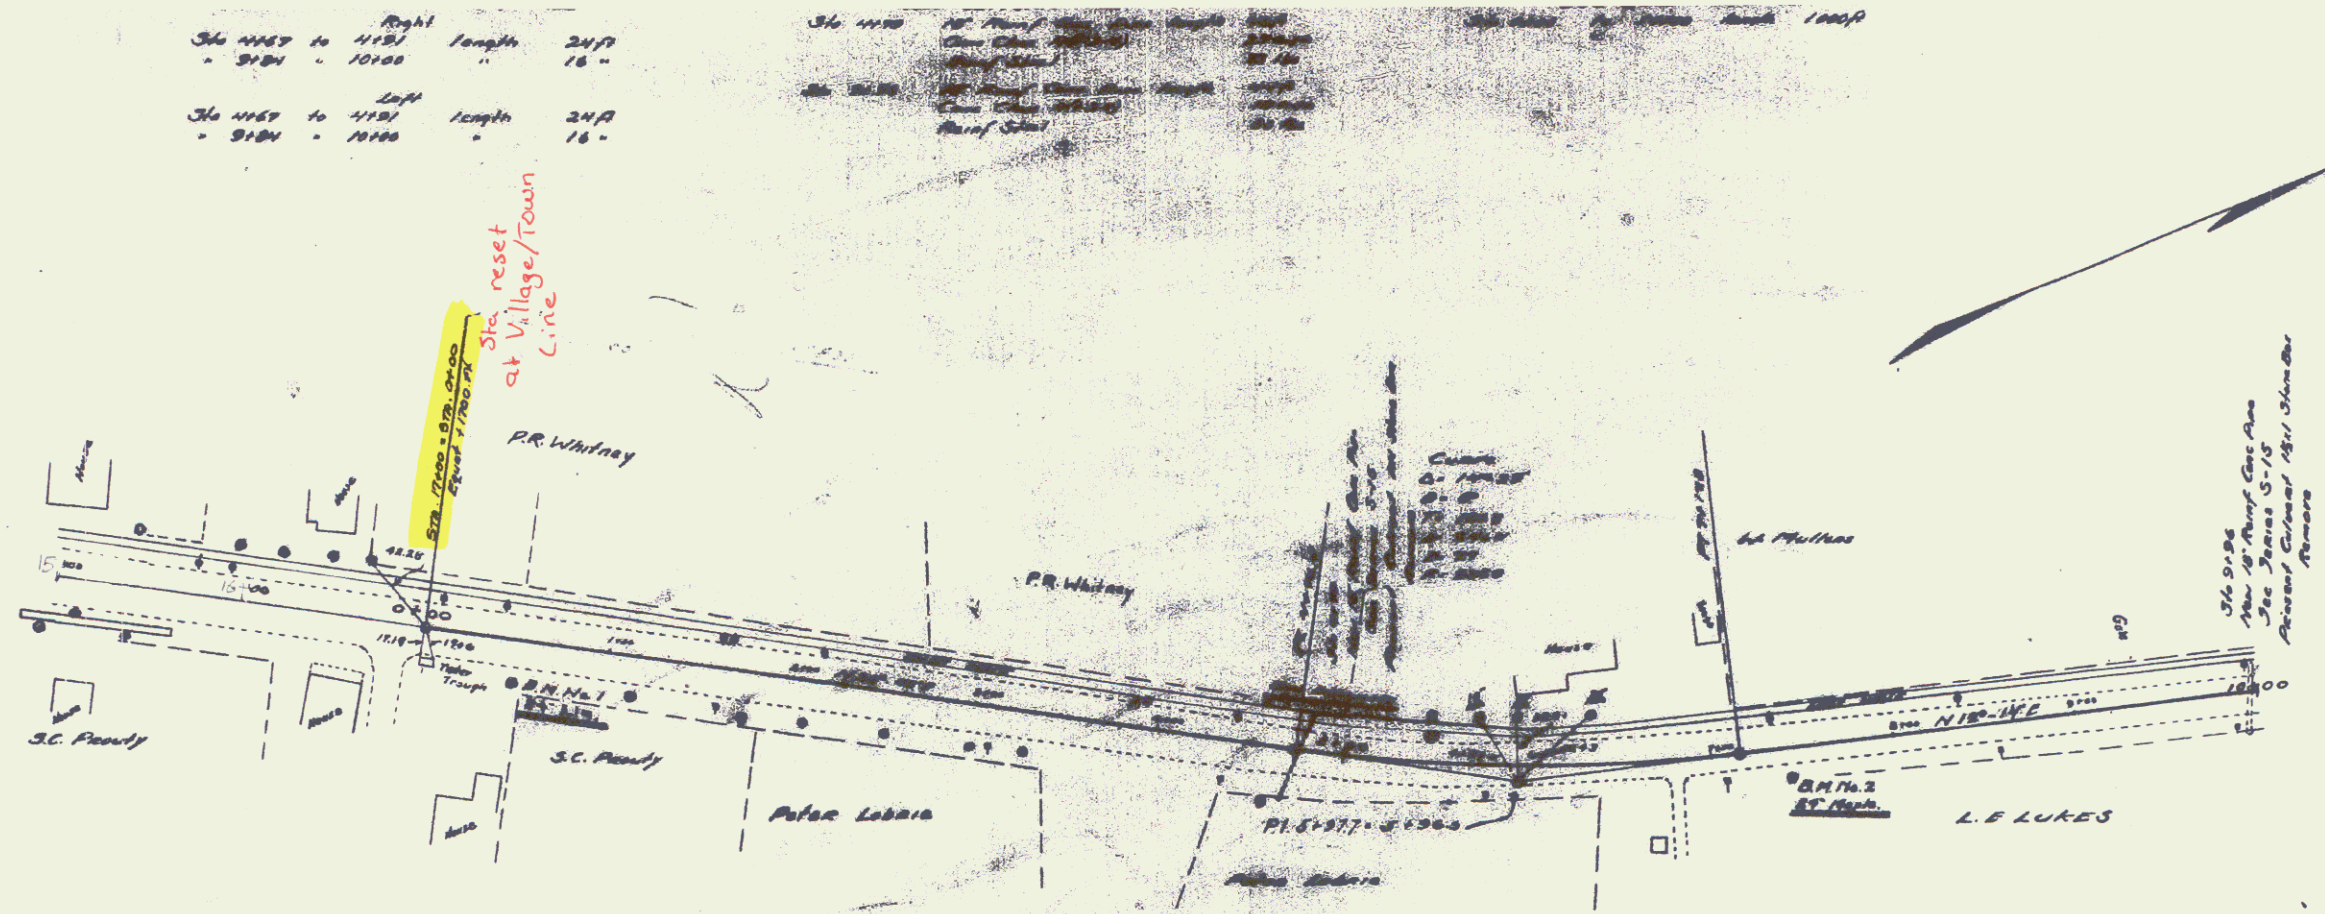

B.M. 1 Spikes in road 26' E. 23' N. Right of Sta. 4167. Elev. 148.00