

INDEX OF SHEETS

SHEET NO.	TITLE PAGE
1	TYPICAL CROSS-SECTION OF IMPROVEMENT (7" ONE COURSE CEMENT CONCRETE PAVEMENT, ITEM 35A)
2	BANKING AND WIDENING TABLES
3	PLAN AND PROFILE
4-8	7'x5' REINFORCED CONCRETE BOX STA. 30+05
9-28	PIPE CULVERTS
11	S-30 GUARD RAIL
12	S-30A BOUNDARY MARKERS
13	S-33 ONE COURSE CEMENT CONCRETE PAVEMENT
14	S-40 BARRICADES, SIGNS, LIGHTS (ROADWAY)
15	SB-11 BARRICADES, SIGNS, LIGHTS (BRIDGE)
16	S-41 ROUNDING OF SLOPES
17-26	CROSS SECTIONS

STANDARD STRUCTURE SHEETS APPROVED BY THE CHIEF ENGINEER

S-28 JULY 11, 1933
S-30 AUG 15, 1934

STATE OF VERMONT
STATE HIGHWAY DEPARTMENT

PLAN AND PROFILE OF PROPOSED
STATE HIGHWAY


FEDERAL AID PROJECT

TOWN OF HIGHGATE
ROUTE U.S. 7


BEGINNING AT A POINT 750 FEET NORTHERLY
OF THE NORTHERN END OF FEDERAL AID PROJECT
82A (1926) IN HIGHGATE SPRINGS AND EXTENDING NORTHERLY
TO THE SOUTHERN END OF FEDERAL AID PROJECT 21 (1)

LENGTH OF PROJECT 5362 FT. = 1.015 MILES

FED. ROAD DIST. NO.	STATE	FE. NO.	FE. NO.	FE. NO.	FE. NO.	FE. NO.	FE. NO.	FE. NO.	FE. NO.
9	VT	34	12	12	12	12	12	12	12

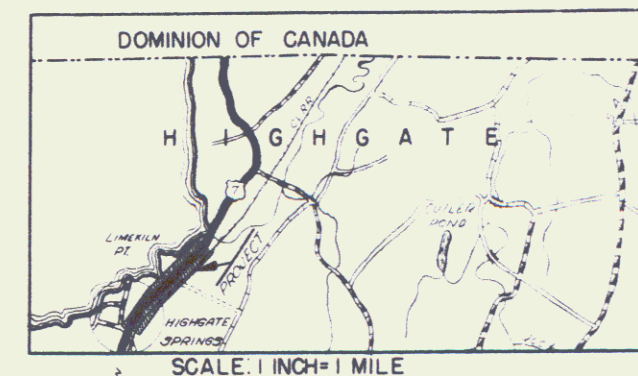

RECORD PLANS
By H.C. BIRD

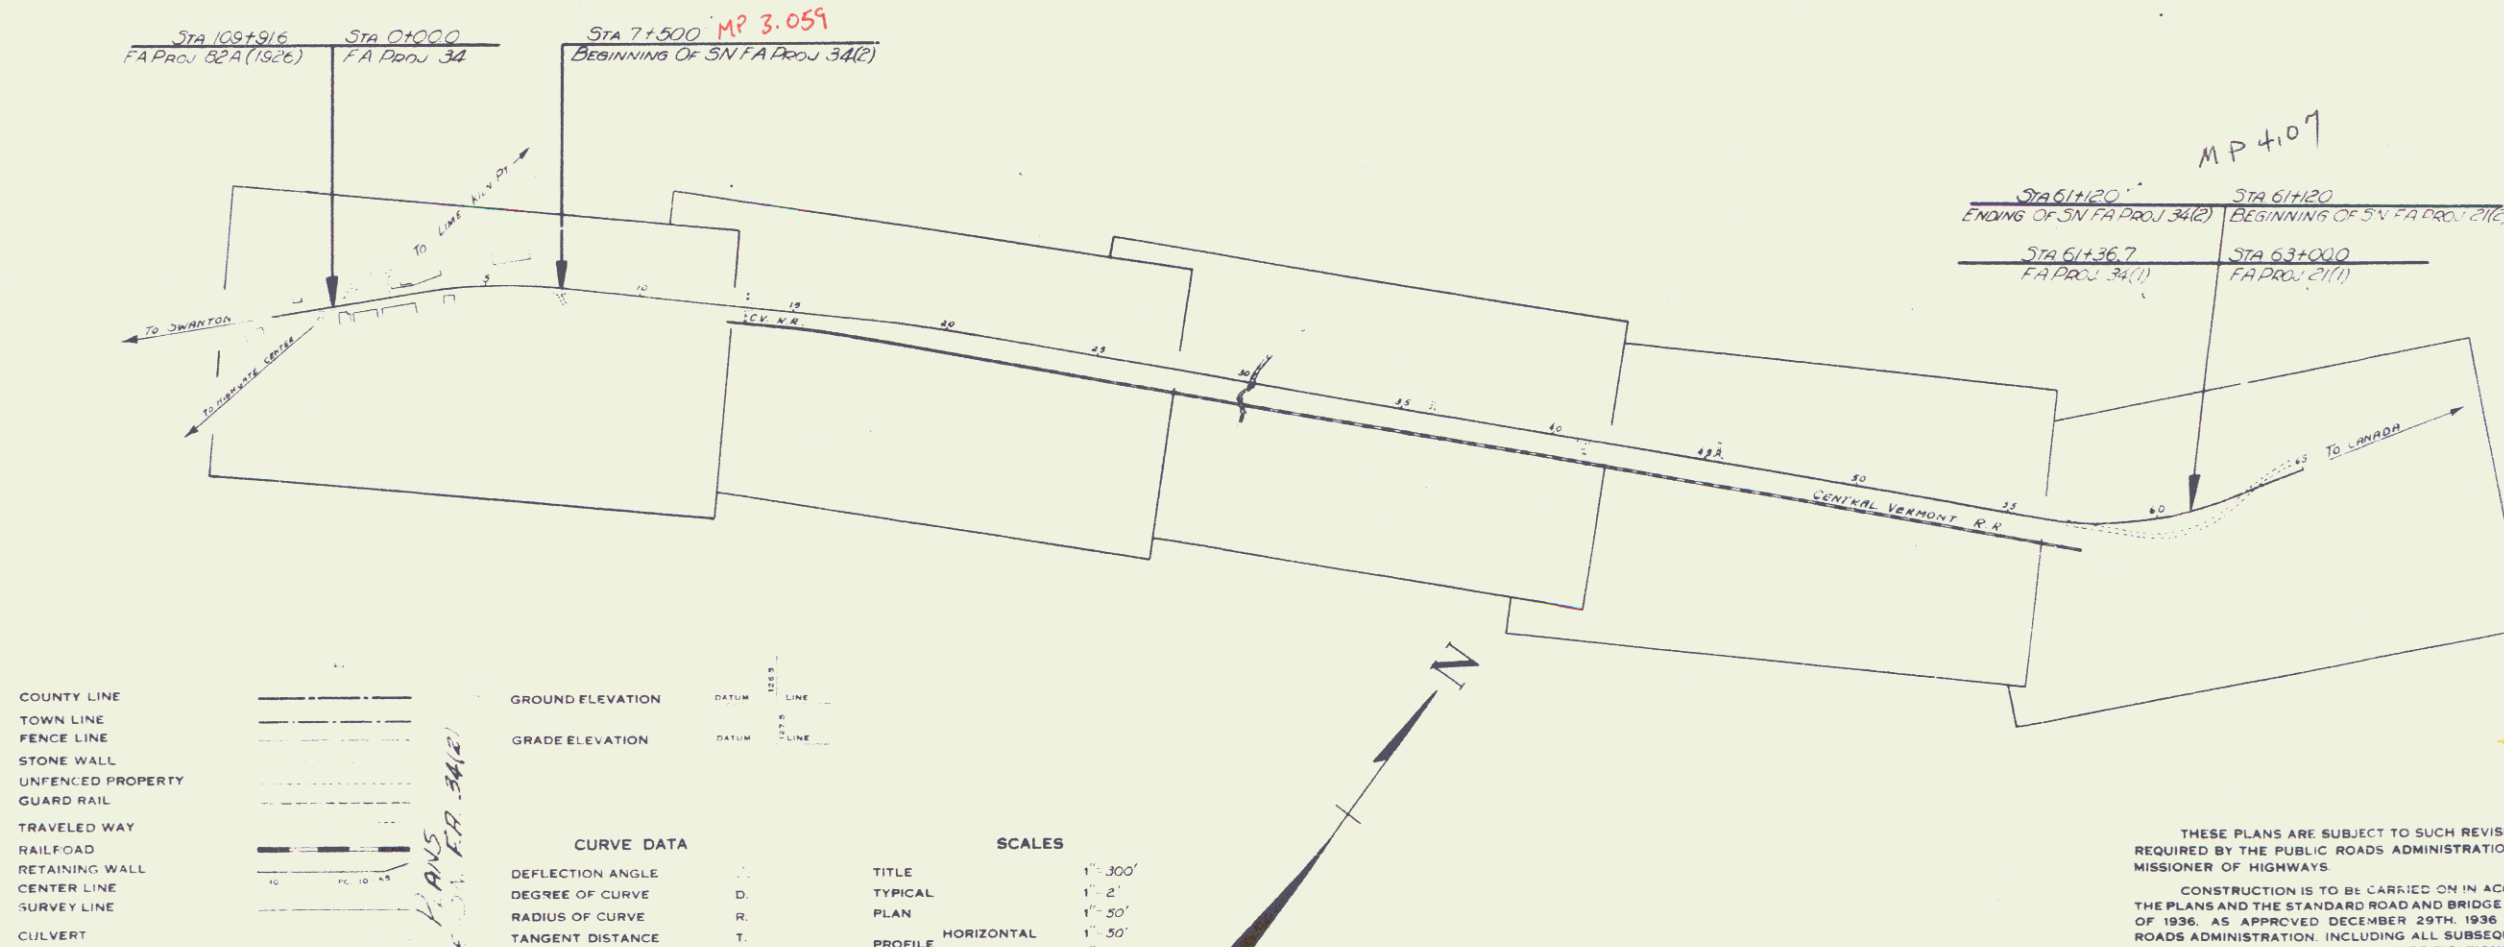

APPROVED: [Signature]
COMMISSIONER OF HIGHWAYS

SUBMITTED BY ORDER OF THE STATE HIGHWAY BOARD

1/1/42

Project No. S.N.F.A.P. 34(2)

RECOMMENDED FOR APPROVAL

DISTRICT ENGINEER
PUBLIC WORKS ADMINISTRATION
FEDERAL WORK AGENCY

APPROVED

THESE PLANS ARE SUBJECT TO SUCH REVISIONS AS MAY BE
REQUIRED BY THE PUBLIC ROADS ADMINISTRATION OR THE COM-
MISSIONER OF HIGHWAYS.

CONSTRUCTION IS TO BE CARRIED ON IN ACCORDANCE WITH
THE PLANS AND THE STANDARD ROAD AND BRIDGE SPECIFICATIONS
OF 1936, AS APPROVED DECEMBER 28TH, 1936 BY THE PUBLIC
ROADS ADMINISTRATION INCLUDING ALL SUBSEQUENT APPROVED
REVISIONS AND SUCH REVISED SPECIFICATIONS AND SPECIAL