

STATE OF VERMONT
DEPARTMENT OF HIGHWAYS



PROPOSED IMPROVEMENT
TOWNS OF COLCHESTER & MILTON
COUNTY OF CHITTENDEN
BURLINGTON - ST. ALBANS ROAD

U.S. ROUTE 7

BETTERMENT PROJECT

BEGINNING AT A POINT APPROX. 0.08 MILES NORTHERLY OF THE JUNCTION OF U.S. ROUTE 2, AND U.S. ROUTE 7, AND EXTENDING NORTHERLY 0.492 MILES.

LENGTH OF PROJECT 2600.0 FT.


END R.O.W. PROJECT

BP 019-5-7510 STA. 150+50
MP 0.129

BEGIN R.O.W. PROJECT

BP 019-5-7510 STA. 124+50
MP 6.596

R.O.W. PLANS

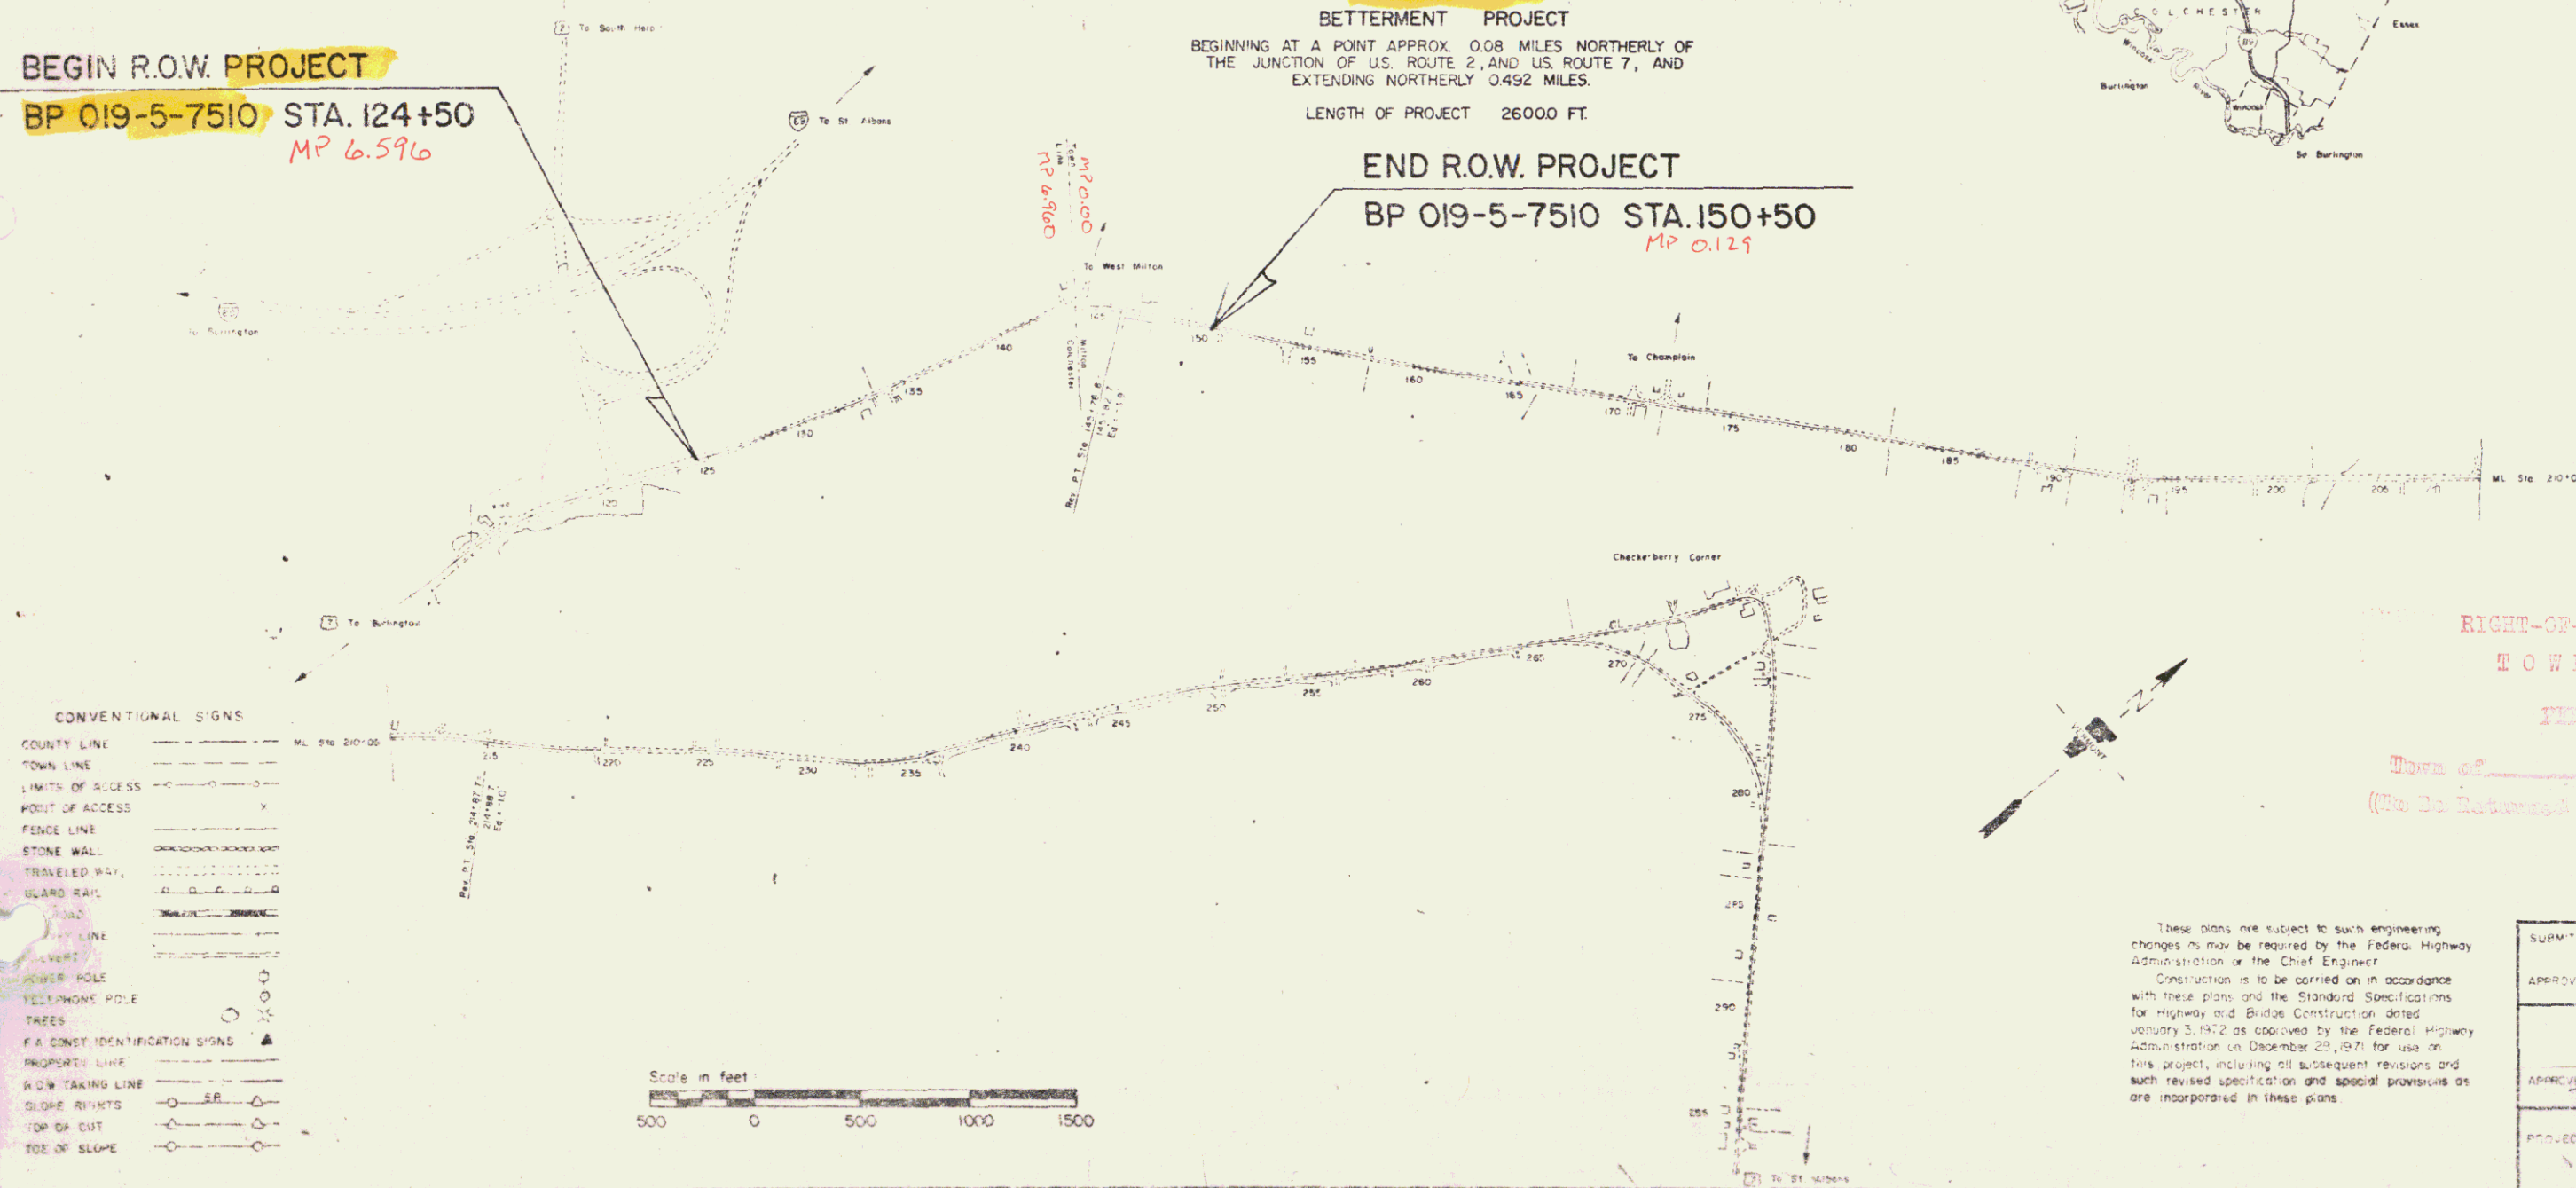

RIGHT-OF-WAY DIVISION
TOWN FILE

These plans are subject to such engineering changes as may be required by the Federal Highway Administration or the Chief Engineer.

Construction is to be carried on in accordance with these plans and the Standard Specifications for Highway and Bridge Construction dated January 3, 1942 as approved by the Federal Highway Administration on December 28, 1971 for use on this project, including all subsequent revisions and such revised specification and special provisions as are incorporated in these plans.

SUBMITTED BY ORDER OF THE STATE HIGHWAY DEPARTMENT

APPROVED C. H. Steiner DATE 4-8-71
CHIEF ENGINEER

APPROVED: SP Jensen DATE 4-8-7
ROW DIRECTOR

PROJECT NO BP 019-5-7510

SHEET 1 OF 4 SHEETS

STATE OF VERMONT
DEPARTMENT OF HIGHWAYS
RIGHT-OF-WAY PLANS
DETAIL SHEET

TABLE OF PROJECT PROPERTY ACQUISITION

PARCEL NO.	GRANTOR	SHEET NO.	BEGINNING STATION	ENDING STATION	TAKING	REM.	RIGHTS	TITLE TAKEN	DATE	TOWN OR CITY RECORDED	BK.	PG.	REMARKS
1	STARR, BERNARD F. & VIRGINIA C.		128+50 LT 127+15 LT	133+64 LT			SLOPE (P) (0.14 A±) DRIVE (T)						DRIVE 14', GRAVEL, M.P.066 DRIVE RELEASE DATE: DRIVE PERMIT DATE:
2	VAN BUREN, RONALD C. & JUNE M.		133+55 LT	135+00 LT			SLOPE (P) (1150 S.F.±)						
3	JACKSON, KENNETH L.		139+73 LT 140+61 LT				DRIVE (T) DRIVE (T)						DRIVE 18', GRAVEL, M.P.068 DRIVE RELEASE DATE: DRIVE PERMIT DATE: DRIVE 16', GRAVEL, M.P.069 DRIVE RELEASE DATE: DRIVE PERMIT DATE:
4	LARRABEE, GEORGE F. & NELLIE A. LARRABEE, GEORGE F., JR. & LUCILE M.		127+00 RT 133+00 RT 133+00 RT 134+25 RT	131+50 RT 135+00 RT			SLOPE (P) (3050 S.F.±) SLOPE (P) (400 S.F.±) DRIVE (T) DRIVE (T)						DRIVE 24', GRAVEL, M.P.067 DRIVE RELEASE DATE: DRIVE PERMIT DATE: DRIVE 19', GRAVEL, M.P.060 DRIVE RELEASE DATE: DRIVE PERMIT DATE:

TABLE OF REVISIONS

REVISION NO.	SHEET NO.	DESCRIPTION OF REVISION	DATE	MADE BY	APPROVED BY




MADE BY: NBB DATE: 4-2-75

CHECKED BY: _____ DATE: _____

DR. RT. — DRAINAGE RIGHT
DIT. RT. — DITCHING RIGHT
CH. RT. — CHANNEL RIGHT
DRIVE RT. — DRIVE RIGHT
CUL. RT. — CULVERT RIGHT
D — DEMOLITION OR
REMOVAL
W — WATER SOURCES

-----	PRESENT	R.O.W.
///-----///	TAKING WITHOUT ACCESS	
/// <u>P</u> ---///	TAKING WITHOUT ACCESS ALONG PROPERTY LINES	
-----	TAKING WITH ACCESS	
(P)	PERMANENT EASEMENT	
(T)	TEMPORARY EASEMENT	

   LEGEND

 SR SR SLOPE RIGHTS
 P L PROPERTY LINE
 Δ Δ Δ TOP OF CUT
 ○ ○ ○ TOE OF SLOPE



APPROVED Thomas P. Mayo DATE 4-8-73
CHIEF OF PLANS & BATTLES

PROJECT COLCHESTER-MILTON
NO. BP 019-5-7510
SHEET (2) OF 4

REGIN ROW PROJECT
EP 919-S-7510 STA. 124+50

CONSTRUCT DRIVE
133+00 ST
134+25 RT
127+15 LT

ALL DRIVES AS INDICATED ON
PLANS ARE SUBJECT TO PERMITS
PURSUANT TO TITLE 19, SEC. 43,
V.S.A.

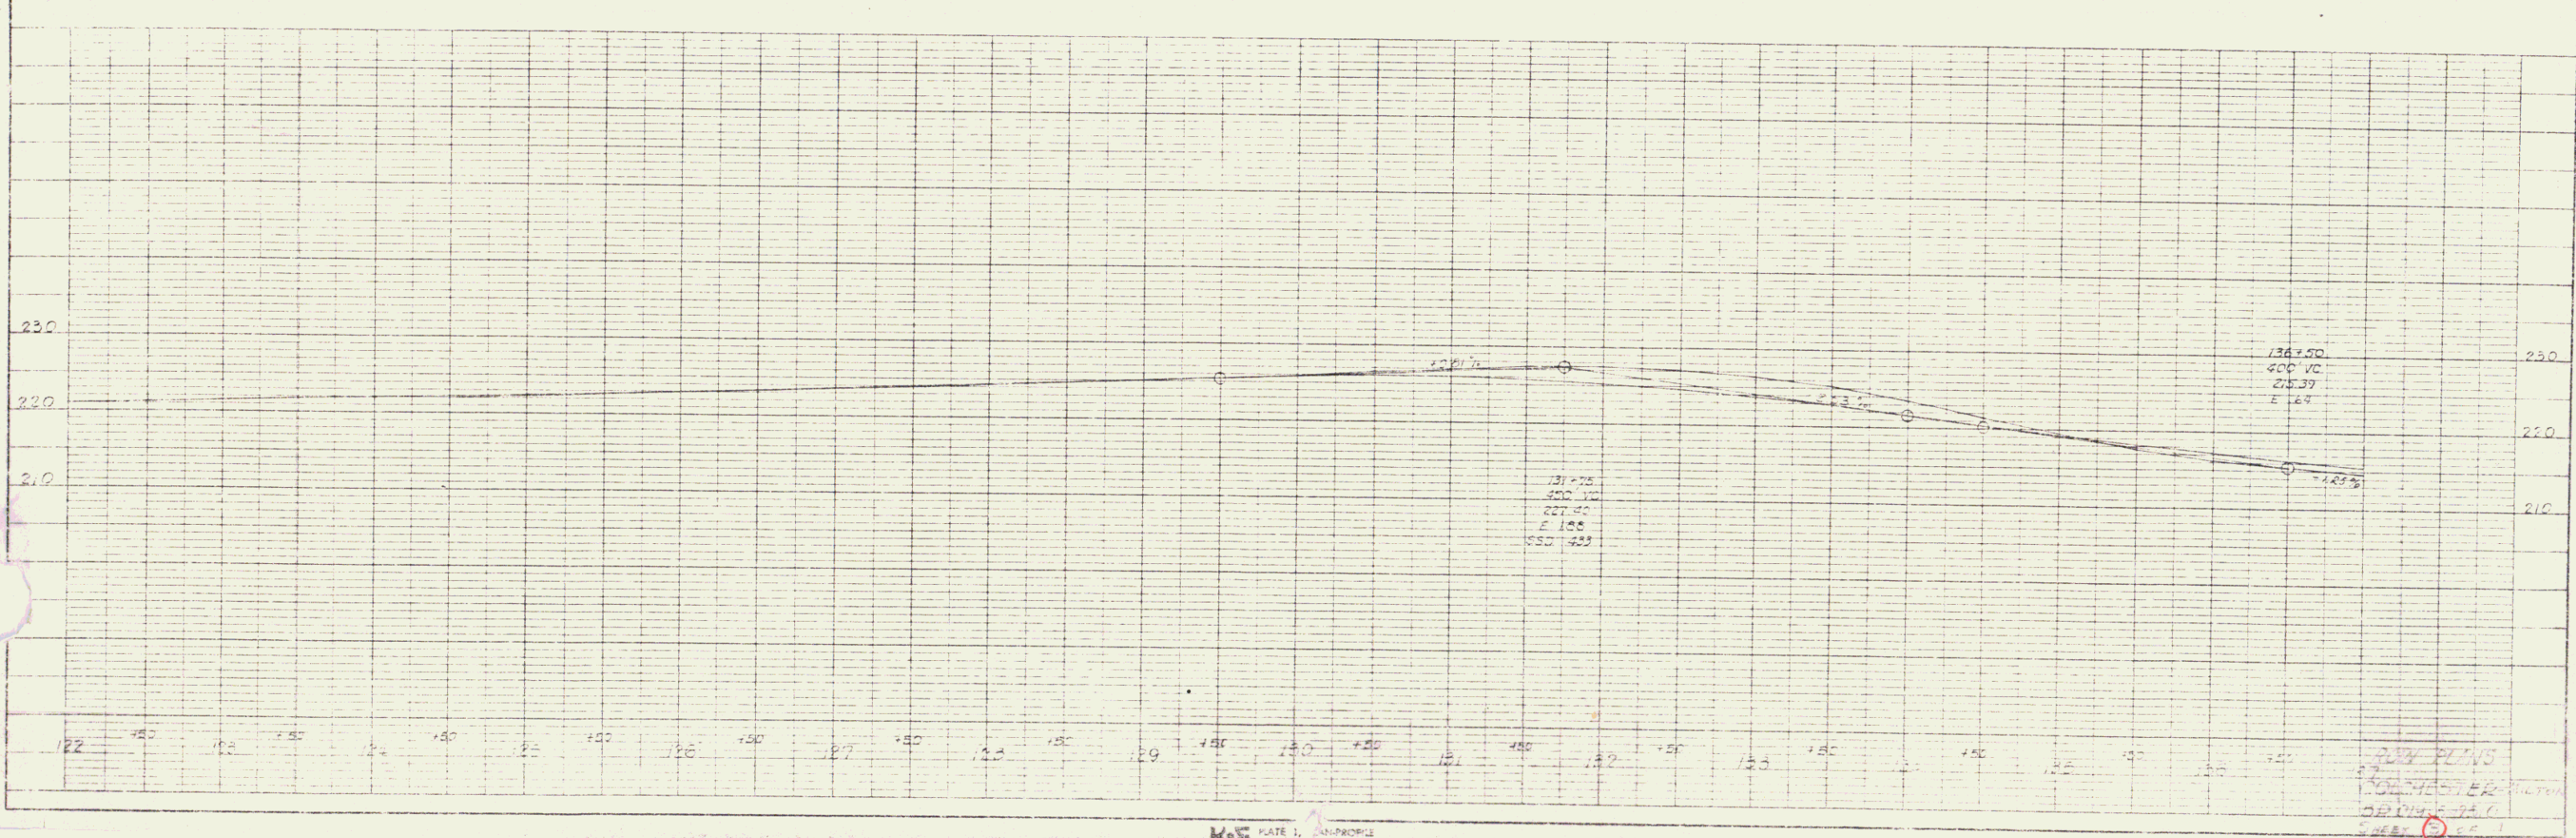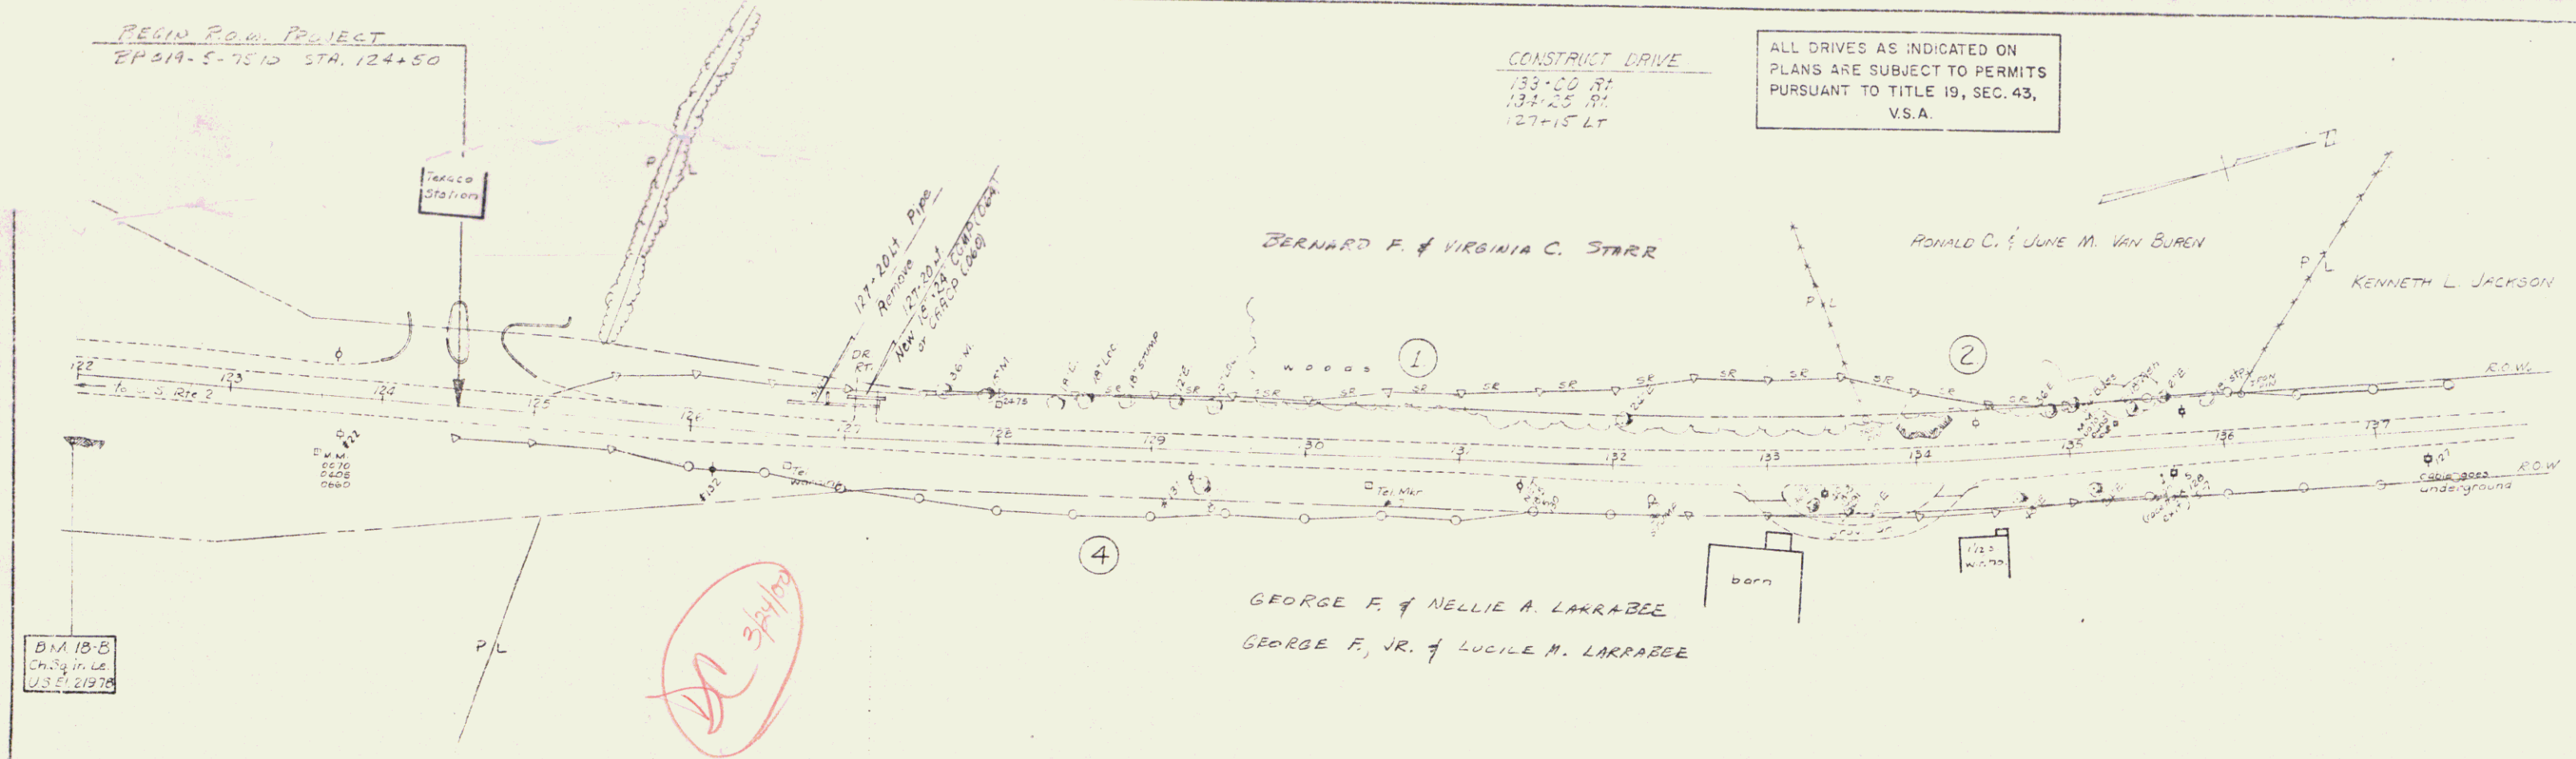

PLAN
DATE 10/1/78
BY J. H. HARRIS
CHECKED BY J. H. HARRIS
IN CHARGE OF THE PROJECT
NO.

DM 13-B
Ch. 3 in. L.S.
U.S. 21978



FILE
DATE 10/1/78
BY J. H. HARRIS
CHECKED BY J. H. HARRIS
IN CHARGE OF THE PROJECT
NO.

K&E DATE 10/1/78

214 PLANS
100 HESTER
DEPT. OF TRANSPORTATION
SHEET 1 OF 1

PLAN
 NOTE BOOK
 NO.

PROFILE
 NOTE BOOK
 NO.

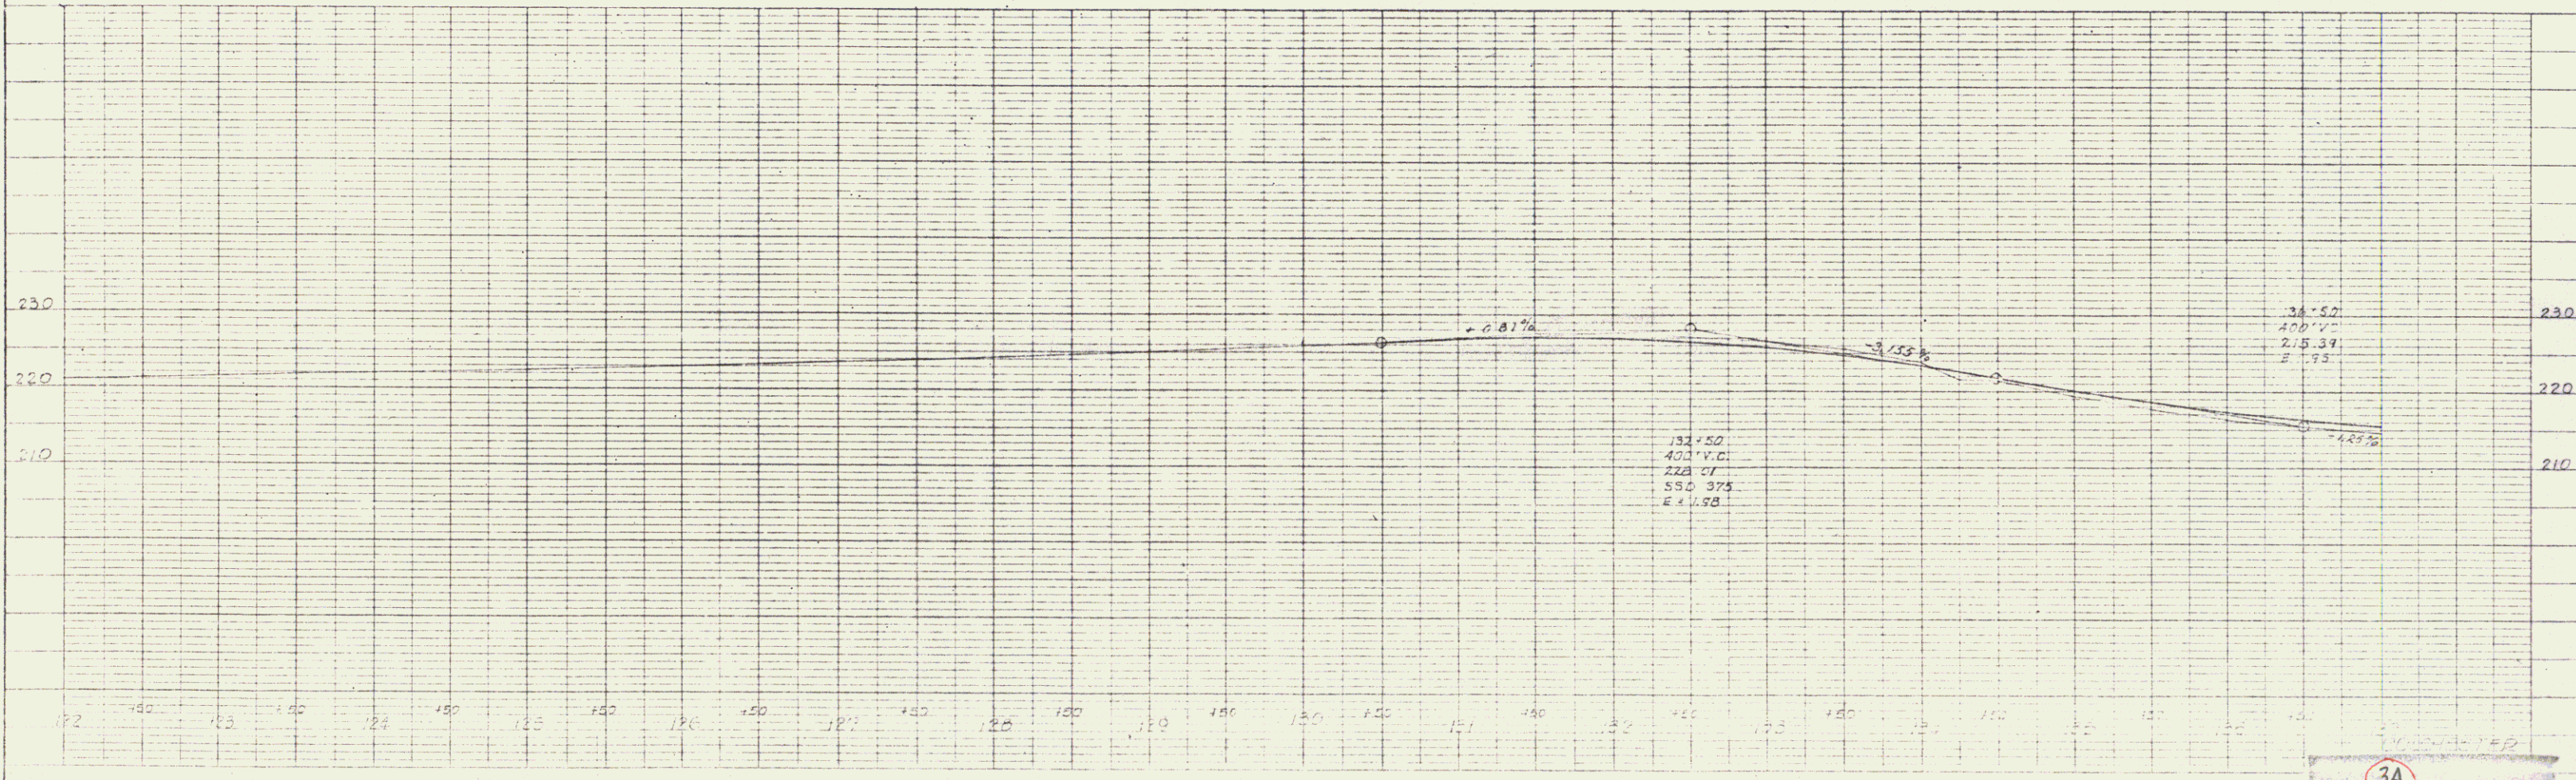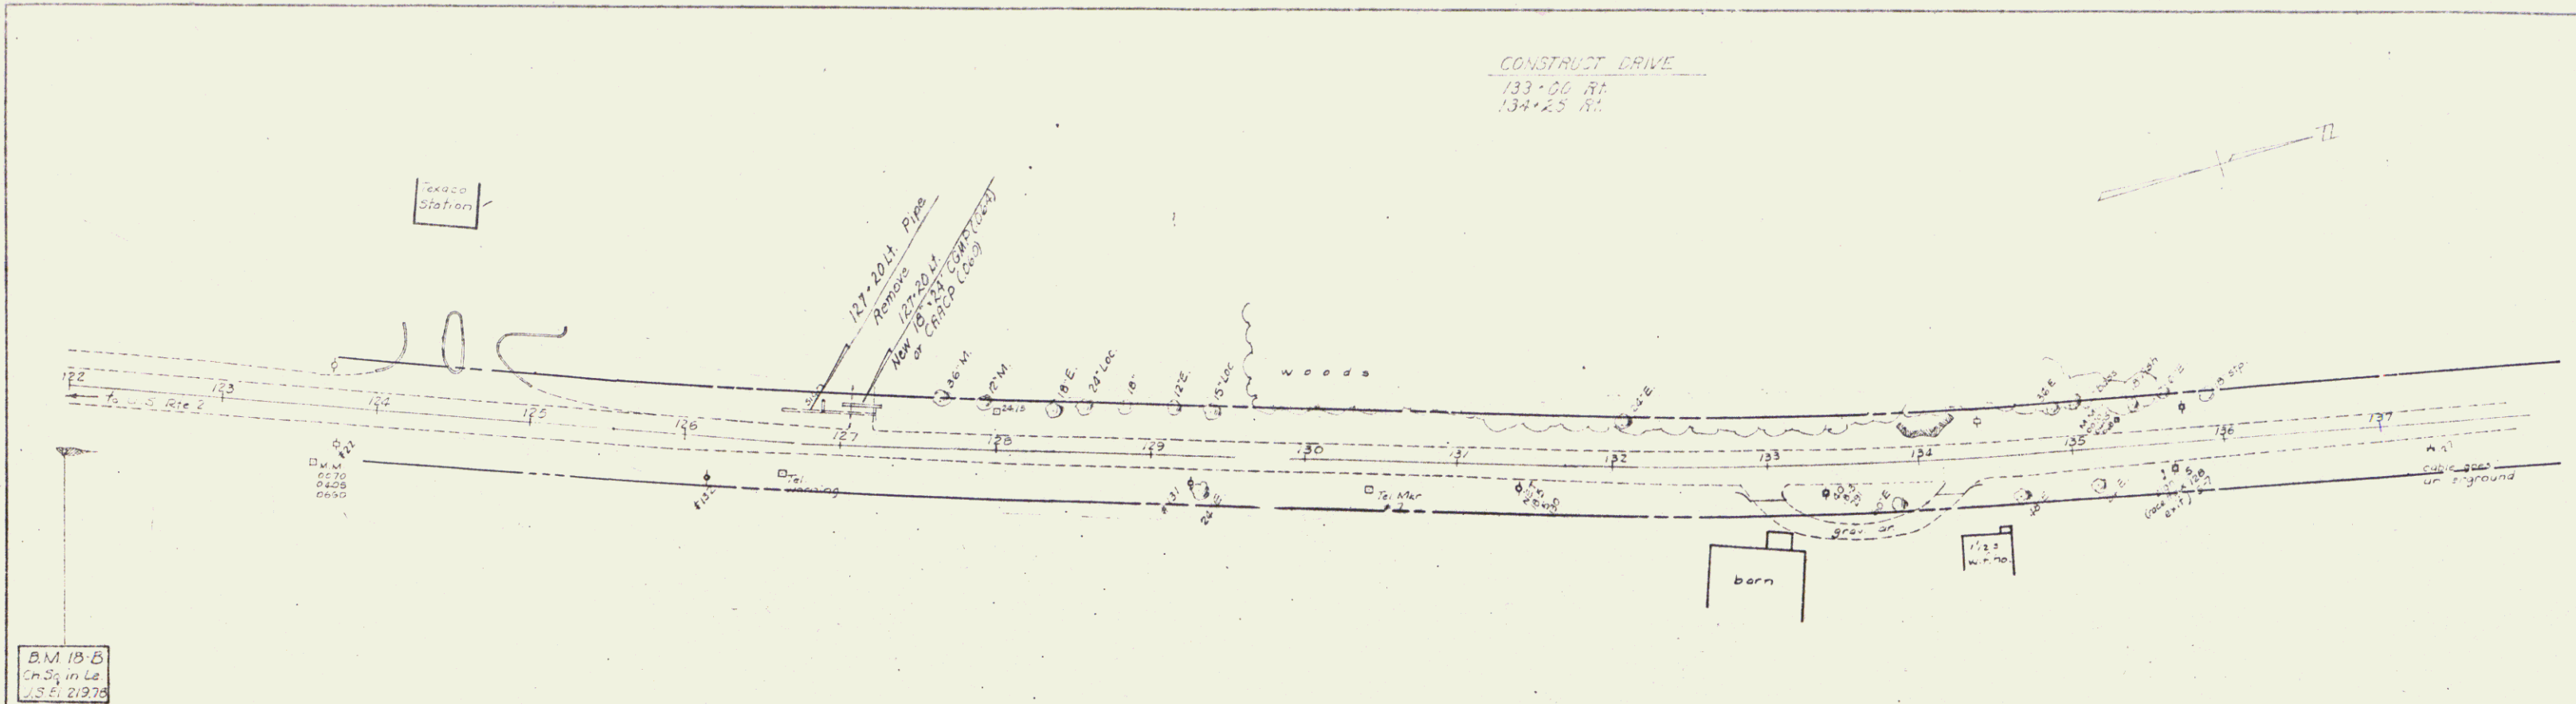


NOTE 1. PLANS & PROFILE
 DRAWN BY: [Signature]


3A

4


PLAN
 SURVEYED BY
 NOTE BOOK
 DATE
 BY
 OF WAY CHANGED
 NO.

PROFILE
 SURVEYED BY
 NOTE BOOK
 DATE
 BY
 OF WAY CHANGED
 NO.

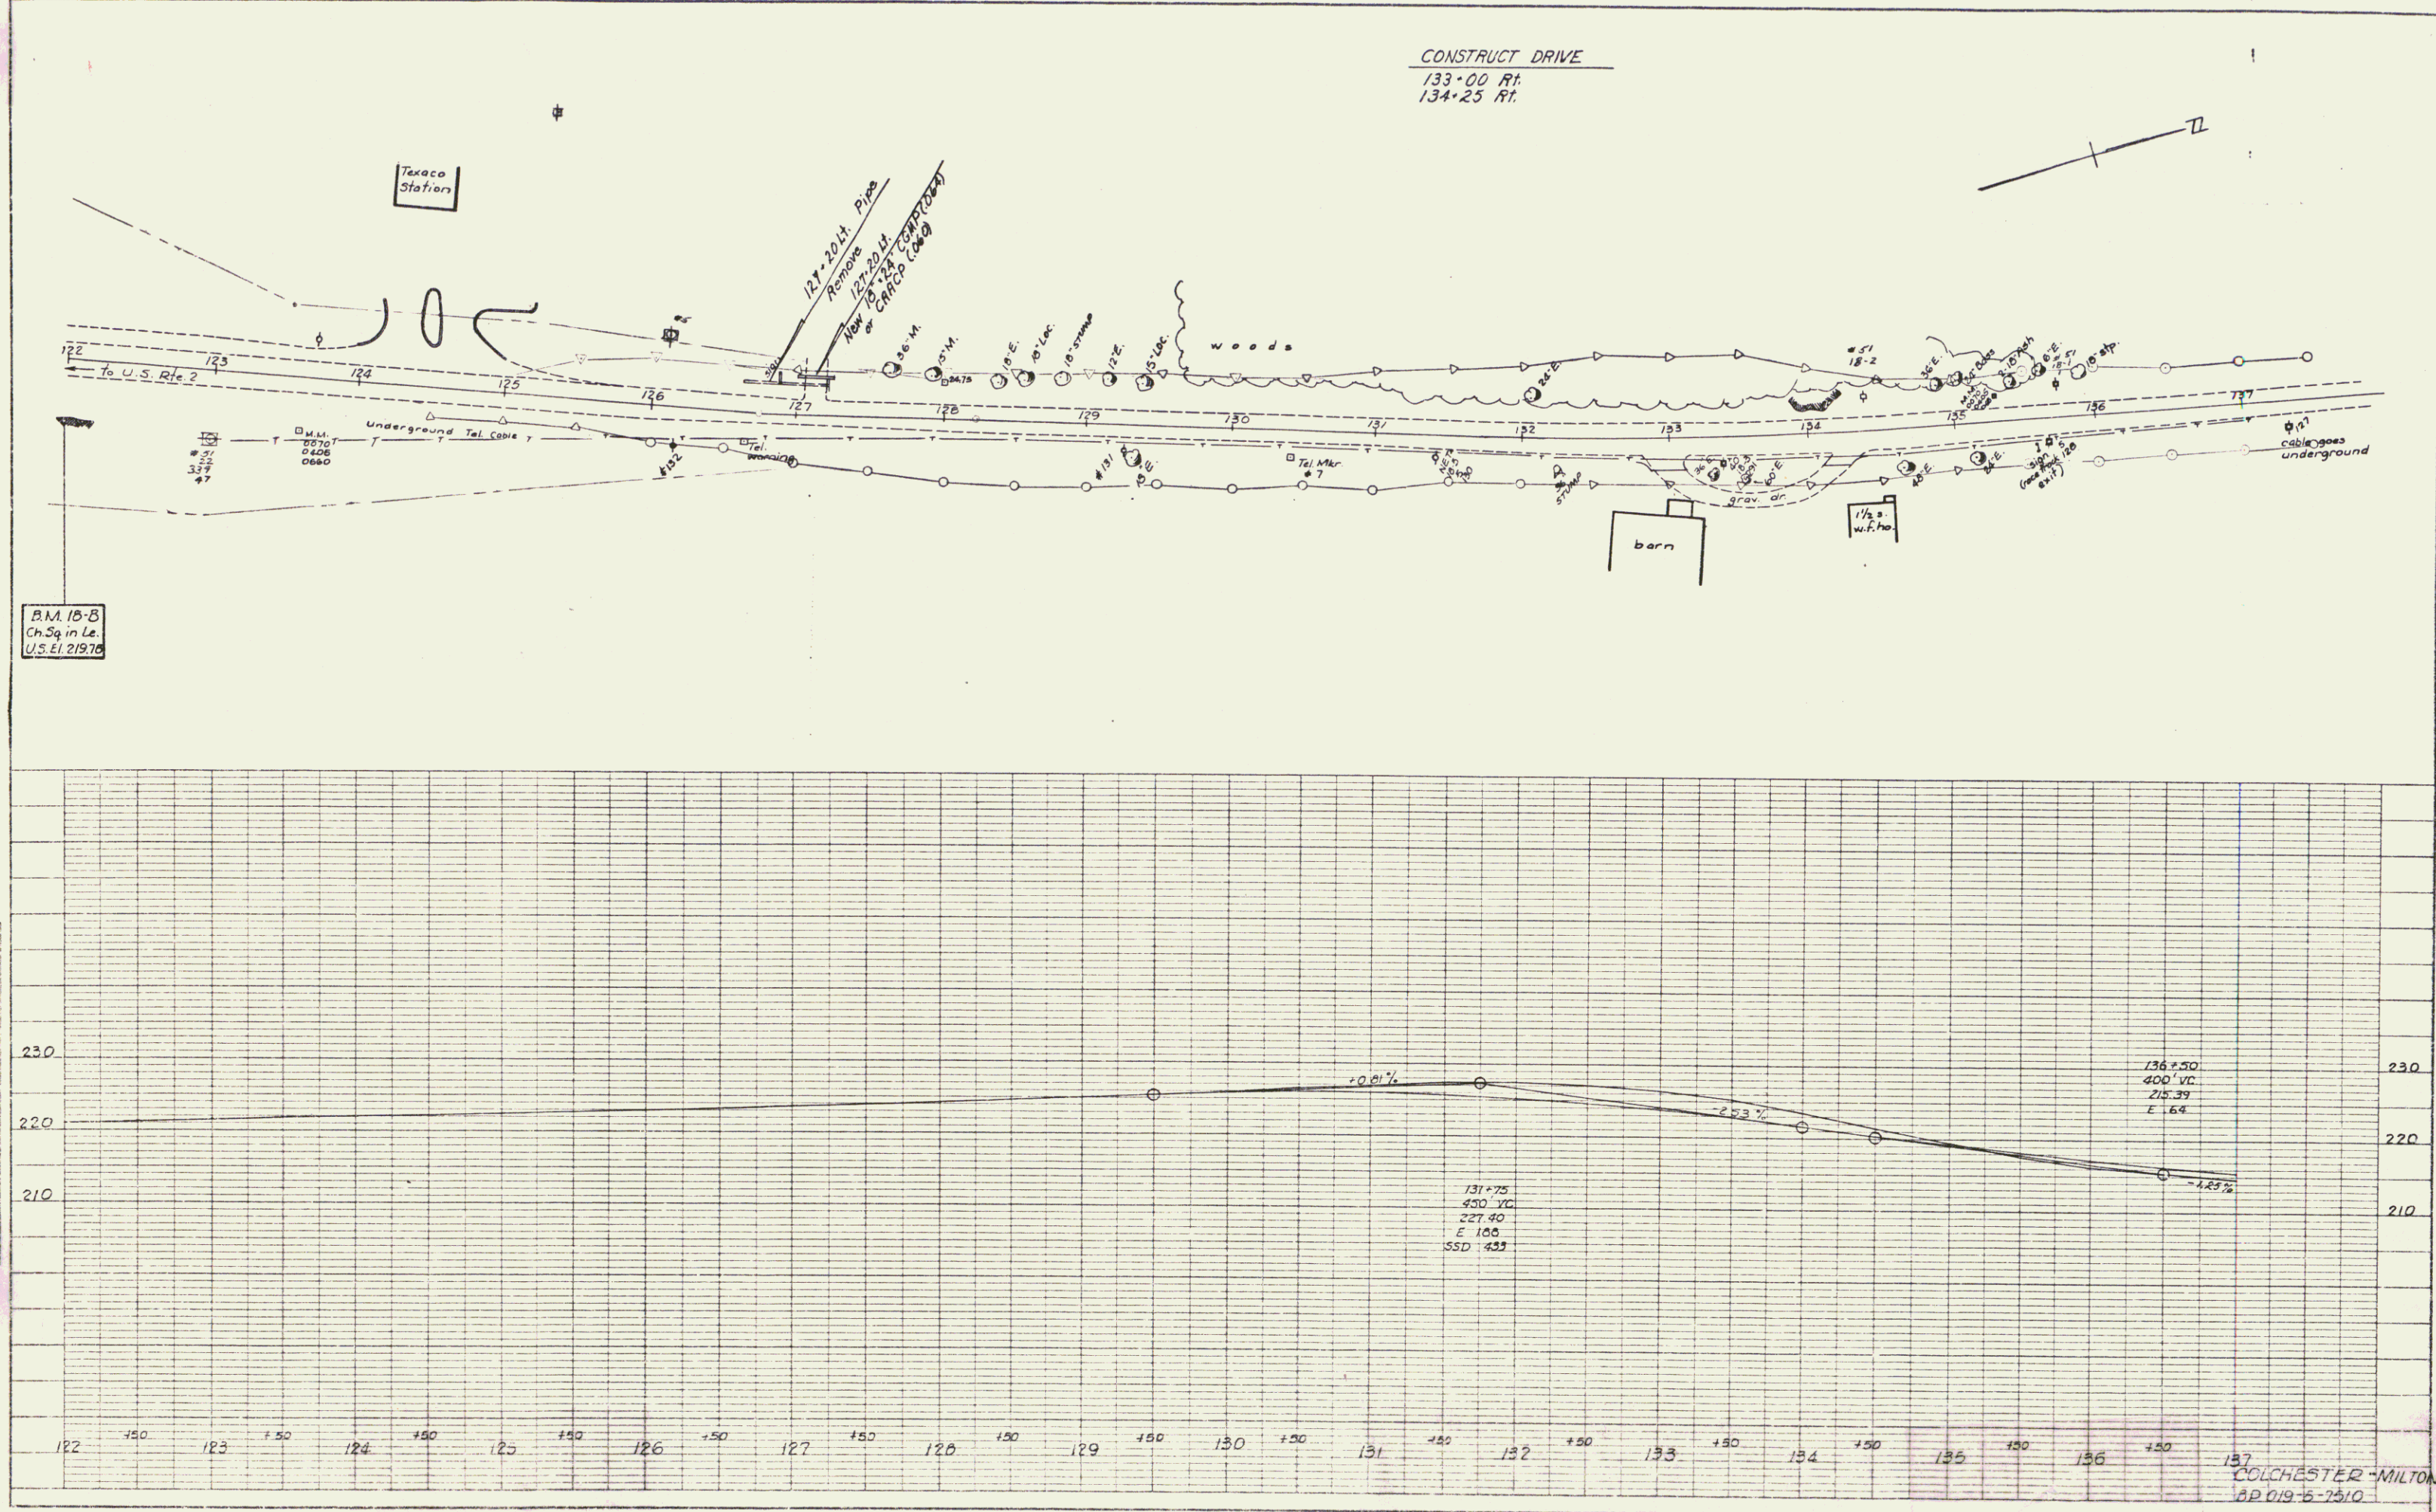


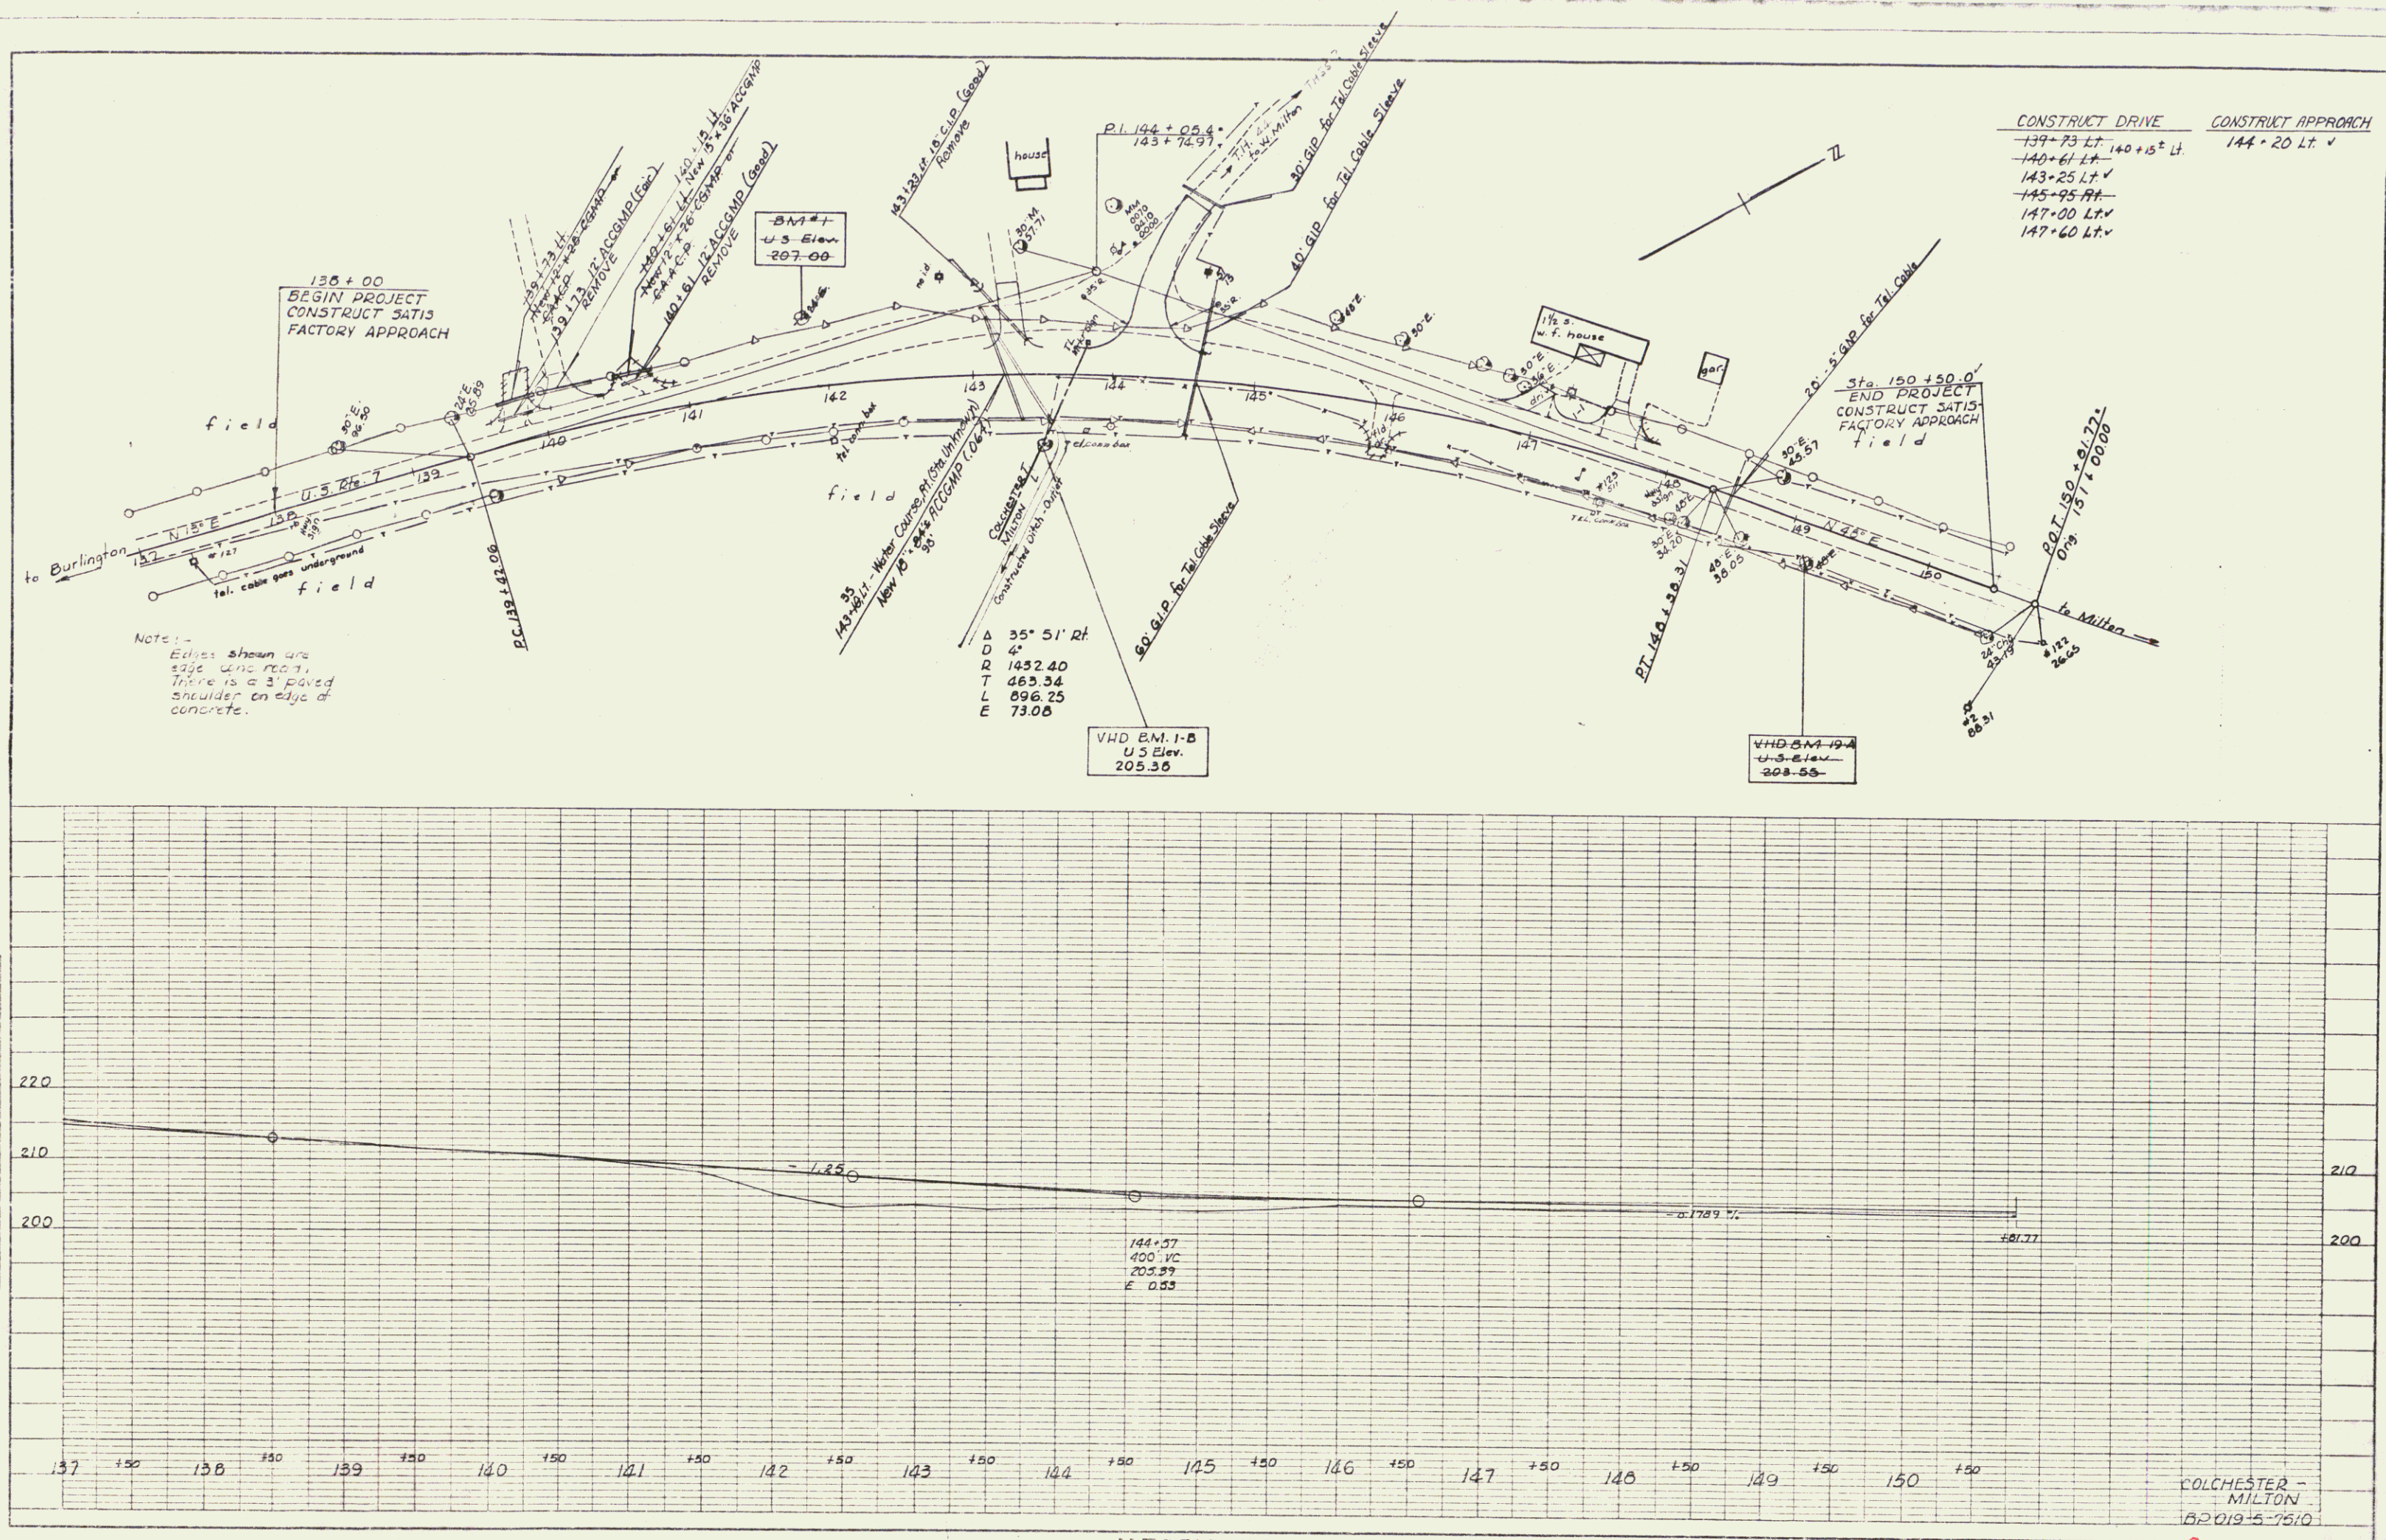

PLAN	PROJECT	
	DATE	
	BY	
	NO.	

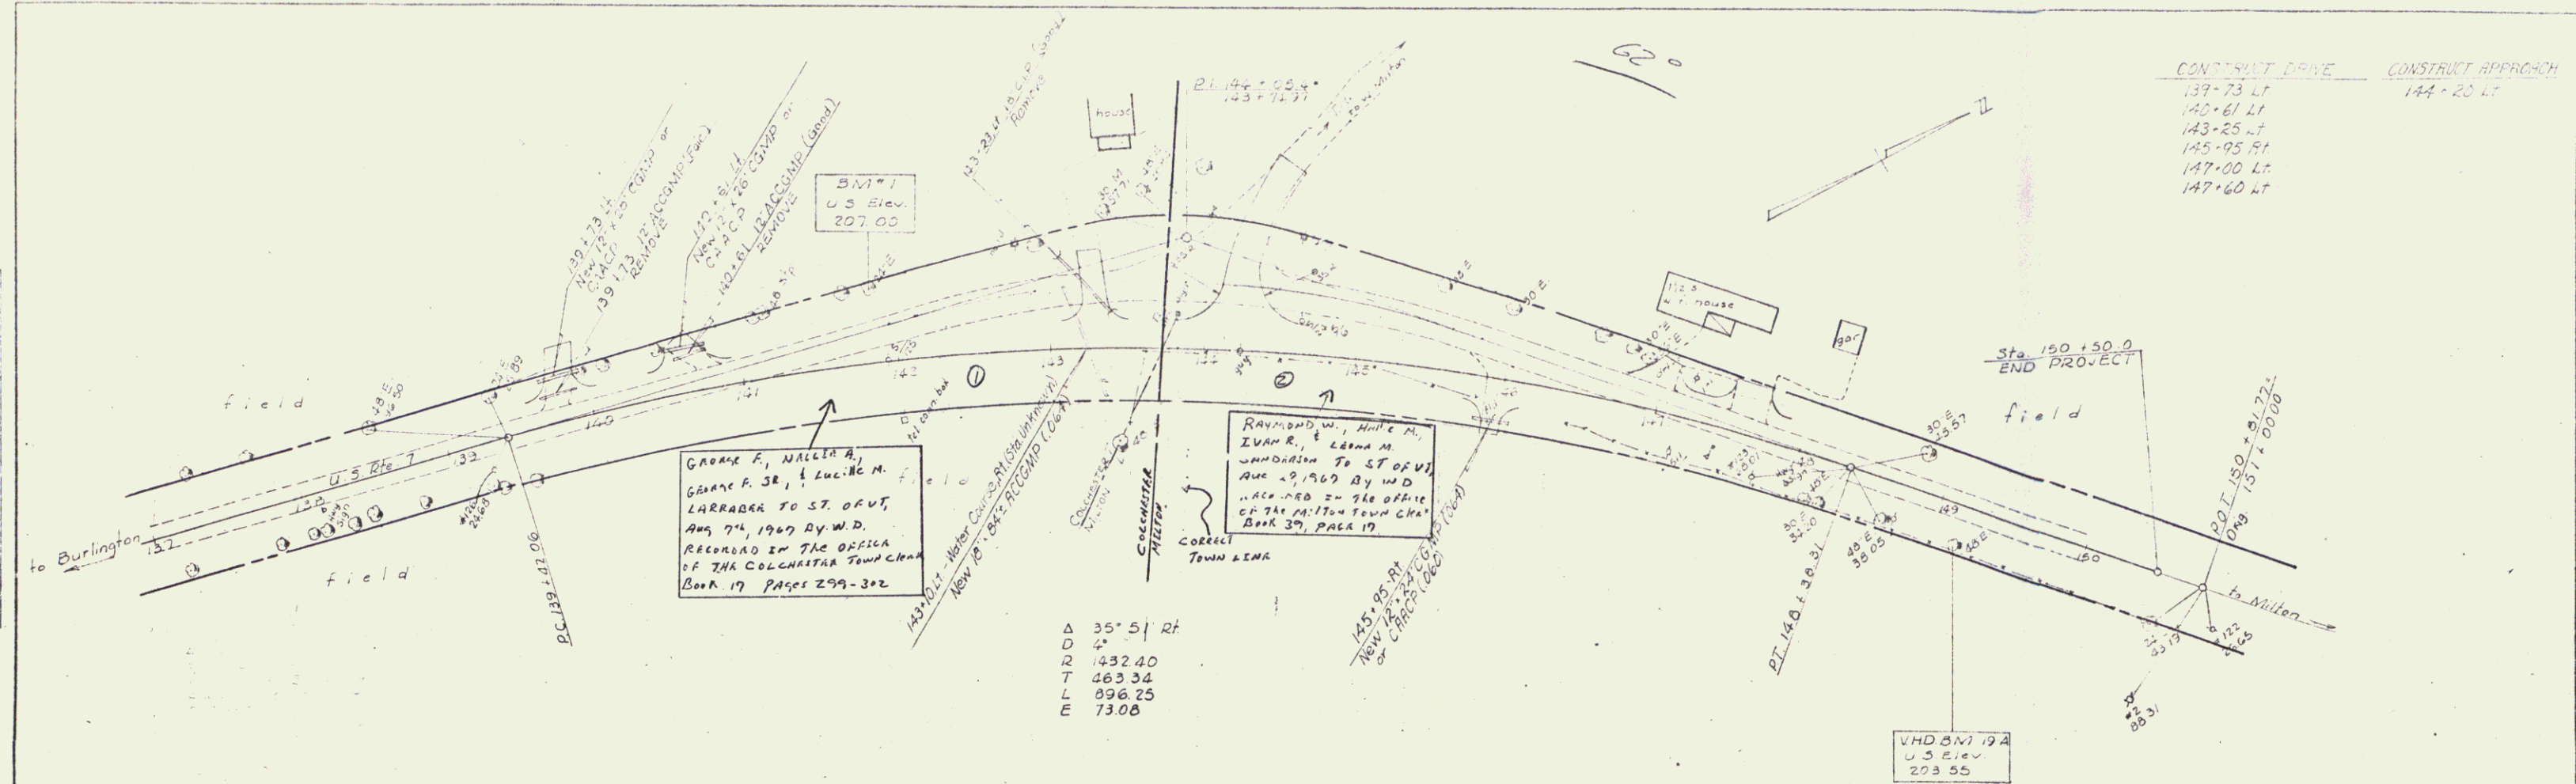

PROFILE	PROJECT	
	DATE	
	BY	
	NO.	

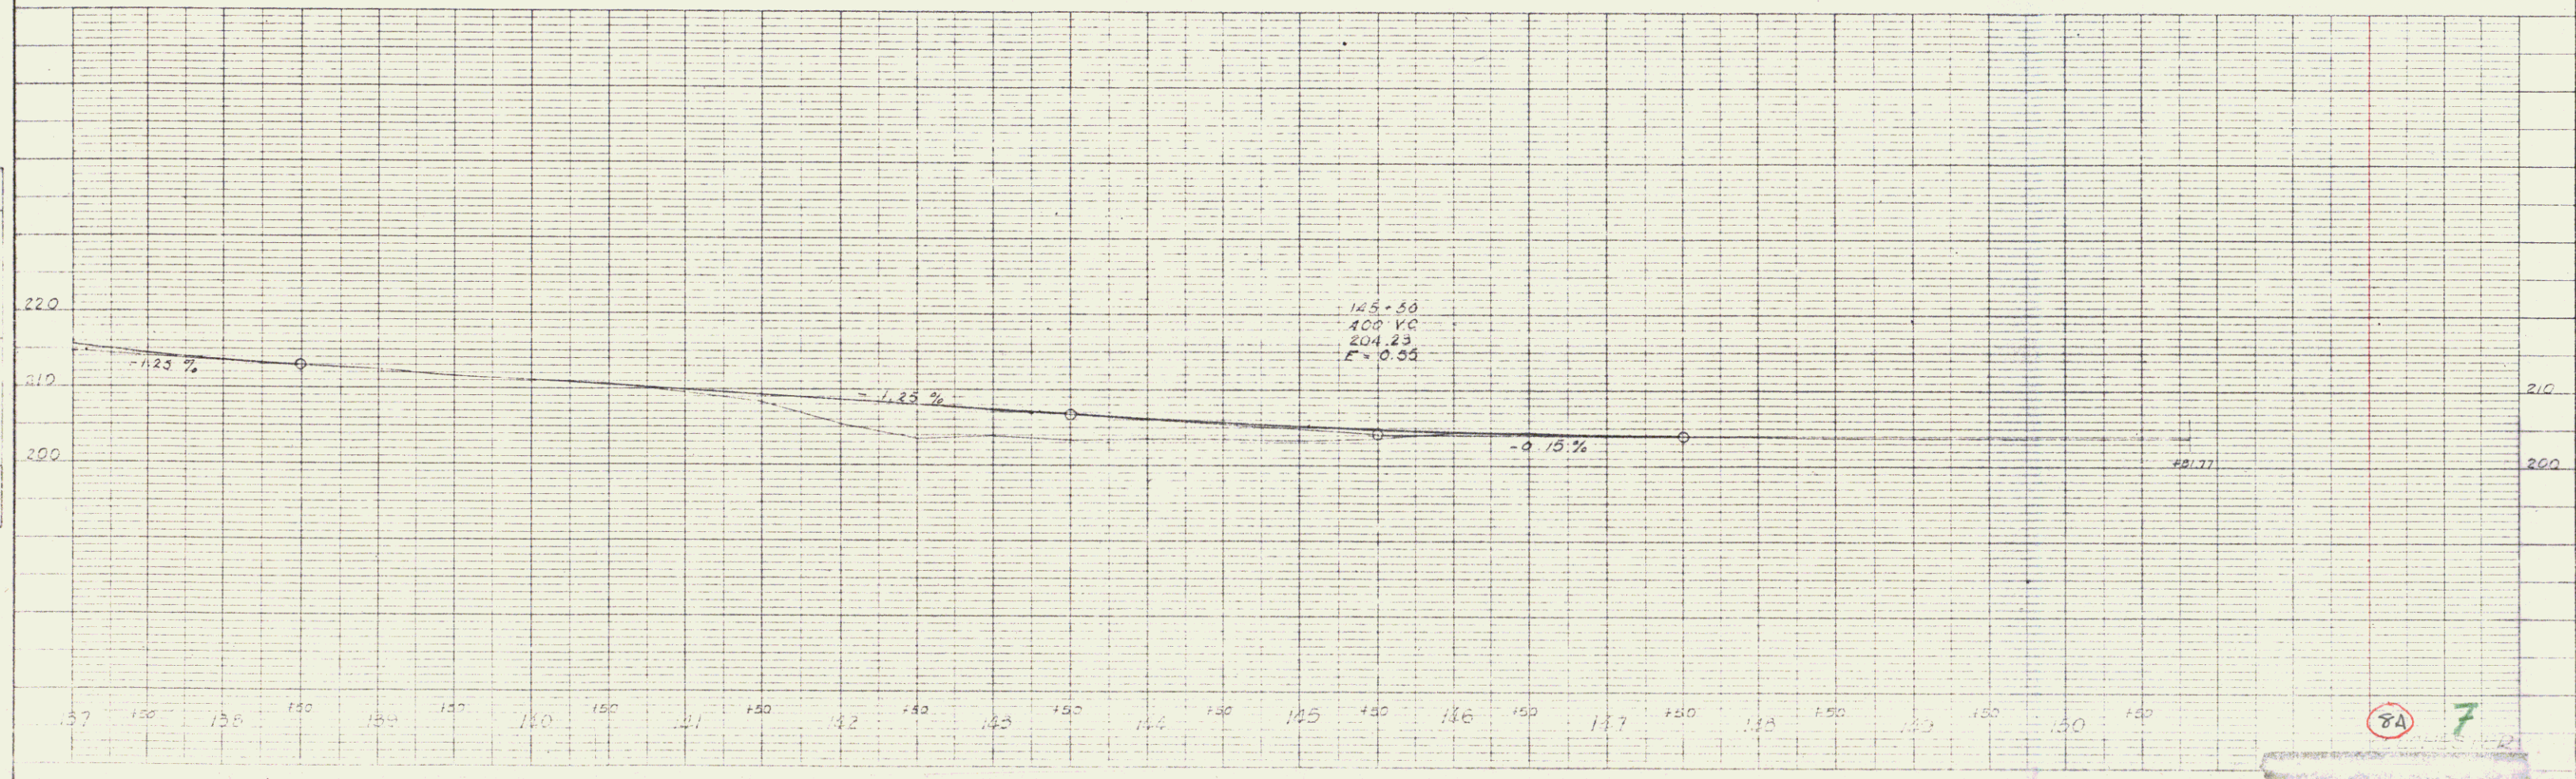

K-E PLATE 1, PLAN-PROFILE
SHEET 1 & 2 OF 100

8A 7

