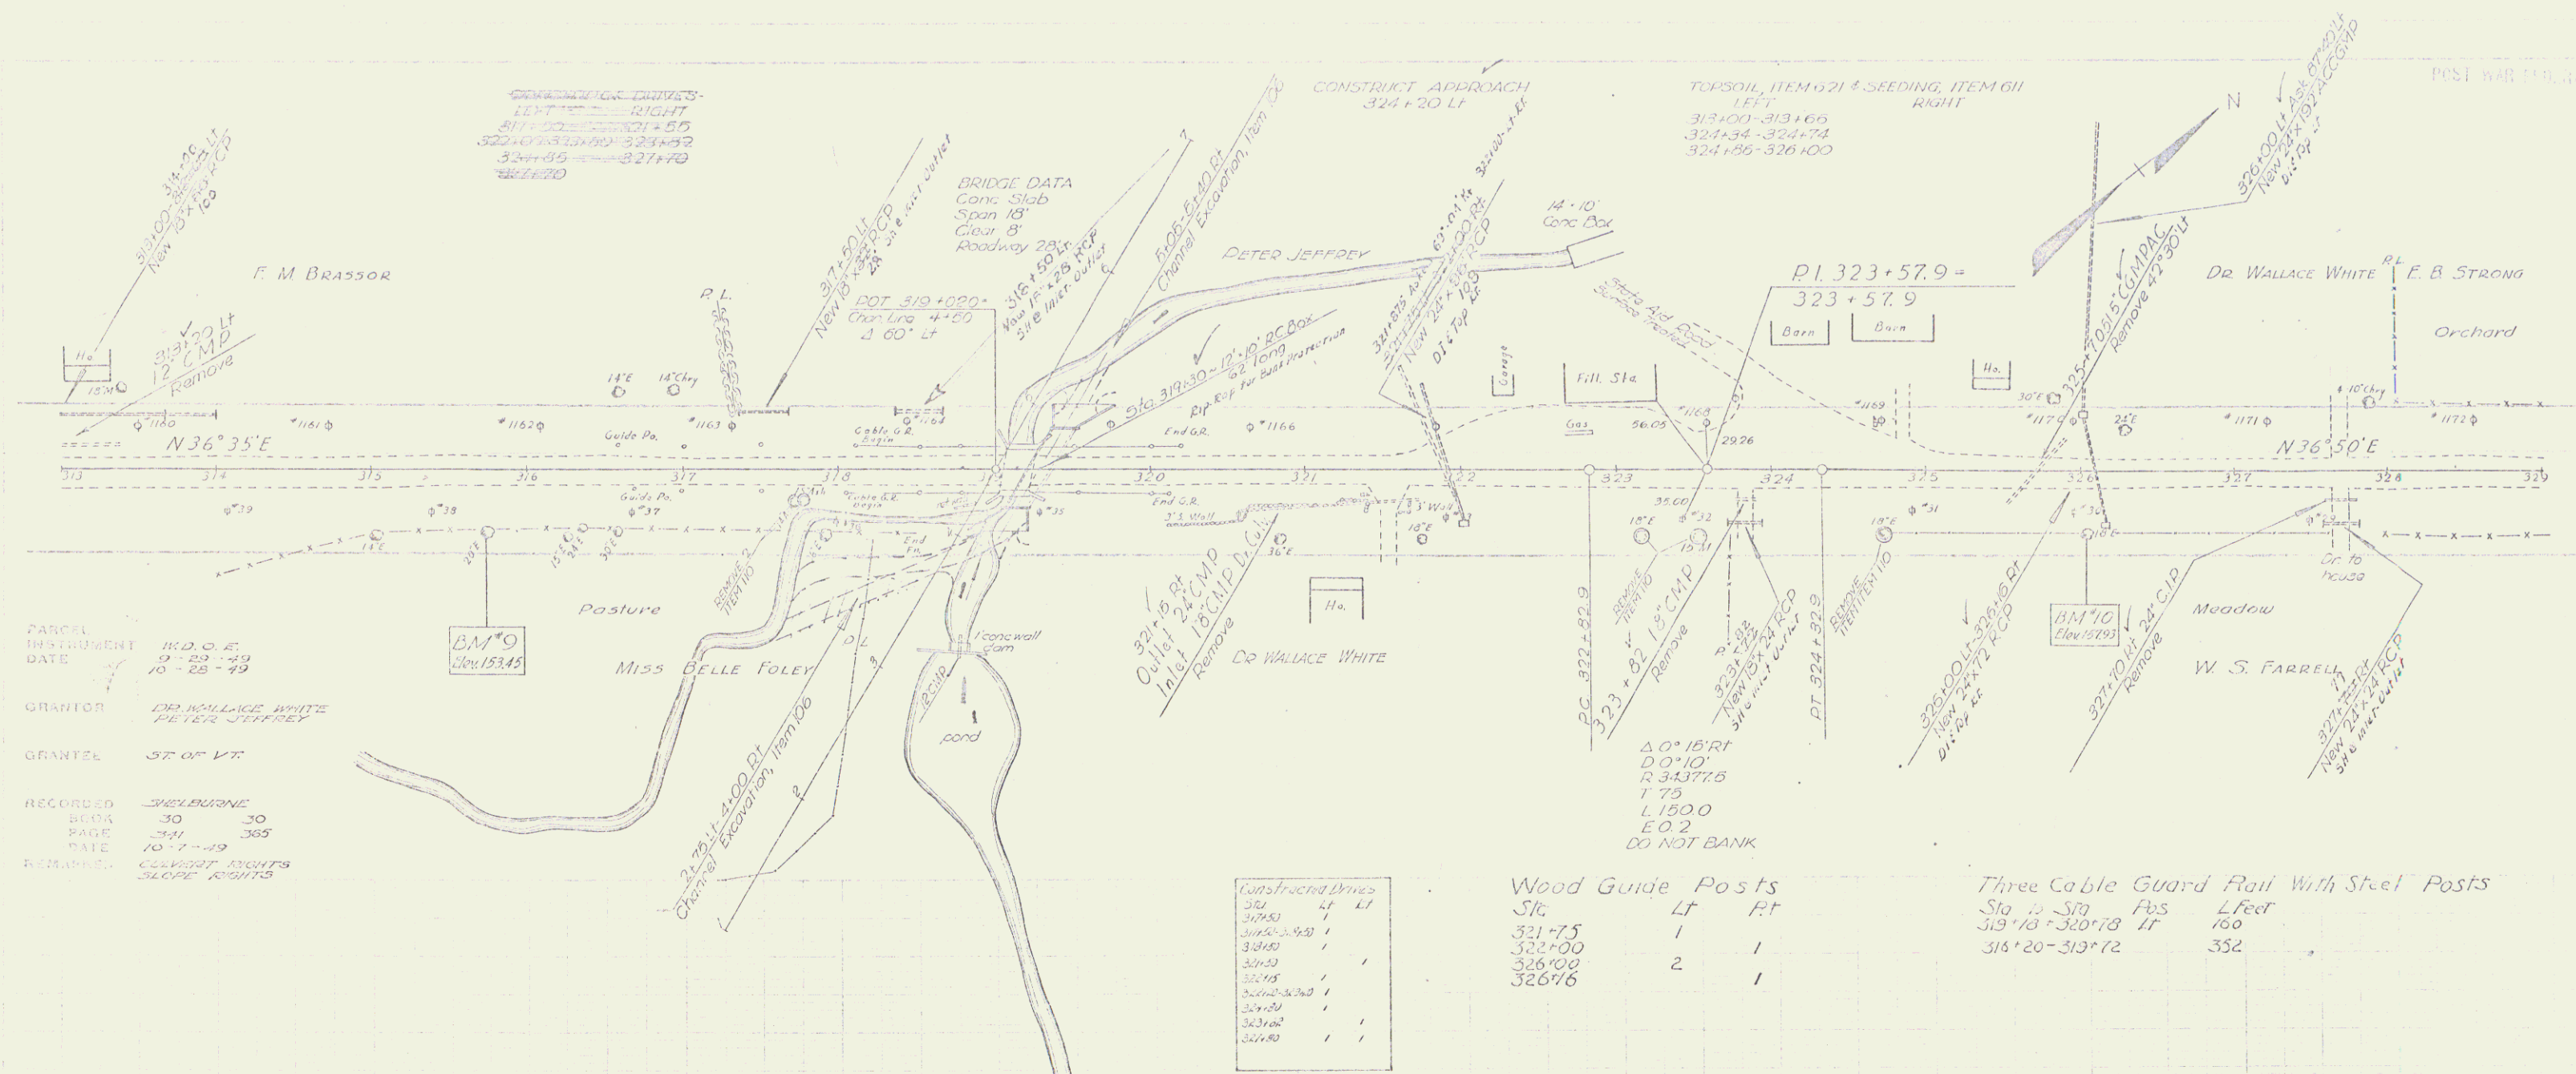


B.M. #9 Spike in root of 20' Elm 38 ft. rt. of sta. 315+75 - Elev. 153.45
 B.M. #10 Spike in root of 18' Elm 38 ft. rt. of sta. 326+05 - Elev. 157.93

Constructed Drives

Sta.	LT	RT
317+53	1	1
317+53.43	1	1
318+00	1	1
318+30	1	1
318+78	1	1
318+82.32	1	1
319+20	1	1
323+00	1	1
324+00	1	1

Wood Guide Posts

Sta.	LT	RT
321+75	1	1
322+00	1	1
326+00	2	1
326+76	1	1

Three Cable Guard Rail With Steel Posts

Sta. to Sta.	Pos	LF
319+18 to 320+78	1	160
318+20 to 319+72	1	352

5