
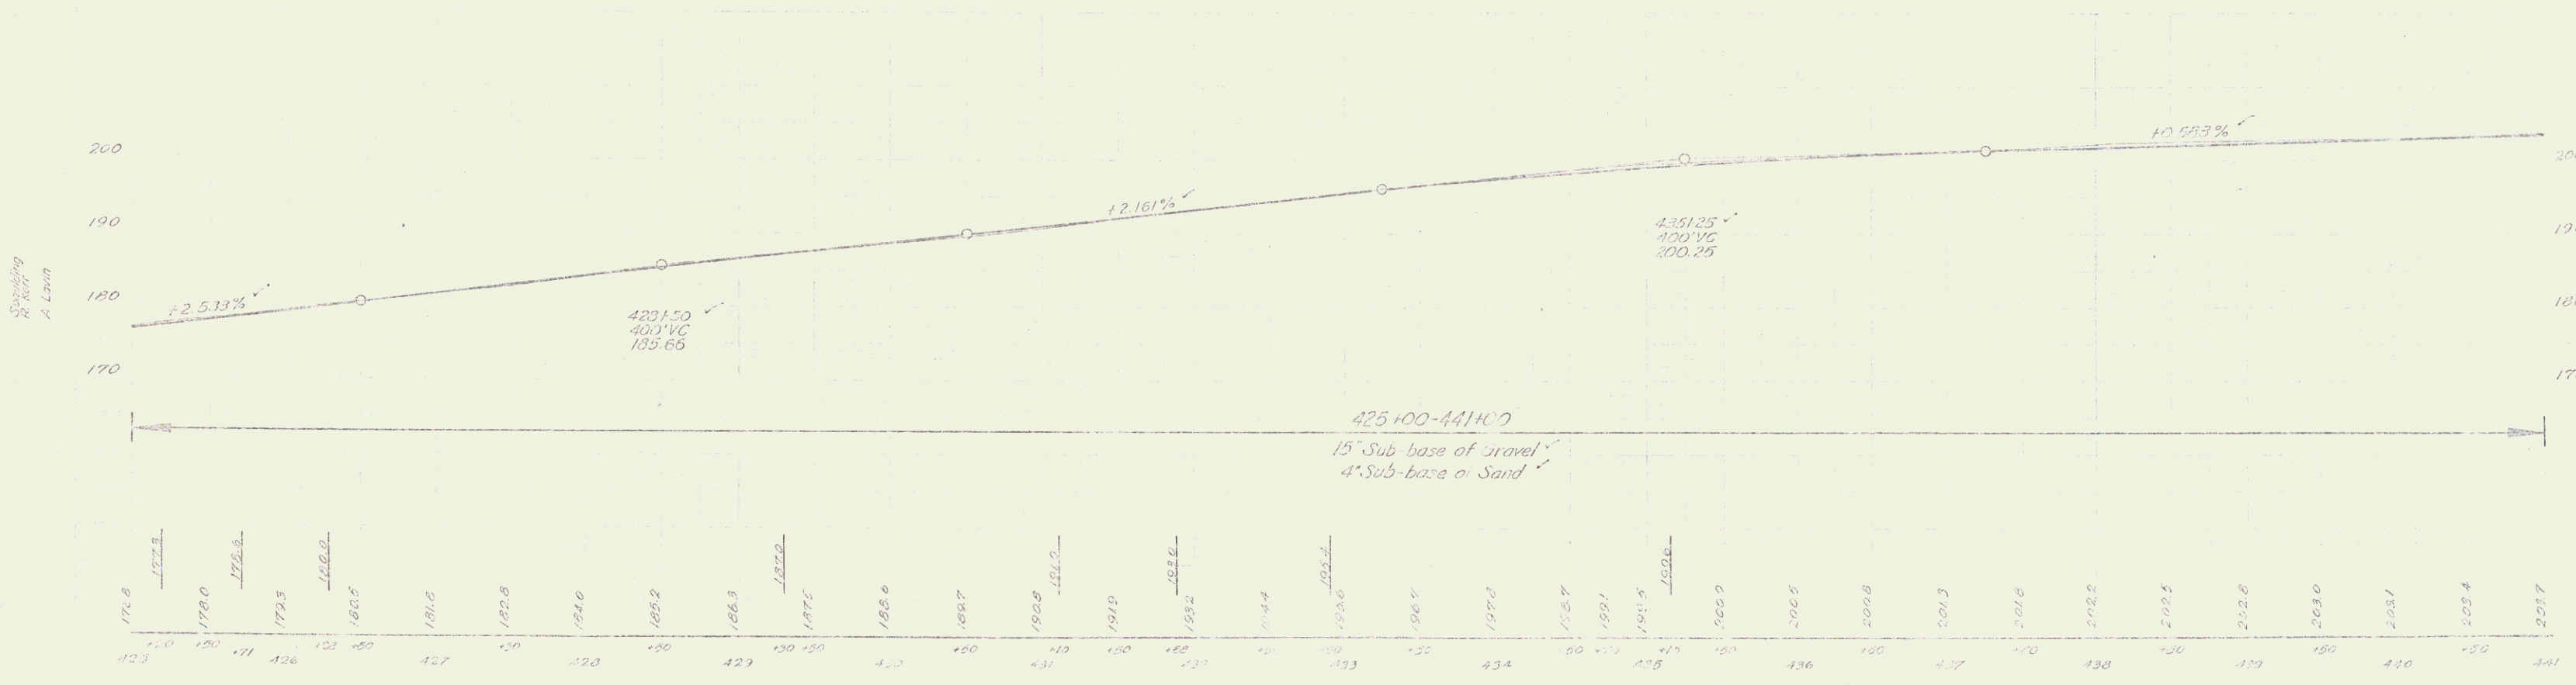


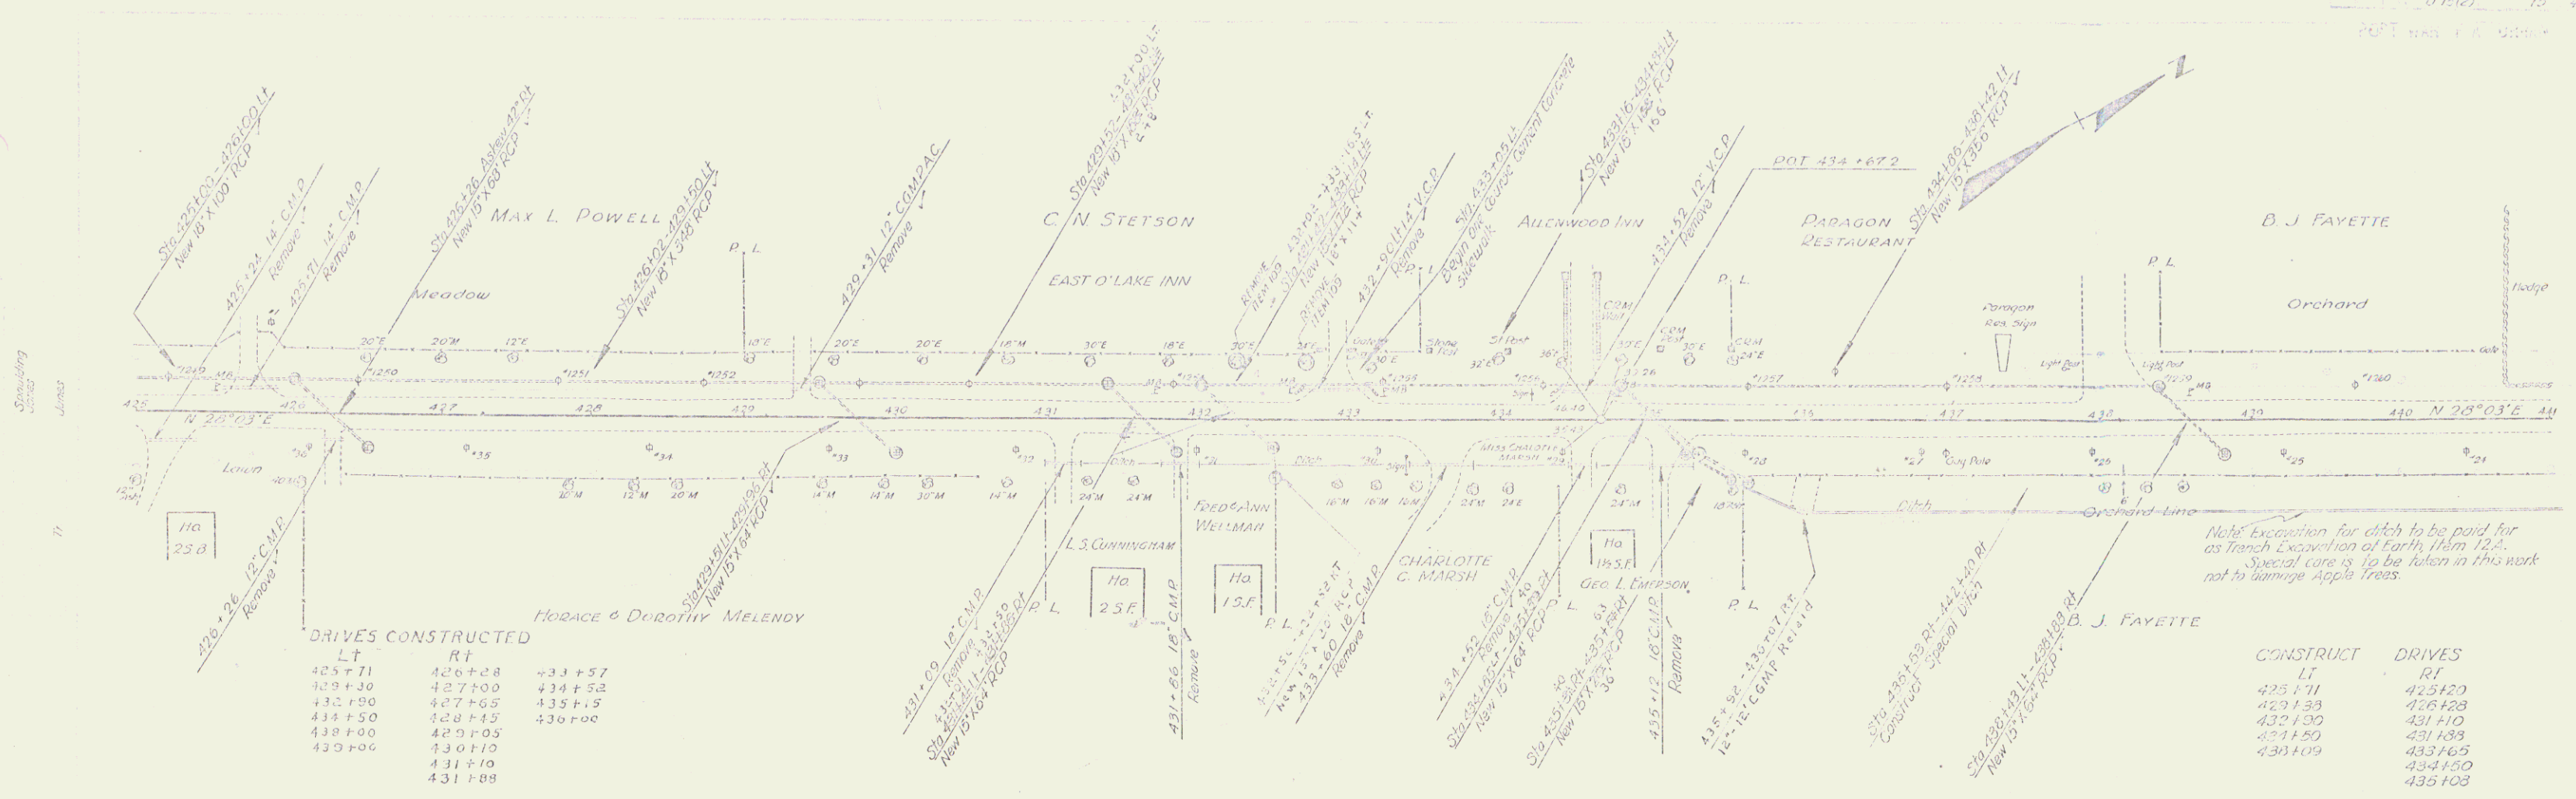

4