
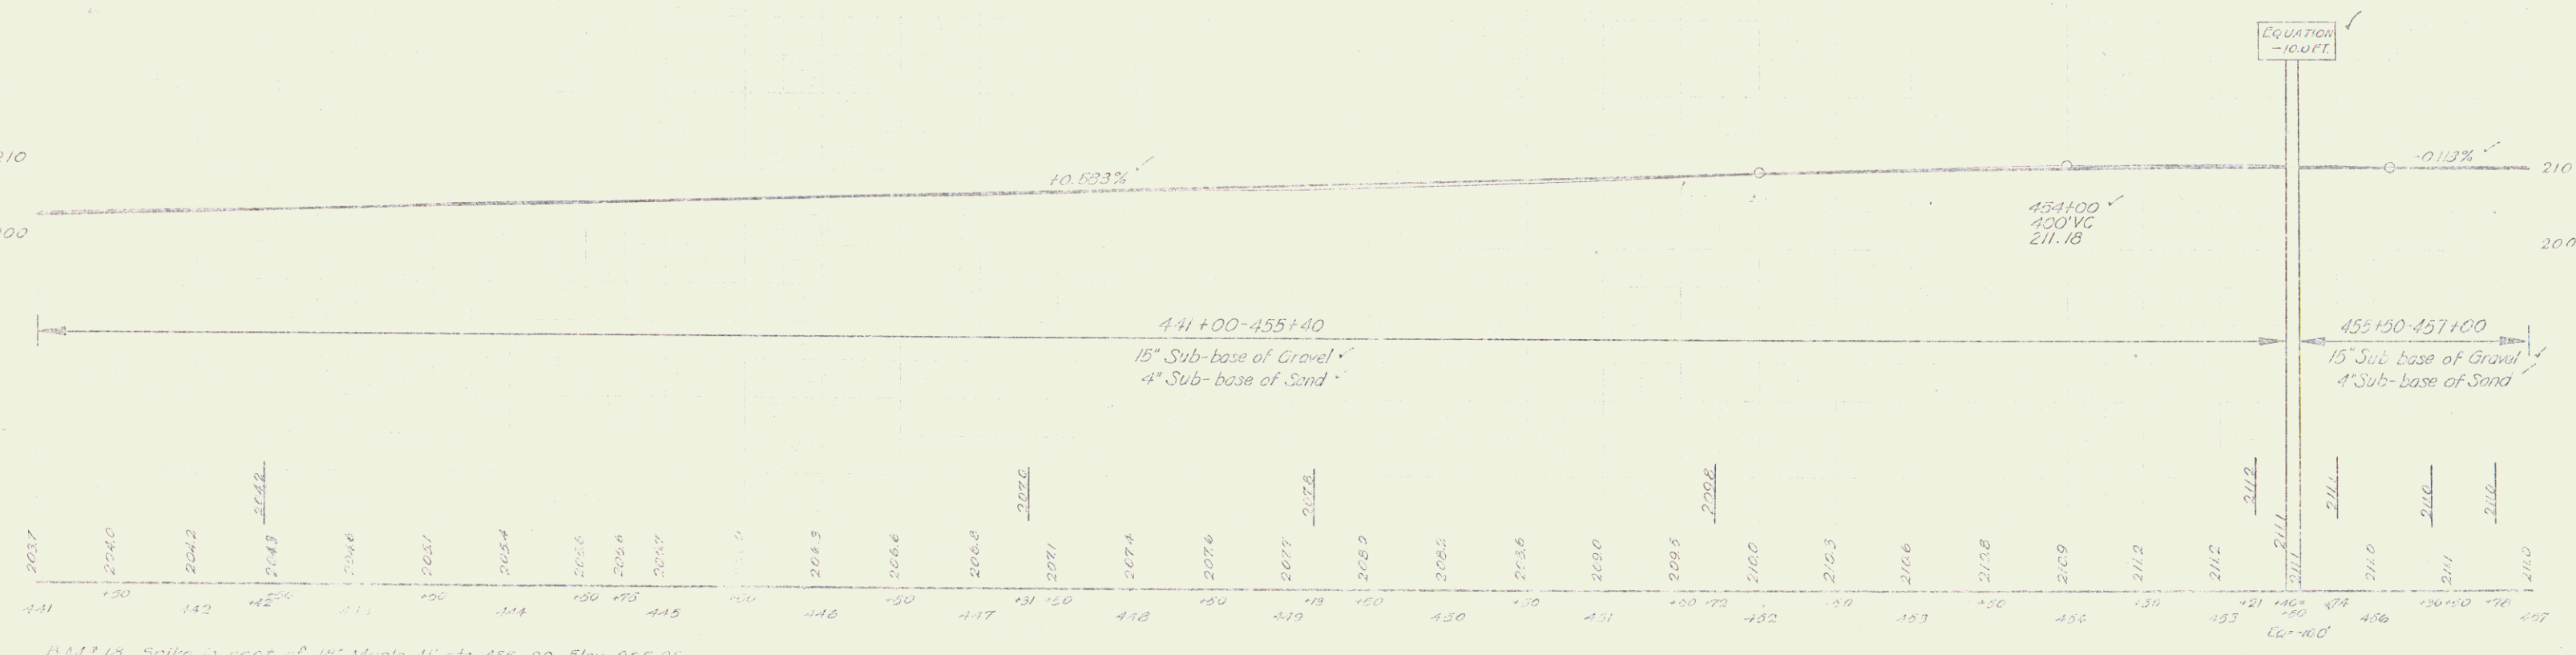


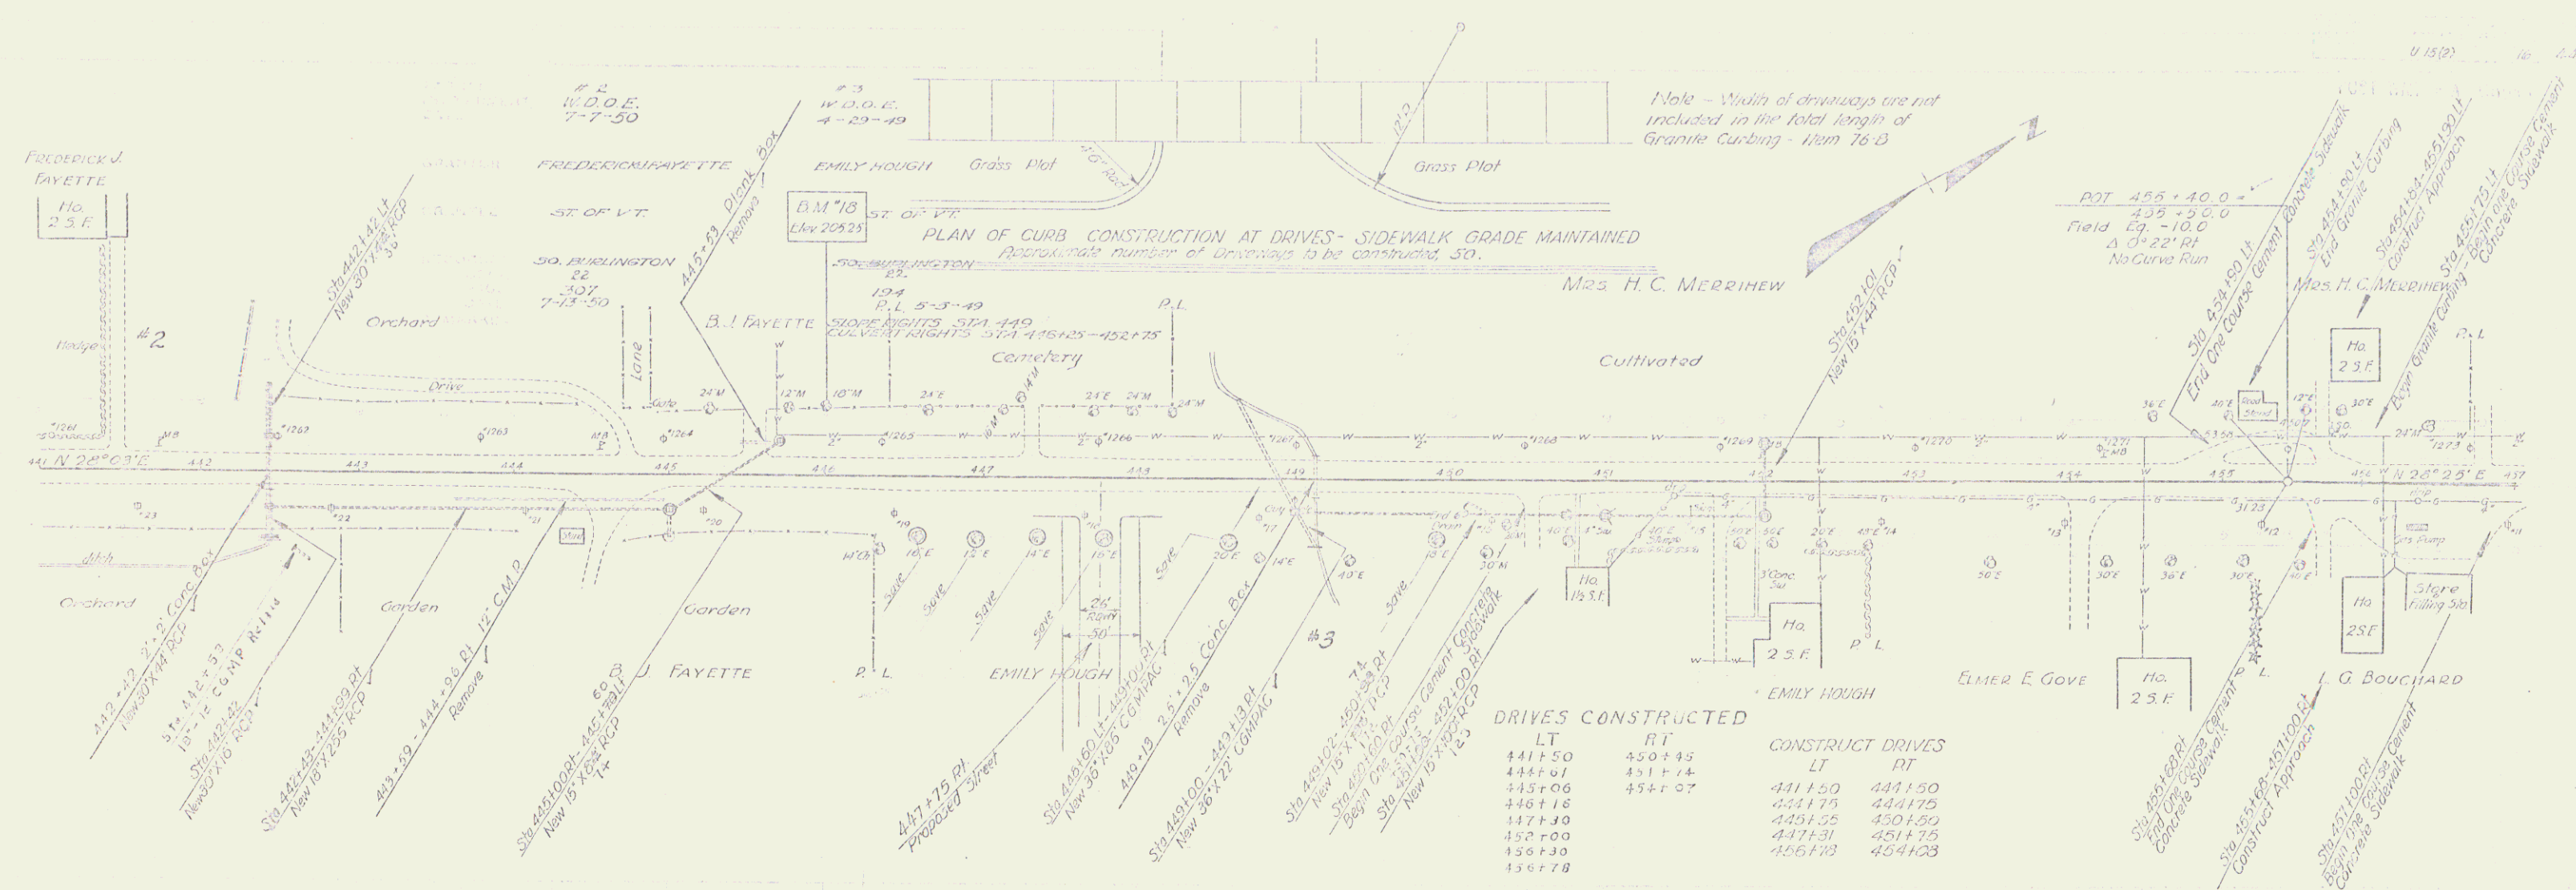

SOUTH BURLINGTON U 15 (21)
 SHEET 16 OF 24