


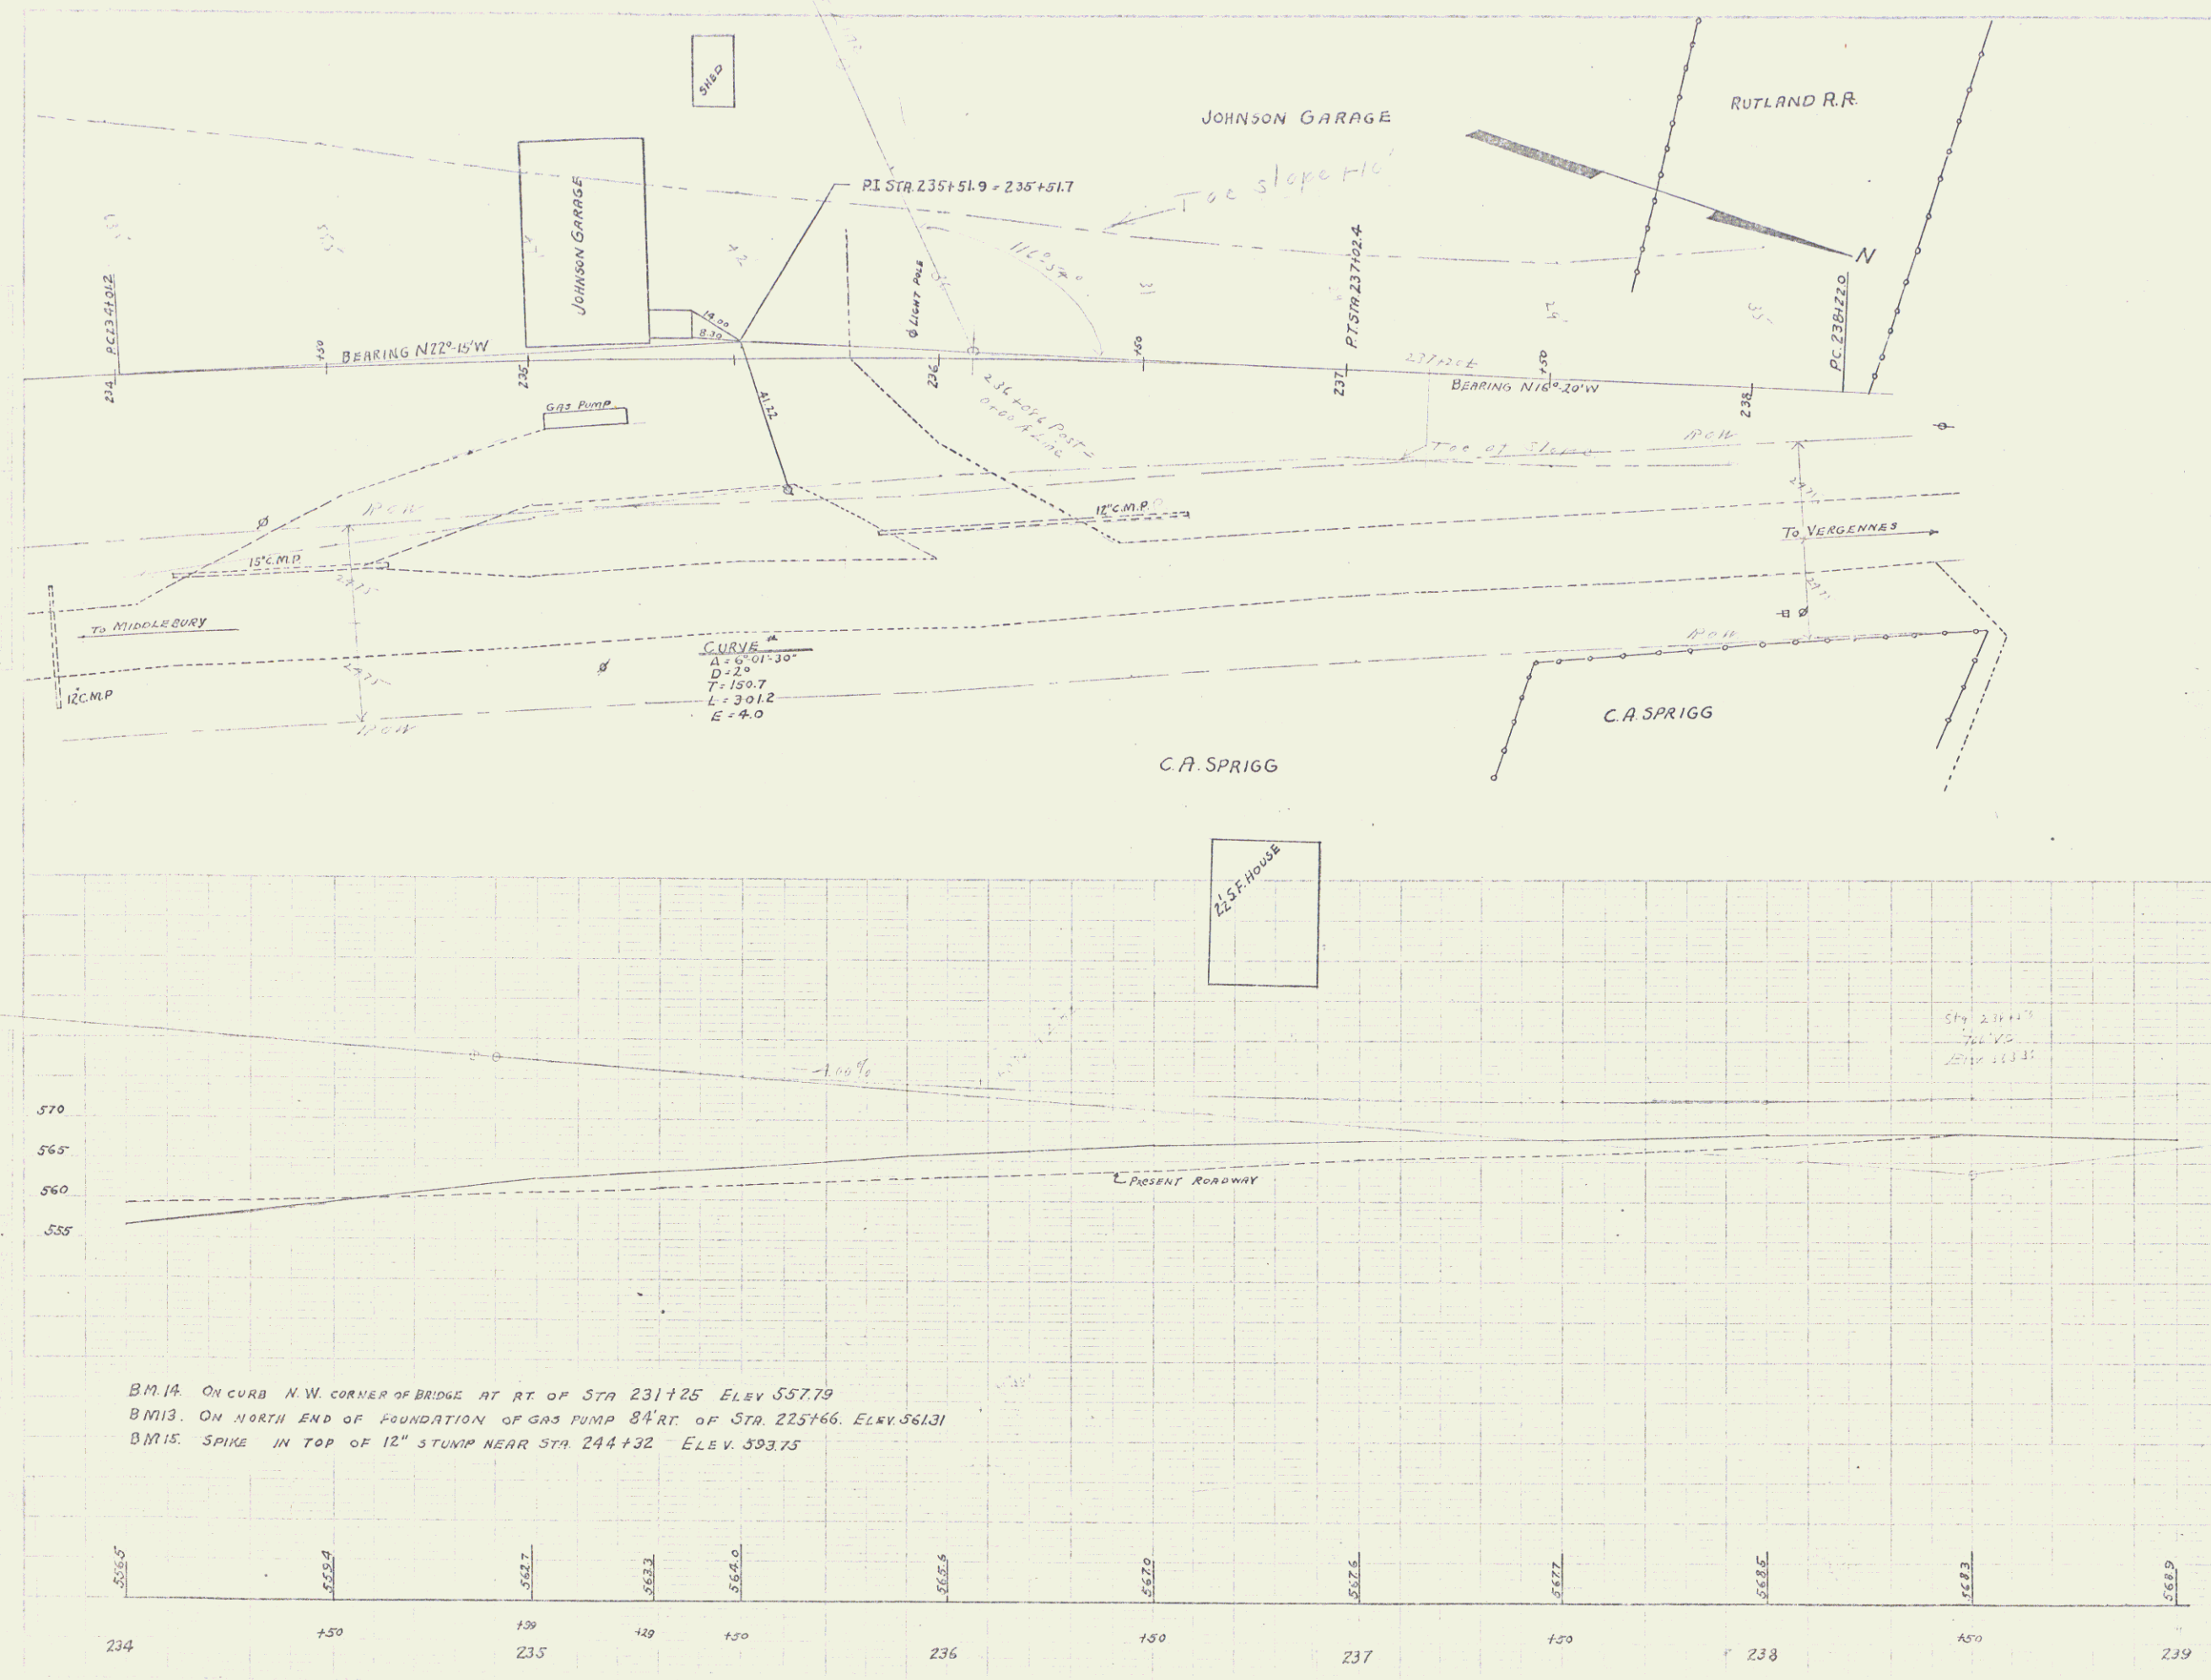

R.H. ARNOLD  
C.E.N.

R.H. ARNOLD  
C.E.N.

BM 14. ON CURB N.W. CORNER OF BRIDGE AT RT. OF STA 231+25 ELEV 557.79  
BM 13. ON NORTH END OF FOUNDATION OF GAS PUMP 84' RT. OF STA. 225+66. ELEV. 561.31  
BM 15. SPIKE IN TOP OF 12" STUMP NEAR STA. 244+32 ELEV. 553.75

11A