

INDEX OF SHEETS

SHEET NO.	TITLE PAGE
1	TYPICAL CROSS-SECTION OF IMPROVEMENT (ONE COURSE CEMENT CONCRETE PAVEMENT ITEM 35-A)
2	BANKING AND WIDENING TABLES
3	5-28 PIPE CULVERTS
4	5-29 BOX CULVERTS
5	5-30 GUARD RAIL
6	5-31 BOUNDARY MARKERS
7	5-40 BARRICADES, SIGNS AND LIGHTS
8	DETAILS OF CORR. GRAY MULTI-METAL PLATE PIPE STA 35+74
9	PLAN AND PROFILE
10-46	CROSS SECTIONS

STANDARD STRUCTURE SHEETS APPROVED BY THE CHIEF ENGINEER

SHEETS	5-281-329	JULY 15, 1933
SHEET	5-30	AUGUST 15, 1933
SHEET	5-31	JULY 25, 1934

STATE OF VERMONT
STATE HIGHWAY DEPARTMENT

PLAN AND PROFILE OF PROPOSED
STATE HIGHWAY
FEDERAL AID PROJECT



TOWNS OF NEW HAVEN-WALTHAM

MIDDLEBURY-BURLINGTON ROAD Pin # 99R458

BEGINNING 2754 ± FT. NORTHERLY OF THE INTERSECTION
OF ROUTE 17 WITH ROUTE U.S. 7 AND EXTENDING NORTH-
ERLY 2.019 MILES TO A POINT 1666.0 FT. NORTHERLY
OF THE NEW HAVEN-WALTHAM TOWN LINE
LENGTH OF PROJECT 10660.5 FT. = 2.019 MILES

FED. ROAD DIST. NO.	STATE	FED. AID PROJ. NO.	FISCAL YEAR	SHEET NO.	TOTAL SHEETS
9	VT.	13	1938	1	46

(CONT. 3)

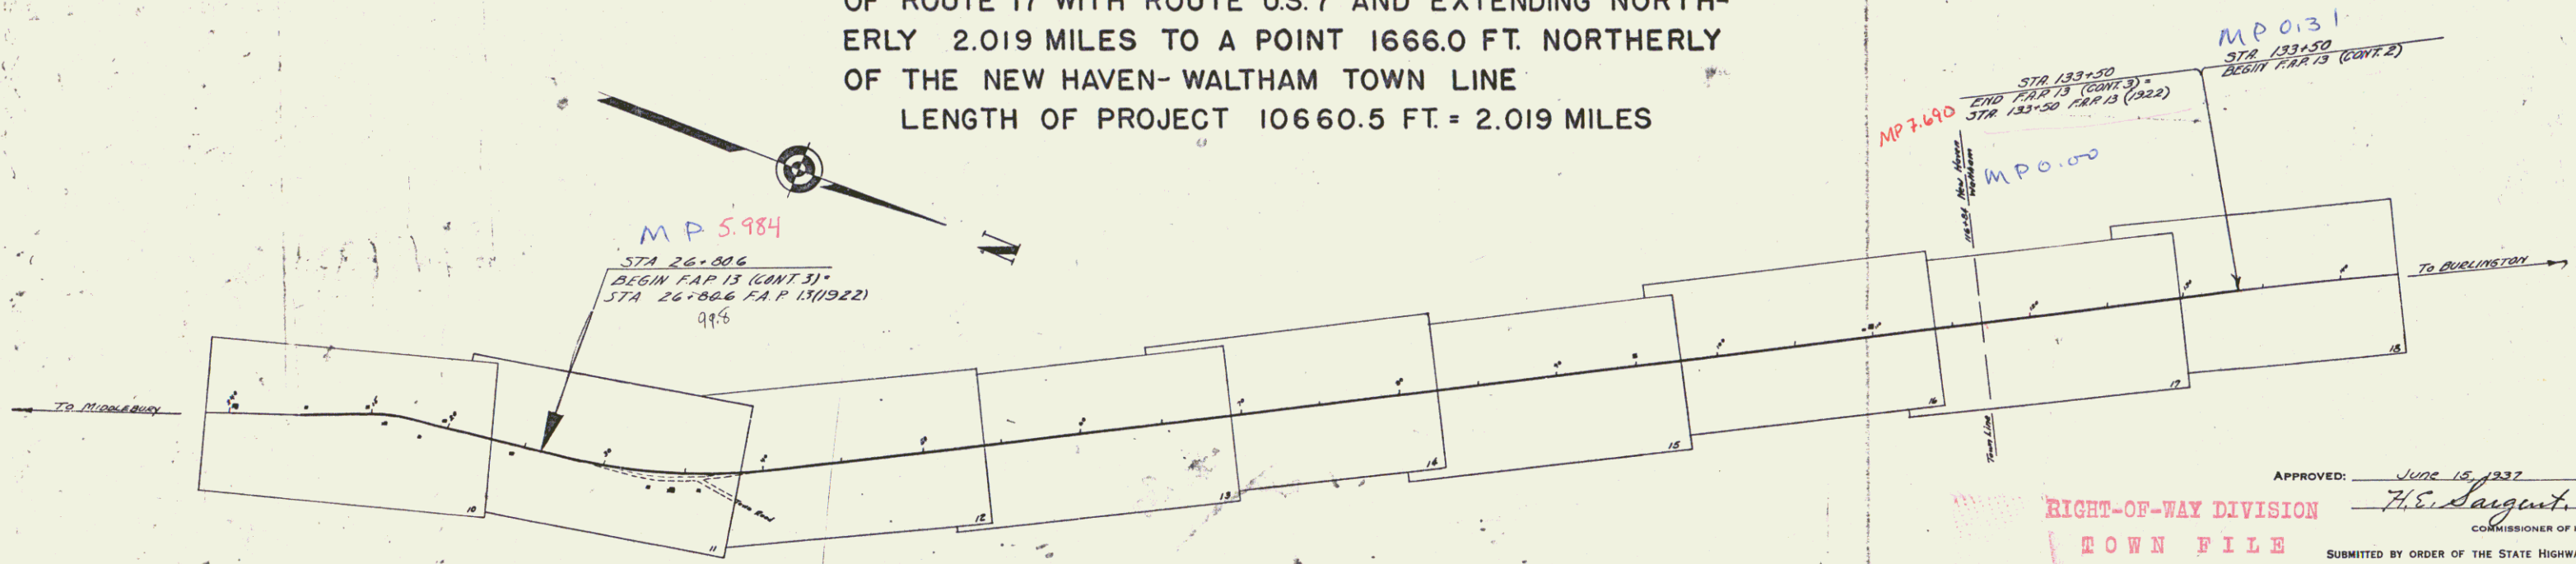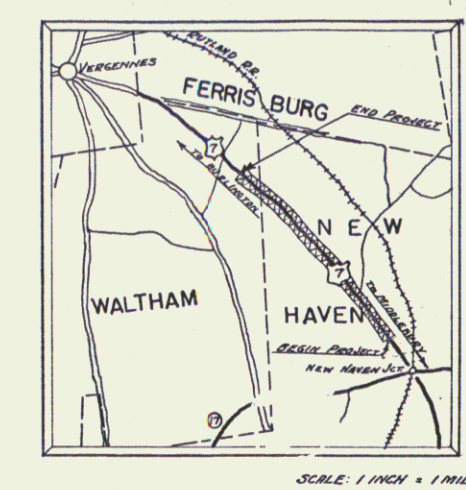

CONVENTIONAL SIGNS

COUNTY LINE	GROUND ELEVATION
TOWN LINE	FENCE LINE
STONE WALL	UNFENCED PROPERTY
GUARD RAIL	TRAVELED WAY
RAILROAD	RETAINING WALL
CENTER LINE	SURVEY LINE
CULVERT	DROP INLET
TROLLEY POLE	POWER POLE
TELEPHONE POLE	TREES
HEDGE	

CURVE DATA

DEFLECTION ANGLE	D.
DEGREE OF CURVE	D.
RADIUS OF CURVE	R.
TANGENT DISTANCE	T.
EXTERNAL DISTANCE	E.
POINT OF INTERSECTION	P. I.
POINT OF CURVE	P. C.
POINT OF TANGENT	P. T.
POINT ON TANGENT	P. O. T.

SCALES

TITLE	1" = 500'
TYPICAL	1" = 2'
PLAN	1" = 50'
PROFILE	1" = 10'
CROSS-SECTIONS	1" = 5'

These plans are subject to such revisions as may be required by the Bureau of Public Roads or the Commissioner of Highways. Construction is to be carried on in accordance with the plans and Standard Road and Bridge Specifications of 1936, as approved Dec. 23, 1936 by the Bureau of Public Roads, including all subsequent approved revisions and such revised specifications and special provisions as are submitted with the plans.

Project No. F.A.P. 13 (3)


APPROVED: June 15, 1937
TOWN FILE
PERPETUAL
Town of US7
(To Be Returned To R.O.W. Division)

RECOMMENDED
DISTRICT ENGINEER
RECOMMENDED FOR APPROVAL
CHIEF ENGINEER
APPROVED
DIRECTOR, BUREAU OF PUBLIC ROADS


Approved: June 18, 1937
District Highway Comm.
Approved: June 15, 1937
Road Engineer



SERIES F.A.P. NO. 13 (46) FILED
SHEET 1 OF 46


DIST. # 5 PLANS

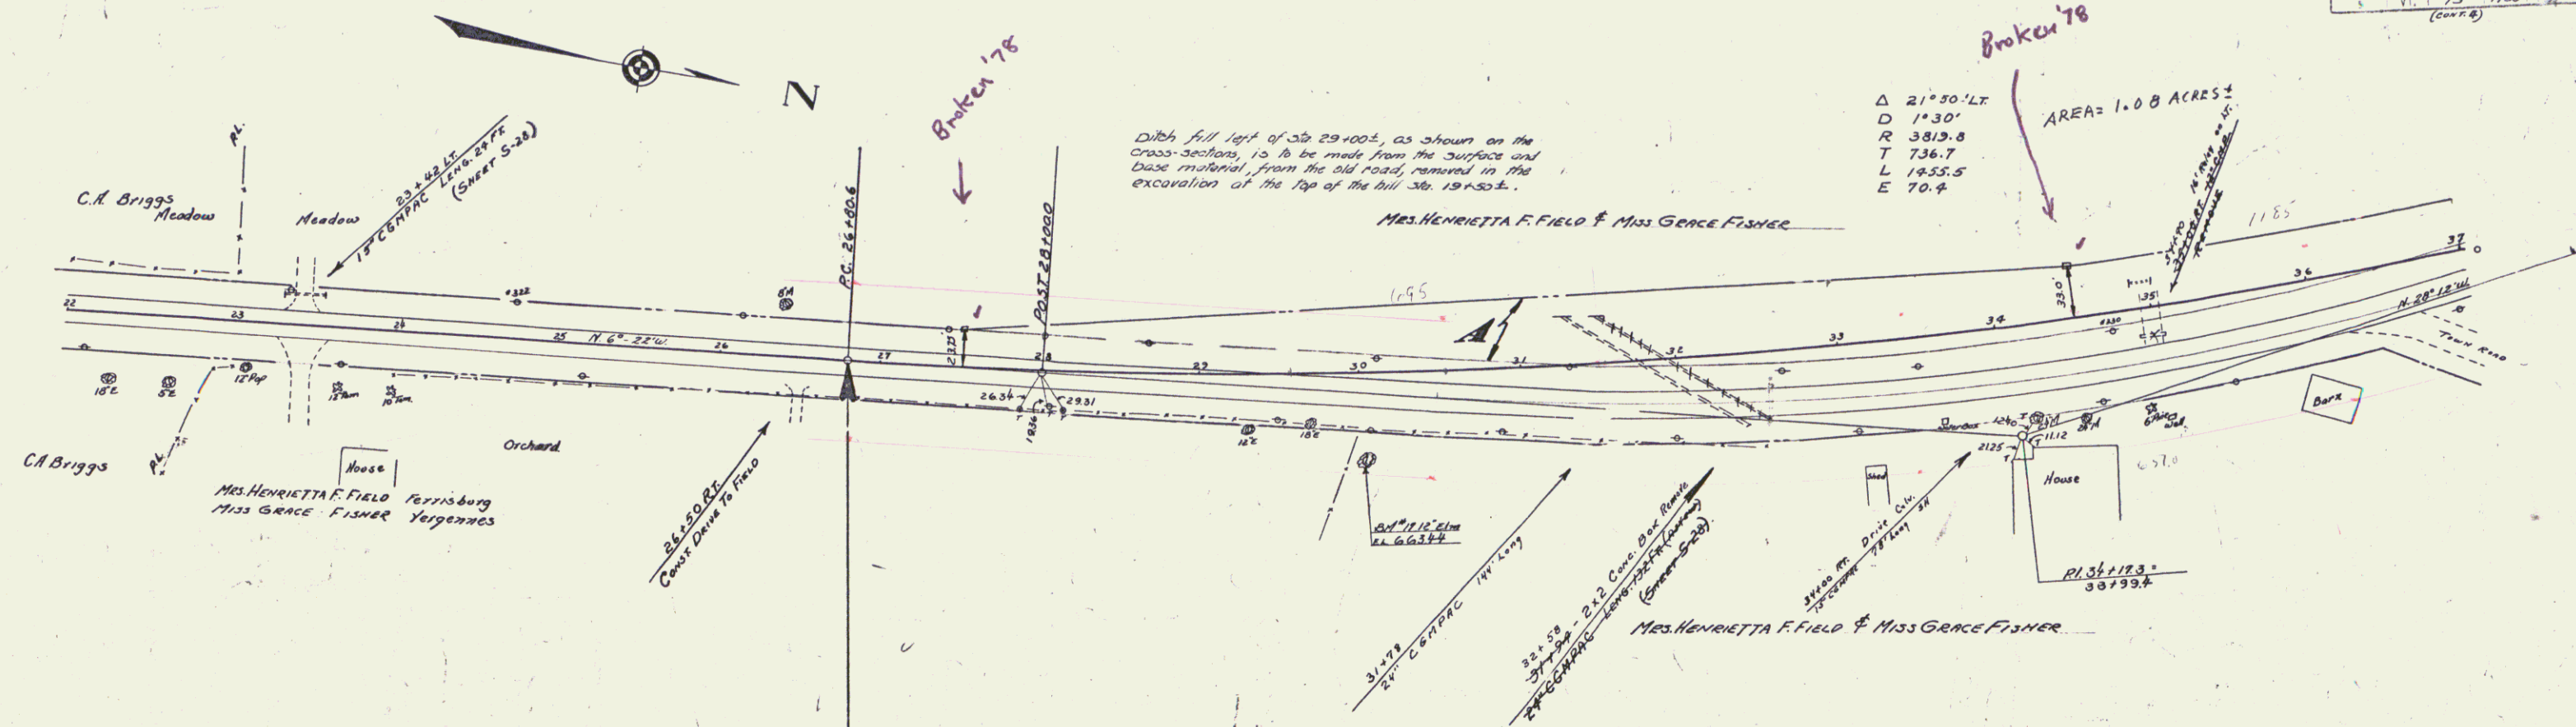


PARCEL	INSTRUMENT	DATE	GRANTOR	GRANTEE	RECORDED	REMARKS
A	O.C.O.	8-23	M. FIELD & G. FISHER	370 FT.	24	665 0-18-37

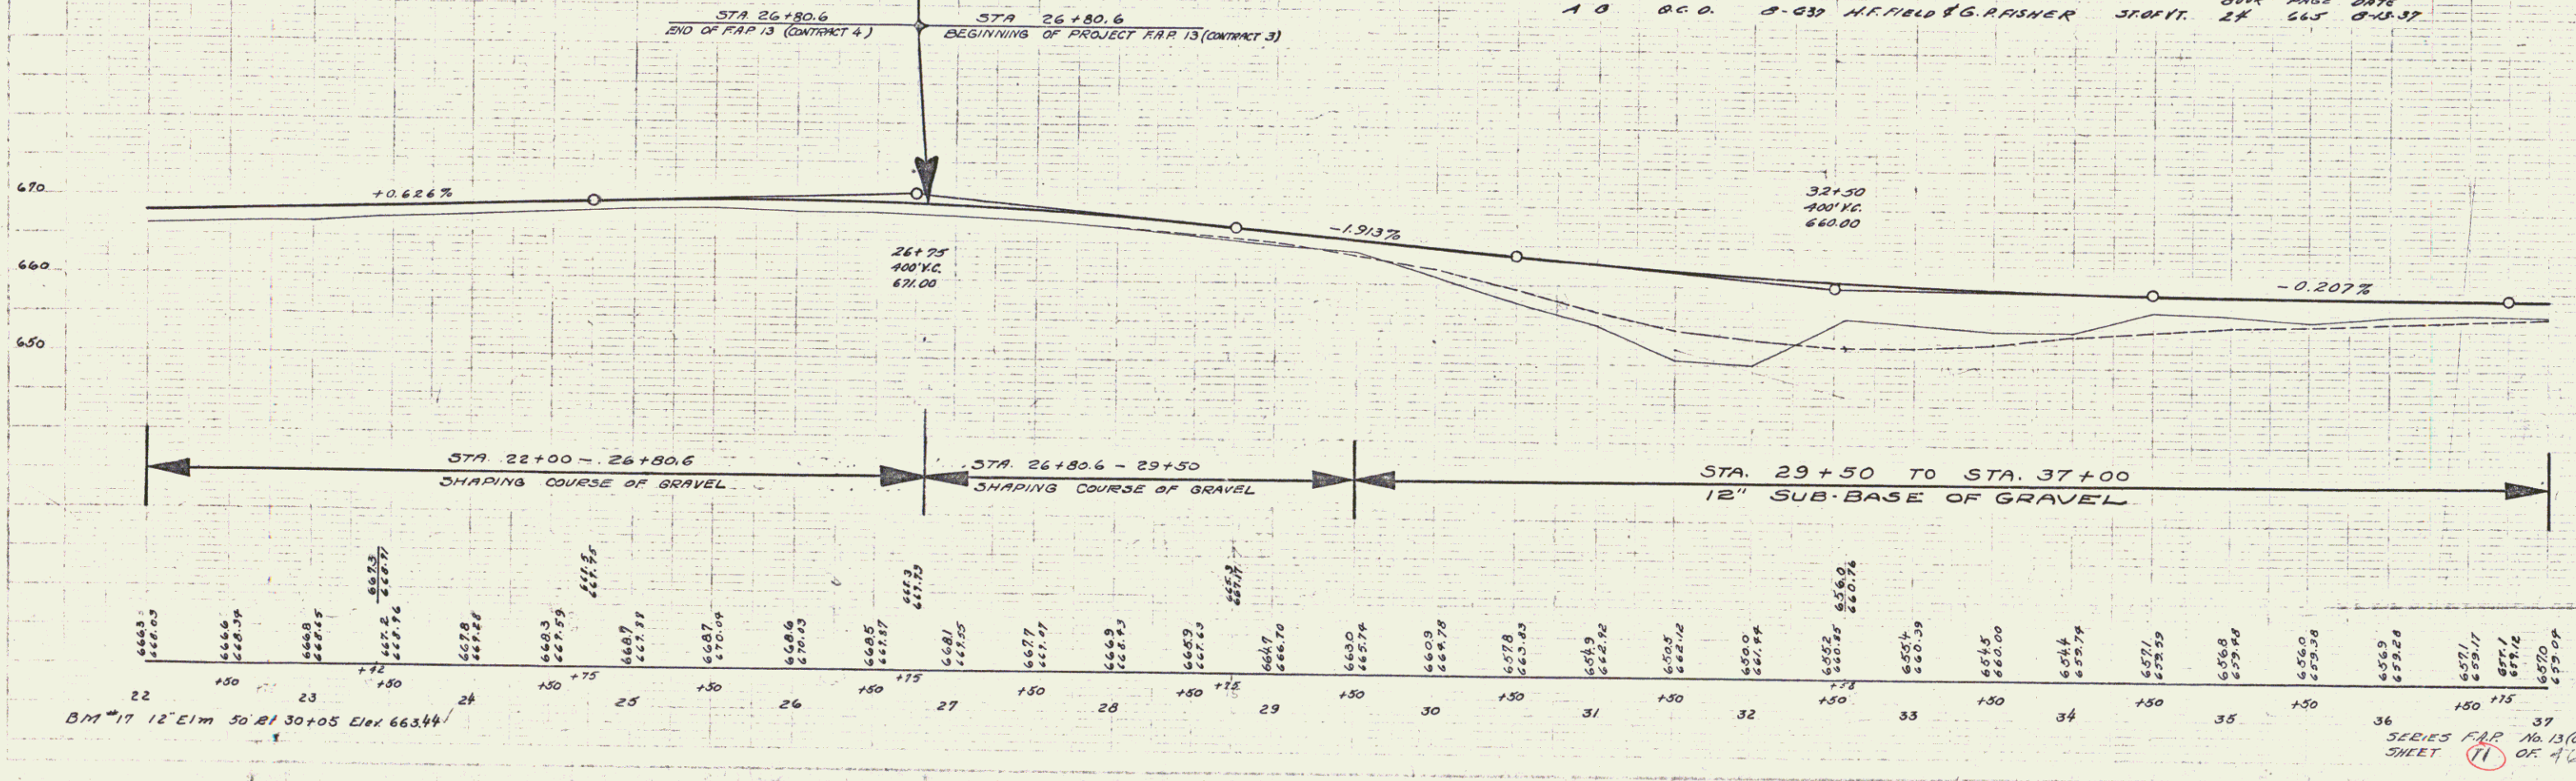

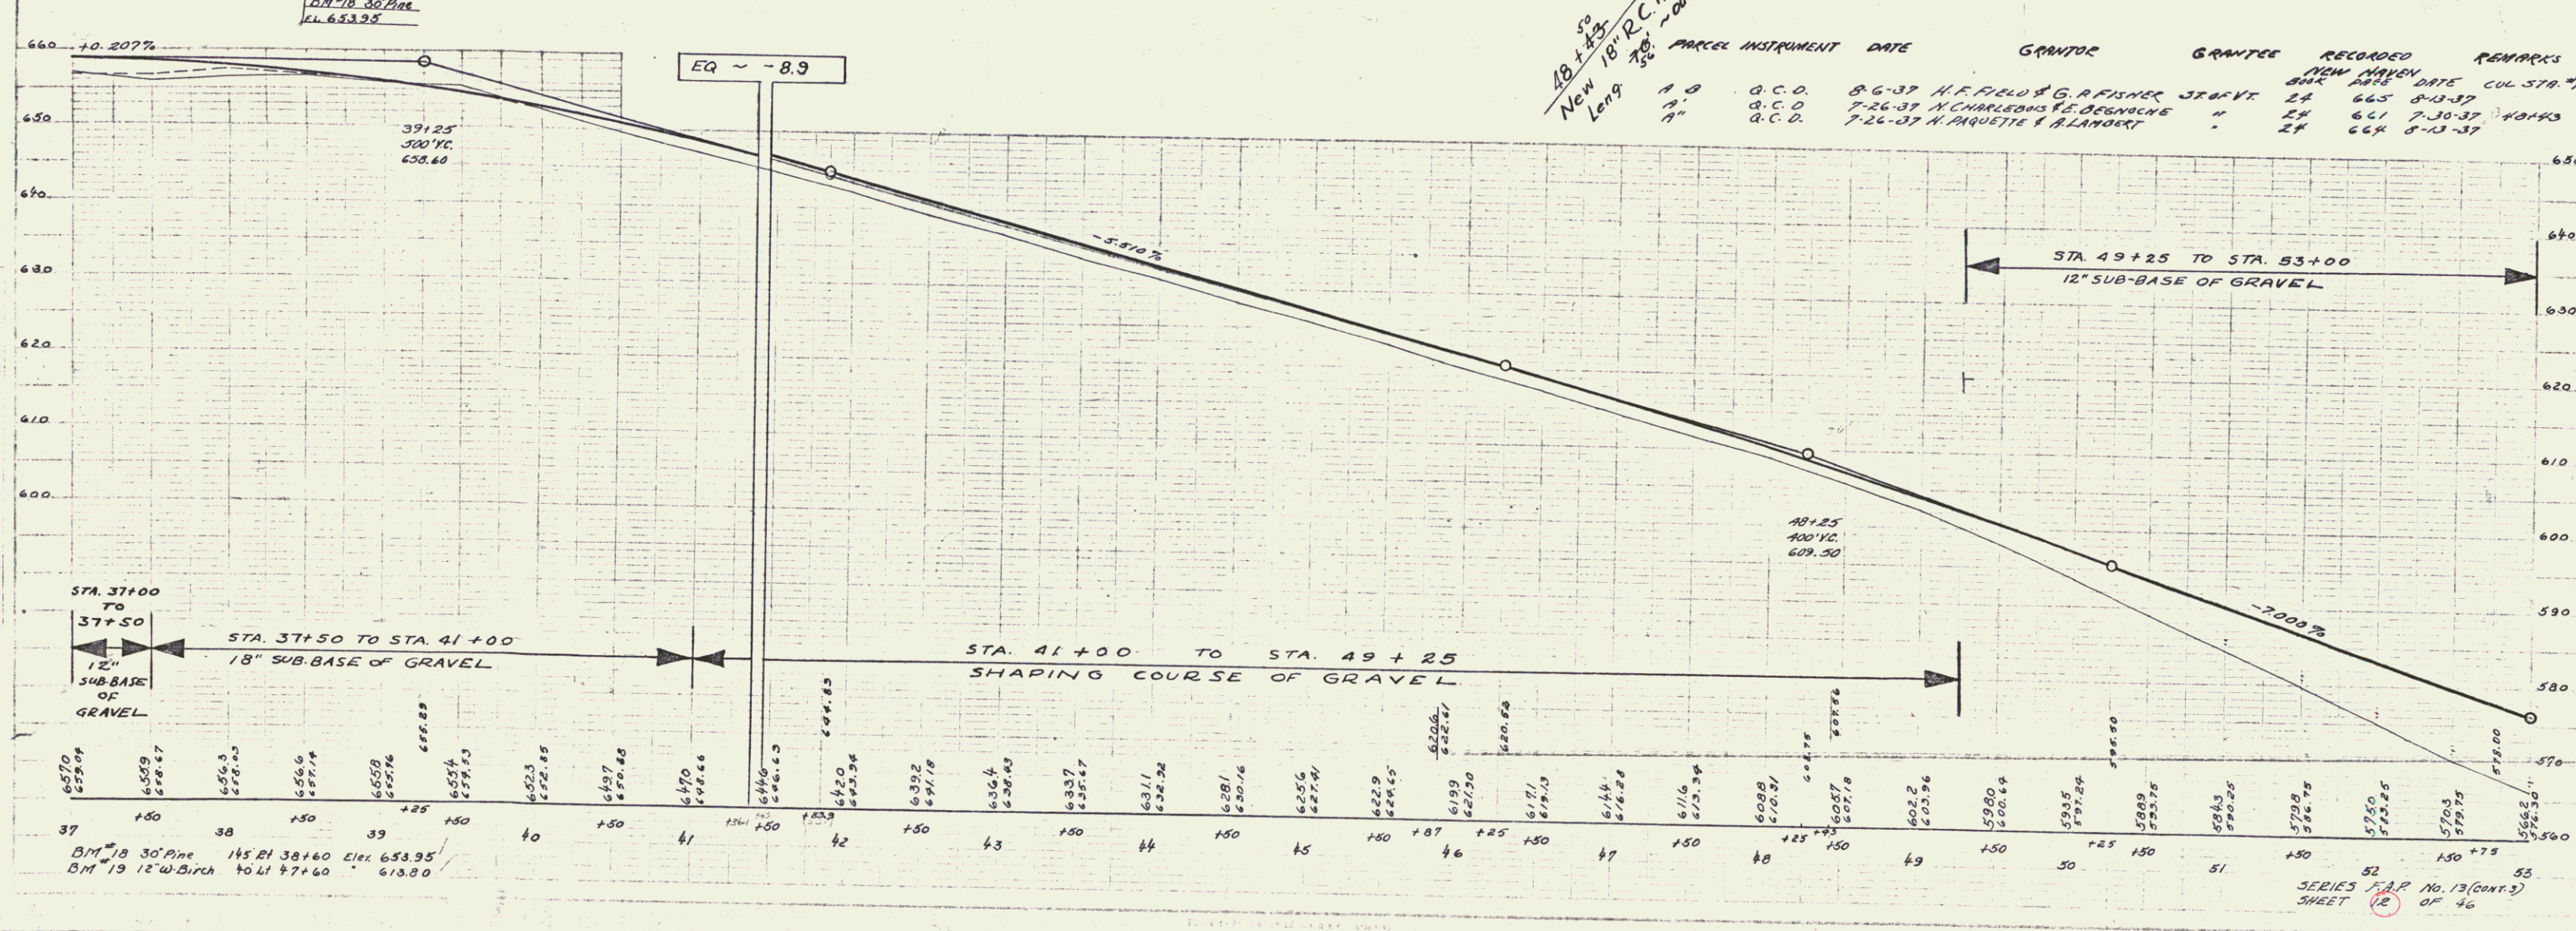
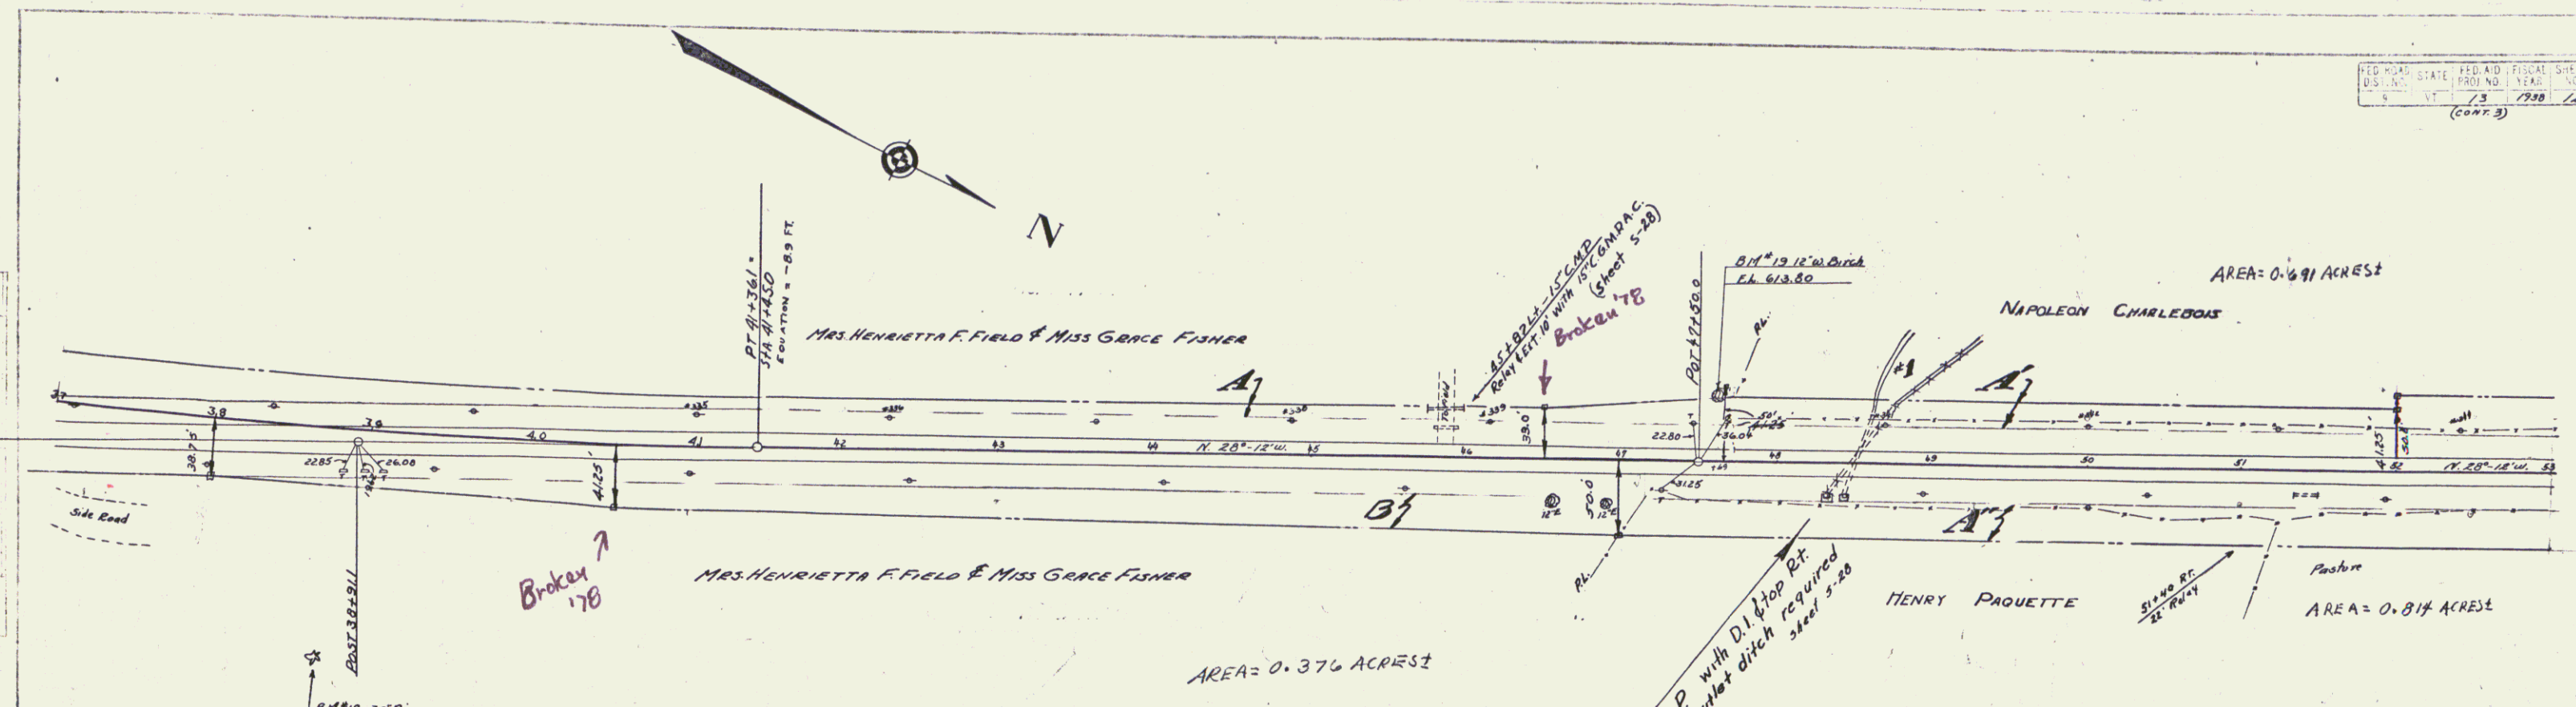


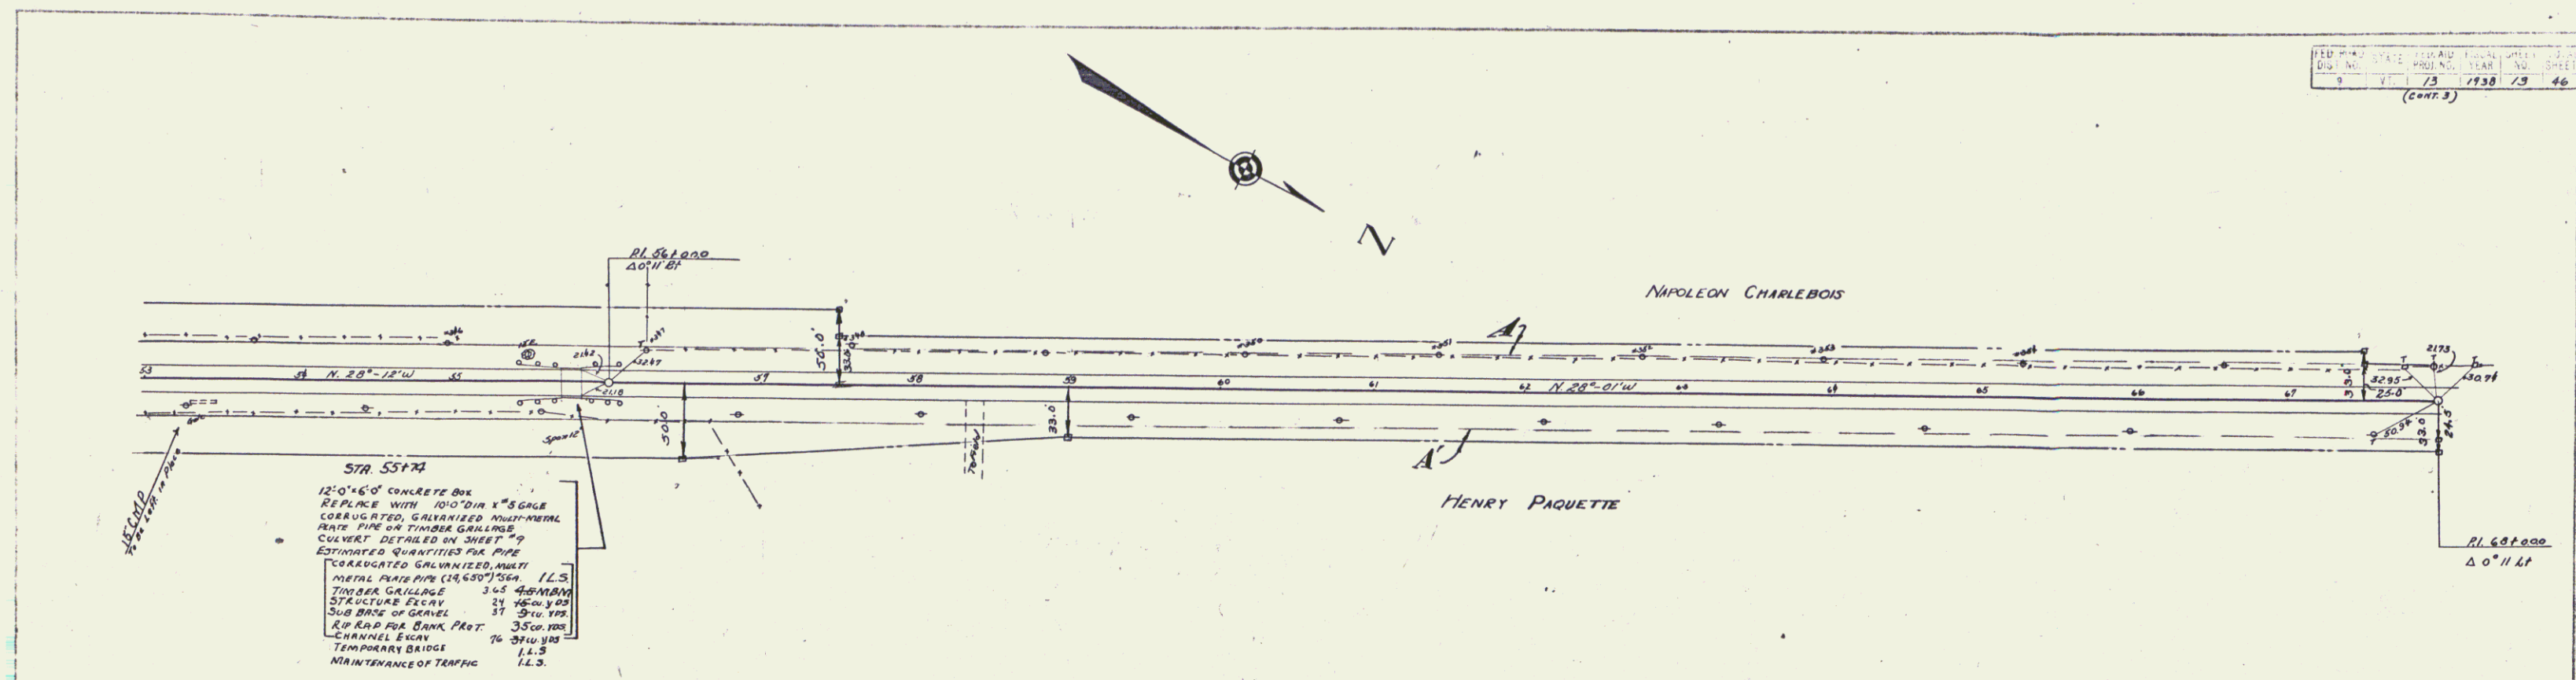



PARCEL	INSTRUMENT	DATE	GRANTOR	GRANTEE	RECORDED	REMARKS
A	O.C.D.	7-26-37	NICHOLAS & E. BEGUIN	STATE OF VT	24 661	NEW HAVEN DATE 7-30-37 CUL 810
A'	O.C.D.	7-26-37	H. PAQUETTE & J. LAMBERT	"	24 664	8-13-37 181 43

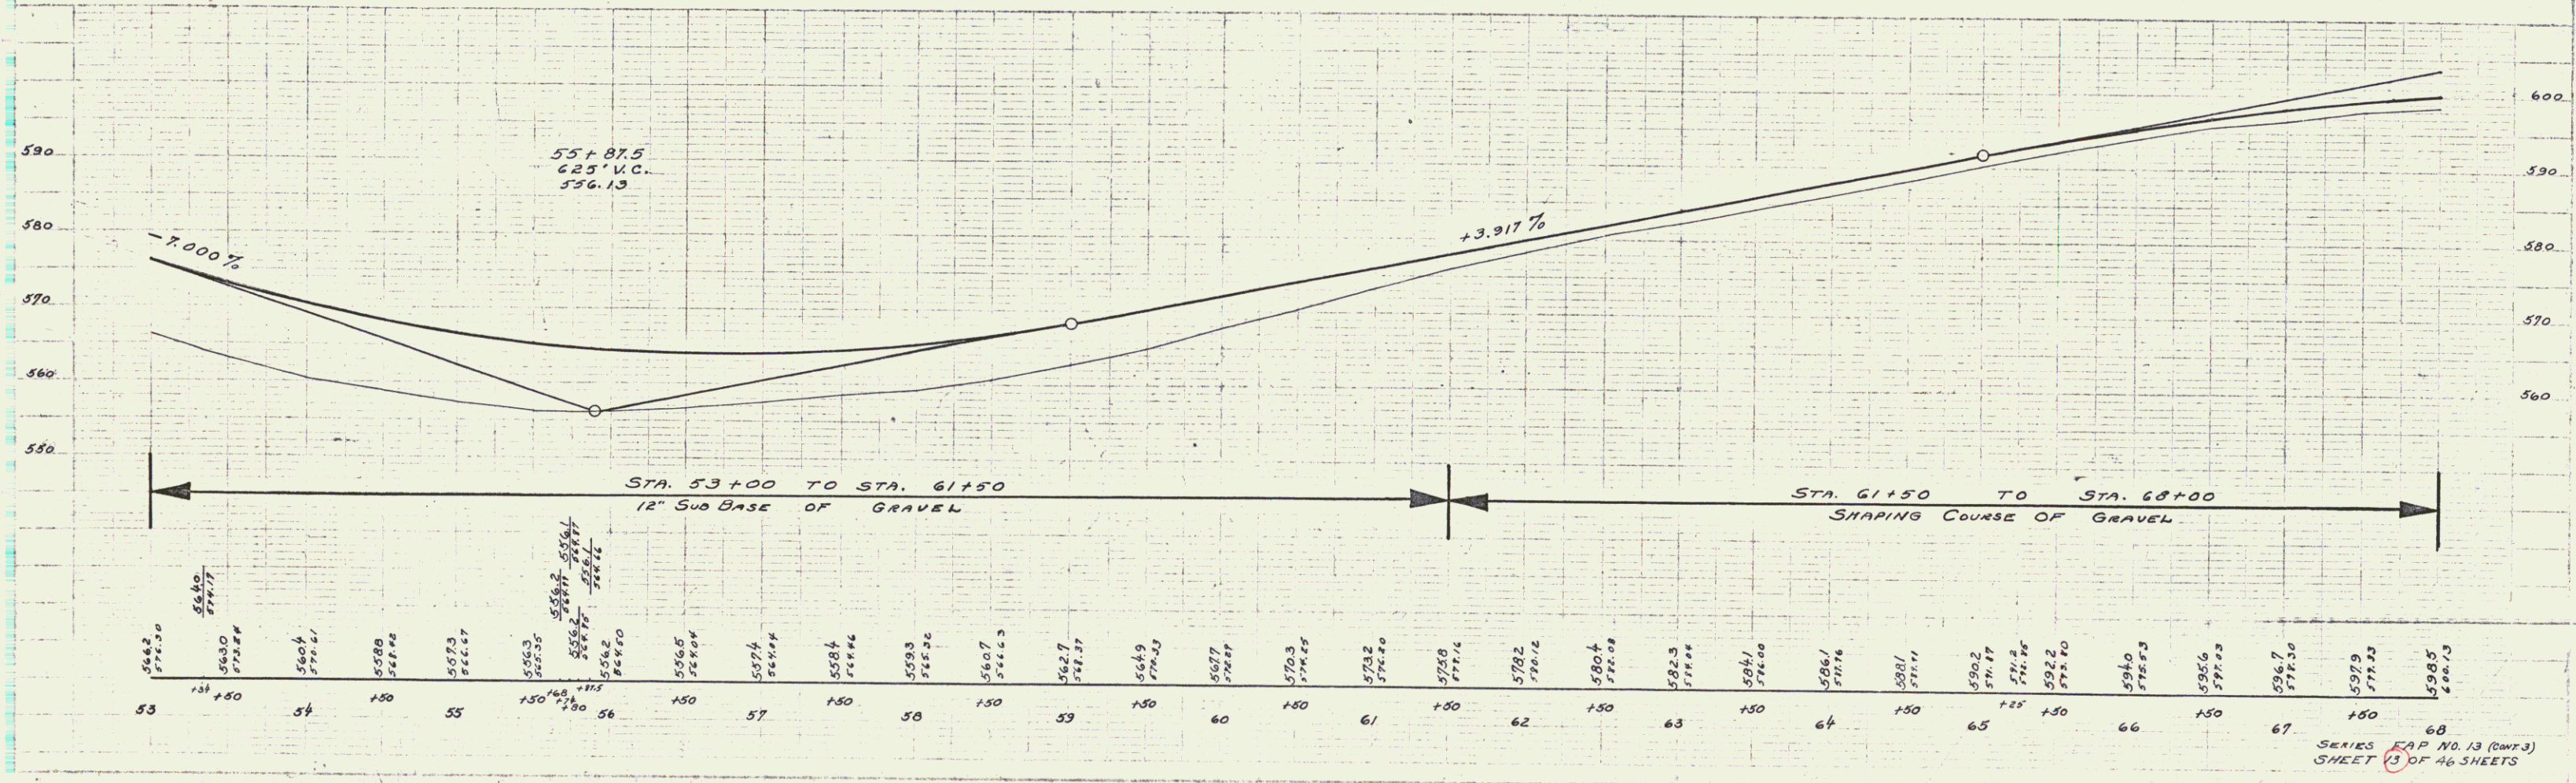


6

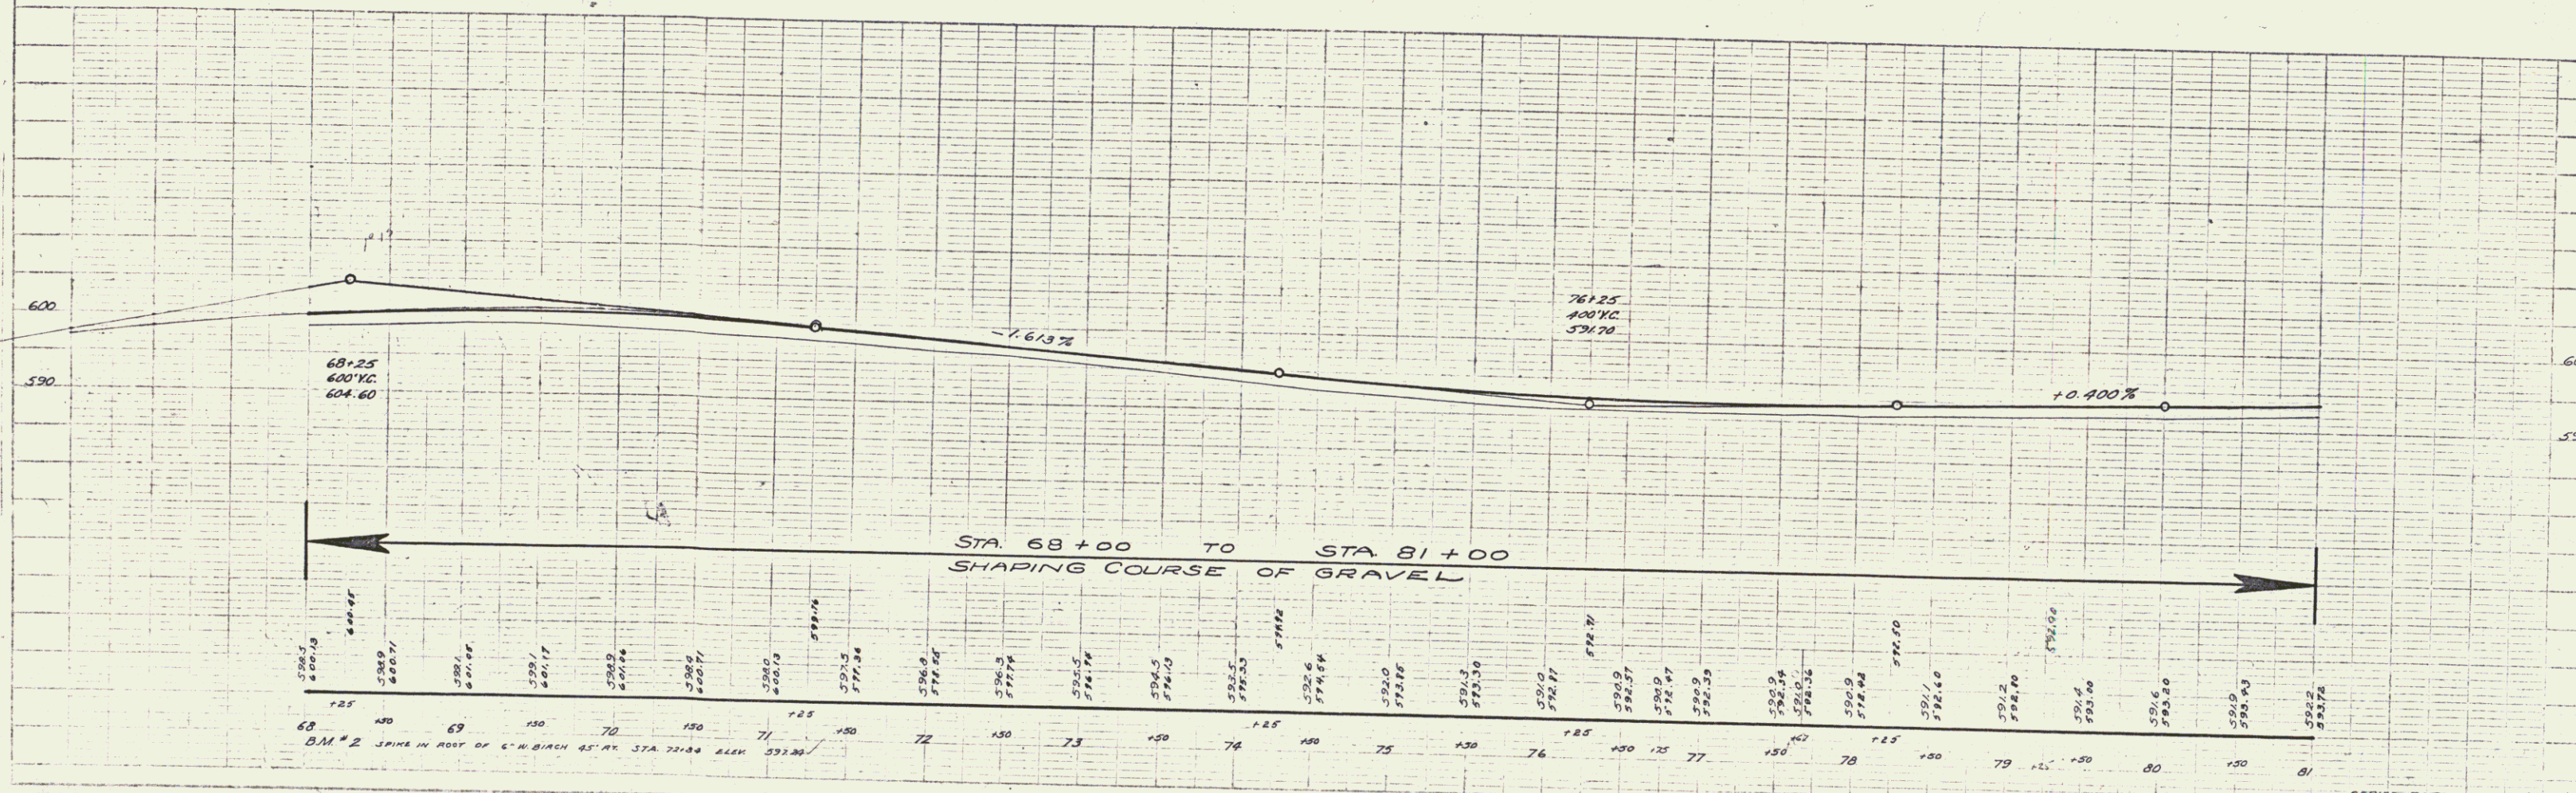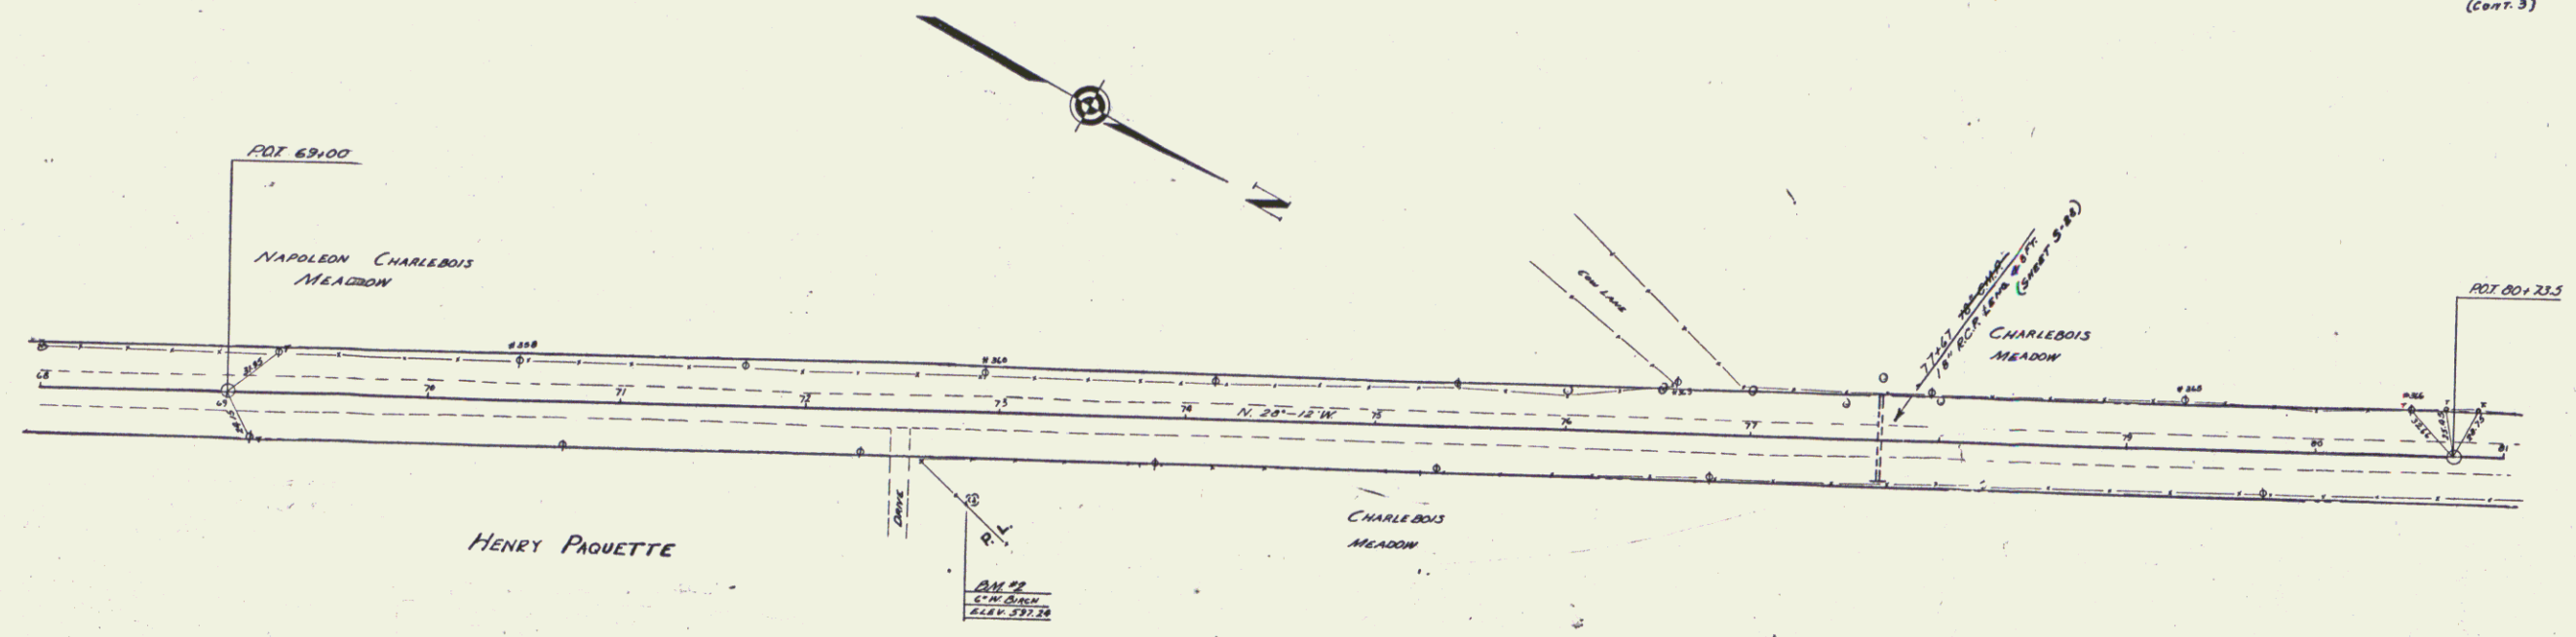



NOTE: B.M. 3 IS IN ROOT OF 12" PINE 25' RT. STA. 82+11.8 ELEV. 532.50
B.M. 4 IS IN ROOT OF 10" ELM 25' RT. STA. 92+36 ELEV. 602.14

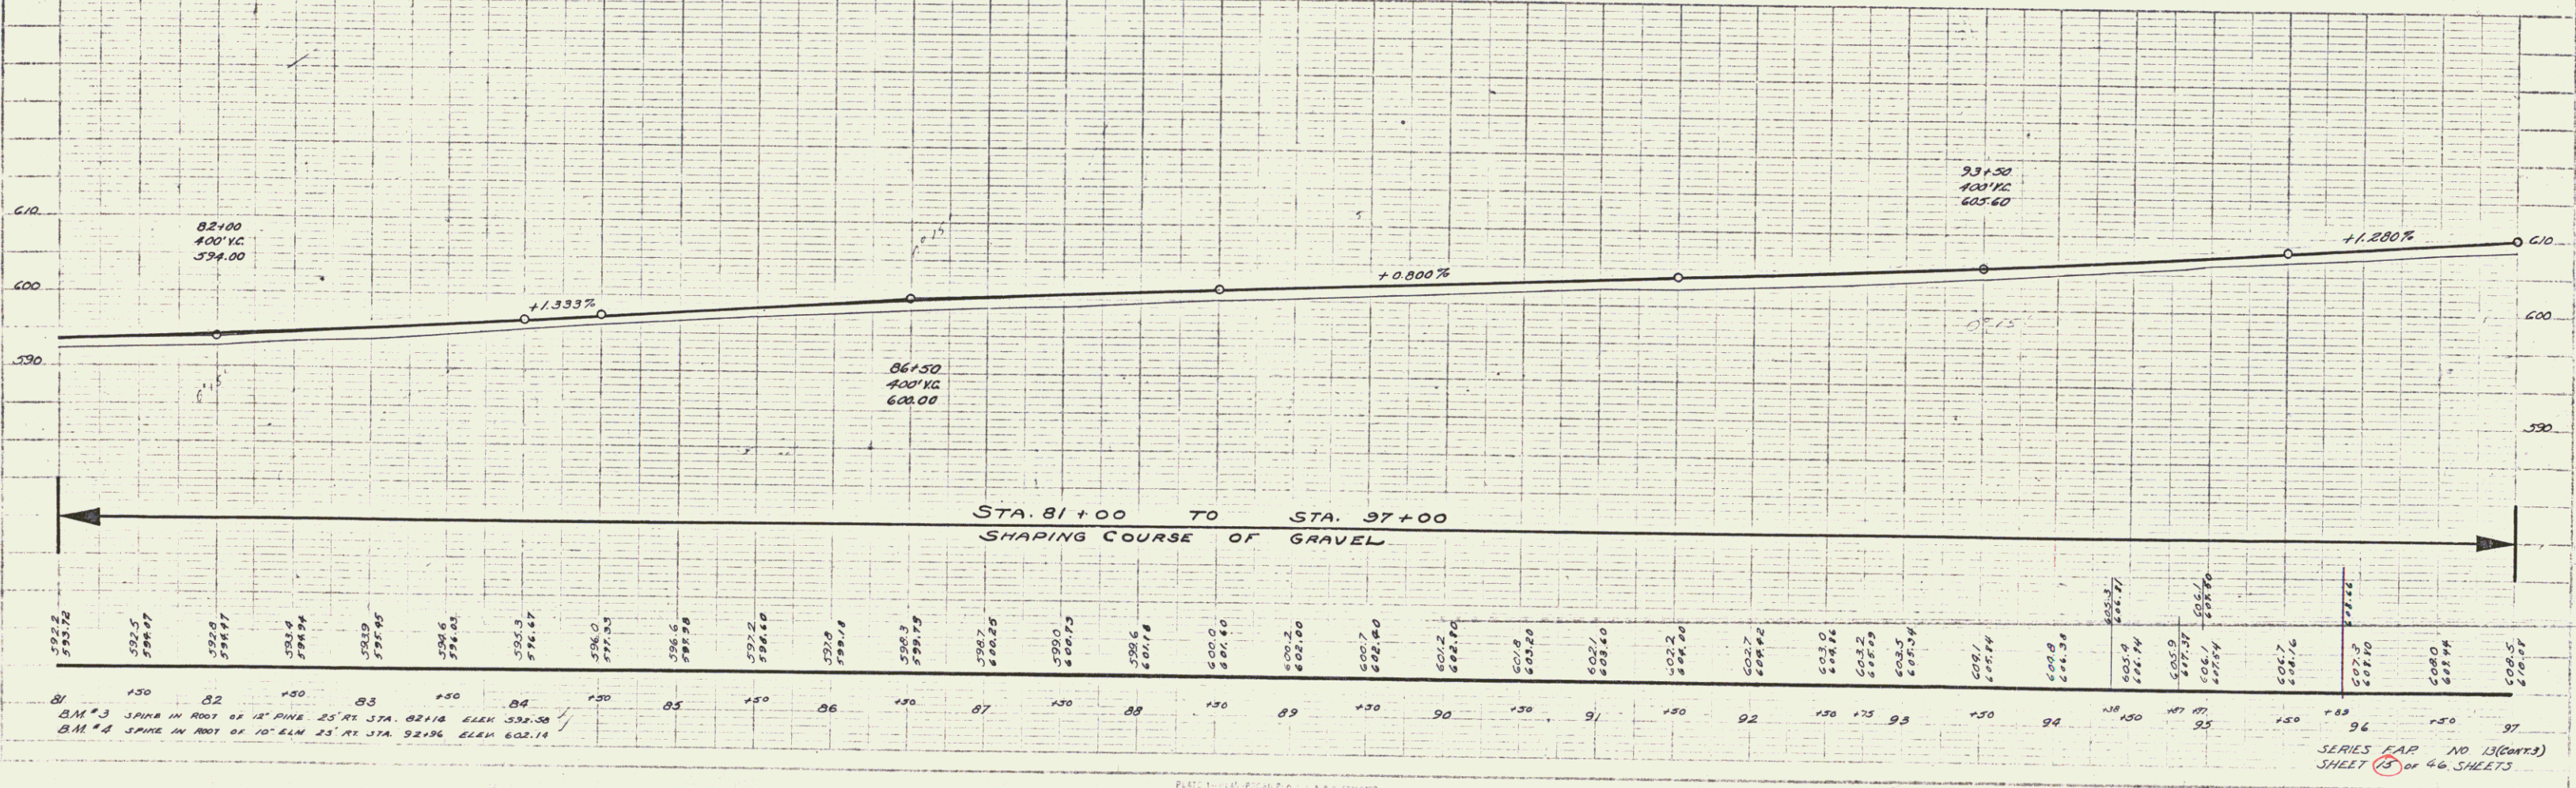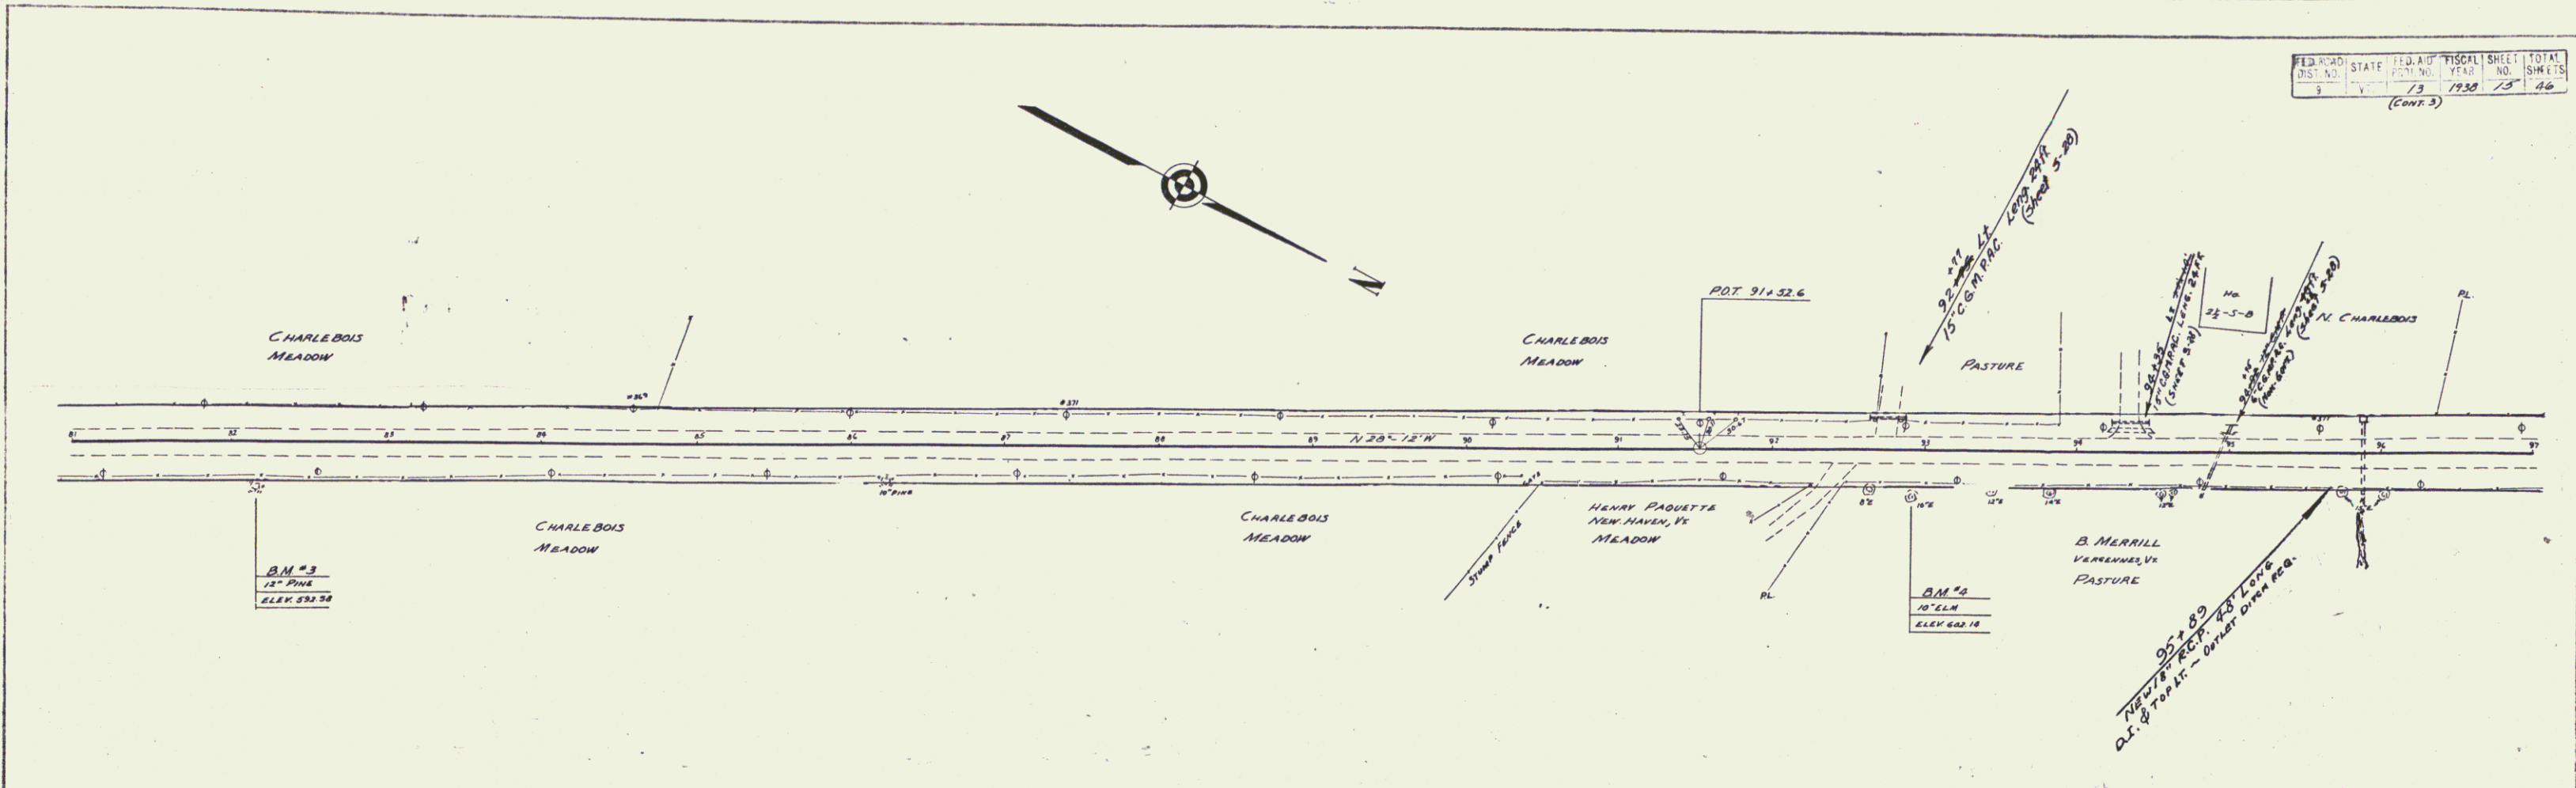

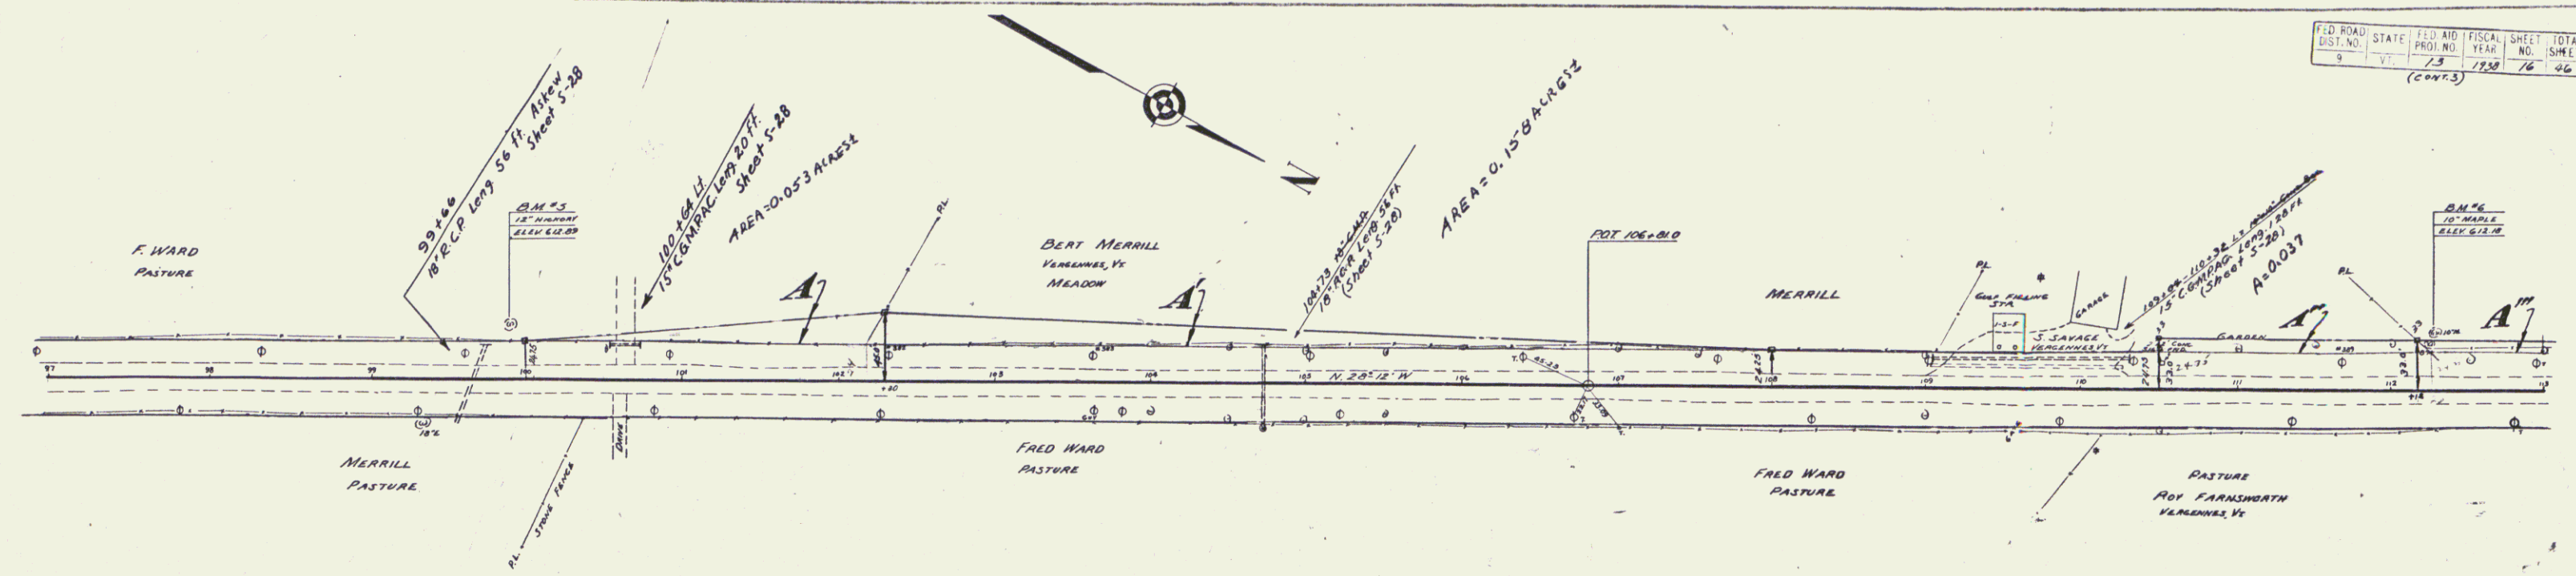


PARCEL	INSTRUMENT	DATE	GRANTOR	GRANTEE	RECORDED	REMARKS
A	O.C.D.	8-6-37	F.C. WARD	ST. OF VT.	24	NEW HAVEN
A'	O.C.D.	7-26-37	B.S. STELLA MERRILL	"	24	DATE 9-13-37
A''	O.C.D.	7-26-37	BERNARD SEYMOUR SAUSAGE	"	24	662 7-30-37 COL. STA. 95109
A'''	O.C.D.	7-23-37	ROY E. FARNSWORTH	"	24	660 7-30-37 663 7-30-37

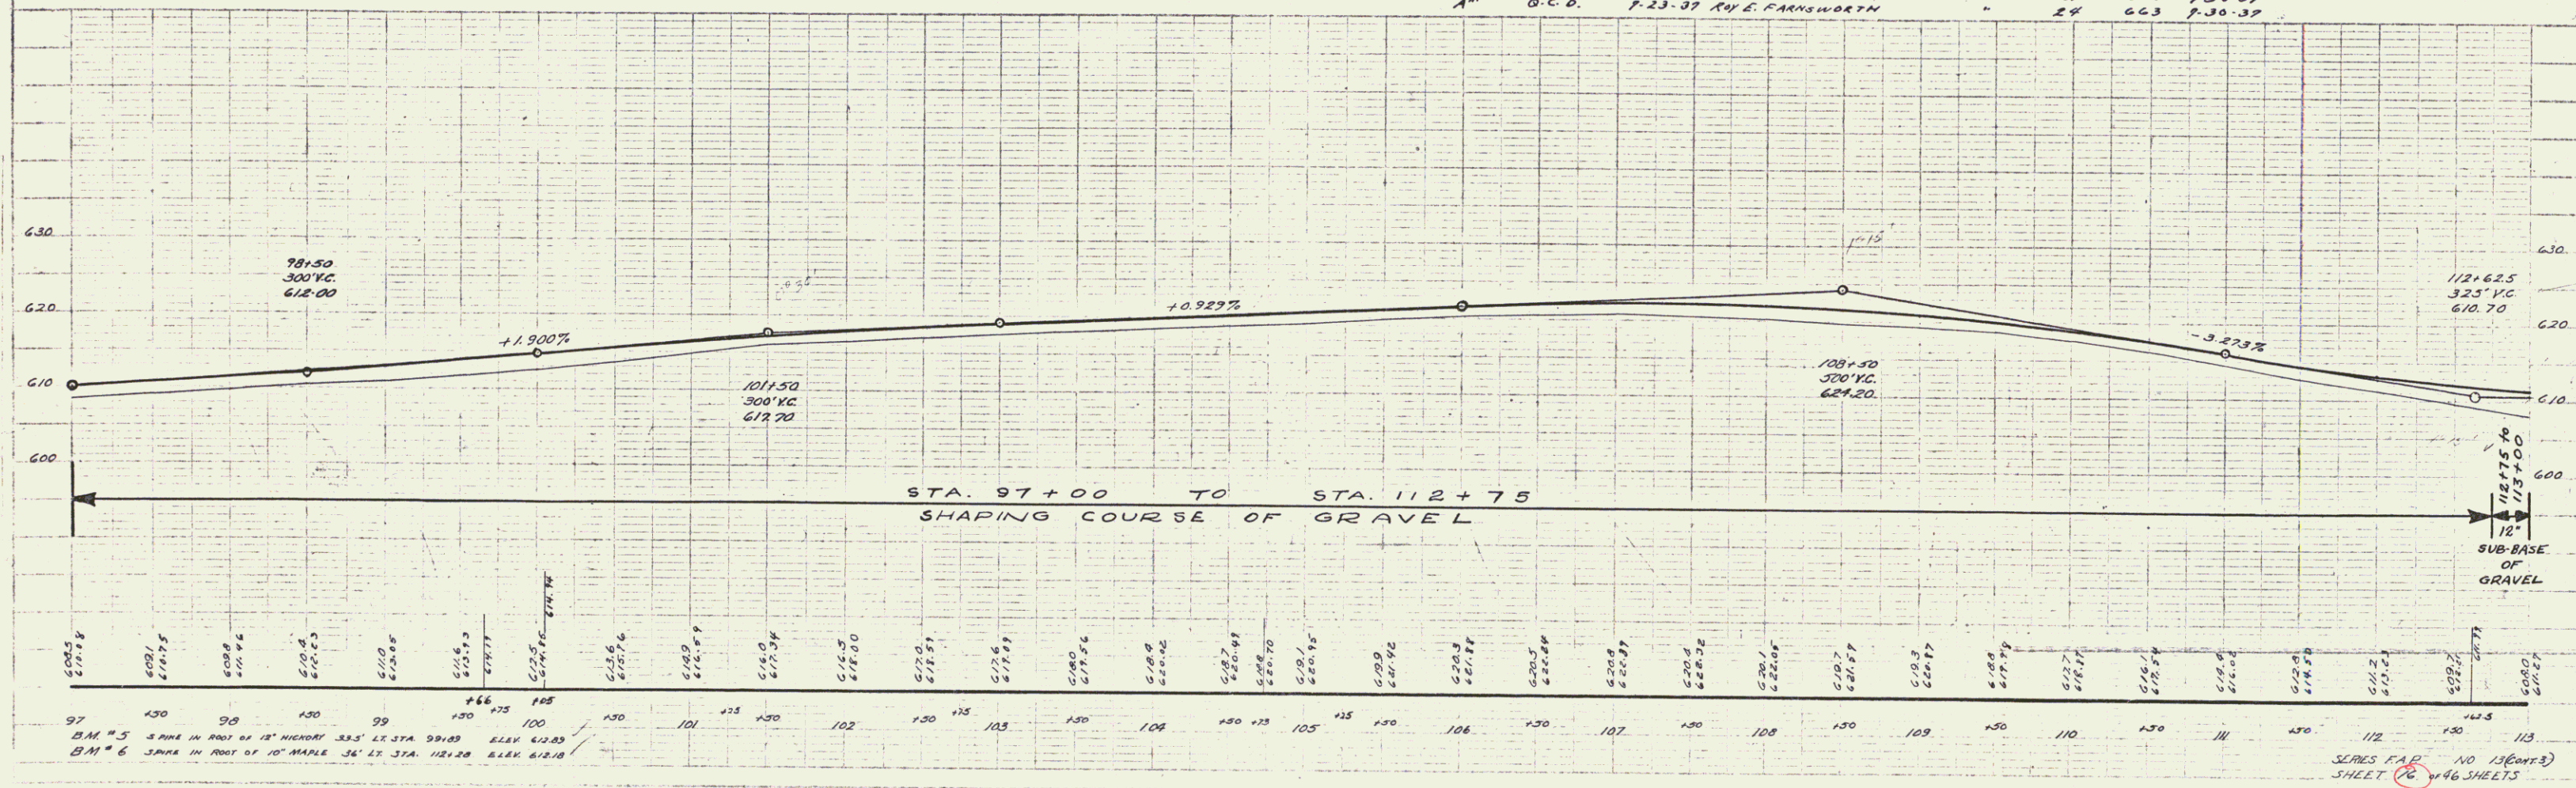

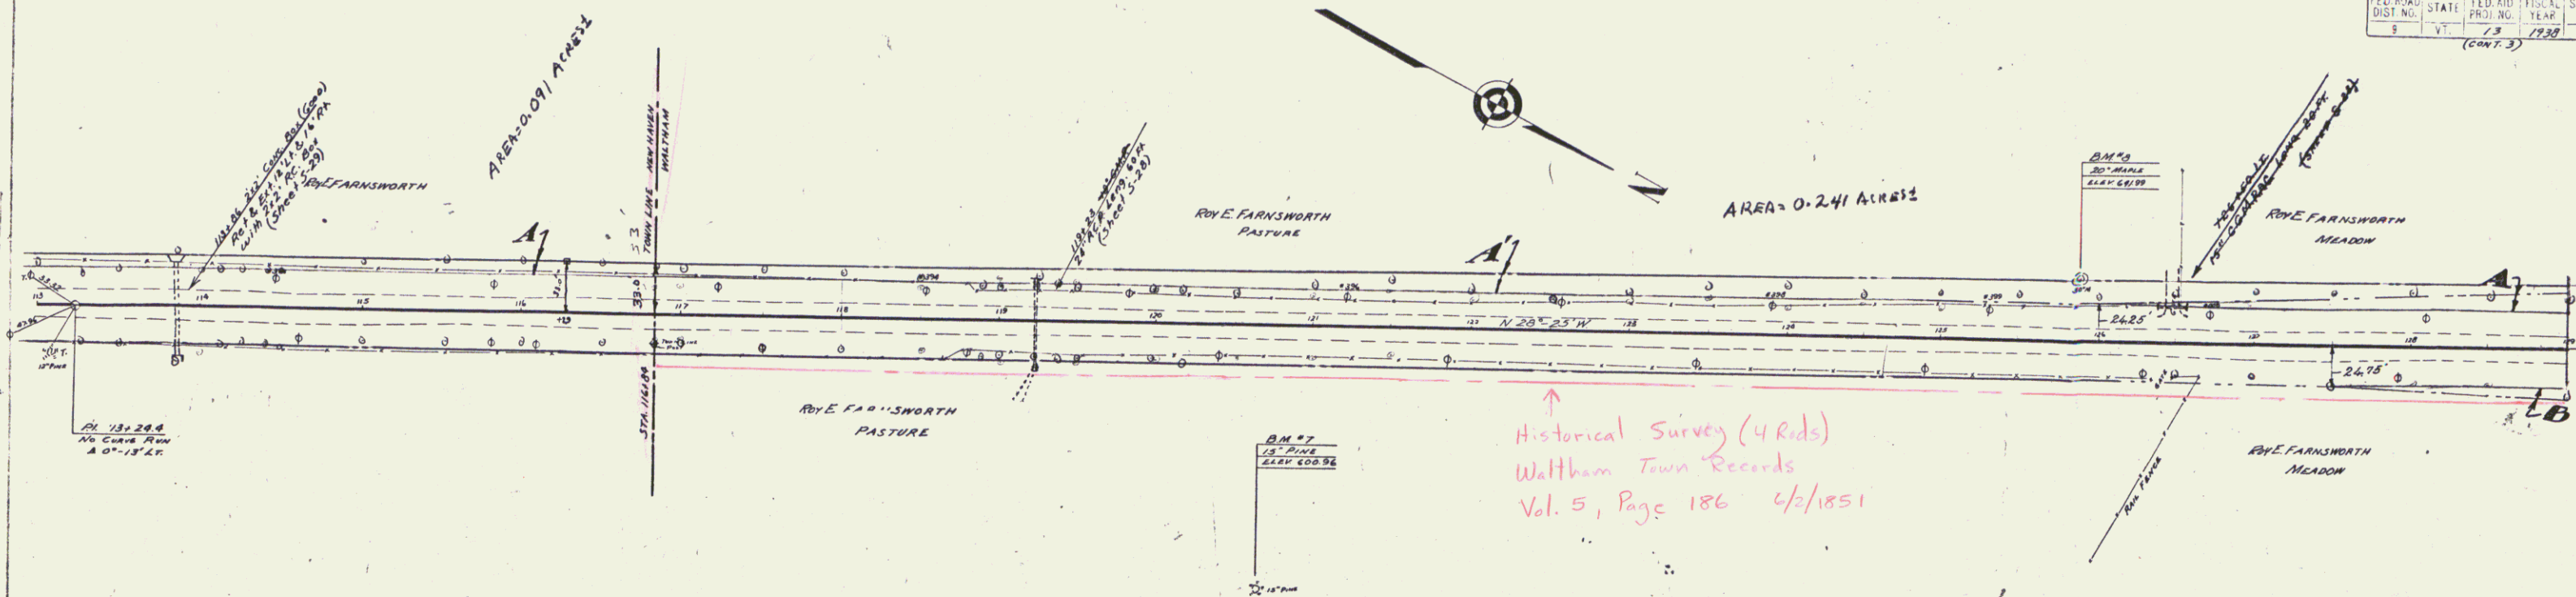


PARCEL	KIND OF	DATE OF	GRANTOR	GRANTEE	RECORDED	REMARKS
A	Q.C.D.	10-9-36	RYE FARNSWORTH	110 FT. 3	DATE 125 10/17/36	
A	Q.C.D.	7-23-37	"	"	Y 136 7-31-37	
A	Q.C.D.	7-23-37	"	"	NEW HAVEN BOOK PAGE 24 663 7-30-37	

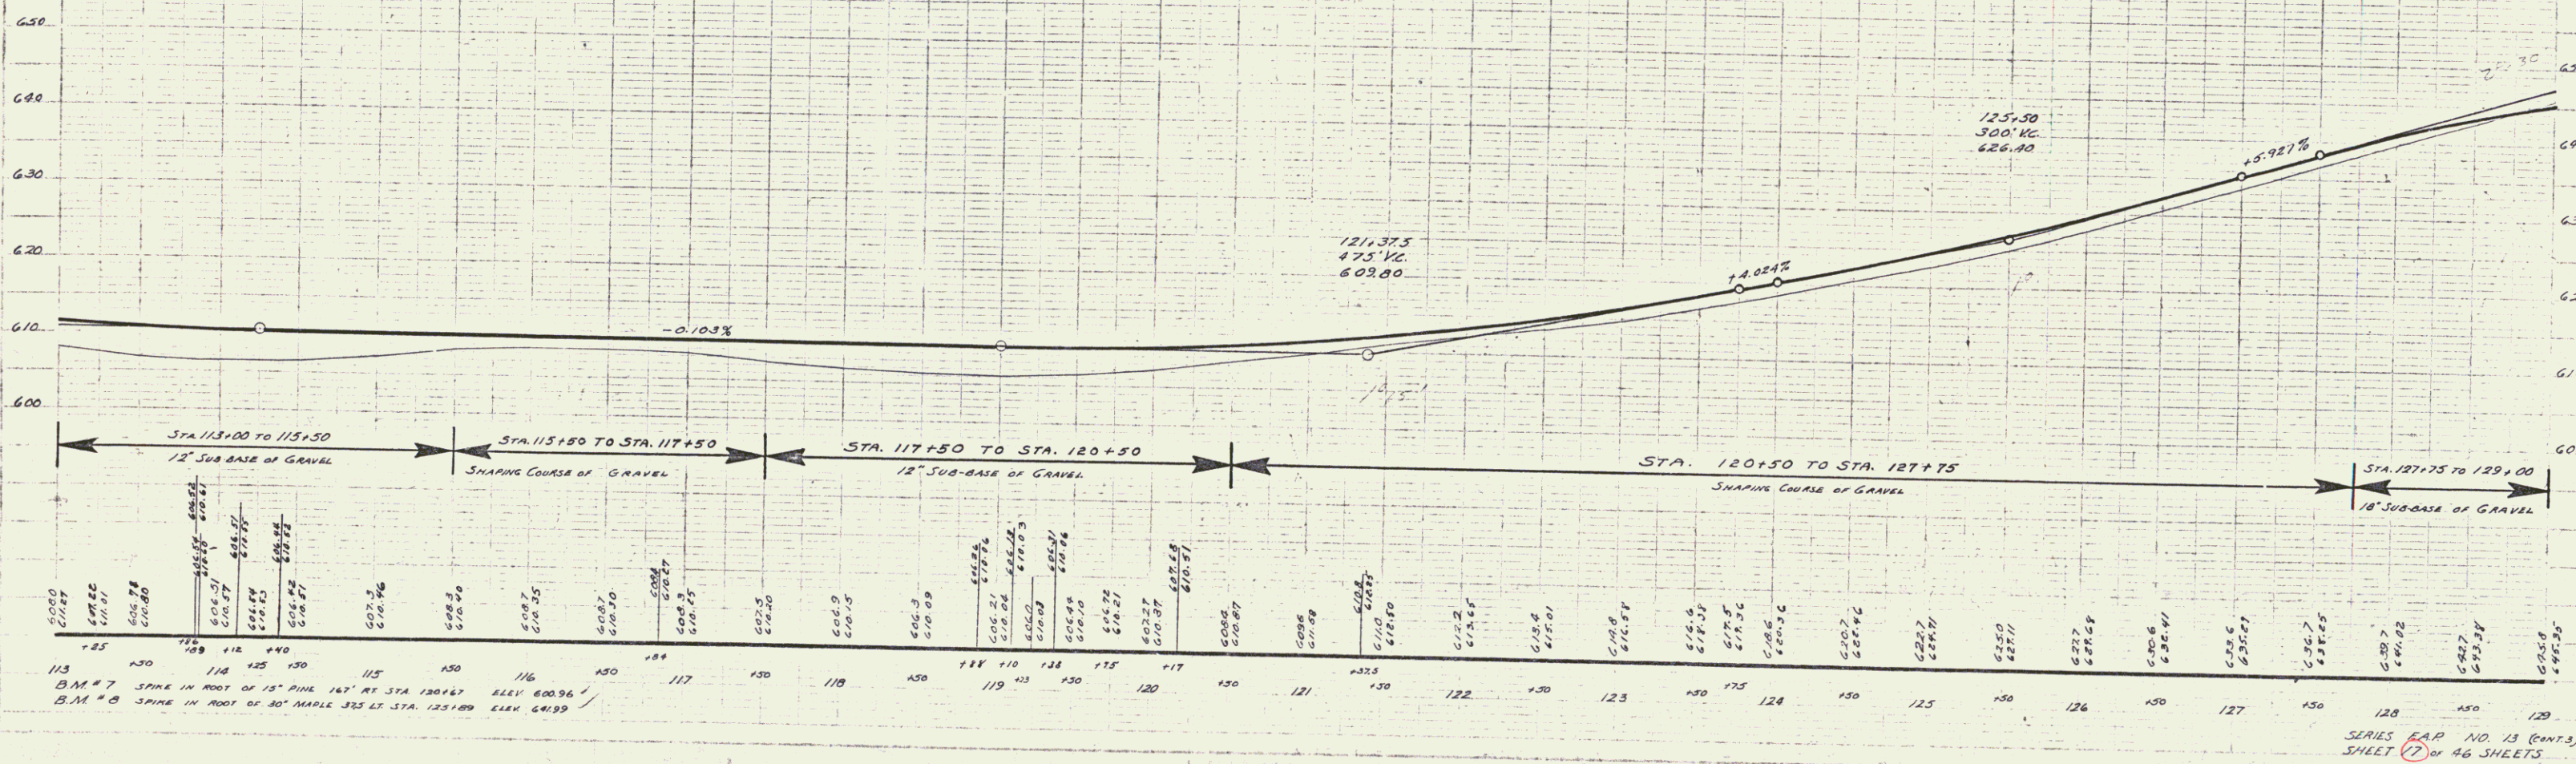

Large
Scale
Map
of
the
Project
Area
as
shown
on
the
Plans

Large
Scale
Map
of
the
Project
Area
as
shown
on
the
Plans

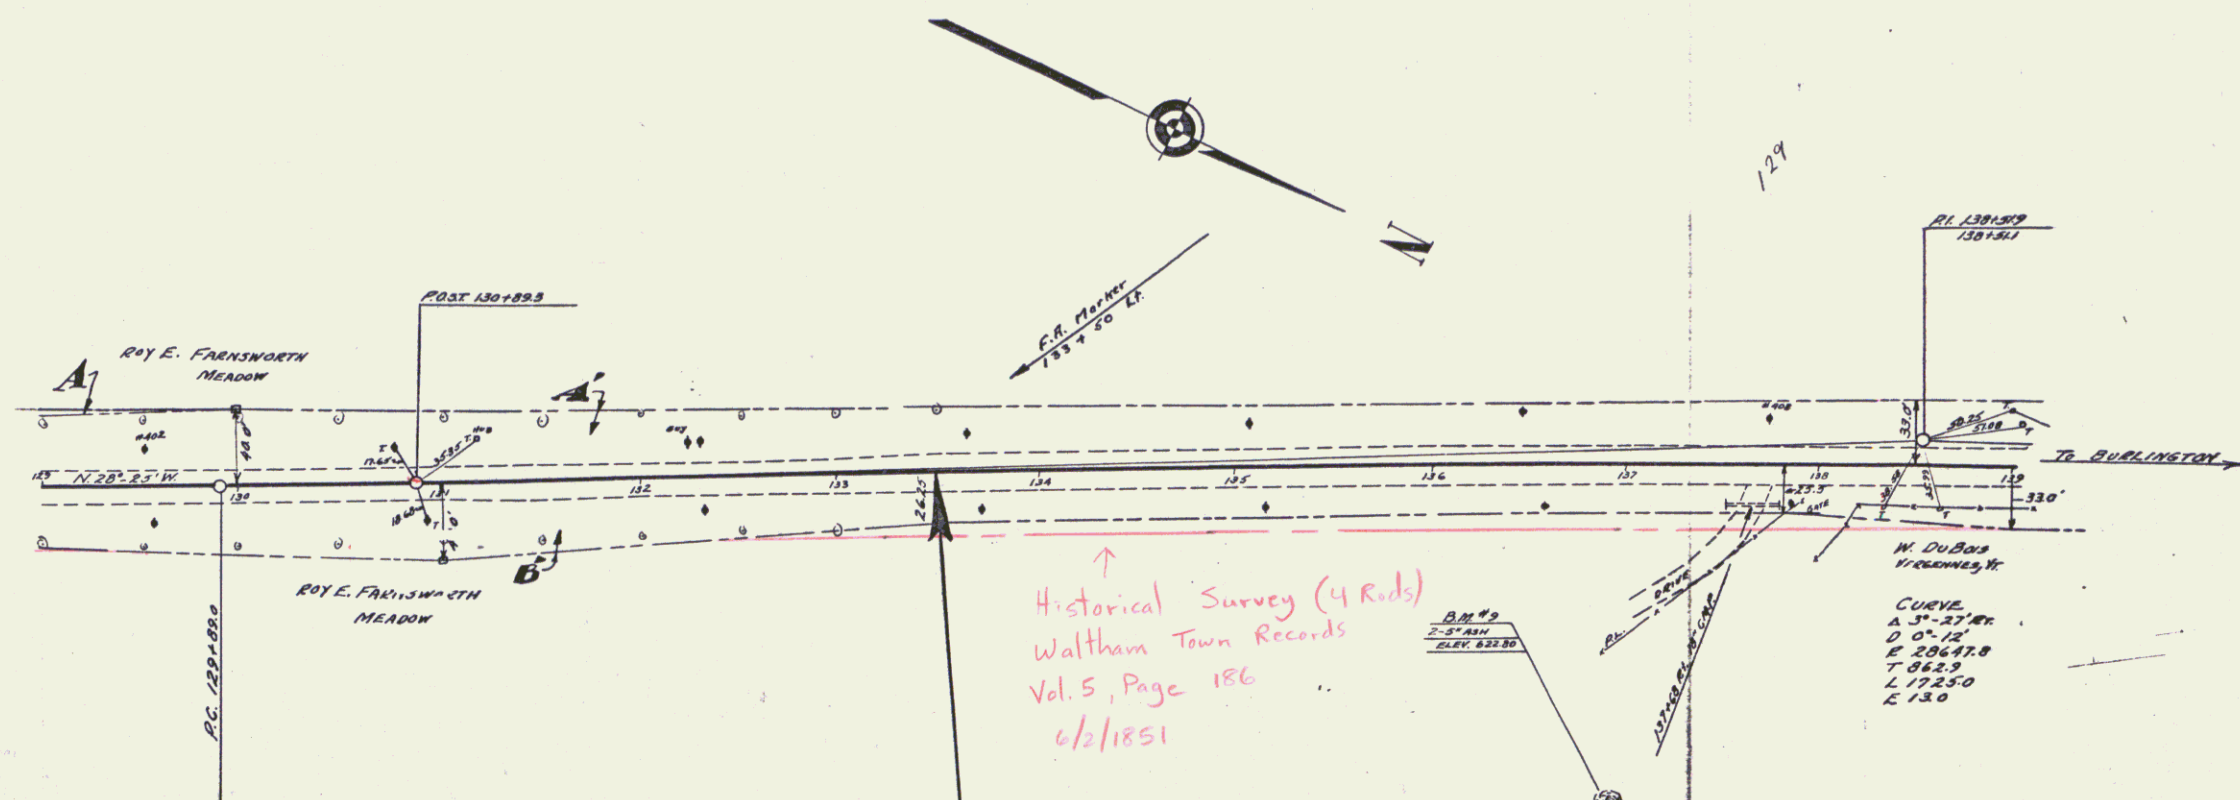

↑
Historical Survey (4 Rods)
Waltham Town Records
Vol. 5, Page 186
6/2/1851

PARCEL	INSTRUMENT	DATE	GRANTOR	GRANTEE	RECORDED	REMARKS
A	G.C.D.	7-26-37	ROY E. FARNSWORTH	"	WALTHAM BOOK PAGE DATE 136 7-31-37	

