

SECTION A
BENNINGTON COUNTY

SHEETS

SECTION B
RUTLAND COUNTY

SHEETS

STATE OF VERMONT
STATE HIGHWAY DEPARTMENT


PLAN AND PROFILE OF PROPOSED STATE HIGHWAY

TOWNS OF DORSET-MT. TABOR-DANBY

DORSET-WALLINGFORD ROAD

FROM MANCHESTER-DORSET LINE TO DANDY-WELLINGFORD LINE

SCALES { PLAN - 1 in. = 50 FT.
PROFILE - HOR. 1 in. = 50 FT. VERT. 1 in. = 10 FT.
CROSS-SECTIONS 1 in. = 5 FT.

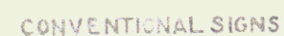

GROUND ELEVATION	DATUM	LINE
GRADE ELEVATION	DATUM	LINE

CURVE DATA	
DEFLECTION ANGLE	Δ
DEGREE OF CURVE	D.
RADIUS OF CURVE	R.
TANGENT DISTANCE	T.
LENGTH OF CURVE	L.
EXTERNAL DISTANCE	E.
POINT OF INTERSECTION	P. I
POINT OF CURVE	P. C
POINT OF TANGENT	P. T

RECORD PLANS

M P 2.473 END OF SECTION B

RIGHT-OF-WAY DIVISION

T O W N F I L E

PERPETUAL

Town of US


(To Be Returned To R.O.W. Division)

DIST. # 1 PLANS

NEW CULVERTS REQUIRED

6+23 14	23
Sta. 8+00 to 10+00 Cor. Iron Pipe	26 ft.
1-2-4 Concrete for Headwalls	10 cu yds

FED ROAD DIST NO	STATE	FED AID PROJ NO	FISCAL YEAR	SHEET NO	TOTAL SHEETS
9	VT.	12	1978-80	3	1

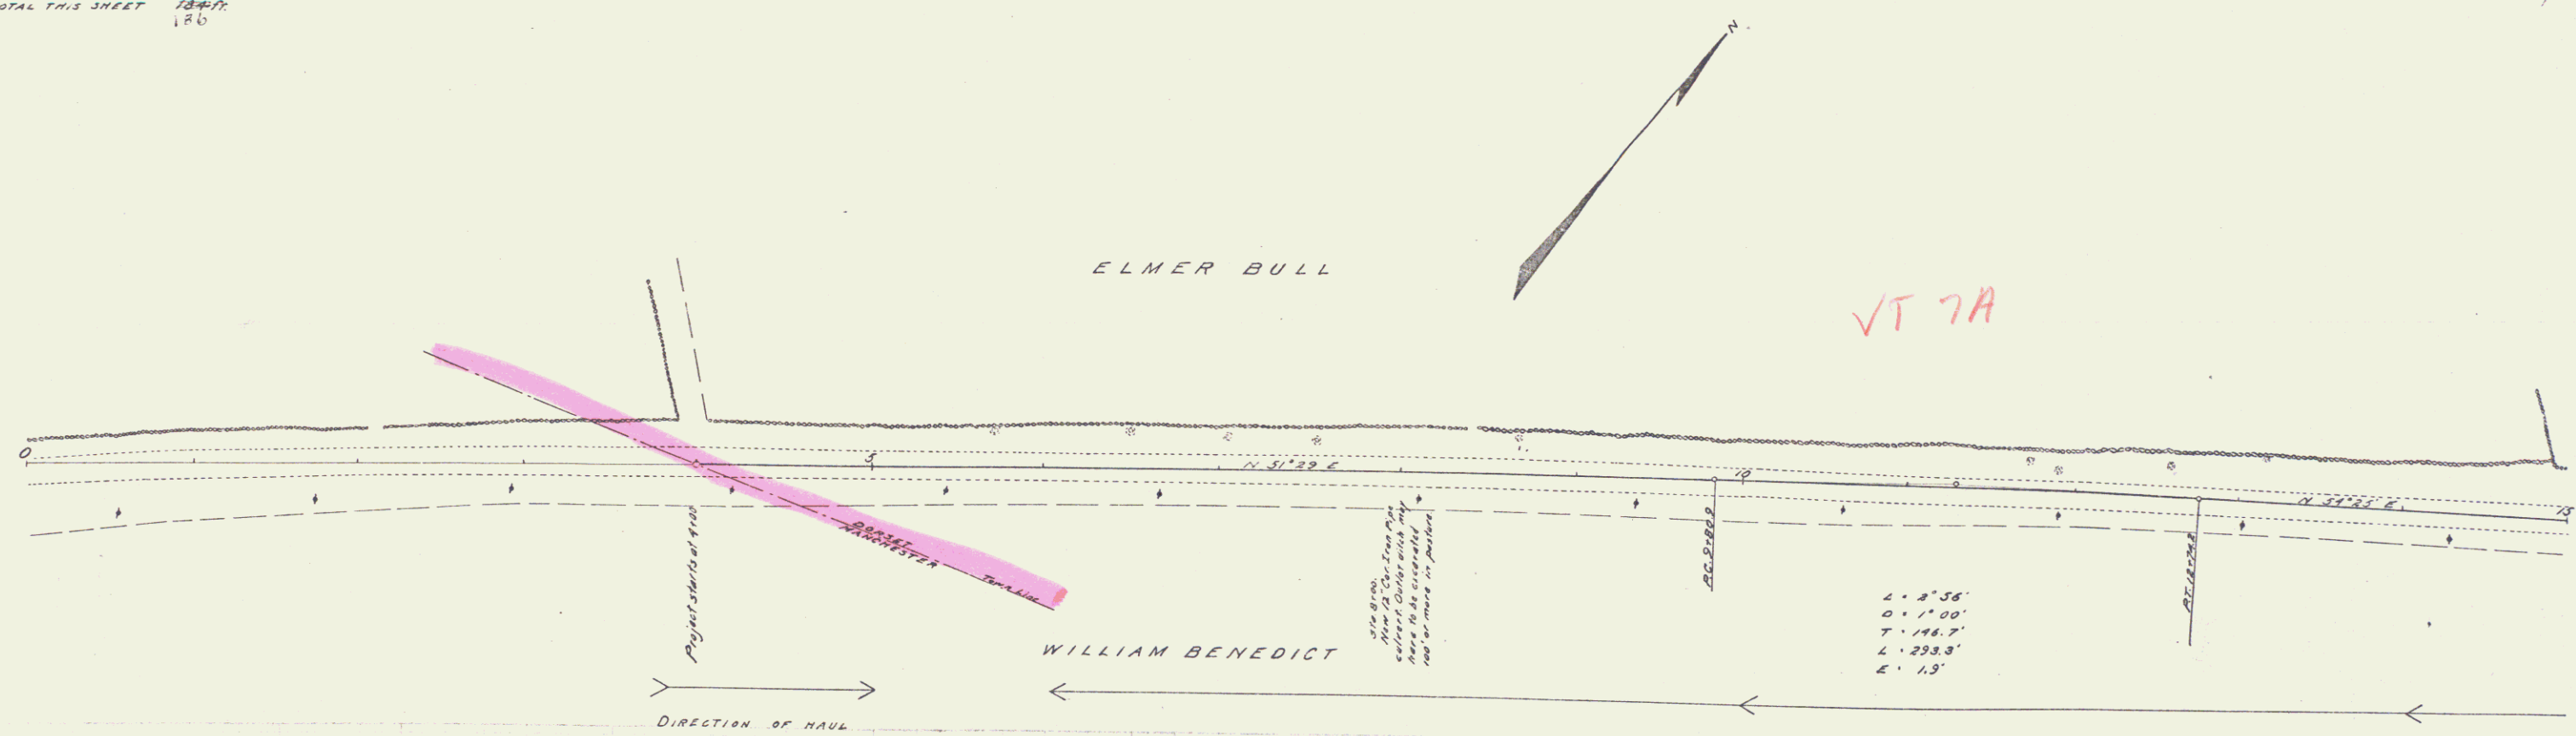


B.M. Spike in Cherry left of 13+12, Elev. 752.15

GUARD RAIL REQUIRED

NEW CULVERTS REQUIRED

TOTAL THIS SHEET 556

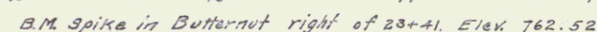

Series F No. 12 Filed
Sheet 4 of 133

GUARD RAIL REQUIRED

01-15-00 ON LEFT	206
Sta 47+00 to Sta 47+50	100'
01-15-00	9
01-15-00	36
01-15-00	47
01-15-00	16
01-15-00	68

01-15-00 ON RIGHT


Sta 47+50 to Sta 48+00	50'
01-15-00	55
01-15-00	10
01-15-00	18
01-15-00	18
01-15-00	18

TOTAL THIS SHEET 700'

01-15-00

" 43 175' 1440' 11 107


TO THIS SHEET 956

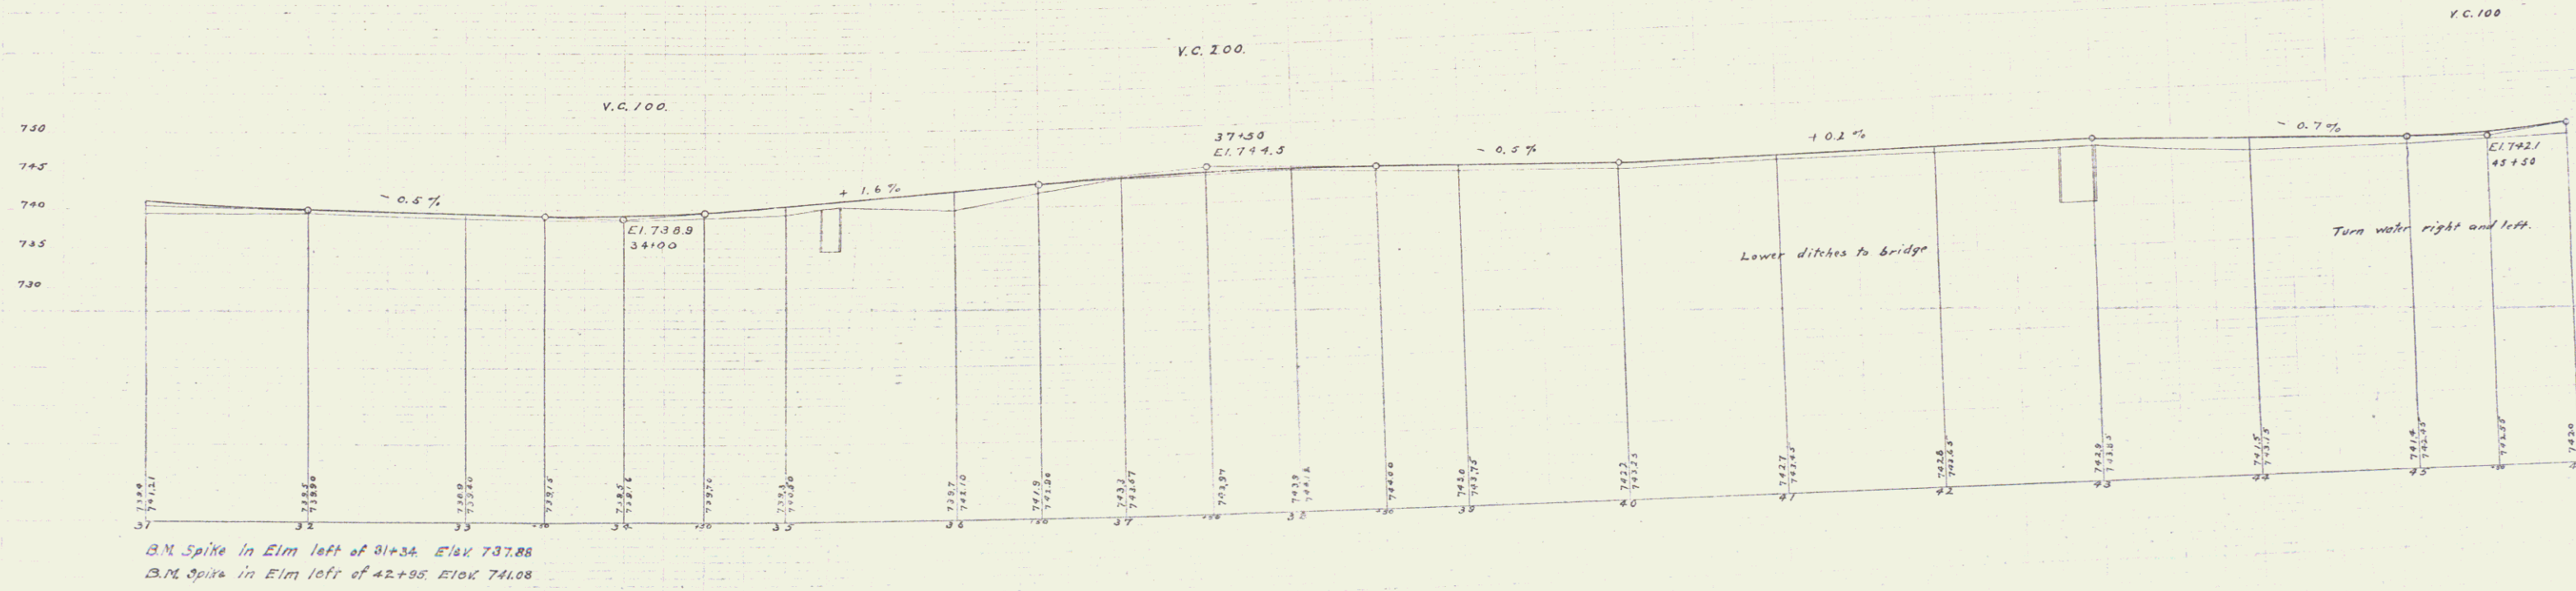


Series F No 12 Filed
Sheet 5 of 133

SECTION	STATE	FEEDING	FEEDING	FEEDING	TOTAL
8	VT.	12	10-20	6	133

W.D. 1/10/14
J.L.D. and C.D. 1/14/14

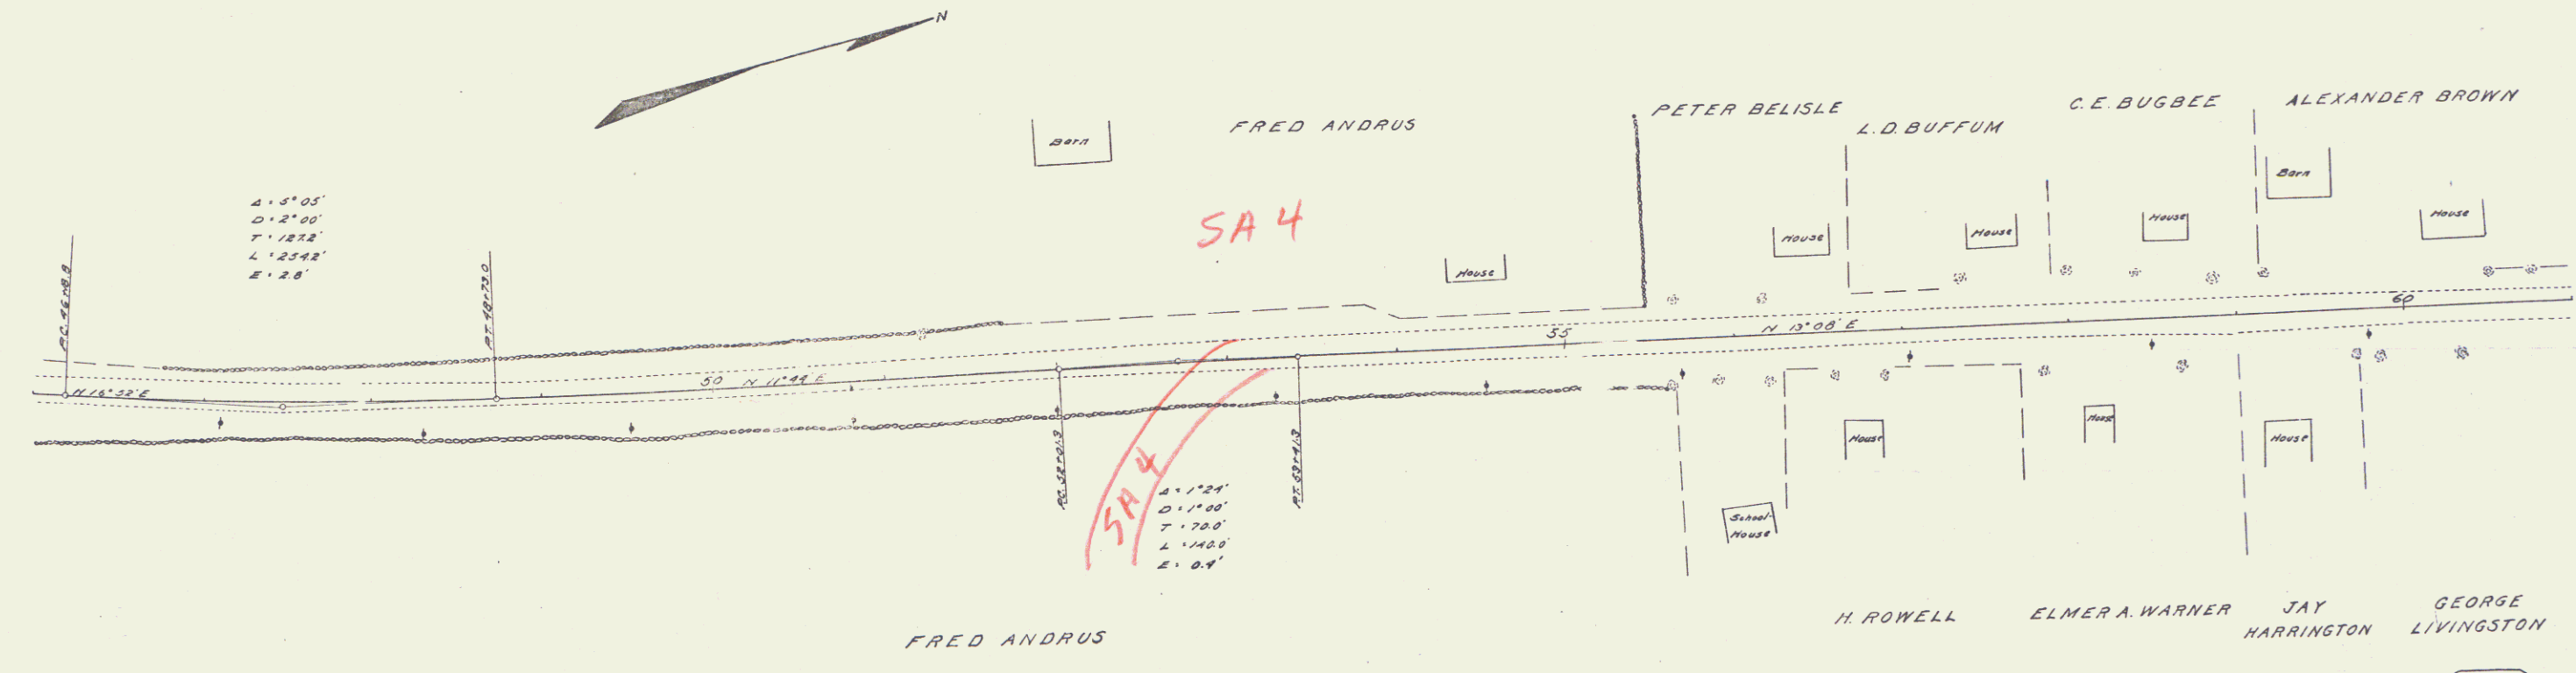

W.D. 1/10/14
J.L.D. and C.D. 1/14/14

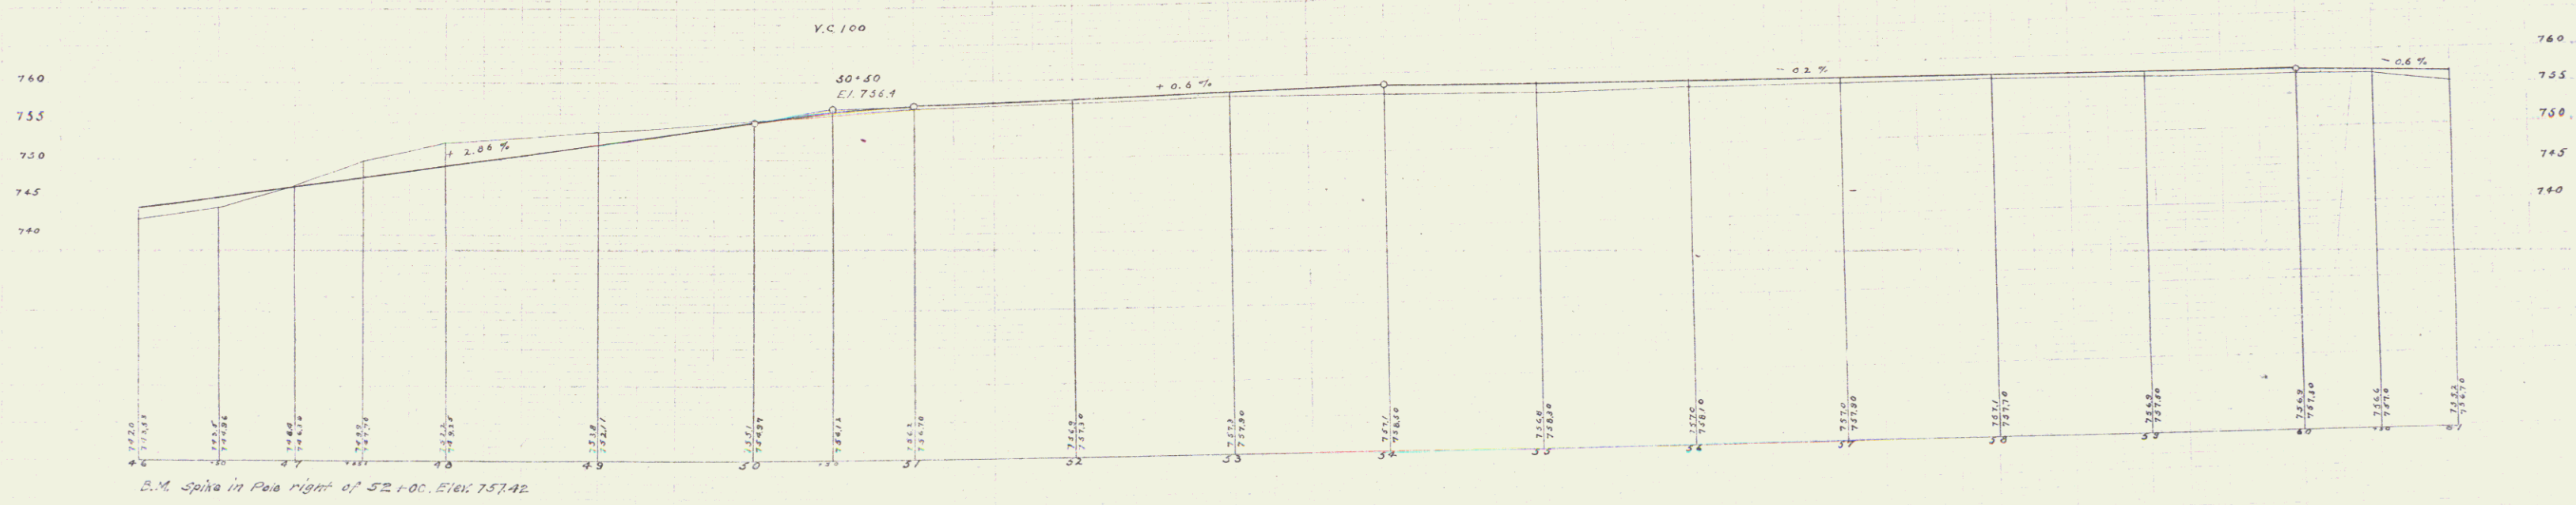

Survey F. 1/14/14
Sheet 133

GUARD RAIL REQUIRED

ON LEFT

Sta 61+24 to Sta 61+32	Length 8 ft.
61+24	8
61+25	8
61+26	8
61+27	8
61+28	8
61+29	8
61+30	8
61+31	8
61+32	8
TOTAL THIS SHEET	72

ON RIGHT

Sta 61+32 to Sta 61+40	Length 8 ft.
61+32	8
61+33	8
61+34	8
61+35	8
61+36	8
61+37	8
61+38	8
61+39	8
61+40	8
TOTAL THIS SHEET	72

TOTAL THIS SHEET 144

STONE BASE REQUIRED

Sta 61+32 to Sta 61+40 Length 8 ft.

61+32	8
61+33	8
61+34	8
61+35	8
61+36	8
61+37	8
61+38	8
61+39	8
61+40	8
TOTAL THIS SHEET	72

TOTAL THIS SHEET 144



NEW CULVERTS REQUIRED

Sta 61+32 to Sta 61+40 Length 8 ft.

12" Cor. Iron Pipe 28 ft.

Concrete Headwalls 12" 10 cu yds.

SECTION	STATE	FED. AID	FISCAL YEAR	SHEET NO.	TOTAL SHEETS
9	VT	12	1940-41	7	133

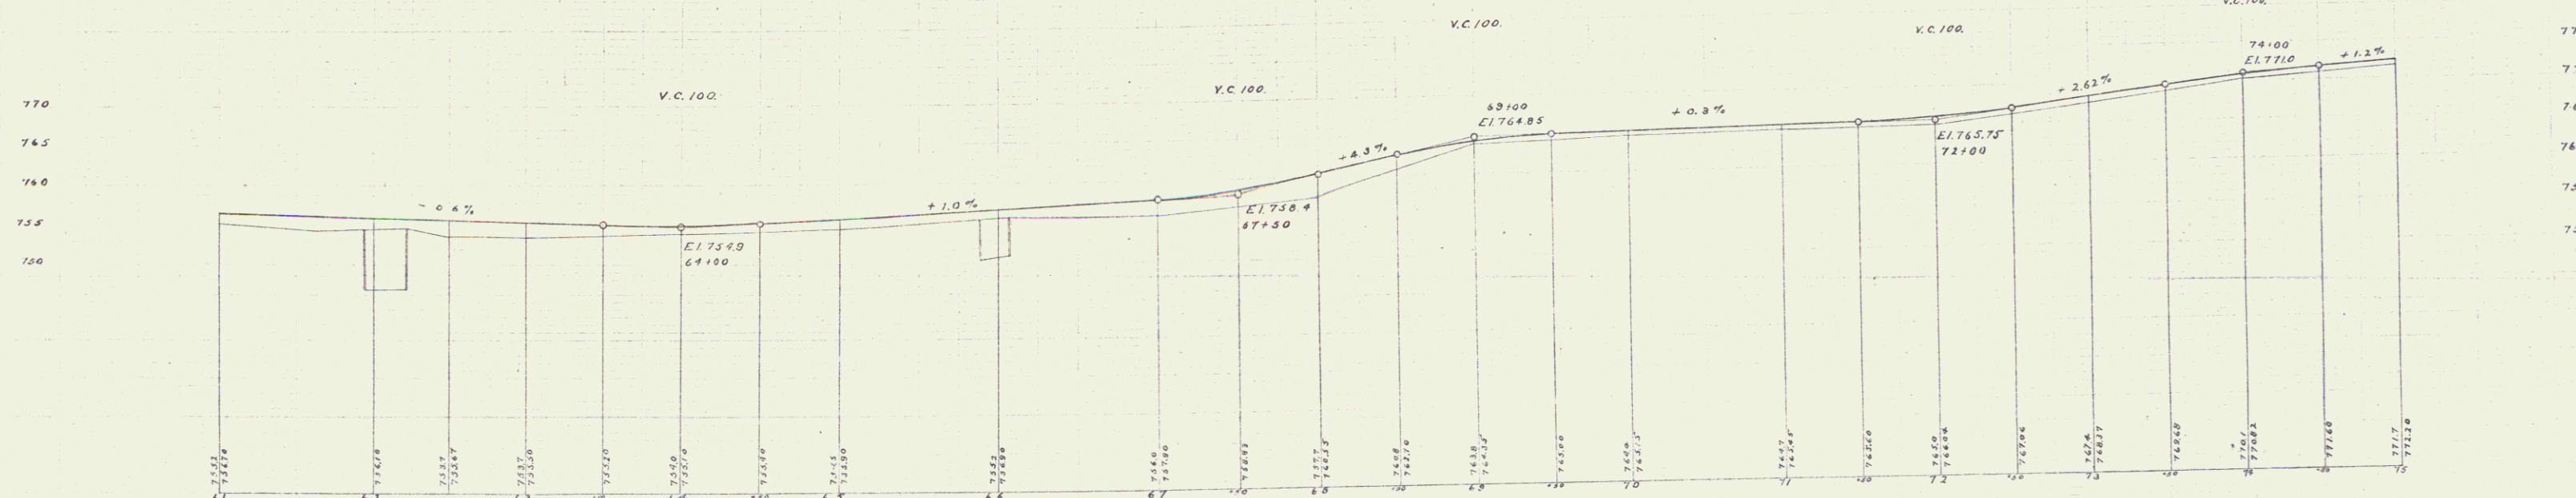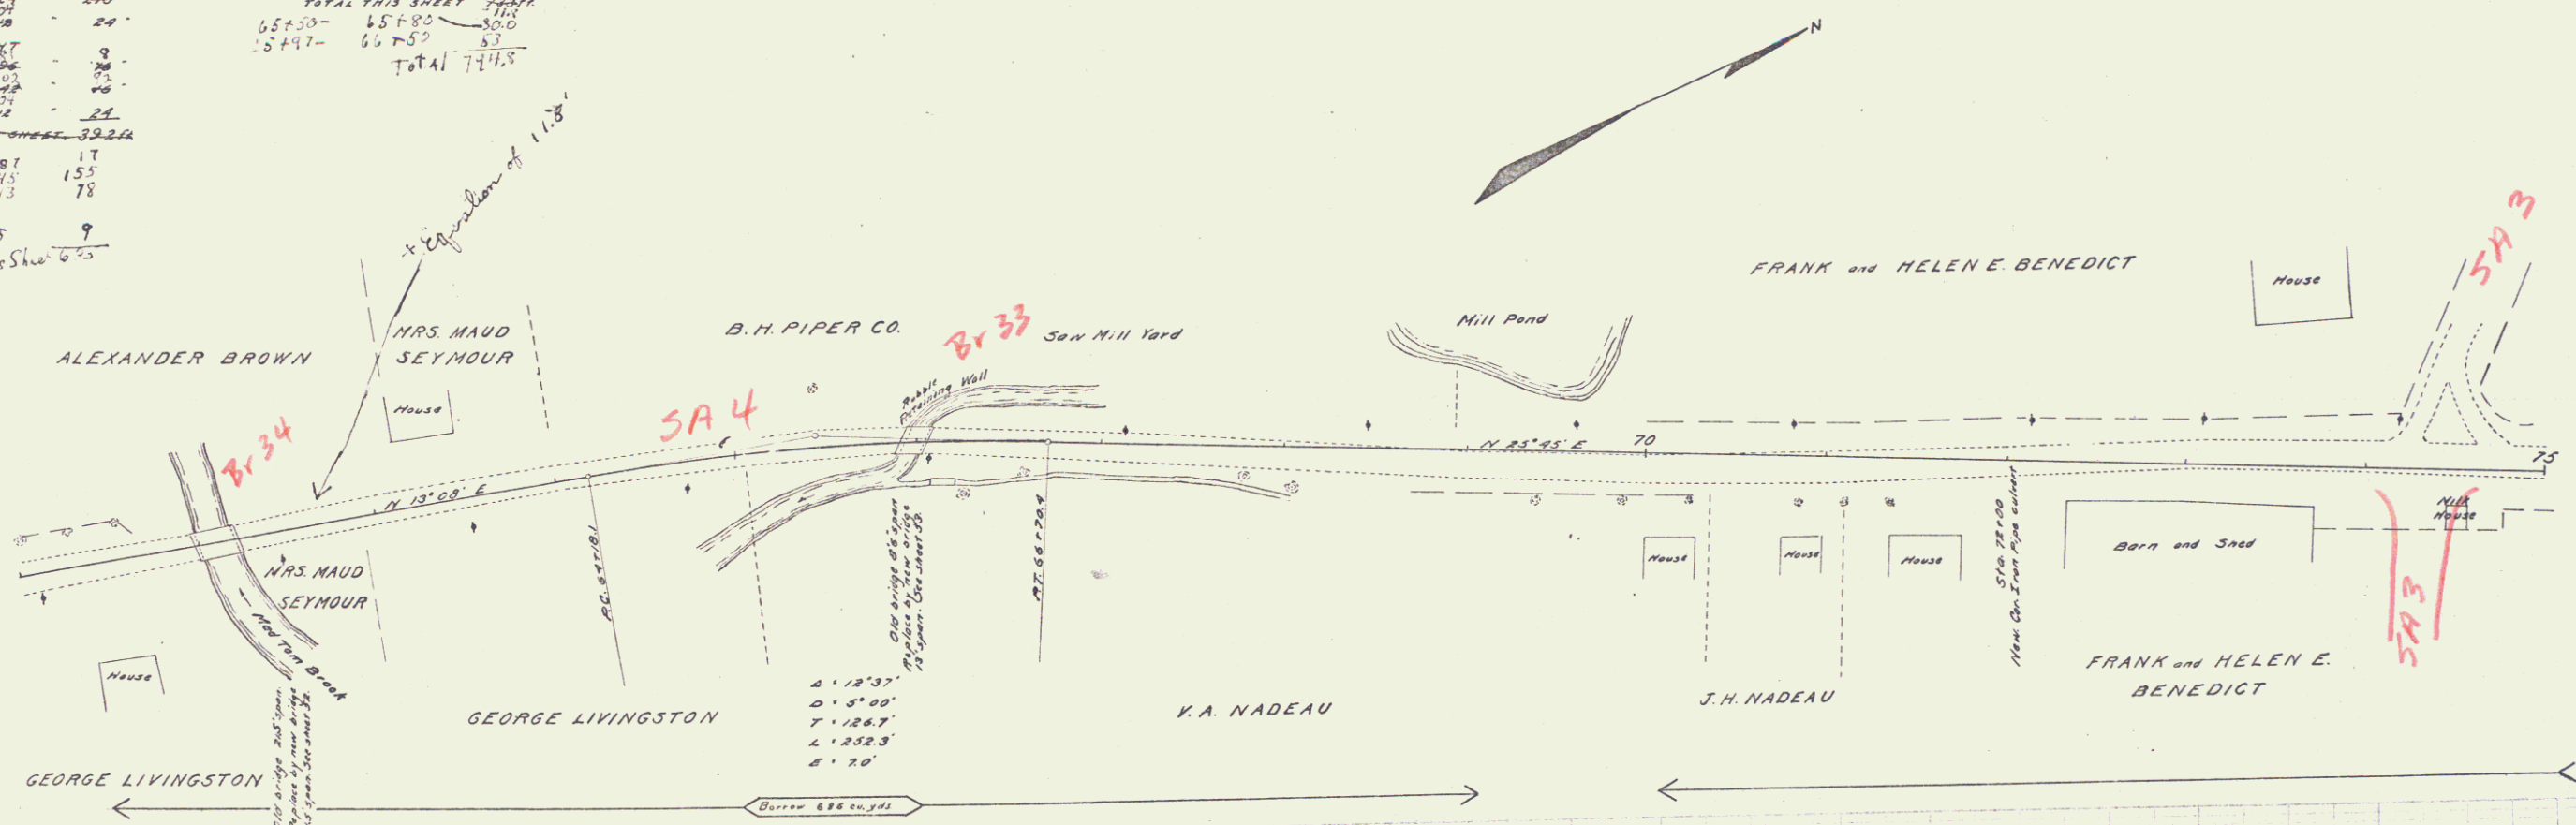

B.M. Spike in Elm clump right of 66+20. Elev. 754.18

B.M. Marble Post N. of gate left of 73+77. Elev. 771.00

Survey of Road, Filed Sheet 7, 1940



GUARD RAIL REQUIRED
 ON RIGHT
 STA 80+00 TO 80+120 < 49% 20ft
 ON LEFT
 STA 80+00 TO 80+120 20 ft
 TOTAL THIS SIDE 40ft.

PROJECT NO.	STATE	FED. AID	DATE	SHEET NO.	TOTAL SHEETS
9	VT	12	1918-21	0	133

FRANK and HELEN E. BENEDICT

LOUIS NOREAU

FRANK and HELEN E. BENEDICT

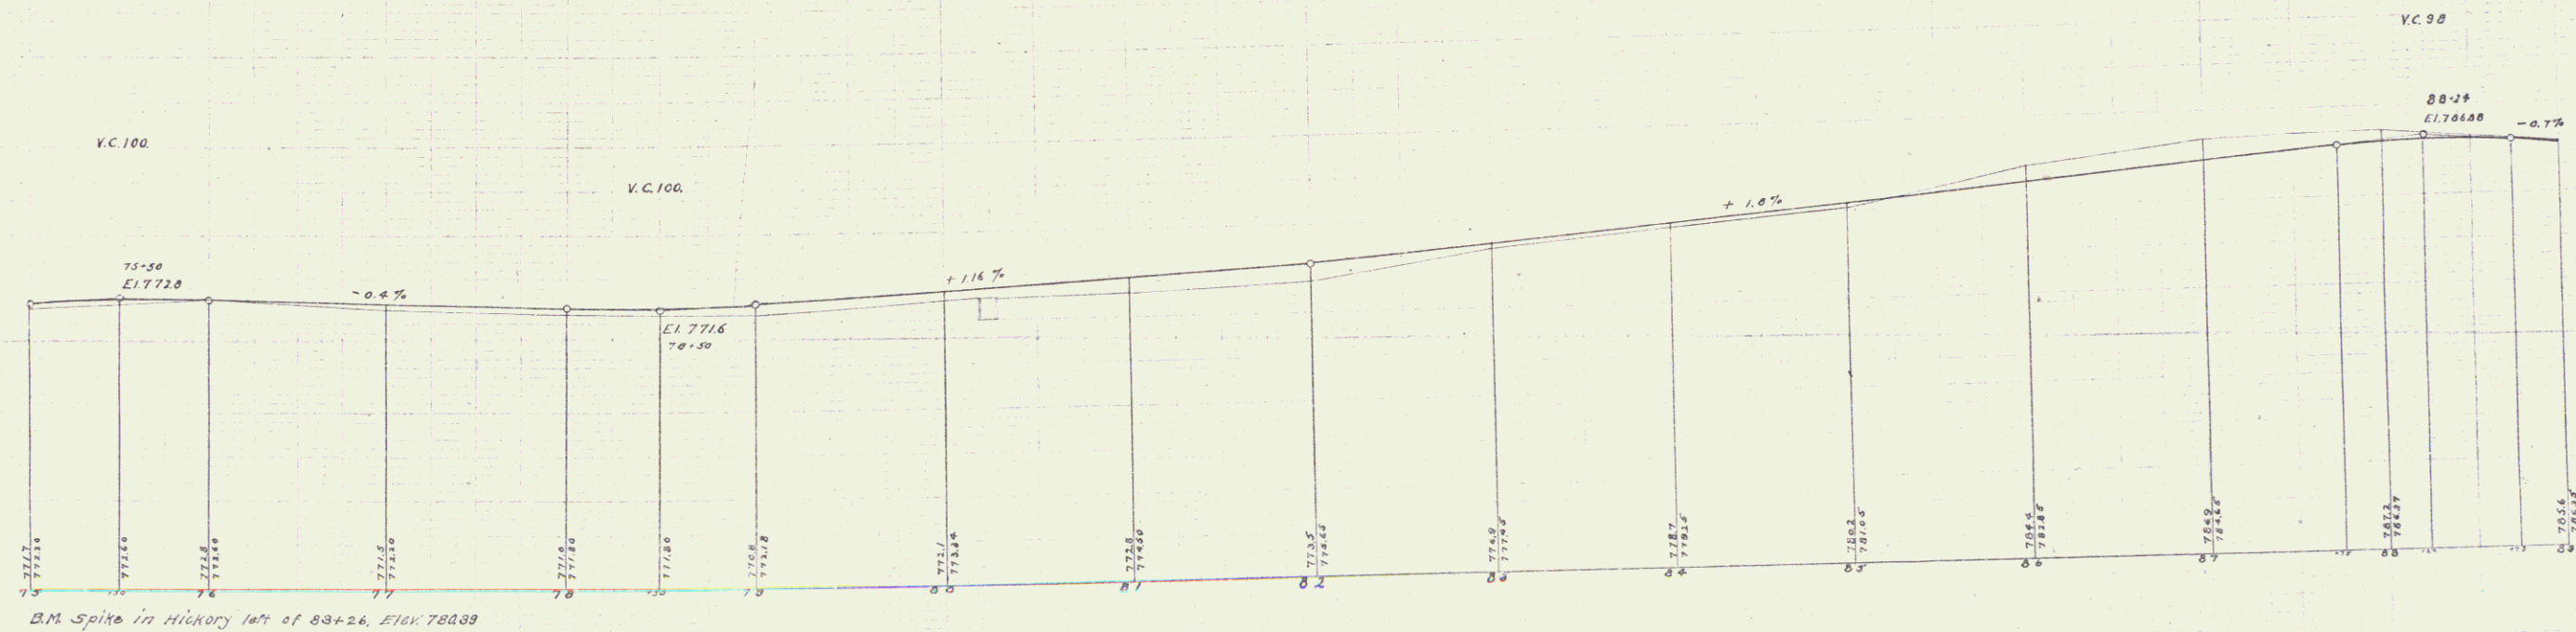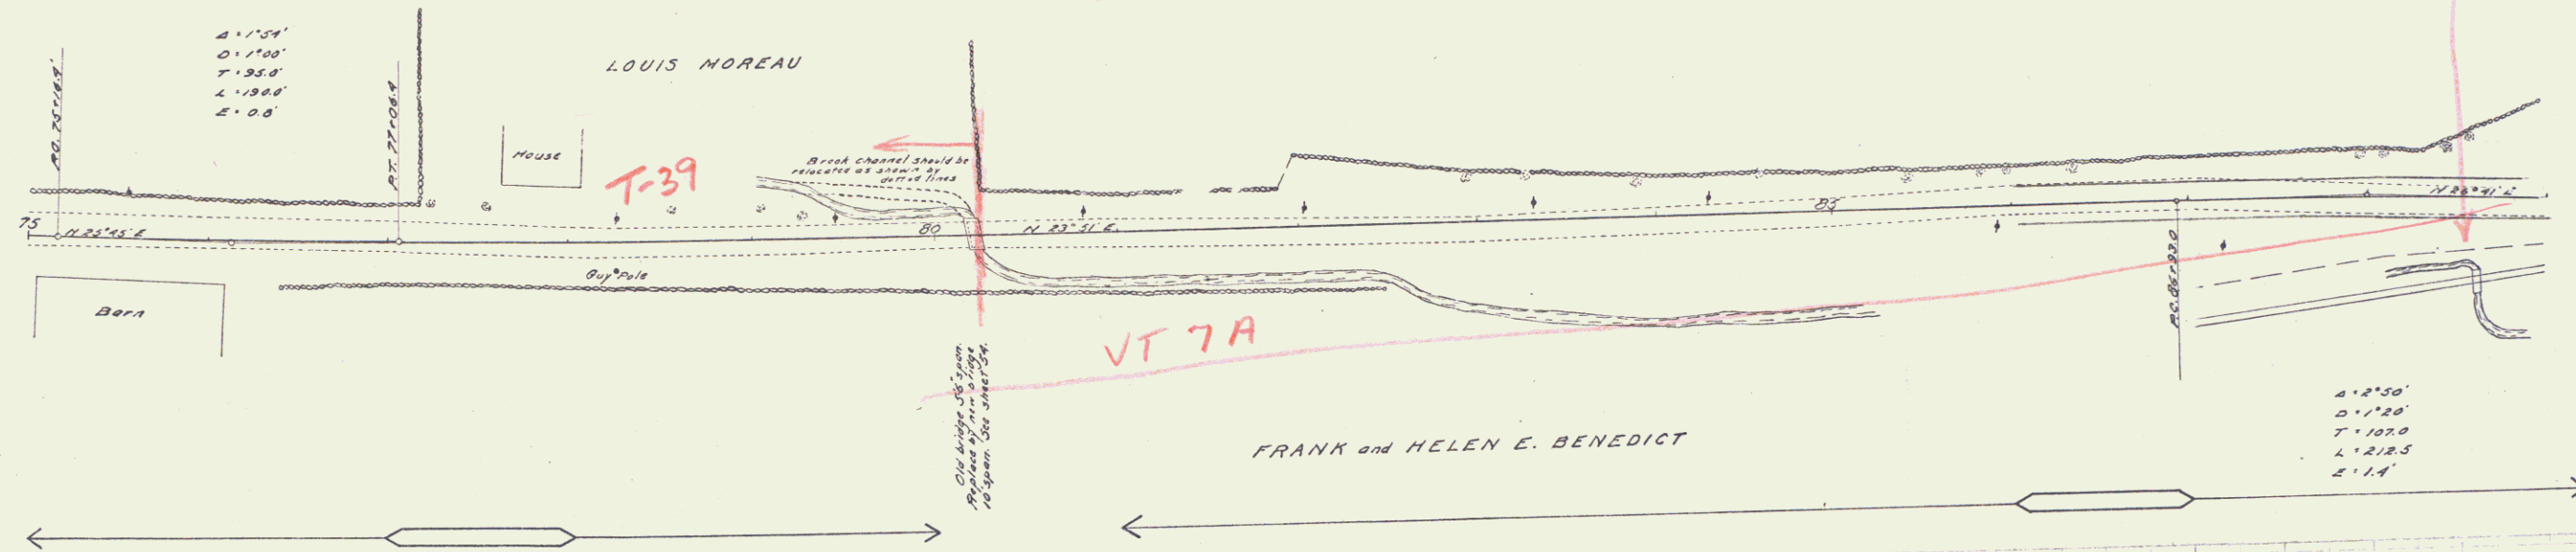

Series F. No. 13, Filed
 August 1, 1921

GUARD RAIL REQUIRED ON LEFT

Sta 31+32 to 31+38	Length 66 ft	
31+32	31+38	19'
31+38	31+44	6'
31+44	31+50	6'
31+50	31+56	6'
31+56	31+62	6'
31+62	31+68	6'
31+68	31+74	6'
31+74	31+80	6'
31+80	31+86	6'
31+86	31+92	6'
31+92	31+98	6'
31+98	32+04	6'
32+04	32+10	6'
32+10	32+16	6'
32+16	32+22	6'
32+22	32+28	6'
32+28	32+34	6'
32+34	32+40	6'
32+40	32+46	6'
32+46	32+52	6'
32+52	32+58	6'
32+58	32+64	6'
32+64	32+70	6'
32+70	32+76	6'
32+76	32+82	6'
32+82	32+88	6'
32+88	32+94	6'
32+94	33+00	6'
33+00	33+06	6'
33+06	33+12	6'
33+12	33+18	6'
33+18	33+24	6'
33+24	33+30	6'
33+30	33+36	6'
33+36	33+42	6'
33+42	33+48	6'
33+48	33+54	6'
33+54	33+60	6'
33+60	33+66	6'
33+66	33+72	6'
33+72	33+78	6'
33+78	33+84	6'
33+84	33+90	6'
33+90	33+96	6'
33+96	34+02	6'
34+02	34+08	6'
34+08	34+14	6'
34+14	34+20	6'
34+20	34+26	6'
34+26	34+32	6'
34+32	34+38	6'
34+38	34+44	6'
34+44	34+50	6'
34+50	34+56	6'
34+56	34+62	6'
34+62	34+68	6'
34+68	34+74	6'
34+74	34+80	6'
34+80	34+86	6'
34+86	34+92	6'
34+92	34+98	6'
34+98	35+04	6'
35+04	35+10	6'
35+10	35+16	6'
35+16	35+22	6'
35+22	35+28	6'
35+28	35+34	6'
35+34	35+40	6'
35+40	35+46	6'
35+46	35+52	6'
35+52	35+58	6'
35+58	35+64	6'
35+64	35+70	6'
35+70	35+76	6'
35+76	35+82	6'
35+82	35+88	6'
35+88	35+94	6'
35+94	36+00	6'
36+00	36+06	6'
36+06	36+12	6'
36+12	36+18	6'
36+18	36+24	6'
36+24	36+30	6'
36+30	36+36	6'
36+36	36+42	6'
36+42	36+48	6'
36+48	36+54	6'
36+54	36+60	6'
36+60	36+66	6'
36+66	36+72	6'
36+72	36+78	6'
36+78	36+84	6'
36+84	36+90	6'
36+90	36+96	6'
36+96	37+02	6'
37+02	37+08	6'
37+08	37+14	6'
37+14	37+20	6'
37+20	37+26	6'
37+26	37+32	6'
37+32	37+38	6'
37+38	37+44	6'
37+44	37+50	6'
37+50	37+56	6'
37+56	37+62	6'
37+62	37+68	6'
37+68	37+74	6'
37+74	37+80	6'
37+80	37+86	6'
37+86	37+92	6'
37+92	37+98	6'
37+98	38+04	6'
38+04	38+10	6'
38+10	38+16	6'
38+16	38+22	6'
38+22	38+28	6'
38+28	38+34	6'
38+34	38+40	6'
38+40	38+46	6'
38+46	38+52	6'
38+52	38+58	6'
38+58	38+64	6'
38+64	38+70	6'
38+70	38+76	6'
38+76	38+82	6'
38+82	38+88	6'
38+88	38+94	6'
38+94	39+00	6'
39+00	39+06	6'
39+06	39+12	6'
39+12	39+18	6'
39+18	39+24	6'
39+24	39+30	6'
39+30	39+36	6'
39+36	39+42	6'
39+42	39+48	6'
39+48	39+54	6'
39+54	39+60	6'
39+60	39+66	6'
39+66	39+72	6'
39+72	39+78	6'
39+78	39+84	6'
39+84	39+90	6'
39+90	39+96	6'
39+96	40+02	6'
40+02	40+08	6'
40+08	40+14	6'
40+14	40+20	6'
40+20	40+26	6'
40+26	40+32	6'
40+32	40+38	6'
40+38	40+44	6'
40+44	40+50	6'
40+50	40+56	6'
40+56	40+62	6'
40+62	40+68	6'
40+68	40+74	6'
40+74	40+80	6'
40+80	40+86	6'
40+86	40+92	6'
40+92	40+98	6'
40+98	41+04	6'
41+04	41+10	6'
41+10	41+16	6'
41+16	41+22	6'
41+22	41+28	6'
41+28	41+34	6'
41+34	41+40	6'
41+40	41+46	6'
41+46	41+52	6'
41+52	41+58	6'
41+58	41+64	6'
41+64	41+70	6'
41+70	41+76	6'
41+76	41+82	6'
41+82	41+88	6'
41+88	41+94	6'
41+94	42+00	6'
42+00	42+06	6'
42+06	42+12	6'
42+12	42+18	6'
42+18	42+24	6'
42+24	42+30	6'
42+30	42+36	6'
42+36	42+42	6'
42+42	42+48	6'
42+48	42+54	6'
42+54	42+60	6'
42+60	42+66	6'
42+66	42+72	6'
42+72	42+78	6'
42+78	42+84	6'
42+84	42+90	6'
42+90	42+96	6'
42+96	43+02	6'
43+02	43+08	6'
43+08	43+14	6'
43+14	43+20	6'
43+20	43+26	6'
43+26	43+32	6'
43+32	43+38	6'
43+38	43+44	6'
43+44	43+50	6'
43+50	43+56	6'
43+56	43+62	6'
43+62	43+68	6'
43+68	43+74	6'
43+74	43+80	6'
43+80	43+86	6'
43+86	43+92	6'
43+92	43+98	6'
43+98	44+04	6'
44+04	44+10	6'
44+10	44+16	6'
44+16	44+22	6'
44+22	44+28	6'
44+28	44+34	6'
44+34	44+40	6'
44+40	44+46	6'
44+46	44+52	6'
44+52	44+58	6'
44+58	44+64	6'
44+64	44+70	6'
44+70	44+76	6'
44+76	44+82	6'
44+82	44+88	6'
44+88	44+94	6'
44+94	45+00	6'
45+00	45+06	6'
45+06	45+12	6'
45+12	45+18	6'
45+18	45+24	6'
45+24	45+30	6'
45+30	45+36	6'
45+36	45+42	6'
45+42	45+48	6'
45+48	45+54	6'
45+54	45+60	6'
45+60	45+66	6'
45+66	45+72	6'
45+72	45+78	6'
45+78	45+84	6'
45+84	45+90	6'
45+90	45+96	6'
45+96	46+02	6'
46+02	46+08	6'
46+08	46+14	6'
46+14	46+20	6'
46+20	46+26	6'
46+26	46+32	6'
46+32	46+38	6'
46+38	46+44	6'
46+44	46+50	6'
46+50	46+56	6'
46+56	46+62	6'
46+62	46+68	6'
46+68	46+74	6'
46+74	46+80	6'
46+80	46+86	6'
46+86	46+92	6'
46+92	46+98	6'
46+98	47+04	6'
47+04	47+10	6'
47+10	47+16	6'
47+16	47+22	6'
47+22	47+28	6'
47+28	47+34	6'
47+34	47+40	6'
47+40	47+46	6'
47+46	47+52	6'
47+52	47+58	6'
47+58	47+64	6'
47+64	47+70	6'
47+70	47+76	6'
47+76	47+82	6'
47+82	47+88	6'
47+88	47+94	6'
47+94	48+00	6'
48+00	48+06	6'
48+06	48+12	6'
48+12	48+18	6'
48+18	48+24	6'
48+24	48+30	6'
48+30	48+36	6'
48+36	48+42	6'
48+42	48+48	6'
48+48	48+54	6'
48+54	48+60	6'
48+60	48+66	6'
48+66	48+72	6'
48+72	48+78	6'
48+78	48+84	6'
48+84	48+90	6'
48+90	48+96	6'
48+96	49+02	6'
49+02	49+08	6'
49+08	49+14	6'
49+14	49+20	6'
49+20	49+26	6'
49+26	49+32	6'
49+32	49+38	6'
49+38	49+44	6'
49+44	49+50	6'
49+50	49+56	6'
49+56	49+62	6'
49+62	49+68	6'
49+68	49+74	6'
49+74	49+80	6'
49+80	49+86	6'
49+86	49+92	6'
49+92	49+98	6'
49+98	50+04	6'
50+04	50+10	6'
50+10	50+16	6'
50+16	50+22	6'
50+22	50+28	6'
50+28	50+34	6'
50+34	50+40	6'
50+40	50+46	6'
50+46	50+52	6'
50+52	50+58	6'
50+58	50+64	6'
50+64	50+70	6'
50+70	50+76	6'
50+76	50+82	6'
50+82	50+88	6'
50+88	50+94	6'
50+94	51+00	6'
51+00	51+06	6'
51+06	51+12	6'
51+12	51+18	6'
51+18	51+24	6'
51+24	51+30	6'
51+30	51+36	6'
51+36	51+42	6'
51+42	51+48	6'
51+48	51+54	6'
51+54	51+60	6'
51+60	51+66	6'
51+66	51+72	6'
51+72	51+78	6'
51+78	51+84	6'
51+84	51+90	6'
51+90	51+96	6'
51+96	52+02	6'
52+02	52+08	6'
52+08	52+14	6'
52+14	52+20	6'
52+20	52+26	6'
52+26	52+32	6'
52+32	52+38	6'
52+38	52+44	6'
52+44	52+50	6'
52+50	52+56	6'
52+56	52+62	6'
52+62	52+68	6'
52+68	52+74	6'
52+74	52+80	6'
52+80	52+86	6'
52+86	52+92	6'
52+92	52+98	6'
52+98	53+04	6'
53+04	53+10	6'
53+10	53+16	6'
53+16	53+22	6'
53+22	53+28	6'
53+28	53+34	6'
53+34	53+40	6'
53+40	53+46	6'
53+46	53+52	6'
53+52	53+58	6'
53+58	53+64	6'
53+64	53+70	6'
53+70	53+76	6'
53+76	53+82	6'
53+82	53+88	6'
53+88	53+94	6'
53+94	54+00	6'
54+00	54+06	6'
54+06	54+12	6'
54+12	54+18	6'
54+18	54+24	6'
54+24	54+30	6'
54+30		

LEACHING BASINS REQUIRED

1 on Left of Sta 118+25.2

GUARD RAIL REQUIRED



ON LEFT

Sta	To Sta	Length	Feet
107+70	107+80	10	10
107+80	107+86	6	6
107+86	107+90	4	4
107+90	107+94	4	4
107+94	107+98	4	4
107+98	108+00	2	2
Total This Sheet			64

REQUIRED Wings ON
Old Bridge at Sta. 107+80

1-3-6 Concrete 3.9 Du Yds

PER INCH	STATE	FO. AND FISCAL	SHEET	TOTAL
DIFF. NO.	YR.	PROJ. NO.	NO.	SHEET
9	YR.	12	100-10	133

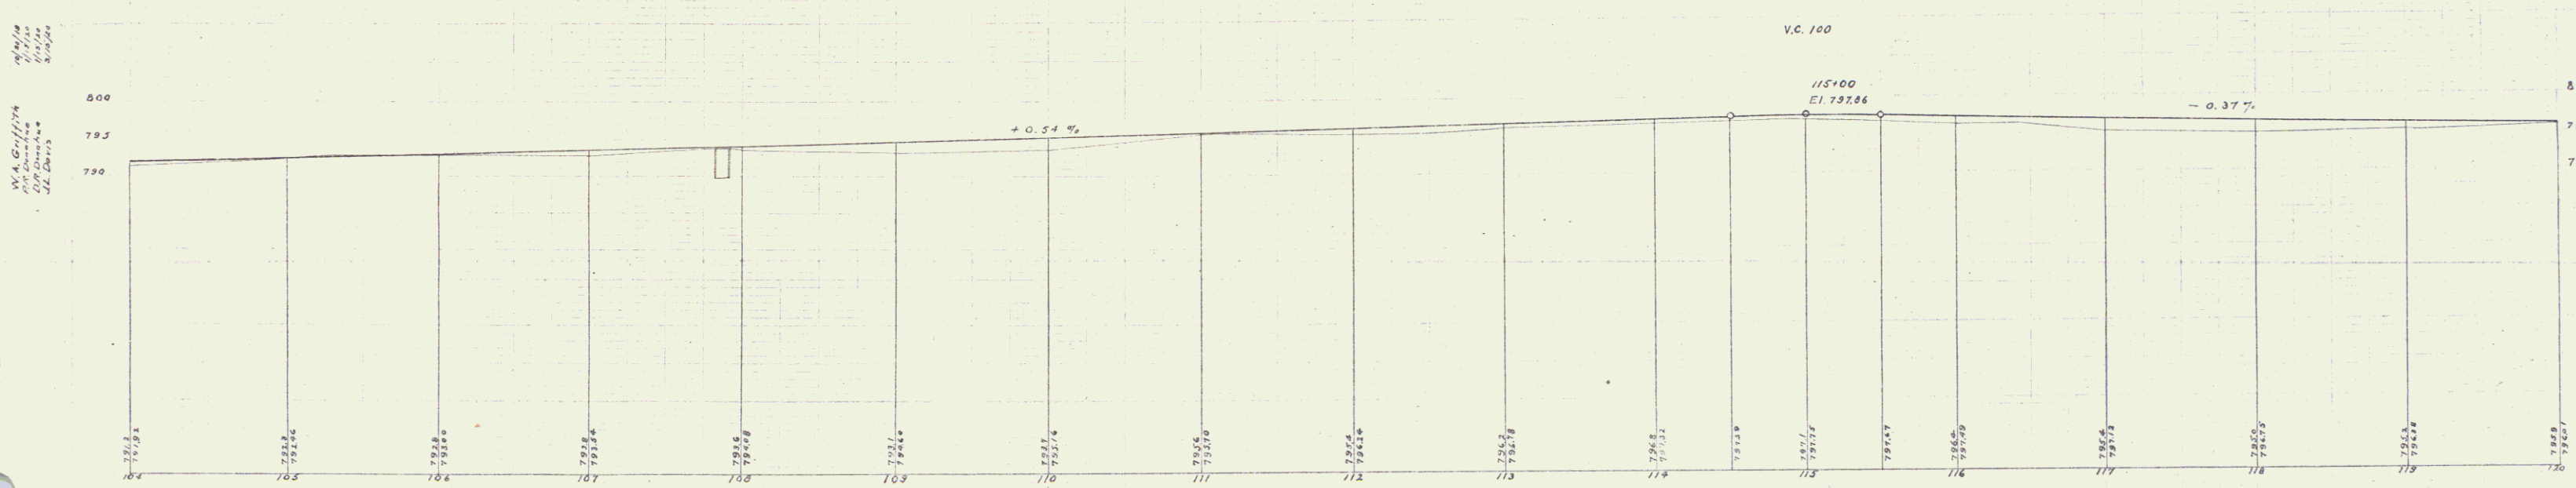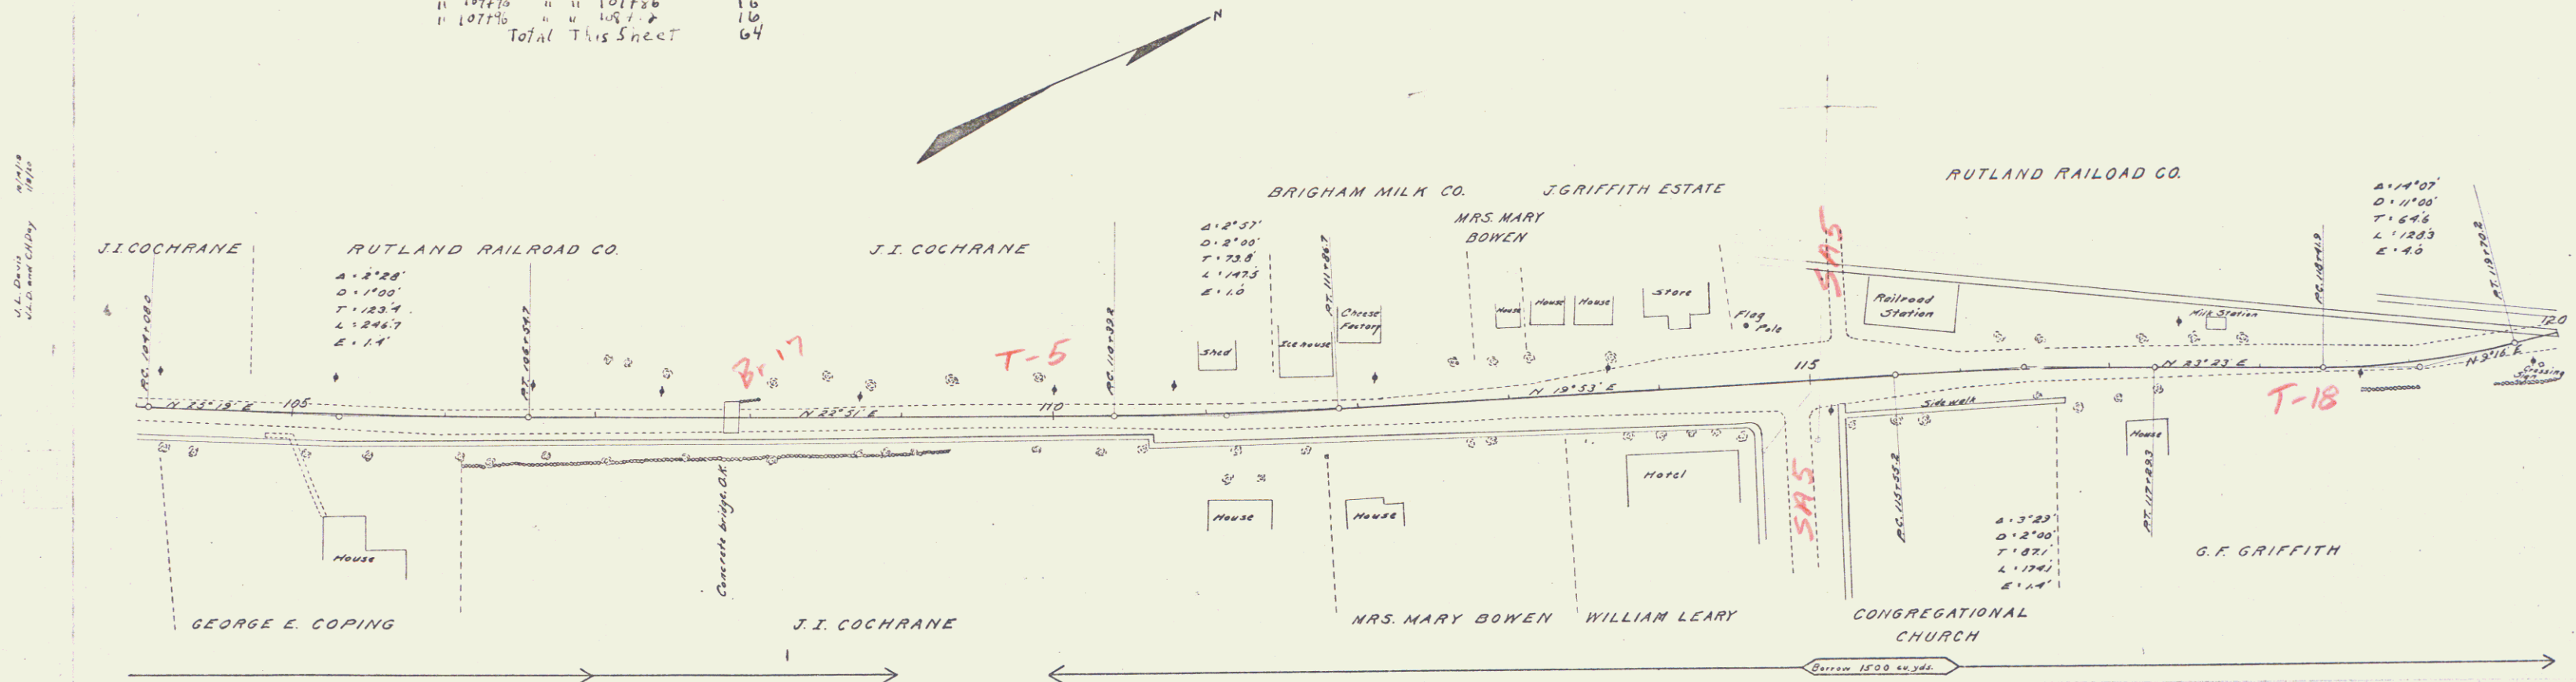



B.M. Center of Wheel Guard at S. End of Concrete bridge right of 107+83. Elev. 794.09
B.M. NE Corner of Marble Base, 1-9 wide, of Water trough left of 114+93 Elev. 796.29

Series F. 100-10, Filed
Sheet 100 of 133

CULVERT REPAIRS REQUIRED

Sta 124+65	18" Cor. Iron Pipe	32 ft.
	12'-9" Concrete Headwalls	46 cu yds.
134+89	14" Cor. Iron Pipe	36 ft.
	12'-9" Concrete Headwalls	10 cu yds.

FED. ROAD DIST. NO.	STATE	FED. AID PROJ. NO.	FISCAL YEAR	SHEET NO.	TOTAL SHEET
9	YT.	12	1919-20	11	133

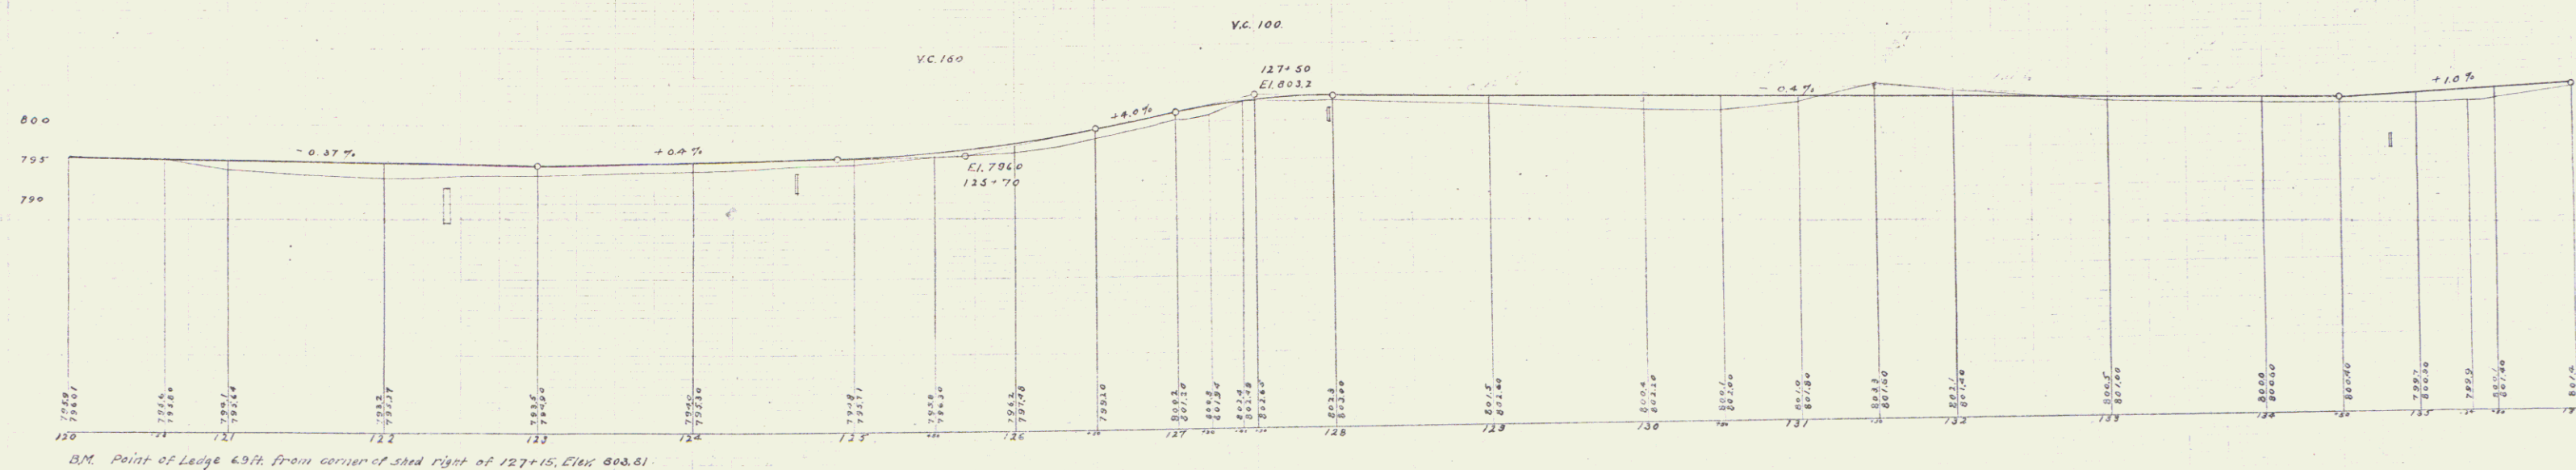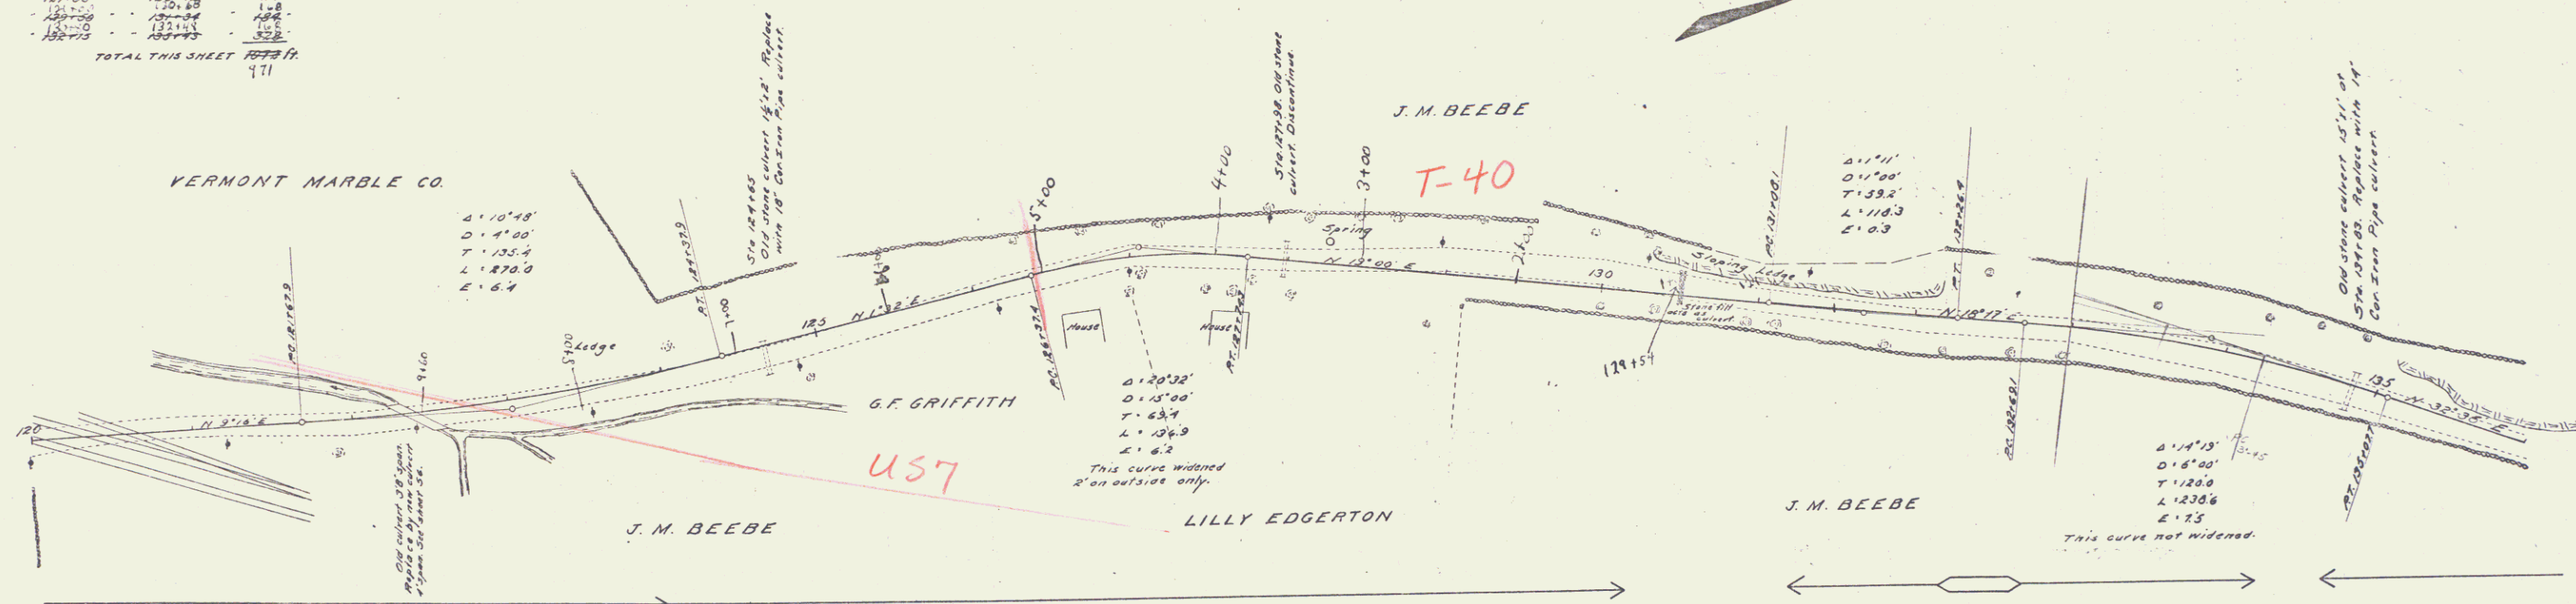

B.M. Point of Ledge 69 ft. from corner of shed right of 127+15; Elev. 803.81

Series F No 12 File
Sheet 11 of 13

GUARD RAIL REQUIRED

ON LEFT	ON RIGHT
Sta 136+00 to Sta 136+25 Length 25 ft.	
136+00 - 136+05 24'	
136+05 - 136+10 24'	
136+10 - 136+15 24'	
136+15 - 136+20 24'	
136+20 - 136+25 24'	
TOTAL THIS SHEET 120 ft.	



CULVERT REPAIRS REQUIRED

Sta 136+70	2'-2" Reinforced Concrete	28 ft.
	12" x 4" Concrete Headwalls	20 cu yds.
	13" x 6" Concrete	13
	Steel	82 lbs.
Sta 141+62	12" x 4" Concrete	37
	13" x 6" Concrete	23
	Steel	75 lbs.
	Cast Iron Grate	1
Sta 145+00	4' x 8" Reinforced Concrete	28' 8"
	12" x 4" Concrete Headwalls	20 cu yds.
	13" x 6" Concrete	13
	Steel	79 lbs.

FED. ROAD DIST. NO.	STATE	PROJECT NO.	SECTION	SHEET NO.	TOTAL SHEETS
0	VT.	12	12	12	123

SLIDING CLAY 1942

W.A. Sullivan
J.P. Sullivan
D.L. Sullivan
G. Sullivan

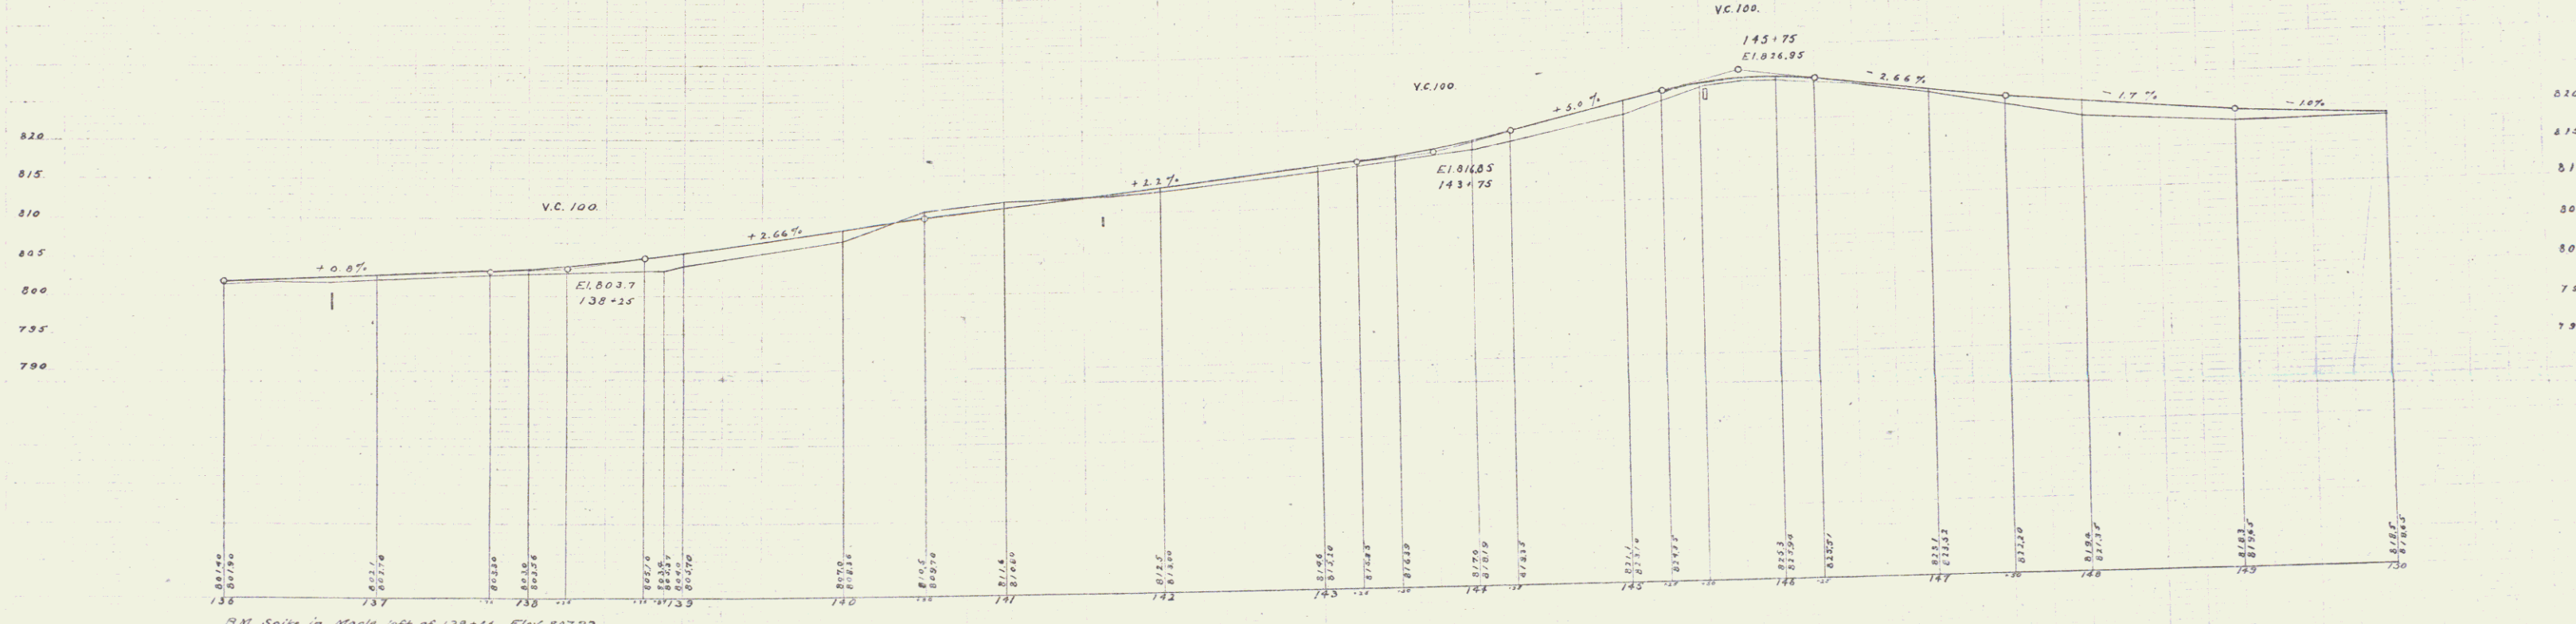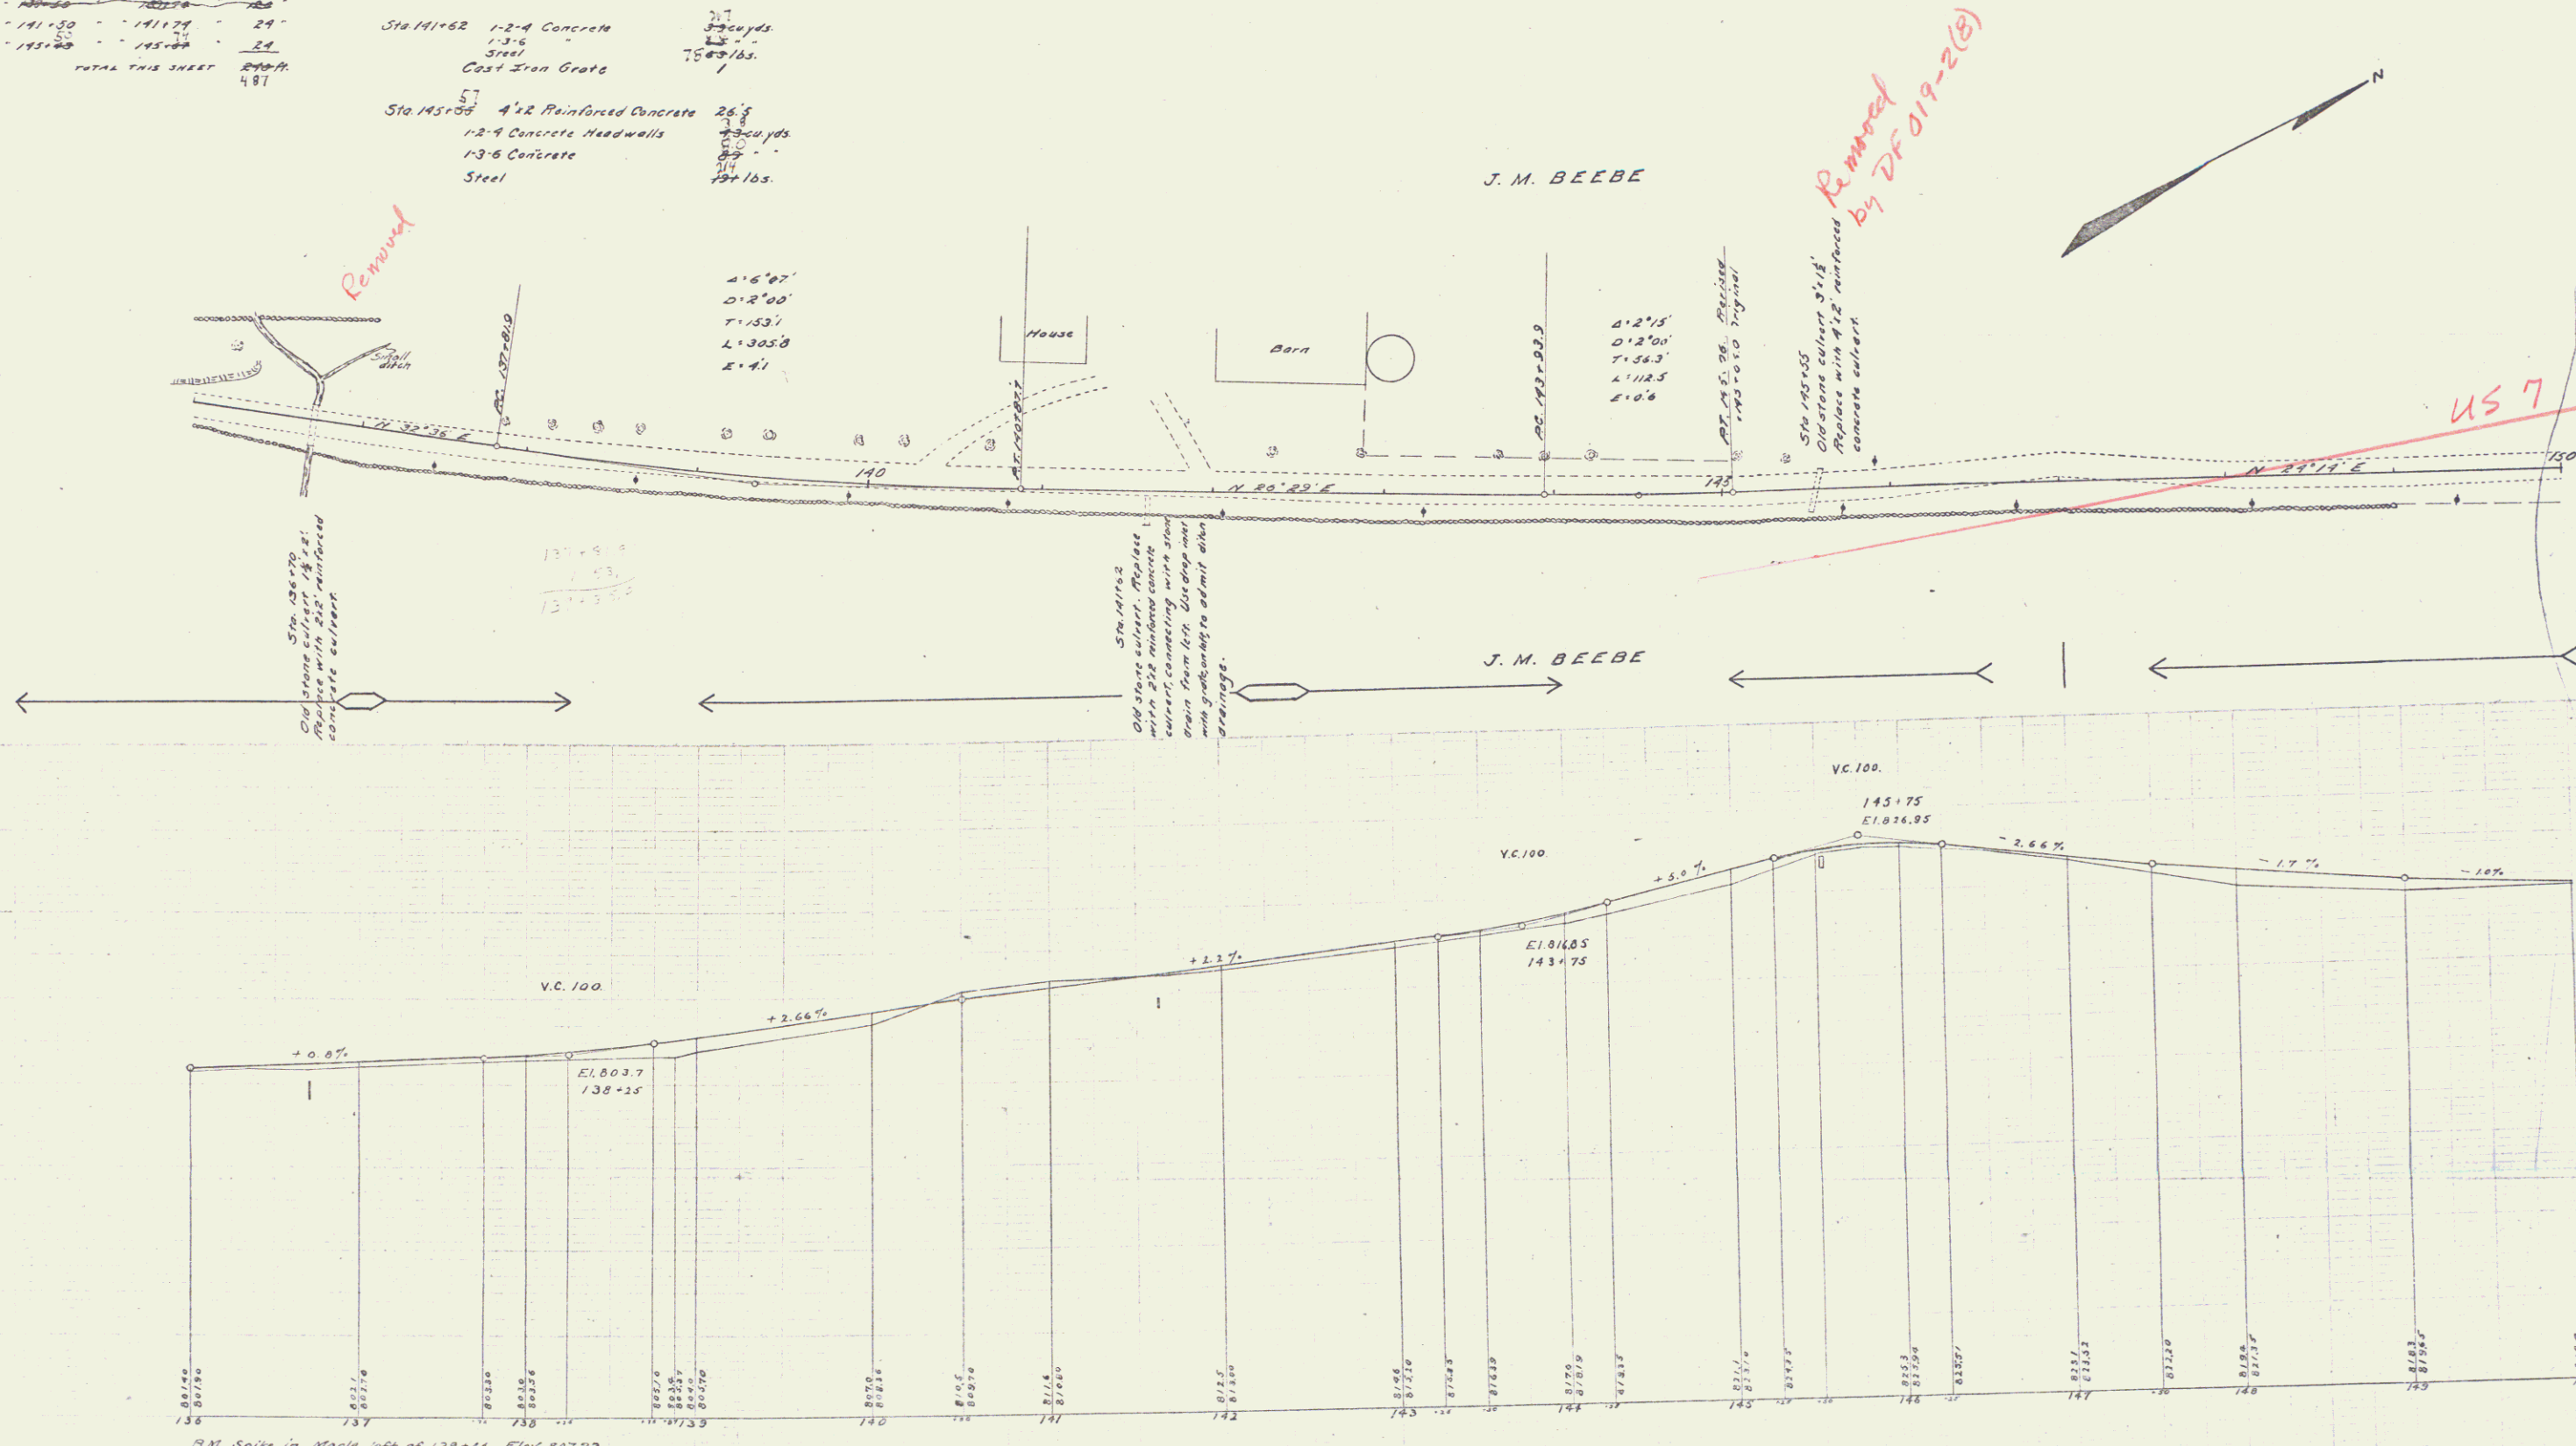

Series F 1942 Filed
Date 12-1-19

GUARD RAIL REQUIRED

ON LEFT

Sta. 133+00 to Sta. 134+17	24.17
134+17 to 135+00	24.17
135+00 to 136+00	24.17
136+00 to 137+00	24.17
137+00 to 138+00	24.17
199+00 to 200+00	24.17
TOTAL THIS SHEET	200.00

CULVERT REPAIRS REQUIRED


ON LEFT

Sta. 162+66.5	4'x2' Reinforced Concrete	26 ft
1-2'x4' Concrete Headwalls	43 cu yds	
1-3'x6' Concrete	100 lbs.	
Steel	100 lbs.	

ON RIGHT

Sta. 165+48	4'x2' Reinforced Concrete	26 ft
1-2'x4' Concrete Headwalls	43 cu yds	
1-3'x6' Concrete	100 lbs.	
Steel	100 lbs.	

FEEDBACK	STATE	FEEDBACK	FEEDBACK	FEEDBACK	TOTAL
DIST. NO.	STATION	FEEDBACK	FEEDBACK	FEEDBACK	FEEDBACK
3	VT	12	1818 10	13	133

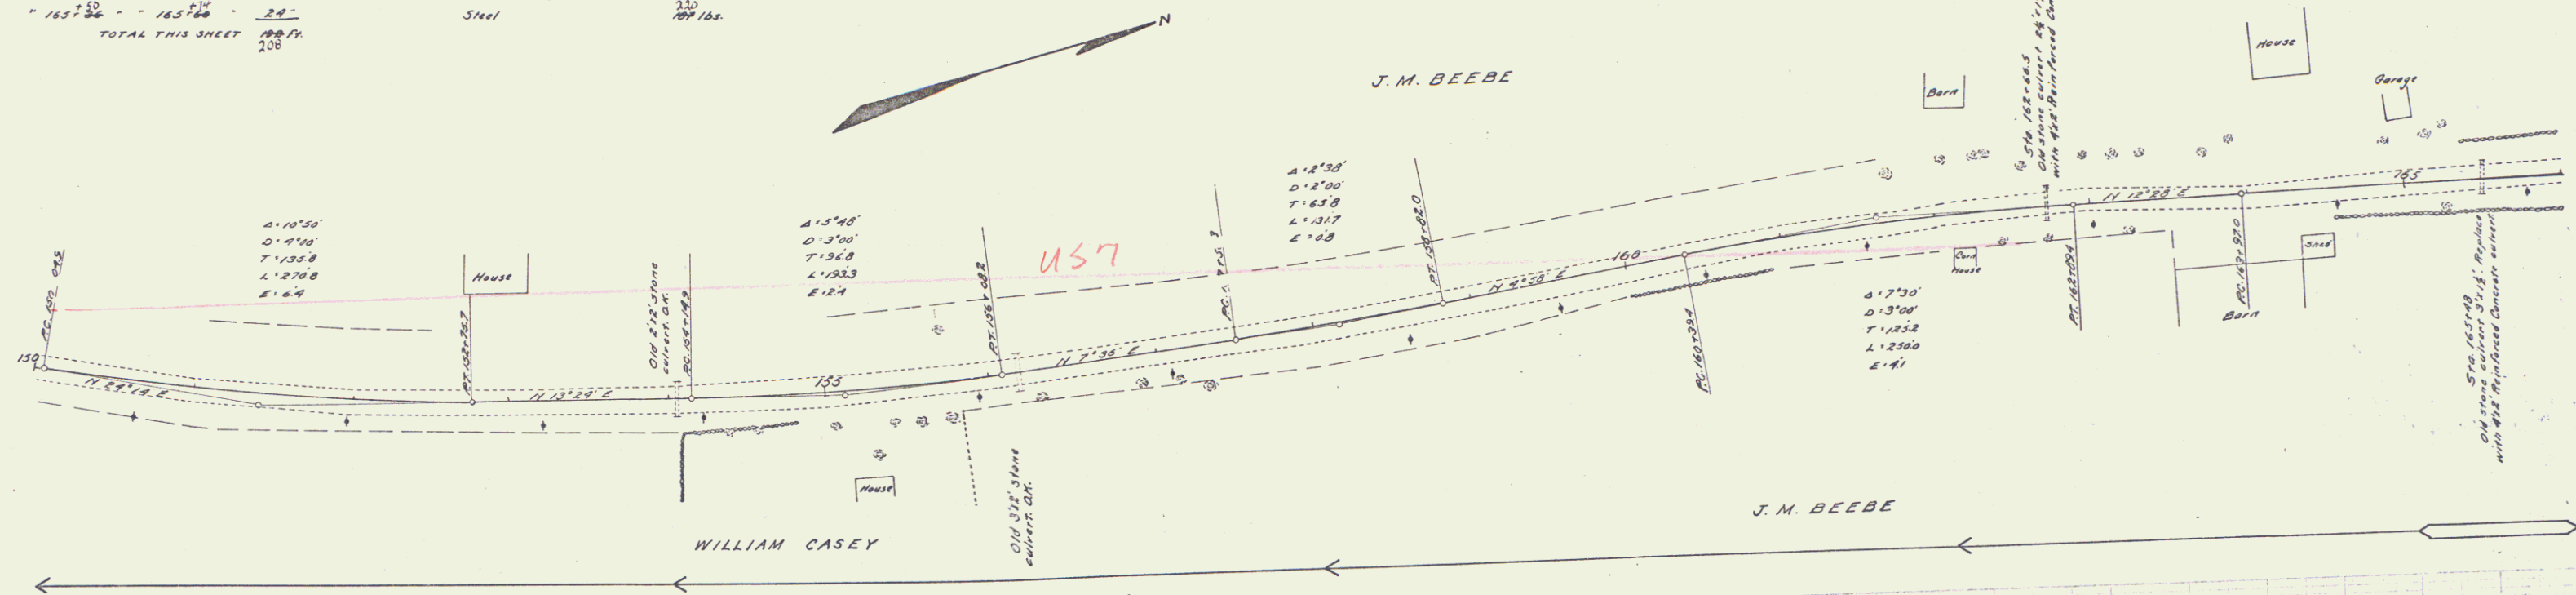

B.M. S. end of Headwall right of 154+01, Elev 816.59
 B.M. S. end of Headwall left of 156+12, Elev 818.91
 B.M. Spike in Maple left of 164+88, Elev 834.64

Series F-2012 F-104
 Sheet 13 of 133

NEW CULVERTS REQUIRED

Sta 172+00 To 172+20 18" Con. Iron Pipe 20 ft
 12" Concrete Headwalls 18 cu yds.
 Sta 173+33 18" Con. Iron Pipe 20 ft
 12" Concrete Headwalls 18 cu yds.


GUARD RAIL REQUIRED

ON LEFT
 Sta 172+00 To Sta 172+20 Length 20 ft
 172+00 172+20 24"
 ON RIGHT
 Sta 173+33 To Sta 174+00 Length 67 ft
 173+33 174+00 24"
 TOTAL THIS SHEET 56 ft.


STONE BASE REQUIRED

Sta 172+16 To 176+00 Length 384 ft

FED. ROAD DIST. NO.	STATE	FED. AID FISCAL YEAR	SHEET NO.	TOTAL SHEETS
9	VT	12	13	133

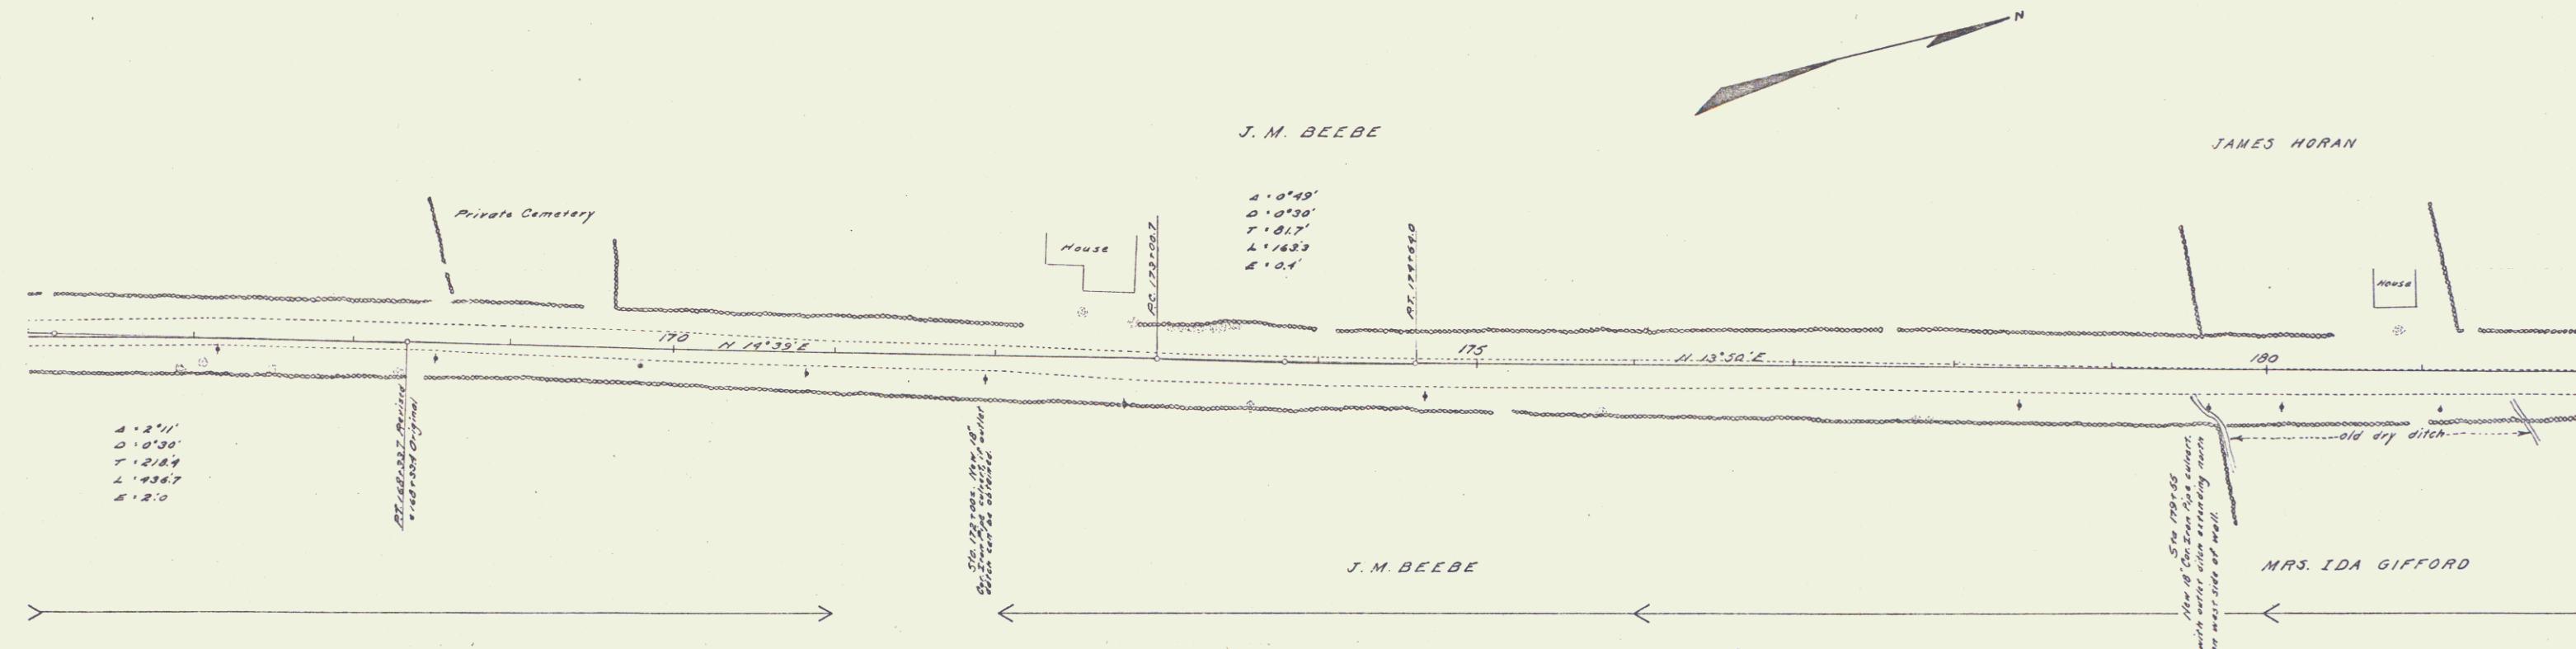

W.A. Gifford
 M.R. Gifford
 D.P. Gifford
 J. Gifford

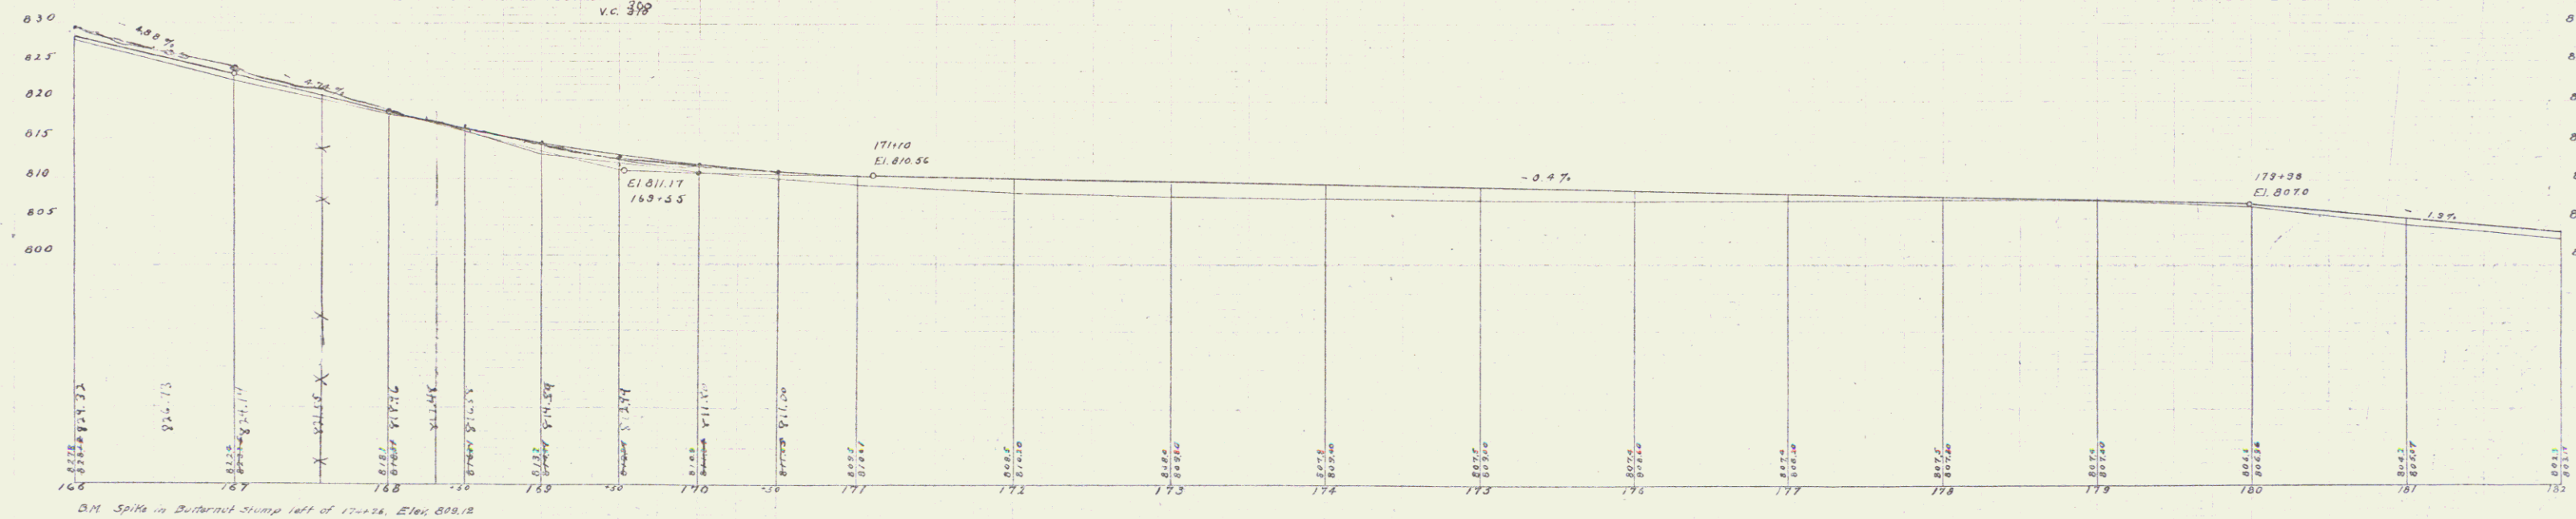

Series C. 1910. Filed
 Sta. 172+00

GUARD RAIL REQUIRED

ON LEFT

Sta	184+00 to Sta 185+00	Length 20 ft
184+00	184+00	20
184+20	184+20	20
184+40	184+40	20
184+60	184+60	20
184+80	184+80	20
185+00	185+00	20

ON RIGHT

Sta	185+00 to Sta 186+00	Length 20 ft
185+00	185+00	20
185+20	185+20	20
185+40	185+40	20
185+60	185+60	20
185+80	185+80	20
186+00	186+00	20



TOTAL THIS SHEET 200

NEW CULVERTS REQUIRED

Sta 185+00 14" Cor Iron Pipe 26 ft. V

12" Concrete Headwalls 12 cu yds.

FEED ROAD	STATE	FEED NO	FISCAL YEAR	SHEET TOTAL
9	VT	12	1914-15	133

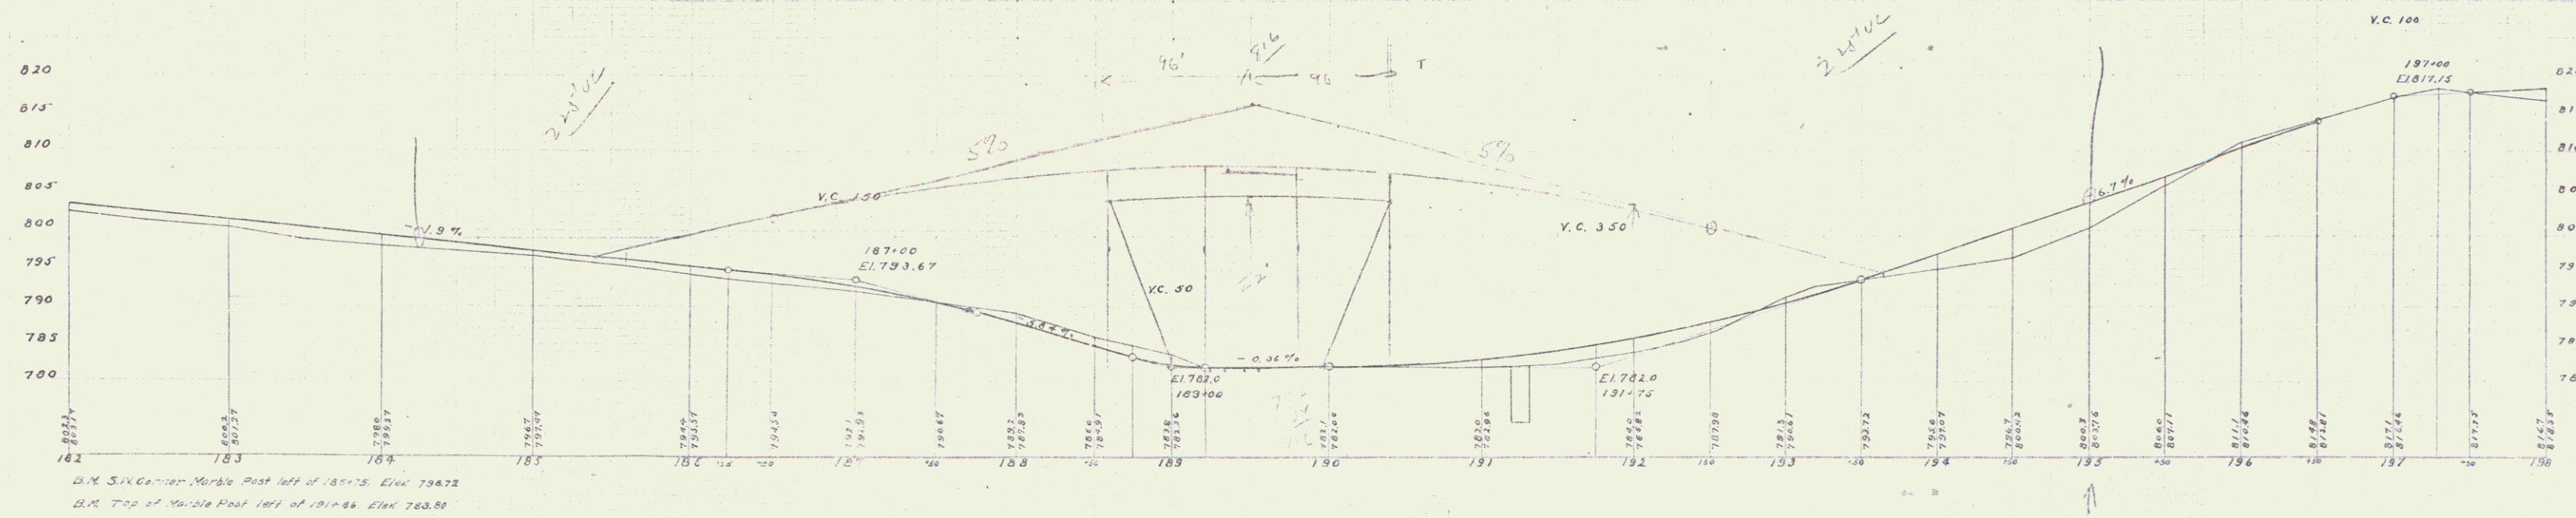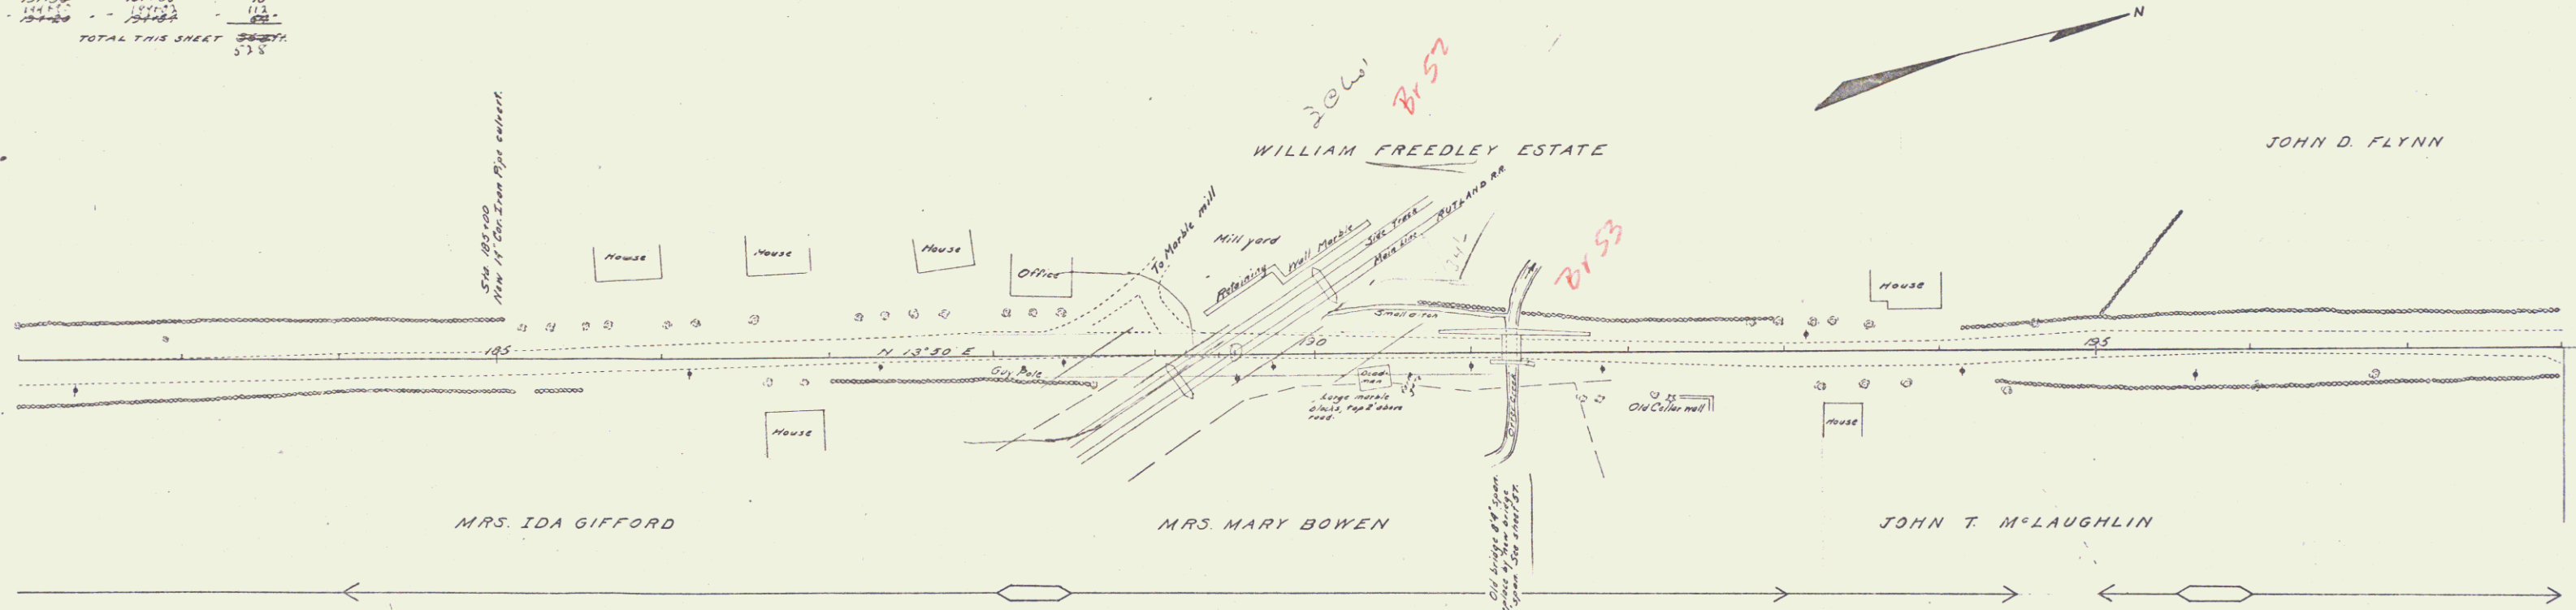

D.M. 5" X 6" Cor. Marble Post left of 184+75. Elev. 796.72

D.M. Top of Marble Post left of 191+66. Elev. 783.86

Series 7 10-1-1915

GUARD RAIL REQUIRED

ON LEFT

213-78 213-78
Sto 205-00 to Sto 213-78 Length 78 ft
" 205-00 " 213-00 " 78 "

ON RIGHT

213-78
" 205-00 to Sto 205-00 " 24 "
" 213-00 " 213-00 " 24 "


TOTAL THIS SHEET 238 ft
655

NEW CULVERTS REQUIRED

Sta. 206+00	12" Cor. Iron Pipe	28 ft. ✓
	1-2' Concrete Headwalls	10 cu. yds.
Sta. 210+50	12" Cor. Iron Pipe	28 ft. ✓
	1-2' Concrete Headwalls	10 cu. yds.

CONCRETE RETAINING WALL REQUIRED

Sta 212+45 to Sta 213+60 Length 115 ft.
1-3-6 Concrete ~~4~~ 6 cu. yds.
Steel 7 to 2 lbs

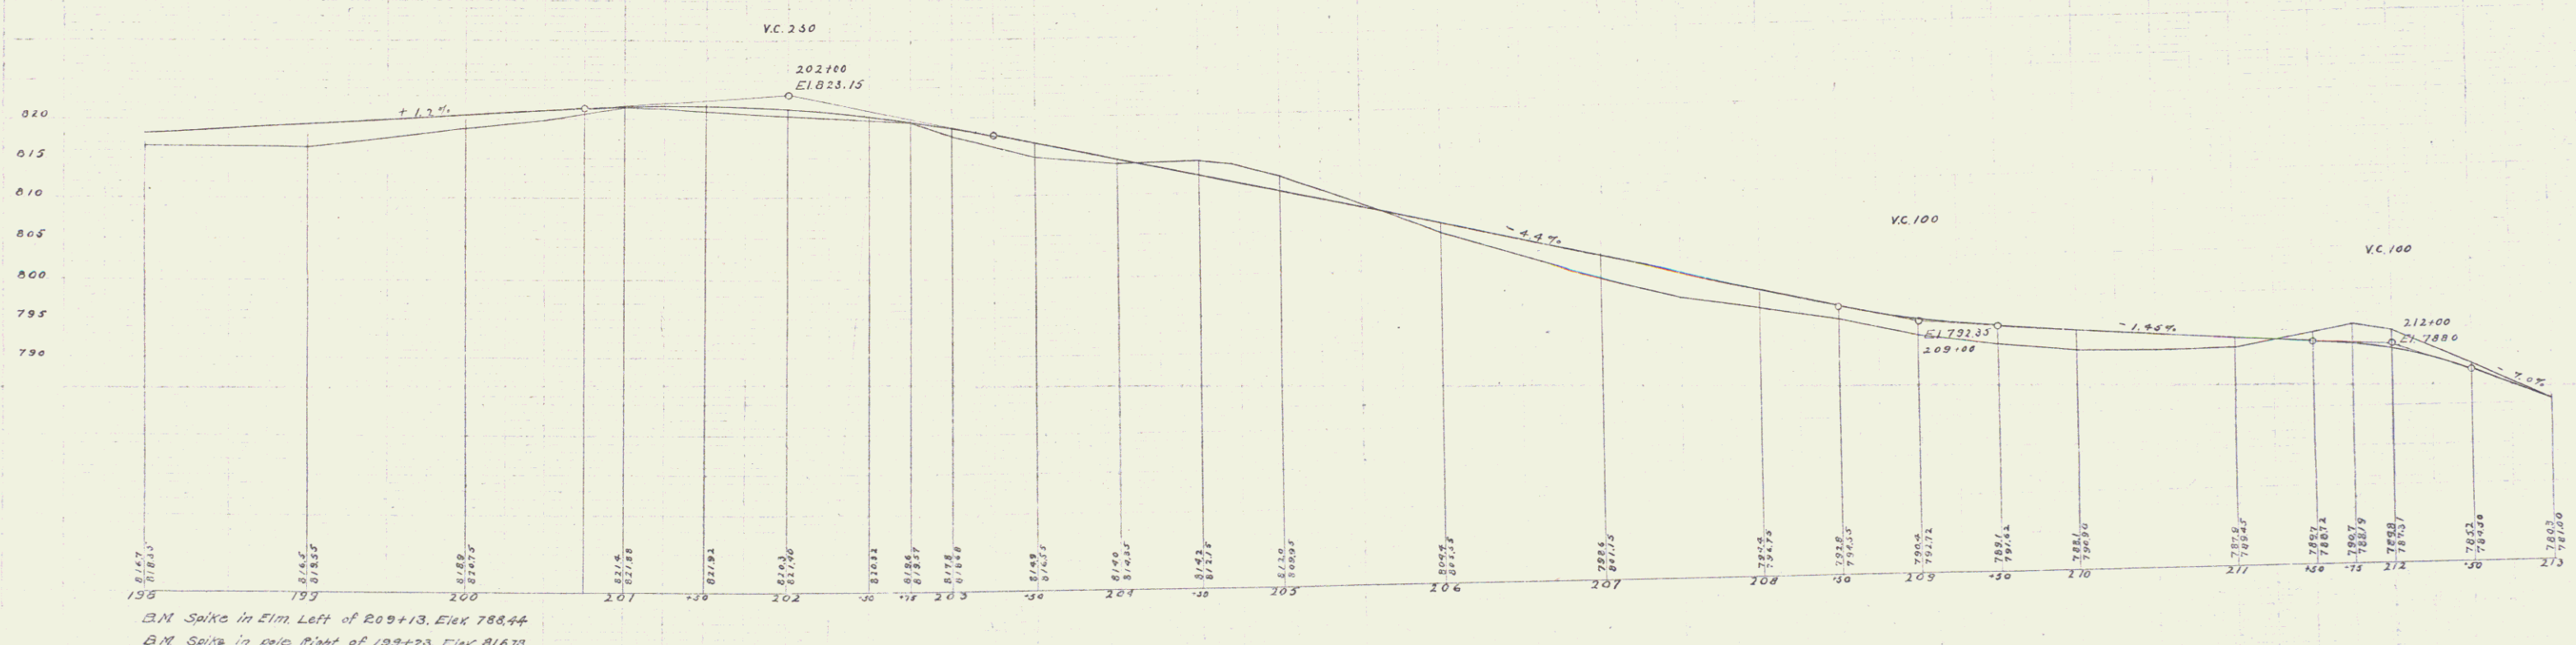

B.M. Spike in Elm. Left of 209+13. Elev 788.44
B.M. Spike in pole Right of 199+23. Elev 816.73

Series F, No 12, Files
Sheet 16 of 133

GUARD RAIL REQUIRED

ON LEFT

Sta 213+00 to Sta 224+00 Length 1100 ft

214+00 100

215+00 100

216+00 100

217+00 100

218+00 100

219+00 100

220+00 100

221+00 100

222+00 100

223+00 100

224+00 100

ON RIGHT

213+00 100

214+00 100

215+00 100

216+00 100

217+00 100

218+00 100

219+00 100

220+00 100

221+00 100



222+00 100

223+00 100

224+00 100

TOTAL THIS SHEET 1100 ft

46.6

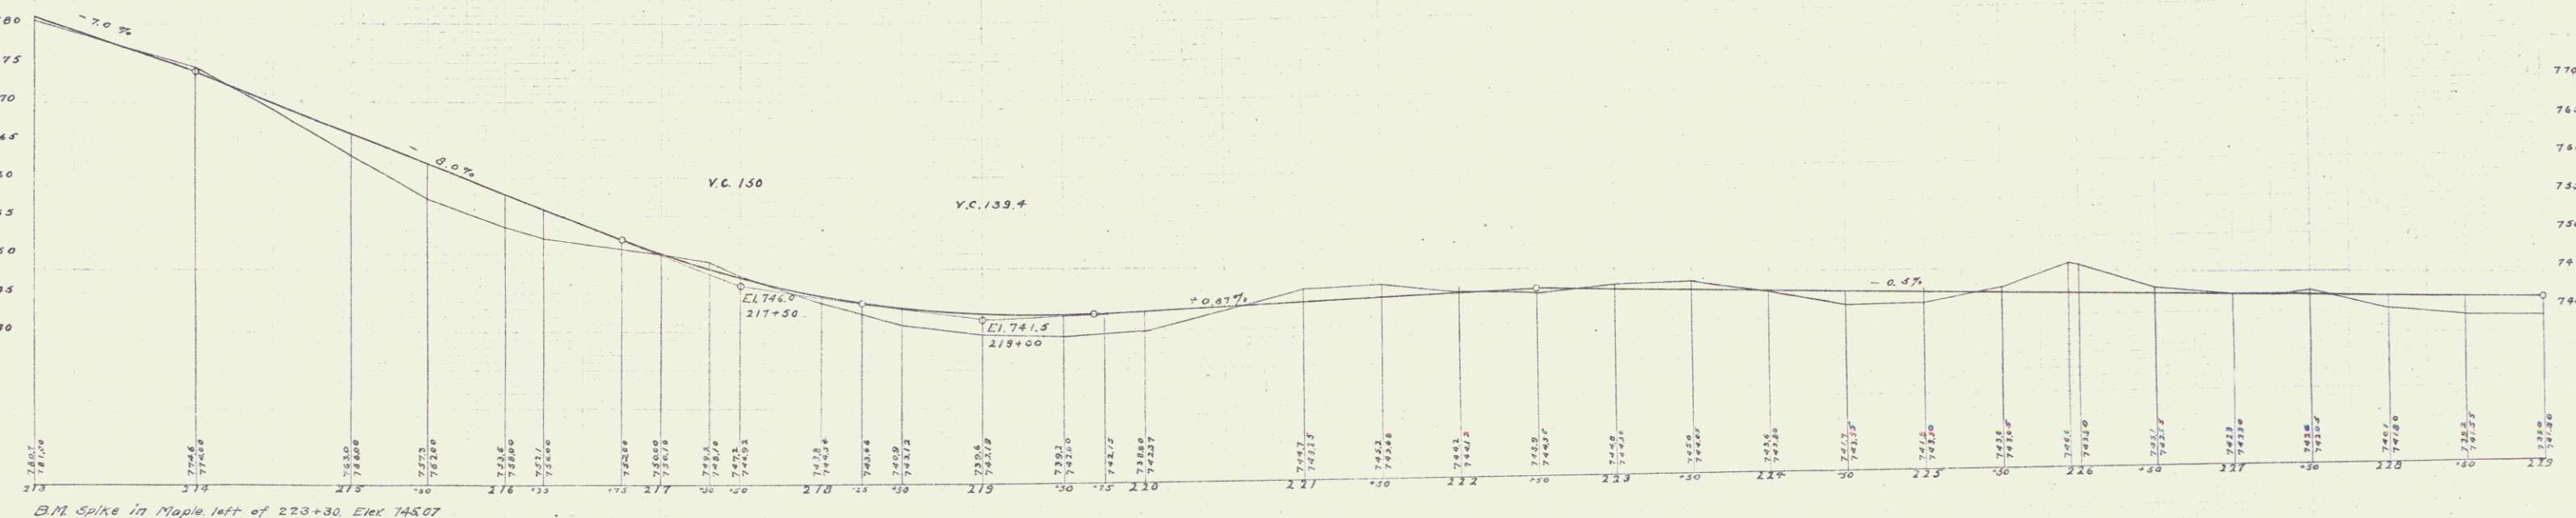
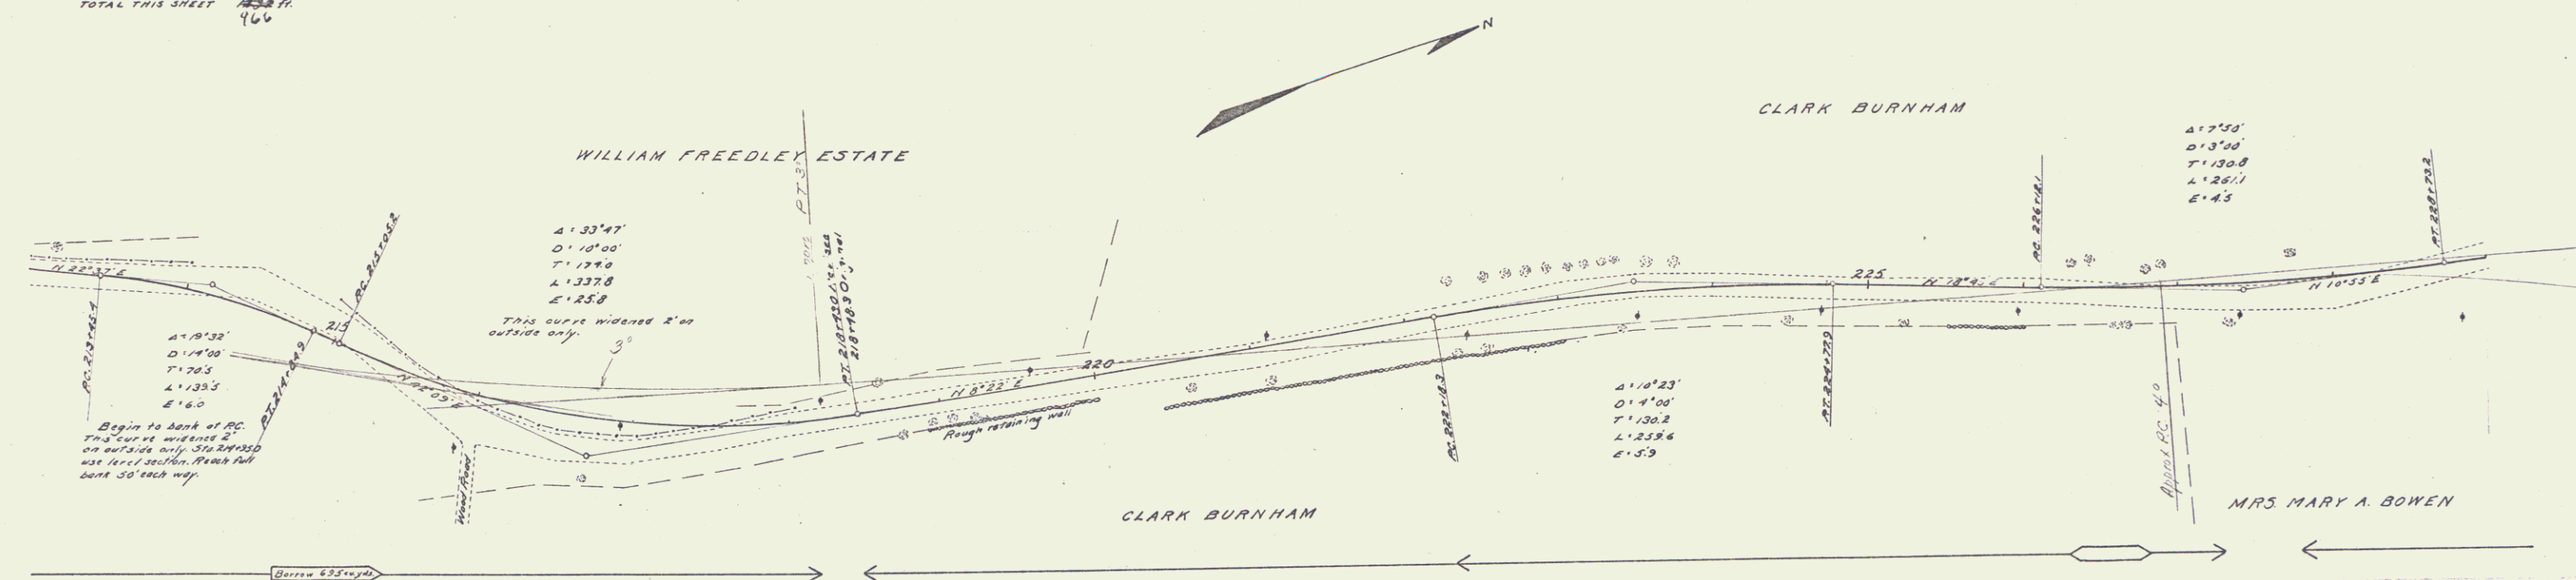


GUARD RAIL REQUIRED
 22+35 ON LEFT
 22+35 TO 22+40 LENGTH 5' 0"
 ON RIGHT
 22+100 TO 22+105
 TOTAL THIS SHEET 330'

NEW CULVERTS REQUIRED
 STA 22+100 14" C.I. Iron Pipe 26' IN
 12" Concrete Headwalls 100' LGS

LEACHING BASINS REQUIRED
 ON RIGHT
 22+100 TO 22+105



FED. ROAD DIST. NO.	STATE	FED. AID PROJ. NO.	FED. AID CL. NO.	TOTAL SHEETS
0	VT.	12	1010-30	133

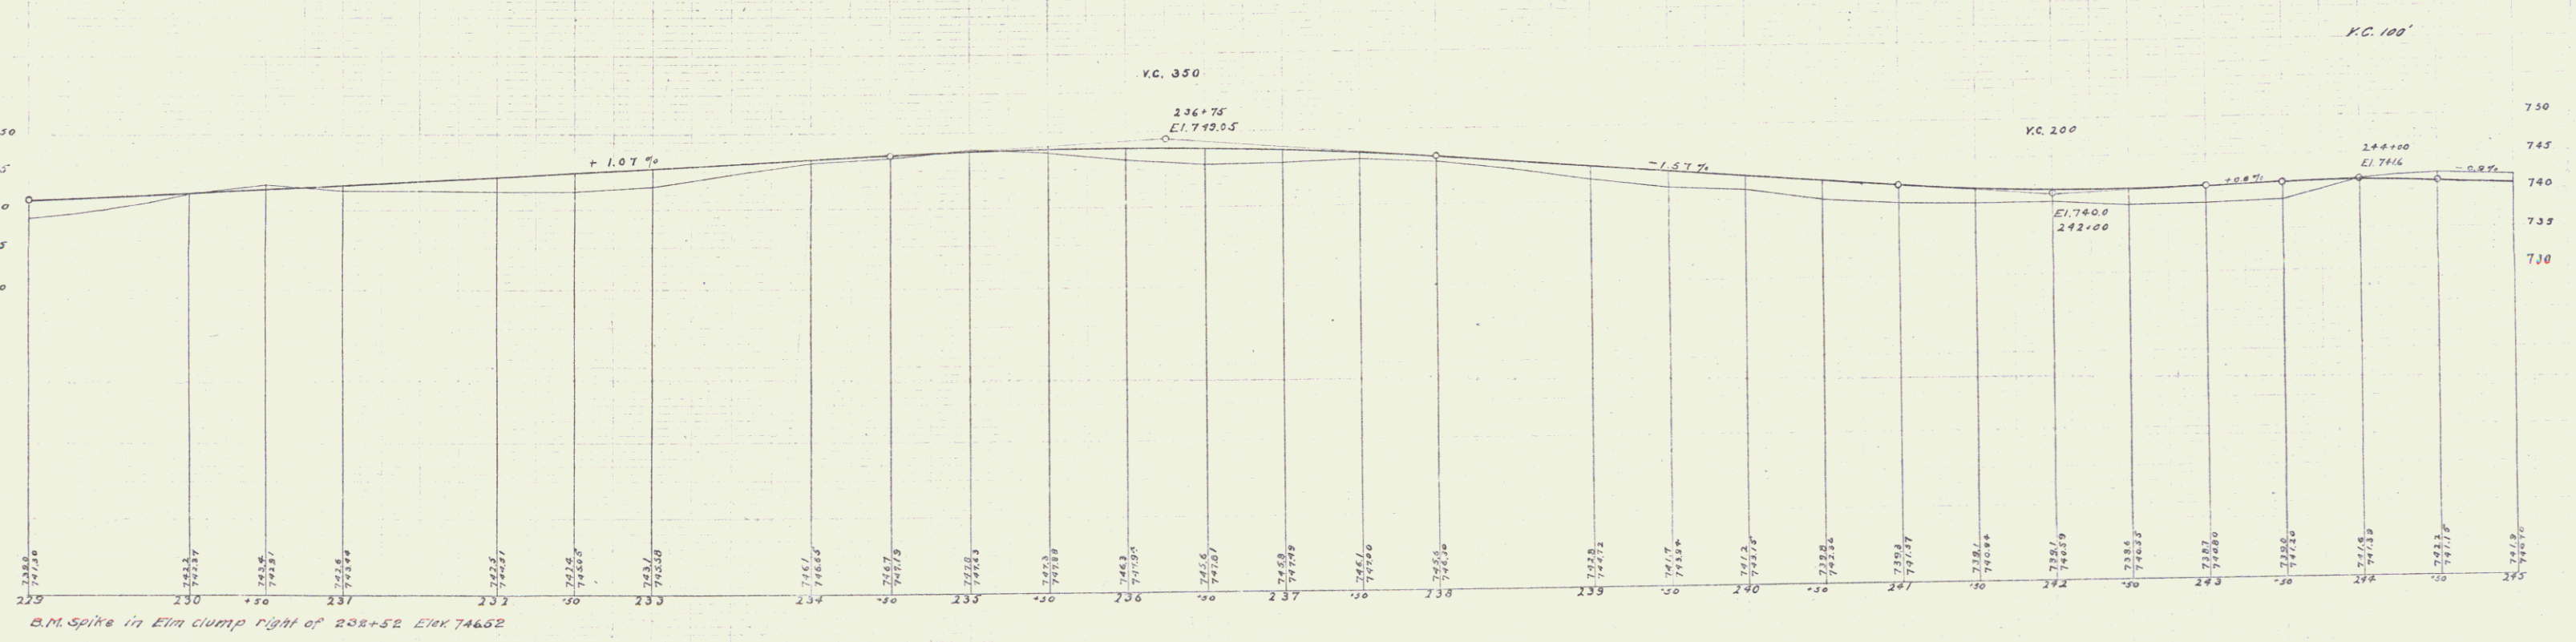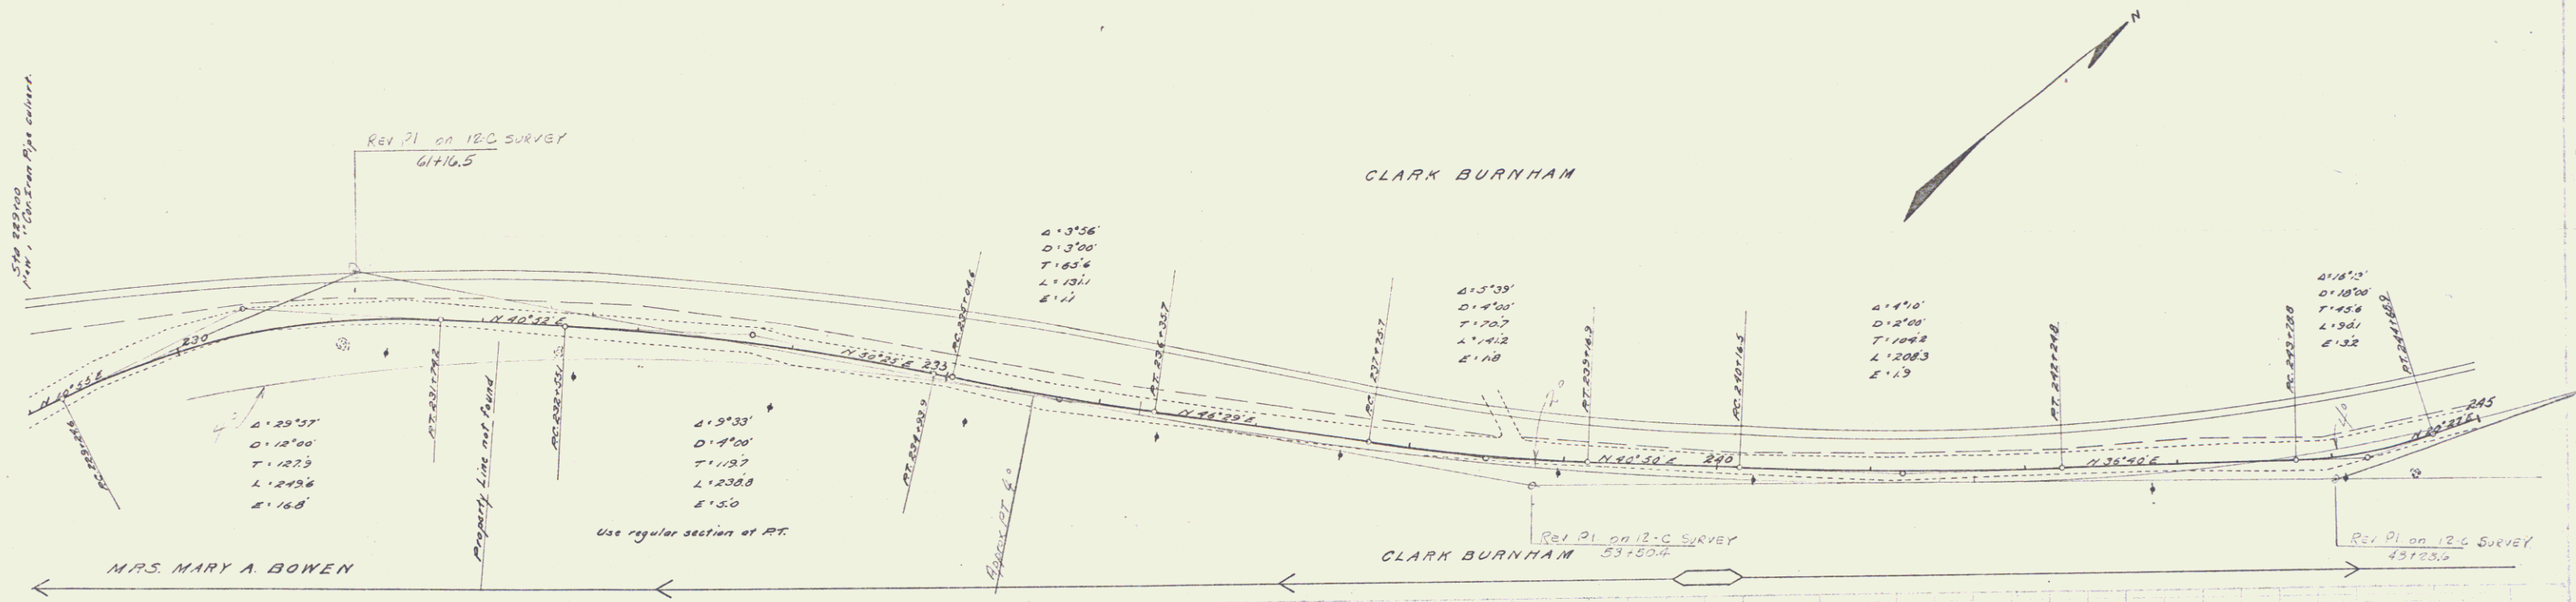

Series A, B, C, D, E, F, G, H, I, J, K, L, M, N, O, P, Q, R, S, T, U, V, W, X, Y, Z

LEARNING BASIN REQUIRED
DATE 11-15-1985
GUYTON, MISSOURI

FED. ROAD DIST. NO.	STATE	FED. AID. PROJ. NO.	FISCAL YEAR	SHEET NO.	TOTAL SHEETS
8	VT.	12	1810-20	19	133

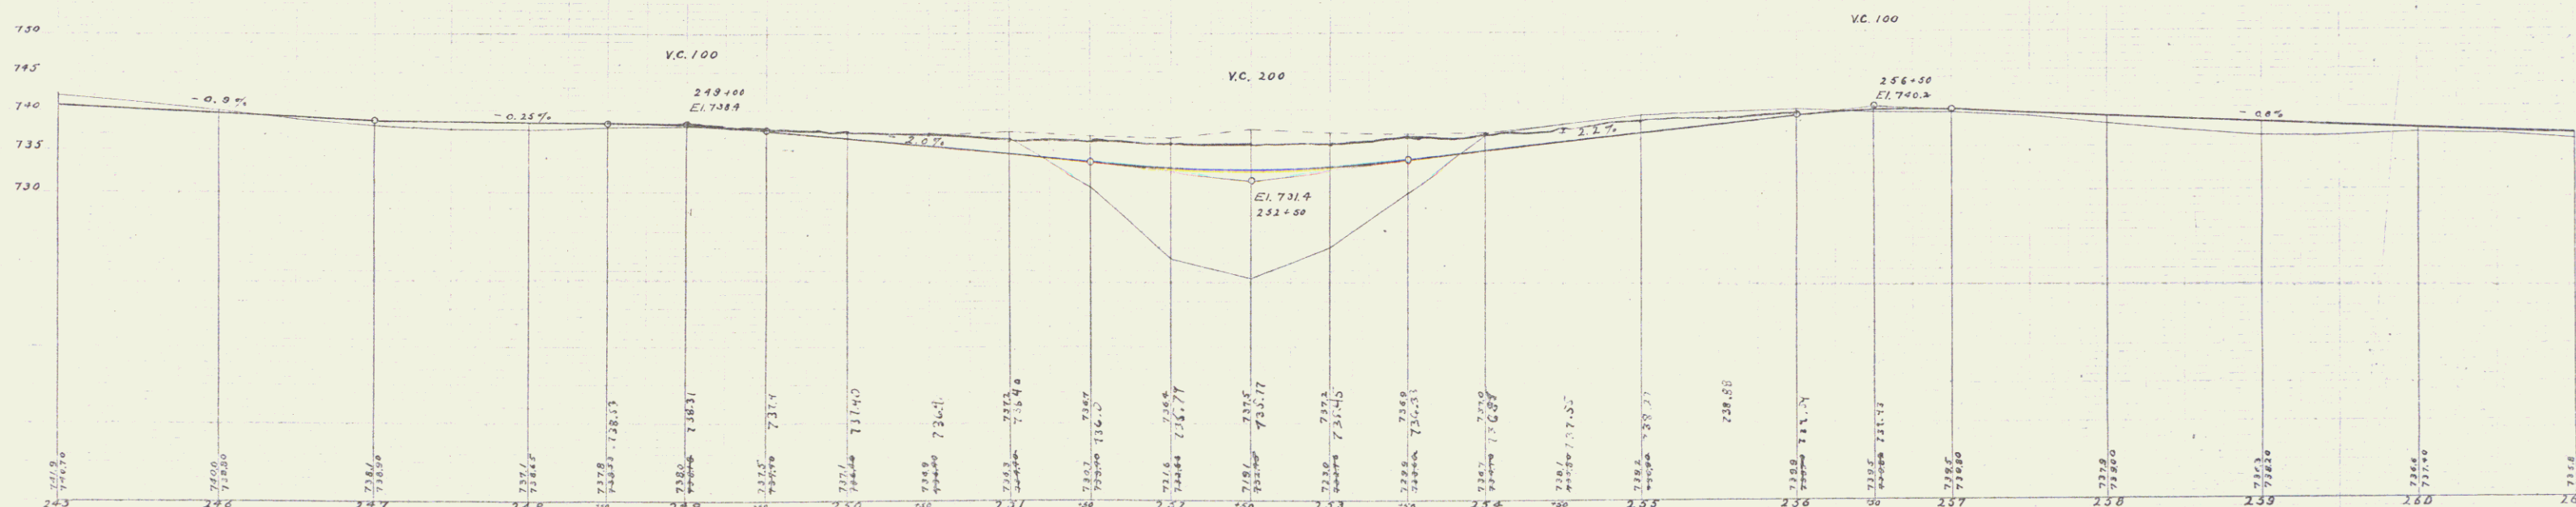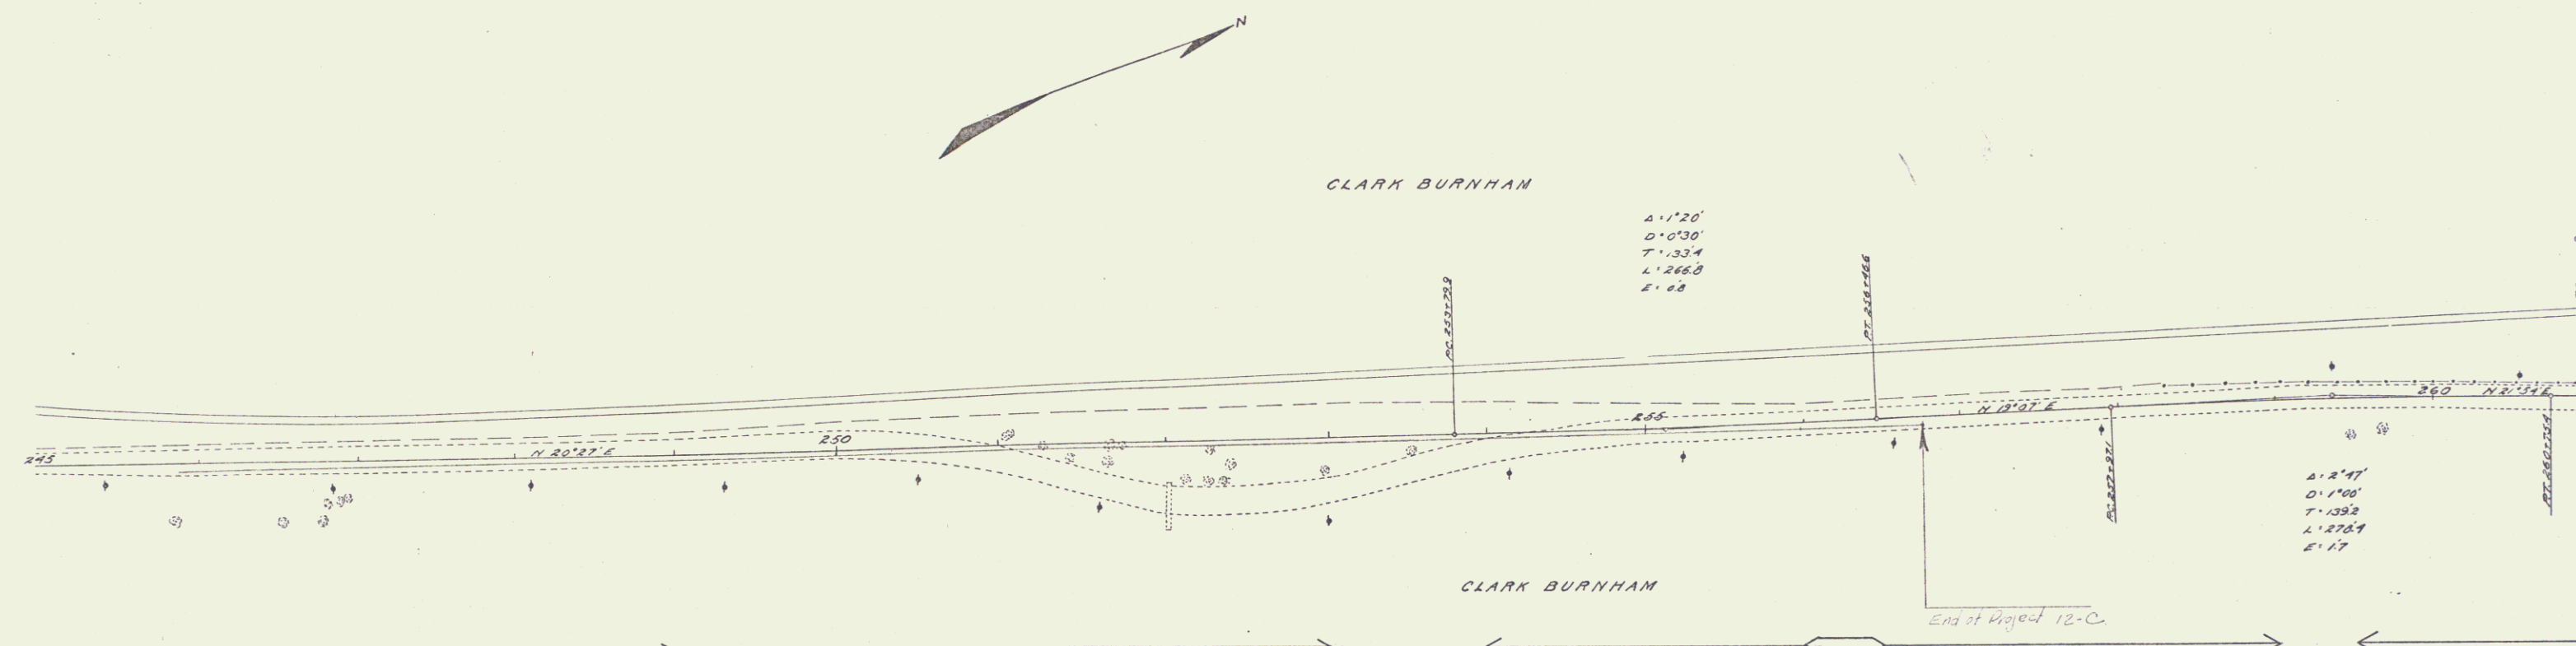

GUARD RAIL REQUIRED
ON LEFT
Sta 283+00 to Sta 283+25 Length 25 ft.
ON RIGHT
Sta 283+25 to Sta 283+50 Length 25 ft.
TOTAL THIS SHEET 48 ft.



CULVERT REPAIRS REQUIRED
Sta 283+32 18" Cor Iron Pipe 20 ft.
12" Concrete Headwalls 13 cu yds.

STONE BASE REQUIRED
Sta 280+00 to Sta 281+50 Length 150 ft.

FEED ROAD DIST. NO.	STATE	FEED AID	FISCAL YEAR	SHEET NO.	TOTAL SHEETS
9	VT	12	1914-15	21	133

L. L. Davis
C. H. Day
H. H. Hays

L. L. Davis
C. H. Day
H. H. Hays

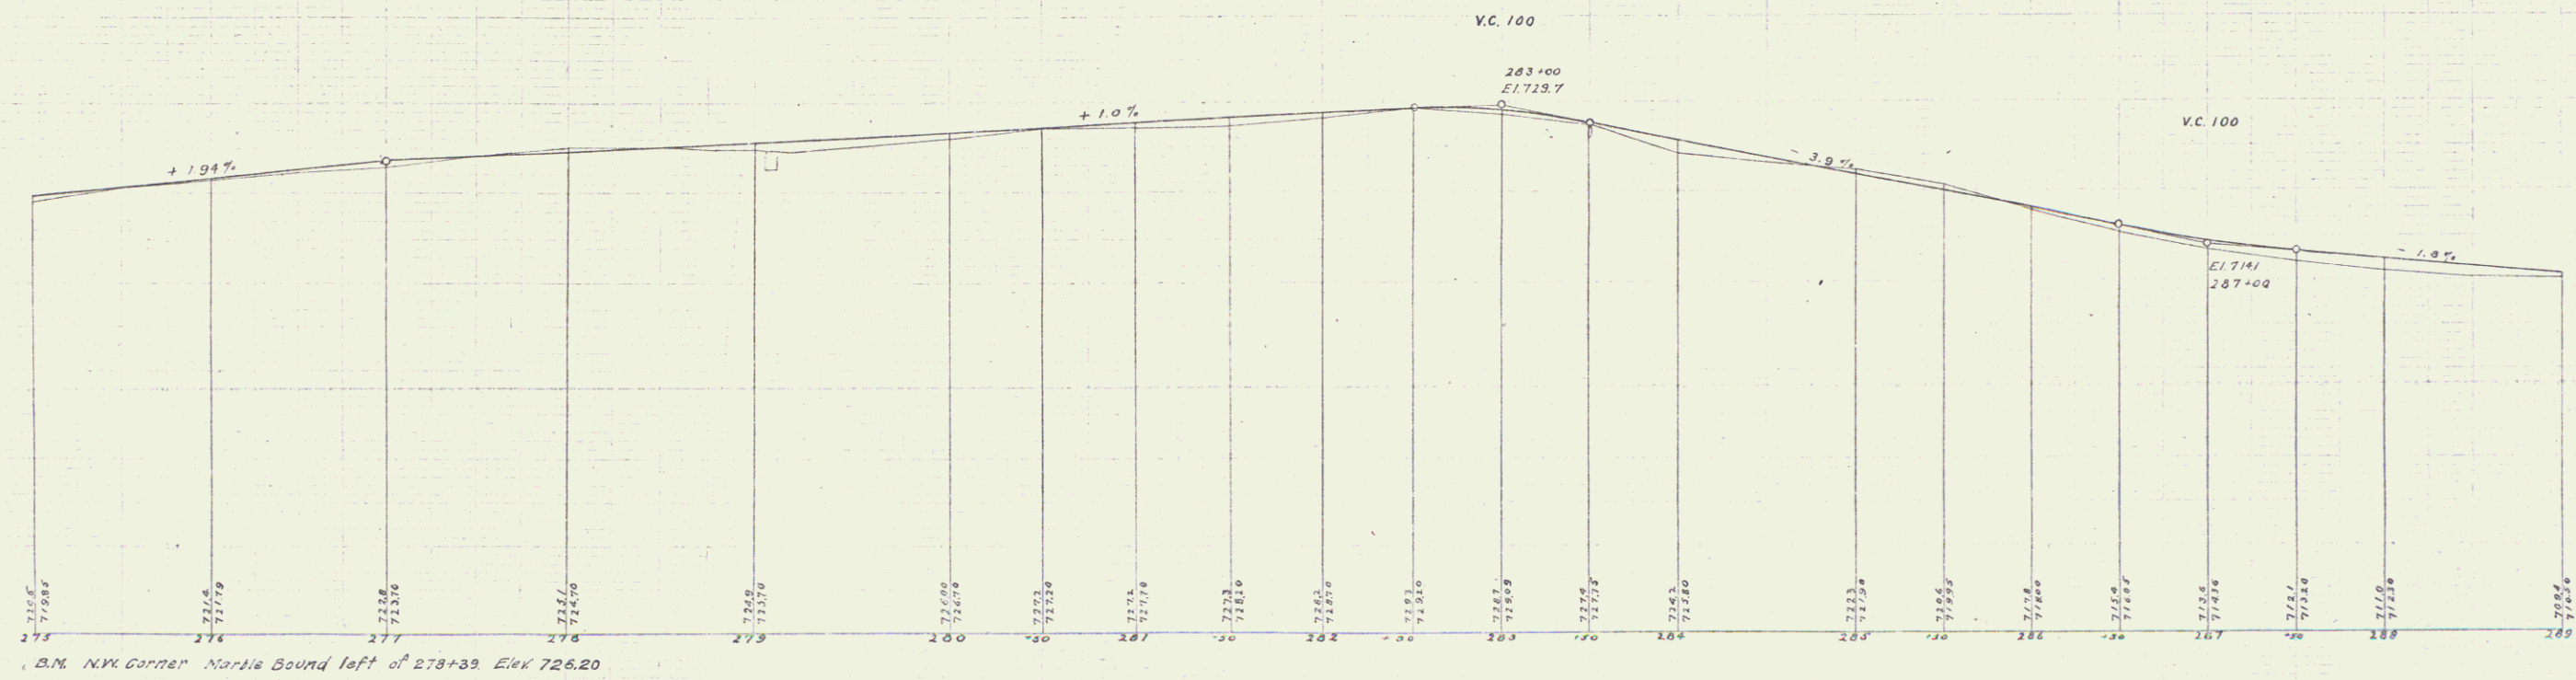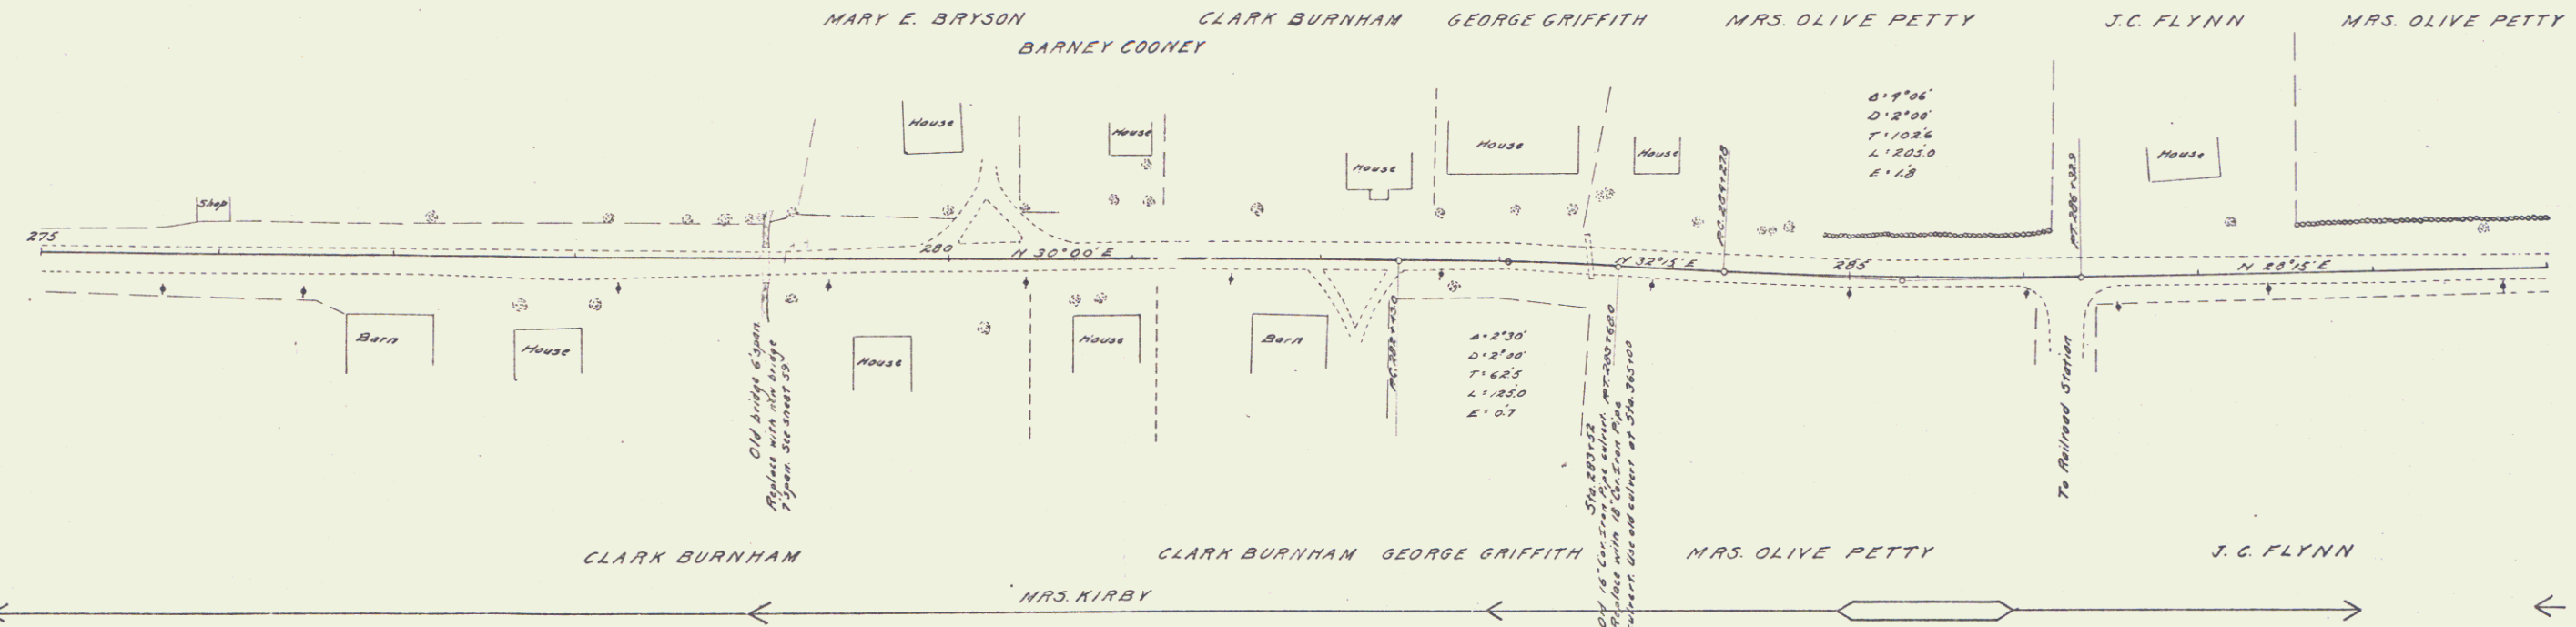

B.M. N.Y. Corner Marble Bound left of 278+39 Elev 726.20

Checked by L. L. Davis
Date 11/1/14

GUARD RAIL REQUIRED

ON LEFT

Sta 289+14 to Sta 289+40	Length 24 ft.
289+14	296+40
296+40	24
301+00	24

ON RIGHT

289+14 to Sta 289+40	24
289+14	296+40
296+40	24
301+00	24

ON LEFT

292+70 to Sta 292+70	24
292+70	292+70
292+70	24

TOTAL THIS SHEET 54

STONE BASE REQUIRED

Sta 291+50 to Sta 293+00	Length 150 ft.
291+50	293+00
293+00	80
301+00	205



CULVERT REPAIRS REQUIRED

Sta 289+28	14" Con. Iron Pipe (Extension) 4 ft.	10 cu yds.
1-2-4 Concrete Headwalls		
Sta 296+70	16" Con. Iron Pipe (Extension) 8 ft.	12 cu yds.
1-2-4 Concrete Headwalls		
Sta 301+67	16" Con. Iron Pipe (Extension) 8 ft.	10 cu yds.
1-2-4 Concrete Headwalls		
Sta 292+30	12" Con. Iron Pipe	30 ft.
1-2-4 Concrete		20 cu yds.

FED. ROAD DIST. NO.	STATE	FED. AID	FISCAL YEAR	PROJECT NO.	SHEET NO.
9	VT	12	1944-45	22	

11/15/44
C.H. Day

11/15/44
L.H. Grant
O.S. Perkins
J.L. Davis

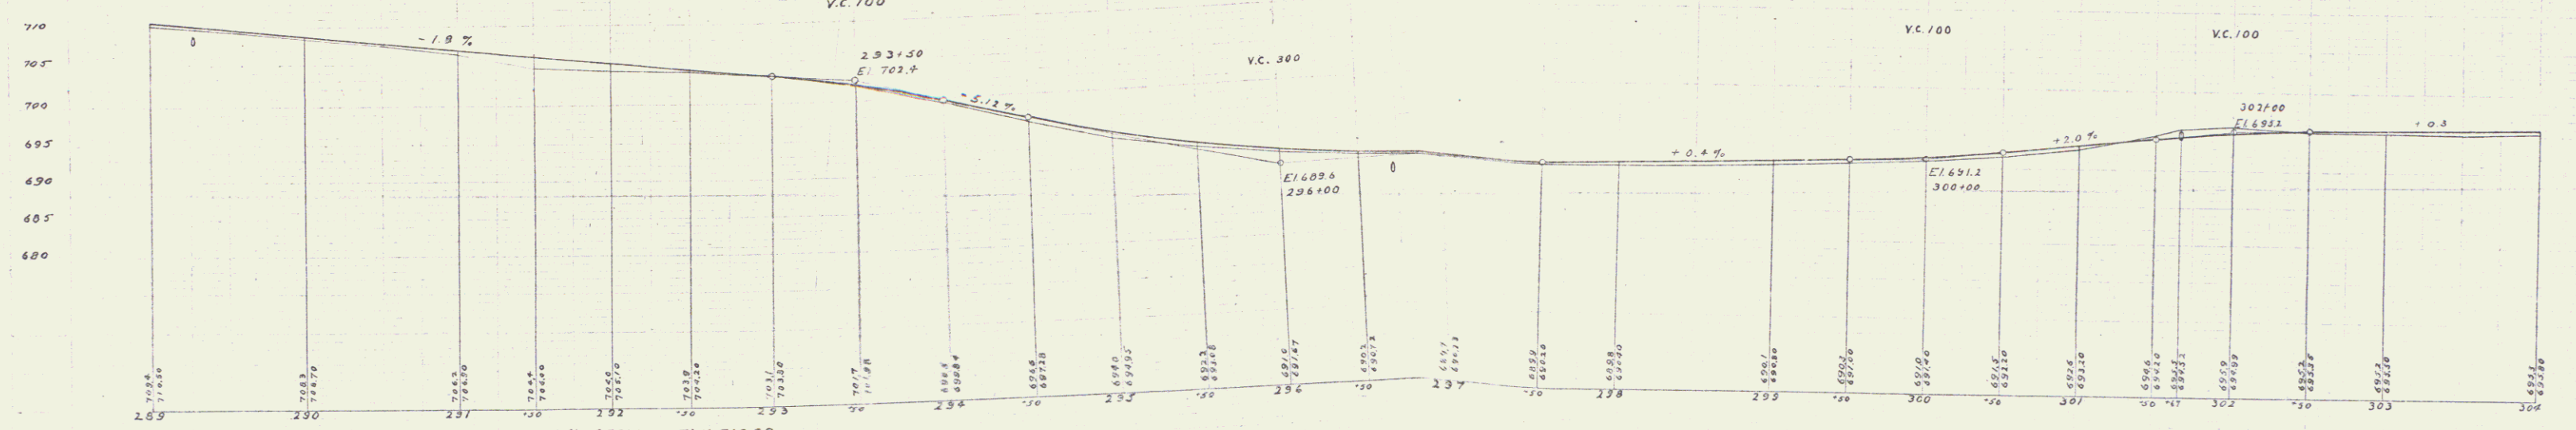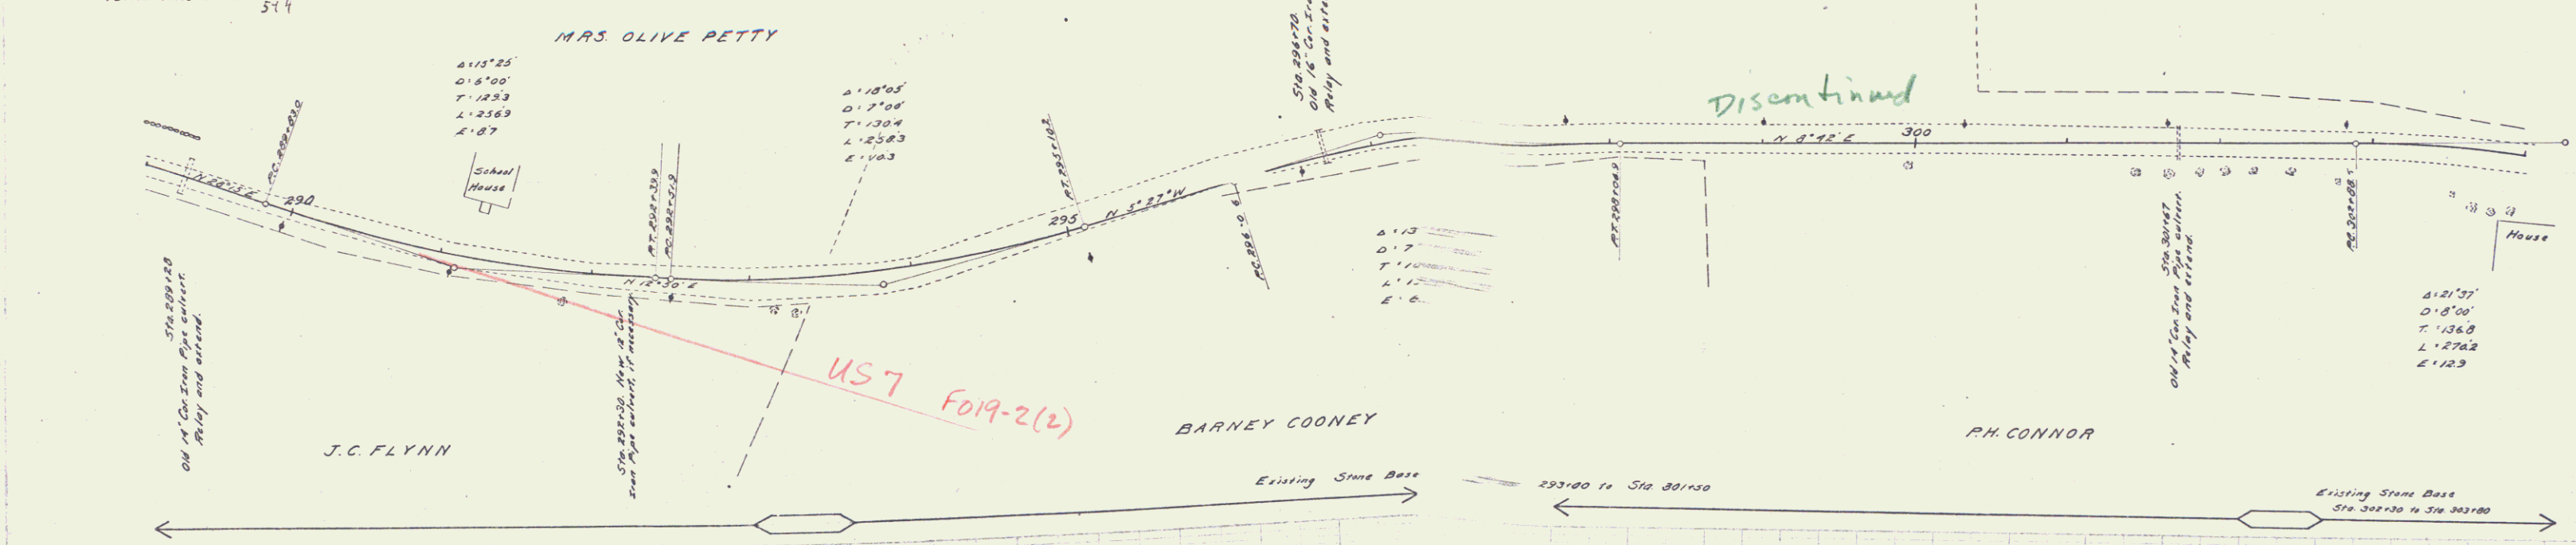

B.M. Foundation Stone Eft. N. of S.E. corner School, left of 291+06, Elev. 709.39
 B.M. Spike in Elm right of 291+84, Elev. 700.40
 B.M. Spike in Maple right of 302+77, Elev. 691.71



Sheet 22 of 23

GUARD RAIL REQUIRED
 ON LEFT:
 Sta 307+00 to Sta 307+24 Length 24 ft.
 3/12x12 " 24'
 3/12x12 " 24'
 3/12x12 " 24'
 ON RIGHT:
 307+24 to Sta 307+25 24'
 3/12x12 " 24'
 3/12x12 " 24'
 3/12x12 " 24'
 TOTAL THIS SHEET 94.8 ft.
 50'

STONE BASE REQUIRED
 Sta 307+20 to Sta 307+25 Length 50 ft.
 30'

CULVERT REPAIRS REQUIRED
 Sta 307+19 14" Cor Iron Pipe (Extending 4 ft.)
 12-4 Concrete Headwalls 10 cu yds.
 Sta 313+30 12" Cor Iron Pipe (Extension) 6 ft.
 12-4 Concrete Headwalls 10 cu yds.
 Sta 315+00 12" Cor Iron Pipe (Extension) 2 ft. (at inlet)
 12-4 Concrete Headwalls 2 cu yds.
 Sta 319+23 14" Cor Iron Pipe (Extending 8 ft.)
 12-4 Concrete Headwalls 10 cu yds.

FED. ROAD DIST. NO.	STATE	FED. ROAD DIST. NO.	FISCAL YEAR	SHEET NO.	TOTAL SHEETS
9	VT	12	1933	25	133

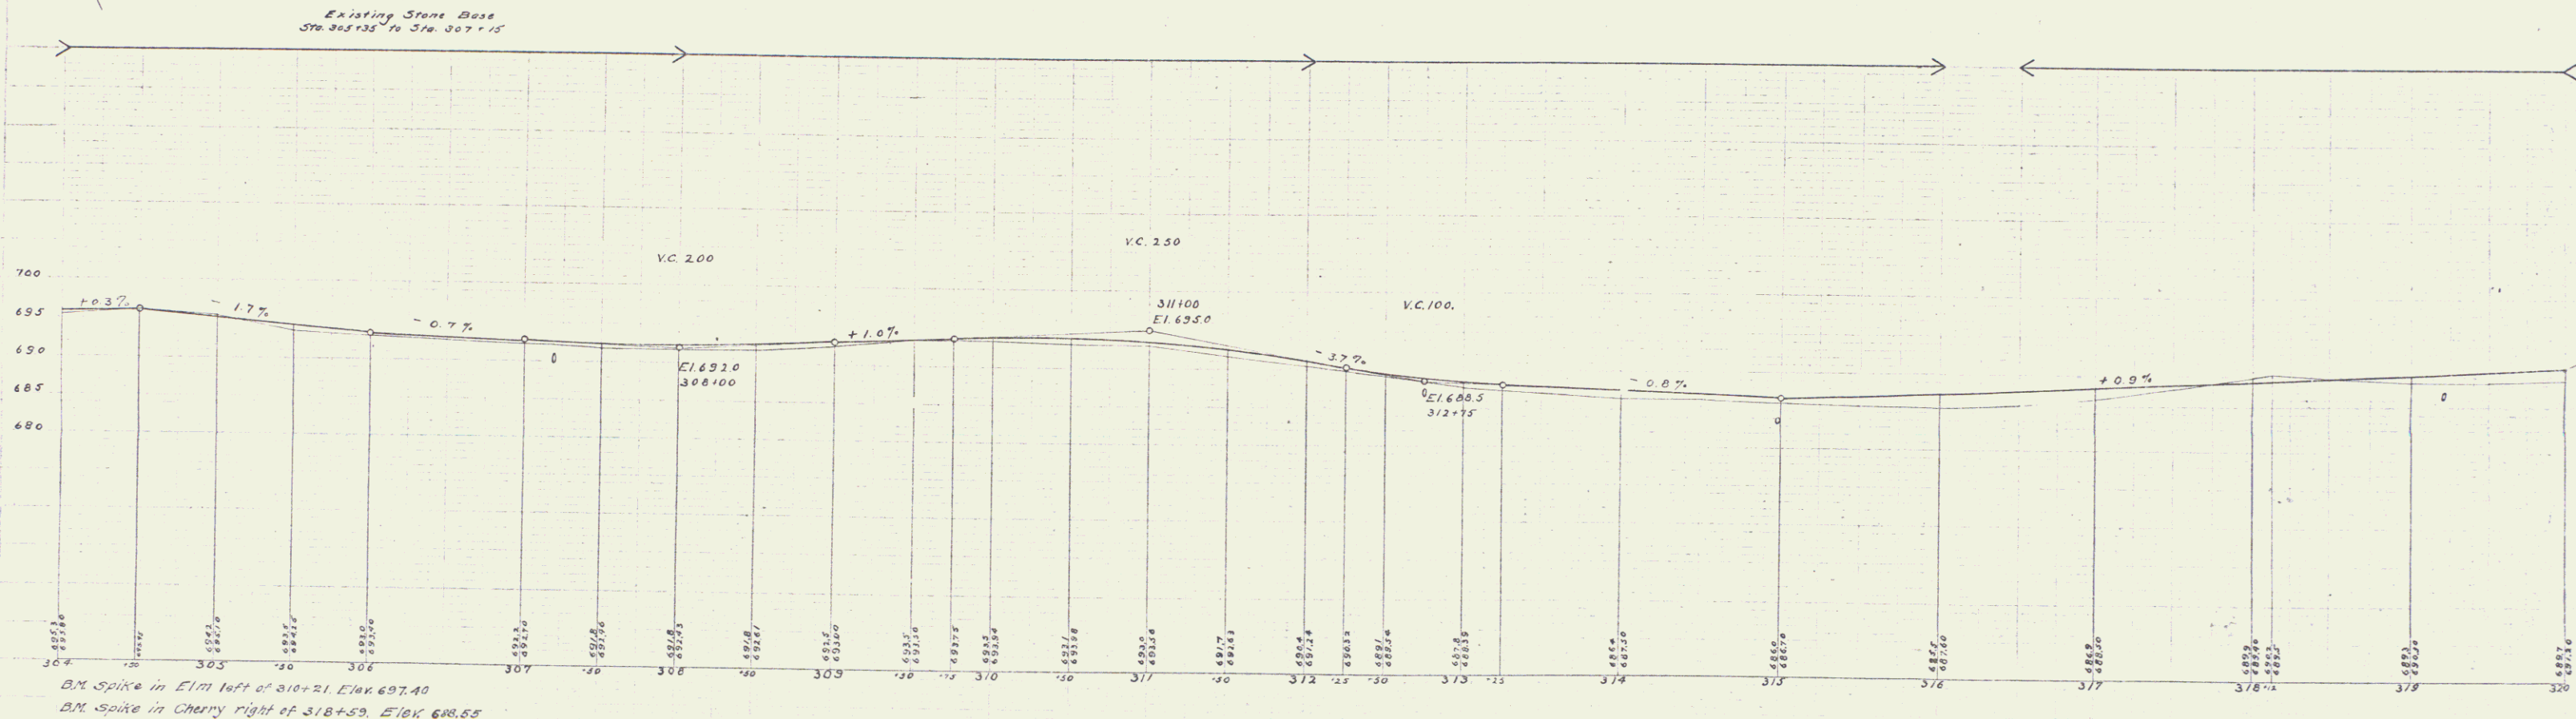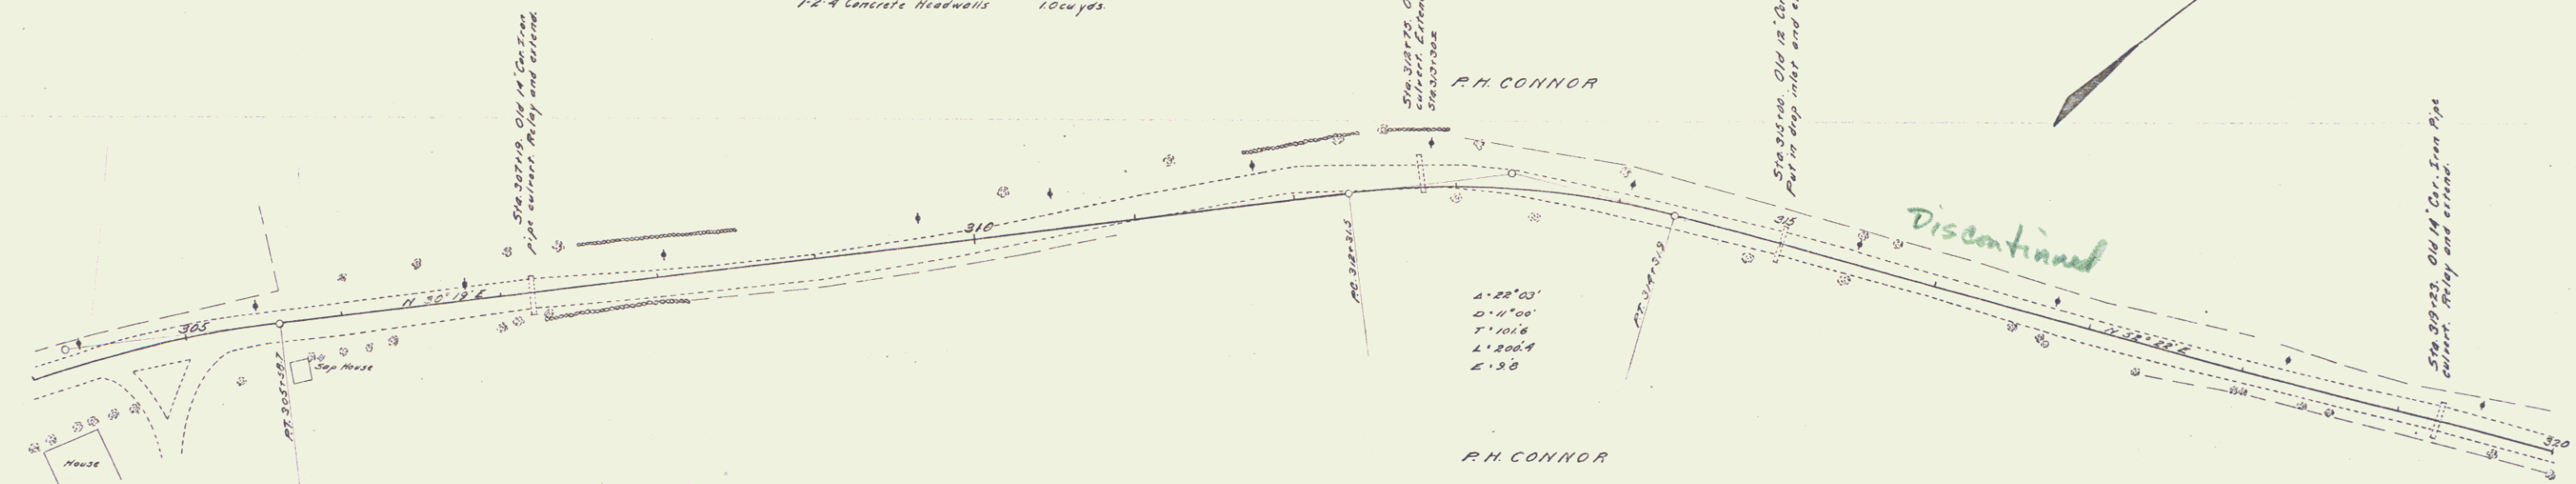

B.M. Spike in Elm left of 310+21 Elev 697.40
 B.M. Spike in Cherry right of 318+59, Elev 688.55

Series T No. 12-1124
 Sheet 25 of 133

GUARD RAIL REQUIRED
 75' ON LEFT
 Sta 322+00 to Sta 322+75 Length 75 ft
 332+00 - 332+75 75'
 ON RIGHT
 322+00 - 322+75 75'
 323+00 - 323+75 75'
 324+00 - 324+75 75'
 325+00 - 325+75 75'
 326+00 - 326+75 75'
 327+00 - 327+75 75'
 328+00 - 328+75 75'
 329+00 - 329+75 75'
 330+00 - 330+75 75'
 331+00 - 331+75 75'
 332+00 - 332+75 75'
 TOTAL THIS SHEET 332+75

STONE BASE REQUIRED
 Sta 331+00 to Sta 332+00 Length 100 ft
 331+00 - 332+00 100'

NEW CULVERT
 Sta 329+00 to Sta 330+00 Length 100 ft
 329+00 - 330+00 100'
 CULVERT
 Sta 332+00 to Sta 333+00 Length 100 ft
 332+00 - 333+00 100'
 REPAIRS REQUIRED
 Sta 332+00 to Sta 333+00 Length 100 ft
 332+00 - 333+00 100'

DIST. NO.	STATE	FED. AID	FISCAL
3	VT	12	1918-19



B.M. Spike in Pole left of 329+35, Elev 662.60
 D.M. S.E. corner middle Stone of door steps left of 331+57, Elev 662.18


NEW CULVERTS REQUIRED

near Sta 337+59 3'-2" Reinforced Concrete
1'-2" Concrete 80 cu yds.
1'-3" " 20 "
Steel 144 lbs.

Sta 339+57 12' EAT¹ 8'
1'-2" Concrete 140 cu yds.
72 " 4"
= 345.5 cu yds 14' EAT 4"
1'-2" " 1.0
12 cu yds.

" 339+65 14" Cor. Iron Pipe 26 ft.
1'-2" Concrete 10 cu yds.

FED ROAD DIST. No	STATE	FED AID PROJ. No	FISCAL YEAR	SHEET No	TOTAL SHEET
9	VT.	12	1918-20	25	133

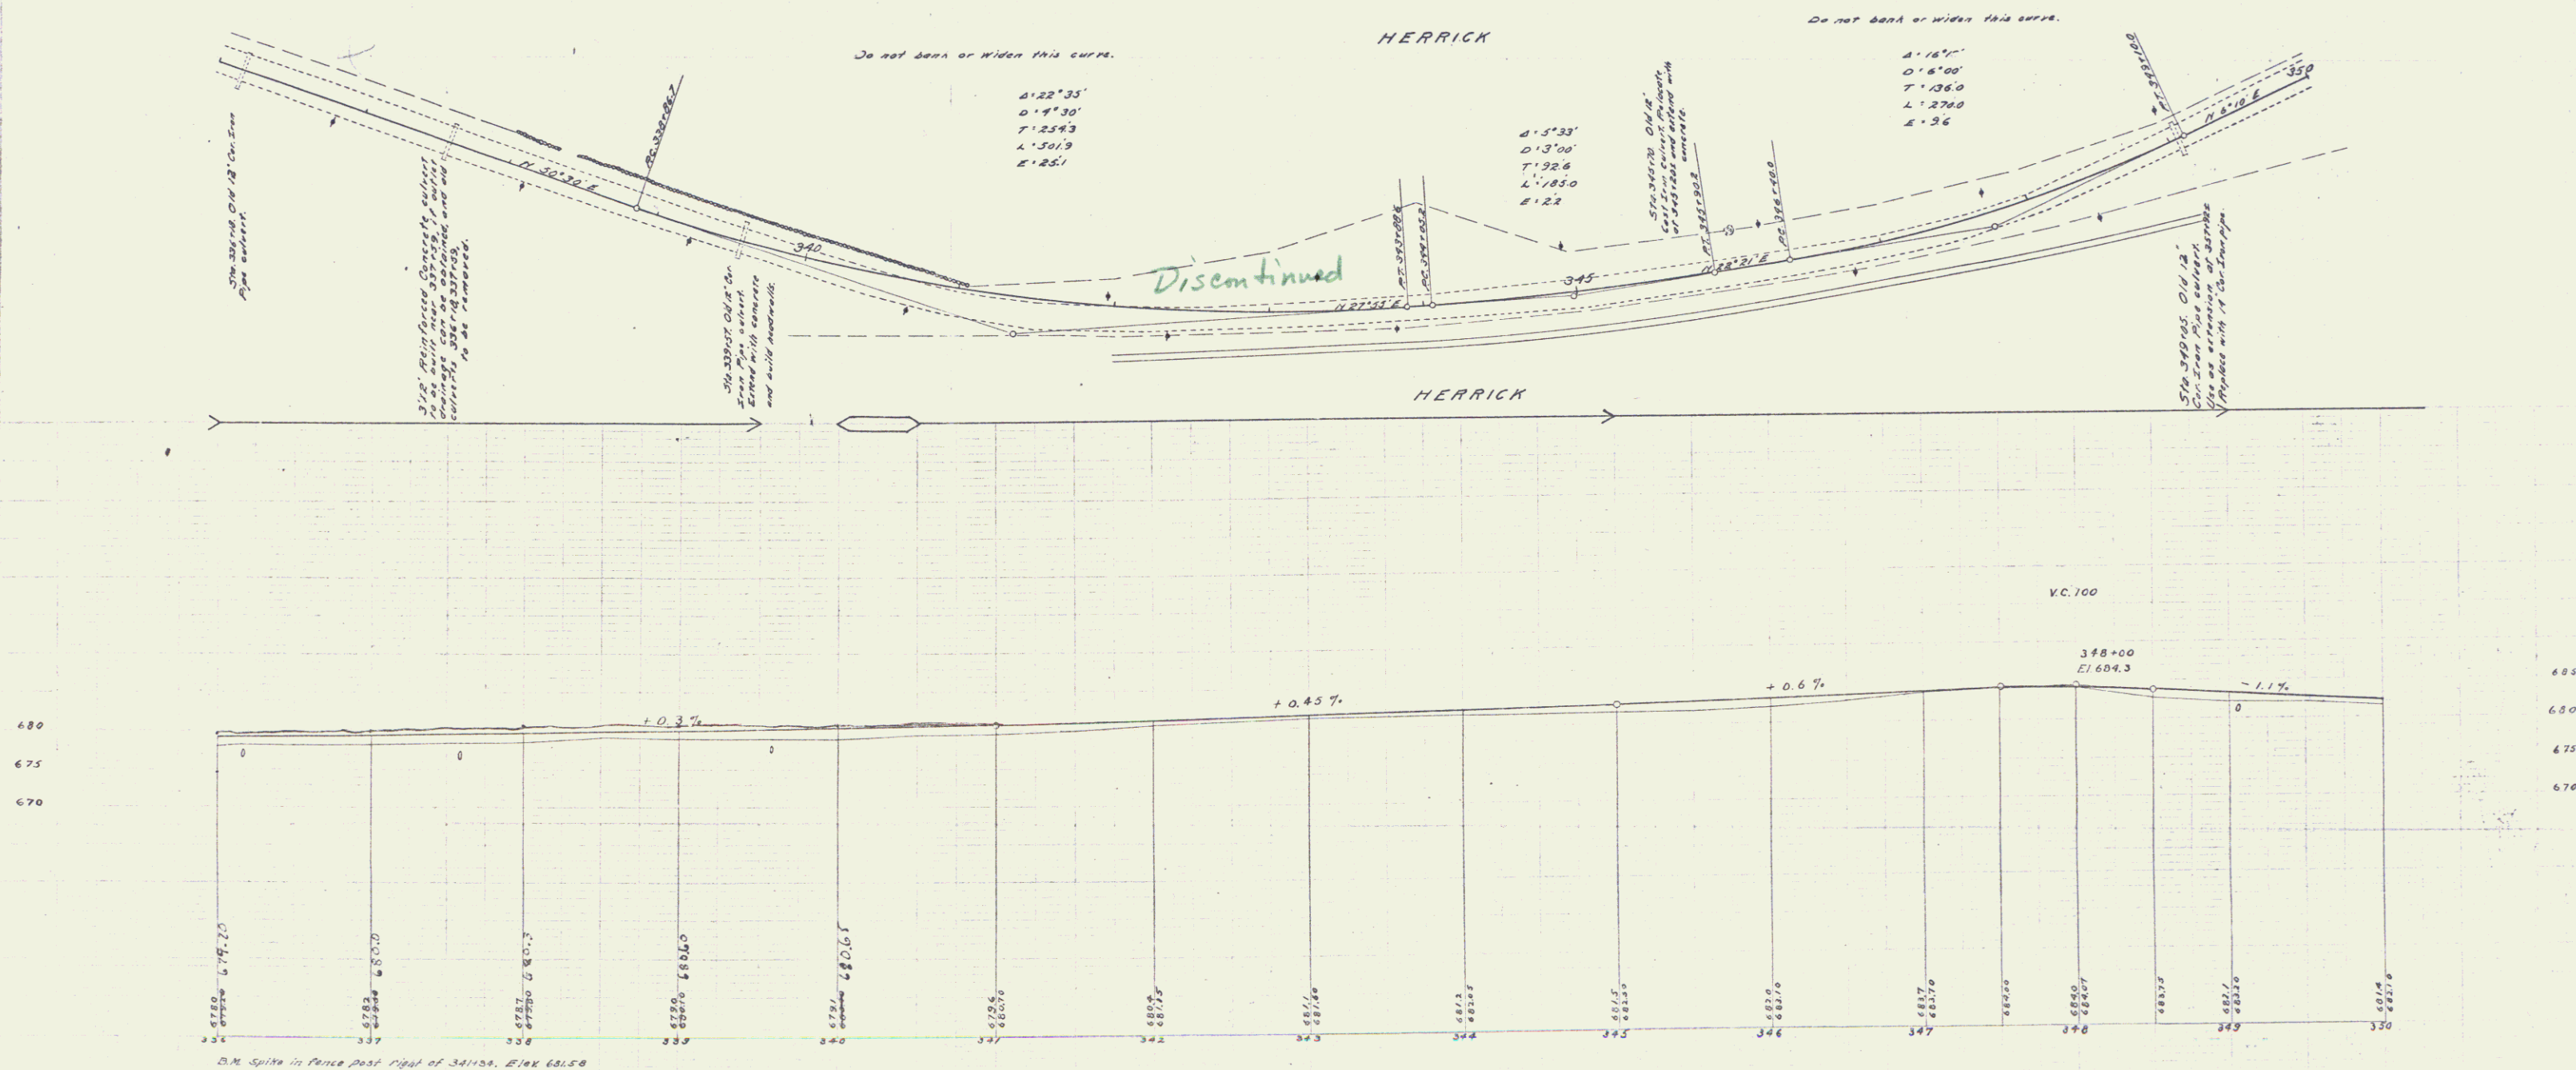

GUARD RAIL REQUIRED

ON LEFT

Sta. 351+00 to Sta. 351+04 Length 24 ft.

" 357+00 " 357+04 " 24 "

ON RIGHT

" 351+00 to Sta. 351+04 " 24 "

" 357+00 " 357+04 " 24 "

" 357+00 " 357+04 " 24 "

" 357+00 " 357+04 " 24 "

ON LEFT

" 353+00 to Sta. 353+04 " 24 "


" 361+00 " 361+04 " 24 "

FOIPA b7C, b7D DELETED

521

CULVERT REPAIRS REQUIRED

Sta 351+32	12" Cor Iron Pipe (Extension)	8 ft.
	1'-2" Concrete Headwalls	12 cu yds.
Sta 357+92	12" Cor Iron Pipe (Ext)	4 ft
	1'-2" Concrete Headwalls	10 cu yds. ✓
Sta 363+35		12
	1'-2" Concrete	7 1/2 cu yds
Sta 361+50	14" Cor Iron Pipe	30 ft. ✓
	1'-2" Concrete	10 cu yds.

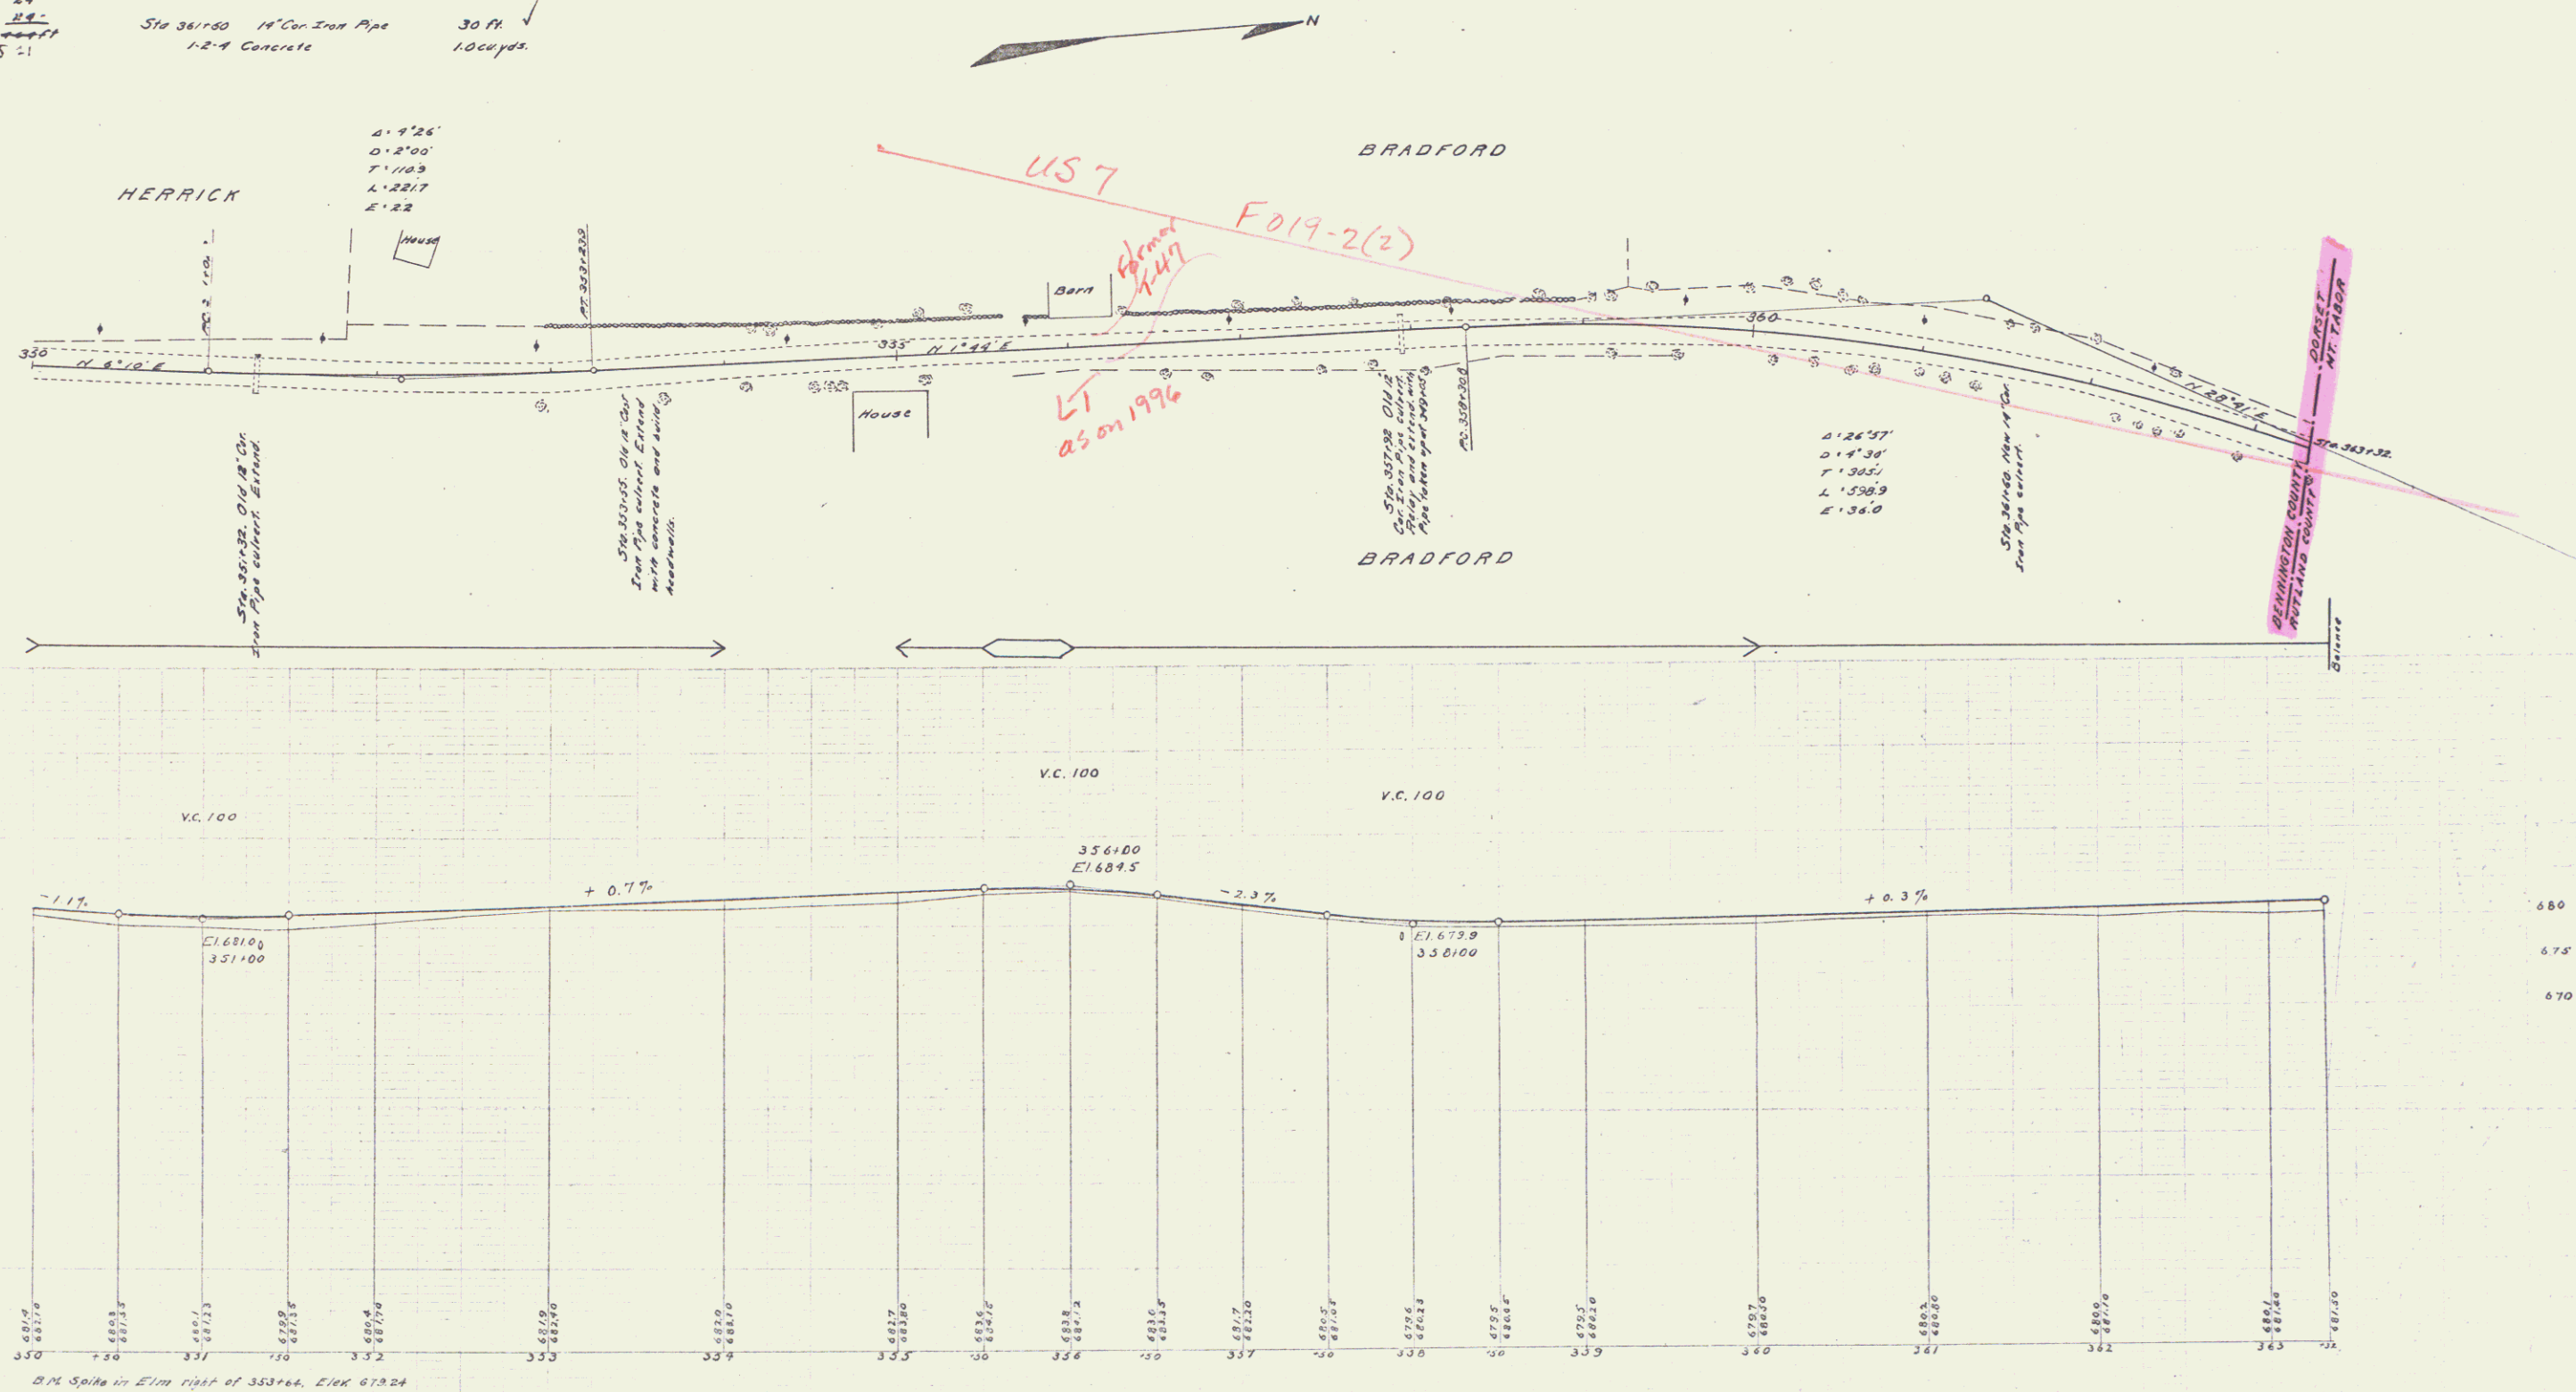


Series F. No 12 Filed
Sheet 26 of 133

GUARD RAIL REQUIRED
ON LEFT
Sta. 364+88 to Sta. 365+12 Length 24 ft.
" 374+13 " 374+37 " 24 "
ON RIGHT
" 365+16 to Sta. 365+18 " 136 "
" 368+30 " 369+44 " 24 "
" 374+13 " 374+37 " 24 "
TOTAL THIS SHEET 324 ft.


CULVERT REPAIRS REQUIRED
Sta. 365+00 16" Cor. Iron Pipe (Extension) 4 ft.
12" 4" Concrete Headwalls 15 cu. yds.
Sta. 374+25
12" 4" Concrete Headwalls 20 cu. yds.

FED. ROAD DIST. NO.	STATE	FED. AID PROJ. NO.	FISCAL YEAR	SHEET NO.	TOTAL SHEETS
8	Yr.	12	1949-50	27	133

U.L. Davis
W.D. and C. Kelly
1950

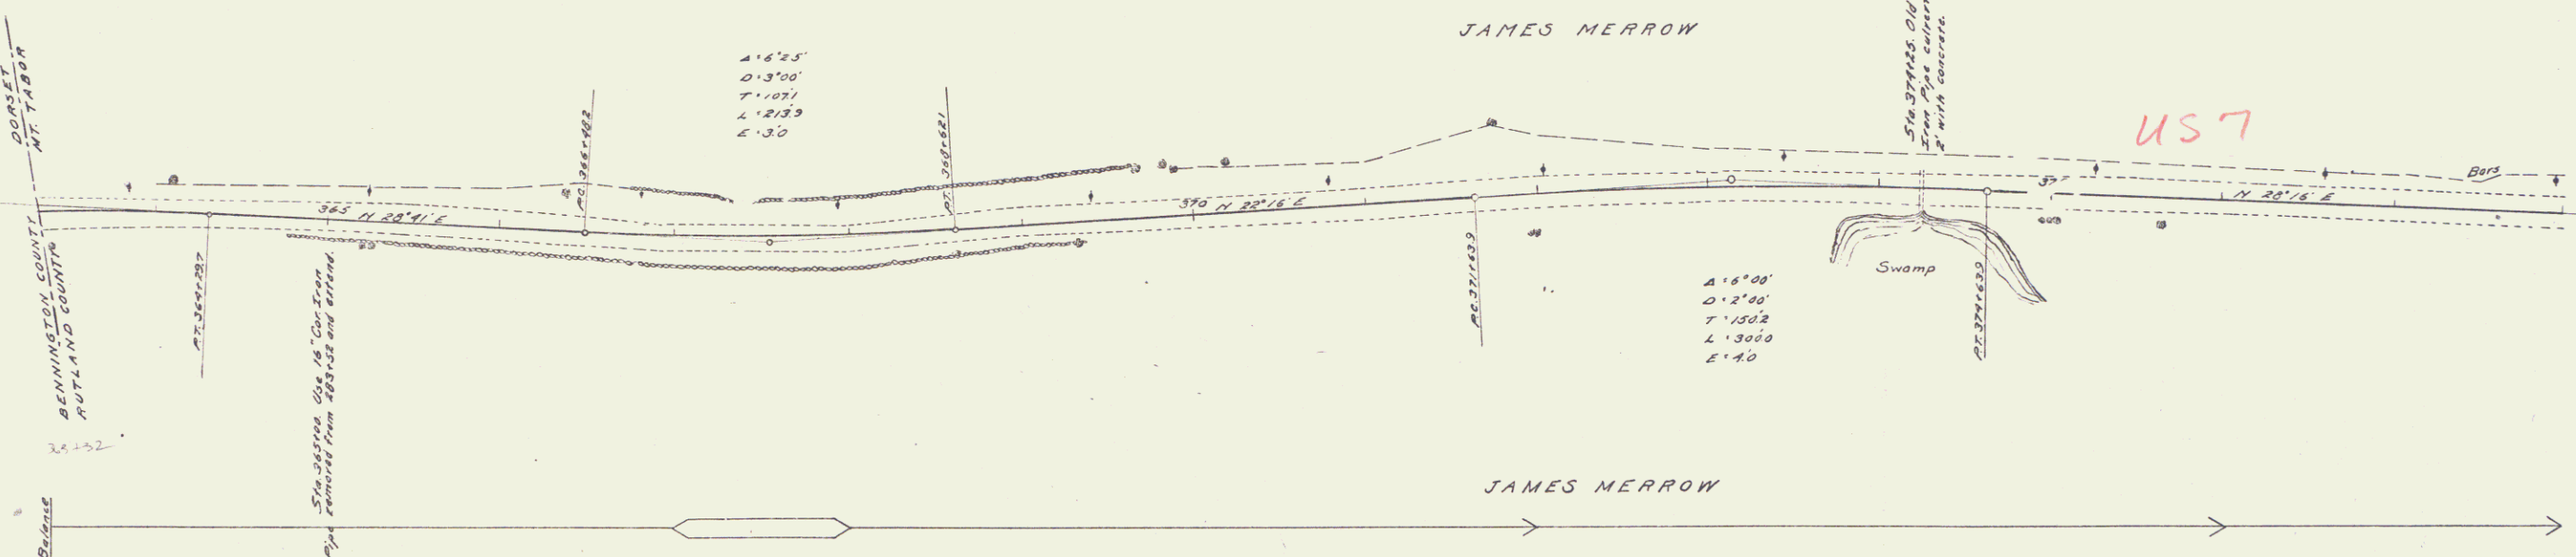

U.L. Davis
W.D. and C. Kelly
1950

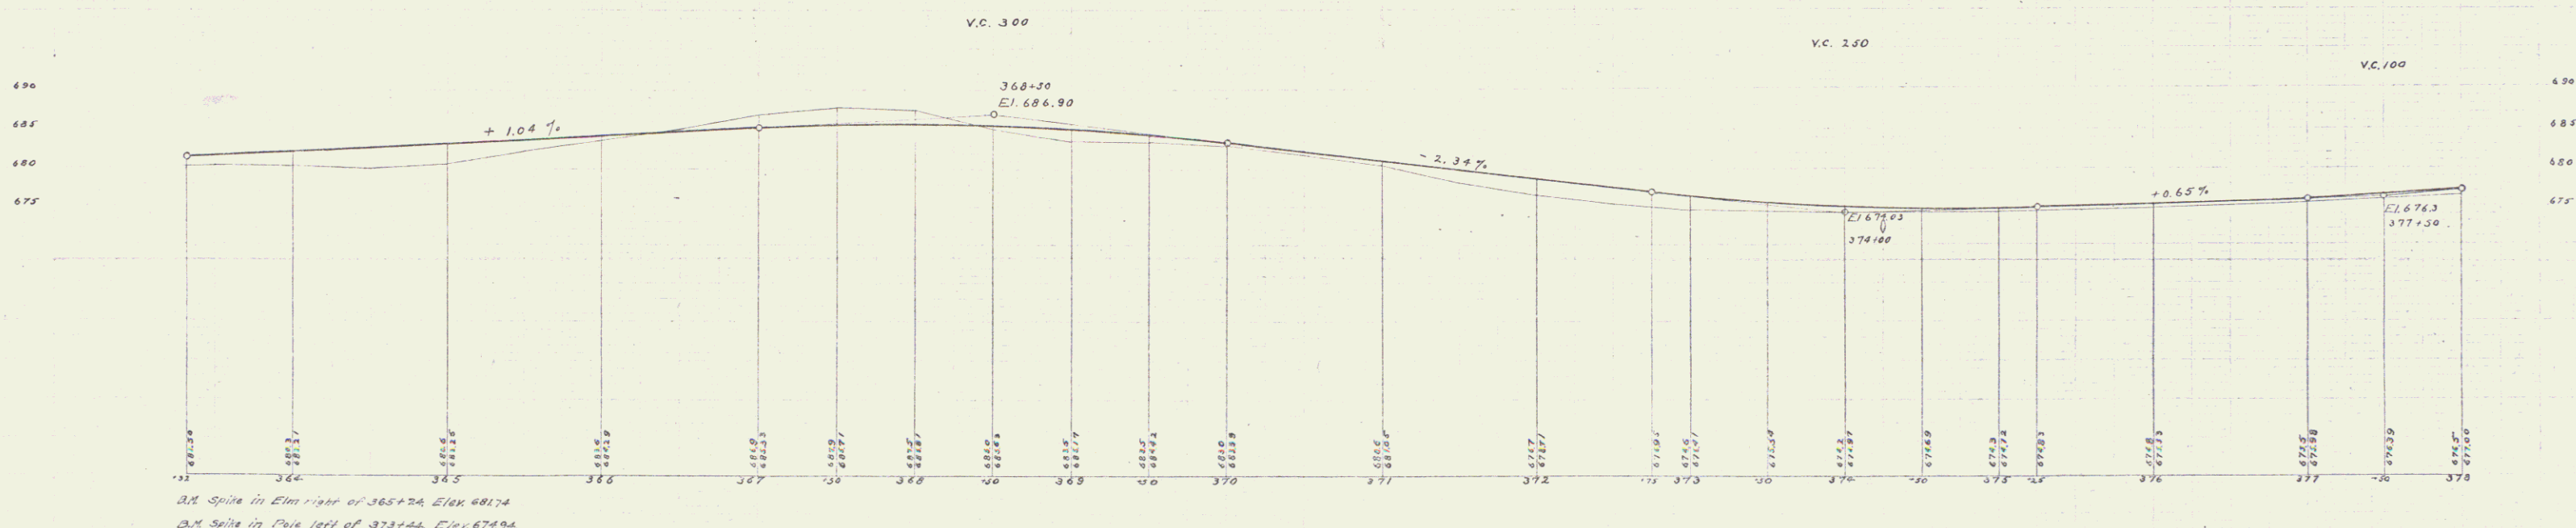

Surveyed by F. H. Fildes
Check by J. H. Fildes

GUARD RAIL REQUIRED
ON LEFT
Sta 384+16 to Sta 384+70 Length 54 ft.
- 387+37 " 387+61 " 24"
- 331+49 " 332+13 " 64"
ON RIGHT
- 384+16 to Sta 384+70 " 24"
- 387+37 " 387+61 " 24"
- 330+20 " 333+00 " 280"
TOTAL THIS SHEET 440 ft.



CULVERT REPAIRS REQUIRED
Sta 384+38
1-2-4 Concrete Headwalls 10 cu yds.
Sta 387+49
1-2-4 " 10 cu yds.
Sta 391+62
1-2-4 " 20 cu yds.

BLIND DRAIN REQUIRED
Sta 386+00 Broken Stone 1 cu yds.
Sta 386+50 " 36 "
Sta 387+00 " 34 "

PRO. ROAD DIST. IN.	STATE	PRO. AID	FISCAL YEAR	SHEET NO.	TOTAL SHEETS
8	VT.	12	1916-17	20	133

J.L. Davis
J.L.D. and C.H. Day
11/15/16



11/15/16
J.L. Davis
J.L.D. and C.H. Day
11/15/16

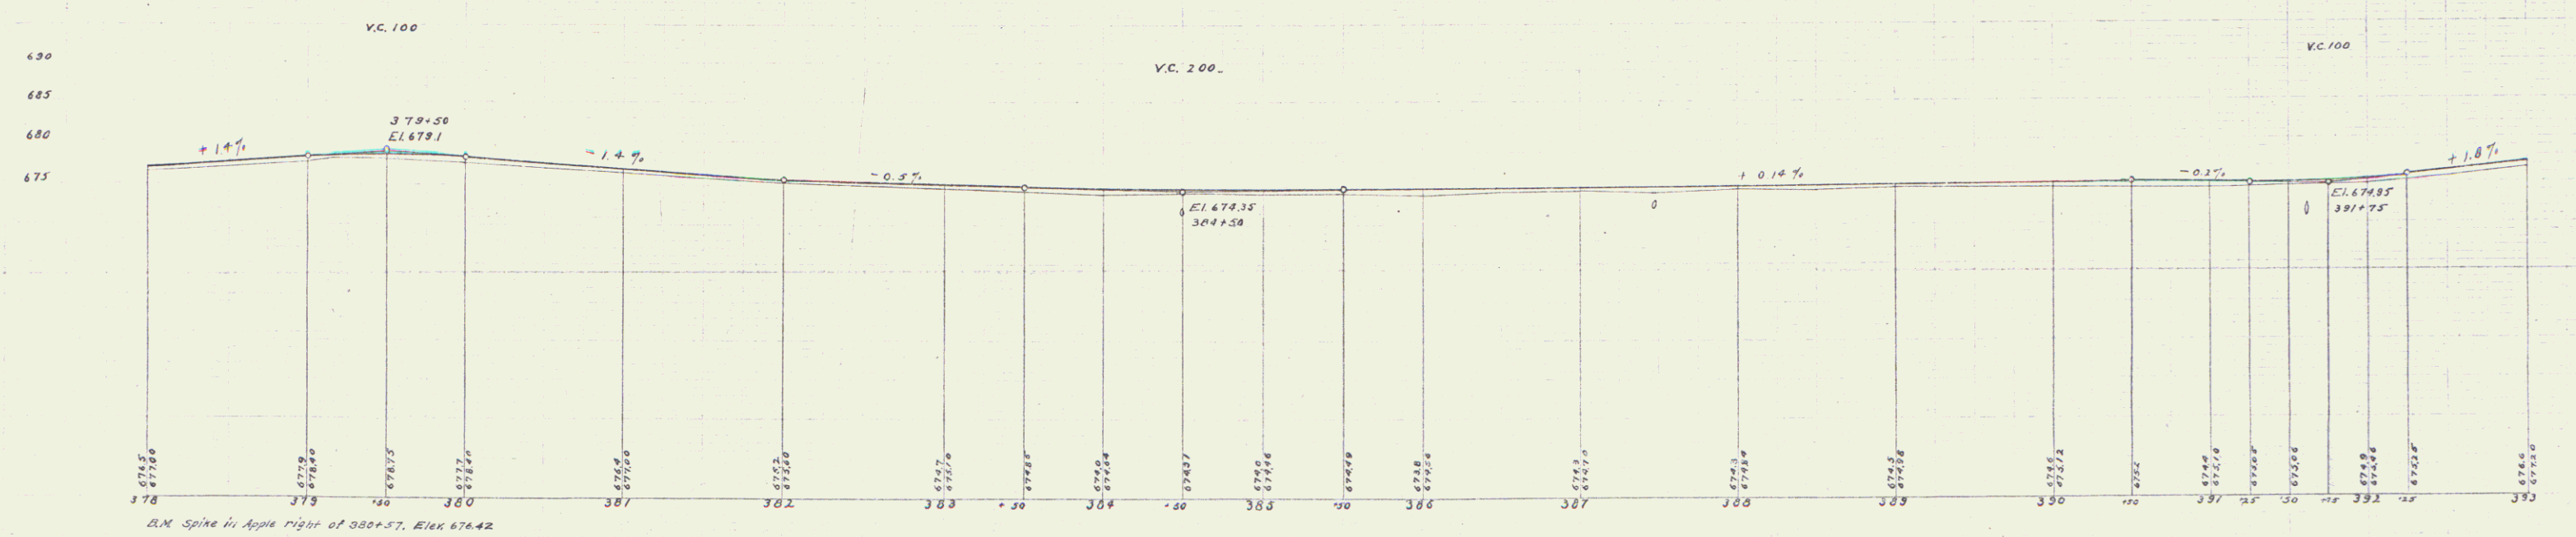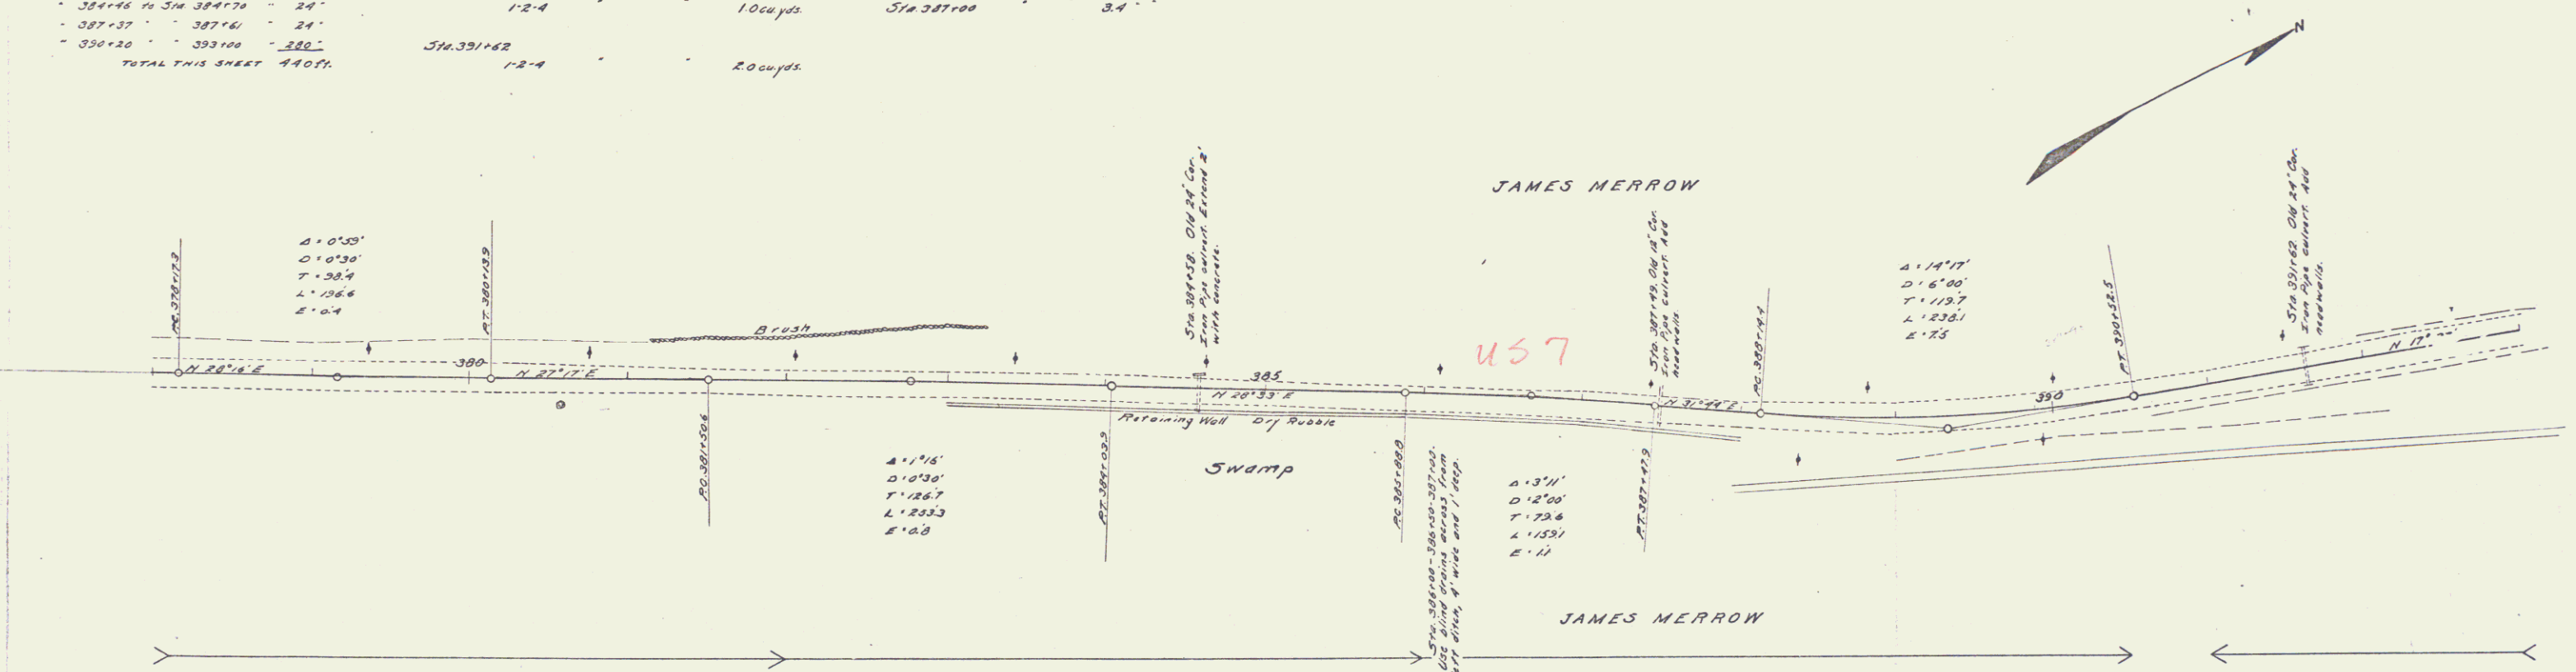

Series R. 10/15/16
S.A. 10/15/16

GUARD RAIL REQUIRED
 ON LEFT
 Sta 400+30 to Sta 401+22 Length 24 ft.
 407+33 " 5' 408+33 " 24"
 ON RIGHT
 393+00 to Sta 393+24 " 24"
 394+70 " 395+66 " 36"
 400+18 " 401+22 " 104"
 407+33 " 408+33 " 24"
 TOTAL THIS SHEET 236 ft.

FED. ROAD DIST. NO.	STATE	FED. AID PROJ. NO.	FISCAL YEAR	SHEET NO.	TOTAL SHEETS
8	VT	12	1948	28	133

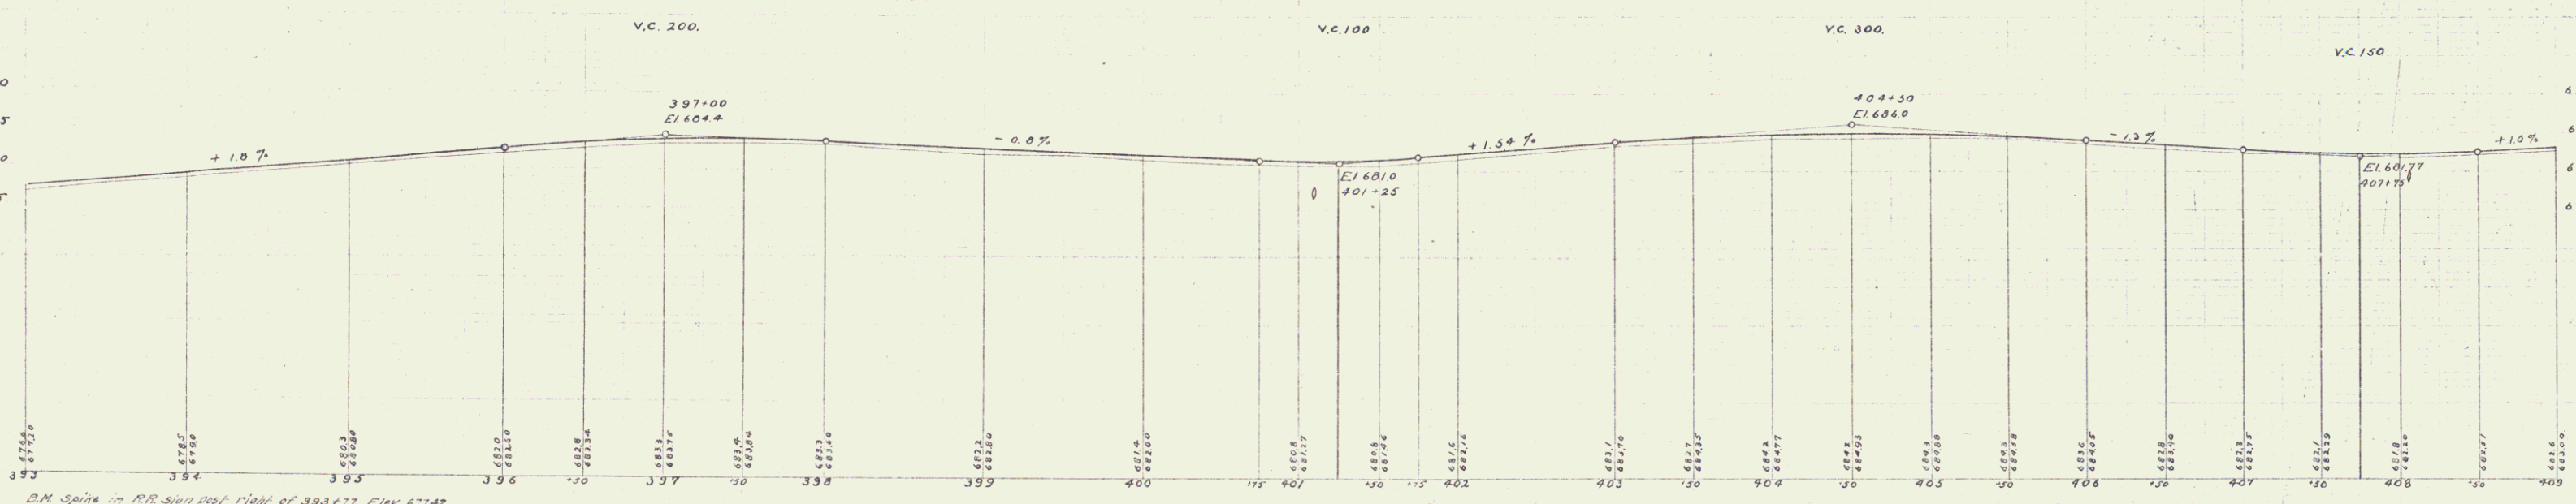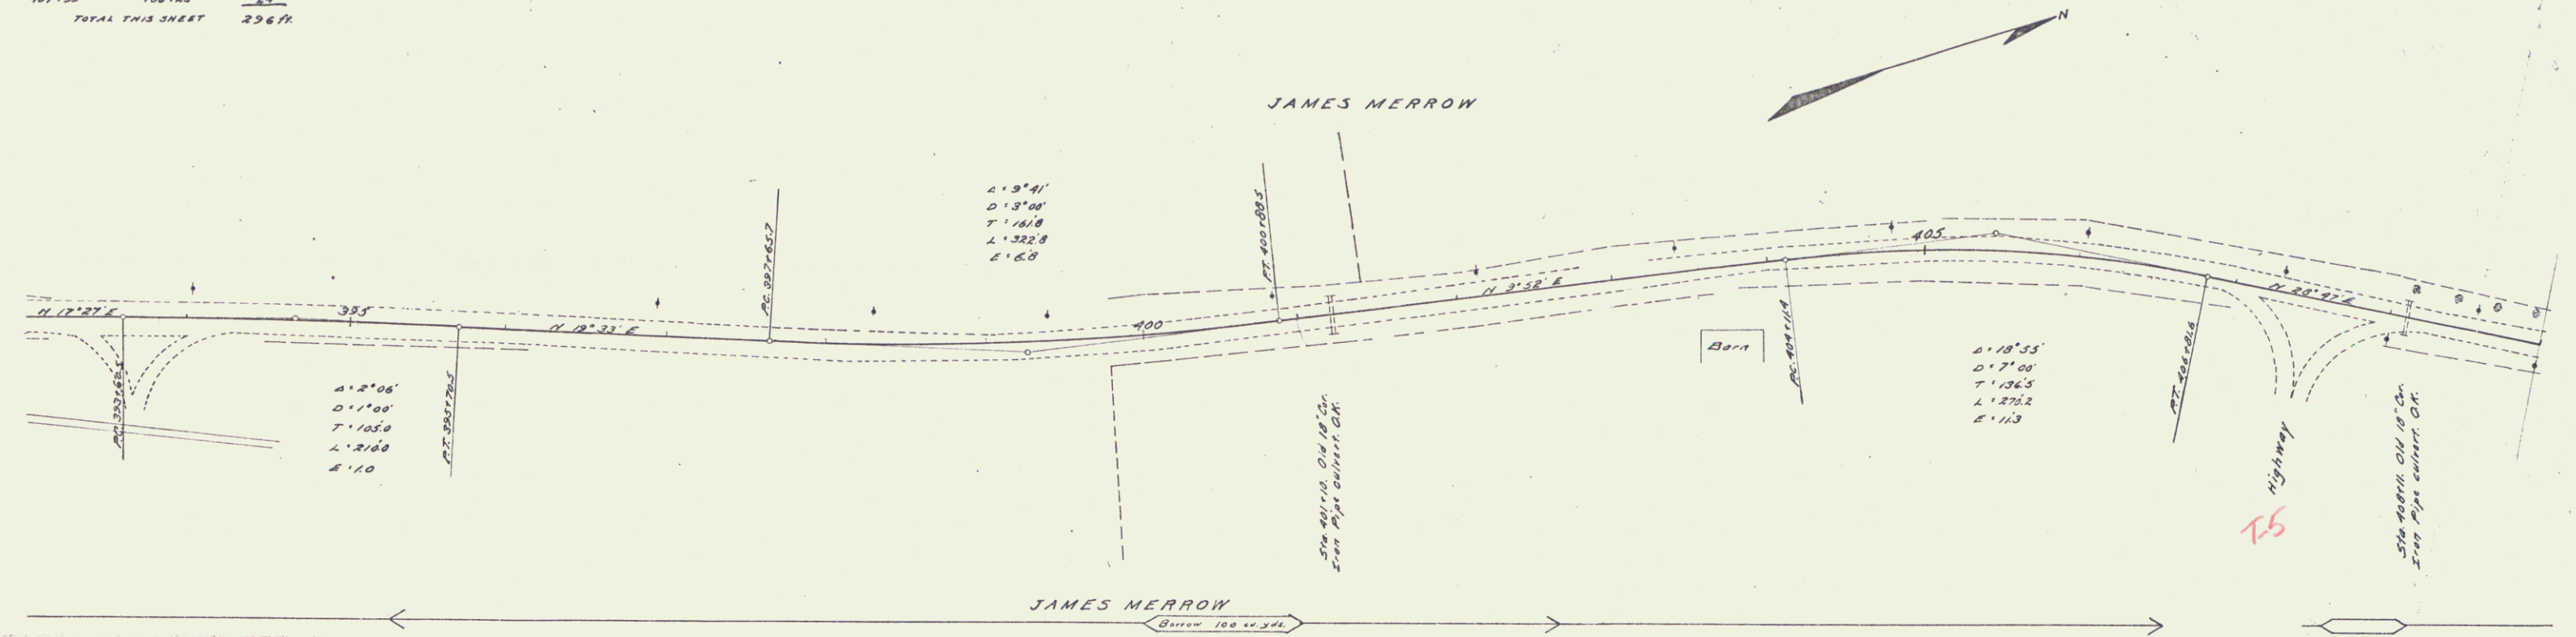

B.M. Spike in RR sign post right of 393+77, Elev. 672.42
 B.M. Spike in Elm right of 401+87, Elev. 680.01


Series C. 1948
 Since 28 7/13

GUARD RAIL REQUIRED
ON LEFT
 Sta 410+88 to Sta 411+18 Length 30 ft
 411+12 413+32 24'
 413+45 418+89 24'
ON RIGHT
 410+88 to Sta 411+18 24'
 412+36 412+80 24'
 413+65 418+89 24'
 419+32 420+00 24'
TOTAL THIS SHEET 100 ft.


CULVERT REPAIRS REQUIRED
 Sta 411+03
 1-3-6 Concrete Headwalls 20 cu yds.
 Sta 412+68 21' Concrete 28.5 ft.
 1-2-4 Concrete 5.8 cu yds.
 1-3-6 " 26 "
 Sta 418+77
 1-3-6 Concrete Headwalls 25 cu yds.

FED. ROAD DIST. NO.	STATE	FED. AID PROJ. NO.	FISCAL YEAR	SHEET NO.	TOTAL SHEETS
3	VT	12	FY-50	38	133

L.L. Davis, Millis
 U.S.D. and Chas. (1950)

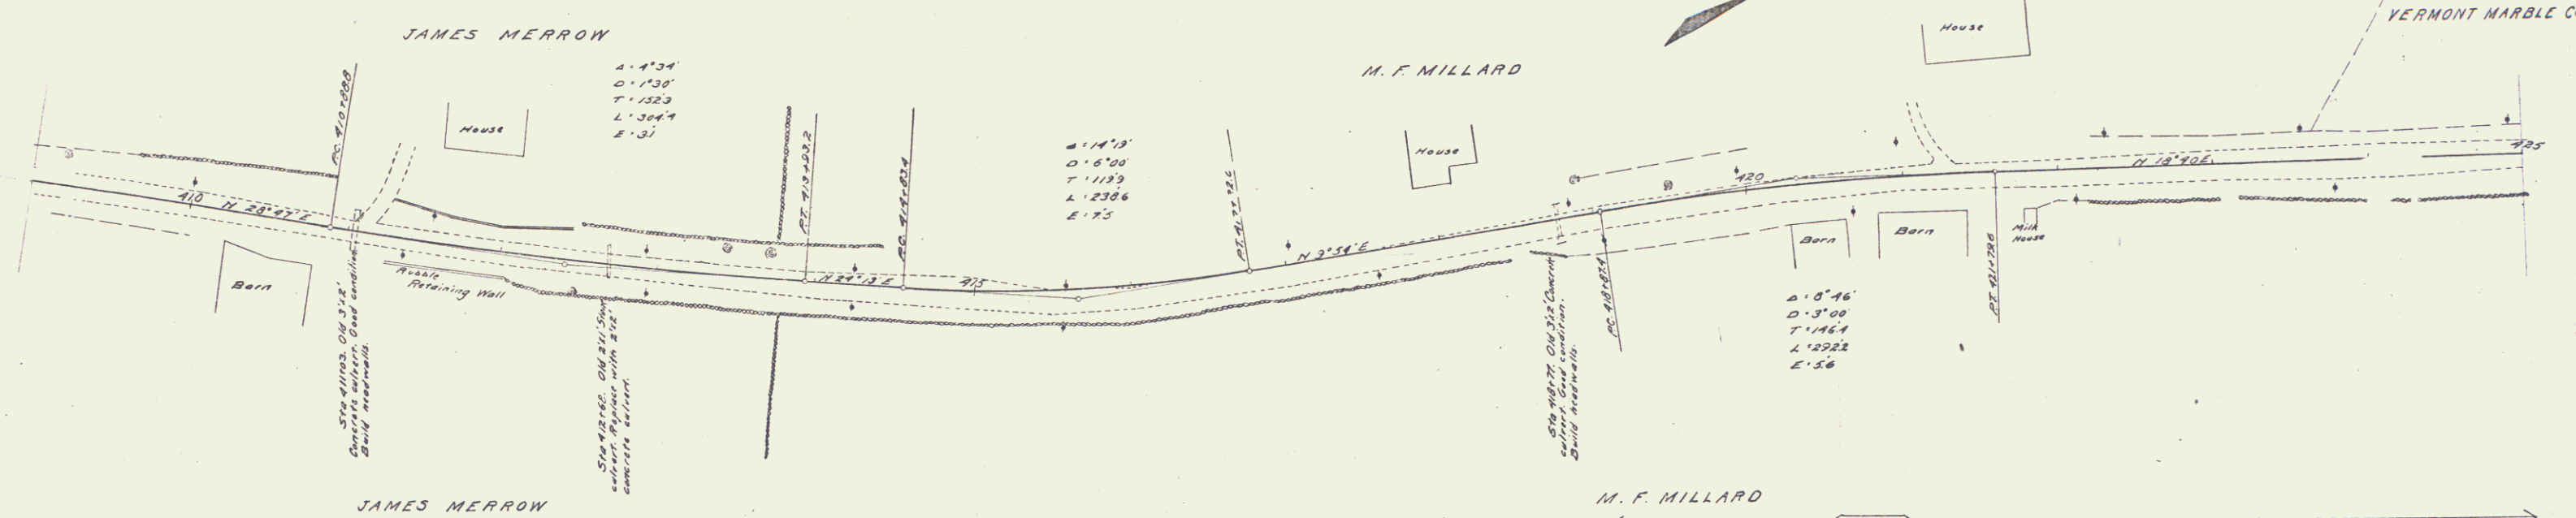

L.L. Davis, Millis
 U.S.D. and Chas. (1950)

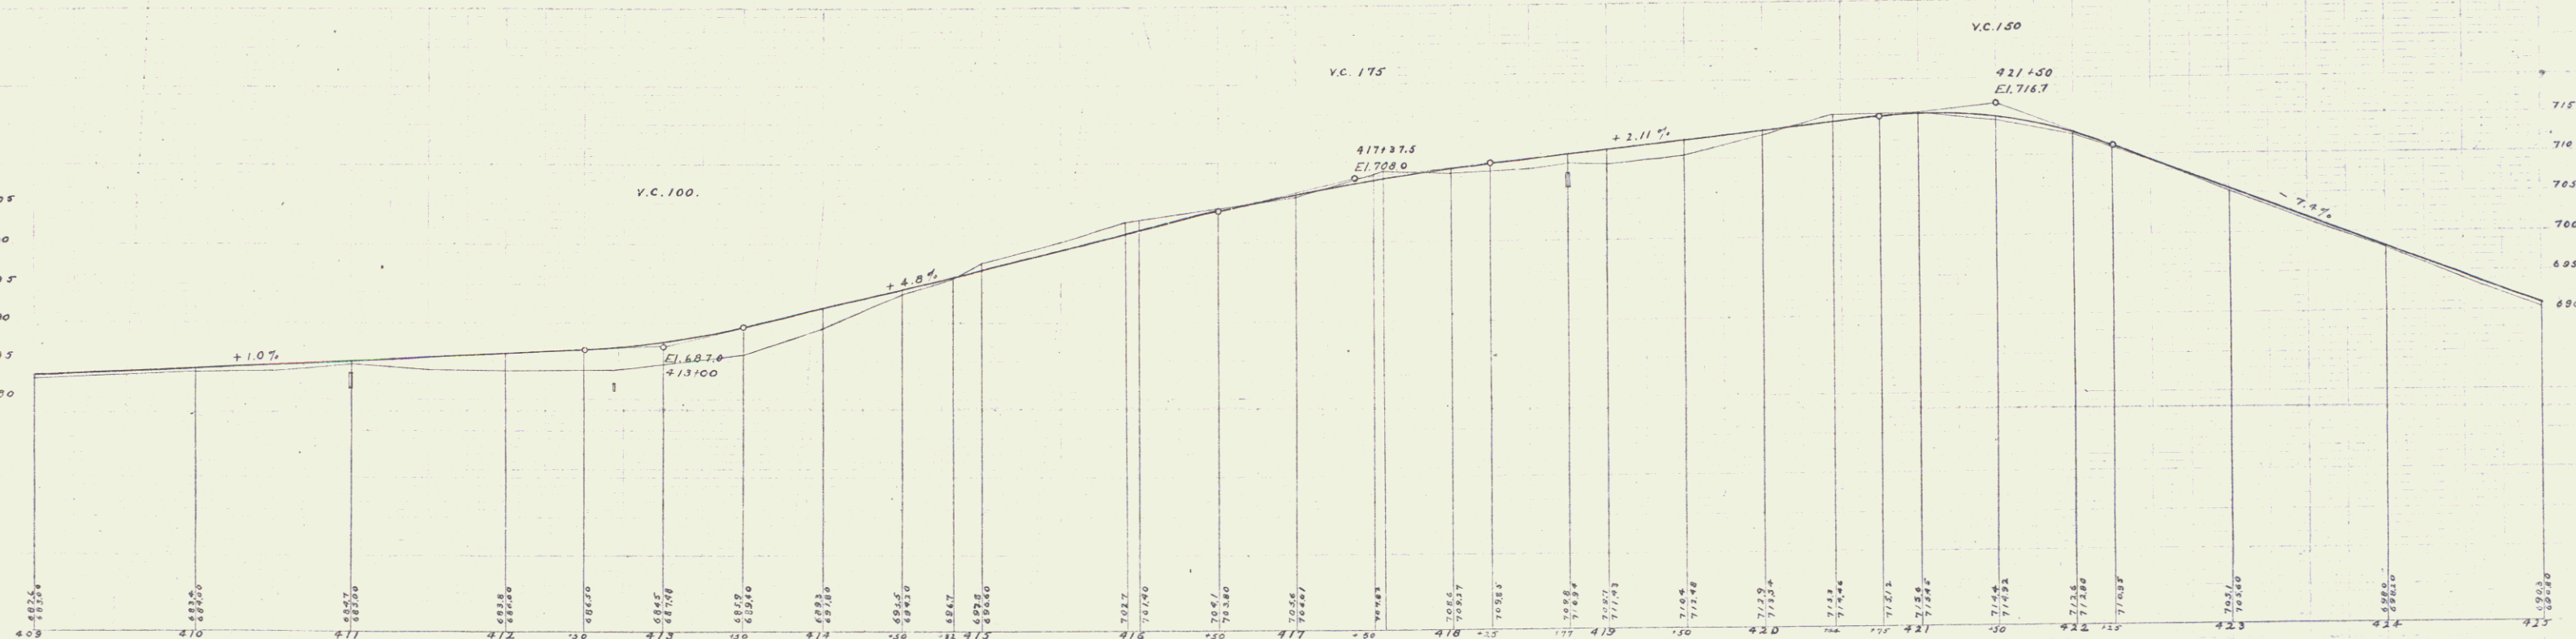



GUARD RAIL REQUIRED
ON LEFT
Sta 430+02 to Sta 430+28 Length 26 ft.
436+62 " 436+86 " 24"
ON RIGHT
430+02 to Sta 430+54 " 60"
431+20 " 437+20 " 600"
438+10 " 439+00 " 90"
TOTAL THIS SHEET 800 ft.

CULVERT REPAIRS REQUIRED
Sta 430+14 18" Cor. Iron Pipe 28 ft.
12" Concrete Headwalls 15 cu yds.
Sta 436+74 18" Cor. Iron Pipe 32 ft.
12" Concrete Headwalls 15 cu yds.

FED. ROAD DIST. NO.	STATE	FED. AID FISCAL YEAR	SHEET NO.	TOTAL SHEETS
8	VT	12	28	31

J.L. Davis, 1919
J.L.D. and C.H. Day 1919

L.C. Green, 1919
W.E. Walker, 1919
J.L. Davis, 1919

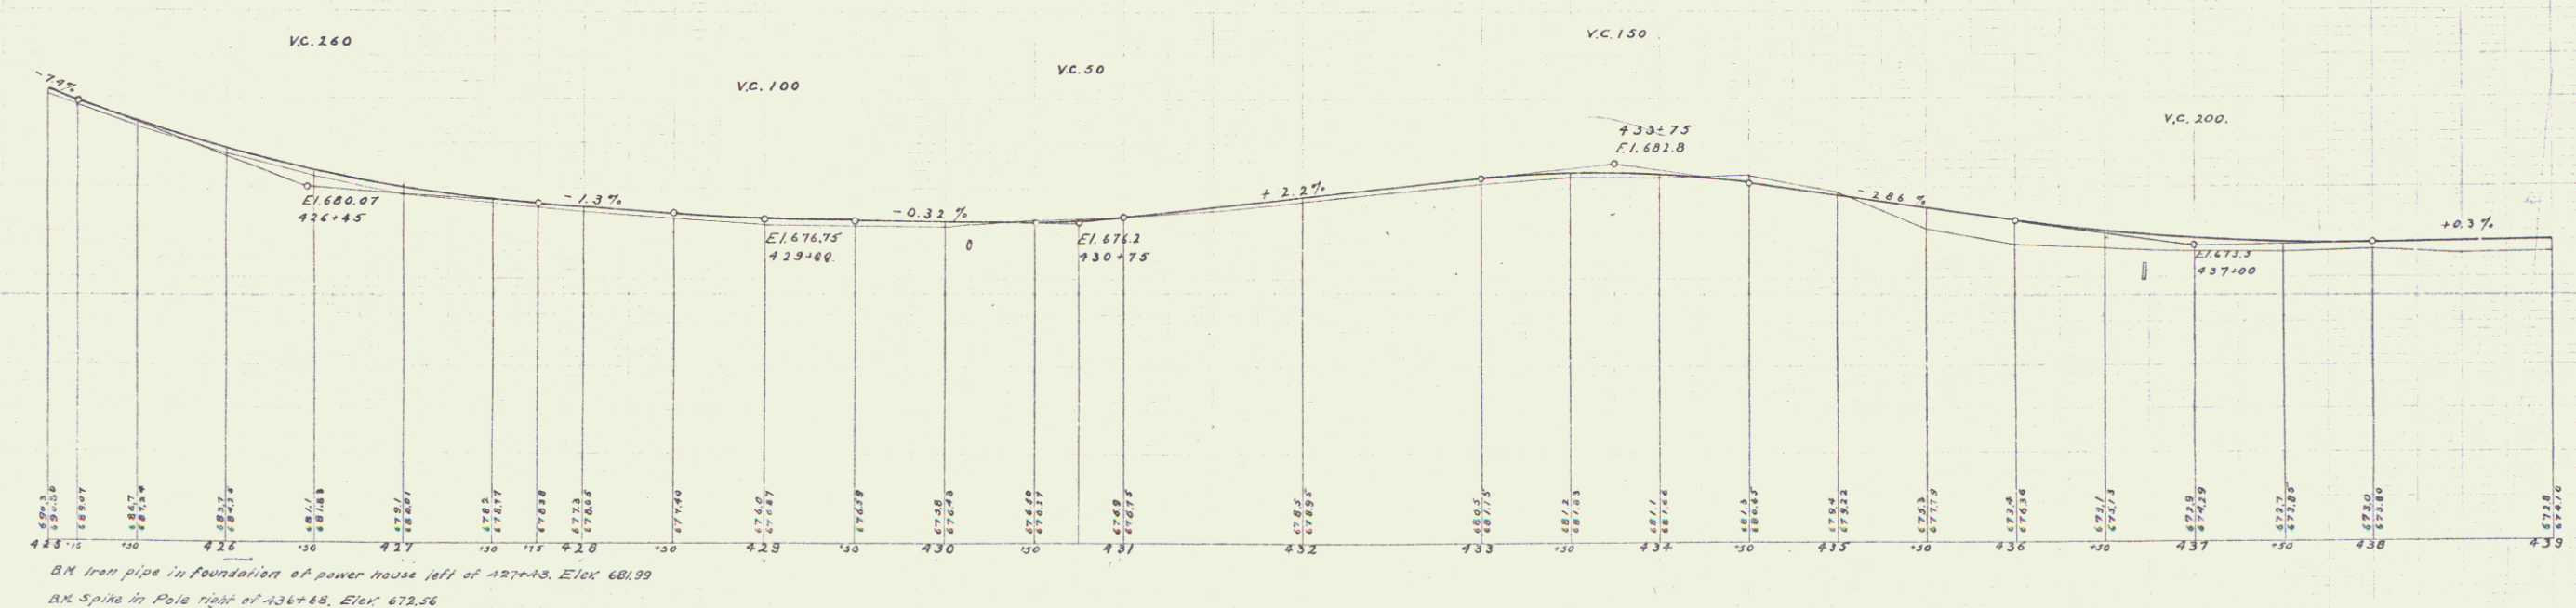
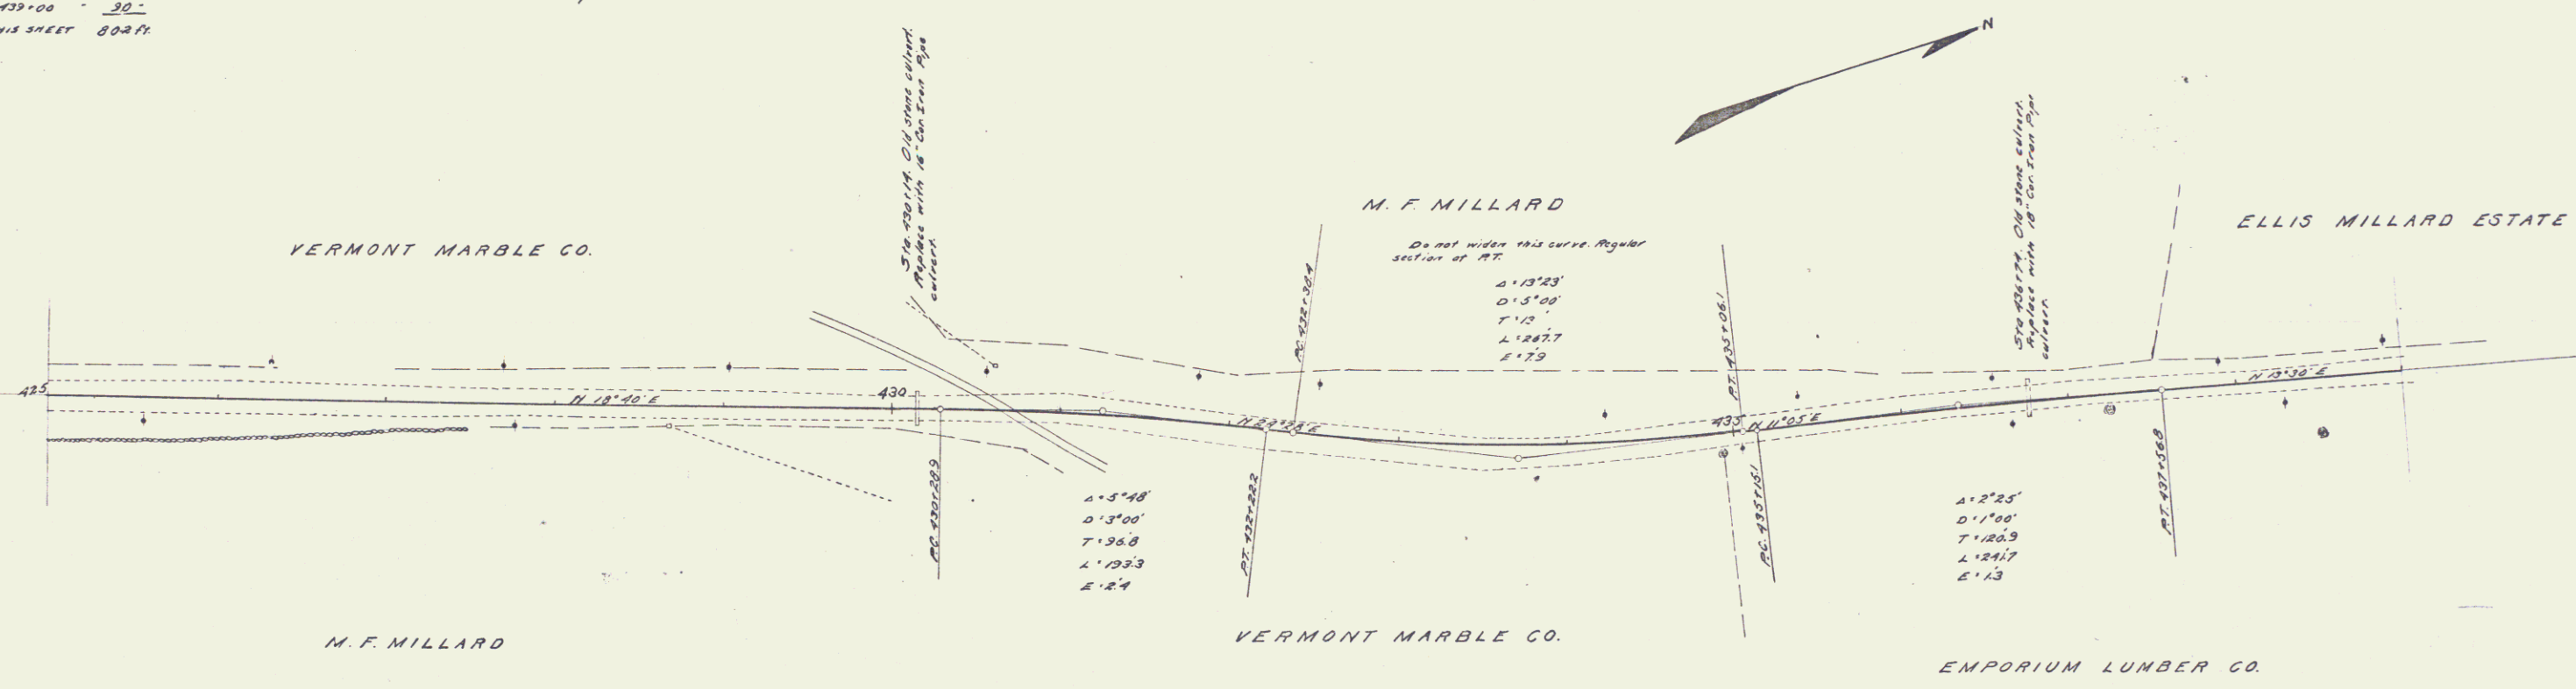


Series 1, 1919, 1920, 1921, 3748,

GUARD RAIL REQUIRED
 ON LEFT
 Sta 442+34 to Sta 442+58 Length 24 ft.
 " 448+32 " 449+16 " 24'
 " 454+73 " 454+97 " 24'
 ON RIGHT
 " 439+00 to Sta 442+58 " 358'
 " 448+79 " 451+78 " 304'
 " 453+80 " 455+00 " 120'
 TOTAL THIS SHEET 1054 ft.

CULVERT REPAIRS REQUIRED
 Sta 442+96 18" Cor. Iron Pipe (Extension) 6 ft.
 12" Concrete Headwalls 15 cu yds.
 Sta 449+04 14" Cor. Iron Pipe (Extension) 10 ft.
 12" Concrete Headwalls 12 cu yds.
 Sta 454+85 24" Concrete 25.6 ft.
 12" Concrete 5.2 cu yds.
 13.6 "

FED. ROAD DIST. NO.	STATE	FED. AID PROJ. NO.	FISCAL YEAR	SHEET NO.	TOTAL SHEETS
8	VT	12	1934-35	32	133

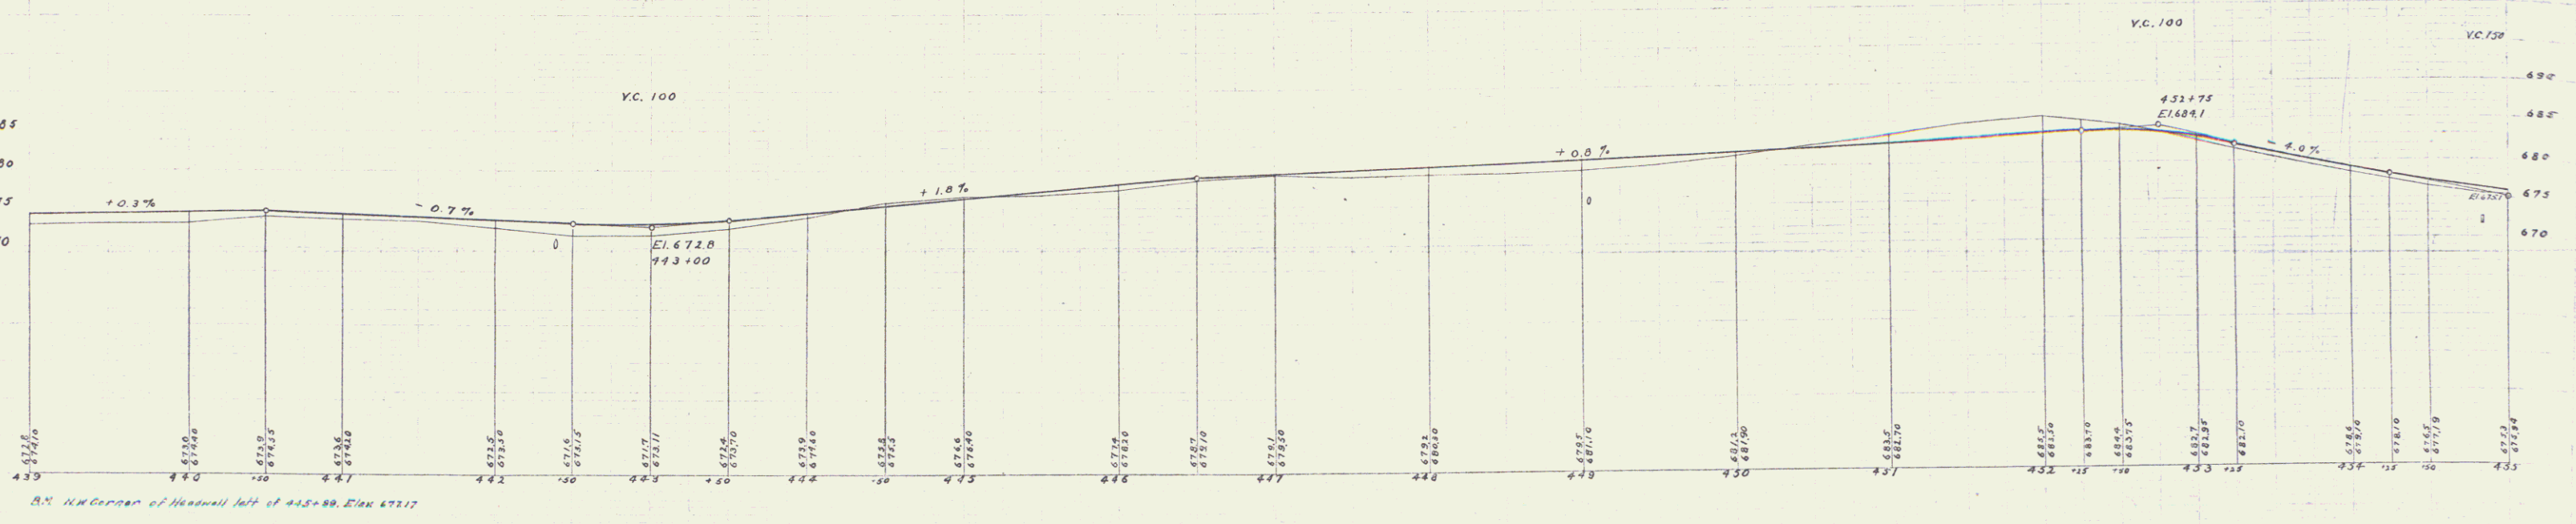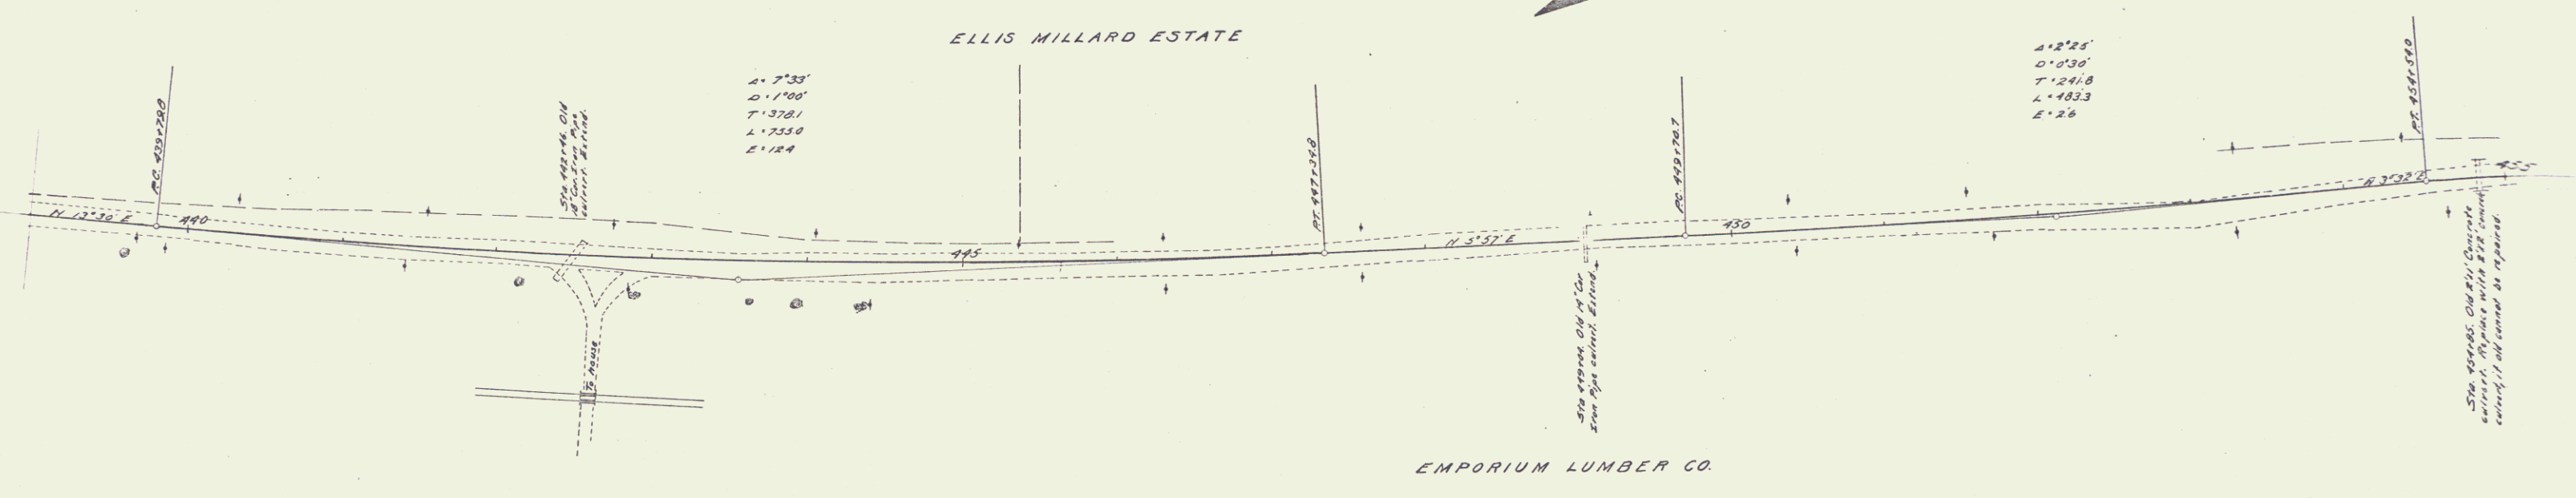

Drawn by F. W. [illegible] 1/33



GUARD RAIL REQUIRED
 ON LEFT
 Sta 459+58 to Sta 459+82 Length 24 ft.
 - 464+88 - 465+12 - 24'
 - 469+10 - 469+34 - 24'
 ON RIGHT
 - 455+00 to Sta 463+72 - 1072'
 - 468+30 - 469+34 - 104'
 TOTAL THIS SHEET 1240 ft.

CULVERT REPAIRS REQUIRED
 Sta 459+70
 12" Concrete Headwall 13 cu yds.
 Sta 465+00 14" Con. Iron Pipe 32 ft.
 12" Concrete 11 cu yds.
 Sta 469+22 14" Con. Iron Pipe (Extension) 9 ft.
 12" Concrete 13 cu yds.

PROJ. NO.	STATE	FED. AID	FISCAL YEAR	SHEET NO.	TOTAL SHEETS
5	VT	12	1918-19	32	133

J.L. Davis, Ch. Eng. 11/1918

J.L. Davis, Ch. Eng. 11/1918

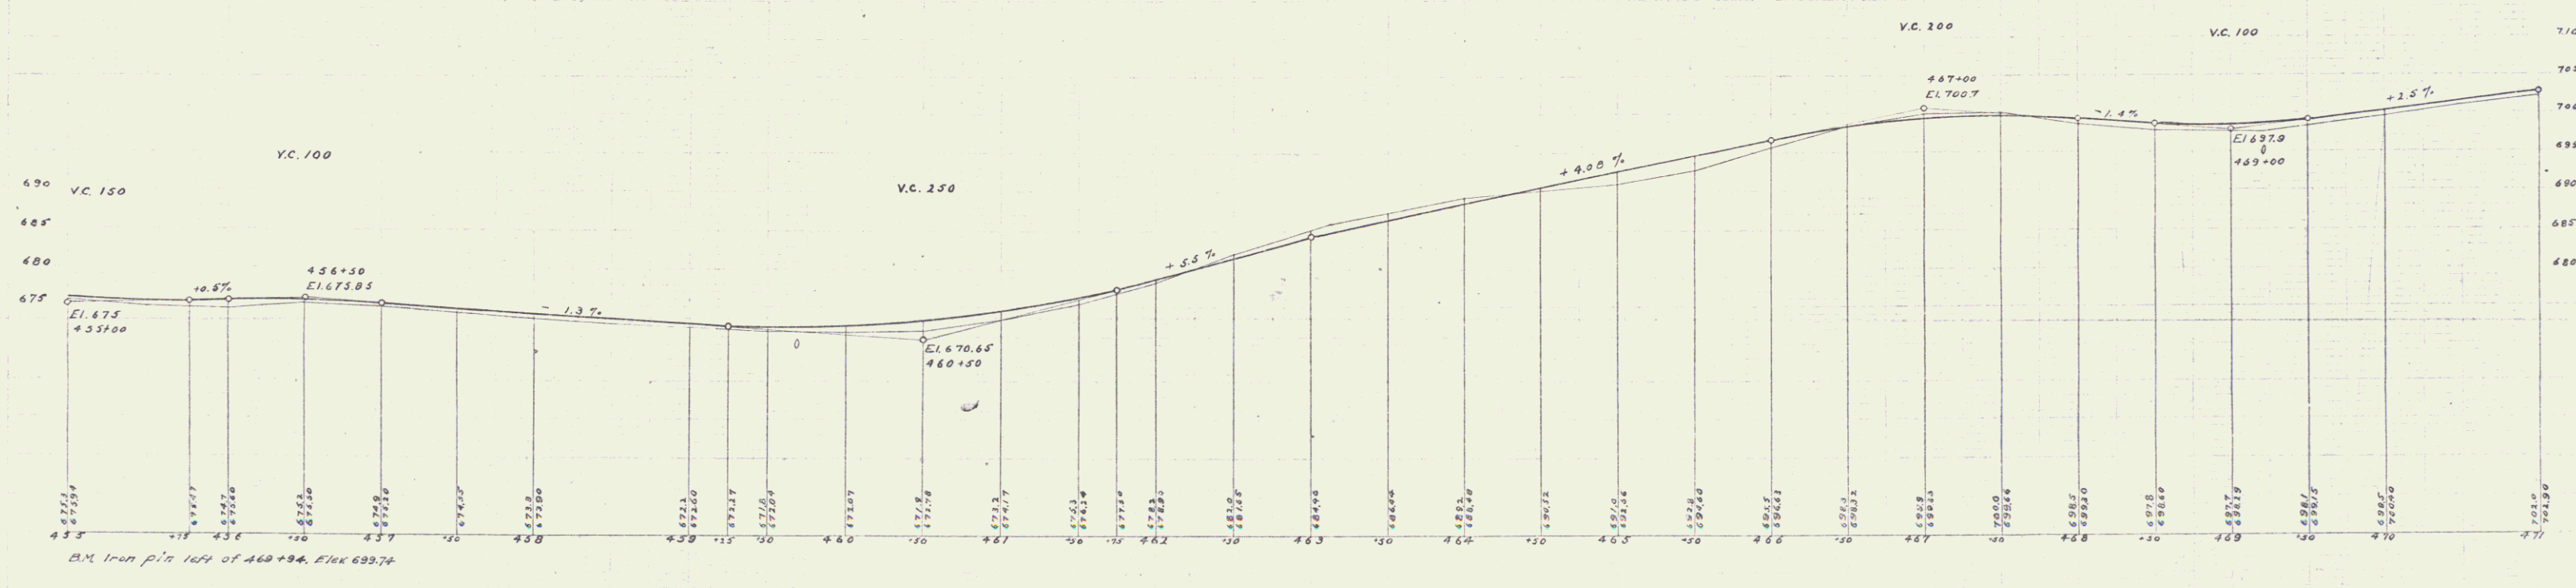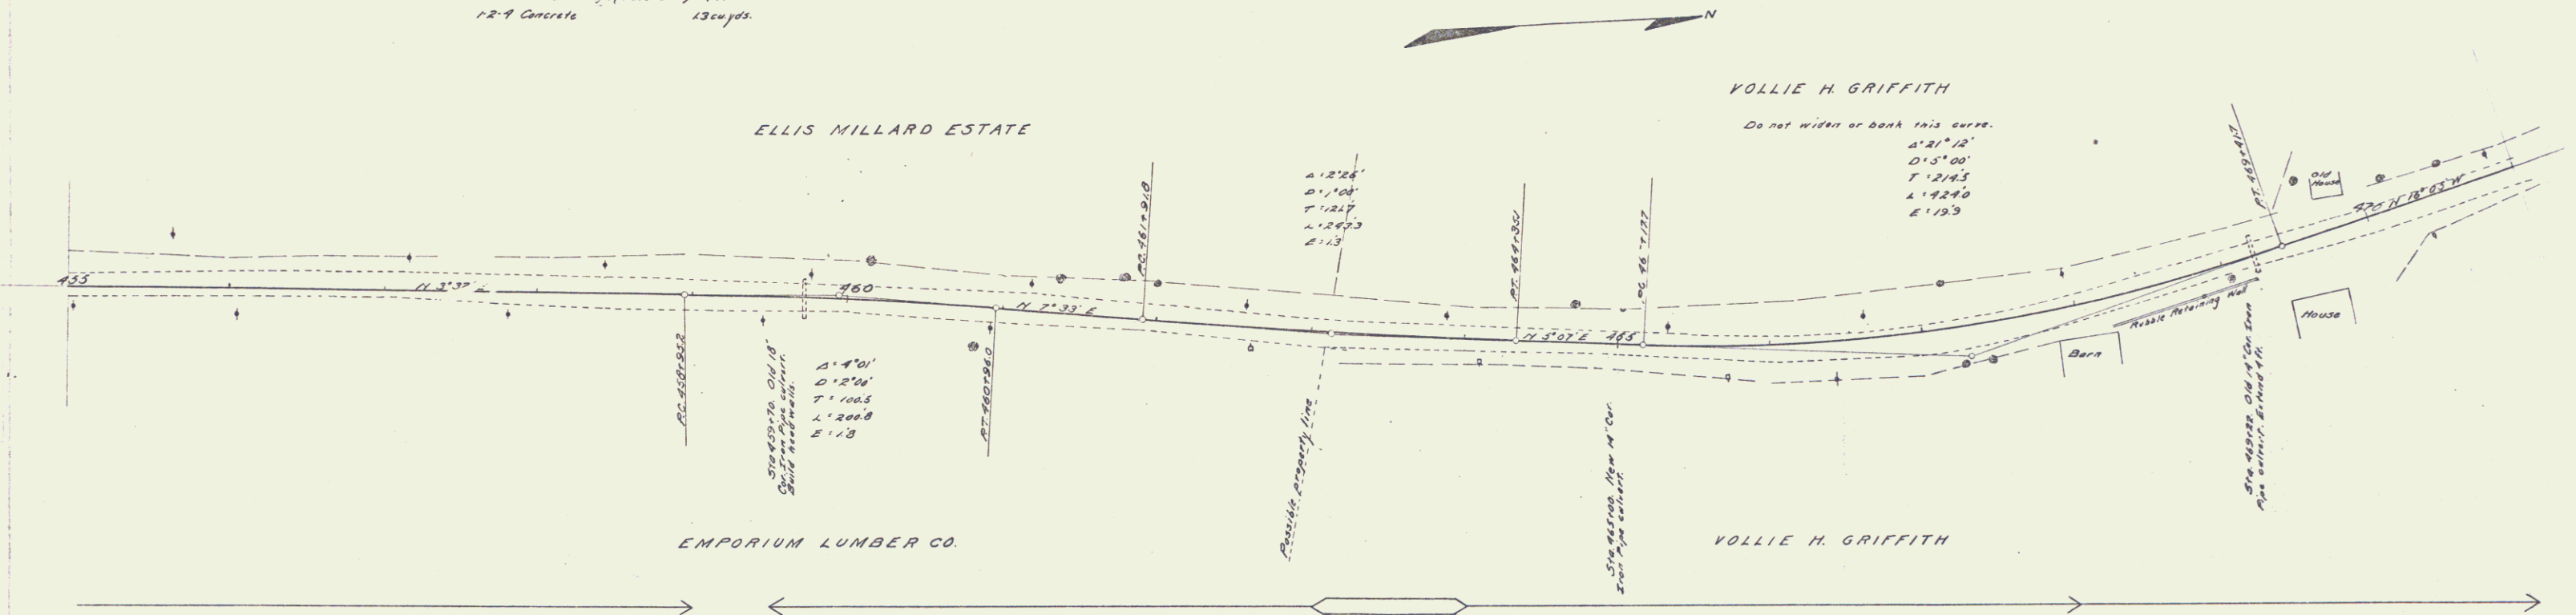

Drawn by J.L. Davis, 11/1918
 Sheet 32 of 133

GUARD RAIL REQUIRED

ON LEFT

Sta 472+00 to Sta 472+25 Length 16 ft	
" 473+63 " 473+73 " 24 "	
" 484+20 " 484+44 " 24 "	
" 484+32 " 484+76 " 24 "	
" 486+36 " 487+00 " 4 "	

ON RIGHT

" 471+61 to Sta 472+25 " 64 "	
" 473+69 " 473+73 " 16 "	
" 484+72 " 487+00 " 228 "	



TOTAL THIS SHEET 552 ft

* Longer Posts required.

CULVERT REPAIRS REQUIRED

Sta 472+13 14" Dia Iron Pipe (Extension) 8 ft	
12" Concrete Headwalls 12 cu yds.	
Sta 473+81 14" Dia Iron Pipe (Extension) 6 ft	
12" Concrete Headwalls 15 cu yds.	

FED. ROAD DIST. NO.	STATE	FED. AID PROJ. NO.	FISCAL YEAR	SHEET NO.	TOTAL SHEETS
3	VT	1/2	1964-65	34	133

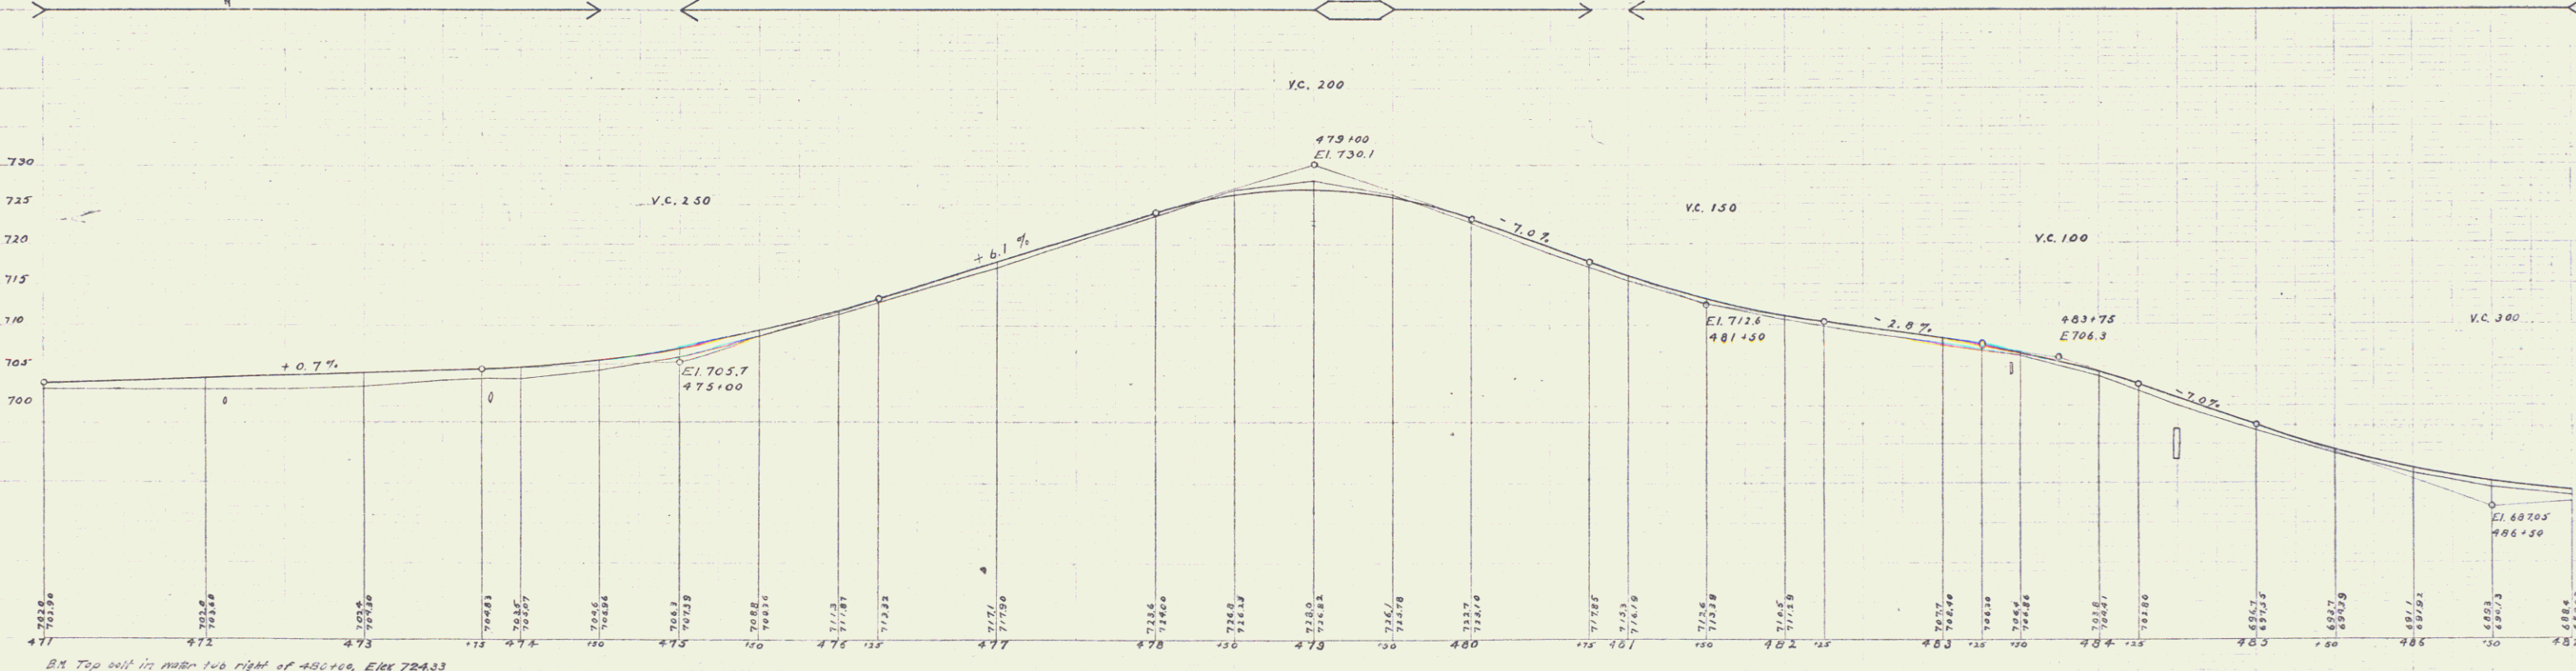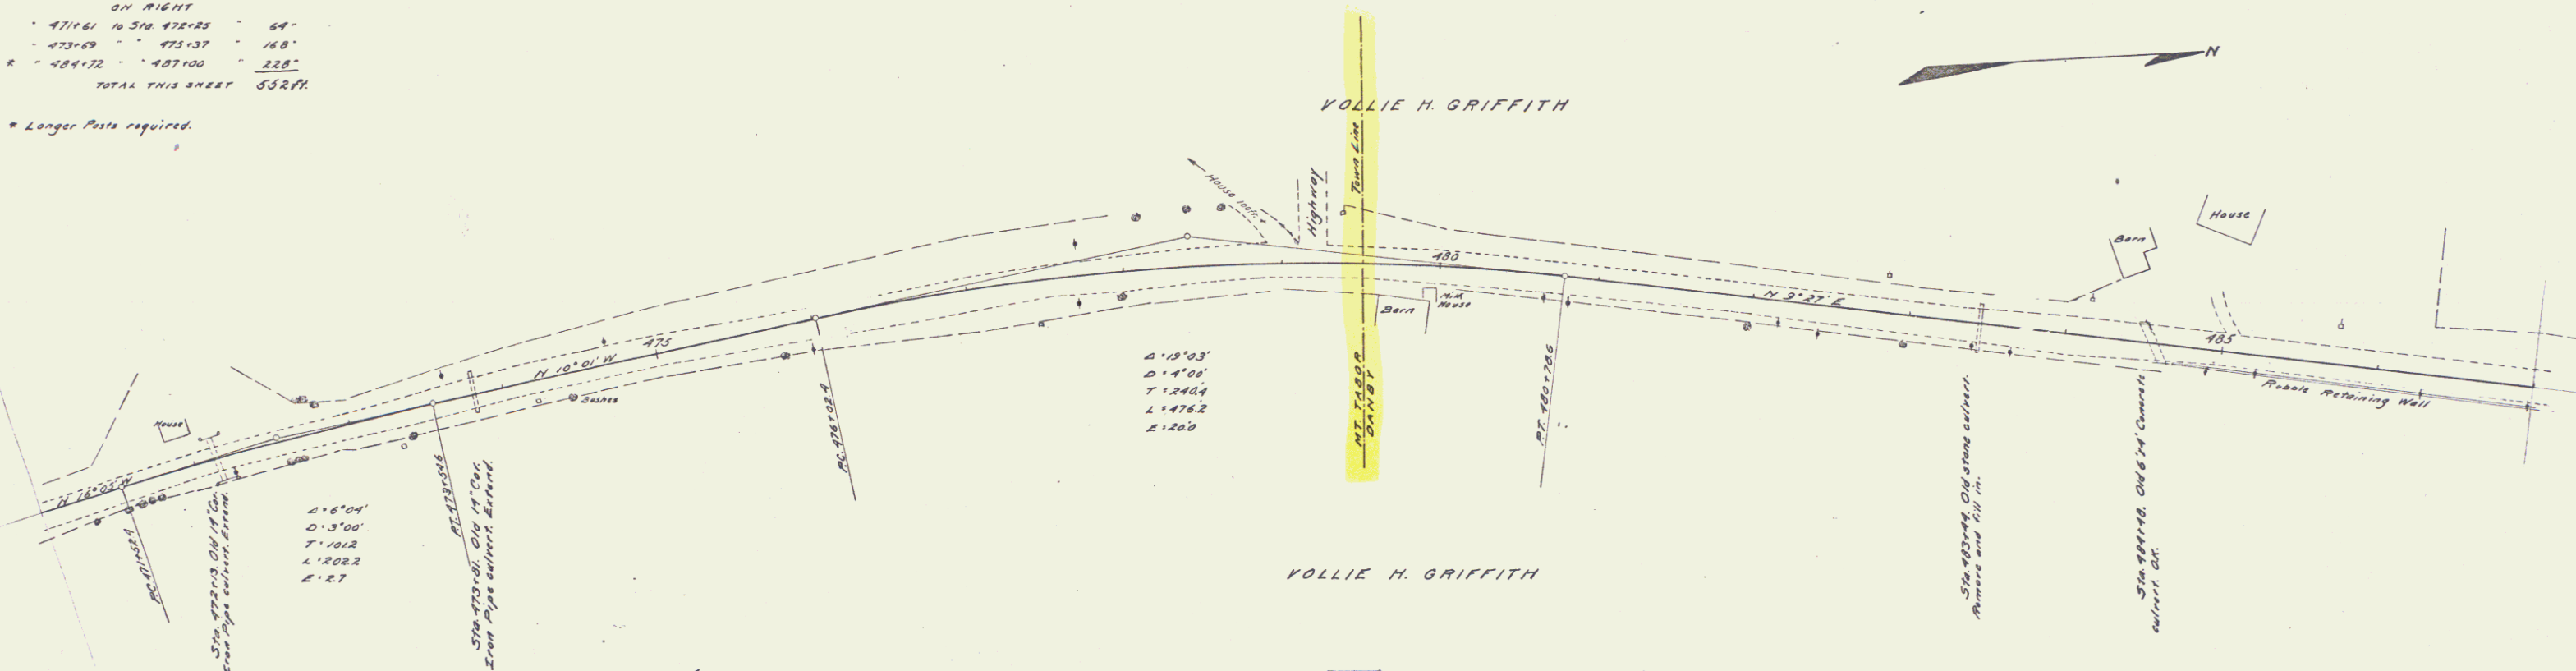

Series C, 1964, 1/2, 34, 133

GUARD RAIL REQUIRED
ON LEFT

Sta 487+00 to Sta 487+20	Length 20 ft	
487+20	487+32	24'
490+37	490+81	24'
494+88	496+72	184'
500+37	501+61	24'

ON RIGHT

487+00 to Sta 488+00	100'	
490+56	496+72	616'
500+37	500+61	24'

TOTAL THIS SHEET 1016 ft

CULVERT REPAIRS REQUIRED



Sta 490+69	12" 4 Concrete	34 cu yds.
1-3-6		72 "
Sta 495+20	12" 4 Concrete	5.8 cu yds.
1-3-6		76 "
Sta 500+49	18" Cur Iron Pipe	32 ft
1-2-4 Concrete Headwalls		1.5 cu yds.

* Longer Posts required.

FED. ROAD DIST. NO.	STATE	FED. AID PROJ. NO.	FISCAL YEAR	SHEET NO.	TOTAL SHEETS
8	VT	12	1918-20	35	133

J.L. Davis
S.L.D. and C. Day
1918

J.L. Davis
S.L.D. and C. Day
1918

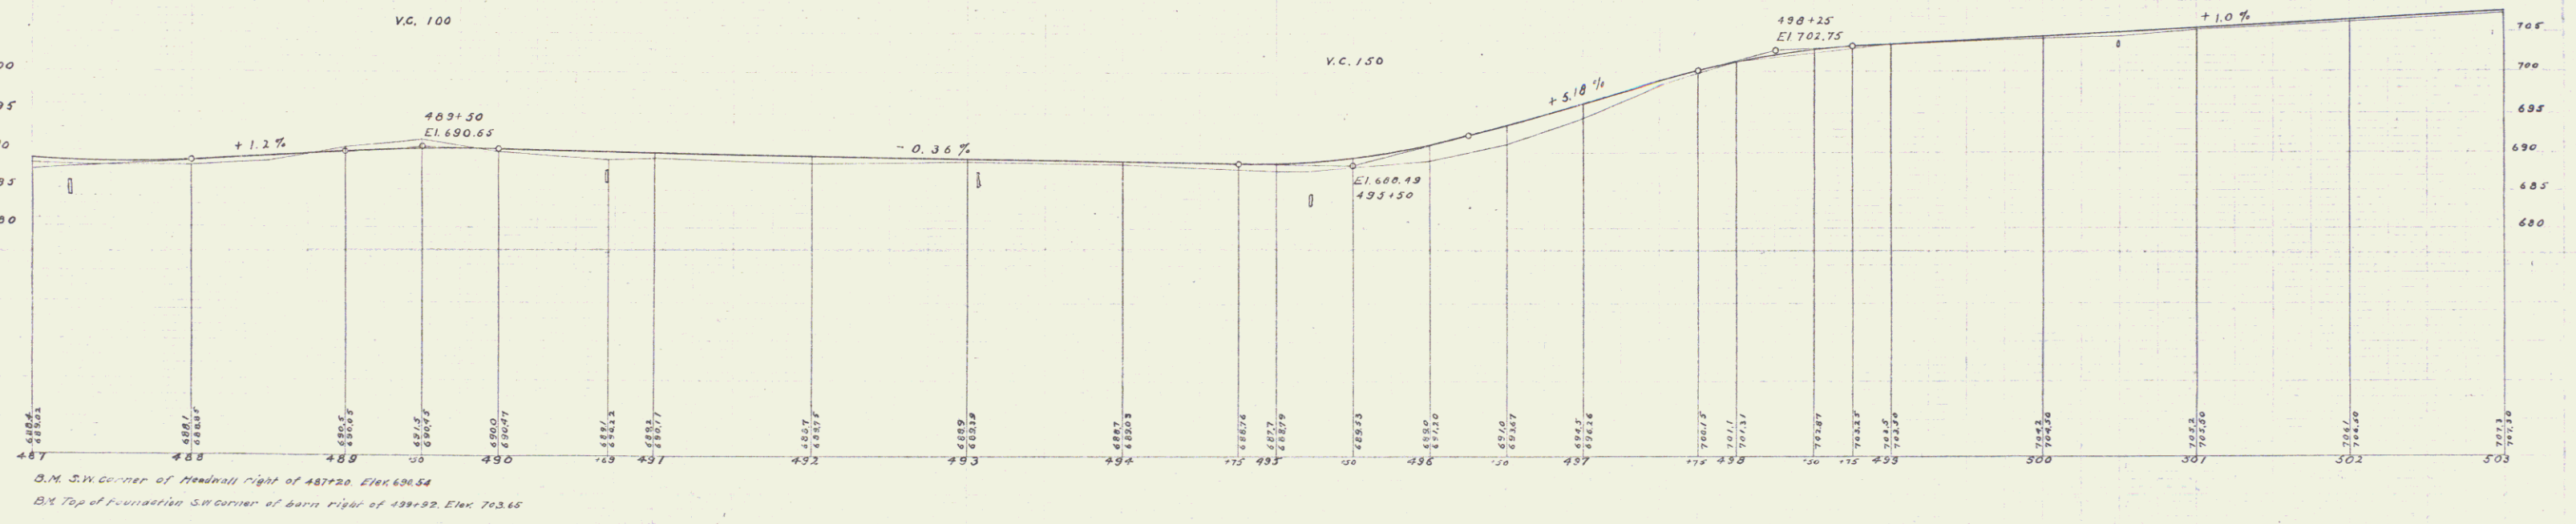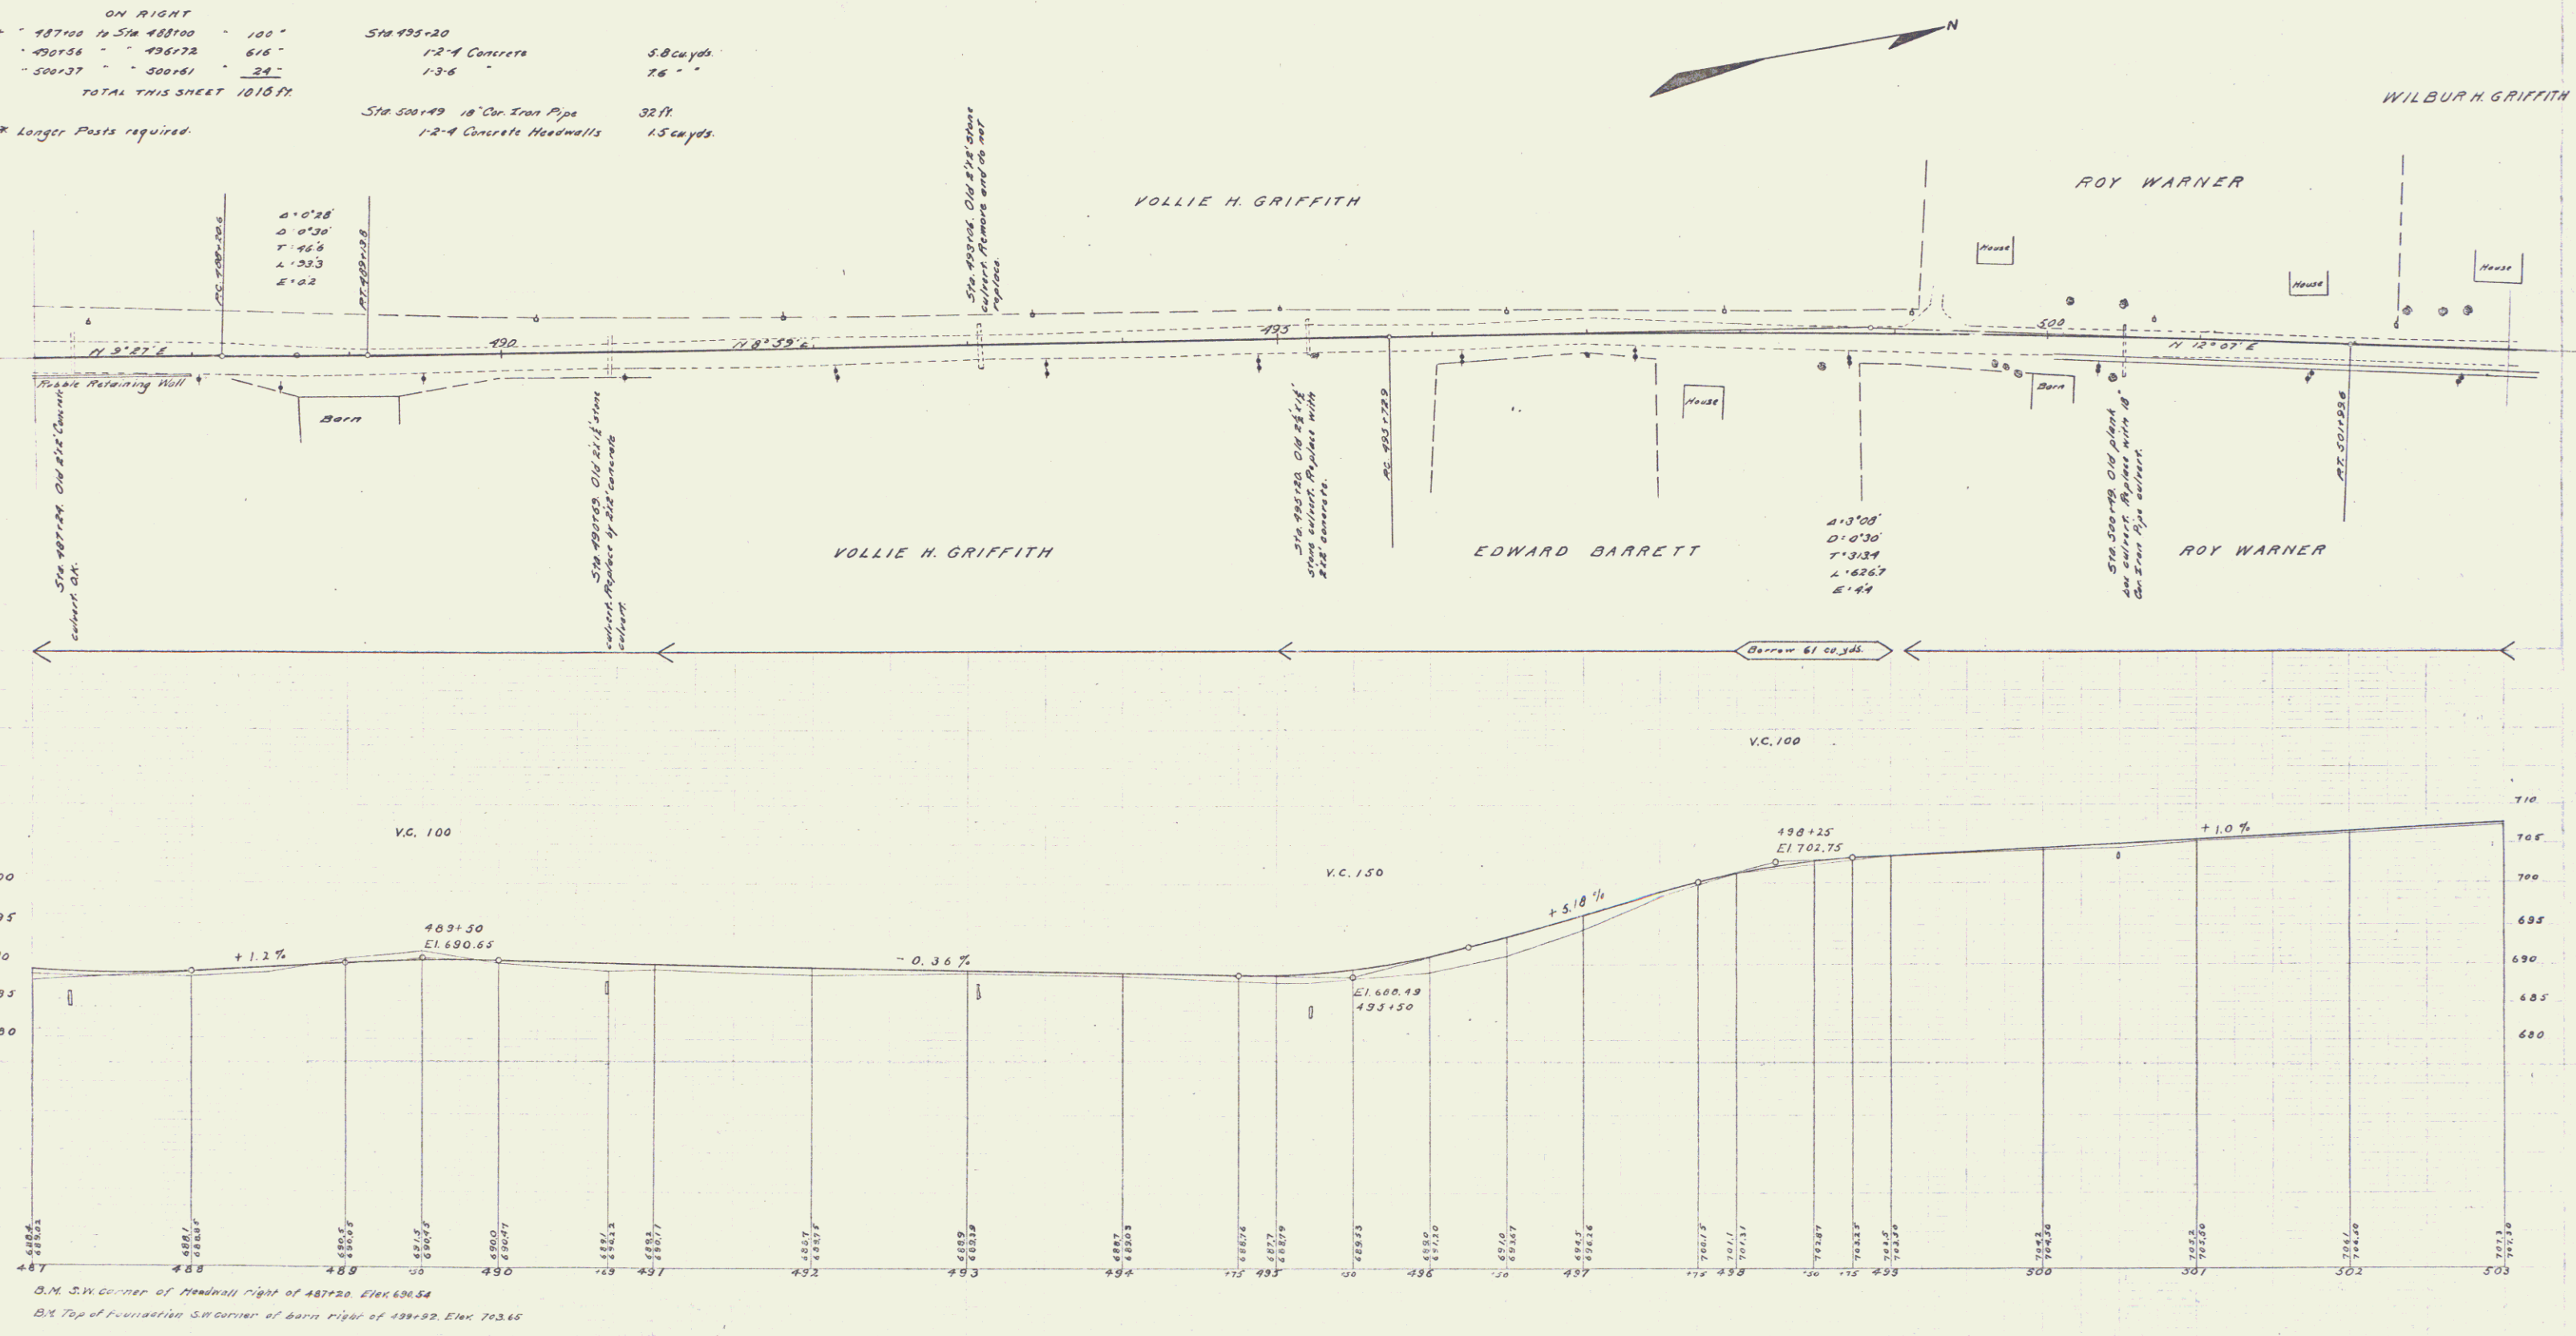

Drawn by J.L. Davis
Checked by S.L.D. and C. Day
1918


GUARD RAIL REQUIRED
ON LEFT
Sta 506+51 to 510+50 Lenth 39.9'

CULVERT REPAIRS REQUIRED
Sta 507+00
12-4 Concrete
13-6 Steel
08 cu yds.
25
11123


CONCRETE RETAINING WALL REQUIRED
Sta 507+10 to Sta 507+70
13-6 Concrete
(Alternative design with bank cutting)
381 cu yds.

FEEDBACK	STATE	FEEDBACK	FISCAL SHEET	TOTAL
DATE	NO.	DATE	NO.	SHEETS
8	VT	12	12	133

J.L. Davis and Co. Inc.
1150
1150
1150

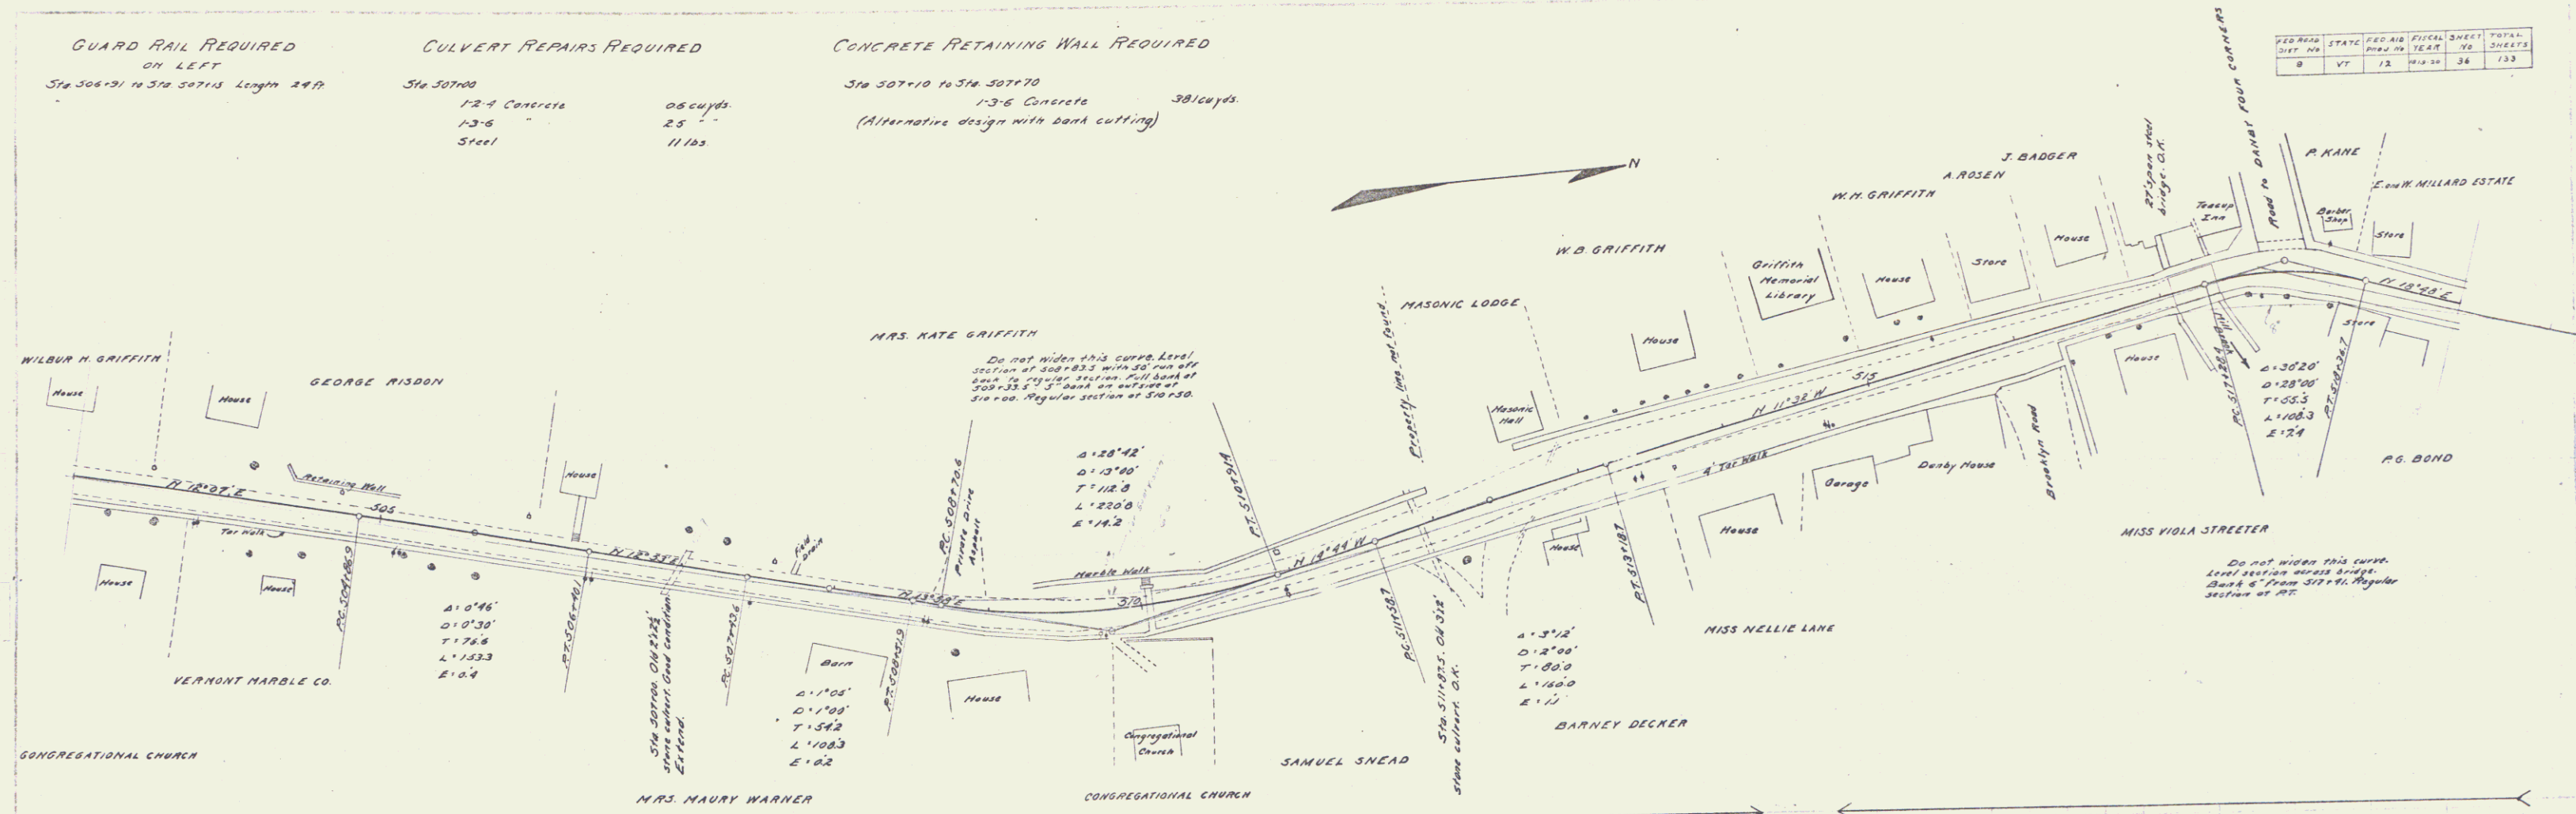

J.L. Davis and Co. Inc.
1150
1150
1150

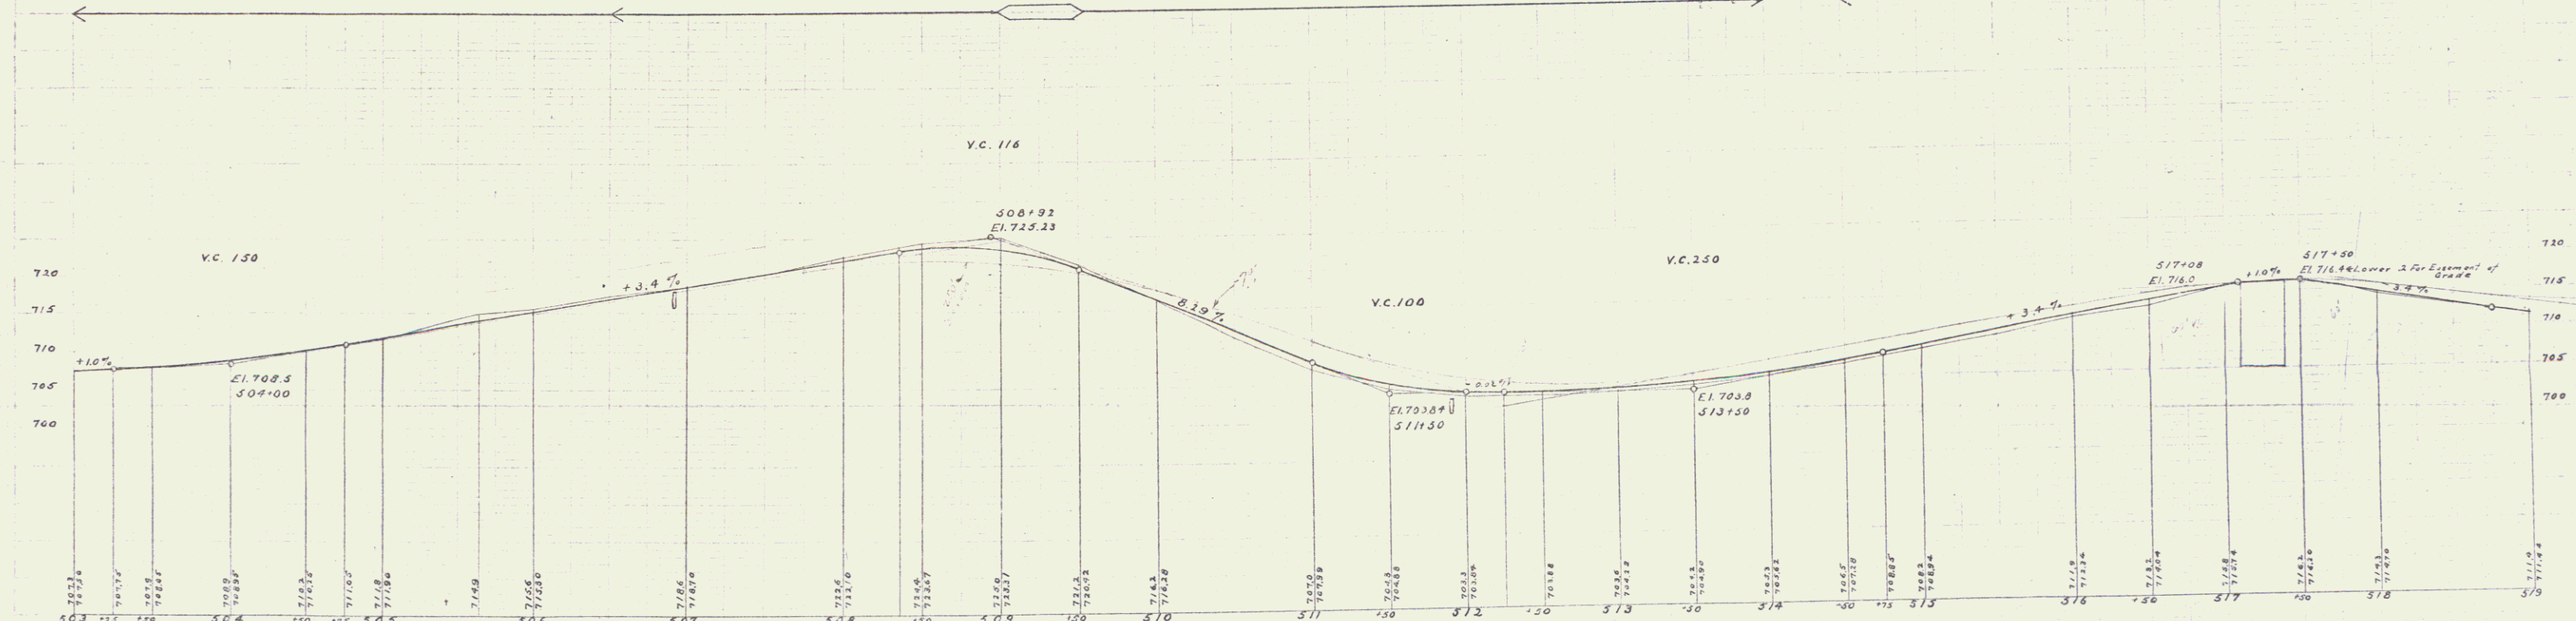

B.M. Stone at iron post left of 509+30, Elev. 724.31
B.M. Top of Stone at corner of triangular wall right of 511+38, Elev. 722.34
B.M. S.E. corner of stone under railing left of 517+67, Elev. 715.38


CHAS. E. BROWN, Filed
May 18, 1938

GUARD RAIL REQUIRED
ON LEFT
Sta 530+82 to Sta 532+34 Length 152 ft.
" 332+48 " 334+00 " 152 "
ON RIGHT
" 330+79 to Sta 532+34 " 155 "
" 332+53 " 334+00 " 147 "
ON LEFT
" 521+03 to Sta 521+27 " 24 "
TOTAL THIS SHEET 633 ft.


CULVERT REPAIRS REQUIRED
Sta 533+87
12" Concrete
13 cu yds.
1-3-6
Sta 521+15 18" Con. Iron Pipe
38 ft.
12" Concrete
10 cu yds.

FED. ROAD DIST. NO.	STATE	FED. AID PROJ. NO.	FISCAL YEAR	SHEET NO.	TOTAL SHEETS
8	VT.	1A	1934	27	135

J. L. Davis, Engineer
J. D. Ward, Chief Draftsman

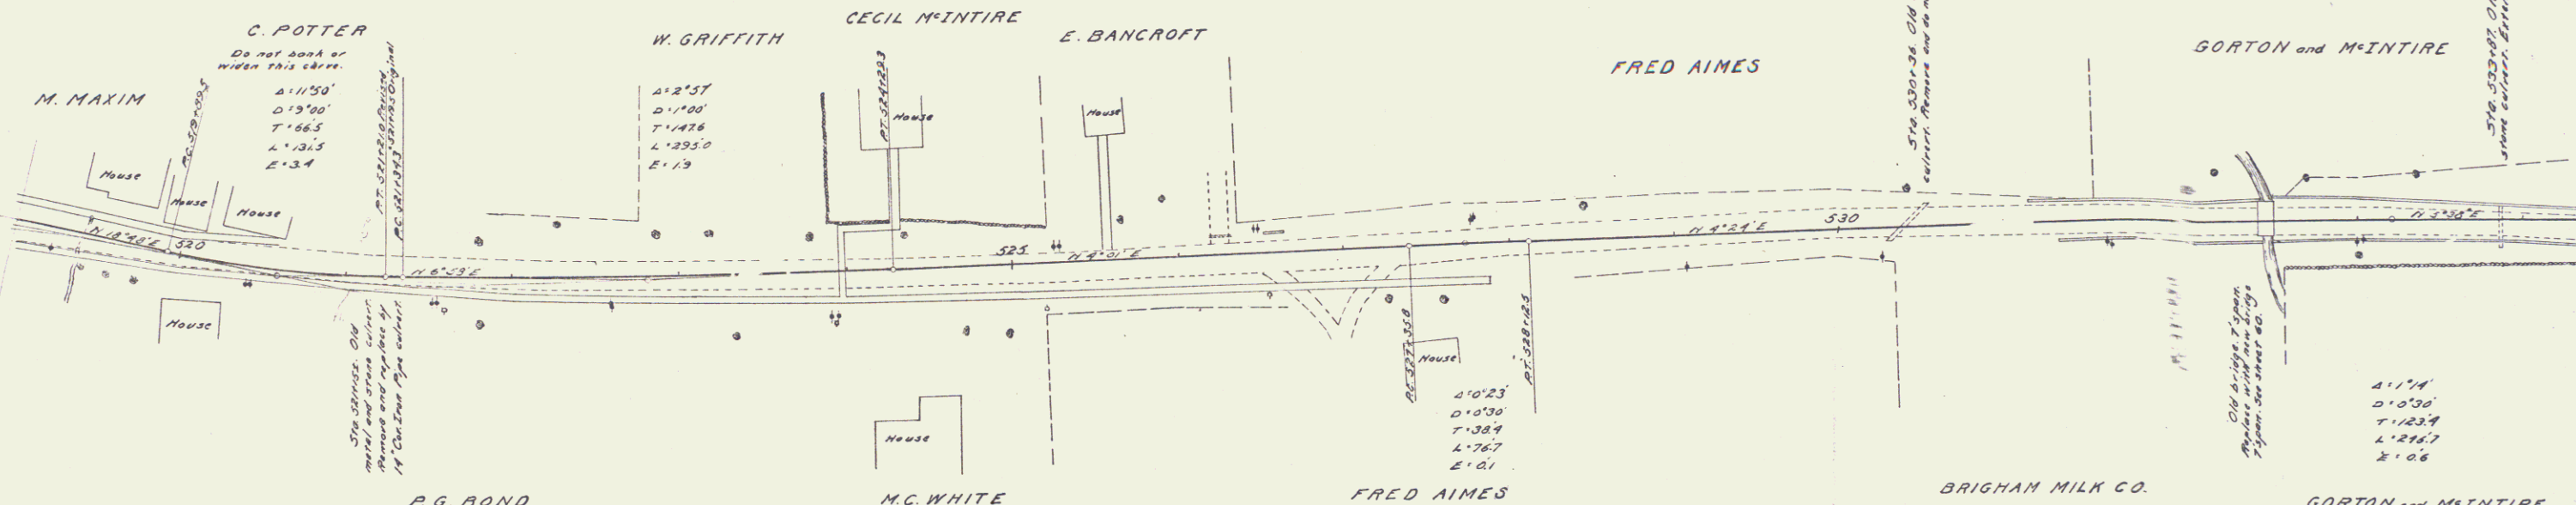

J. L. Davis, Engineer
J. D. Ward, Chief Draftsman

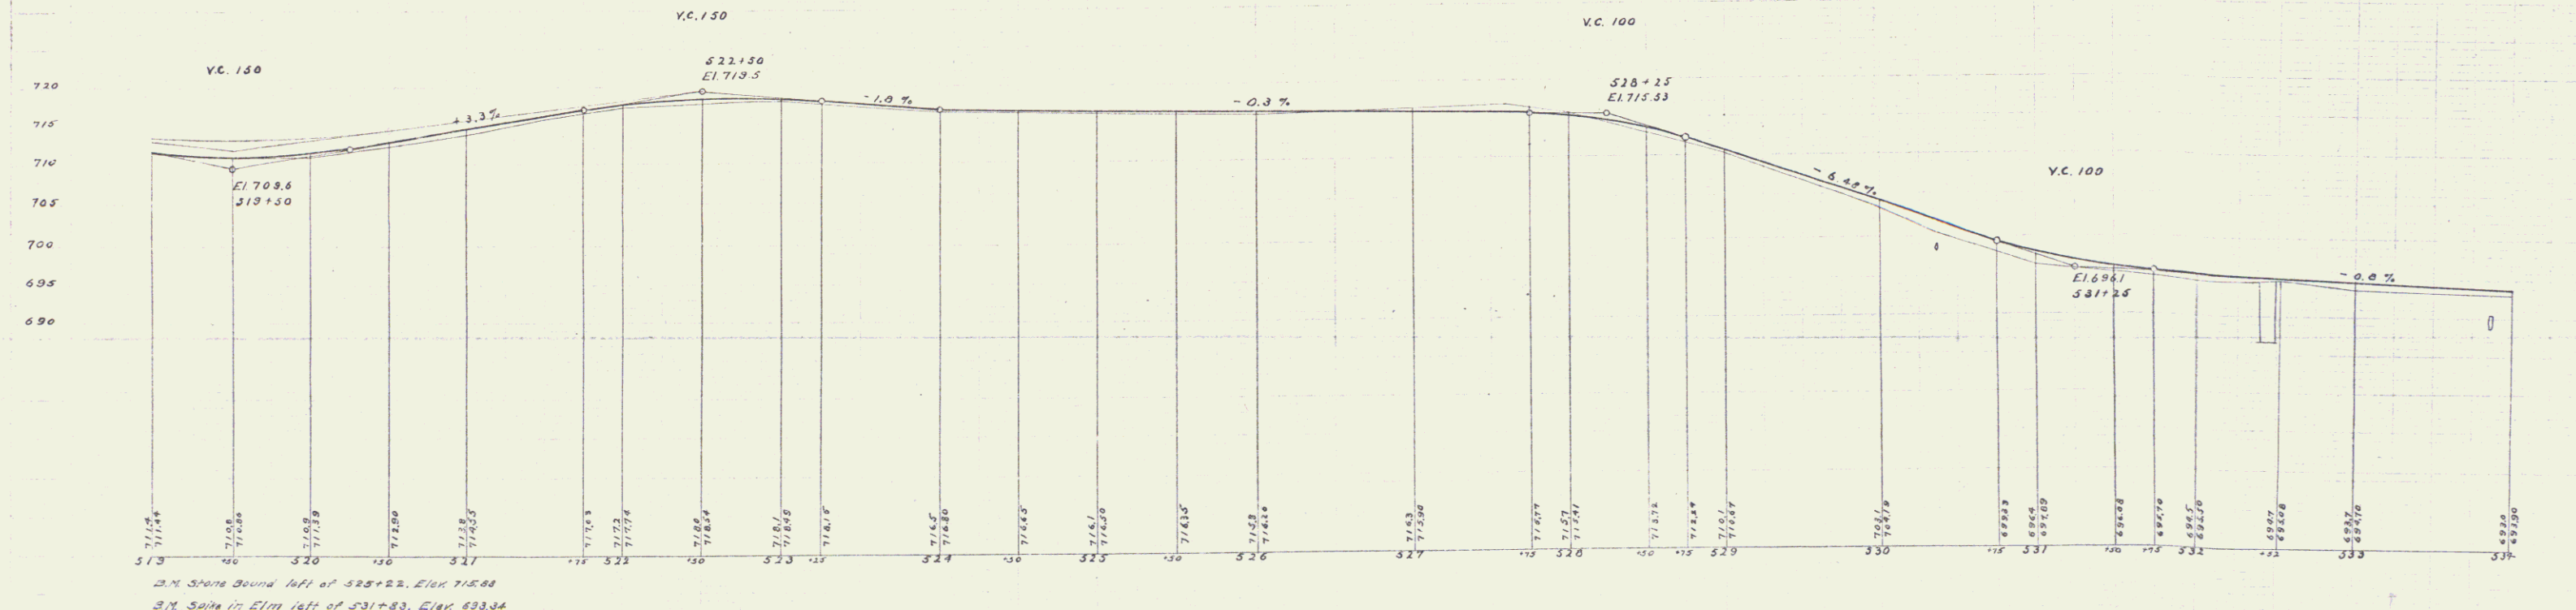

2.5 ft. Stone Bound left of 525+22, Elev 715.00
3 ft. Stone Bound left of 531+25, Elev 715.34

36

GUARD RAIL REQUIRED

ON LEFT

Sta. 534+00 to Sta. 534+80	Length 80 ft.	
534+00	534+80	24'
542+34	543+18	24'
545+81	546+05	24'

ON RIGHT



534+00 to Sta. 534+77	77'	
534+00	534+84	24'
542+34	543+18	24'
545+81	546+05	24'

TOTAL THIS SHEET 301 ft.

CONCRETE REPAIRS REQUIRED

Sta. 533+72	14" Co. Iron Pipe	28 ft.
	12" Concrete Headwalls	10 cu. yds.
Sta. 543+06	12" Concrete	3.5 cu. yds.
	12" Concrete	7.3 "
Sta. 545+22.5	12" Concrete	3.4 cu. yds.
	12" Concrete	7.2 "

FED. ROAD DIST. NO.	STATE	FED. AID PROJ. NO.	FISCAL YEAR	SHEET NO.	TOTAL SHEETS
0	VT.	12	1933	38	133

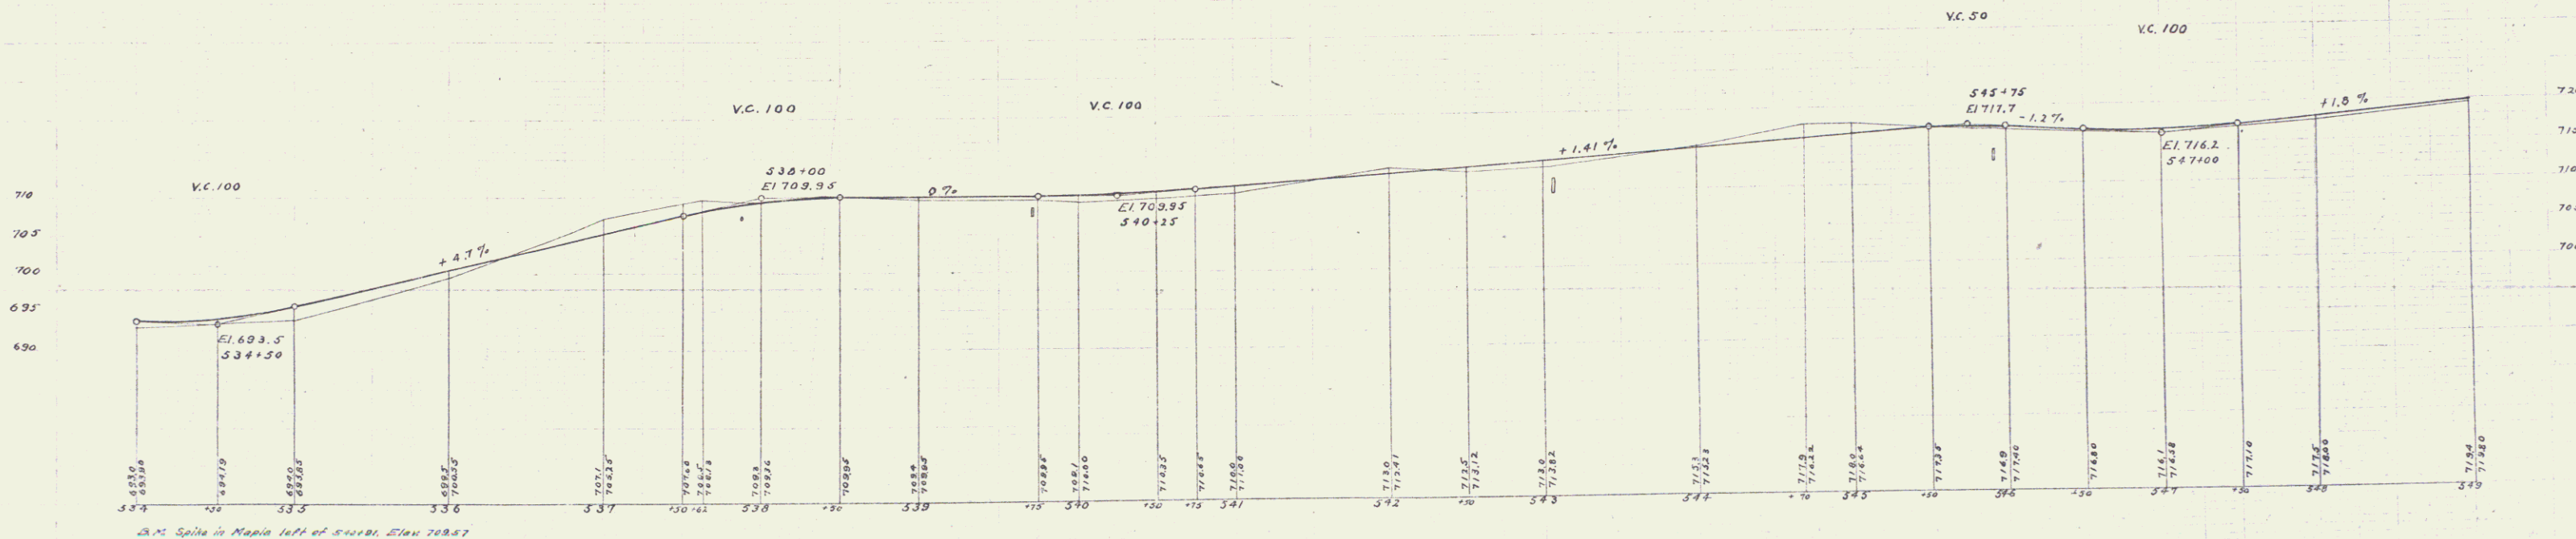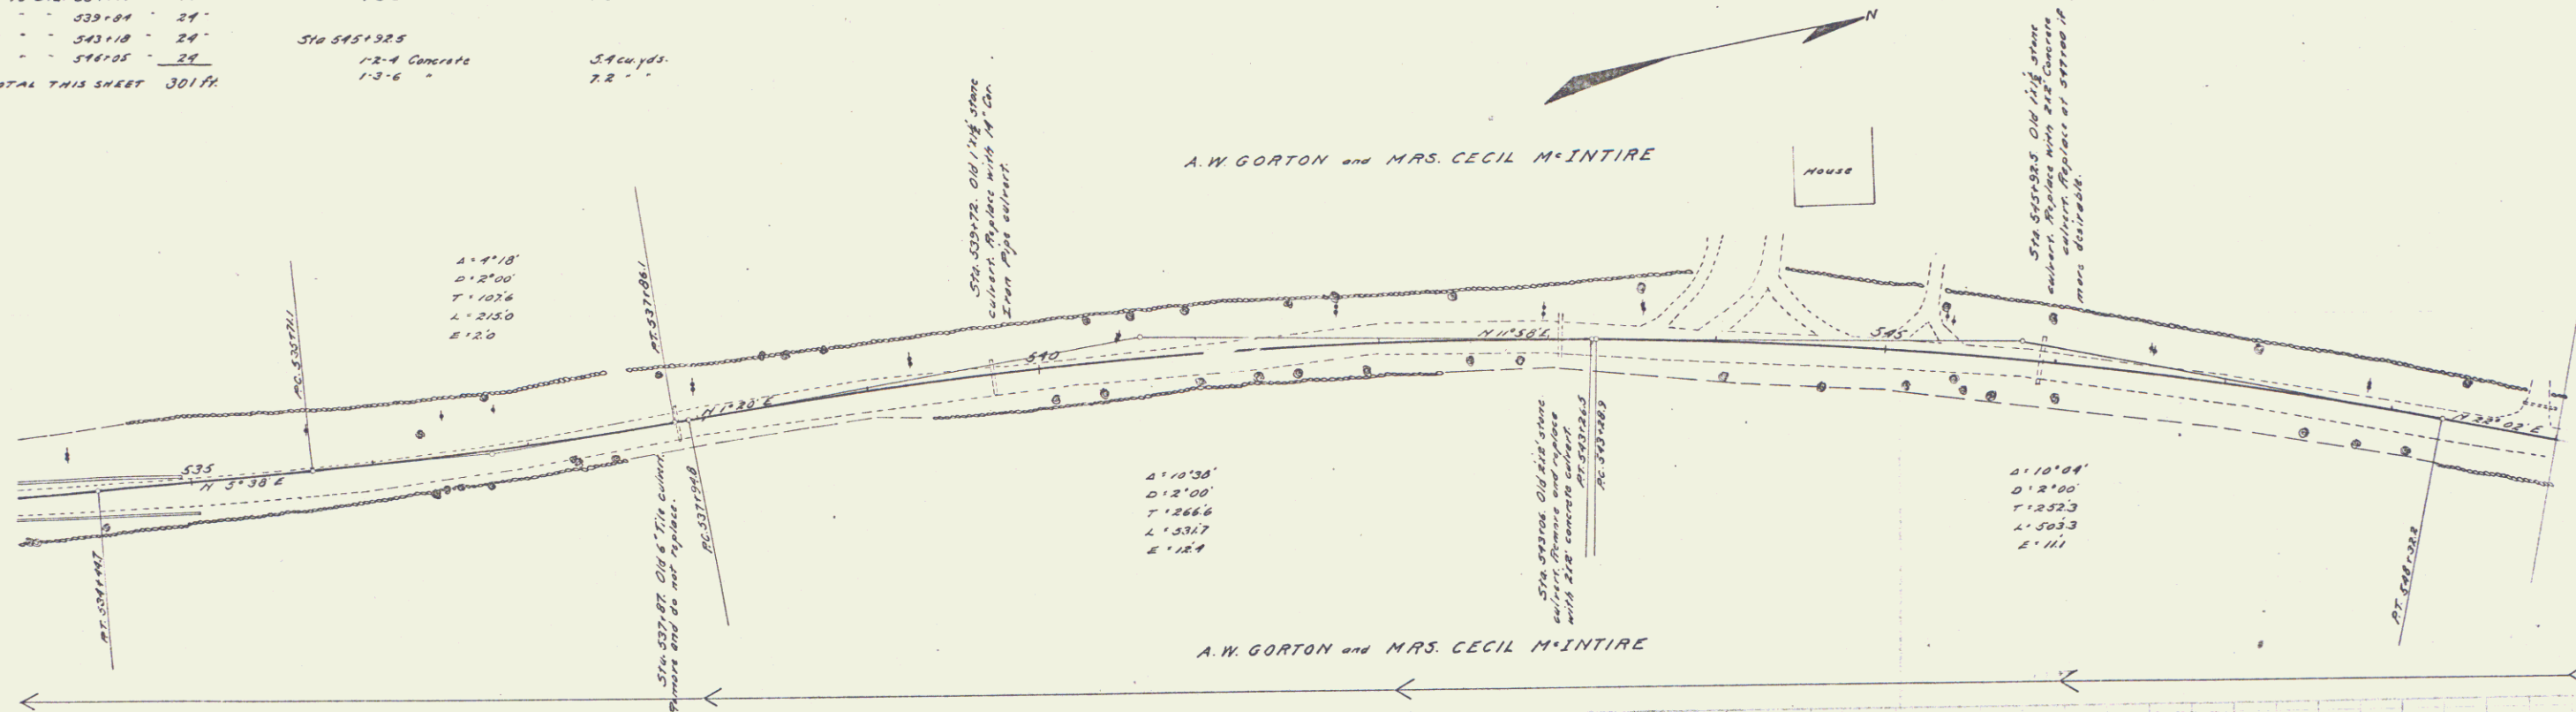

Surveyed by J. Davis, 1933

GUARD RAIL REQUIRED ON LEFT

Sta 551+90 to Sta 551+98	Length	8 ft
" 552+10 "	"	0 "
" 556+34 "	"	24 "
" 560+16 "	"	24 "
ON RIGHT		
" 551+96 to Sta 551+94 "	"	40 "
" 552+06 "	"	0 "
" 556+34 "	"	24 "
" 558+00 "	"	136 "
" 559+38 "	"	108 "
TOTAL THIS SHEET 384 ft		



CULVERT REPAIRS REQUIRED

Sta 556+66	14" Cor. Iron Pipe	28 ft.
"	12" Concrete Headwalls	10 cu yds.
Sta 560+28	14" Cor. Iron Pipe	32 ft.
"	12" Concrete Headwalls	10 cu yds.

FED. ROAD DIST. NO.	STATE	FED. AID PROJ. NO.	FISCAL YEAR	SHEET NO.	TOTAL SHEETS
3	VT	12	1919-20	38	133

U. S. D. A. 1919
V. L. GORTON and MRS. CECIL M. INTIRE

U. S. D. A. 1919
V. L. GORTON and MRS. CECIL M. INTIRE

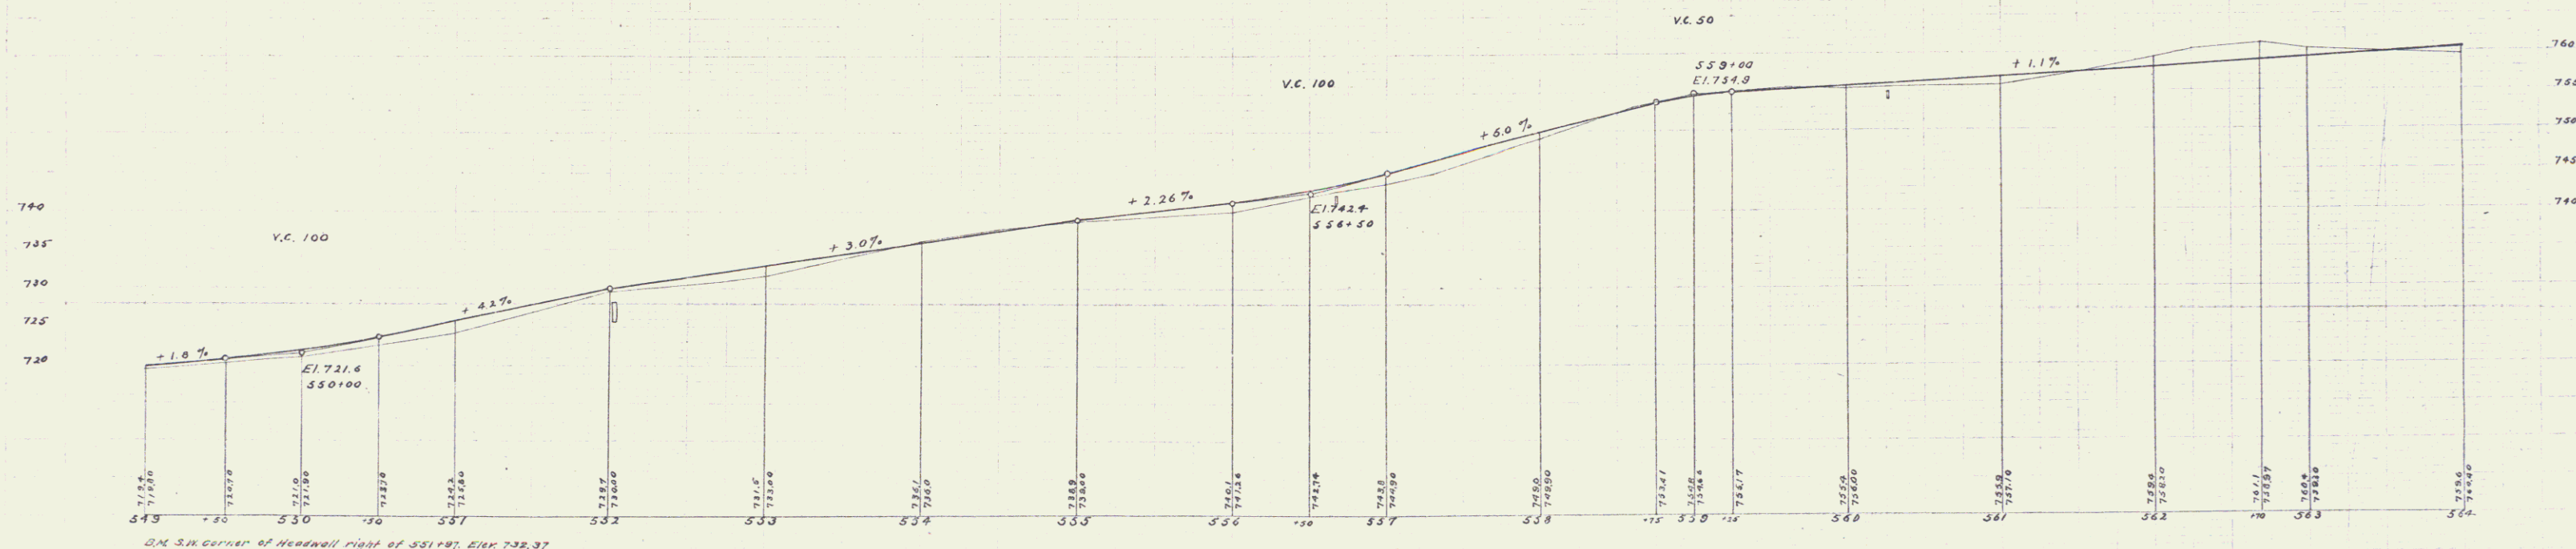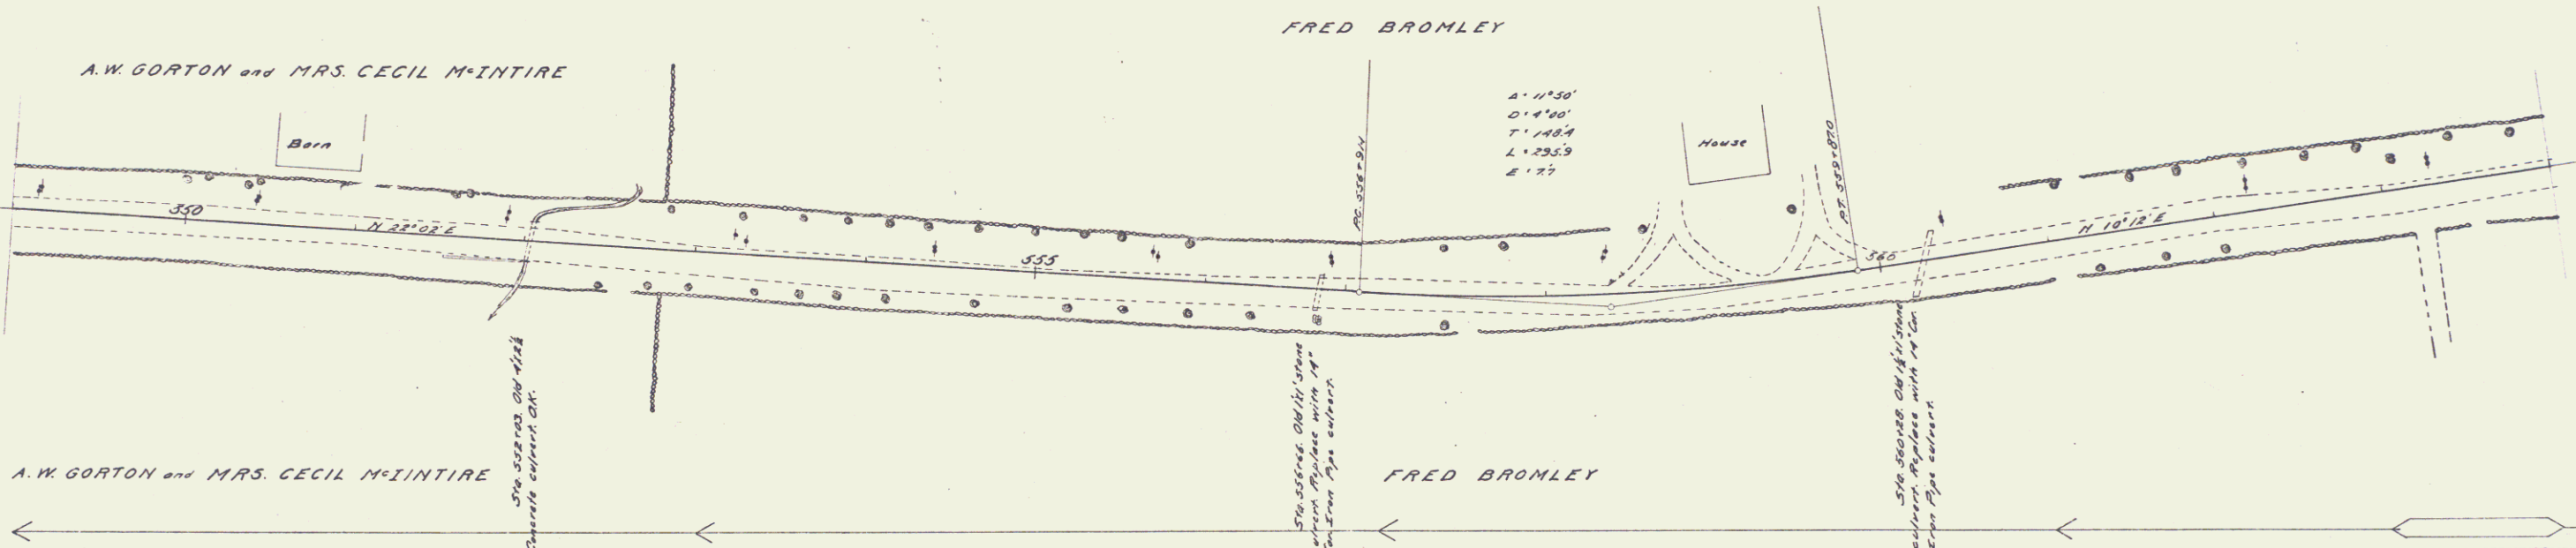

B.M. 314 corner of Headwall right of 551+98; Elev 732.37

Series C. Road, Road
Sheet 38 of 133

GUARD RAIL REQUIRED ON LEFT


Sta 364+16 to Sta 364+40 Length 24 ft.
 - 373+02 - 373+26 - 24' -
 - 377+11 - 377+35 - 24' -
ON RIGHT
 - 364+16 to Sta 364+40 - 24' -
 - 373+02 - 373+26 - 24' -
 - 377+11 - 377+35 - 24' -
TOTAL THIS SHEET 194 ft.

CONCRETE REPAIRS REQUIRED


Sta 364+25 18" Cor Iron Pipe (Extension) 6 ft.
 1-2-4 Concrete Headwalls 08 cu yds.
 Sta 365+30 12" Cor Iron Pipe 24 ft.
 1-2-4 Concrete Headwalls 10 cu yds.
 Sta 373+14 18" Cor Iron Pipe 26 ft.
 1-2-4 Concrete 15 cu yds.
 Sta 375+30 14" Cor Iron Pipe 26 ft.
 1-2-4 Concrete 10 cu yds.
 Sta 377+23 1-2-4 Concrete 3.5 cu yds.
 1-3-6 43/65.

FED. ROAD DIST. NO.	STATE	FED. AID PROJ. NO.	FISCAL YEAR	SHEET NO.	TOTAL SHEETS
9	VT.	12	1942-43	40	133

J.L. Davis, Engineer
J.L. Davis and Chas. J. Davis

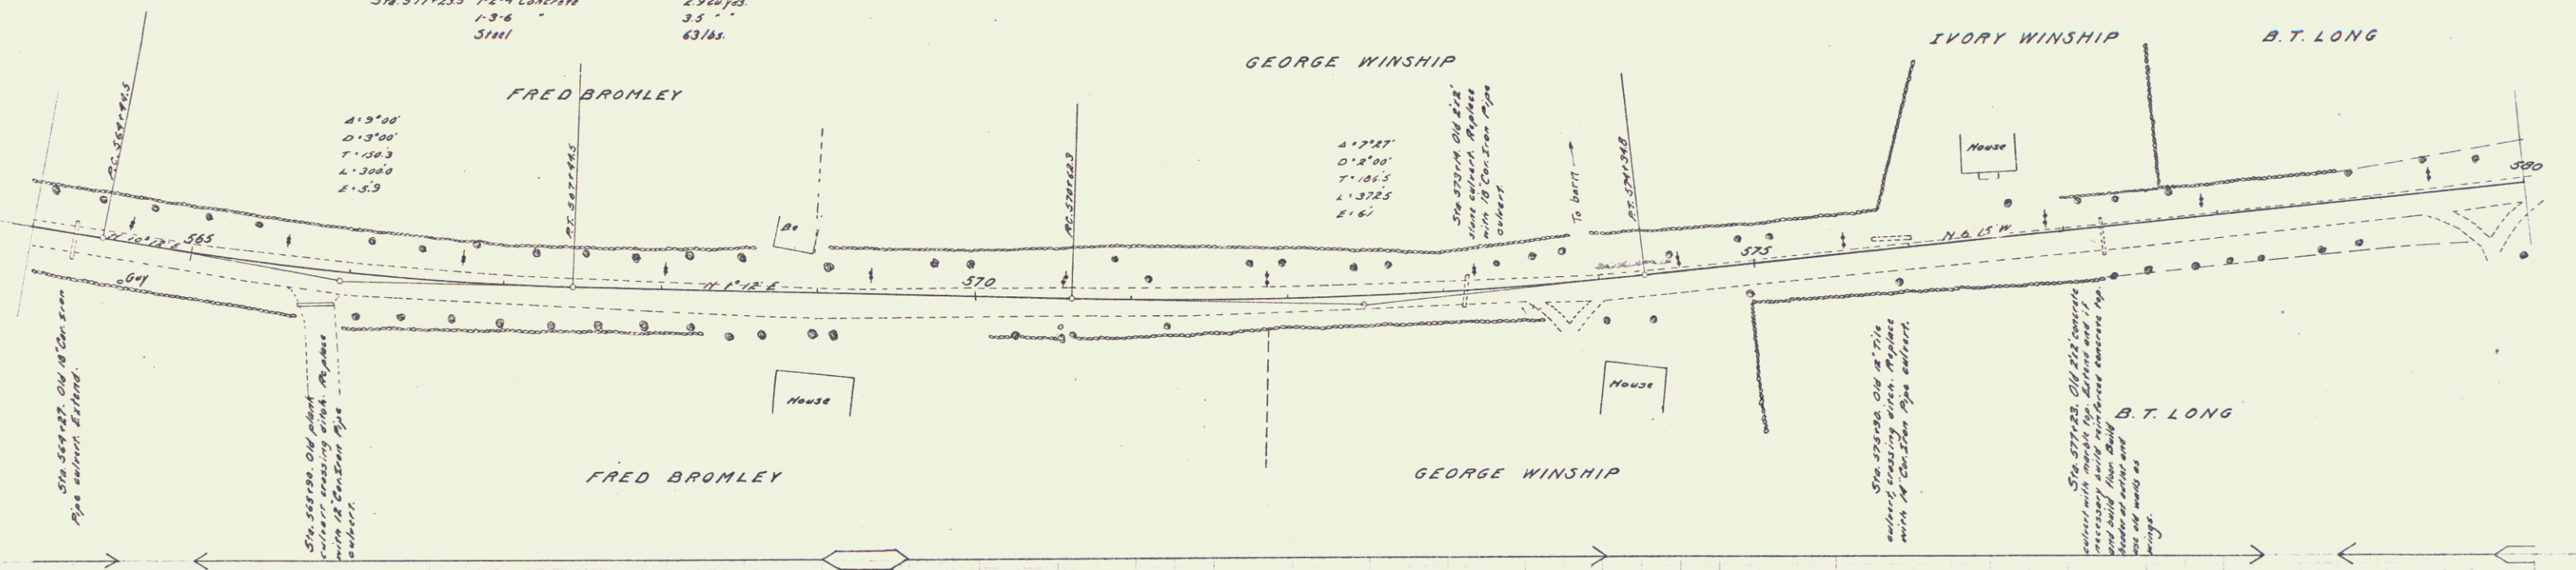

J.L. Davis, Engineer
J.L. Davis and Chas. J. Davis

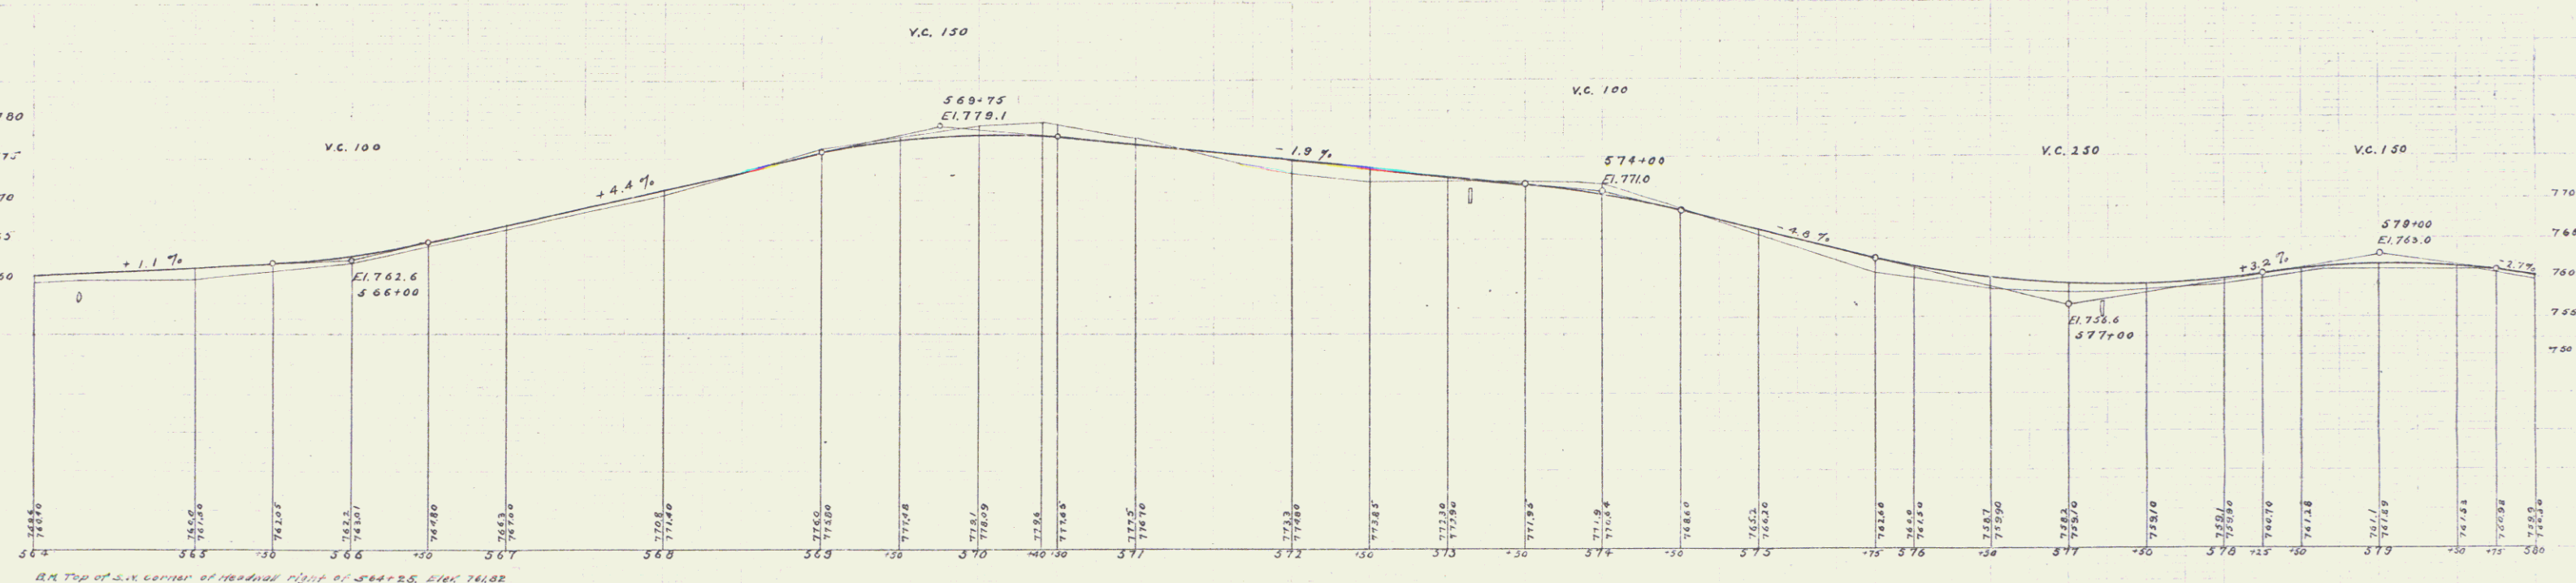



Series F, 1942-43

GUARD RAIL REQUIRED
ON LEFT
Sta 580+50 to Sta 580+82 Length 32 ft.
- 580+50 - 580+52 - 24'
- 580+52 - 580+54 - 24'
ON RIGHT
- 580+50 to Sta 580+82 - 24'
- 580+52 - 580+54 - 360
- 580+54 - 580+82 - 232'
TOTAL THIS SHEET 688 ft.

NEW CULVERTS REQUIRED
Sta 580+20 14" Cor. Iron Pipe 28 ft.
12" Concrete 17 cu yds.
CULVERT REPAIRS REQUIRED
Sta 580+70
12" Concrete 2.8 cu yds.
13" Steel 2.5' - 60 lbs.
Sta 585+73
12" Concrete 43 cu yds.
13" Steel 7.6' - 120 lbs.

FEED ROAD	STATE	FEED NO.	FEEDAL	SHEET	TOTAL
9	VT	12	100-20	41	133


J.L. Davis
J.C. Davis
J.B. Davis

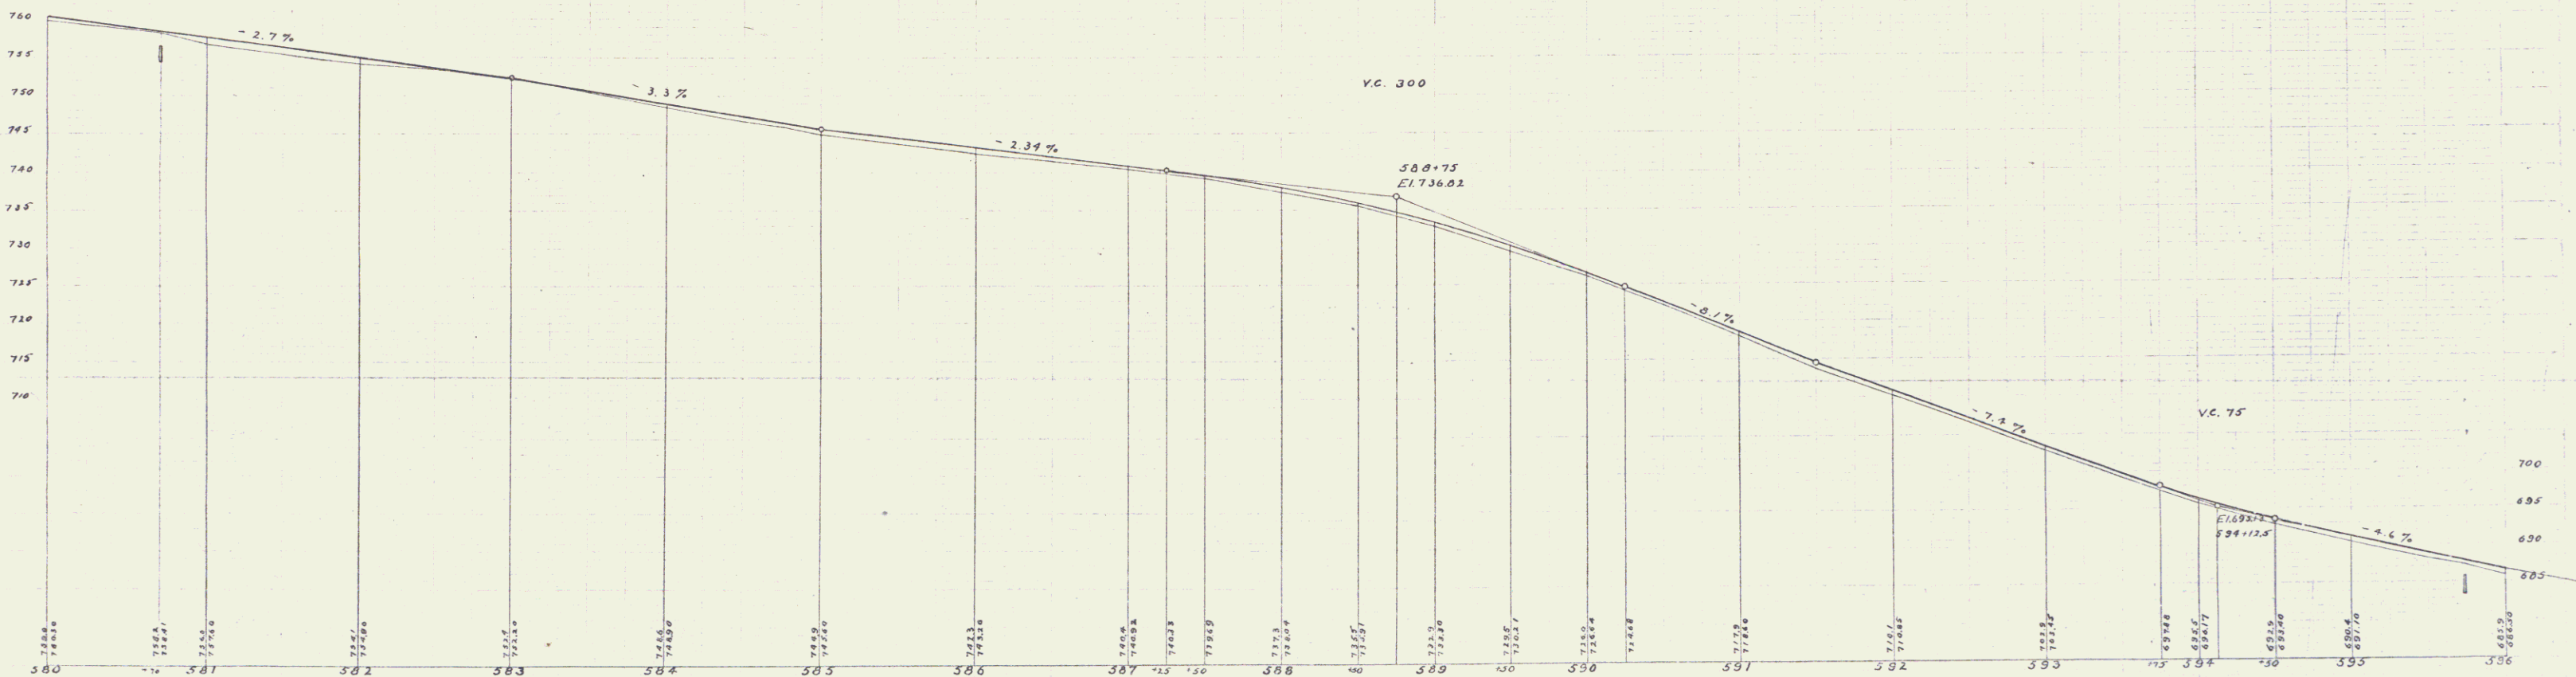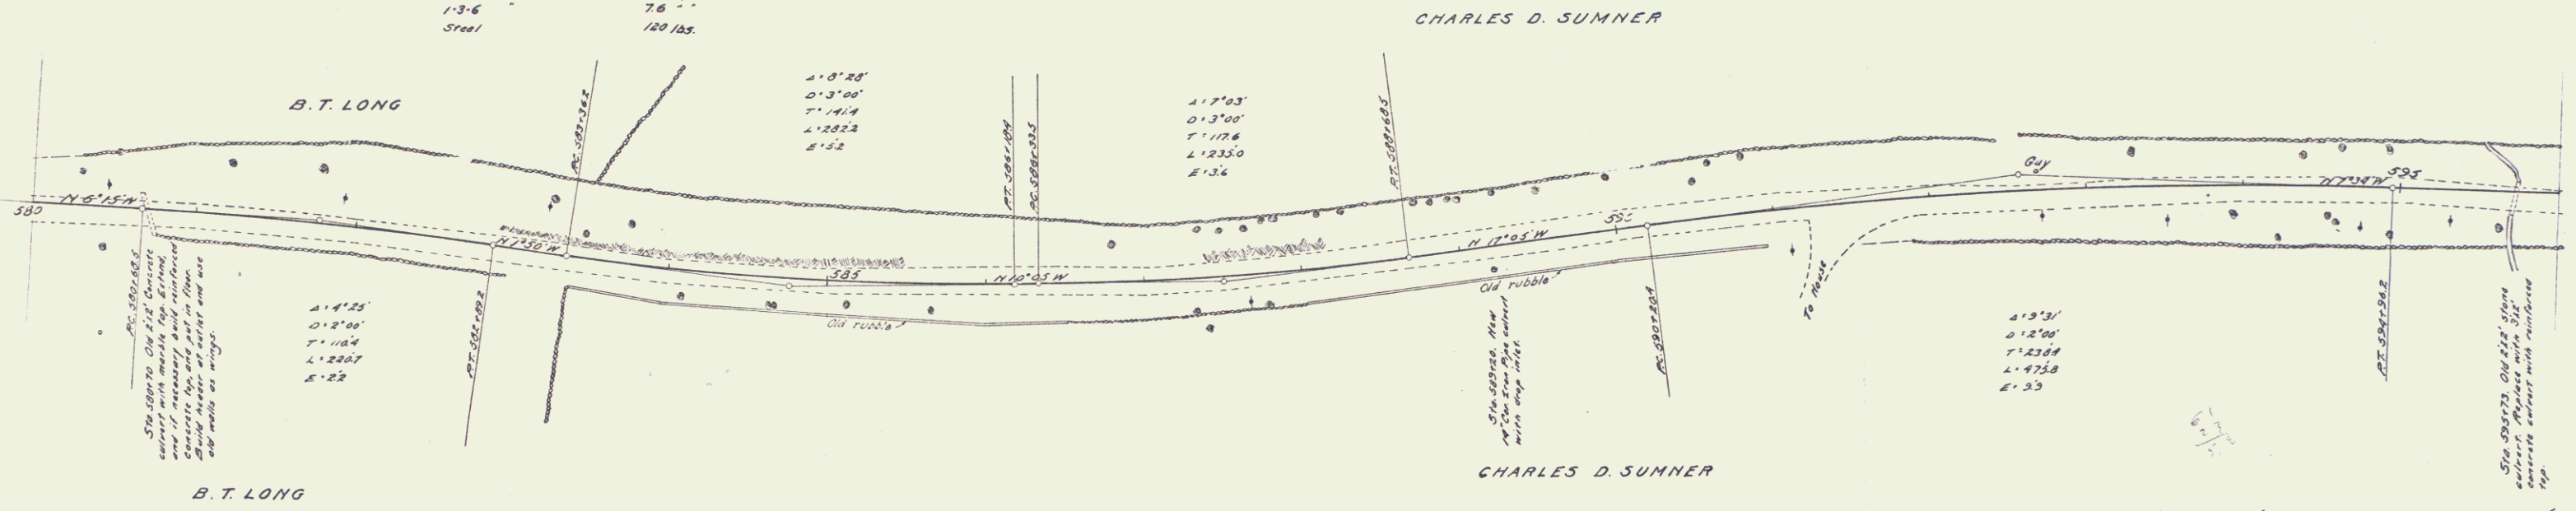

B.M. S.E. corner of Stone Gate Pond. Left of 580+20. Elev. 743.34.
B.M. spike in history right of 580+53. Elev. 718.15.

Series 1000 filed
1/1/12

GUARD RAIL REQUIRED	CULVERT REPAIRS REQUIRED
ON LEFT	
Sta 539+07 to Sta 539+31 Length 24 ft.	Sta 539+13
60S+66 " 60S+90 " 24'	1-2" Concrete 101 cu yds
ON RIGHT	1-3" 197 "
539+25 to Sta 539+31 " 56'	Steel 235 lbs.
60S+25 " 60S+28 " 200'	
60S+10 " 60S+42 " 273'	
60S+63 " 60S+87 " 24'	Sta 60S+78 18" Cor. Iron Pipe 34 ft.
ON LEFT	1-2" Concrete 15 cu yds.
60S+78 to Sta 60S+87 " 24'	
TOTAL THIS SHEET 584 ft	Sta 60S+75S 18" Cor. Iron Pipe 26 ft.
	1-2" Concrete 10 cu yds.

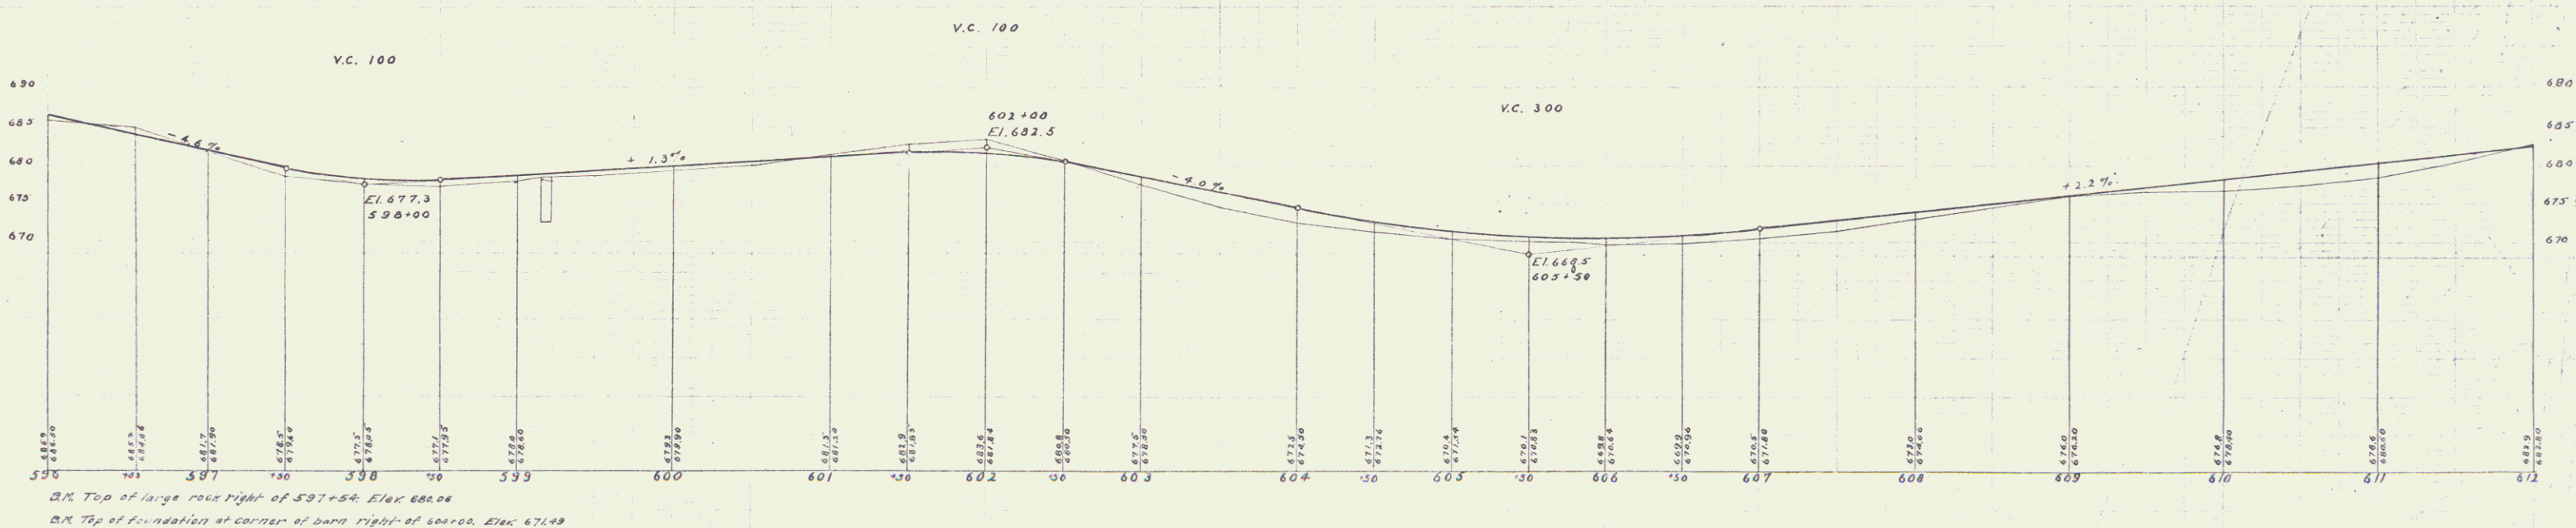



Series T, No. 12, File 43-4346-12

GUARD RAIL REQUIRED
ON LEFT
Sta. 614+14 to Sta. 614+38 length 24 ft.
- 621+19 - 621+43 - 24'
- 624+76 - 625+00 - 24'
ON RIGHT
- 613+50 to Sta. 615+02 - 152'
- 621+19 - 621+43 - 24'
- 624+76 - 625+00 - 24'
TOTAL THIS SHEET 272'

CULVERT REPAIR REQUIRED
Sta. 614+26 14" Dia. Iron Pipe 36 ft.
12-4 Concrete 10 cu yds.
Sta. 621+31 13-6 Concrete 4.5 cu yds.
Sta. 624+88 12" Dia. Iron Pipe (Extending 4 ft.)
12-4 Concrete 1.0 cu yds.

CONCRETE RETAINING WALL REQUIRED
Sta. 625+70 to Sta. 626+70
13-6 Concrete 472 cu yds.

FED. PROJ. NO.	STATE	FED. AID PROJ. NO.	FISCAL YEAR	SHEET NO.	TOTAL SHEETS
0	VT	12	1962-63	42	103

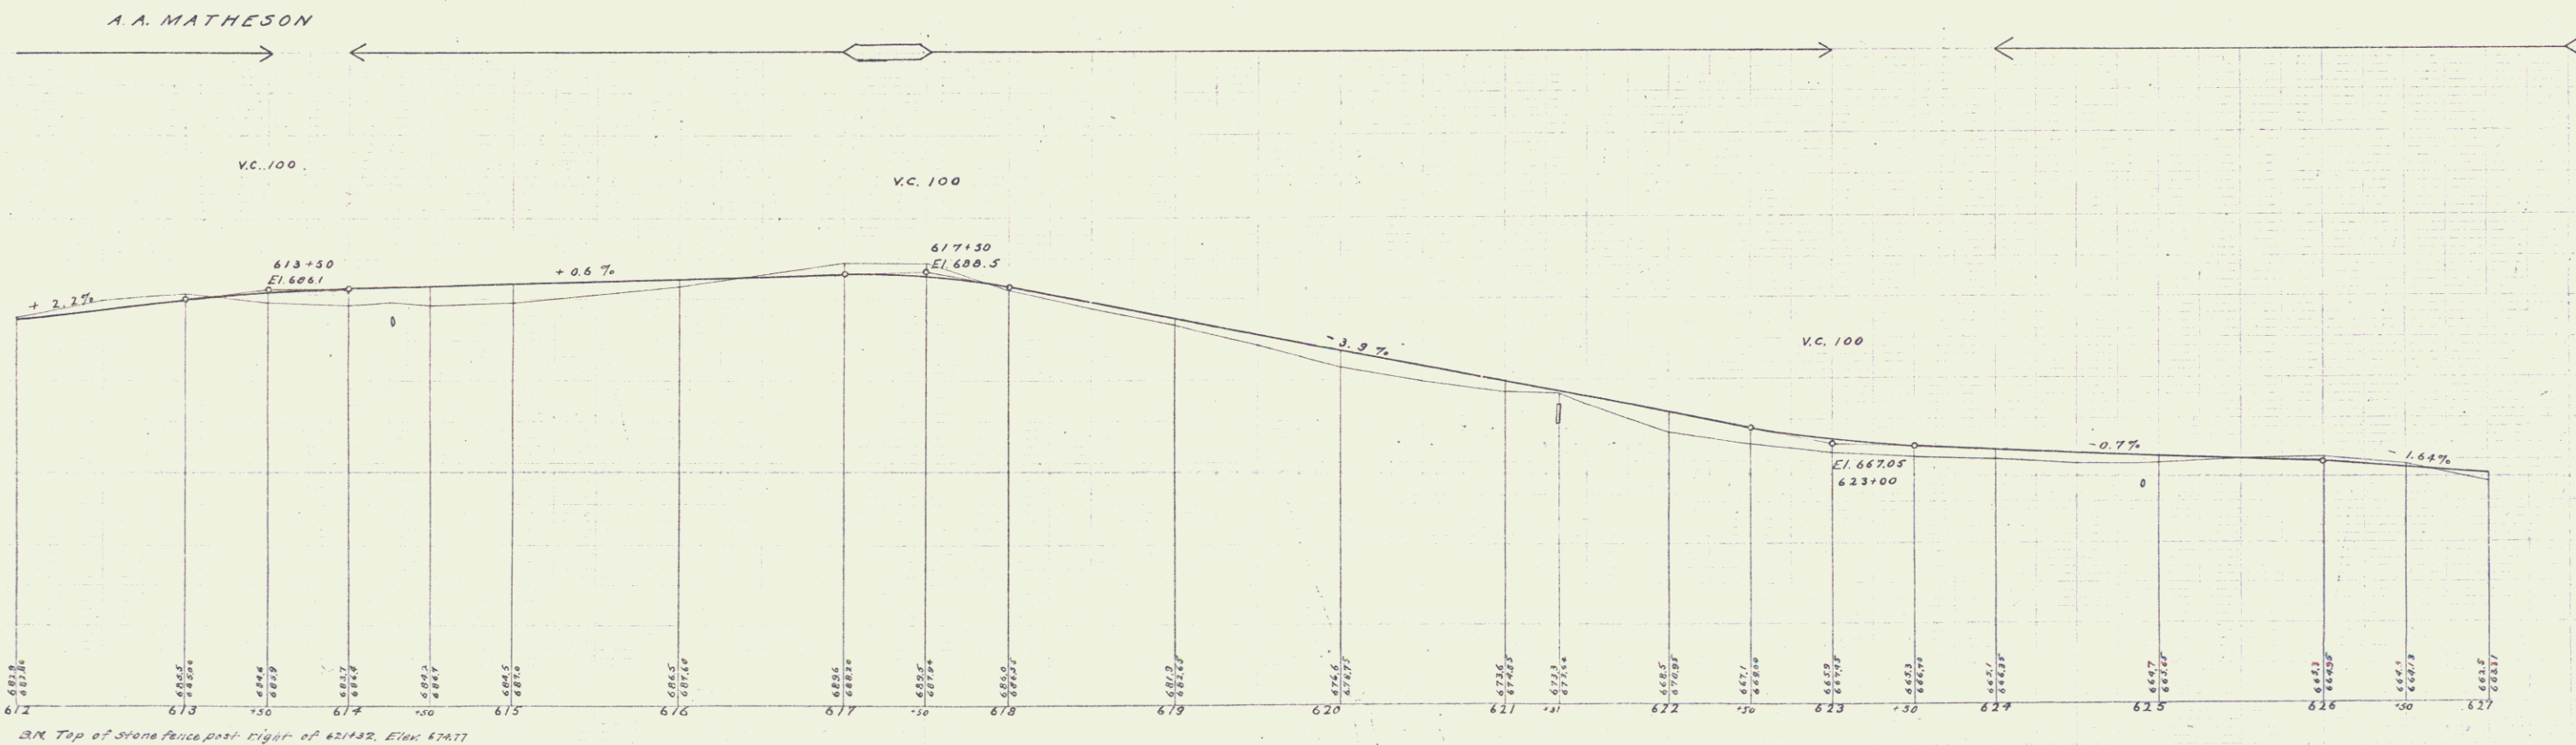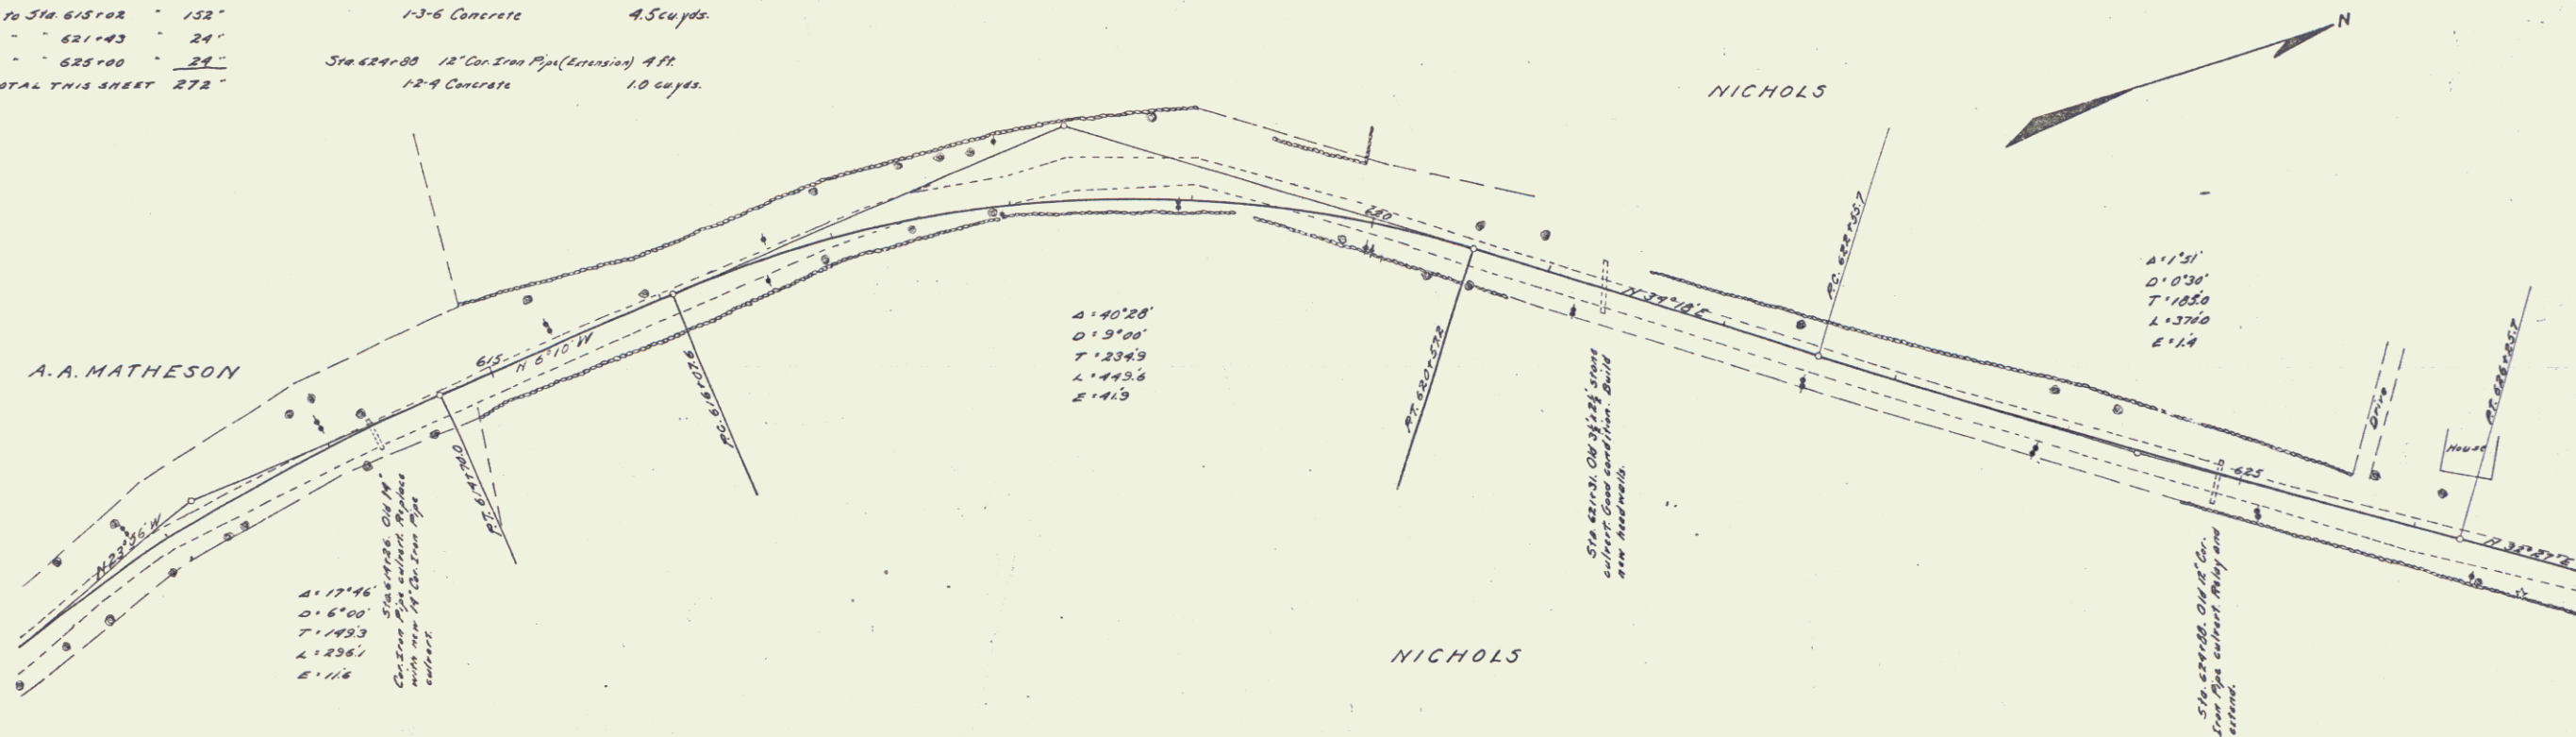

ON Top of Stone Fence, post right of 621+32, Elev. 674.77

Series F. 42 1/2



GUARD RAIL REQUIRED
 ON LEFT
 Sta 630+57 to Sta 630+81 Length 24 ft
 632+70 " 632+94 " 24 "
 ON RIGHT
 630+57 to Sta 630+81 " 24 "
 632+70 " 632+94 " 24 "
 TOTAL THIS SHEET 96 ft

CULVERT REPAIRS REQUIRED
 Sta 630+10 12-4 Concrete 10 cu yds
 Sta 630+59 12-6 Concrete 13 cu yds
 Steel 6 lbs.
 Sta 632+80 12-4 Concrete 10 cu yds
 Sta 630+13 12-4 Concrete 10 "

FED. ROAD DIST. NO.	STATE	FED. AID PROJ. NO.	FISCAL YEAR	SHEET NO.	TOTAL SHEETS
8	VT.	12	1954	43	133

J.L. Davis
 J.L. Davis & Son
 1954
 634 ft

W.E. Weather
 J.L. Davis
 1954
 634 ft

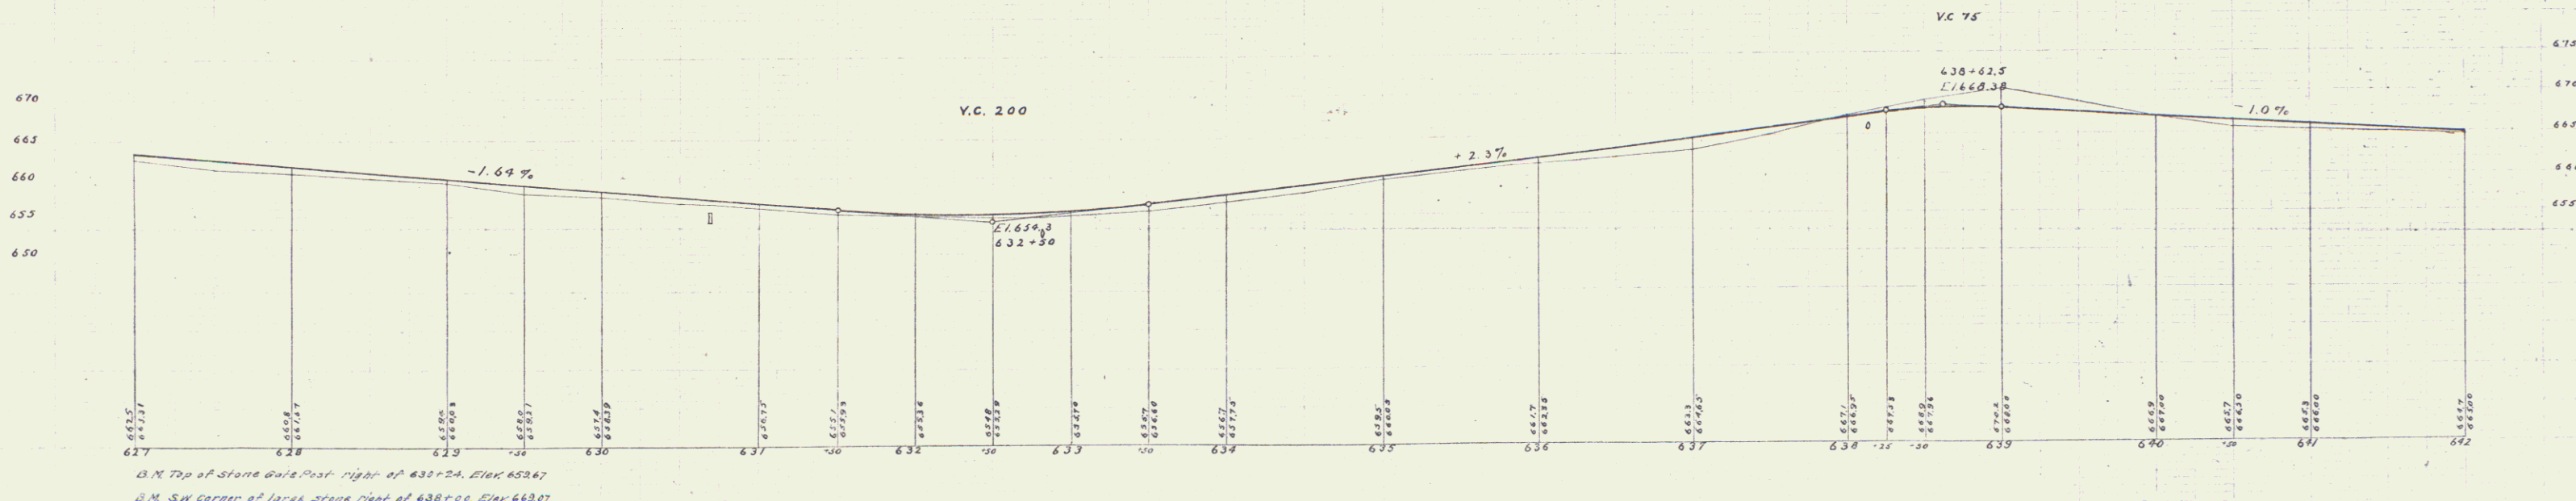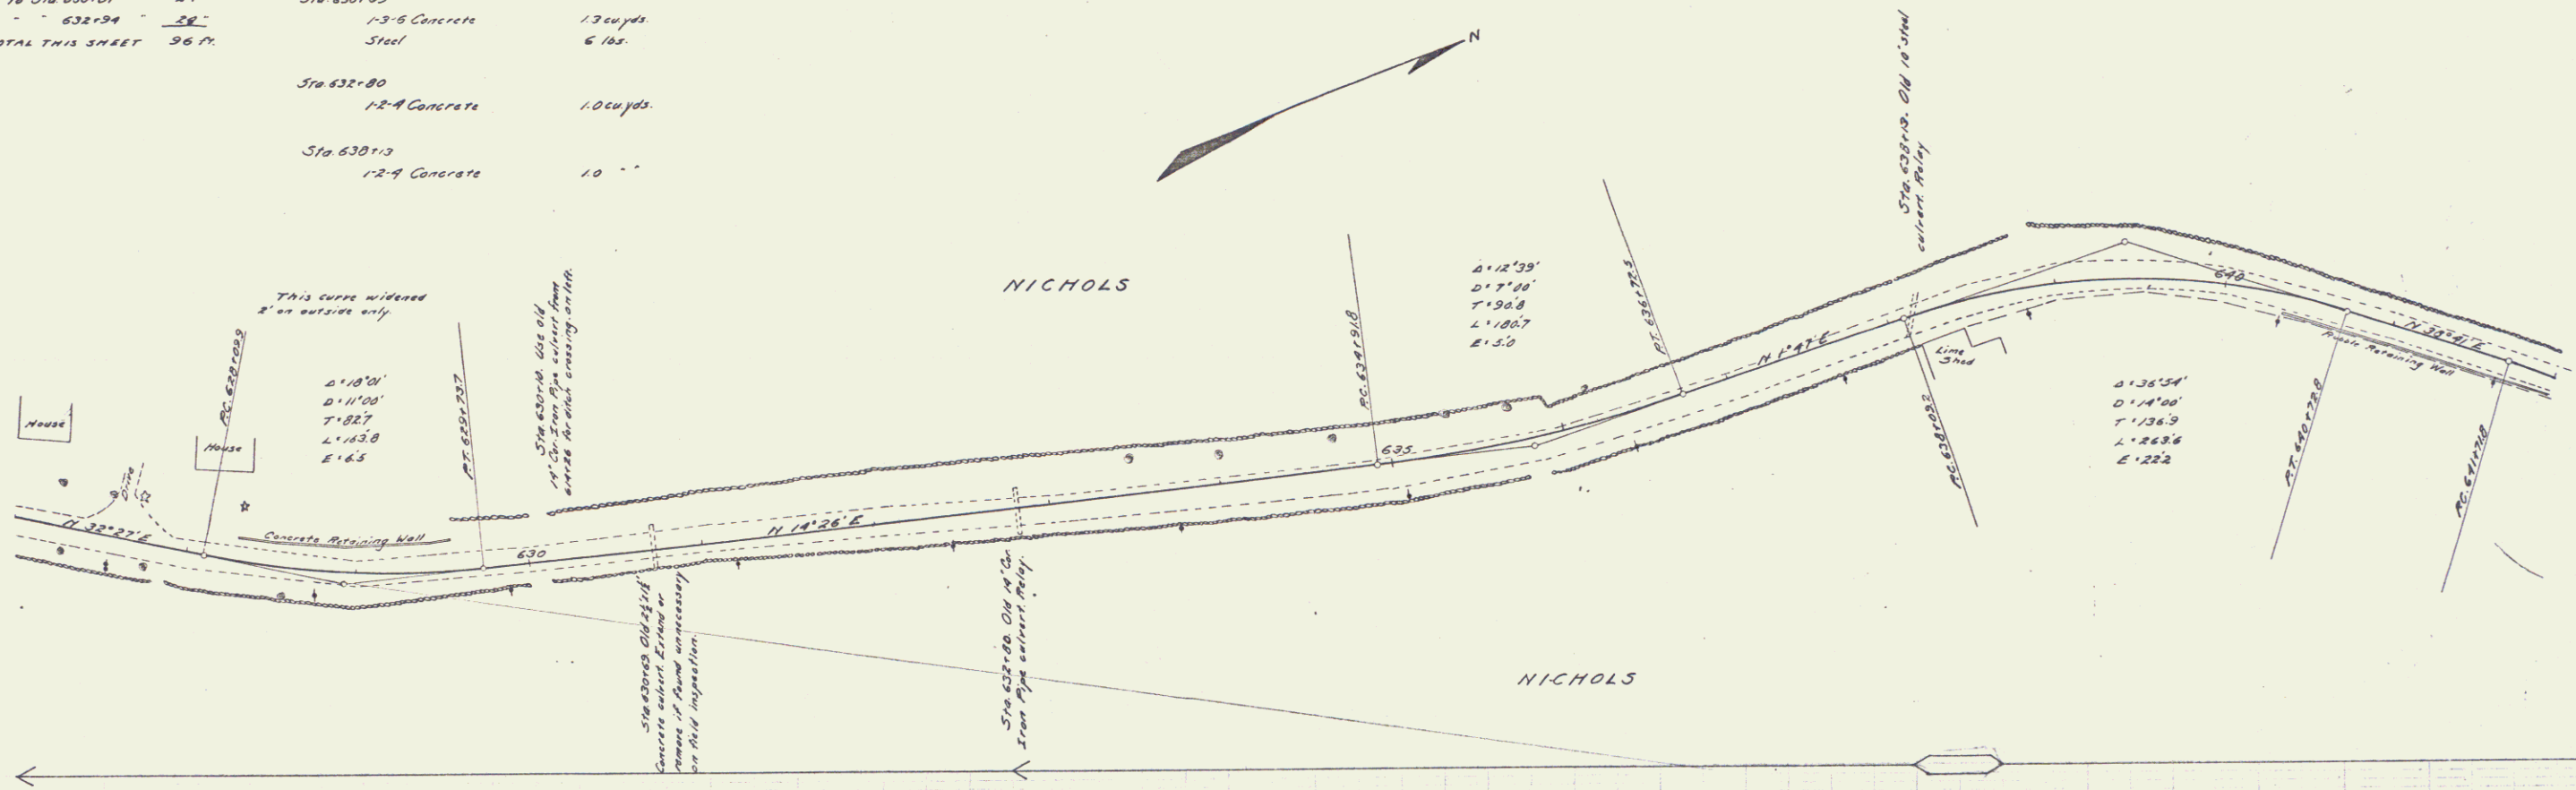

U.M. Top of Stone Guide Post, Right of 632+24, Elev. 652.67
 U.M. S.W. Corner of large stone right of 638+00, Elev. 643.07

During 1954
 Station 634

GUARD RAIL REQUIRED

CULVERT REPAIRS REQUIRED


GUARD RAIL REQUIRED

Sta. 641+99 to Sta. 642+15 Length 16 ft.
" 642+21 " 642+37 " 16 "
ON RIGHT
" 641+99 to Sta. 642+15 " 16 "
" 642+21 " 642+37 " 16 "
" 655+75 " 657+00 " 125 "
TOTAL THIS SHEET 885 ft.

NEW CULVERTS REQUIRED


Danby Cemetery

NICHOLS

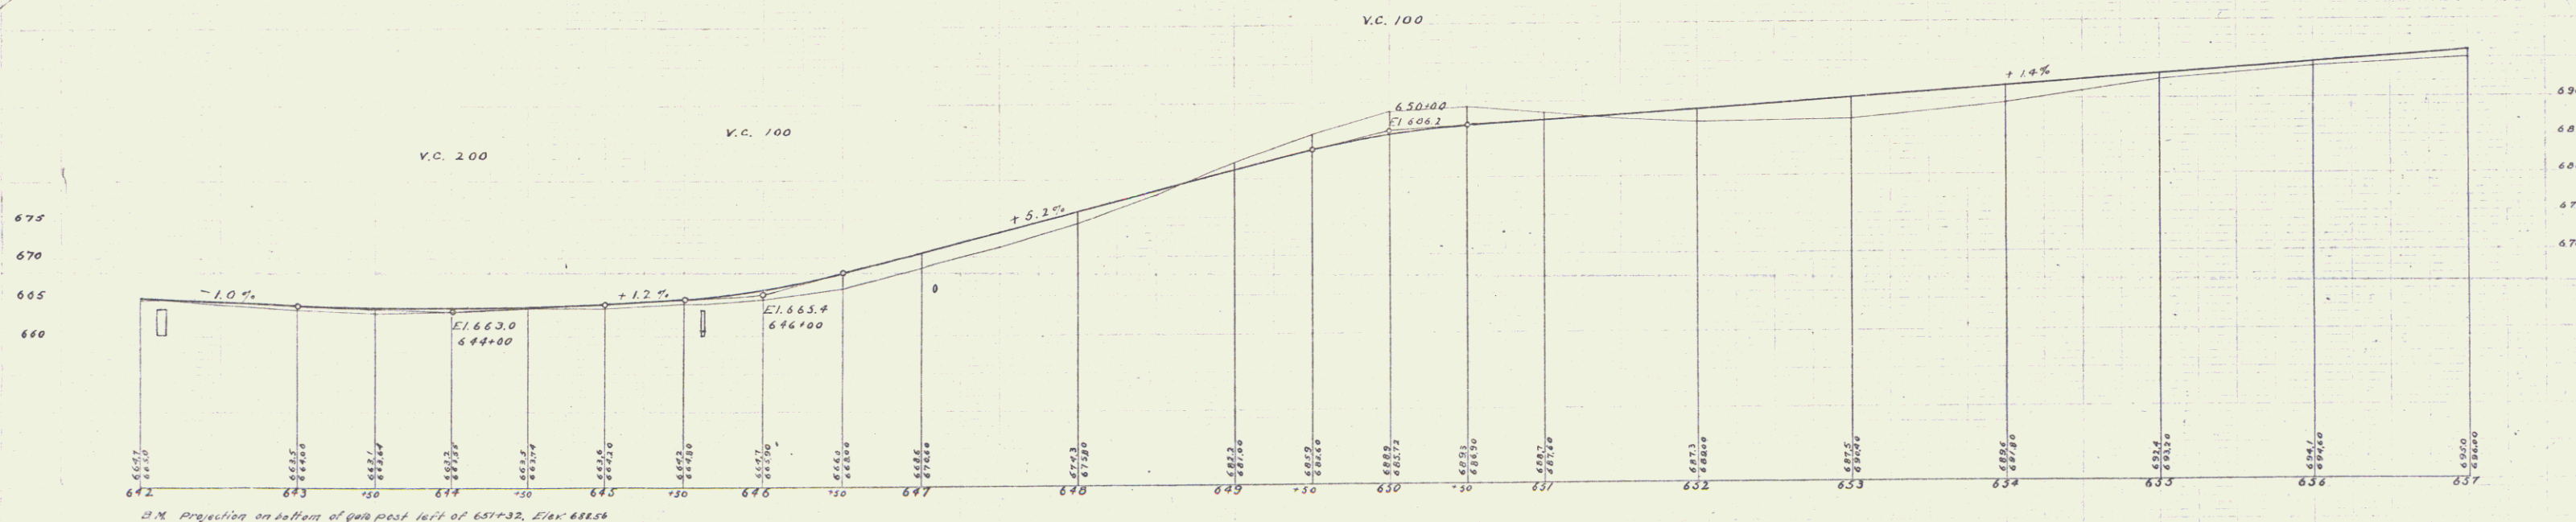



Series F. No 12 Filed
Sheet 45 of 133

GUARD RAIL REQUIRED				CULVERT REPAIRS REQUIRED			
ON LEFT							
Sta 662+12 to Sta 662+36	Length	24 ft		Sta 662+24			
663+02 "	663+30 "	48 "			1-2' Concrete		10 cu yds
663+66 "	663+90 "	24 "					
ON RIGHT							
663+00 to Sta 663+24		24 "					
663+08 "	663+30 "	48 "					
663+66 "	663+90 "	24 "					
663+12 "	663+36 "	24 "					
TOTAL THIS SHEET			213 ft.				

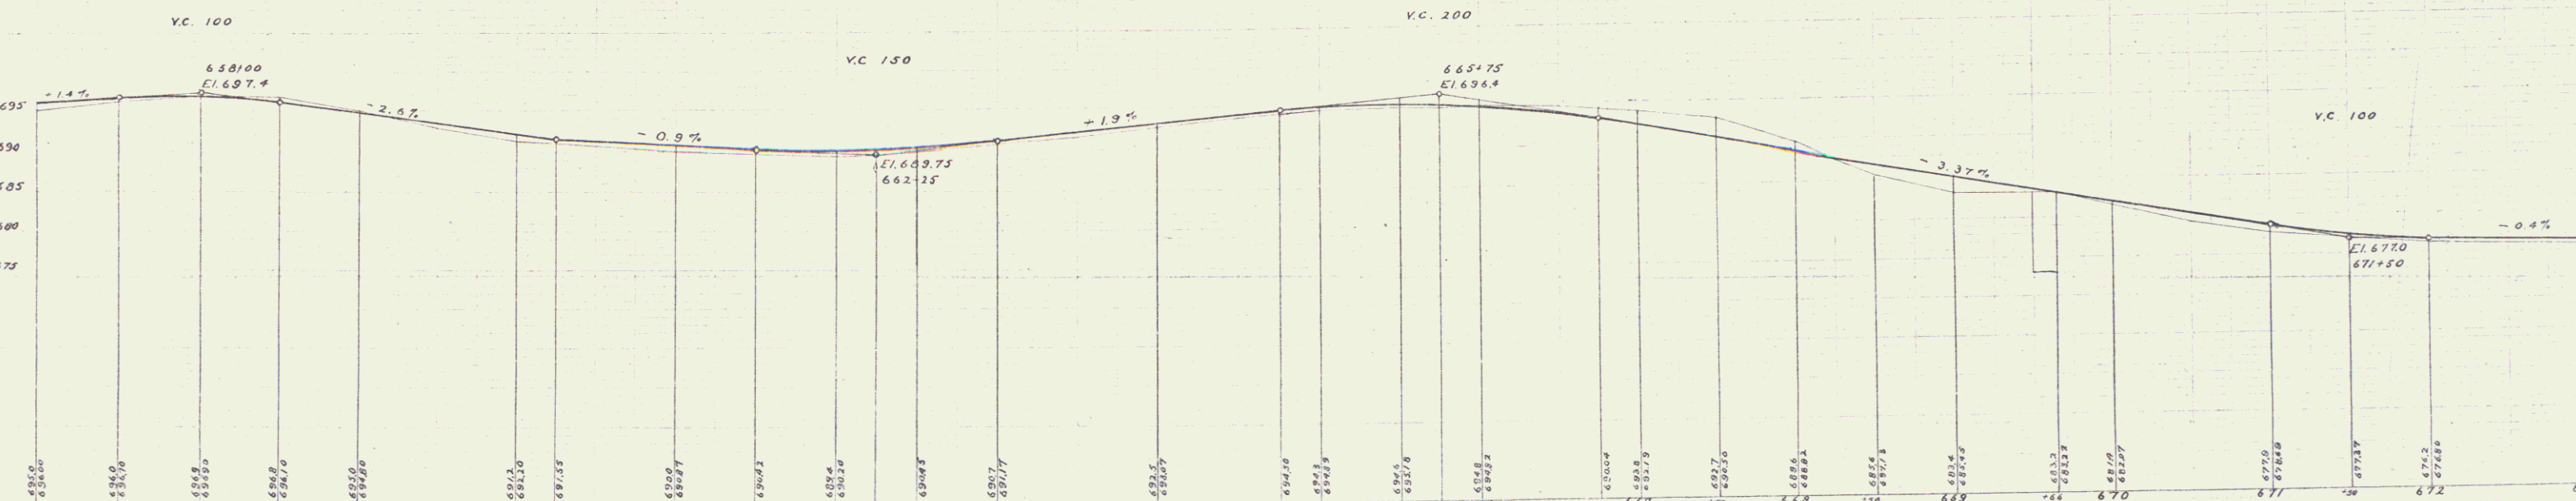

Series F No. 12 Filed
Sheet 46 of 133


FED. ROAD DIST NO	STATE	FED. AID PROJ NO	FISCAL YEAR	SHEET NO	TOTAL SHE
9	VT	12	1019-20	47	13

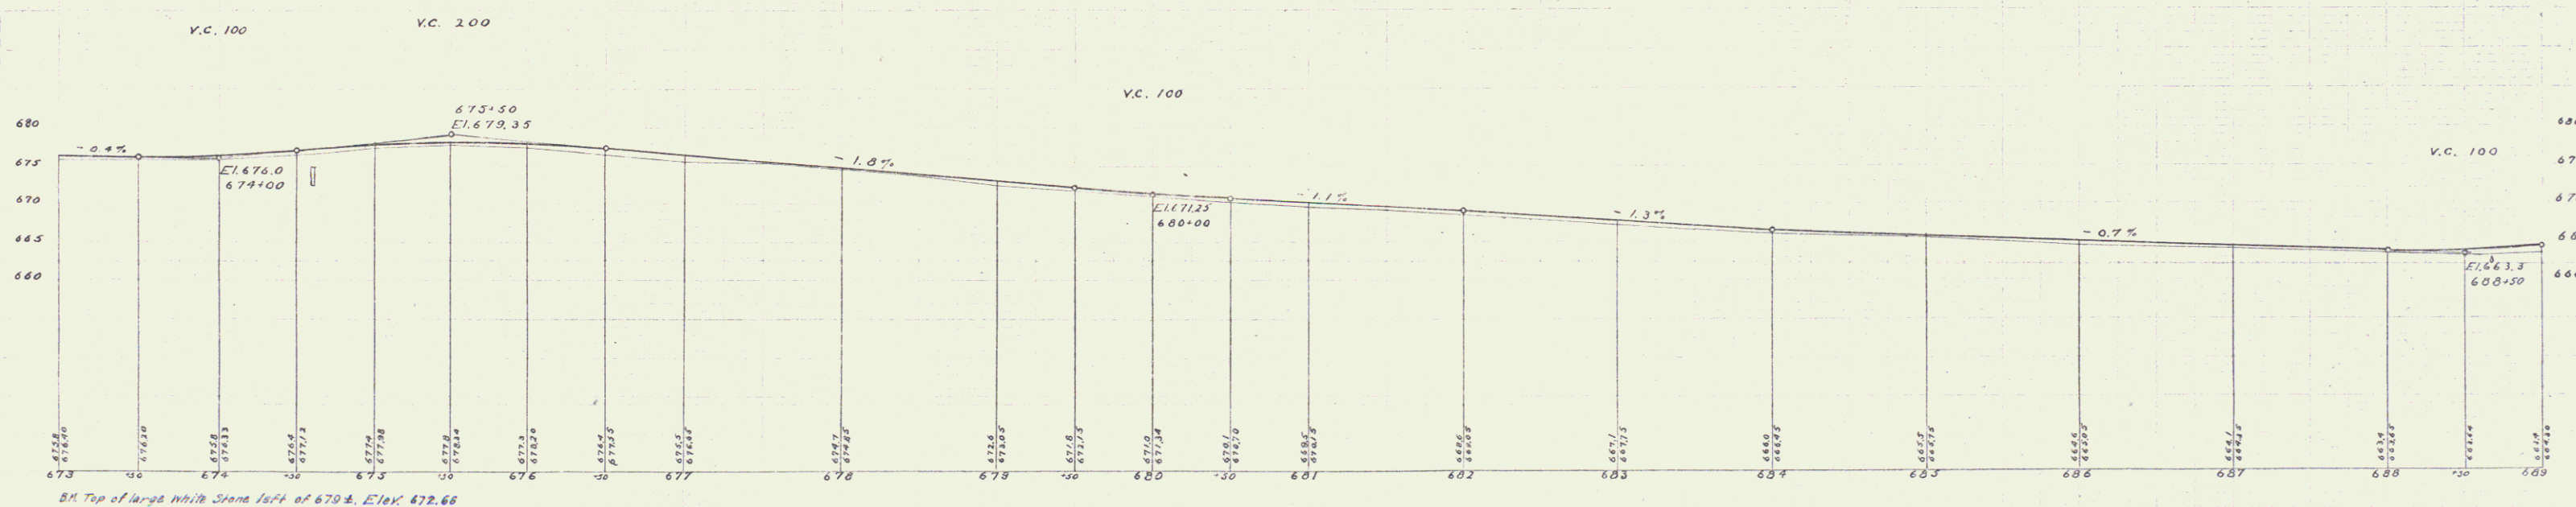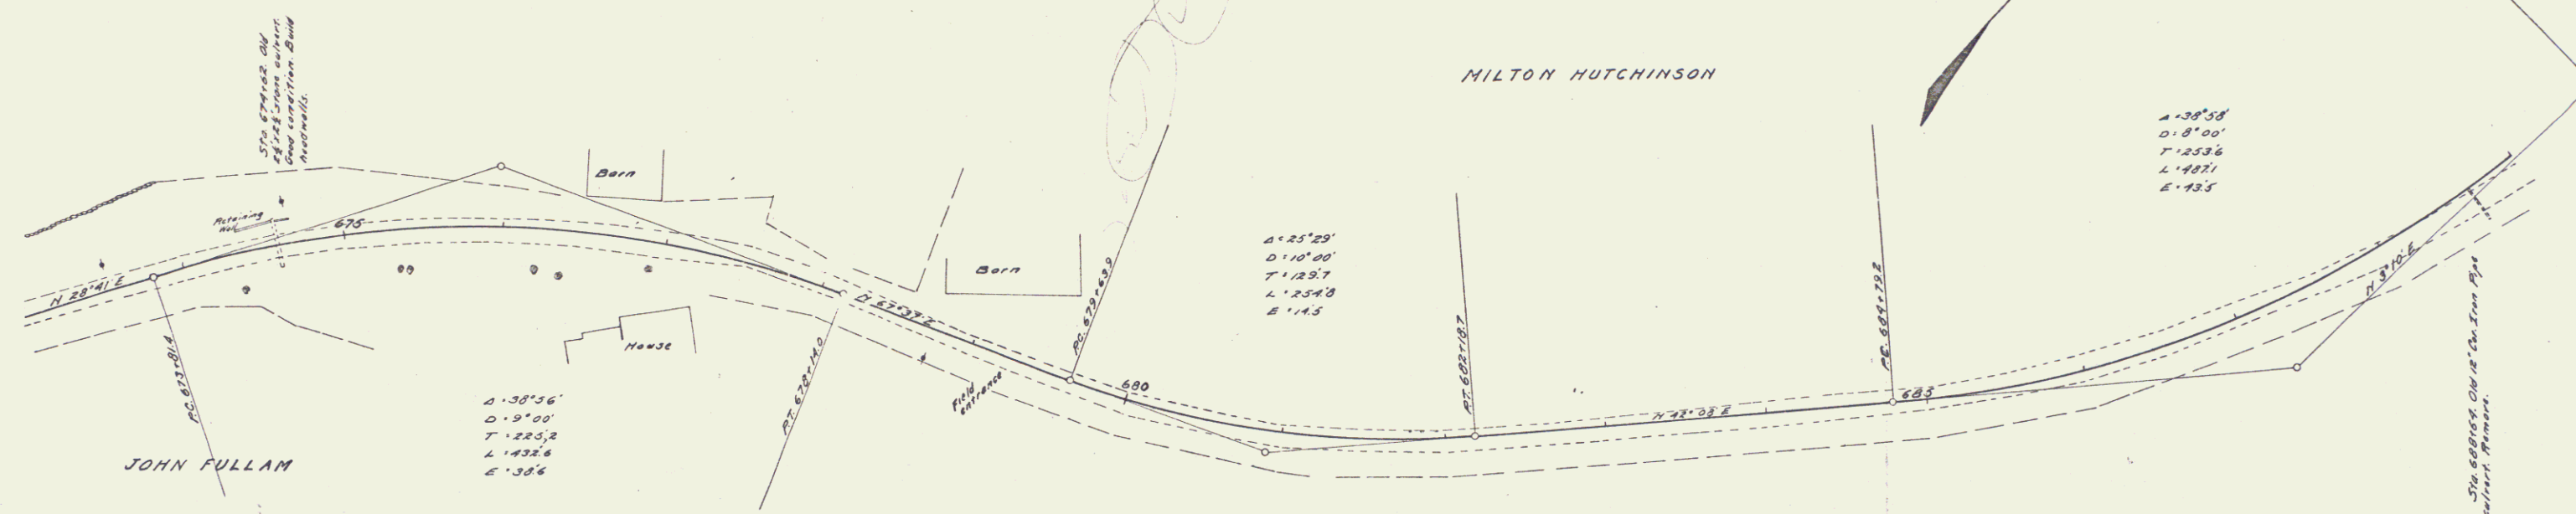

BH Top of large White Stone Isst of 679±, Elev 672.66

Series F No 12 File
Sheet 47 of 12

GUARD RAIL REQUIRED		STONE BASE REQUIRED		NEW CULVERTS REQUIRED	
ON LEFT					
Sta 689+88 to Sta 690+12	Length 24 ft.	Sta 701+00 to Sta 704+00	Length 300 ft.	Sta 689+00	18" Con. Iron Pipe 30 ft.
693+56	693+00 24"			12-4 Concrete	10 cu. yds.
696+88	697+12 24"				
ON RIGHT				Sta 697+00	18" Con. Iron Pipe 26 ft.
689+88 to Sta 690+12	24"			12-4 Concrete	19 cu. yds.
693+56	693+00 24"				
696+88	697+12 24"				
700+20	703+00 <u>328"</u>				
TOTAL THIS SHEET		472 ft.			
				CULVERT REPAIRS REQUIRED	
				Sta 693+58	14" Con. Iron Pipe 26 ft.
				12-4 Concrete	10 cu. yds.


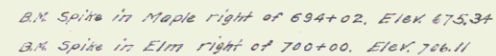


GUARD RAIL REQUIRED
 ON LEFT
 Sta 708+18 to Sta 708+40 Length 22 ft.
 717+11 717+35 24'
 719+20 720+40 120'
 ON RIGHT
 708+24 to Sta 708+72 48'
 716+50 717+84 136'
 TOTAL THIS SHEET 352 ft.

CULVERT REPAIRS REQUIRED
 Sta 708+34 13-6 Concrete 0.3 cu yds.
 Sta 717+23 12-4 Concrete 5.3 cu yds.
 13-6 72' "
 Sta 719+74 12-4 Concrete 11.6 cu yds.
 13-6 201' "
 Steel 314 lbs.

STONE BASE REQUIRED
 1350 linear feet where needed

FED. ROAD DIST. NO.	STATE	FED. AID	PLAN SHEET NO.	TOTAL SHEETS
8	VT	12	1018-M-48	123

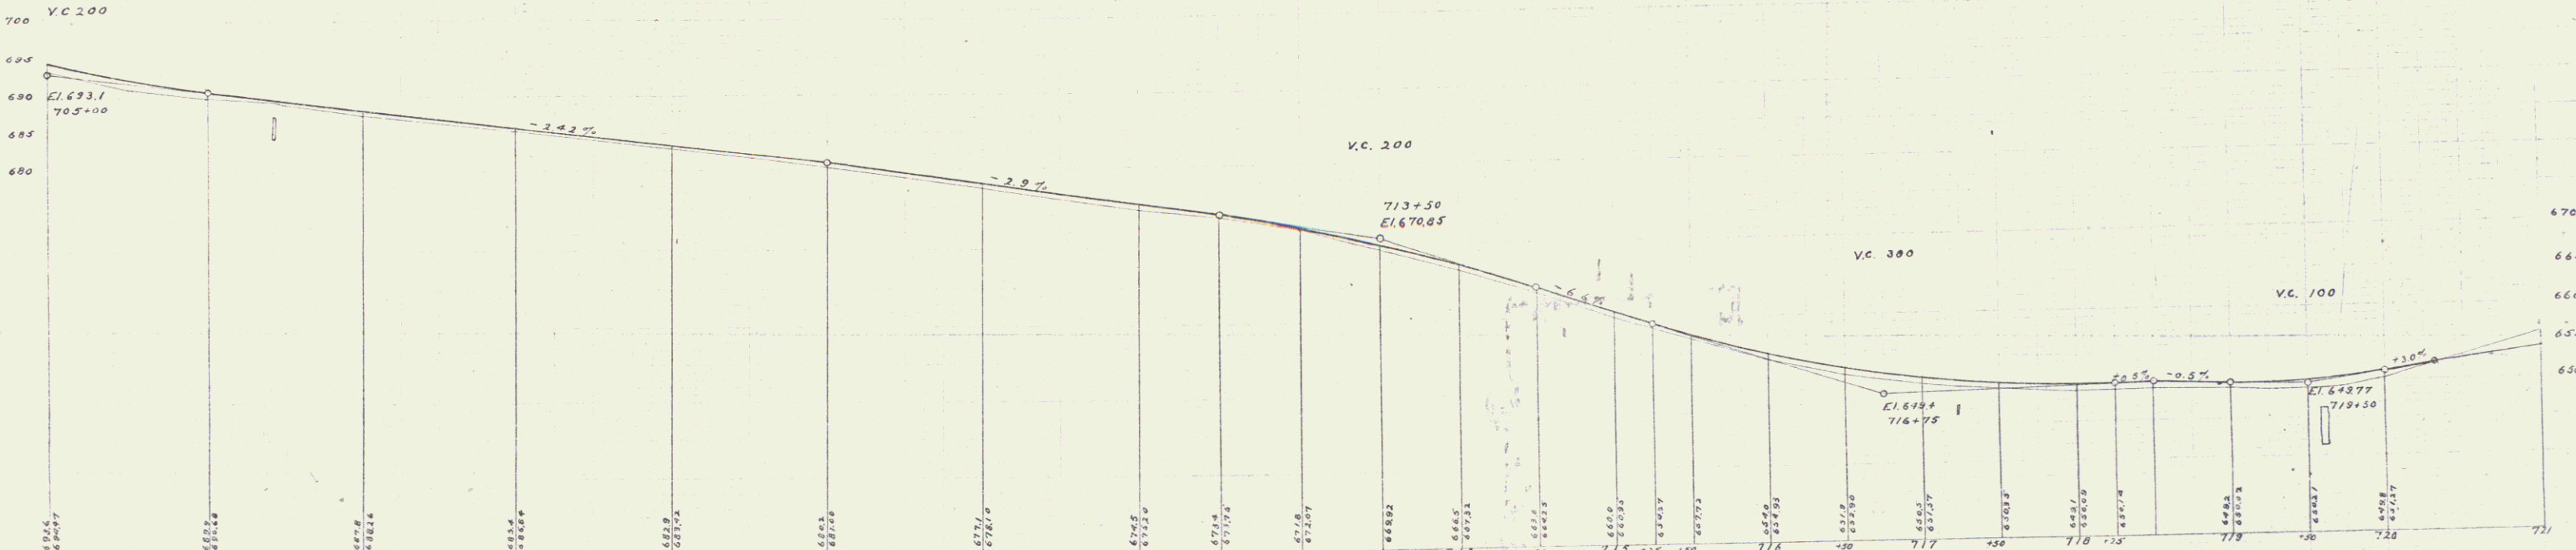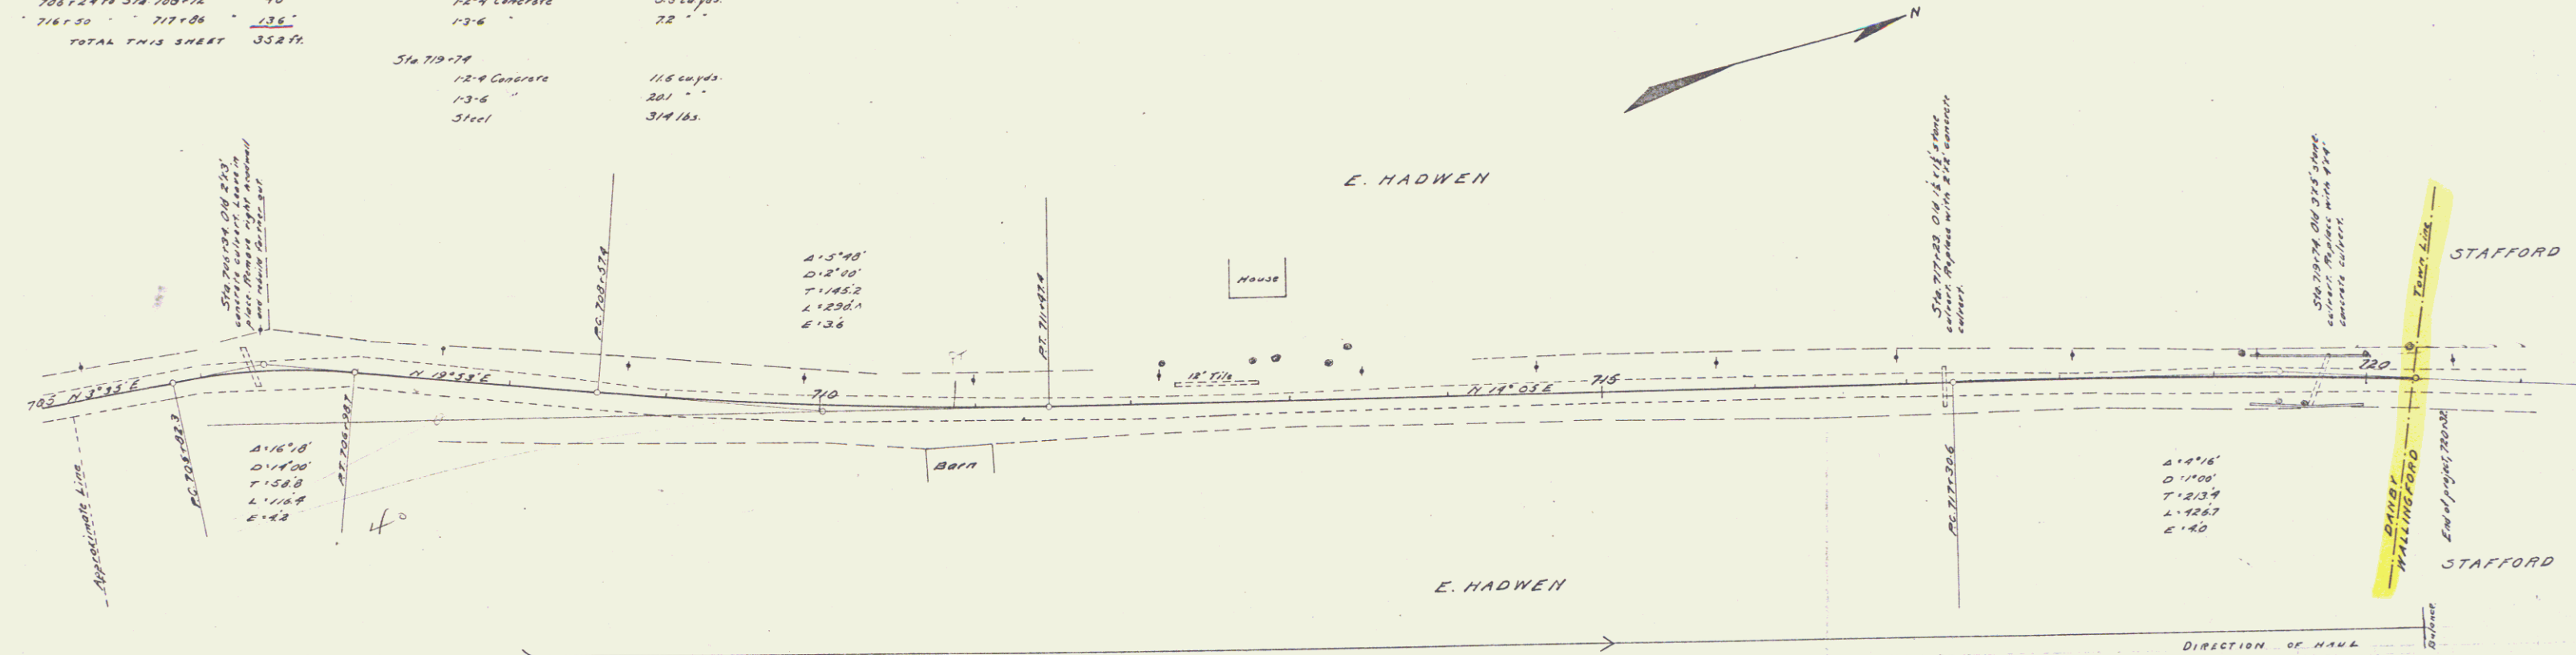

B.A. Top of Sta corner of Headwall right of 706+37. Elev 692.00
 B.X. Top of Stone post at junction of road and meadow fences left of 717+. Elev 654.09
 B.K. Spike in E.M. right of 720+28. Elev 650.87

Checked F. M. F. 10/1/1930