


CONVENTIONAL	SIGNS
DOW	
CUTTY LINE	
TOWN LINE	
HIGH LINE	
STONE WALL	
FENCED PROPERTY	
WIND RAIL	
TRAVELLED WAY	
AL ROAD	
STAINING WALL	
RIVER LINE	
RUEY LINE	
OVERY	
LOW WUFF	
MOLLEY GLE	
WER POLE	
LEMONGS POLE	
REES	

FEDERAL PROJECT

ADT (1957)	780 - 980
ADT (1980)	1275 - 1600
DHV	195 - 230
O	55
T	15
MPit	50

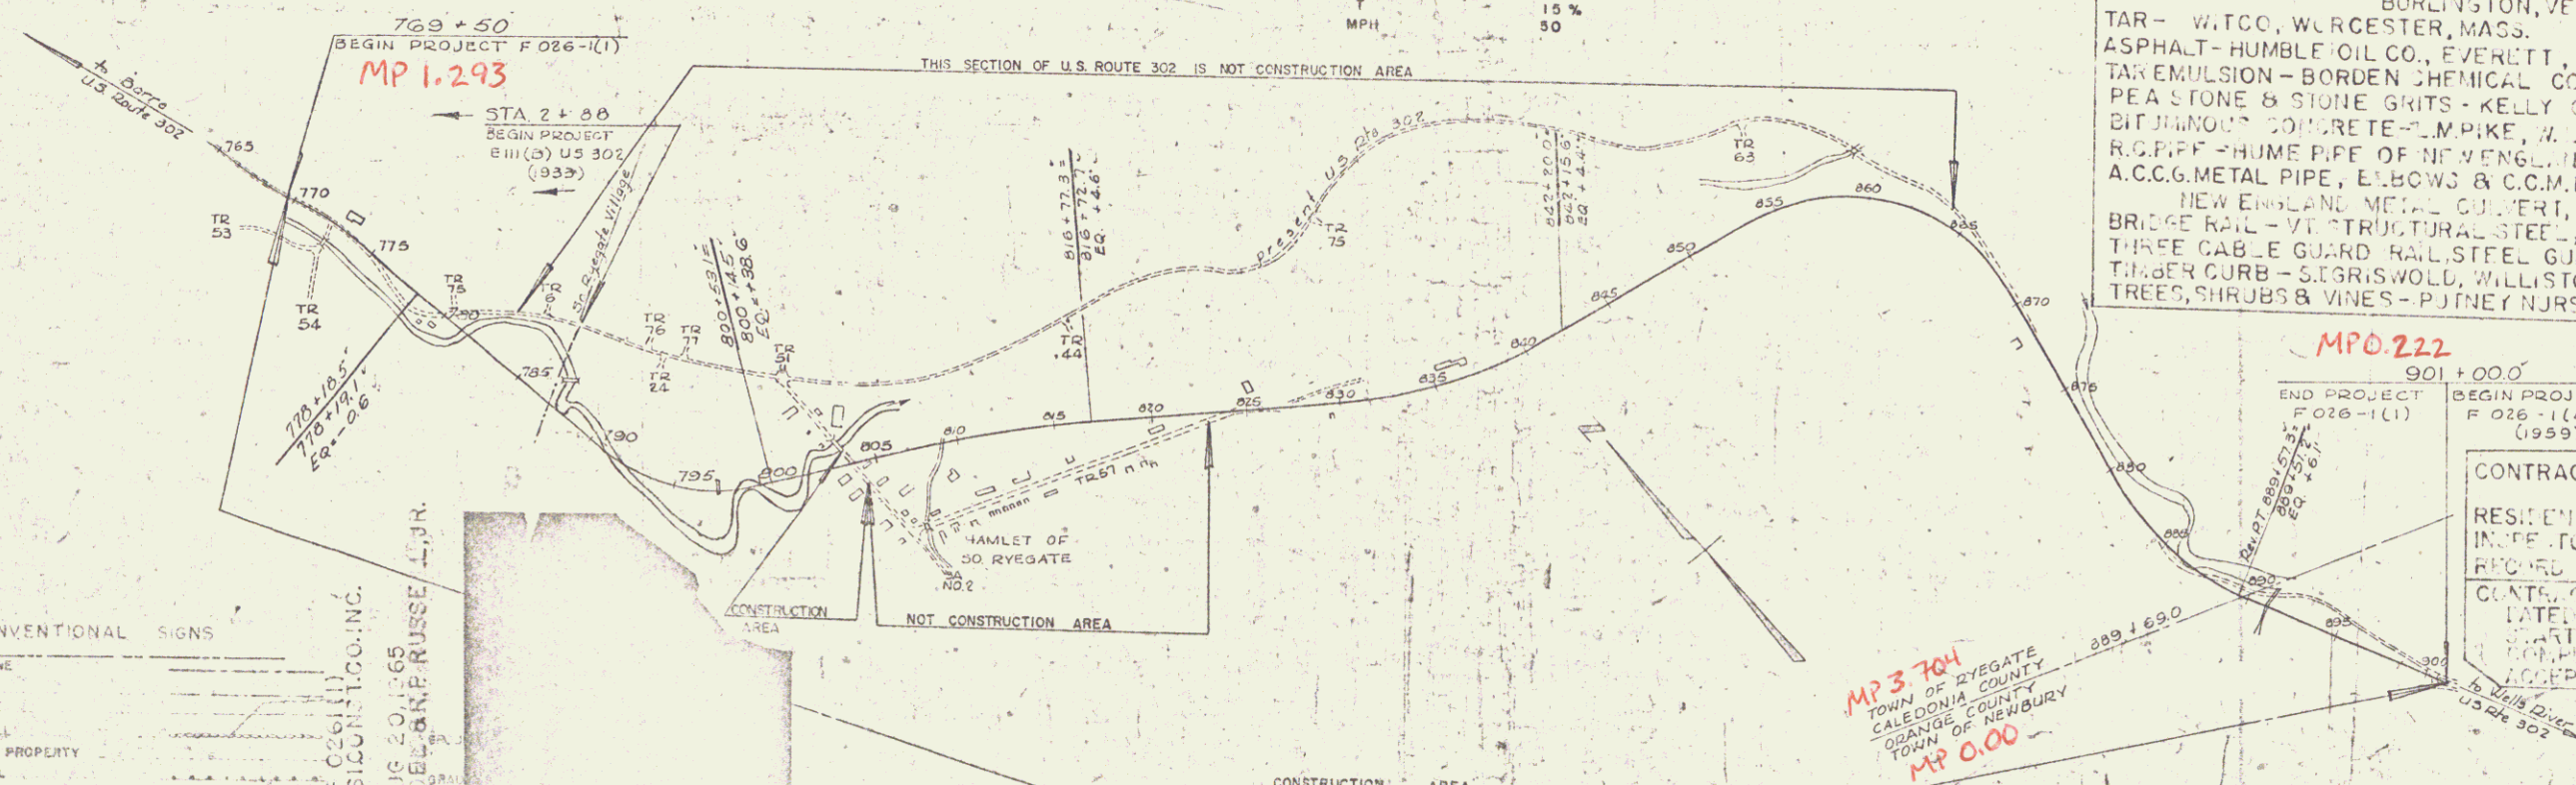

Pin# 99R564

MATERIALS
SUBBASE OF GRAVEL - EASTMAN PIT, SOUTH RYE GATE, VERMONT
S'BBASE OF SAND - EASTMAN & LEET'S PIT, S. RYE GATE, VT.
SUBBASE OF CRUSHED ROCK - CALEDONIA SAND & GRAVEL CO.
RYEGATE, VERMONT
CONCRETE - D & D CONCRETE, MONTEPELIER, VERMONT
REIN. STEEL - REFRUBIC STEEL CORP., BOSTON, MASS.
STRUCTURAL STEEL - VERMONT STRUCTURAL STEEL CORP.
BURLINGTON, VERMONT
TAR - W.T.CO., WORCESTER, MASS.
ASPHALT - HUMBLE OIL CO., EVERETT, MASS.
TAK EMULSION - BORDEN CHEMICAL CO. NEW YORK, N.Y.
PEA STONE & STONE GRITS - KELLY CONST.CO., BARRE, VT
BIRMINGHAM CONCRETE - L.M.PIKE, W. LEBANON, N.H.
R.C.P.I.P - HUMBLE PIPE OF NEW ENGLAND, W. WNSOR, VT.
A.C.C.G. HUME PIPE, E.L.BOWS & C.C.M.P.I.P. ARCH
NEW ENGLAND METAL CO. LUTHER, WHITE RIVER JUNCTION, VT.
BRIDGE RAIL - V.T. STRUCTURAL STEEL, BURLINGTON, VT.
THREE CABLE GUARD RAIL STEEL GUIDE & MARKER POSTS &
TIE-BAR CURB - STORISWOLD, WILLSTON, VT.
TREES, SHRUBS & VINES - PUTNEY NURSEY, PUTNEY, VERMONT

CONTRACTOR: S. V. CROSS, CONSTRUCTION CO., INC.
TERRINGTON, WYOM.
RESIDENT ENGINEER: JOHN WOOD
IN CHARGE: RICHARD L. BURR, A.R.S. ZAMSON
RECORD ENGINEER: A.G. SPELLE & R. BRUSSELL, JR.
COUNTY: T.T.
DATE: DEC. 26, 1963
APPROVED: FEB. 1964
APPROVED: AUG. 20, 1965
APPROVED: AUG. 20, 1965

(To Be Returned To R.O.W. Division)

CONSTRUCTION IS TO BE CARRIED ON IN ACCORDANCE WITH THE PLANS AND THE STANDARD SPECIFICATIONS FOR HIGHWAY AND BRIDGE CONSTRUCTION OF JANUARY 1956, SUBMITTED TO THE BUREAU OF PUBLIC ROADS AS APPROVED JULY 5, 1956, INCLUDING ALL SUBSEQUENT APPROVED REVISIONS AND SUCH REVISED SPECIFICATIONS AND SPECIAL PROVISIONS AS ARE SUBMITTED WITH THE PLANS.

DEPARTMENT OF COMMERCE
BUREAU OF PUBLIC ROADS

(To Be Returned To R.O.W. Division)

APPROVED BY CHIEF <i>R.M. Cantel</i>	APPROVED BY <i>E. St. Lockney</i>	APPROVED BY <i>Sam Brown</i>	APPROVED BY <i>R. G. Fennell</i>	APPROVED BY <i>L. M. Lane</i>	APPROVED BY <i>A. S. F. Hoff</i>
DATE <i>4/5/63</i>	DATE <i>APR 19 1963</i>	DATE <i>4/5/63</i>	DATE <i>4/6/63</i>	DATE <i>4/10/1963</i>	DATE <i>10-19-66</i>





Sta. 769+20 LT. - 772+00 LT., New 1/4" x 250' Seamless Copper
Water Tube Excavation To Be Pwd For As Trench Excavation- Item 103

PARCEL: 13 STA: 768+00 - 769+18
GRANTOR: HERMAN E. WILLIAMS
TAKING: 1440 Sq Ft REM: 60 A
TITLE TAKEN: W.D. 11/22/63
RECORDED: RYEGATE BR. 27 PG. 12 DT. 1/9/64



PARCEL: 13 STA: 768+00 - 771+85
GRANTOR: VIOLA M. WILLIAMS
TAKING: REM. 59.6 A
TITLE TAKEN: W.D. 12/15/63
RECORDED: RYEGATE BR. 27 PG. 9 DT. 1/9/64

ITEM 543
3 CABLE GUARD RAIL
W/ STEEL POSTS
768+00 - 769+44 RT
769+47 - 772+03 RT
768+25 - 772+05 RT

Removal & Disposal of
Present Guard Rail
769+90 - 770+70 RT

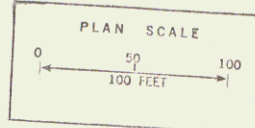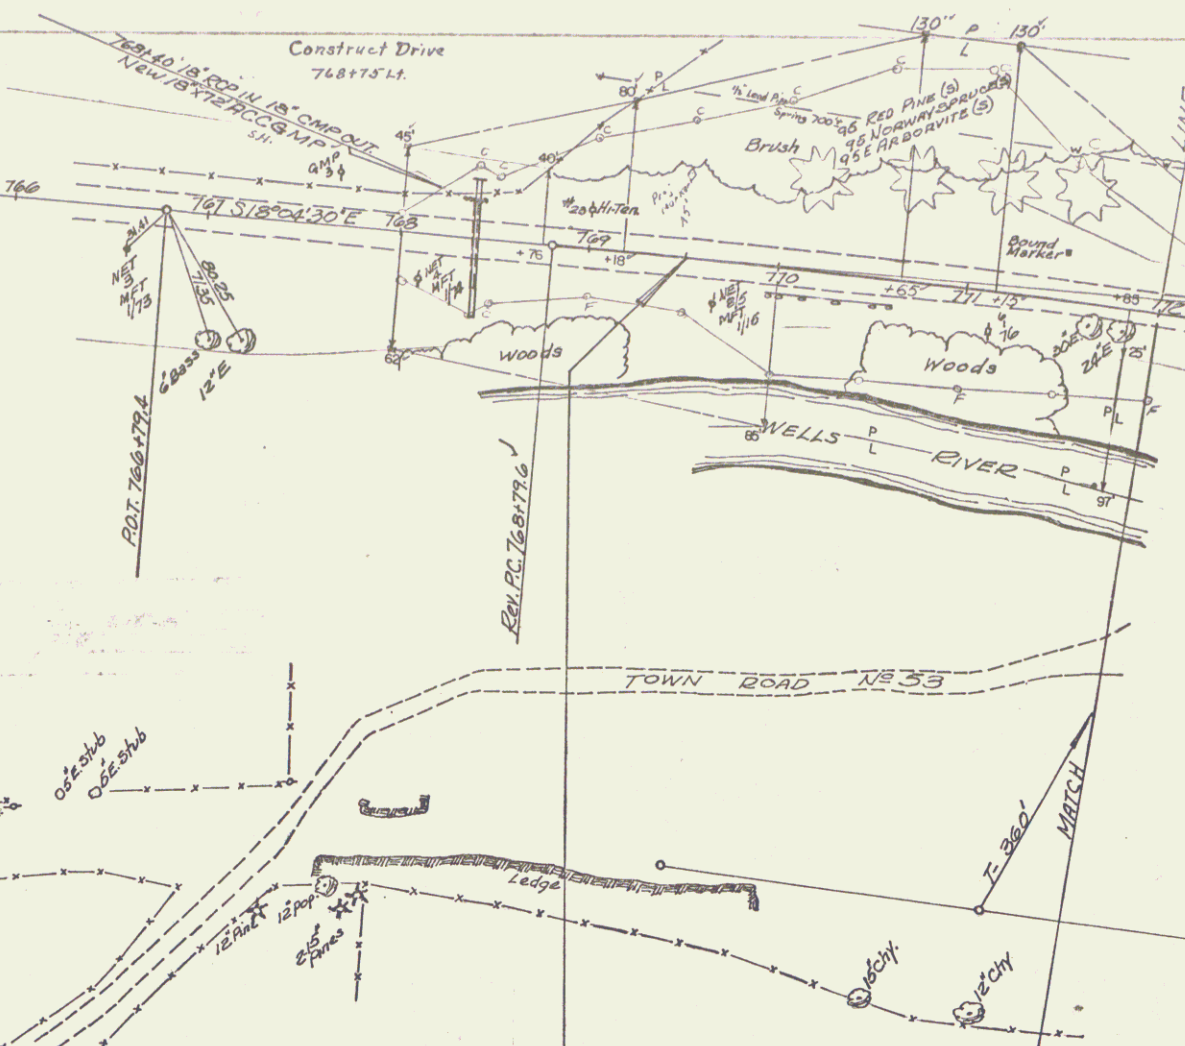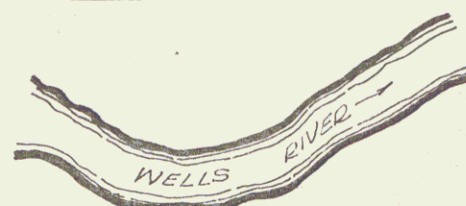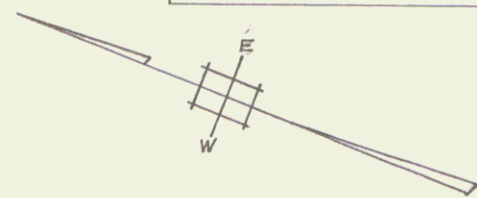

CONSTRUCT SATISFACTORY
APPROACH
769+50
BEGIN PROJ. F026-1(1)

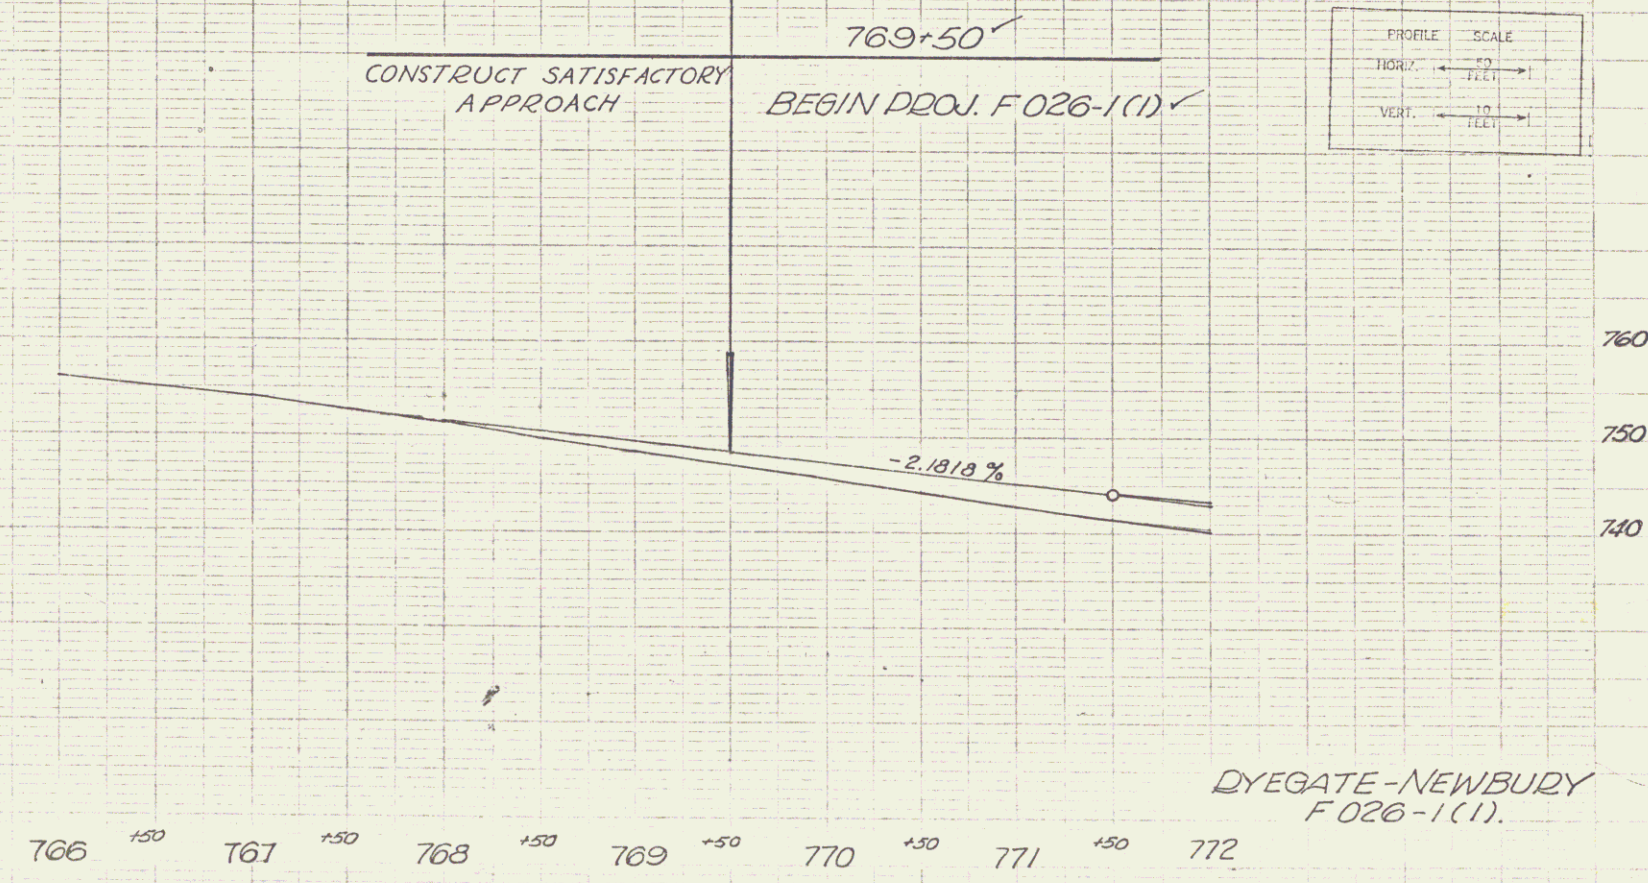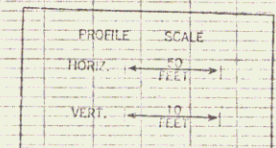

DYEGATE-NEWBURY
F026-1(1).

Sheet 10 of 14 Sheets

PARCEL	2 A, B, C	STA. 768+76 - 775+56
GRANTOR	RELAND O. & BETTY P. DANIELS	
TAKING	0.8 AC	REM. 2.2 AC
RIGHTS	DRIVE 773+35 LT. SEWER PIPE CROSSING 773+40	
TITLE TAKEN	W.D. 12/13/63	
RECORDED	RYEGATE BK 27 PG 17-18 DT. 11/9/64	

Drilling & Blasting of Solid Rock Subgrade
782+50 - 783+50

Excavation & Removal of Road Surface on
Roadways Item 118-A
777+50 - 779+75

PARCEL	2 A
STATIONS	768+76 - 775+56
TAKING	0.8 AC

PARCEL	3	STA. 774+55 - 781+70
GRANTOR	KENDALL F. & POLLY W. BEATON	
TAKING	1.4 AC	REM. 12.6 AC
RIGHTS	SLOPE LIAS 774+60 - 781+50 LT.	
TITLE TAKEN	COND. O. 11/9/63	
RECORDED	RYEGATE BK 26 PG 45B-DT. 11/9/63	

PARCEL	4	STA. 779+75 - 781+95
GRANTOR	DEAN M. THOMPSON	
TAKING	0.5 AC	REM. 0.8 AC
TITLE TAKEN	BK PG DT.	
RECORDED		

CONSTRUCT APPROACH
772+40 RT
779+80 LT

THREE CABLE GUARD RAIL
w/STEEL POSTS ITEM 543
780+42 - 780+65 RT
781+60 - 782+05 LT


CONSTRUCT DRIVE
779+25 RT
779+35 LT
776+00 LT
772+50 RT

Steel Guide Posts
772+50 RT & L&R

Demolition & Removal of Building
780+45 RT
780+60 RT
Fireplace

Removal & Disposal of
Present Guard Rail
774+60 - 778+30 RT
0+20 - 5+00 RT & 182' Remaining
3100 - 3165 LT &


DATE	11/9/63
BY	W. J. HARRIS
REVISION	1. 11/9/63
NO.	1

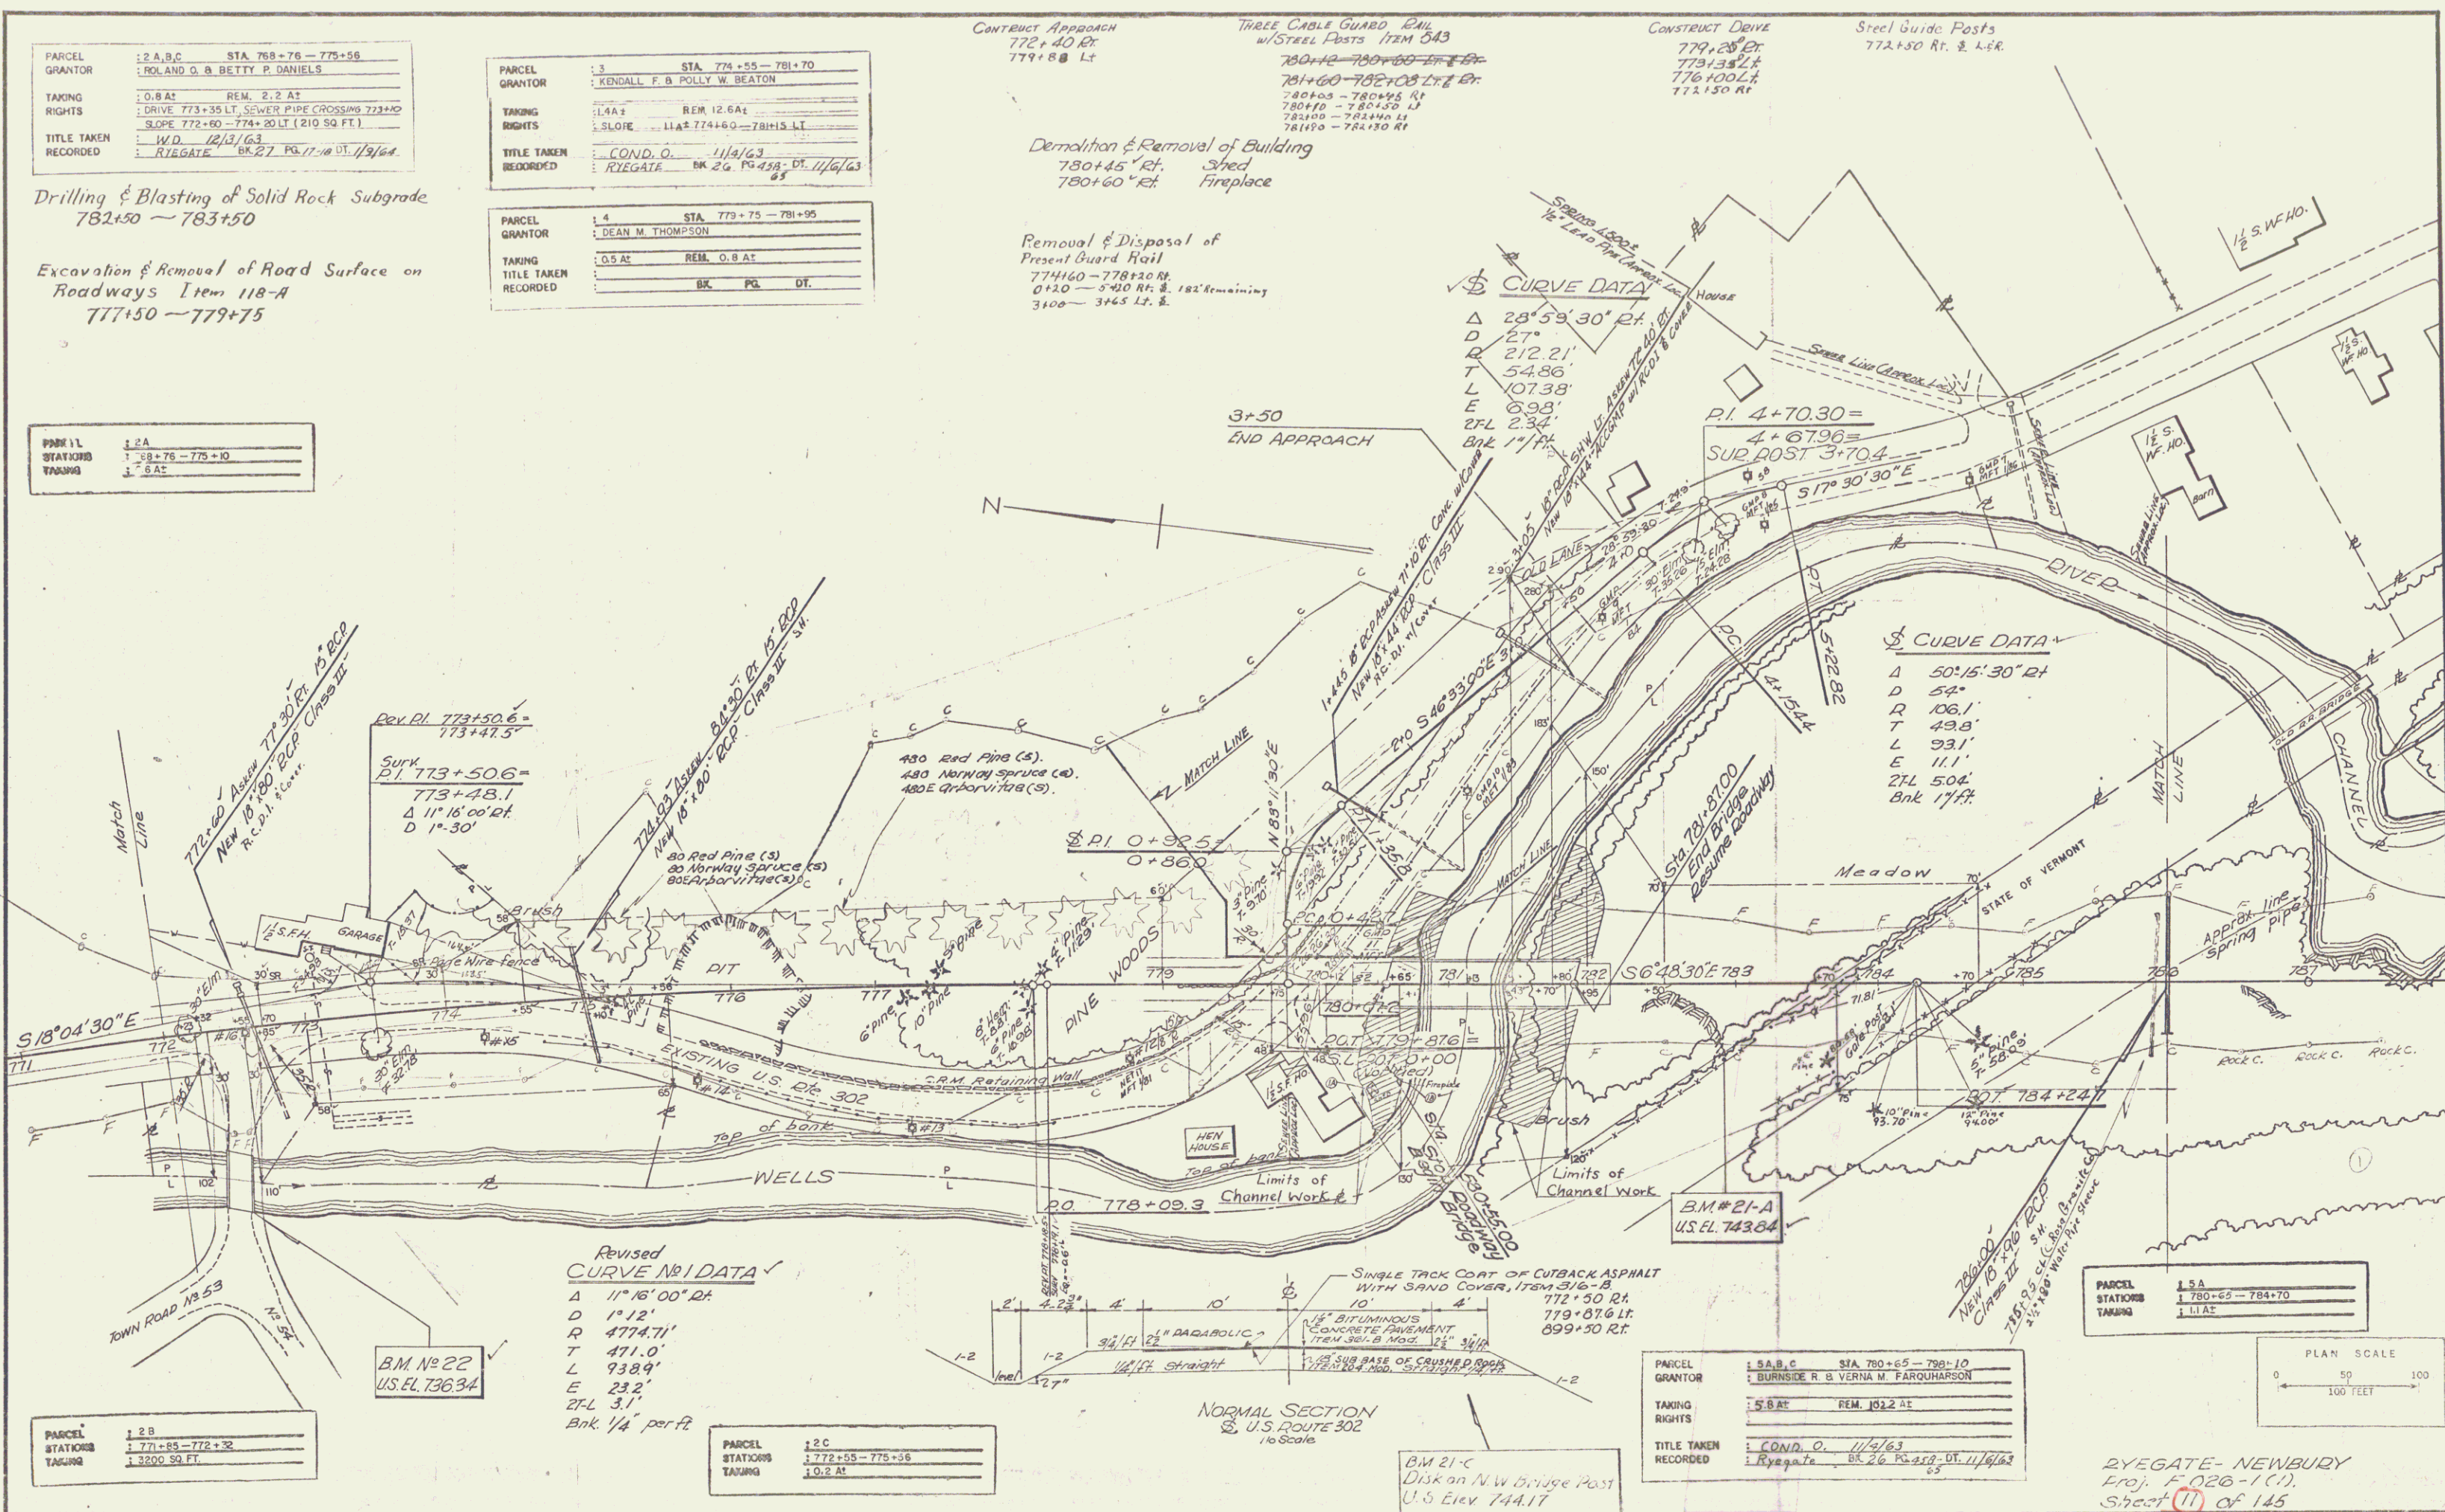

Revised
CURVE NO. 1 DATA

Δ	11° 16' 00" RT
D	1° 12'
R	4774.71'
T	471.0'
L	938.9'
E	23.2'
2FL	3.1'

Bk 1/4 per ft

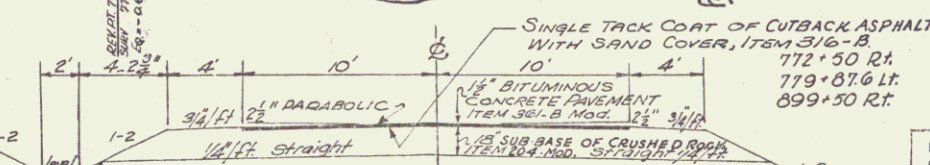

PARCEL	5 A, B, C	STA. 780+65 - 789+10
GRANTOR	BURNSIDE R. & VERNIA M. FARQUHARSON	
TAKING	5.8 AC	REM. 13.2 AC
RIGHTS		
TITLE TAKEN	COND. O. 11/9/63	
RECORDED	RYEGATE BK 26 PG 45B-DT. 11/9/63	

PARCEL	5 A
STATIONS	780+65 - 784+70
TAKING	1 LIAC

RYEGATE-NEWBURY
Proj. F 026-1(1)
Sheet 11 of 145

PARCEL	6	STA	
GRANTOR	EUGENE G. & ELSIE T. MURPHY		
TAKING	NONE	REM.	
RIGHTS	WATER PIPE LINE CROSSING 788+90		
TITLE TAKEN	W.D.	12/13/63	
RECORDED	RYEGATE	BK 27 PG 13	DT 1/9/64

Drilling & Blasting of Solid Rock
Subgrade
786+28 ~ 787+76

STONE FILL FOR BANK
PROTECTION, ITEM 522
Lt. Bank 787+60-802+35±
Rt. Bank 787+00-807+75±

THREE CABLE GUARD RAIL
W/STEEL POSTS ITEM 543
187+35-800+00±
187+50-794+00±
794+50-800+00±
187+00-800+00±

CONSTRUCT DRIVES
797+50 Rt. for as directed by Engineer
790+50 Lt.-792+00 Lt.

PARCEL	7	STA	
GRANTOR	RYEGATE TOWN SCHOOL DISTRICT		
TAKING	NONE	REM.	
RIGHTS	WATER PIPE LINE CROSSING 788+90		
TITLE TAKEN	W.D.	12/11/63	
RECORDED	RYEGATE	BK 27 PG 11	DT 1/9/64

PARCEL	10	STA	797+55-801+98
GRANTOR	OLLA ANDREOLETTI		
TAKING	1.0 AS	REM.	1.0 AS
TITLE TAKEN	P.V.D.	3/20/64	
RECORDED	RYEGATE	BK 27 PG 10	DT 4/24/63

PARCEL	11A B	STA	797+84-801+86
GRANTOR	CHARLES E. GIBSON		
TAKING	2.1 AS	REM.	9.7 AS
TITLE TAKEN	W.D.	12/23/63	
RECORDED	RYEGATE	BK 26 PG 466	DT 1/12/63

Bituminous Concrete Sidewalk
799+50 Rt. - 800+50 Rt.

MOVING BUILDINGS & RECONSTRUCTING
FOUNDATIONS & APPURTENANCES, ITEM 535
1. Community Building @ Sta 797+65 Lt.
2. Band Stand @ Sta 797+05 Lt.

PARCEL	17	STA	
GRANTOR	LARSTIDE & GANDIN & ROSE L. GANDIN		
TAKING	NONE	REM.	
RIGHTS	GUY WIRE, 788+50 Lt.		
TITLE TAKEN	AGREEMENT	9/30/63	
RECORDED	RYEGATE	BK 26 PG 452-453	DT 1/14/63


PARCEL	11A	STA	
GRANTOR			
TAKING	788+33-800+30		
TITLE TAKEN	2.0 AS		

PARCEL	11B	STA	
GRANTOR			
TAKING	797+84-801+86		
TITLE TAKEN	2.0 AS		


CURVE NO. 2 DATA


Δ 54° 14' 30" Lt.
D 6° 30'
Q 831.5'
T 451.5'
L 834.5'
E 108.9'
2FL 68.5'
Bnk 1' Ft.

PLAN
SECTION
ELEVATION
WATER
PIPE
LINE
CROSSING
788+90

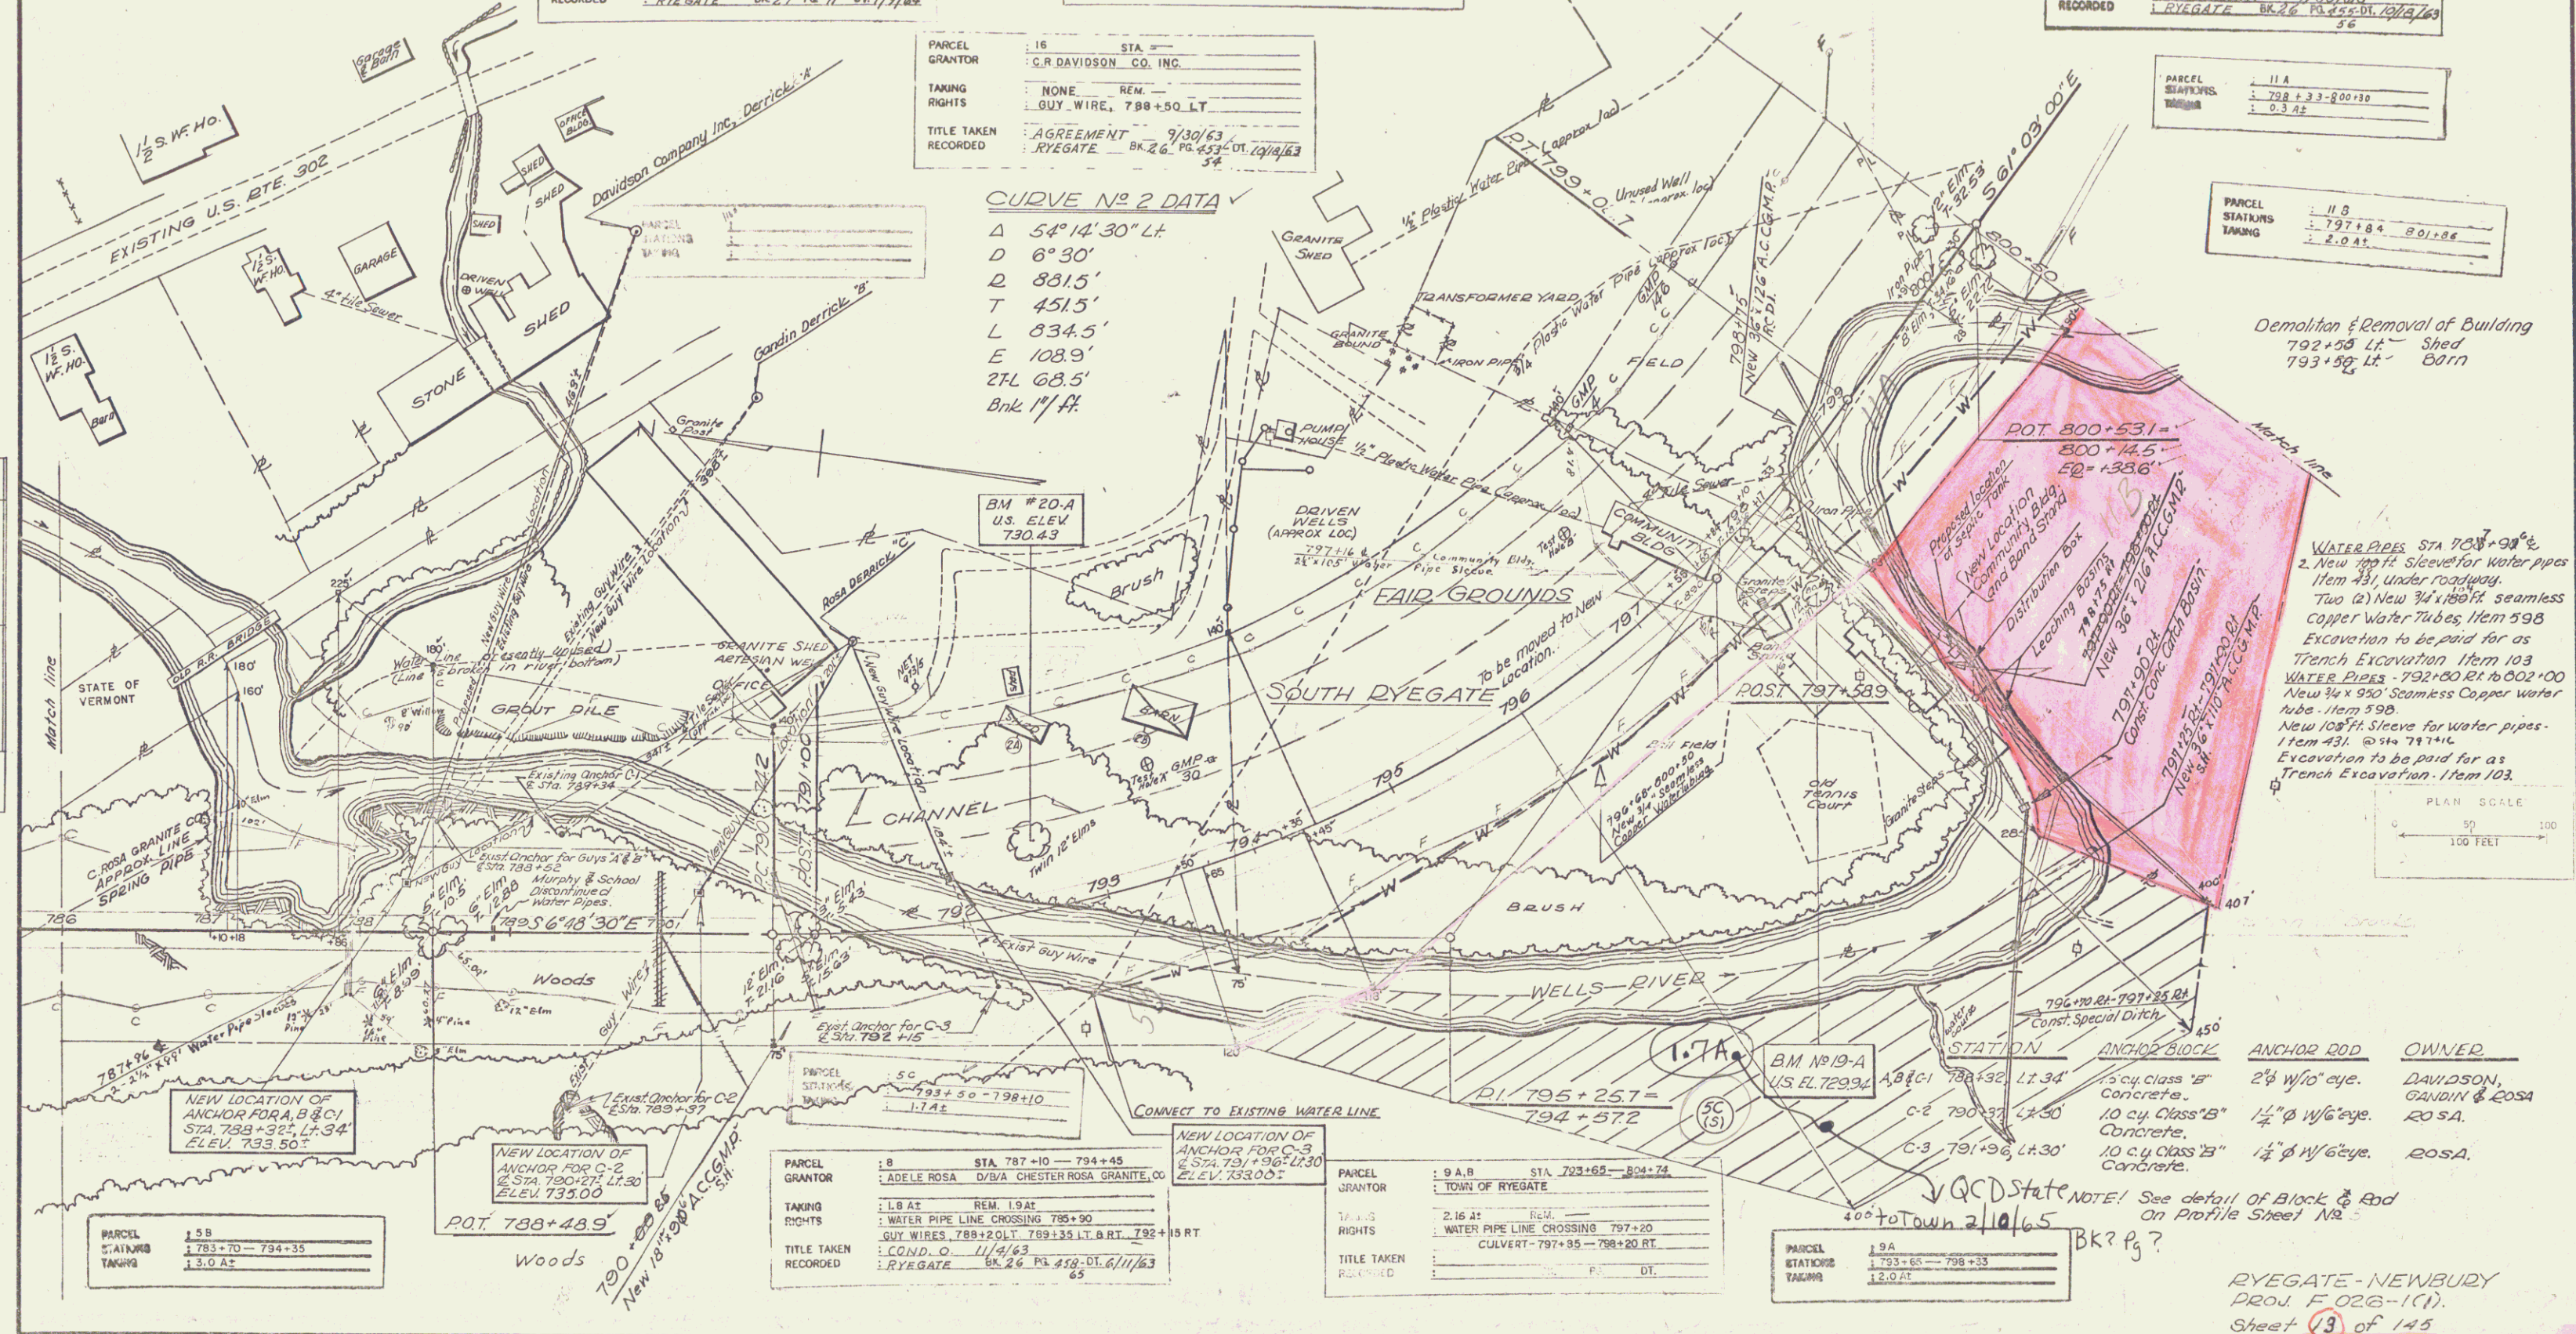

ACQUIRED FROM CHARLES E. & ELIZABETH GIBSON AS
PARCEL 11B BY W.D. RECORDED 11/9/63 IN BK. 26 PG. 466

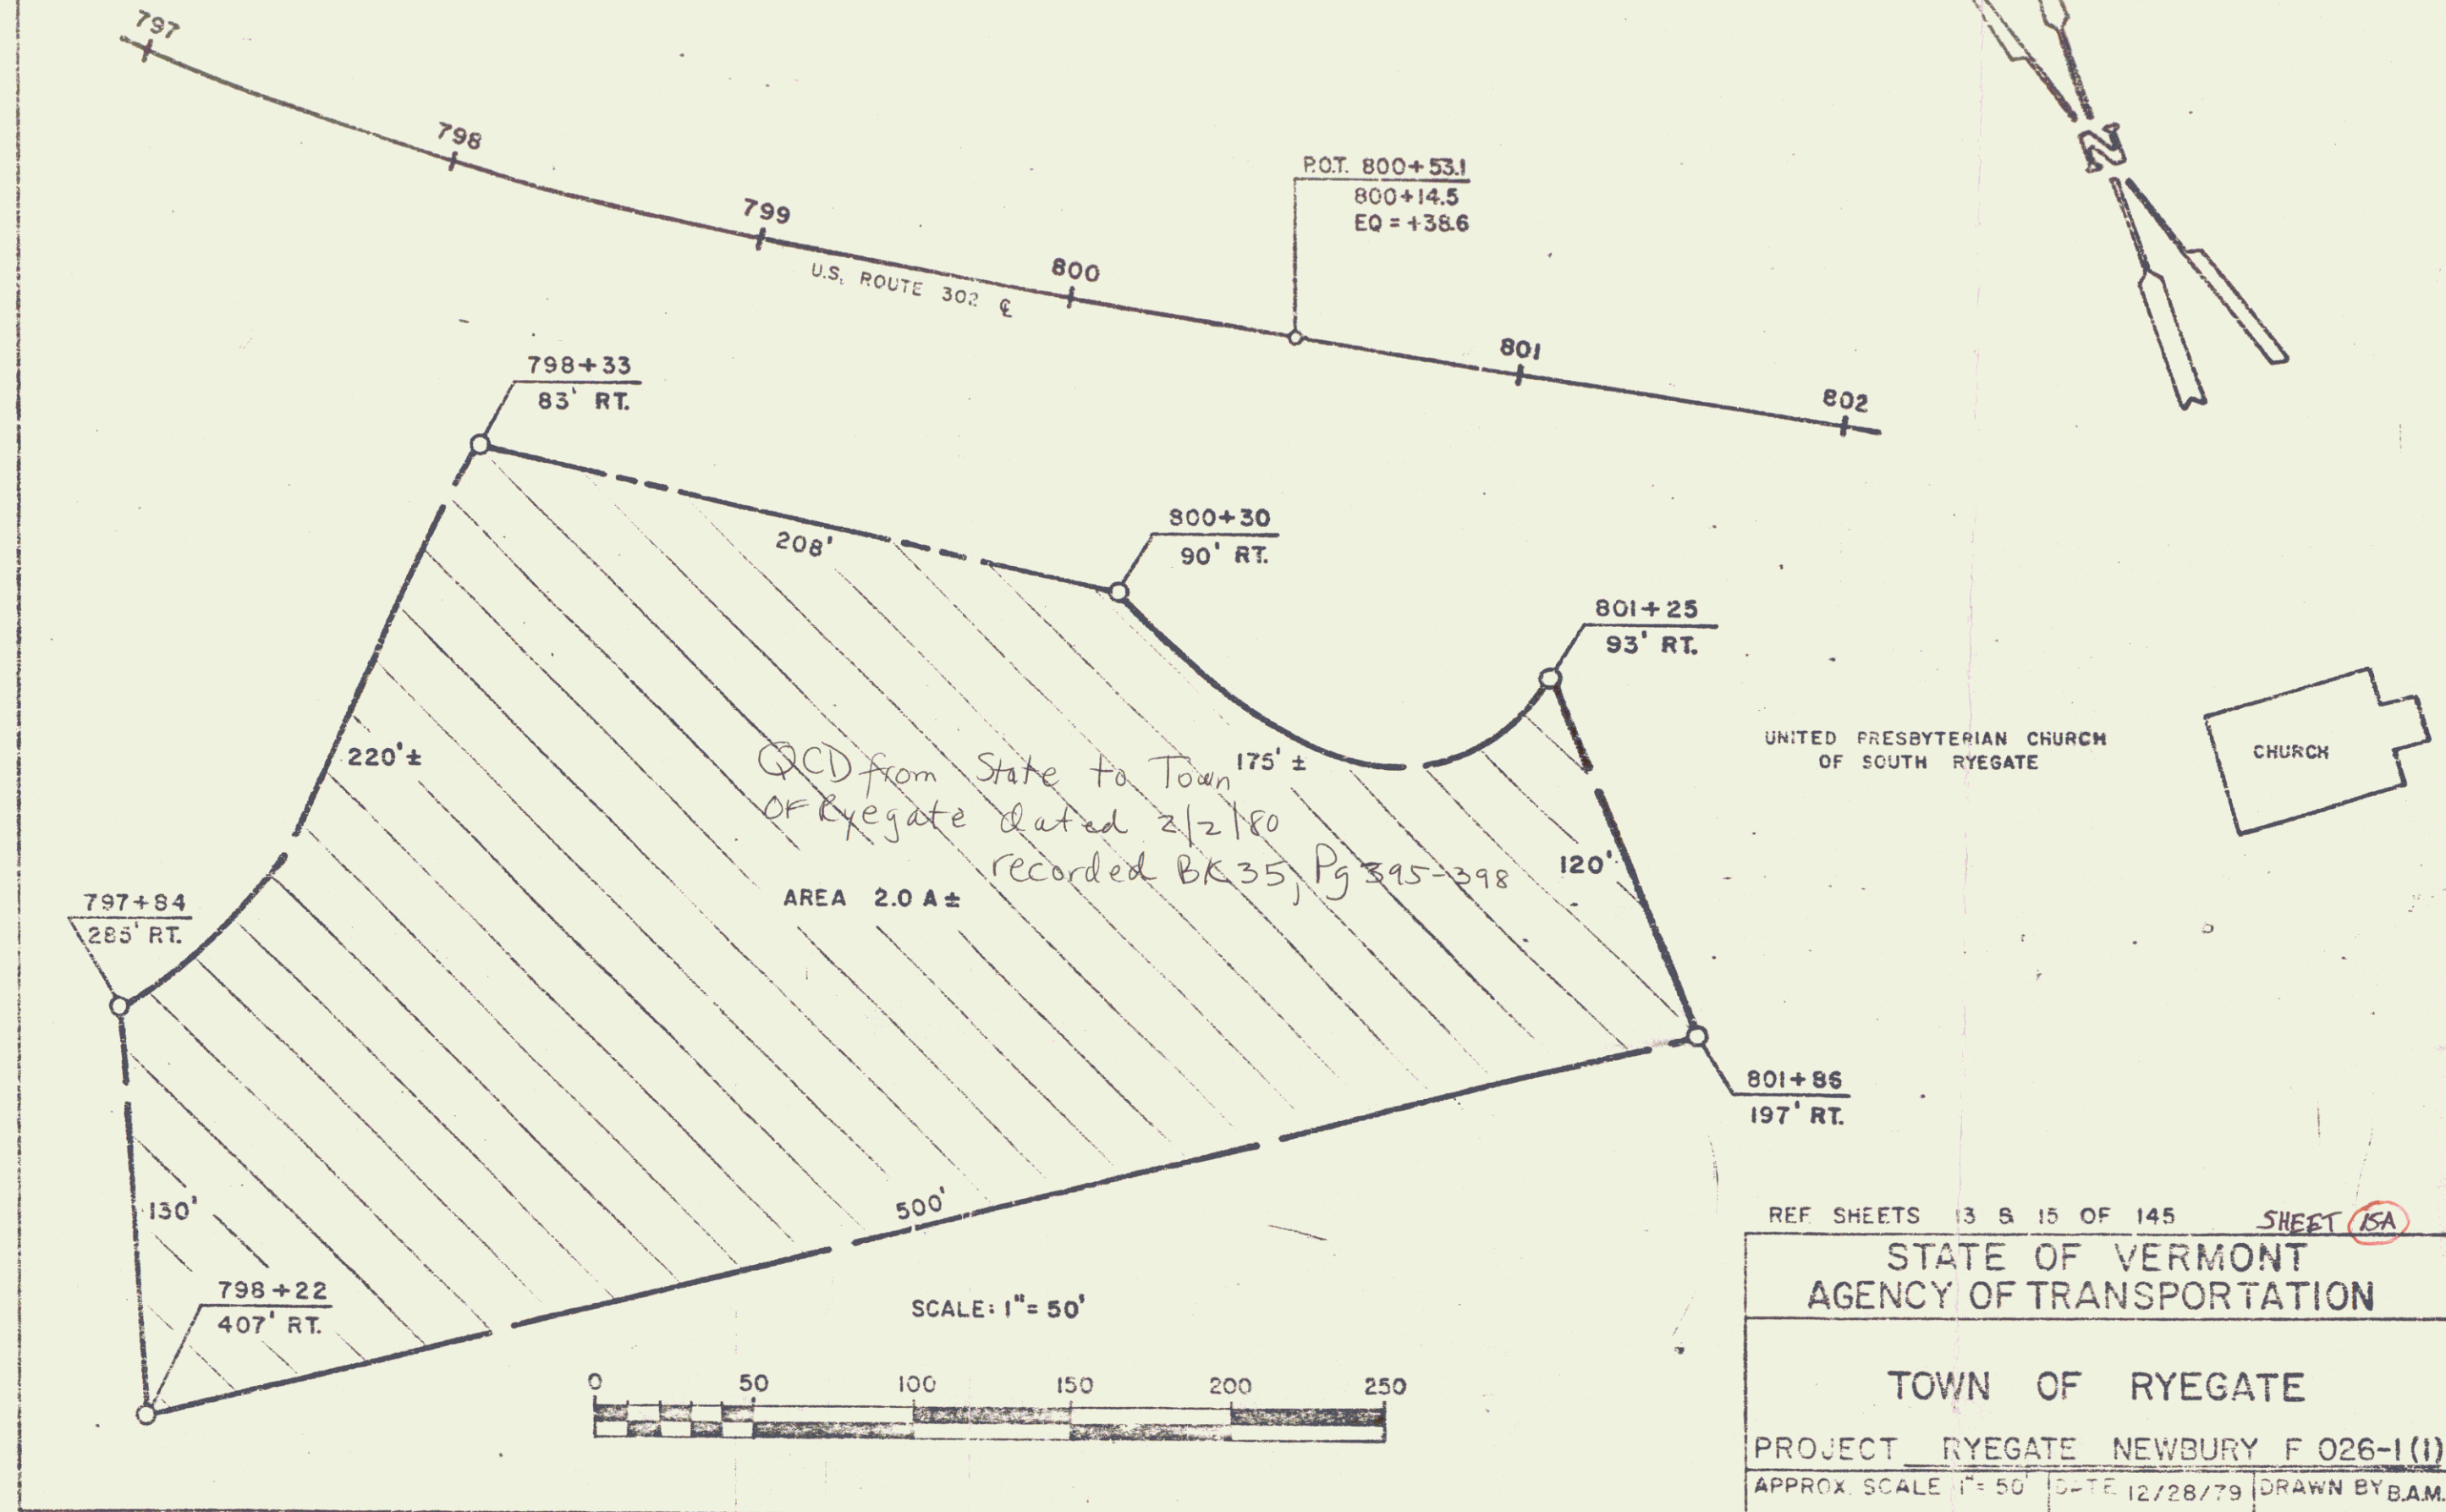

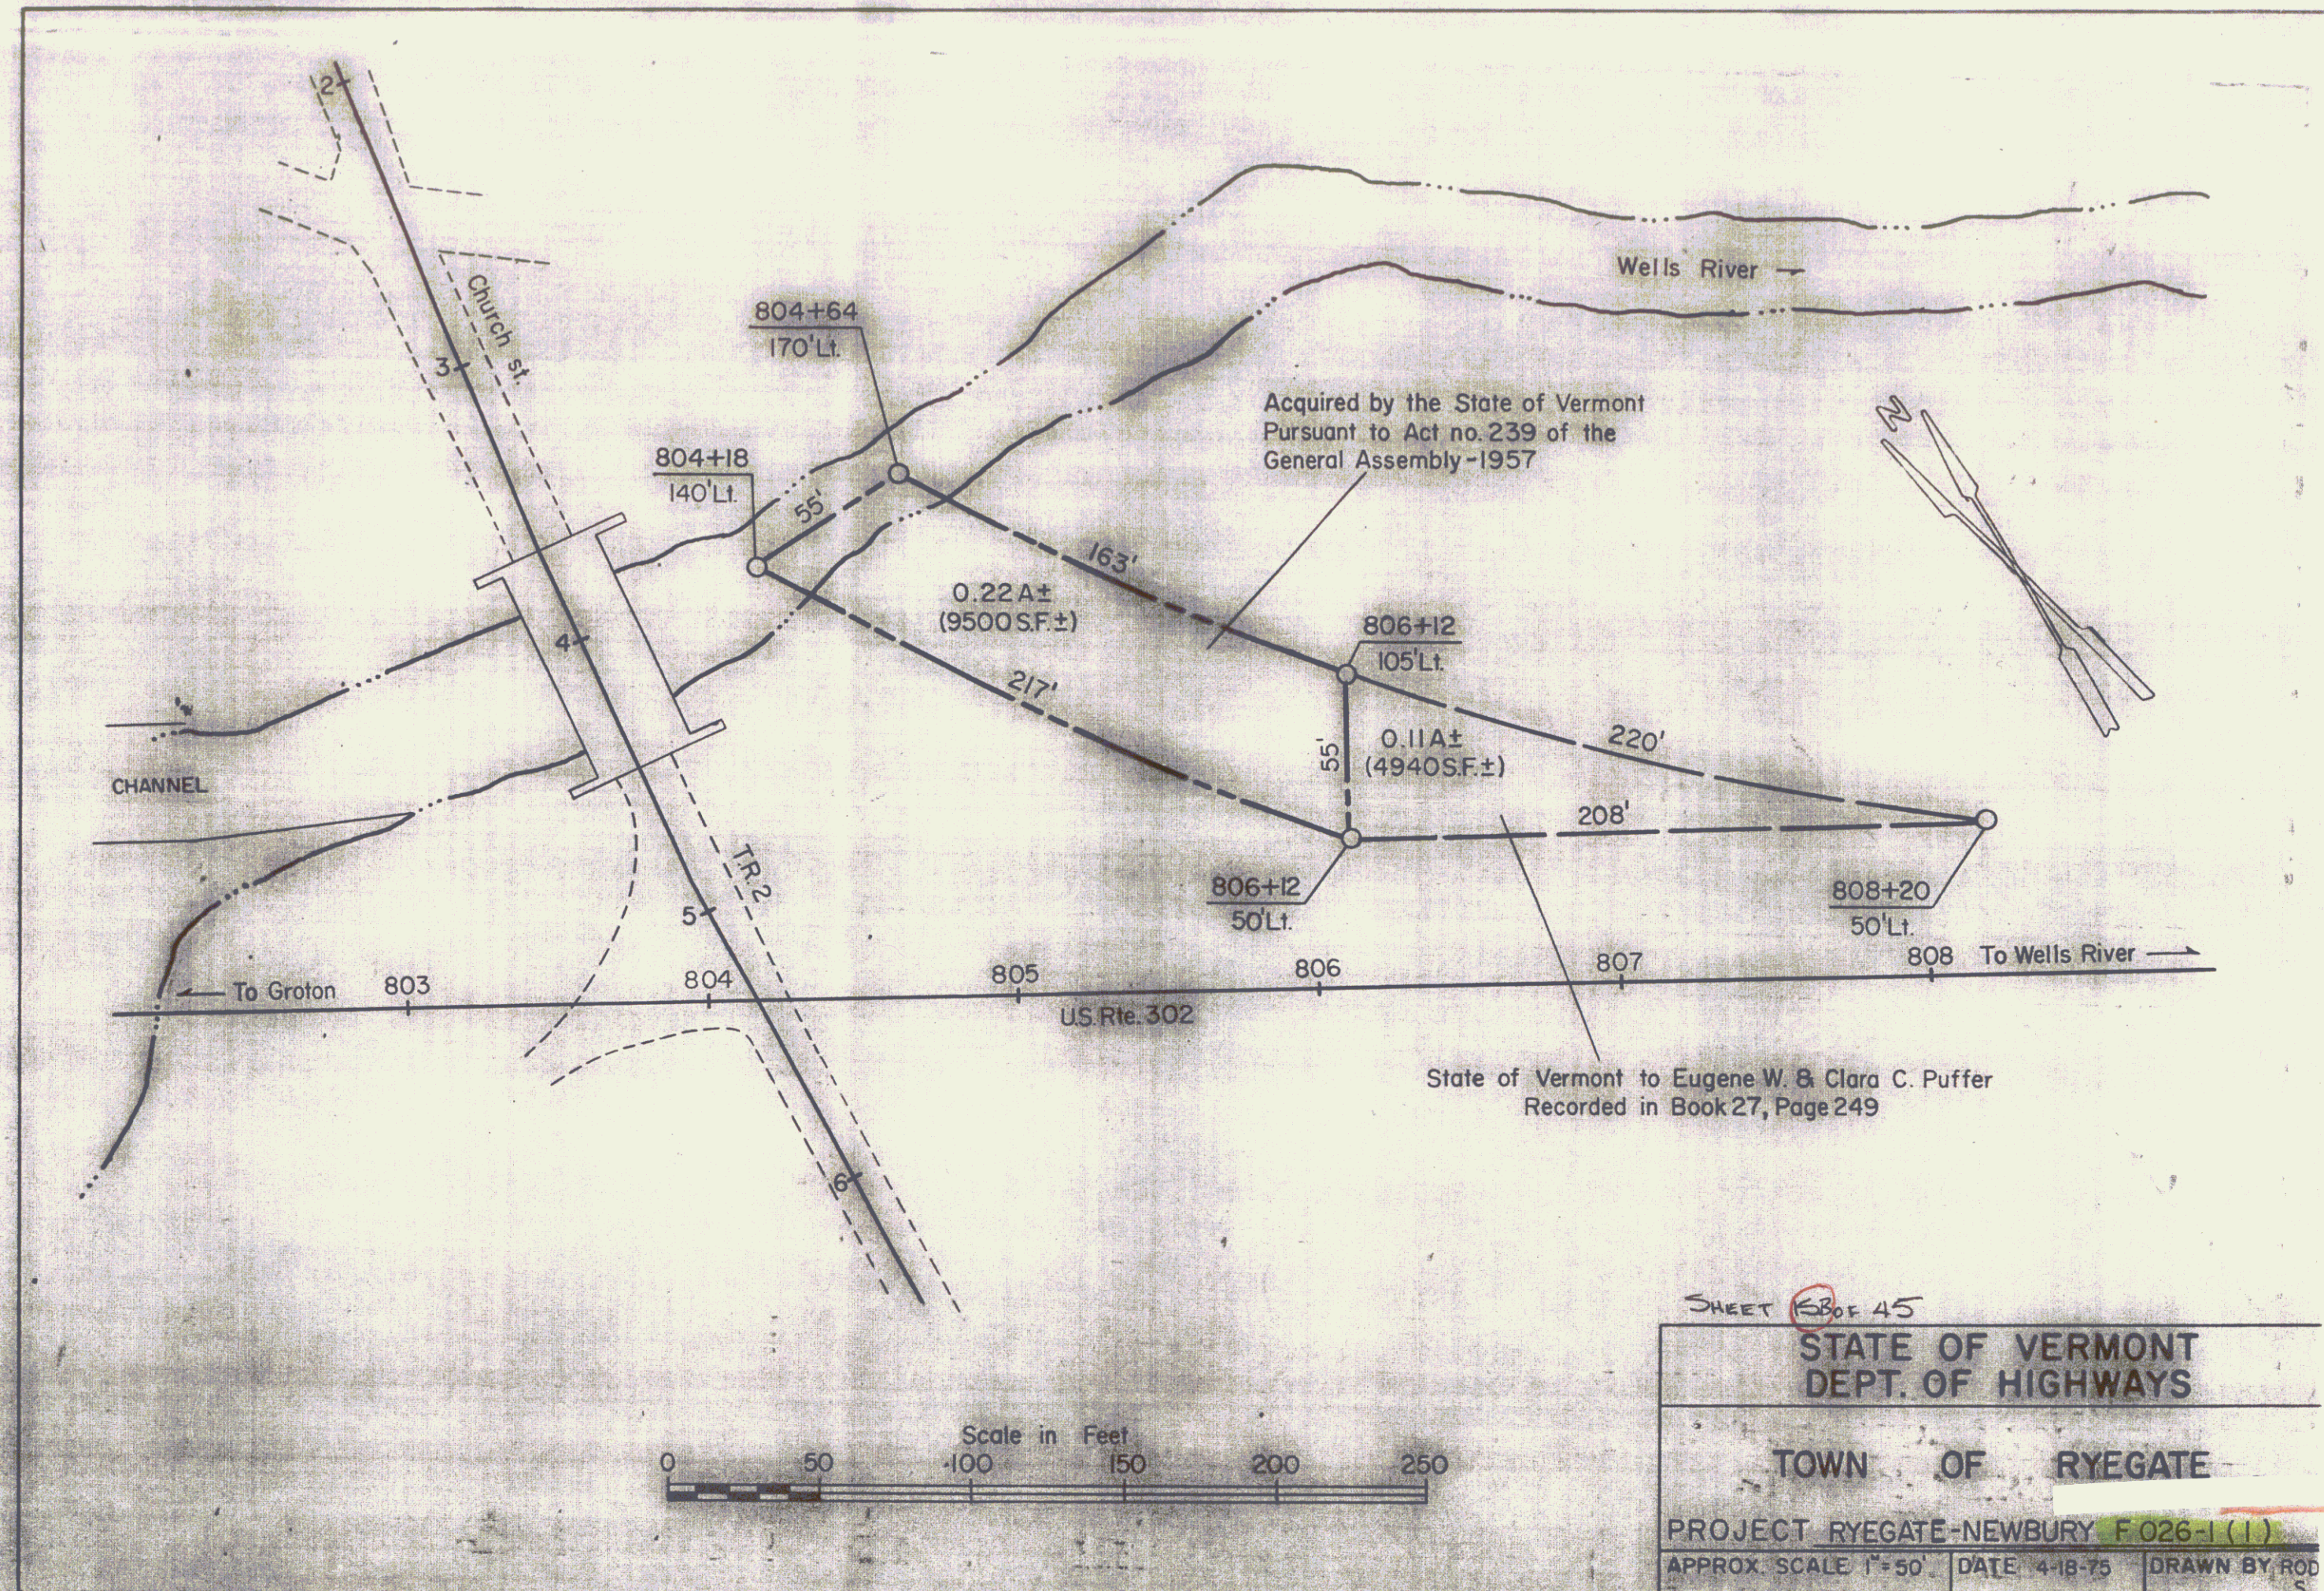


SHEET 158 OF 45


STATE OF VERMONT DEPT. OF HIGHWAYS		
TOWN OF RYEGATE		
PROJECT RYEGATE-NEWBURY F 026-1 (1)		
APPROX. SCALE 1"=50'	DATE 4-18-75	DRAWN BY ROD S.

7

BEING PART OF THE SAME LAND AND PREMISES ACQUIRED BY THE STATE OF VERMONT FROM THE LEOLA M. CRAIGIE ESTATE, WENDELL C. CRAIGIE, ADMINISTRATOR; AND WENDELL C. CRAIGIE; BY CONDEMNATION ORDER DATED DEC. 5, 1961, AND RECORDED IN BOOK 26, PAGES 274 - 283, OF THE TOWN OF RYEGATE LAND RECORDS.

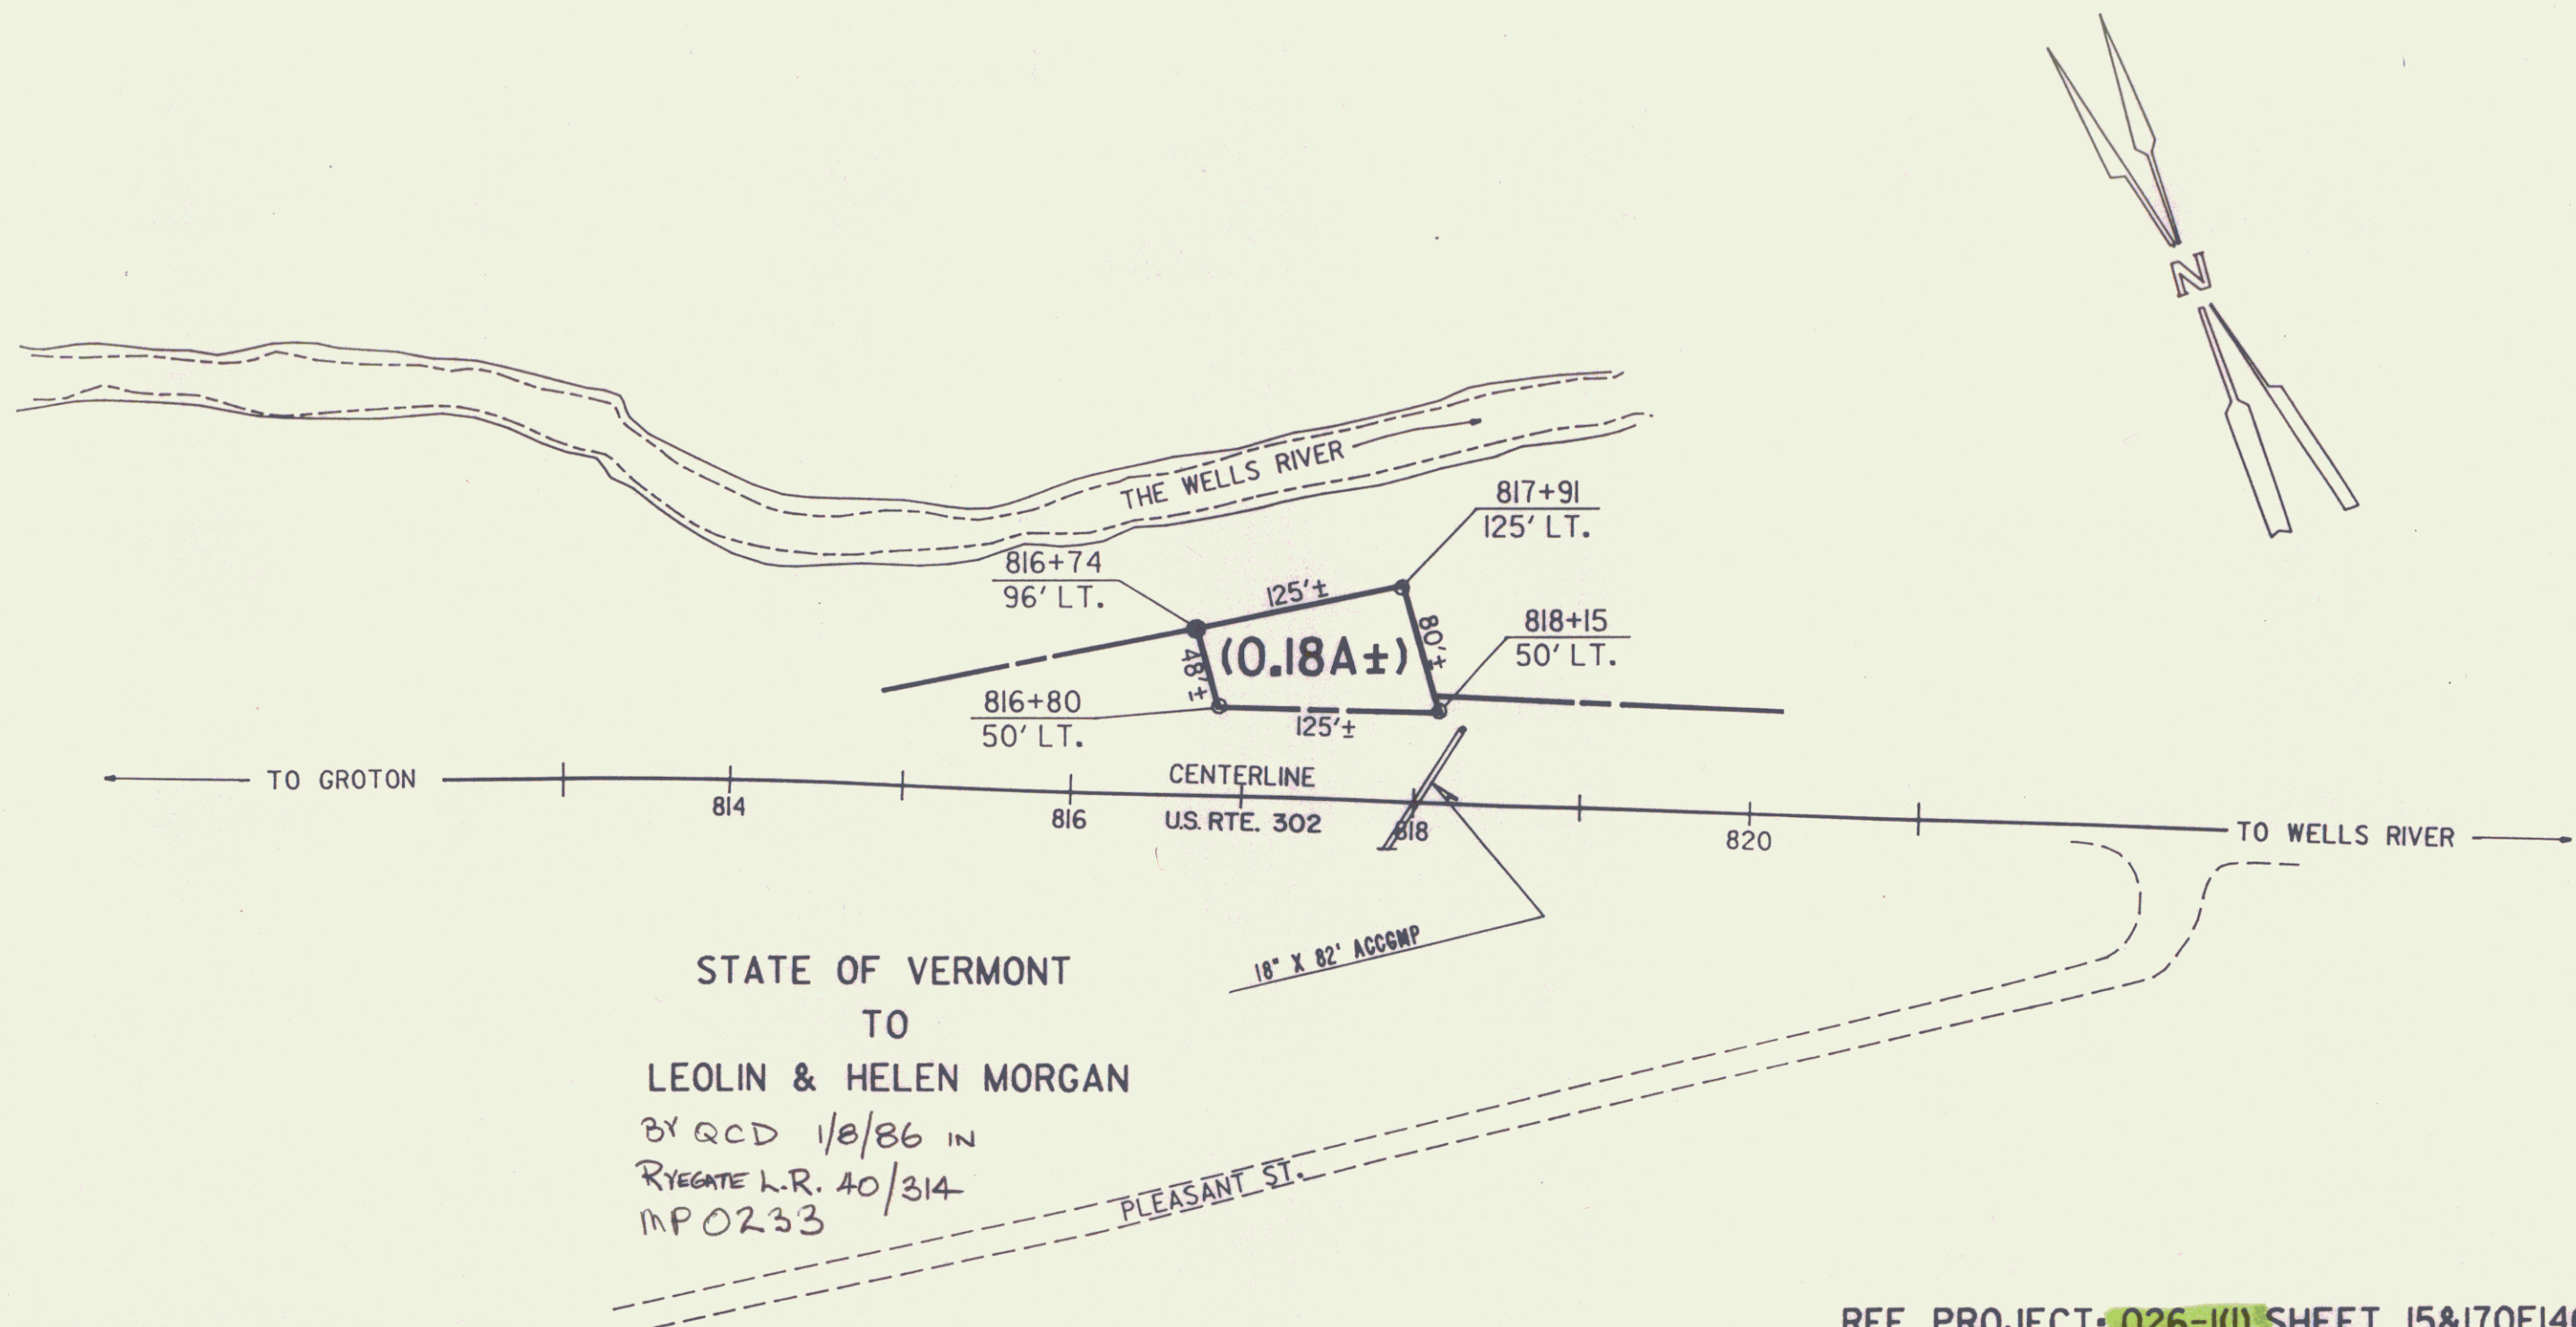

STATE OF VERMONT
TO
LEOLIN & HELEN MORGAN
BY QCD 1/8/86 IN
RYEGATE L.R. 40/314
MP 0233

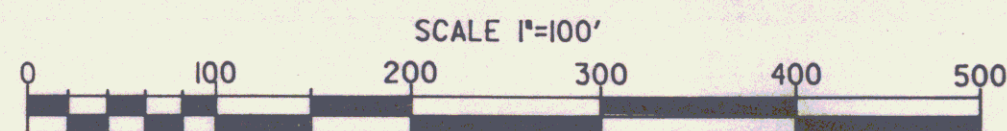

REF. PROJECT: 026-1(1) SHEET 15&170FI46


STATE OF VERMONT
AGENCY OF TRANSPORTATION


TOWN OF RYEGATE

17A OF 145

APPROX. SCALE 1"=100' DATE 12-17-85 DRAWN BY D.E.M.

98

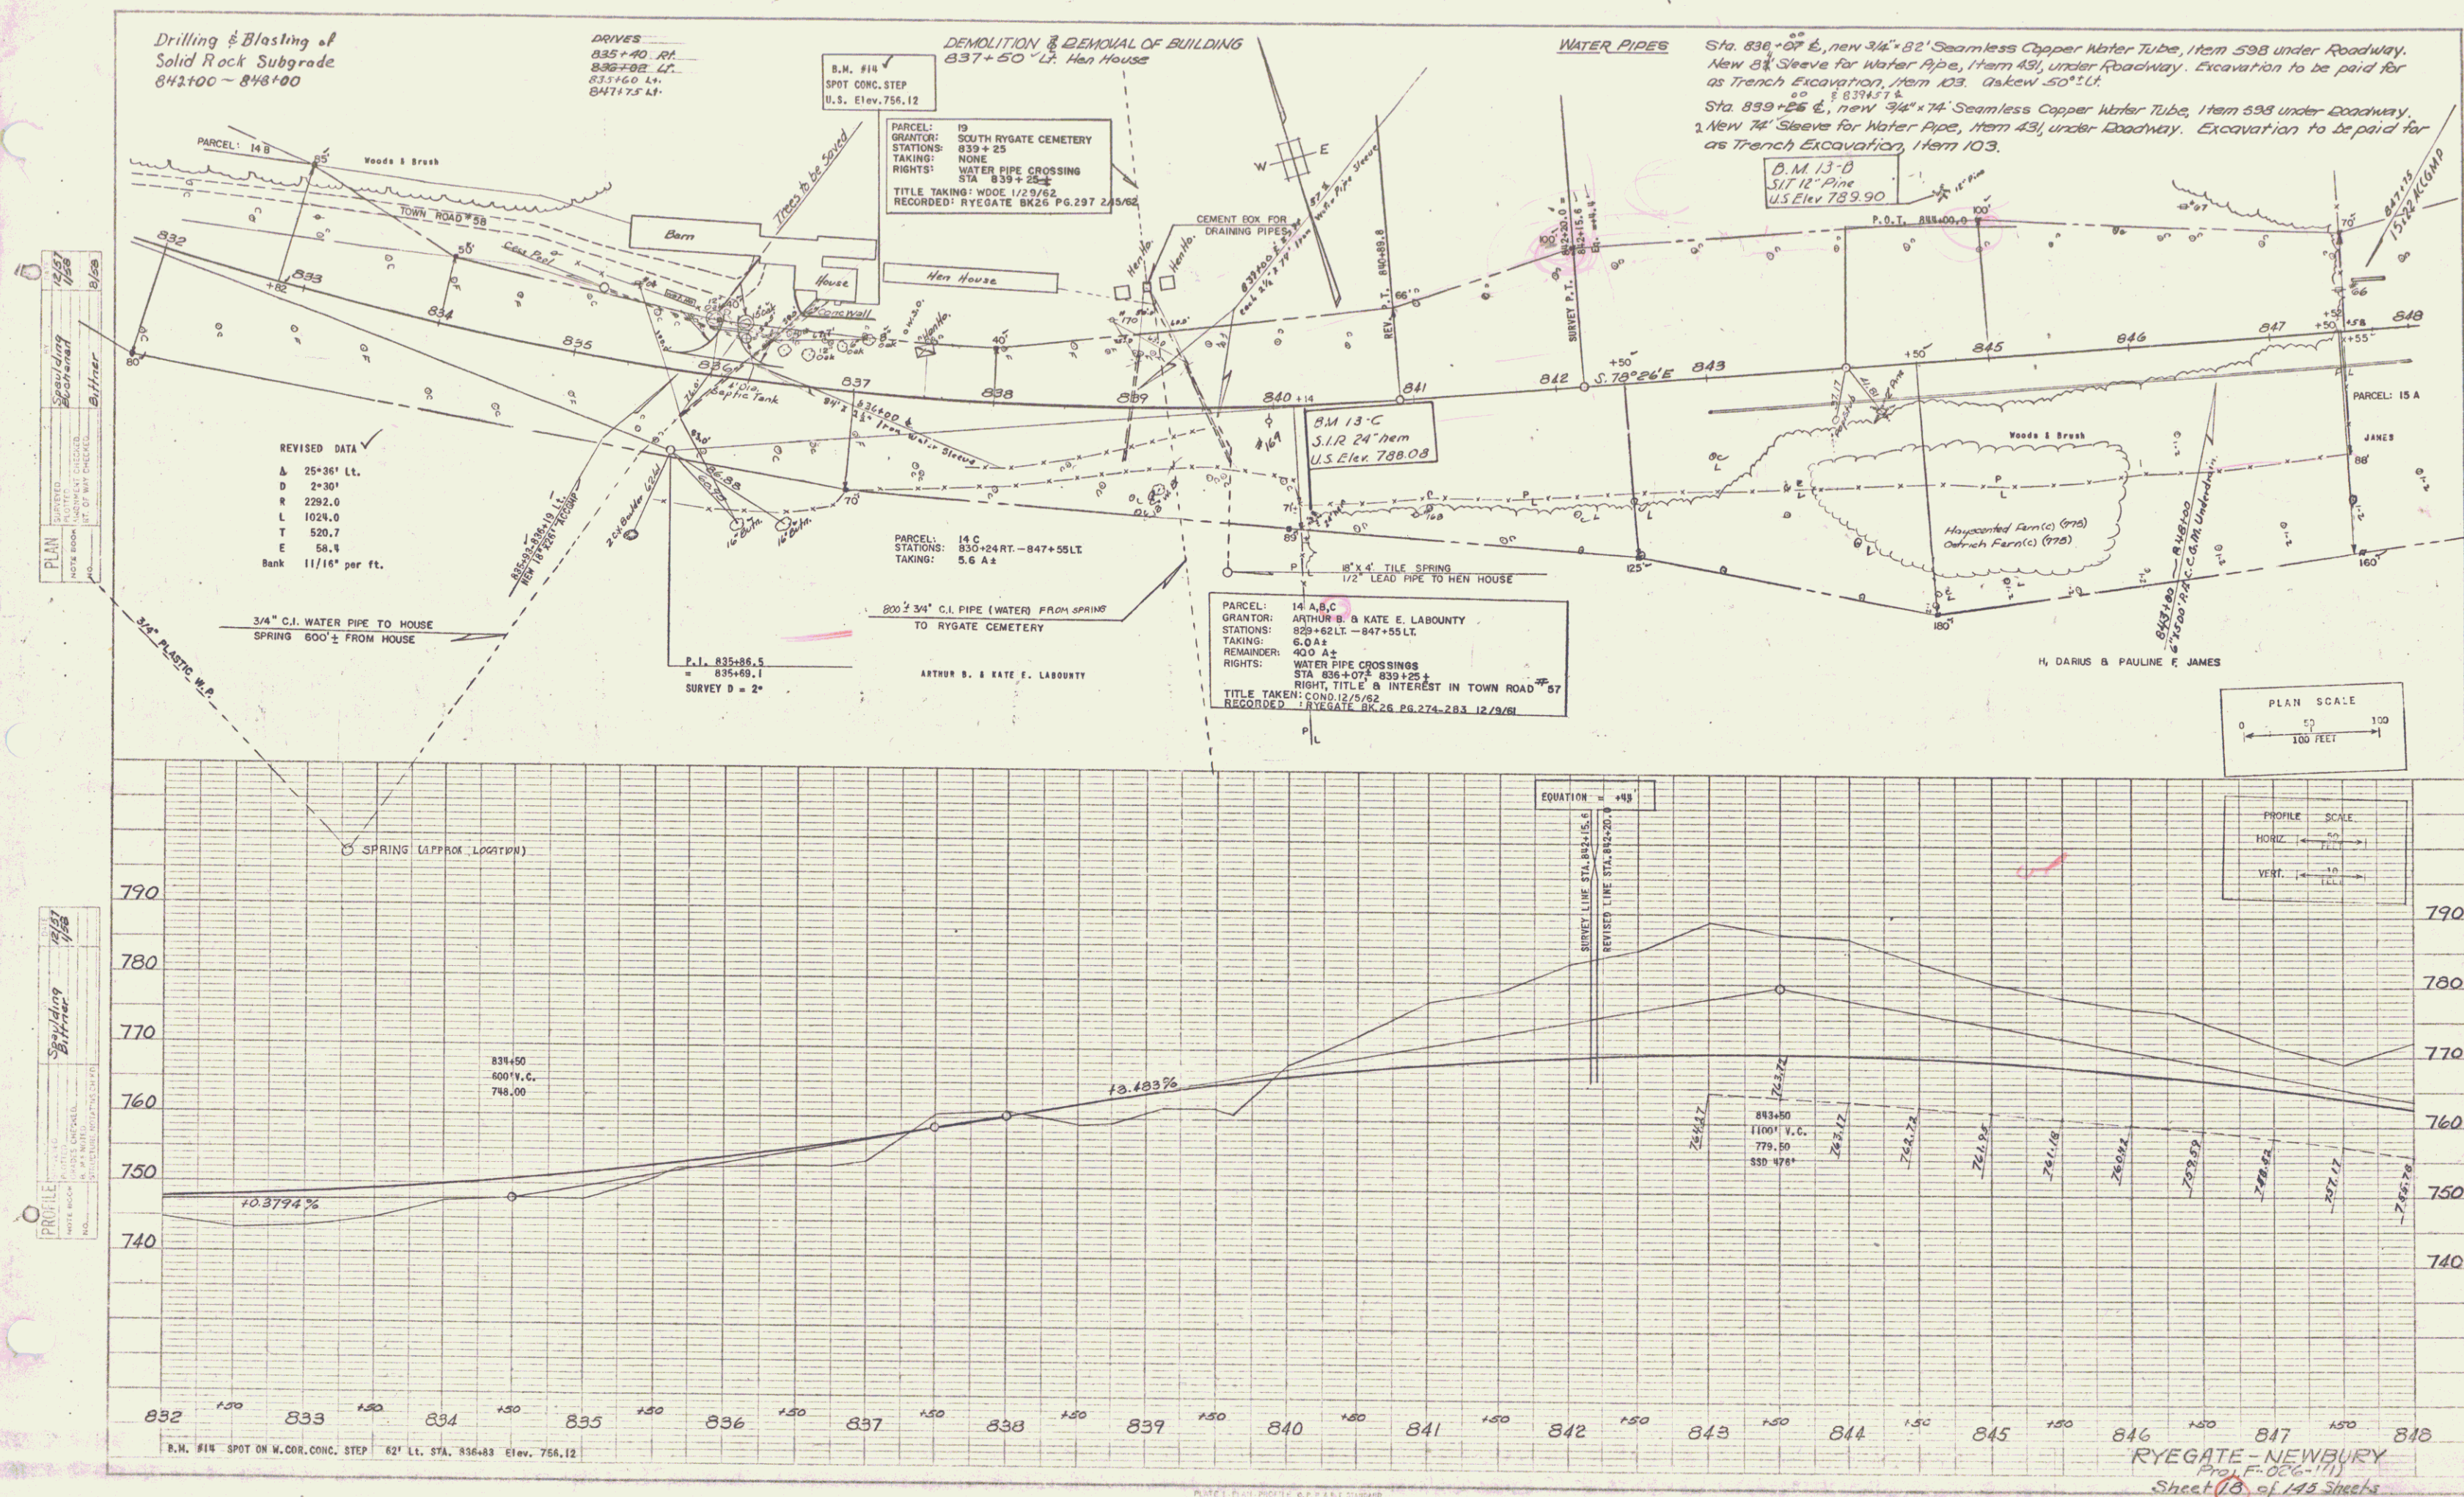

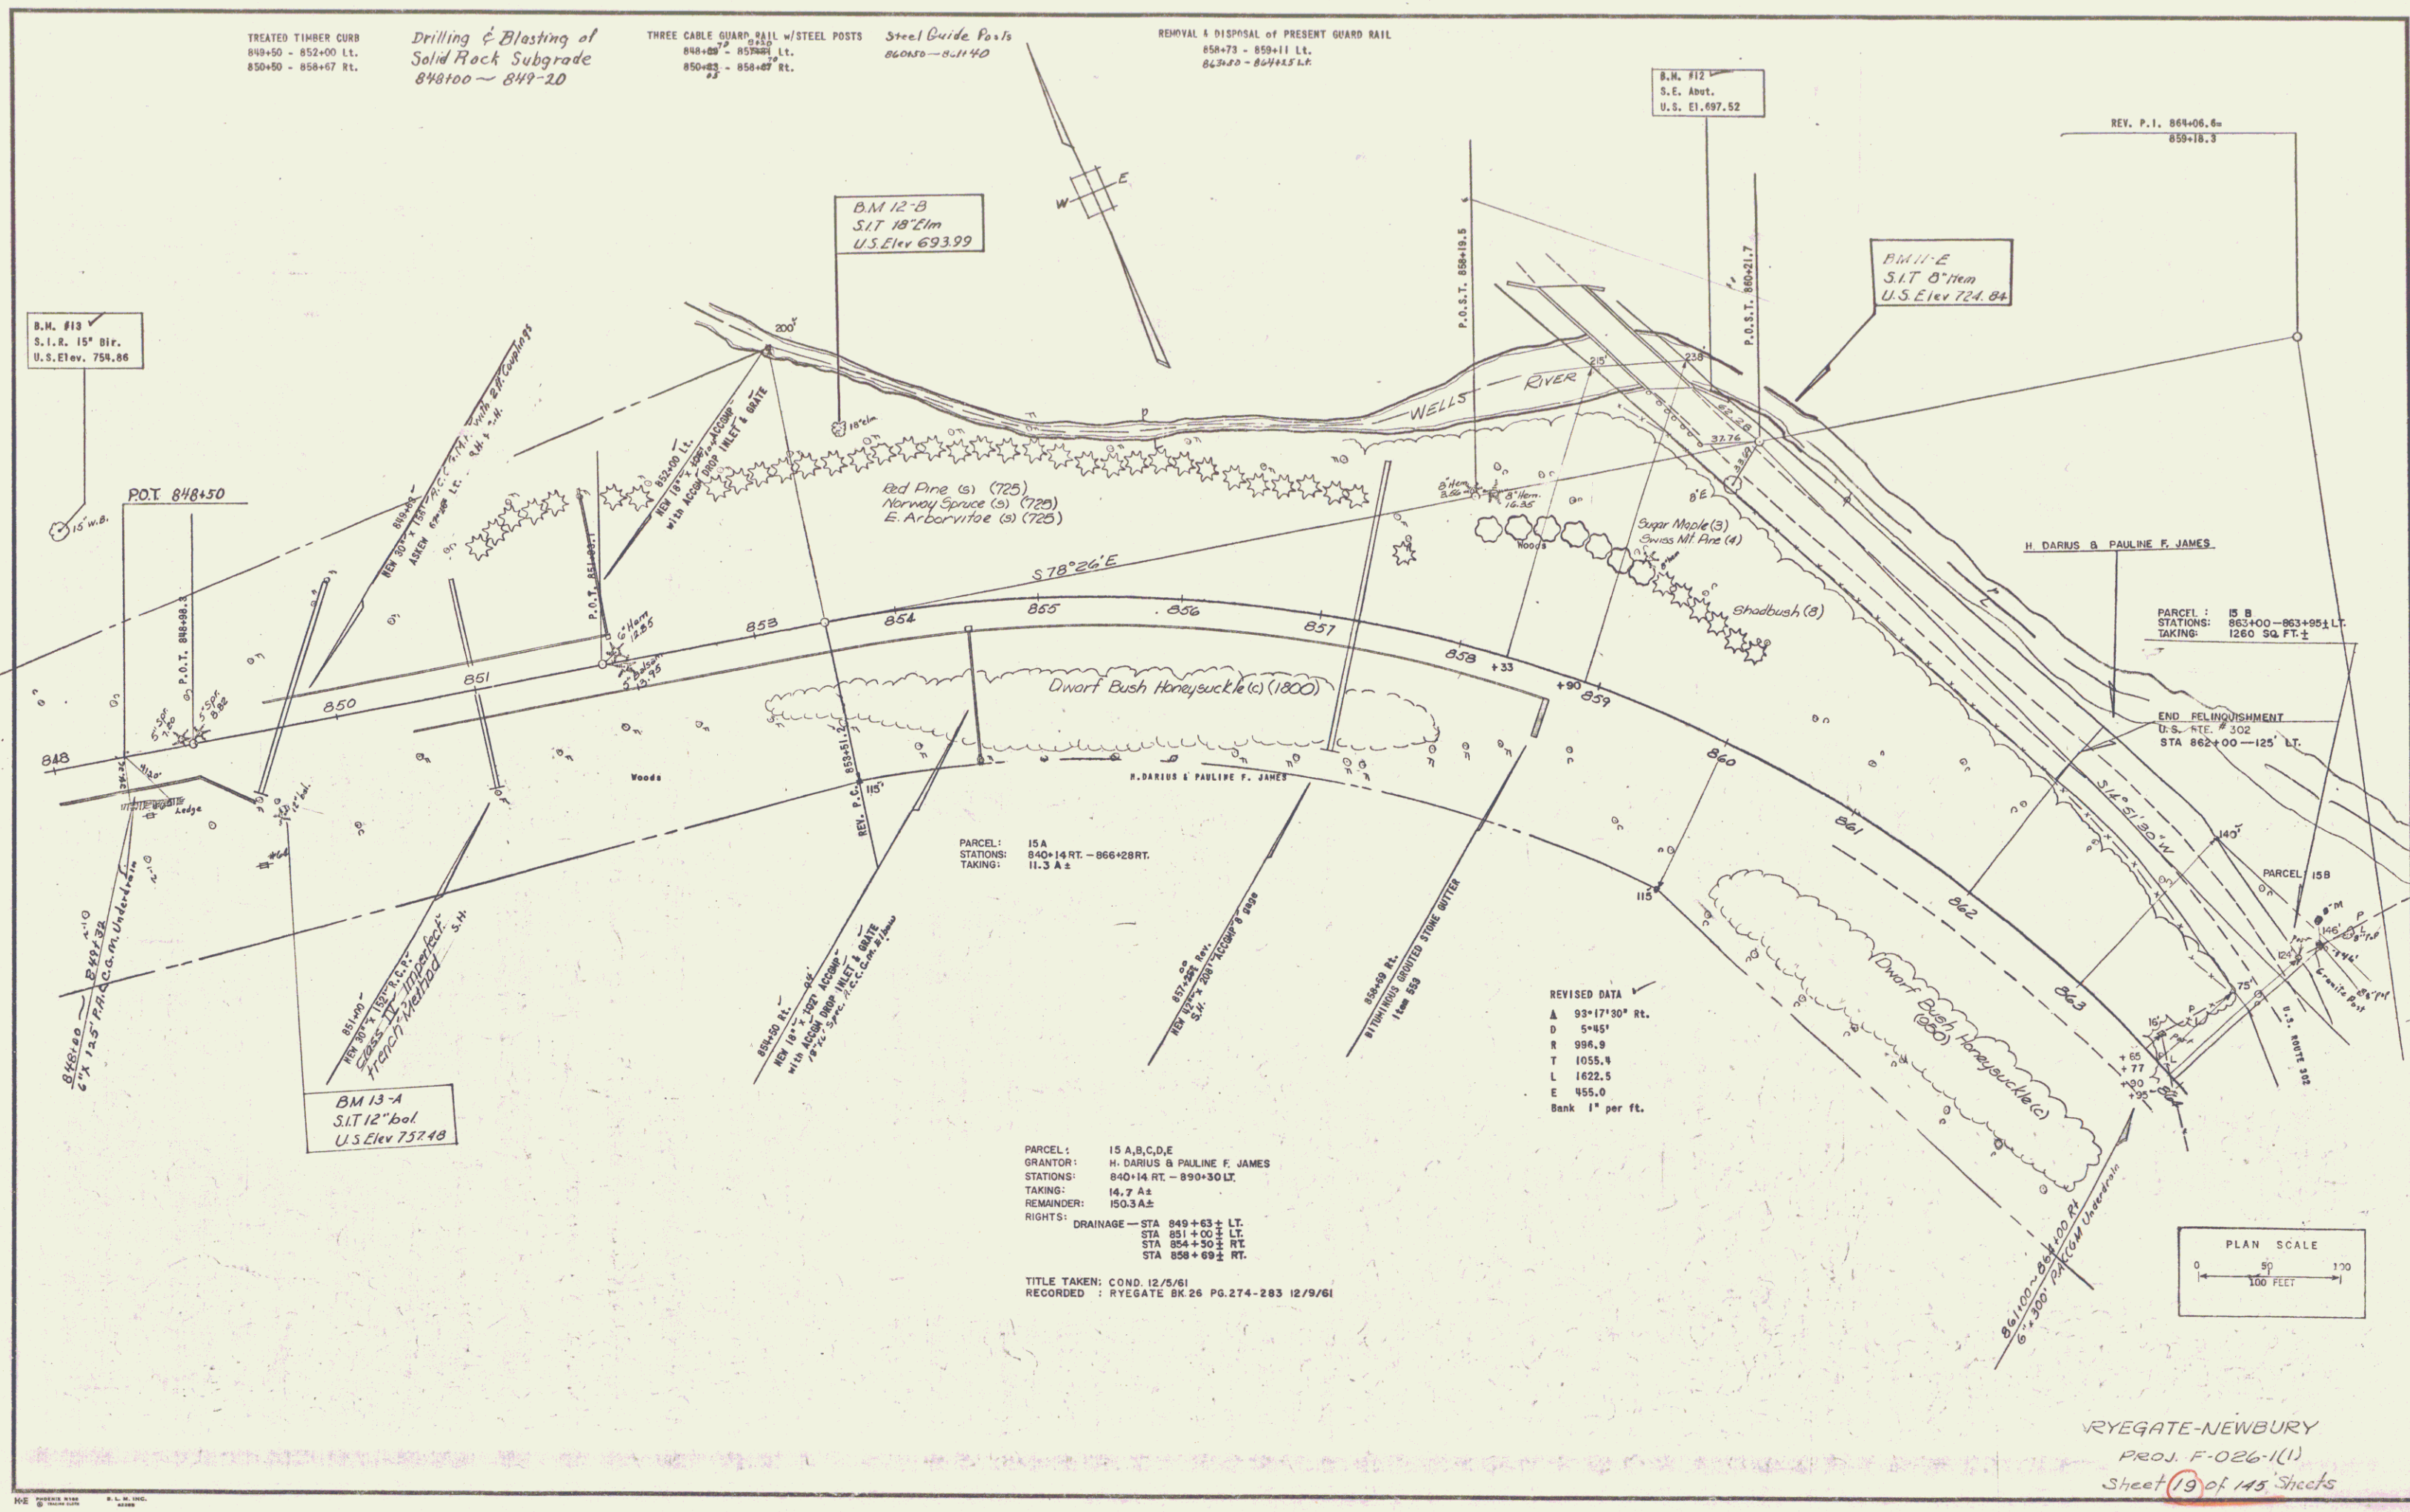

TREATED TIMBER CURB
849+50 - 852+00 LT.
850+50 - 858+67 RT.

Drilling & Blasting of
Solid Rock Subgrade
848+00 ~ 849+20

THREE CABLE GUARD-RAIL w/STEEL POSTS
848+00 ~ 852+00 LT.
850+00 ~ 858+67 RT.

Steel Guide Posts
860+00 ~ 861+40

REMOVAL & DISPOSAL OF PRESENT GUARD RAIL
858+73 - 859+11 LT.
863+20 - 864+15 LT.

B.M. 12-B
S.I.T. 18' Elm
U.S. Elev 693.99

B.M. 13-A
S.I.T. 12' boll
U.S. Elev 757.48

B.M. 11-E
S.I.T. 8' item
U.S. Elev 724.84

REV. P.I. 864+06.6m
859+18.3

Parcel 15A
STATIONS: 840+14 RT. - 866+28 RT.
TAKING: 11.3 A±

Parcel 15B
STATIONS: 863+00 - 863+85± LT.
TAKING: 1260 SQ. FT.±

END DELINEATION
U.S. RTE. # 302
STA 862+00 - 125' LT.

REVISED DATA
A 93°17'30" Rt.
D 5°45'
R 998.9
T 1055.4
L 1622.5
E 955.0
Bank 1' per ft.

TITLE TAKEN: COND. 12/5/61
RECORDED: RYEGATE BK 26 PG. 274-283 12/9/61

RYEGATE-NEWBURY
PROJ. F-026-1(1)
Sheet 19 of 145 Sheets

PLAN
 DRAWN BY: J. B. B. B.
 CHECKED BY: J. B. B. B.
 DATE: 12/1/61

PROFILE
 DRAWN BY: J. B. B. B.
 CHECKED BY: J. B. B. B.
 DATE: 12/1/61

