

Neobornia

STEARNS R. JENKINS

SHEET NO. 1, TITLE PAGE.
" " 2, TYPICAL CROSS-SECTION OF IMPROVEMENT
" " 2, QUANTITIES.

1 1/2" Bituminous Concrete
Pavement, Hem 36LB (Mod)

PROJECT NAME & NUMBER		T Y P E	S U R F A C E
NEWBURY DF 026-1(3)		1 1/2" BITUMINOUS CONCRETE PAVEMENT	28,363 sy.
RECORD PLANS			
MATERIALS			
ASPHALT - SOCONY-E. PROVIDENCE, R. I.		TAR - OLD COLONY TAR CO.	
BITUMINOUS CONCRETE		WORCESTER, MASS.	
WELLS-LANSON QUARRY CO. BARRE, VT.		GRAVEL - RIVER	
CONTRACTOR - COOLEY CONST. CO. INC.		CONTRACT DATED - SEPT. 3, 1958.	
RES. ENG. - J. A. MCCREA		CONTRACT STARTED - SEPT. 23, 1958.	
INSPECTOR - C. HELFRICH		CONTRACT COMPLETED OCT. 14, 1958.	
RECORD PLANS - E. GLYSSON		CONTRACT ACCEPTED OCT. 14, 1958.	



STATE OF VERMONT DEPARTMENT OF HIGHWAYS

Proposed Improvement

FEDERAL AID PROJECT

TOWN OF NEWBURY
COUNTY OF ORANGE
U.S. ROUTE 302
WELLS RIVER - SO. RYEGATE ROAD

BEGINNING AT A POINT 13,951 FEET WEST OF THE INTERSECTION
OF ROUTES U.S. 302 AND U.S. 5 IN THE VILLAGE OF WELLS RIVER
AND EXTENDING EASTERLY 13,934.1 FEET (EXCLUDING
STA. 143+00.0 TO STA. 175+00.0 = 3,297.5 FEET)
TOTAL LENGTH OF PROJECT 10,636.3 FEET = 2.014 MILES.

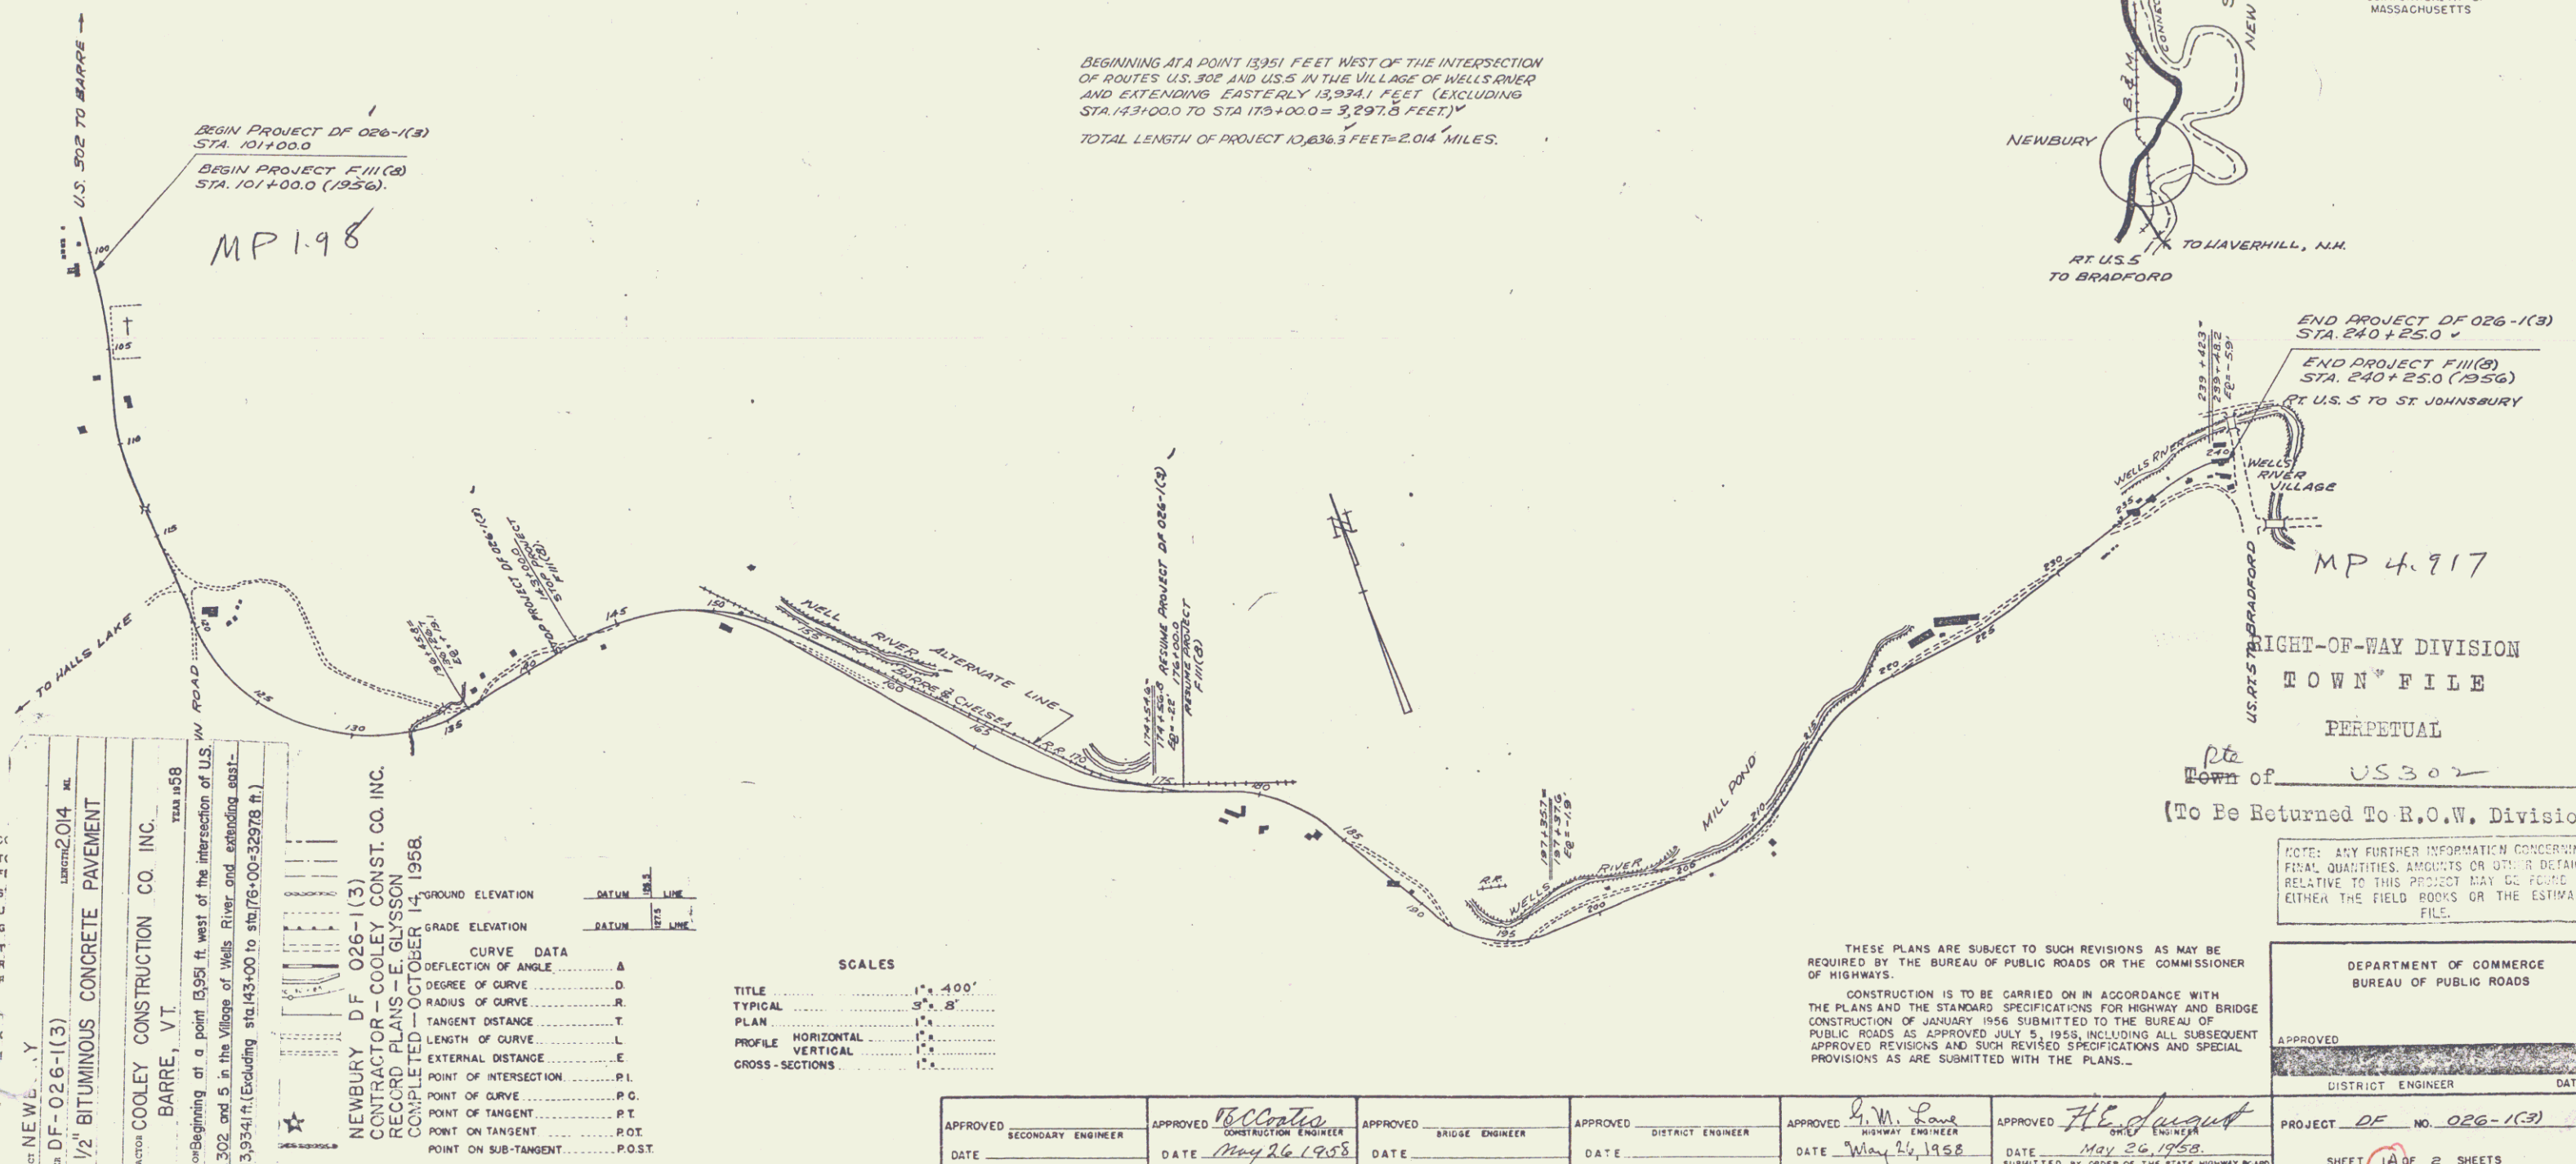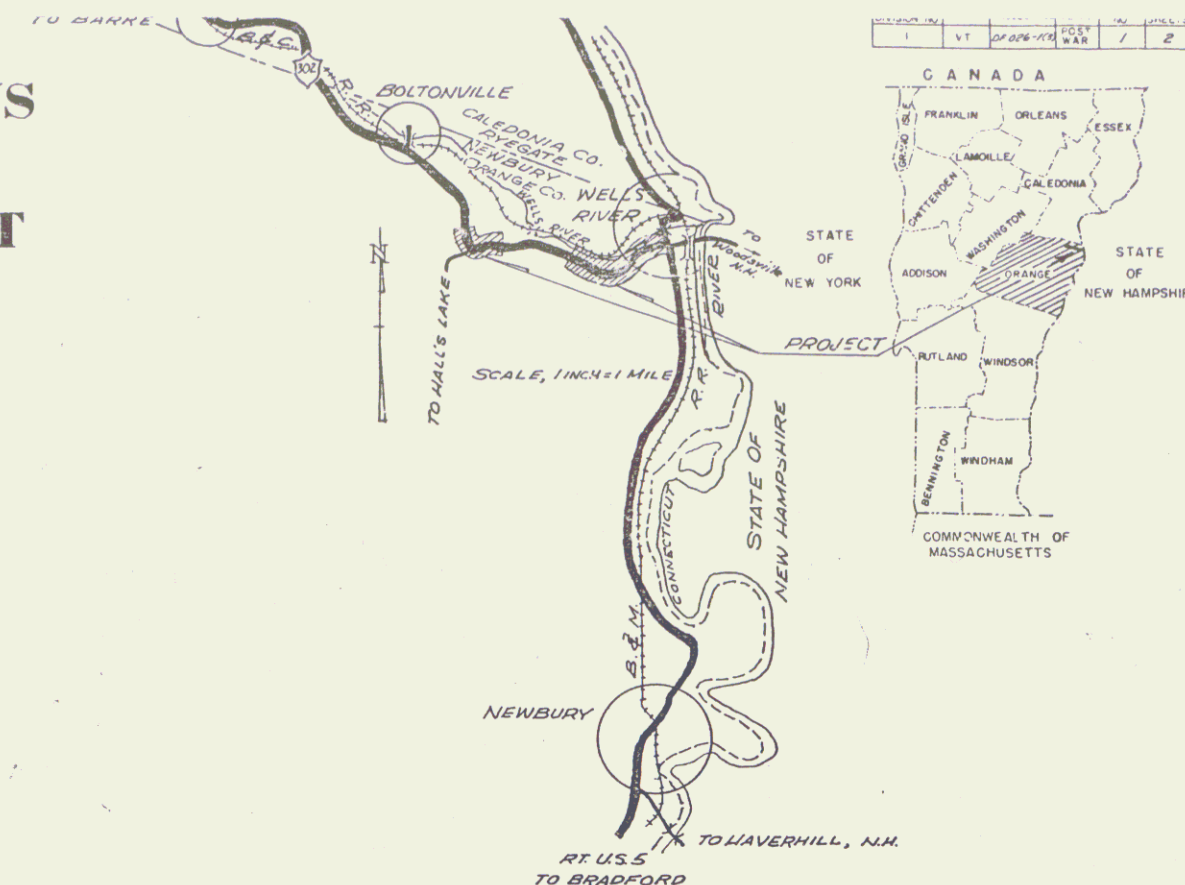

PROJECT NEWBURY
DF-026-1(3)
1/2" BITUMINOUS CONCRETE PAVEMENT
CONTRACTOR COOLEY CONSTRUCTION CO. INC.
BARRE, VT.
LOCATION Beginning at a point 13,951 ft. west of the intersection of U.S.
Routes 302 and 5 in the Village of Wells River and extending east-
erly 13,934.1 ft. (excluding sta. 143+00.0 to sta. 175+00.0 = 3,297.5 ft.)

NEWBURY DF 026-1(3)
CONTRACTOR - COOLEY CONST. CO. INC.
RECORD PLANS - E. GLYSSON
COMPLETED - OCTOBER 14, 1958.

GROUND ELEVATION		DATUM	LINE
GRADE ELEVATION		DATUM	LINE
CURVE DATA			
DEFLECTION OF ANGLE		A	
DEGREE OF CURVE		D	
RADIUS OF CURVE		R	
TANGENT DISTANCE		T	
LENGTH OF CURVE		L	
EXTERNAL DISTANCE		E	
POINT OF INTERSECTION		P.I.	
POINT OF CURVE		P.C.	
POINT OF TANGENT		P.T.	
POINT ON TANGENT		P.O.T.	
POINT ON SUB-TANGENT		P.O.S.T.	

SCALES	
TITLE	1" = 400'
TYPICAL	3" = 8'
PLAN	1" = 4'
PROFILE HORIZONTAL	1" = 4'
PROFILE VERTICAL	1" = 4'
CROSS-SECTIONS	1" = 4'


APPROVED DATE	APPROVED DATE	APPROVED DATE	APPROVED DATE	APPROVED DATE	APPROVED DATE
SECONDARY ENGINEER	CONSTRUCTION ENGINEER	BRIDGE ENGINEER	DISTRICT ENGINEER	HIGHWAY ENGINEER	DISTRICT ENGINEER
	May 26, 1958			May 26, 1958	

DEPARTMENT OF COMMERCE BUREAU OF PUBLIC ROADS	
APPROVED	DATE
DISTRICT ENGINEER	
PROJECT DF NO. 026-1(3)	
SHEET 1A OF 2 SHEETS	

THESE PLANS ARE SUBJECT TO SUCH REVISIONS AS MAY BE
REQUIRED BY THE BUREAU OF PUBLIC ROADS OR THE COMMISSIONER
OF HIGHWAYS.
CONSTRUCTION IS TO BE CARRIED ON IN ACCORDANCE WITH
THE PLANS AND THE STANDARD SPECIFICATIONS FOR HIGHWAY AND BRIDGE
CONSTRUCTION OF JANUARY 1956 SUBMITTED TO THE BUREAU OF
PUBLIC ROADS AS APPROVED JULY 3, 1956, INCLUDING ALL SUBSEQUENT
APPROVED REVISIONS AND SUCH REVISED SPECIFICATIONS AND SPECIAL
PROVISIONS AS ARE SUBMITTED WITH THE PLANS.

NOTE: ANY FURTHER INFORMATION CONCERNING
FINAL QUANTITIES, AMOUNTS OR OTHER DETAILS
RELATIVE TO THIS PROJECT MAY BE FOUND IN
EITHER THE FIELD BOOKS OR THE ESTIMATE
FILE.

(To Be Returned To R.O.W. Division)

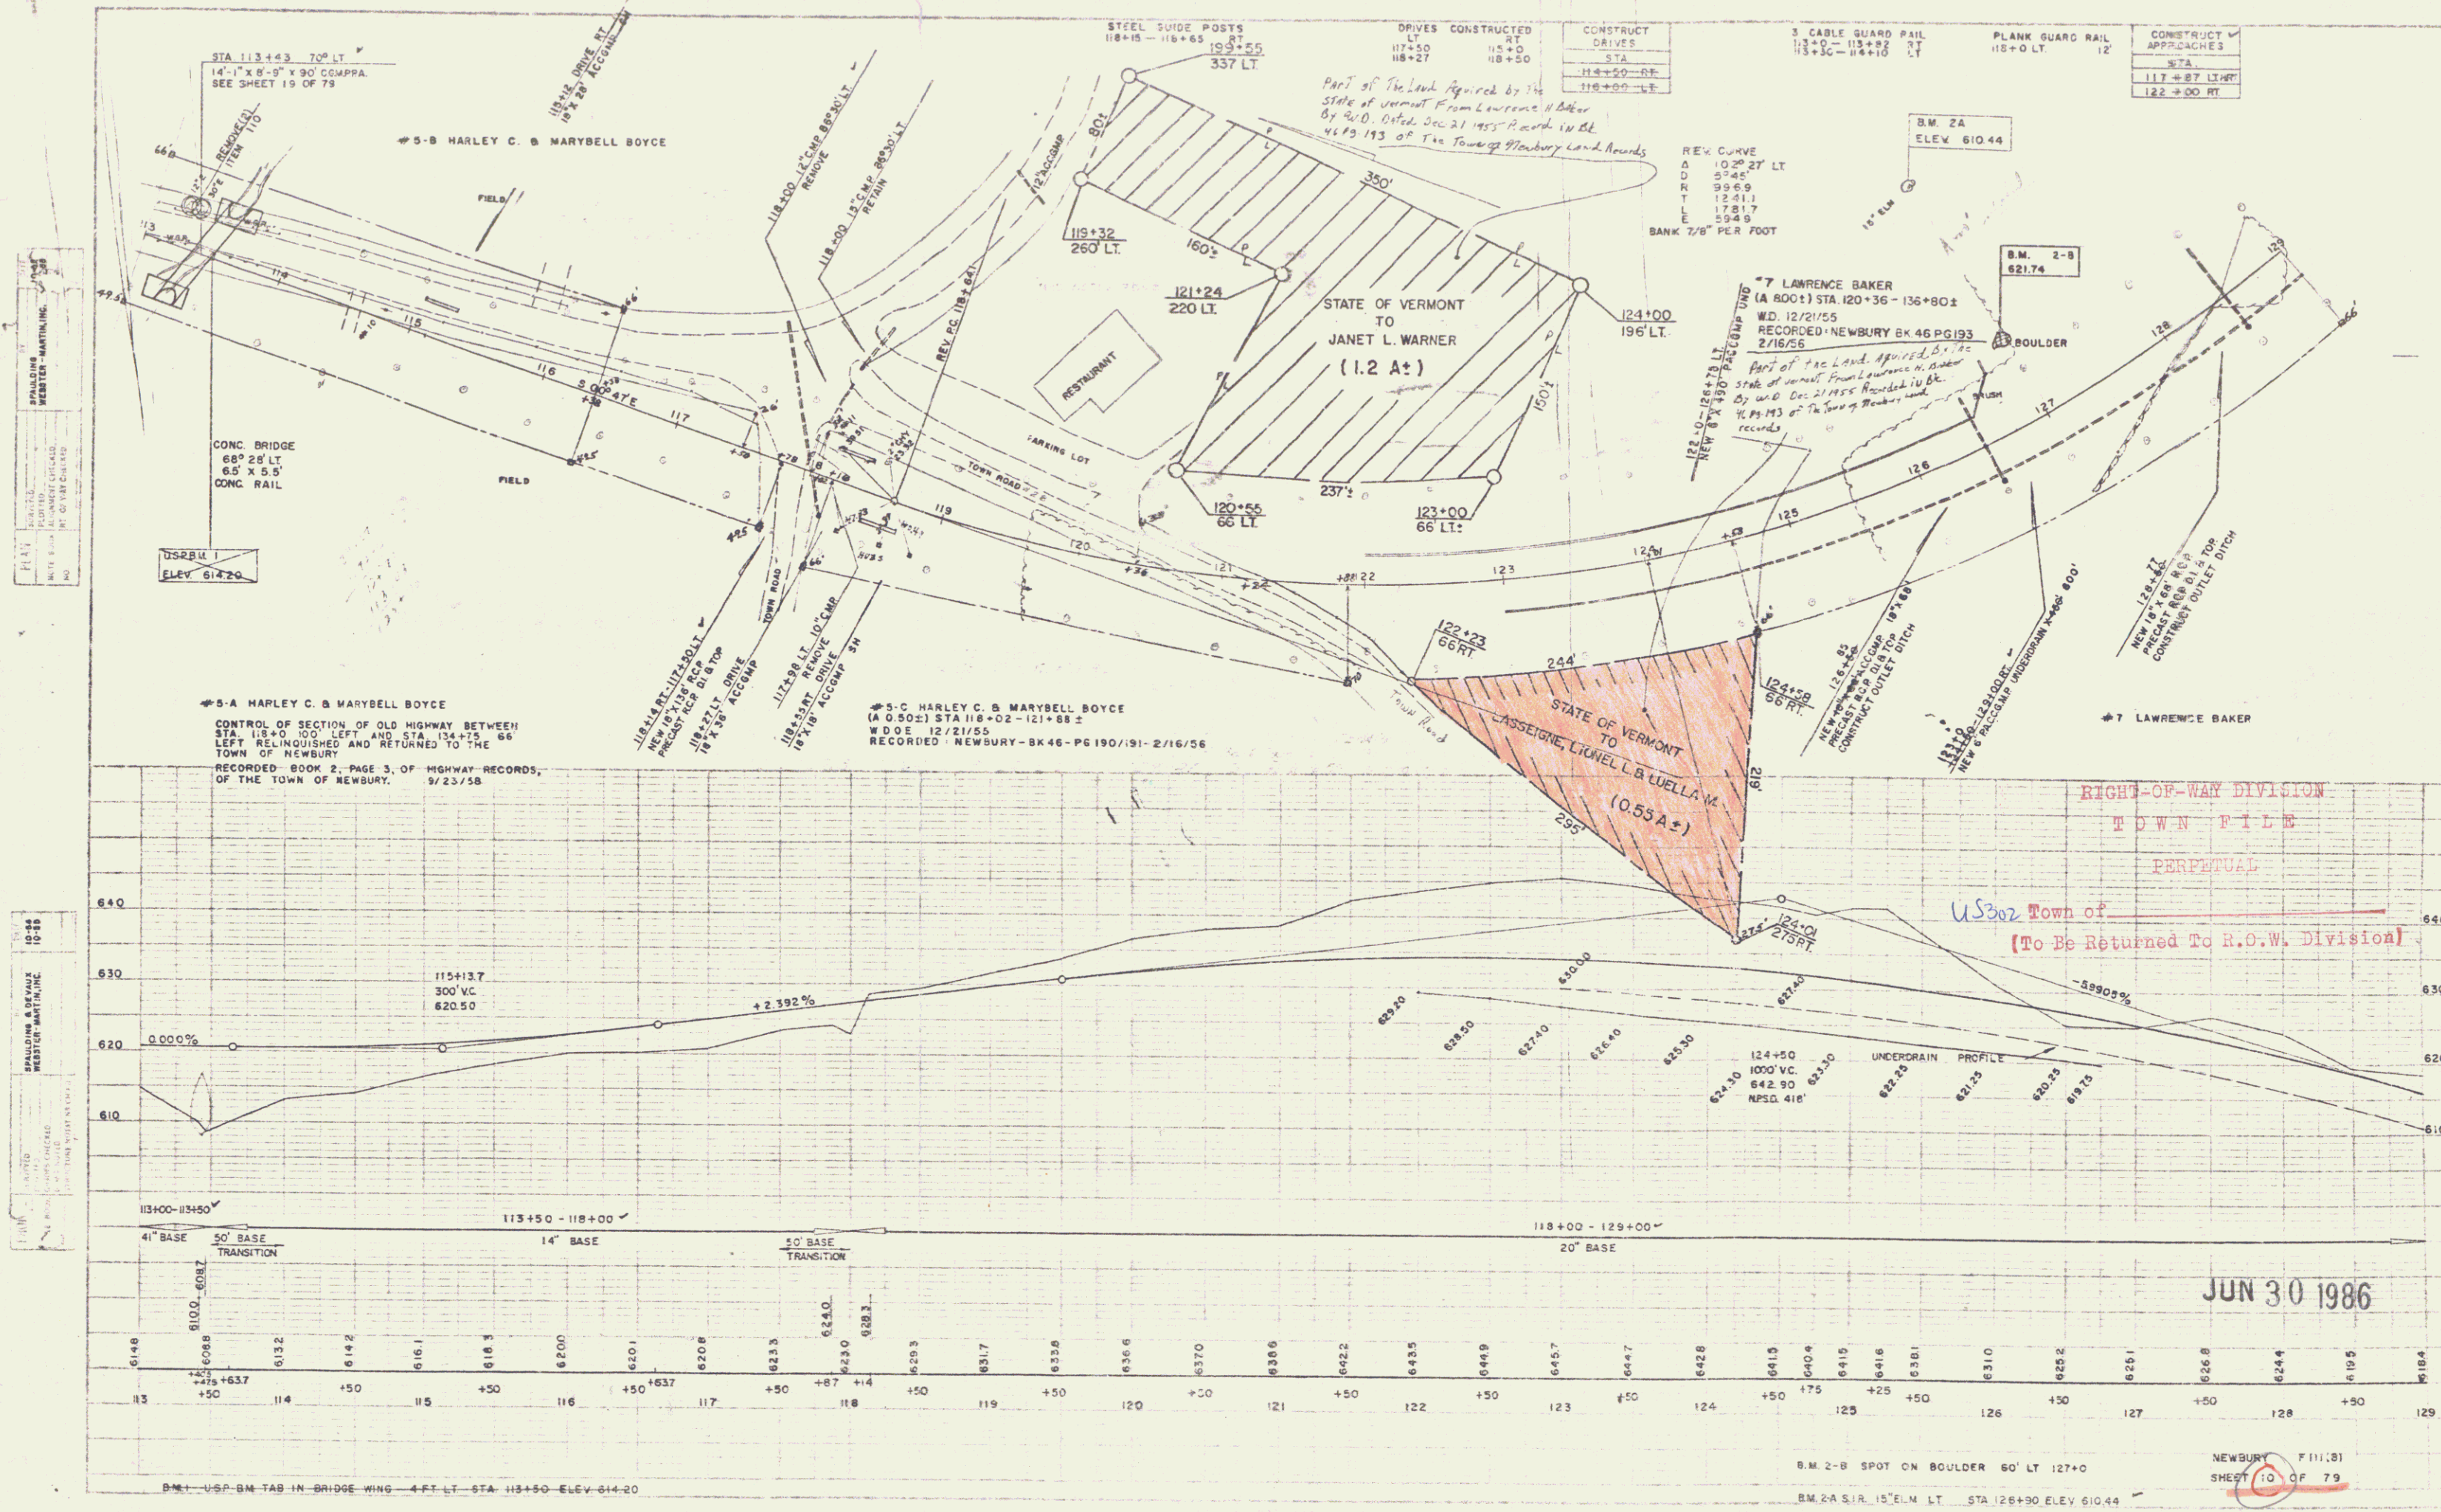


JUN 30 1986

NEWBURY F111(8)
SHEET 10 OF 79

PART OF THE LAND ACQUIRED BY THE STATE OF VERMONT FROM
LAWRENCE H. BAKER BY W.D. DATED DEC. 21, 1955. RECORDED IN BK.
46 PG. 193 OF THE TOWN OF NEWBURY LAND RECORDS

STATE TO WARNER BY QCD
ON 1/8/86 IN BK 40/310-314
MP 0235

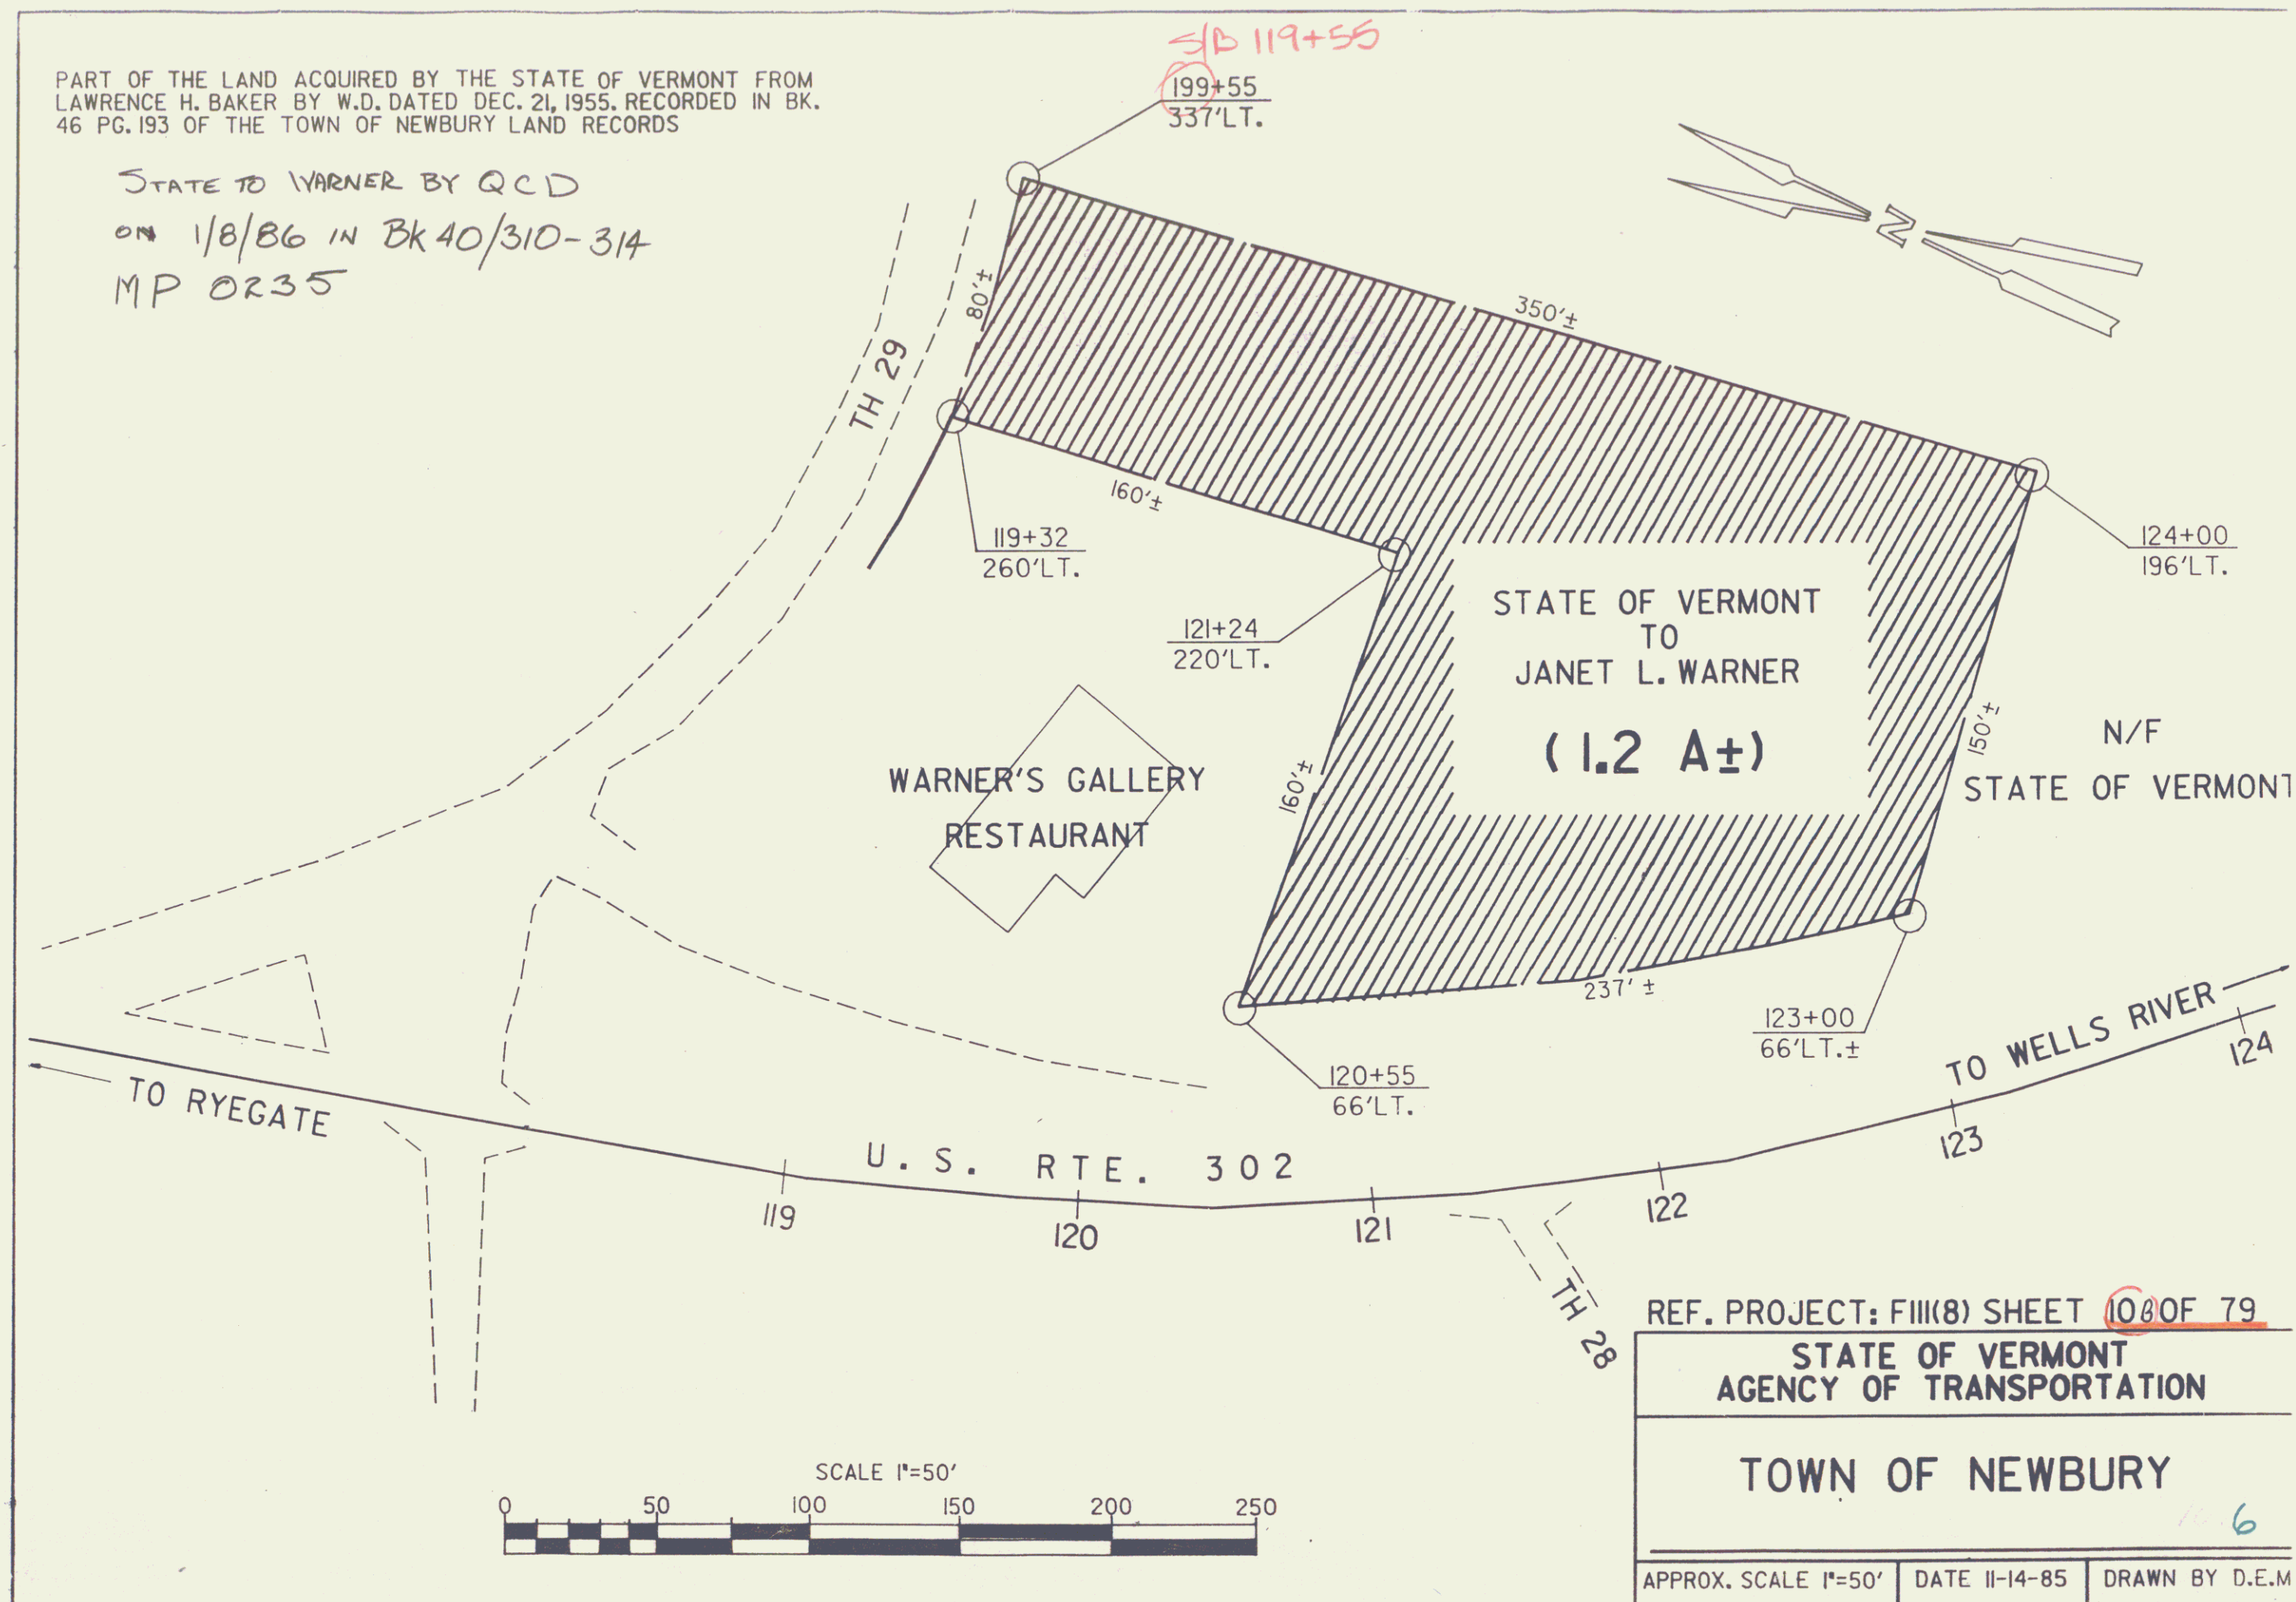

REF. PROJECT: F111(8) SHEET 100 OF 79


STATE OF VERMONT
AGENCY OF TRANSPORTATION


TOWN OF NEWBURY

APPROX. SCALE 1"=50' DATE 11-14-85 DRAWN BY D.E.M.

PART OF THE LAND ACQUIRED BY THE STATE OF VERMONT FROM
LAWRENCE H. BAKER BY W.D. DATED DEC. 21, 1955 RECORDED IN BK.
46 PG. 193 OF THE TOWN OF NEWBURY LAND RECORDS.

STATE OF VERMONT TO L. & L. LASSEIGNE
BY CORRECTIVE GCD REC'D 6/19/91
IN BK 90/152-5A

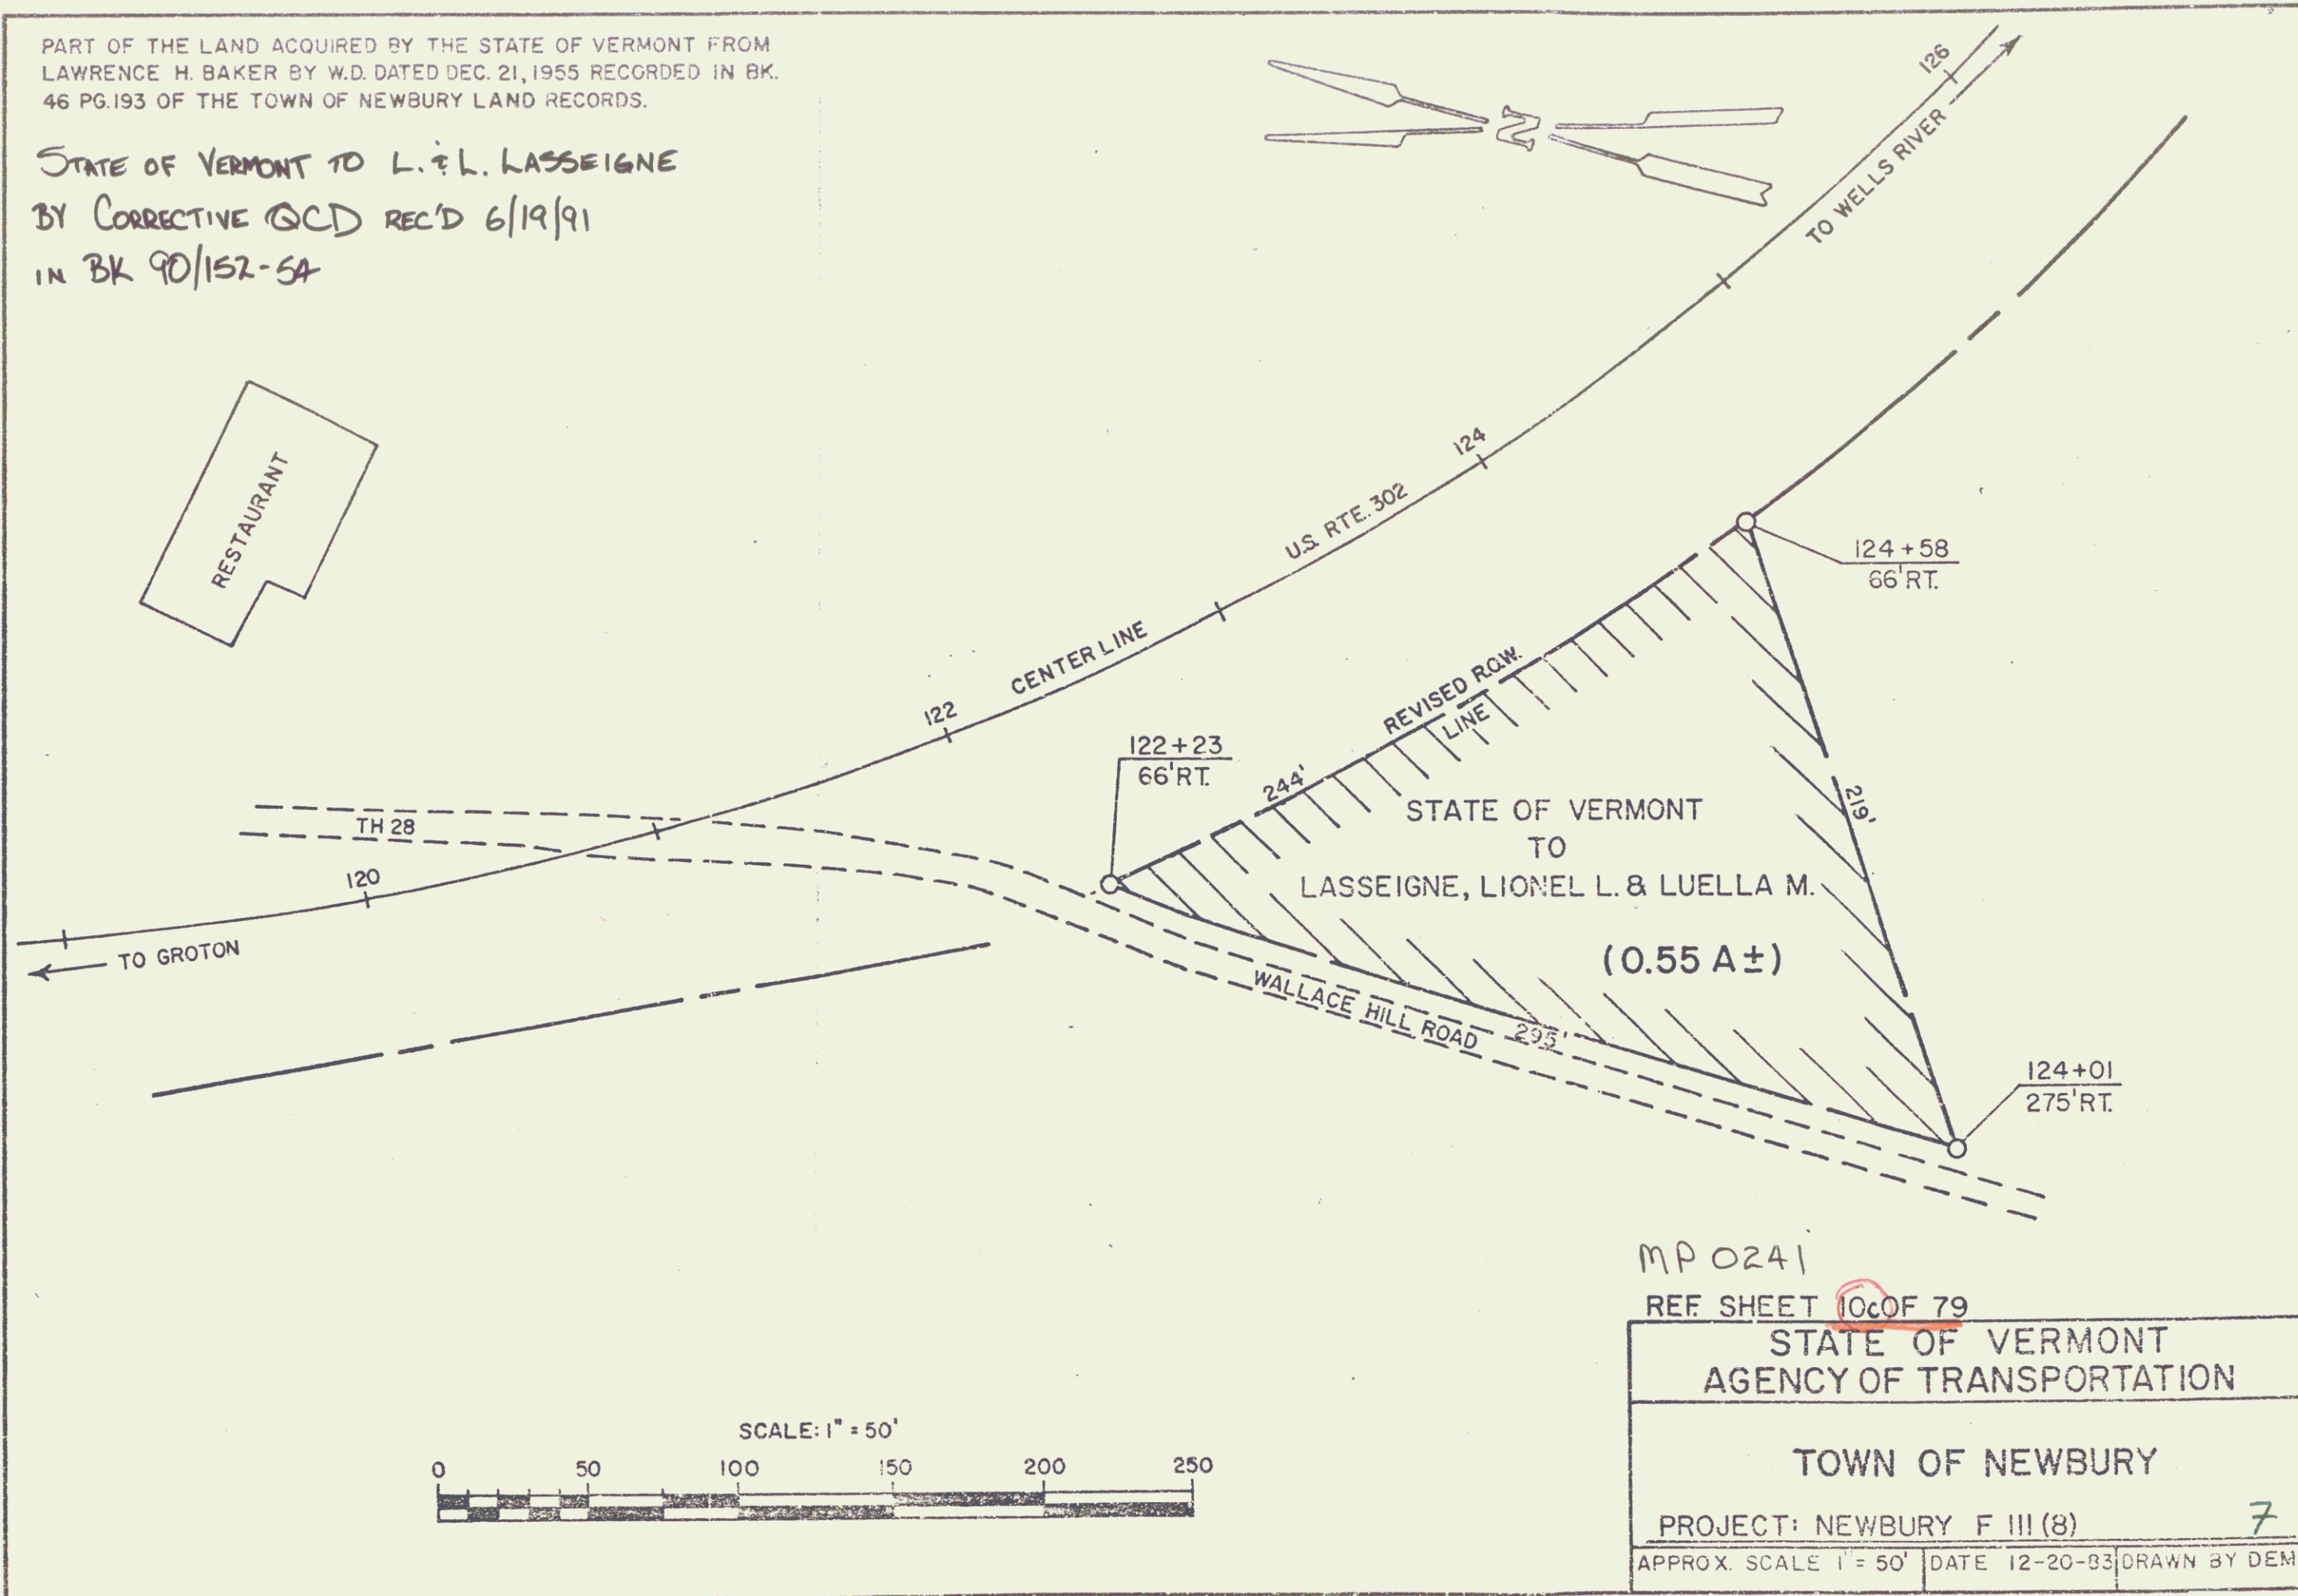

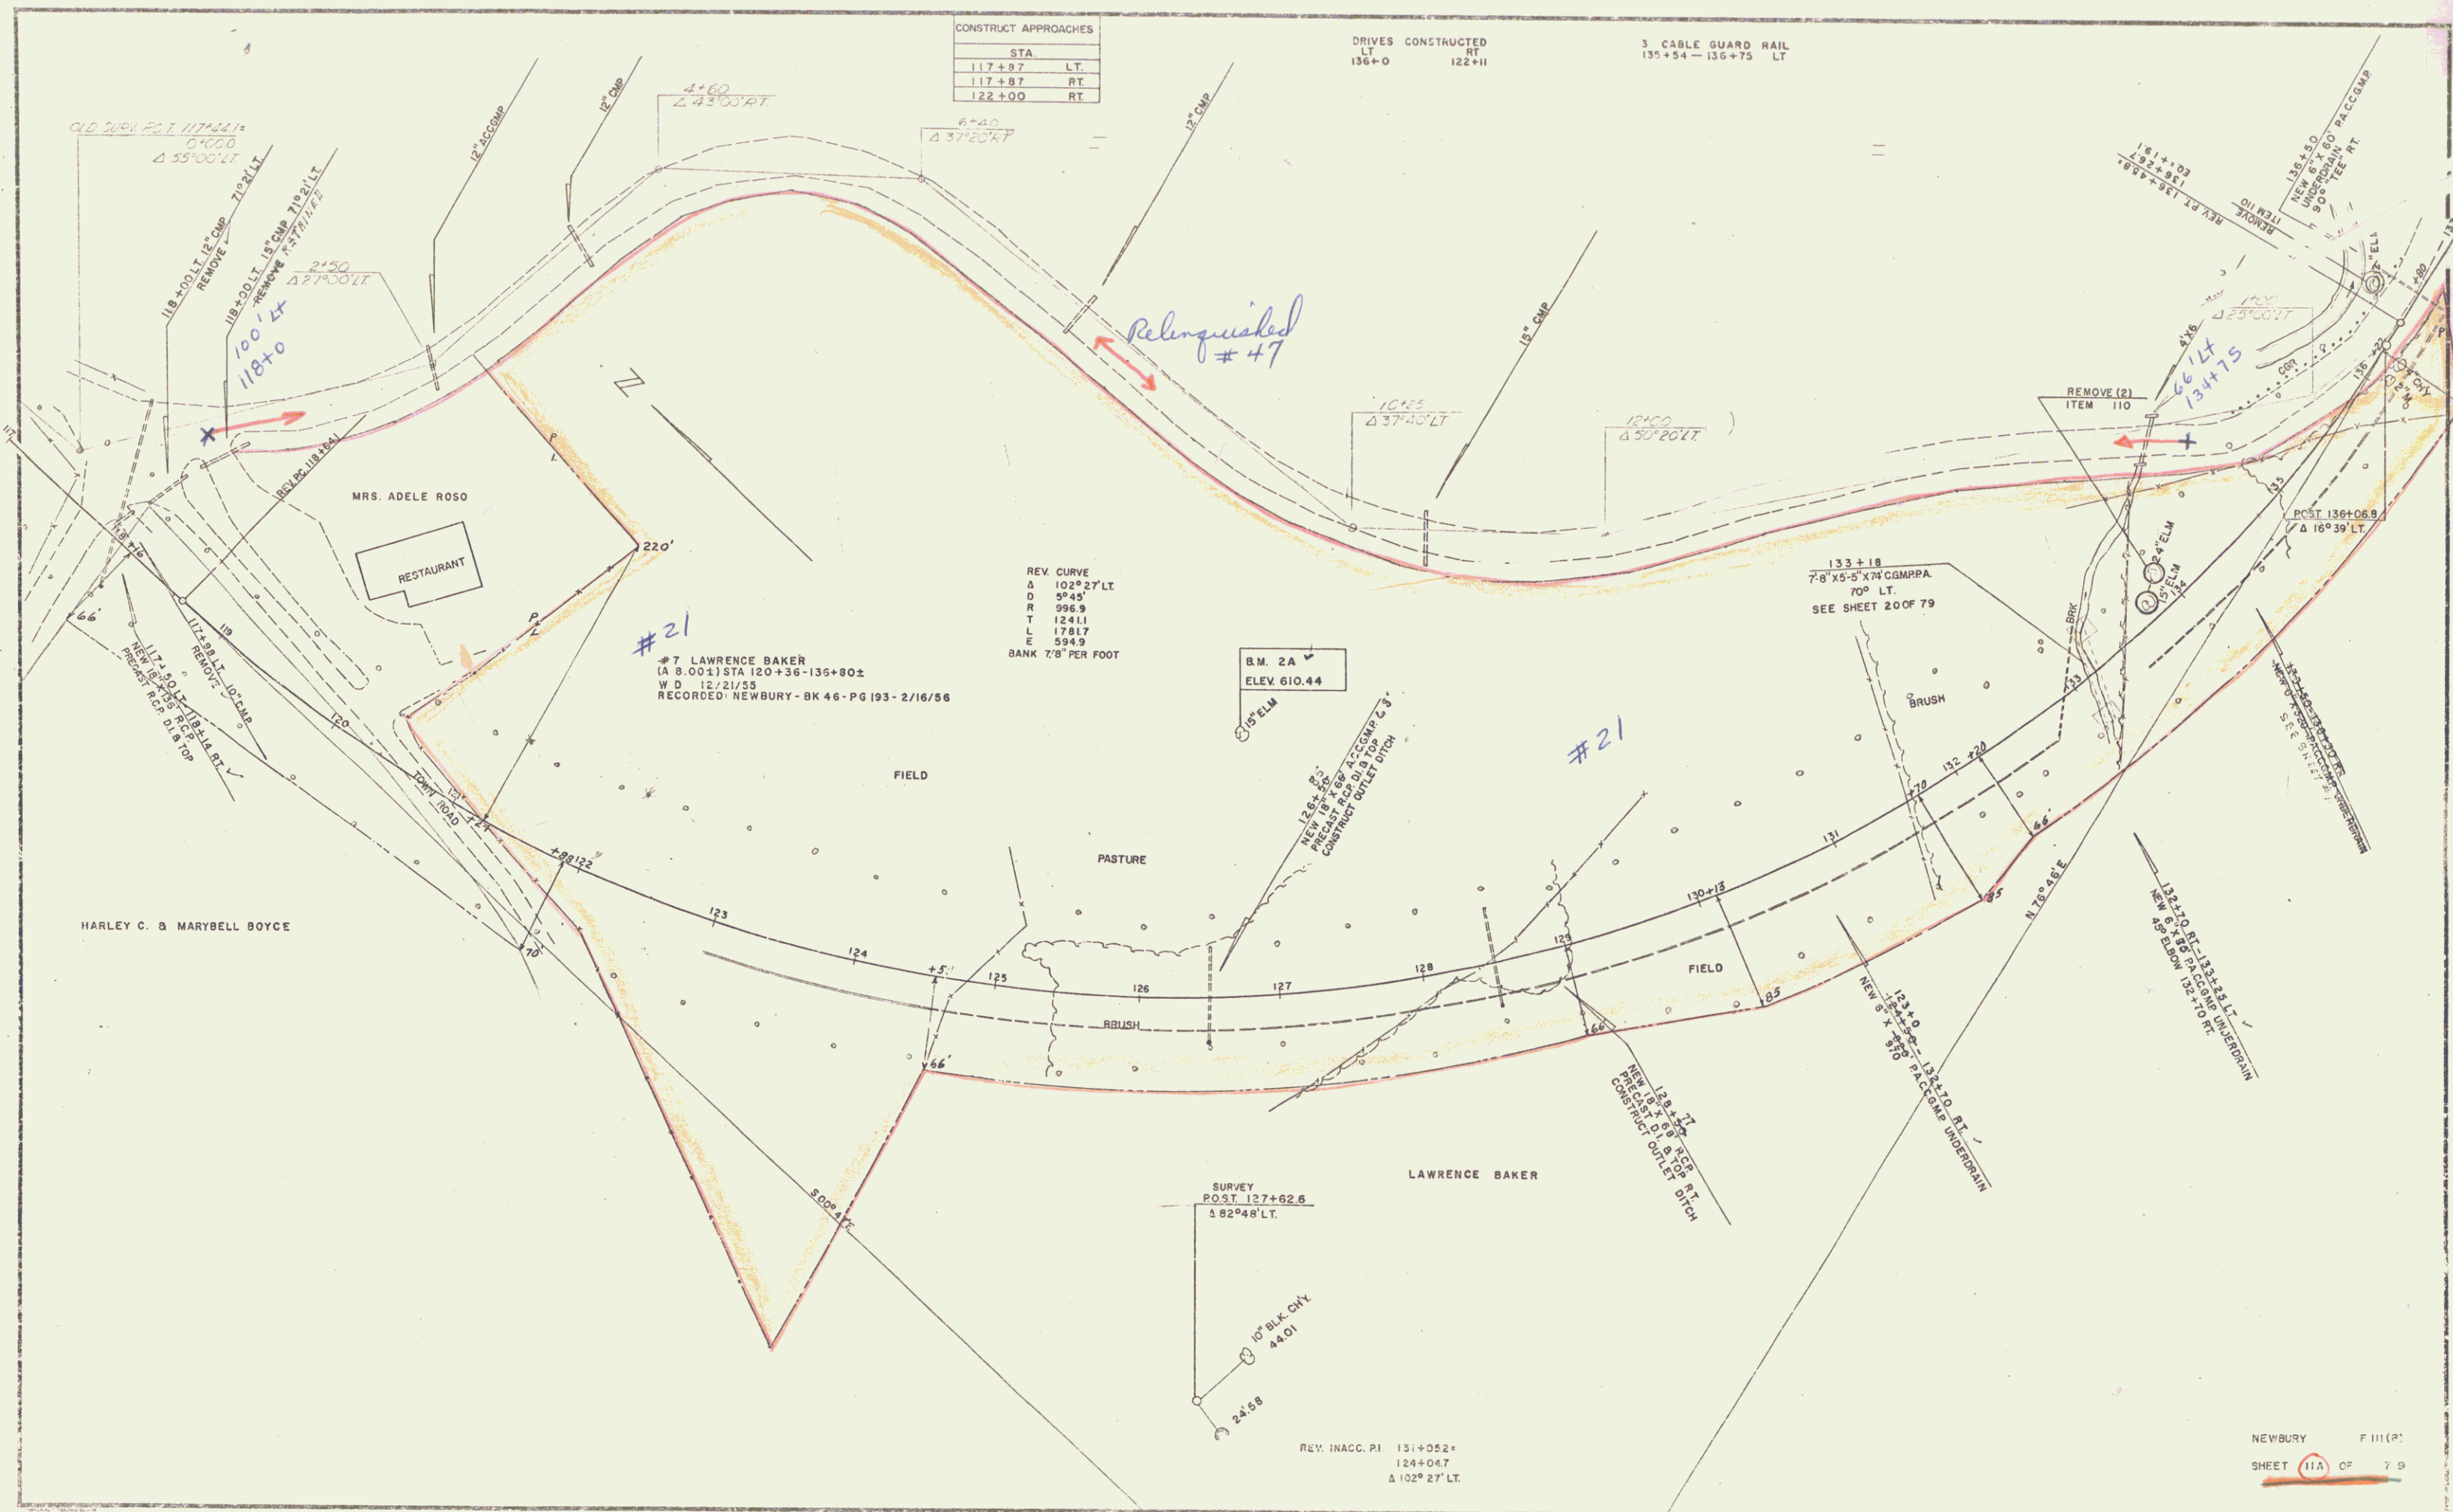



CONSTRUCT APPROACHES	
STA.	
117+87	LT.
117+87	RT.
122+00	RT.

DRIVES CONSTRUCTED	
LT.	RT.
136+00	122+11

3 CABLE GUARD RAIL
135+54 - 136+75 LT

PLAN
 SHEET 12-55
 WESTER-MARTIN, INC.
 12-55


12-55
 WESTER-MARTIN, INC.
 12-55

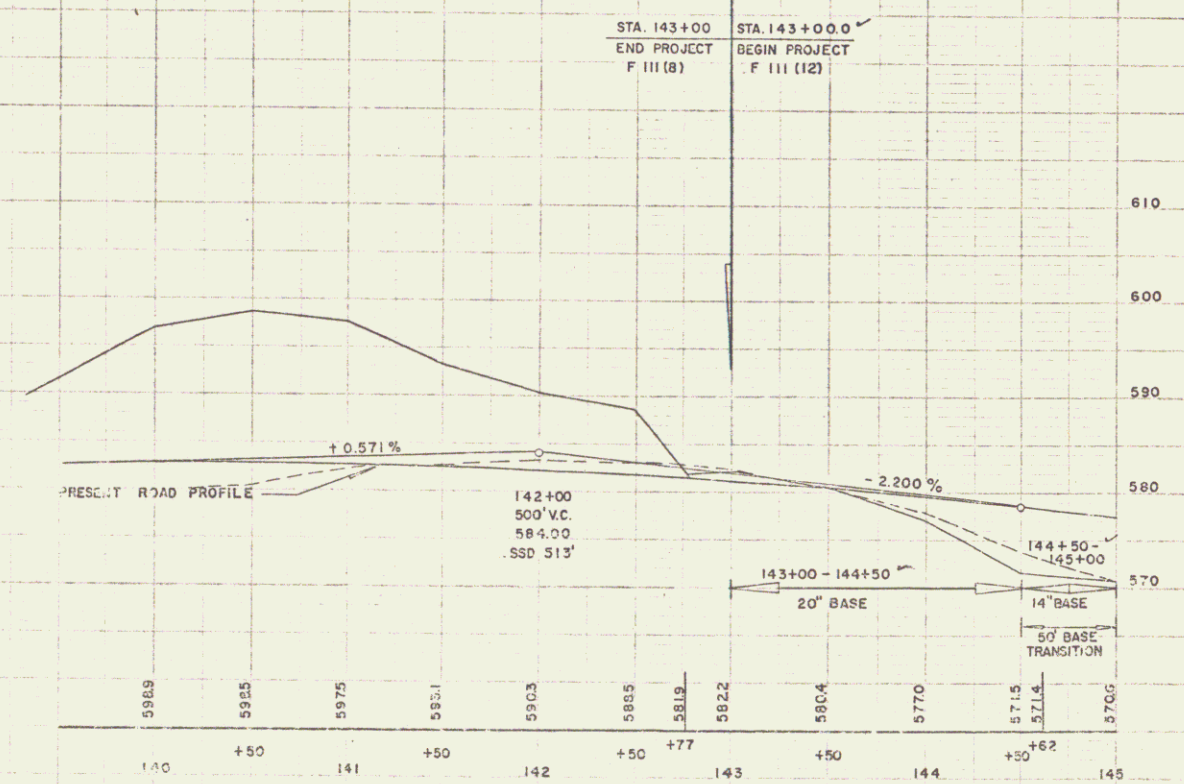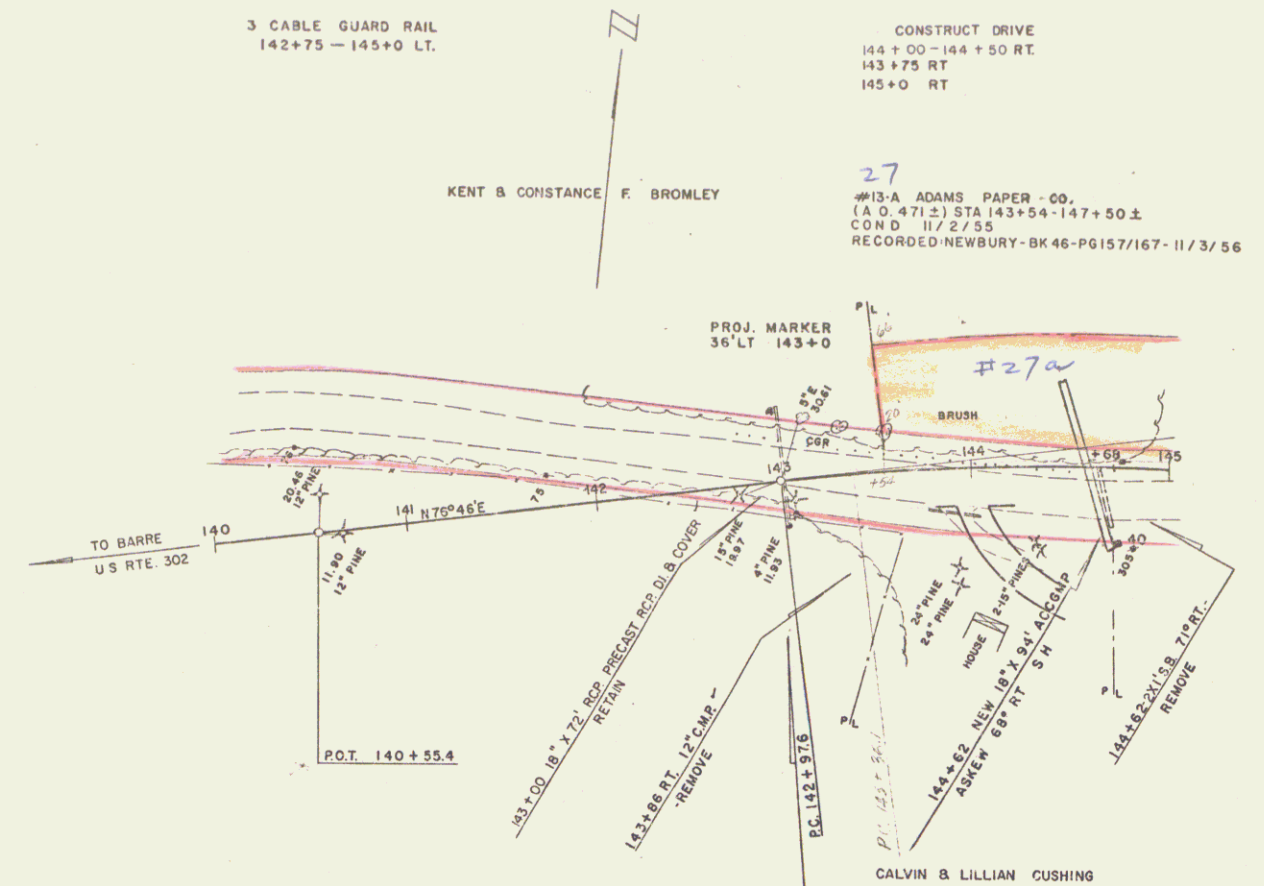

NEWBURY F III (12)
 SHEET 6 OF 33



12-55
SPALLING
WEBSTER-MARTIN, INC.
12-55

12-55
SPALLING
WEBSTER-MARTIN, INC.
12-55

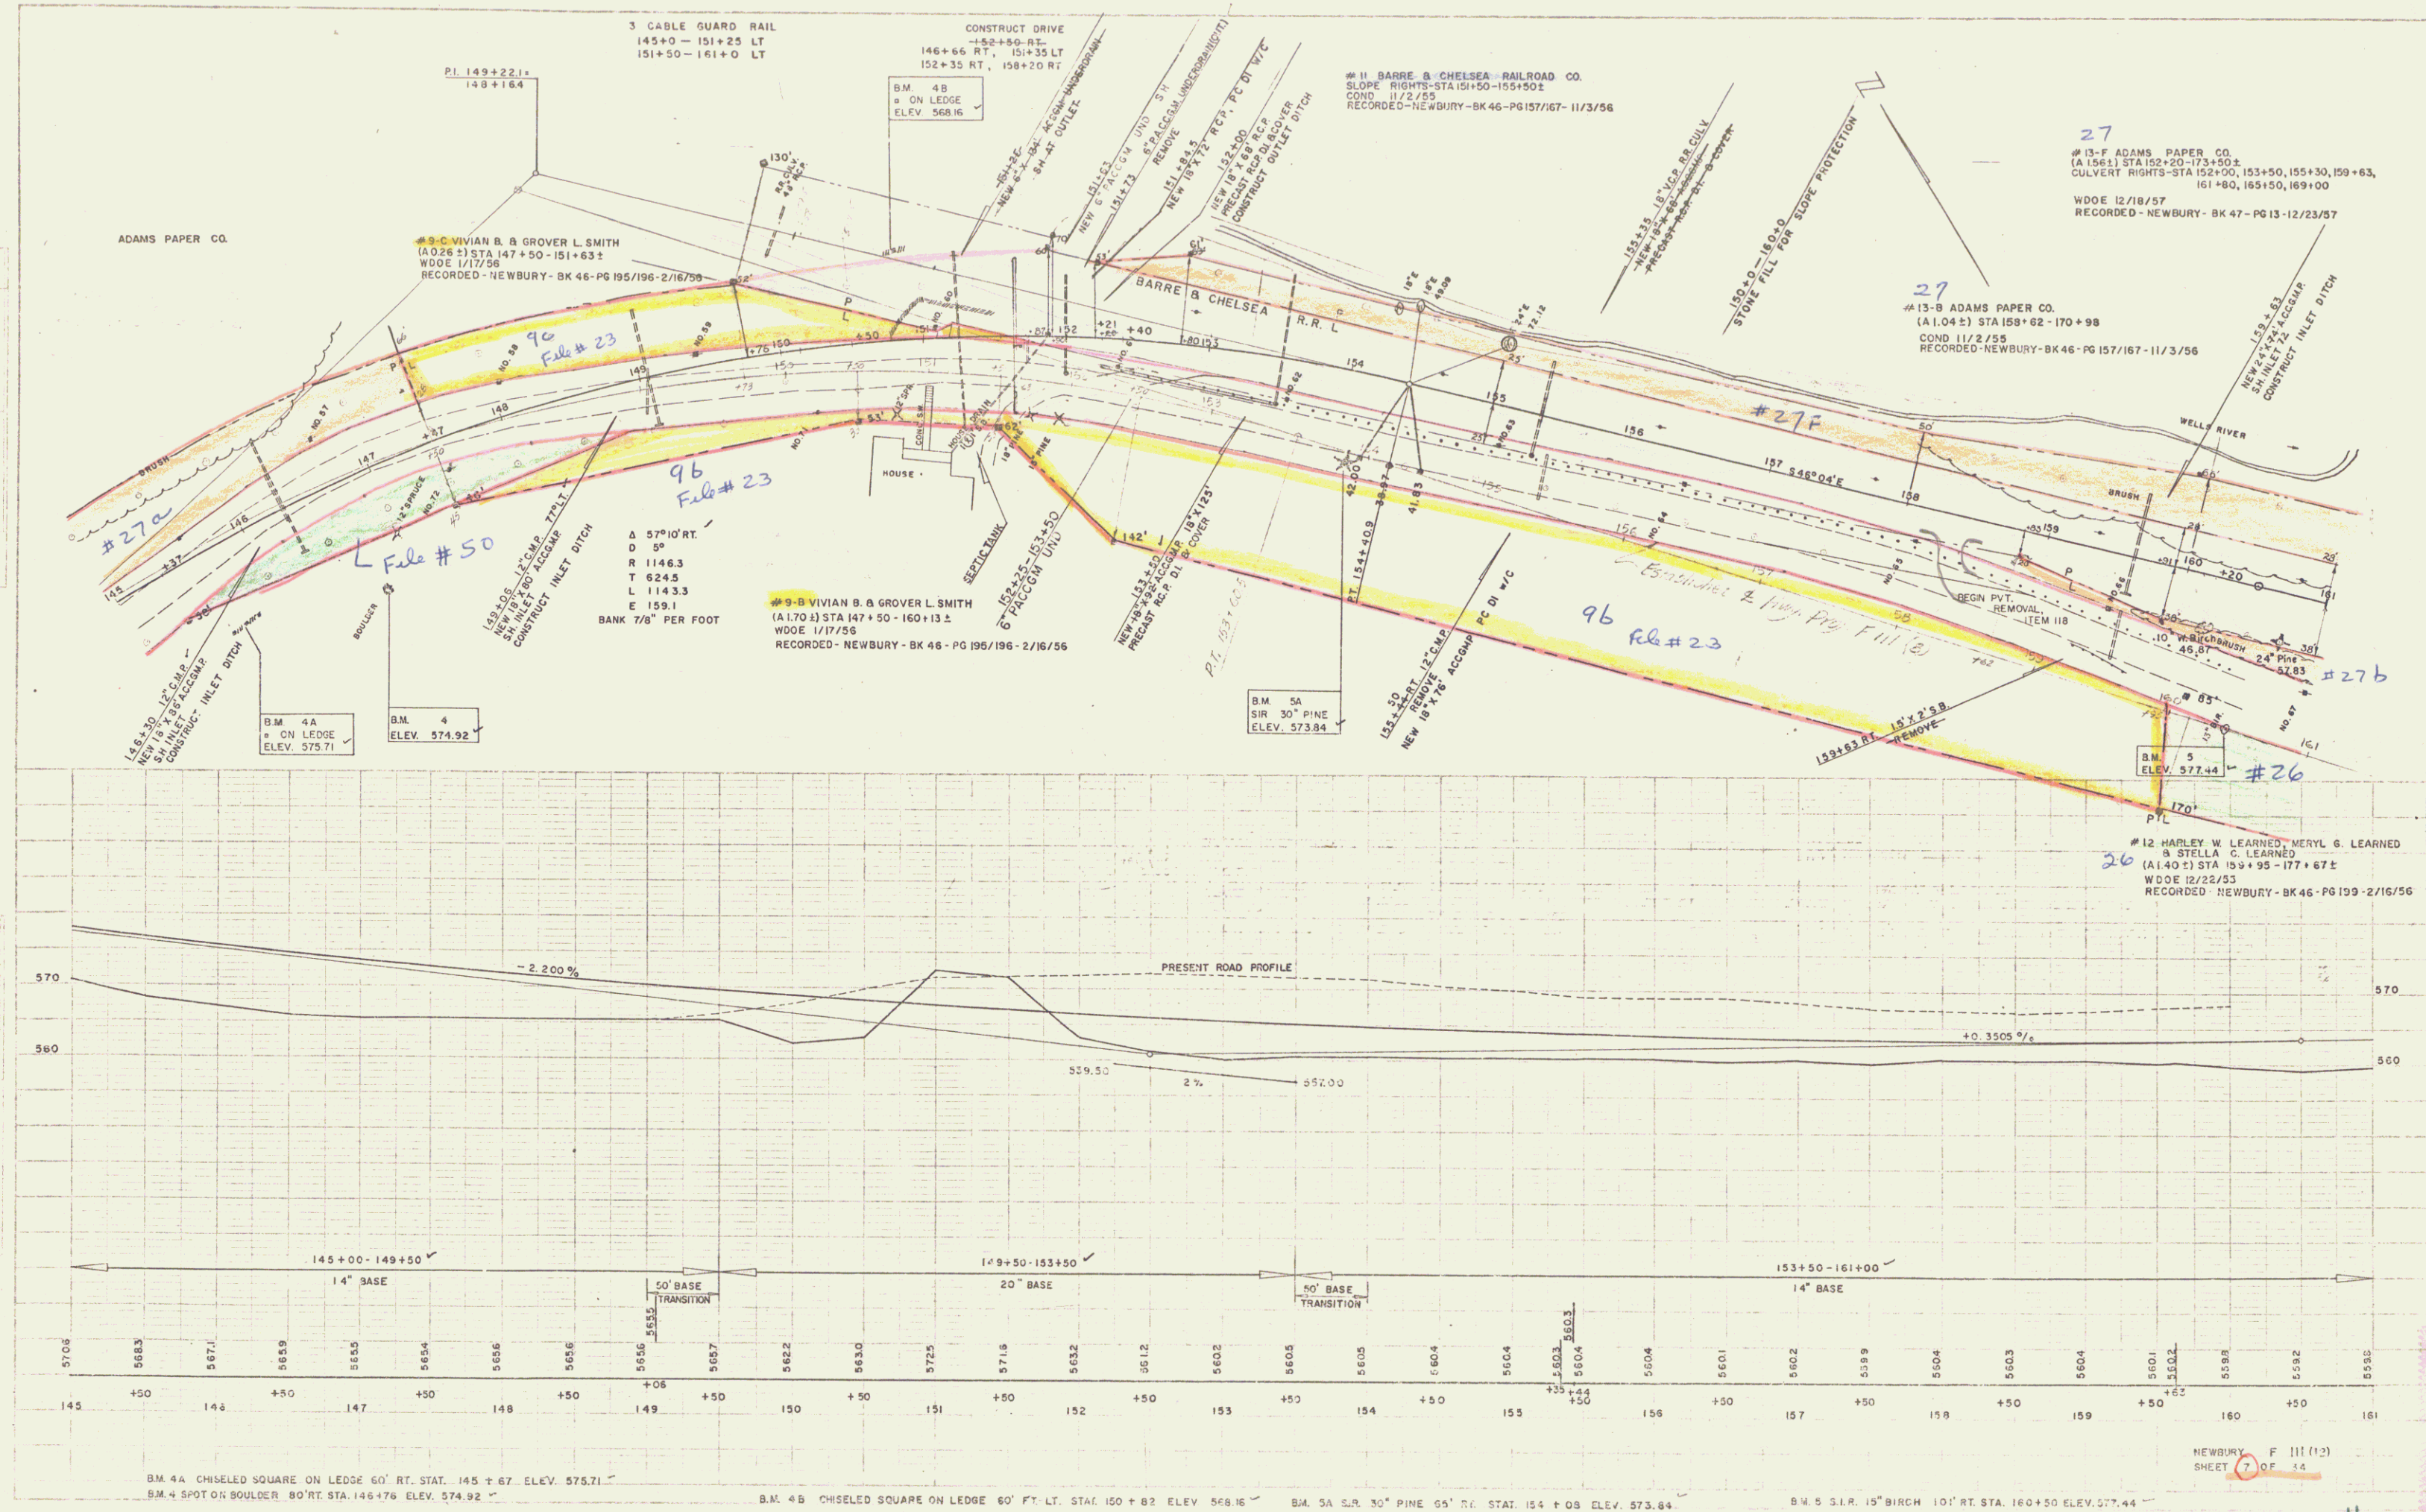

FORMERLY PART OF PARCEL 9B (FIII(8))
ACQUIRED FROM VIVIAN B. & GROVER L. SMITH
RECORDED: WDOE, TOWN OF NEWBURY; 2/16/56;
BK. 46, PG. 195 - 196

STATE OF VERMONT TO KAISER
BY QCD ON 9/18/74 IN
BK 55/530
MP 0295

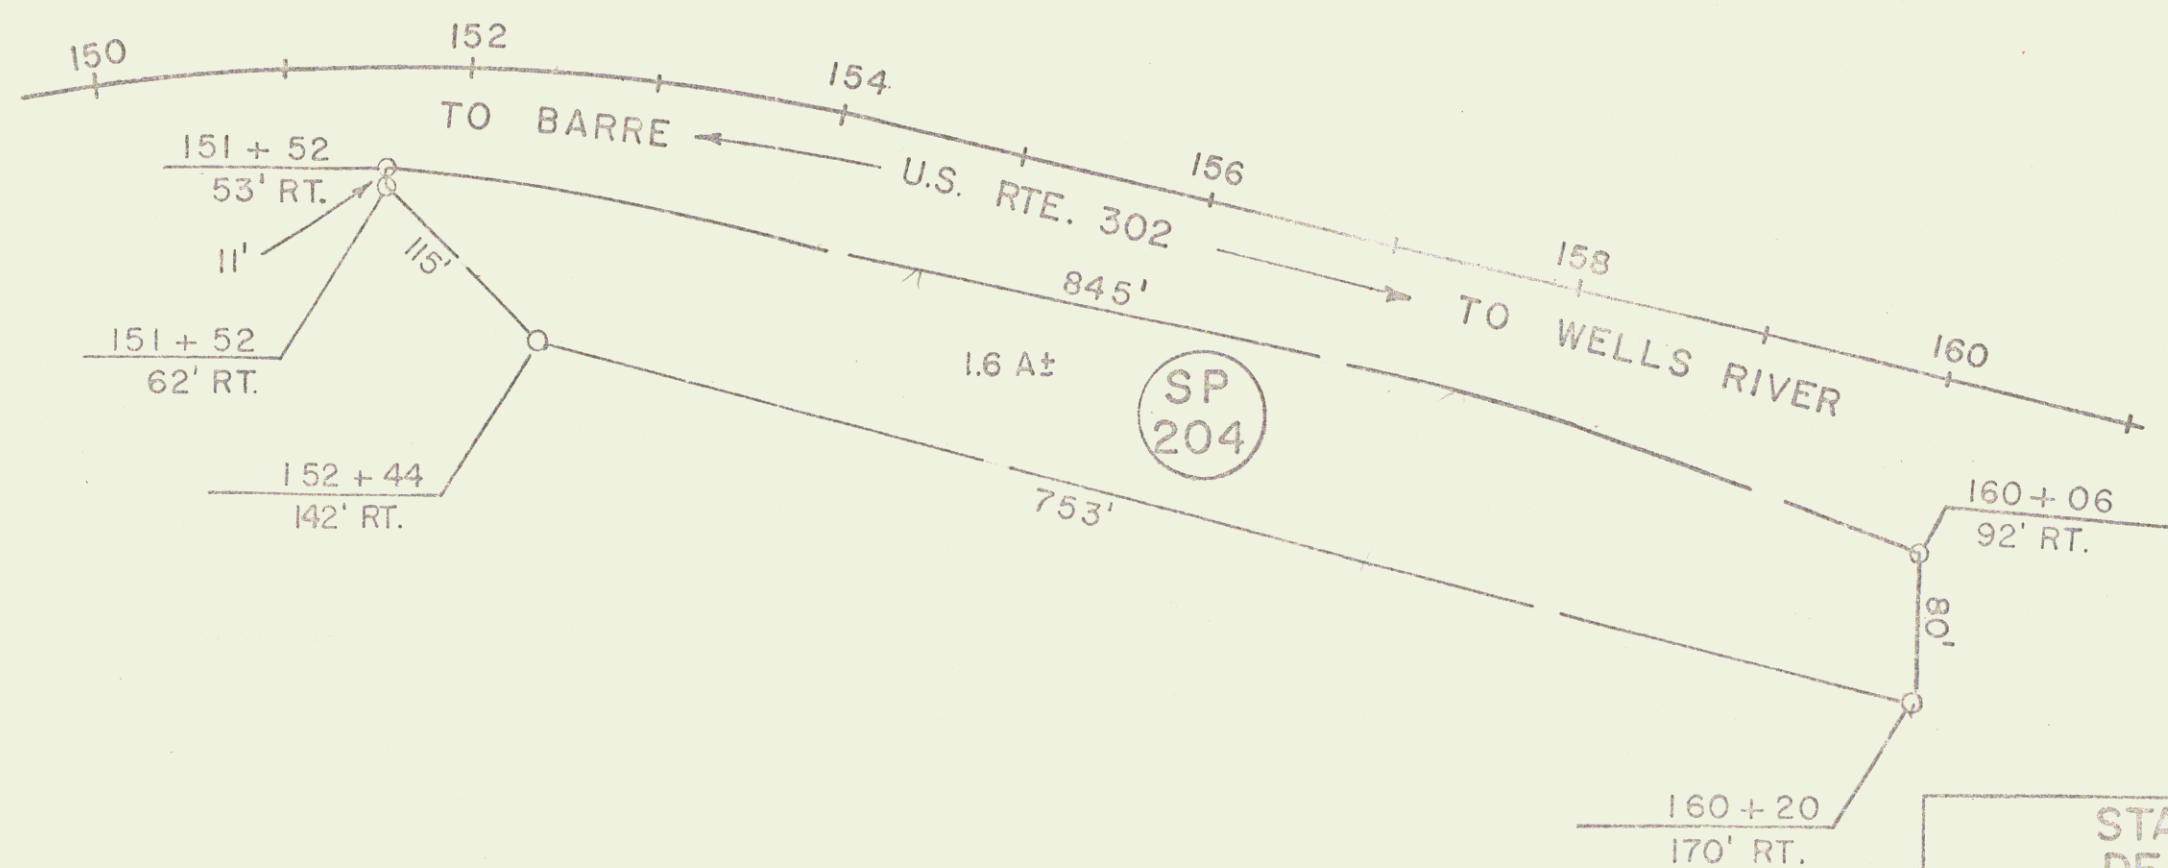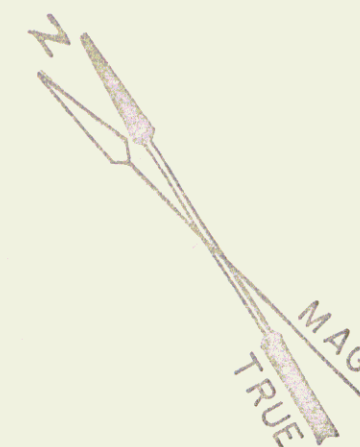

SCALE IN FEET




SHEET 7A

STATE OF VERMONT
DEPT. OF HIGHWAYS


TOWN OF NEWBURY

PROJECT NEWBURY FIII (12) 12
APPROX. SCALE 1"=100' DATE 8-22-74 DRAWN BY KDP

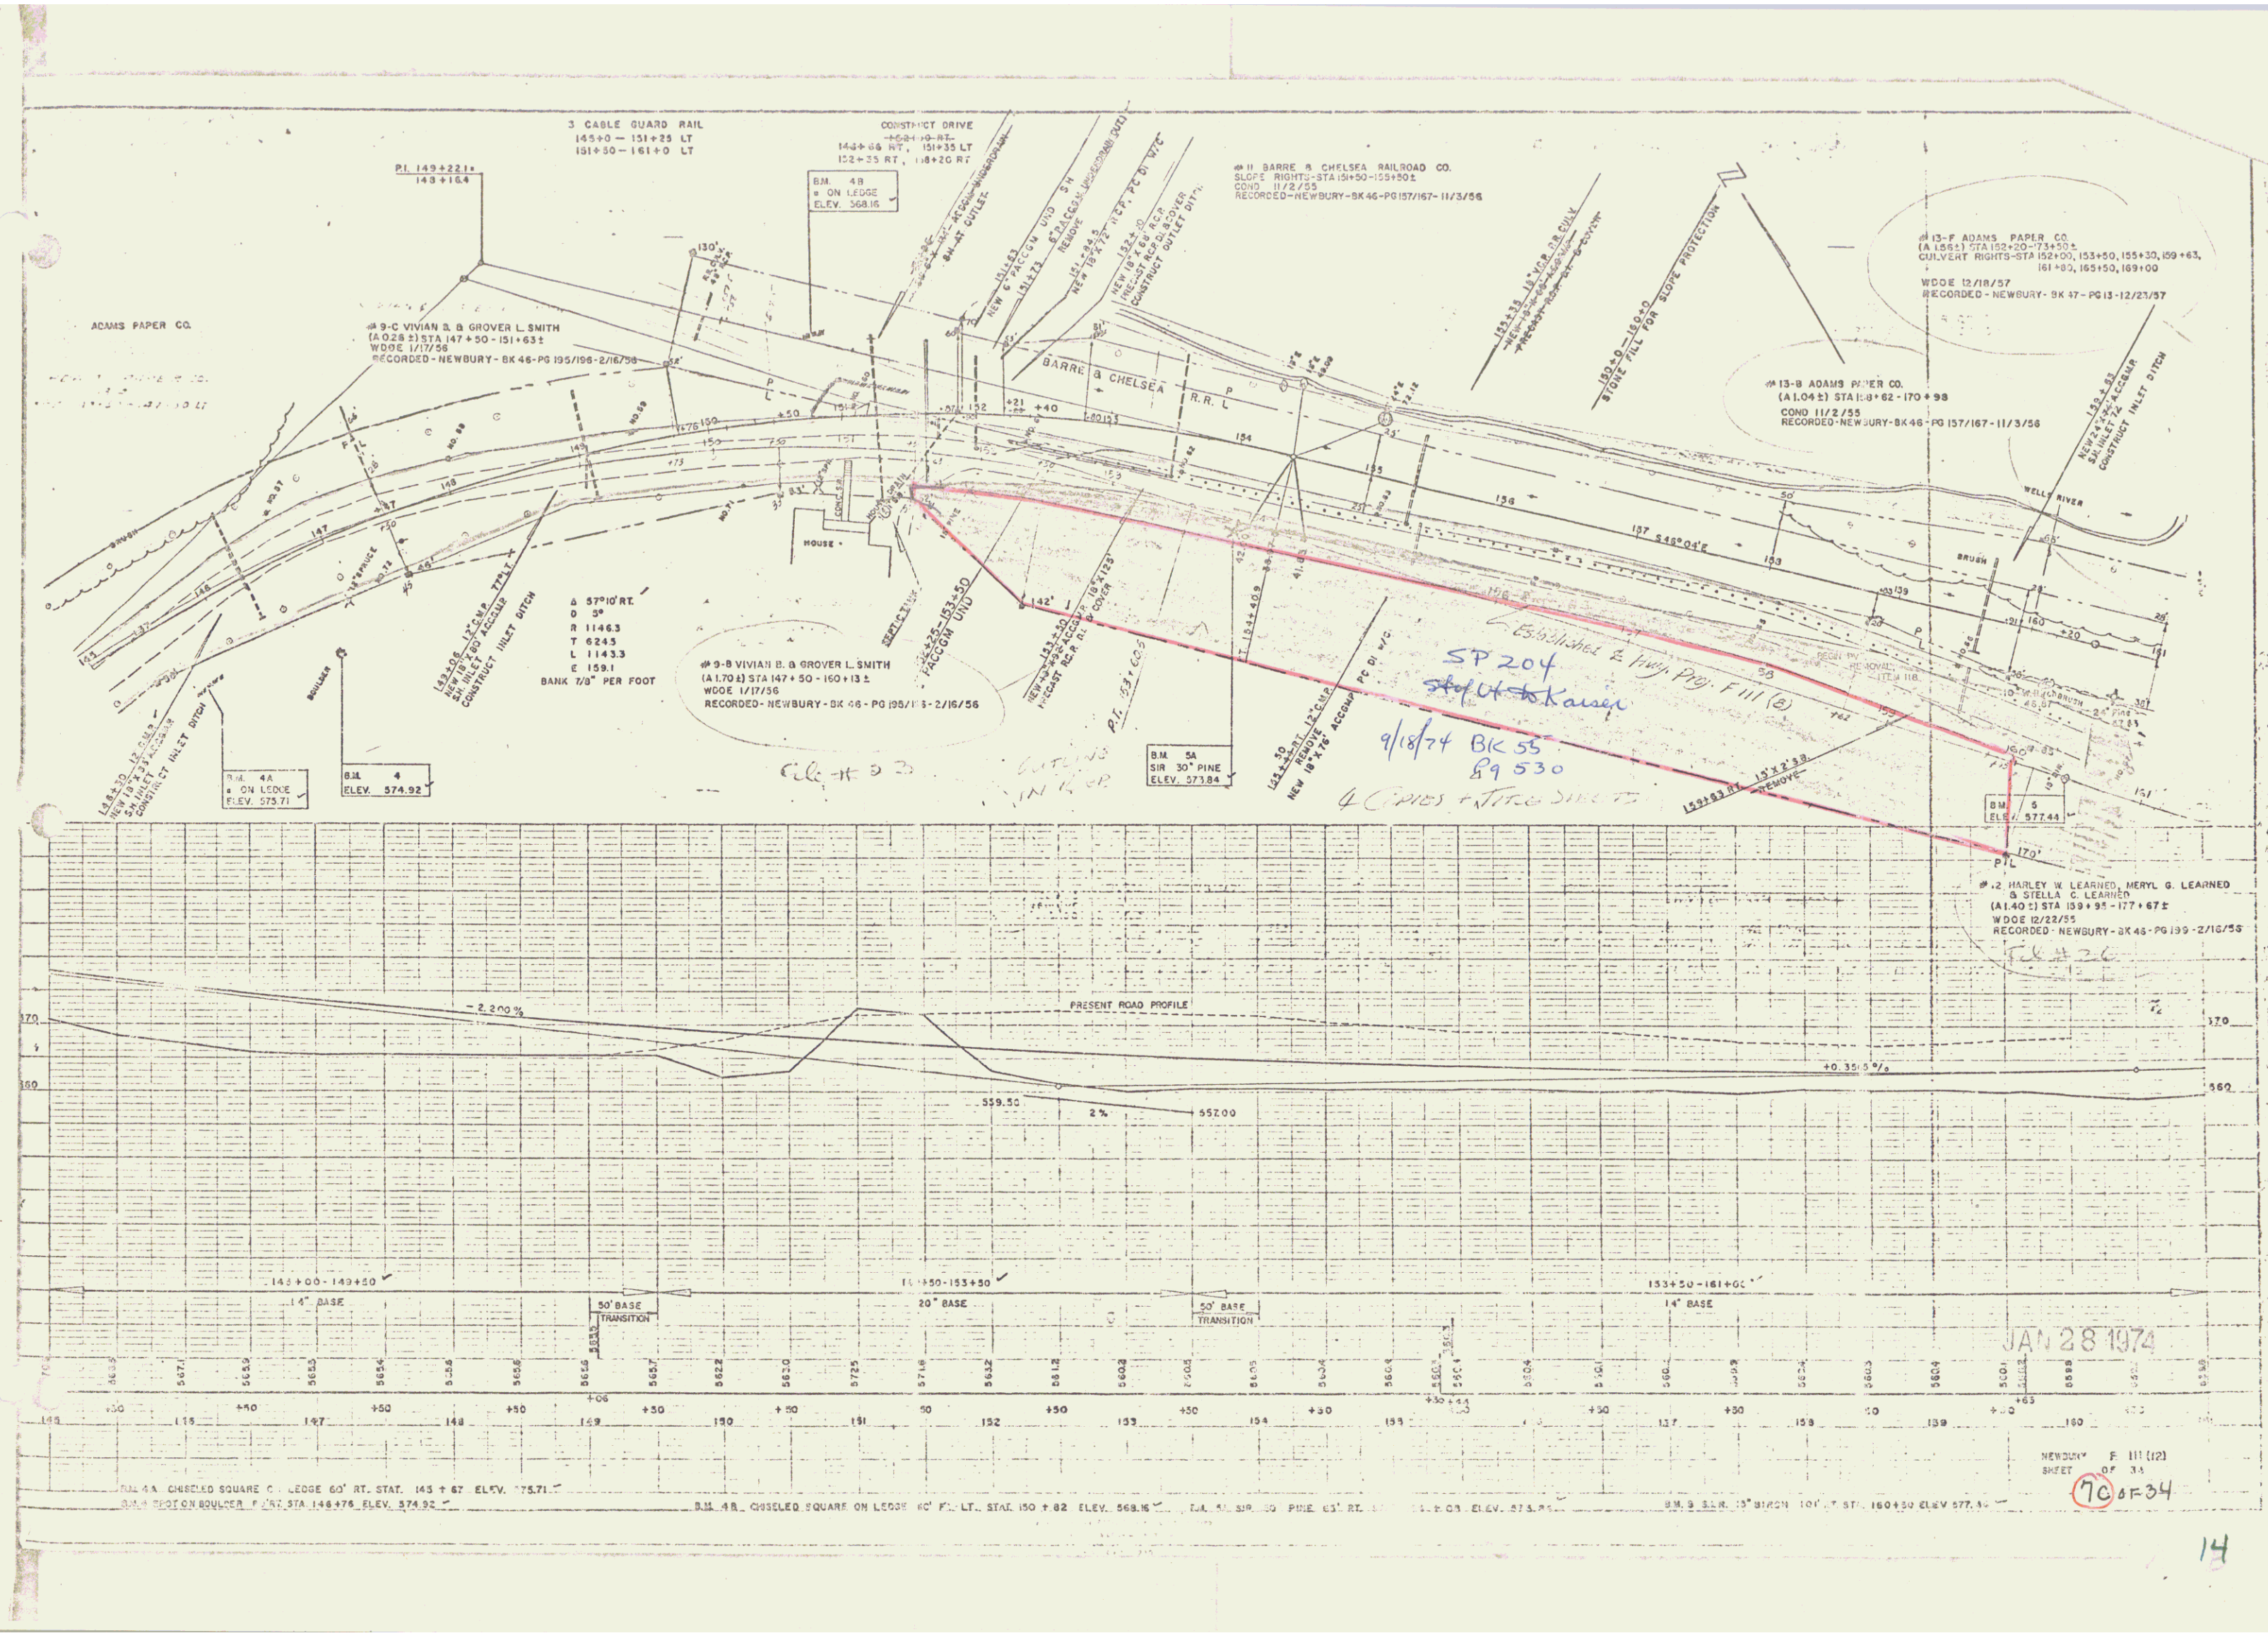

DEVALUX
WESTER-MARTIN INC.
12-54
12-54

DEVALUX
WESTER-MARTIN INC.
12-54
12-54

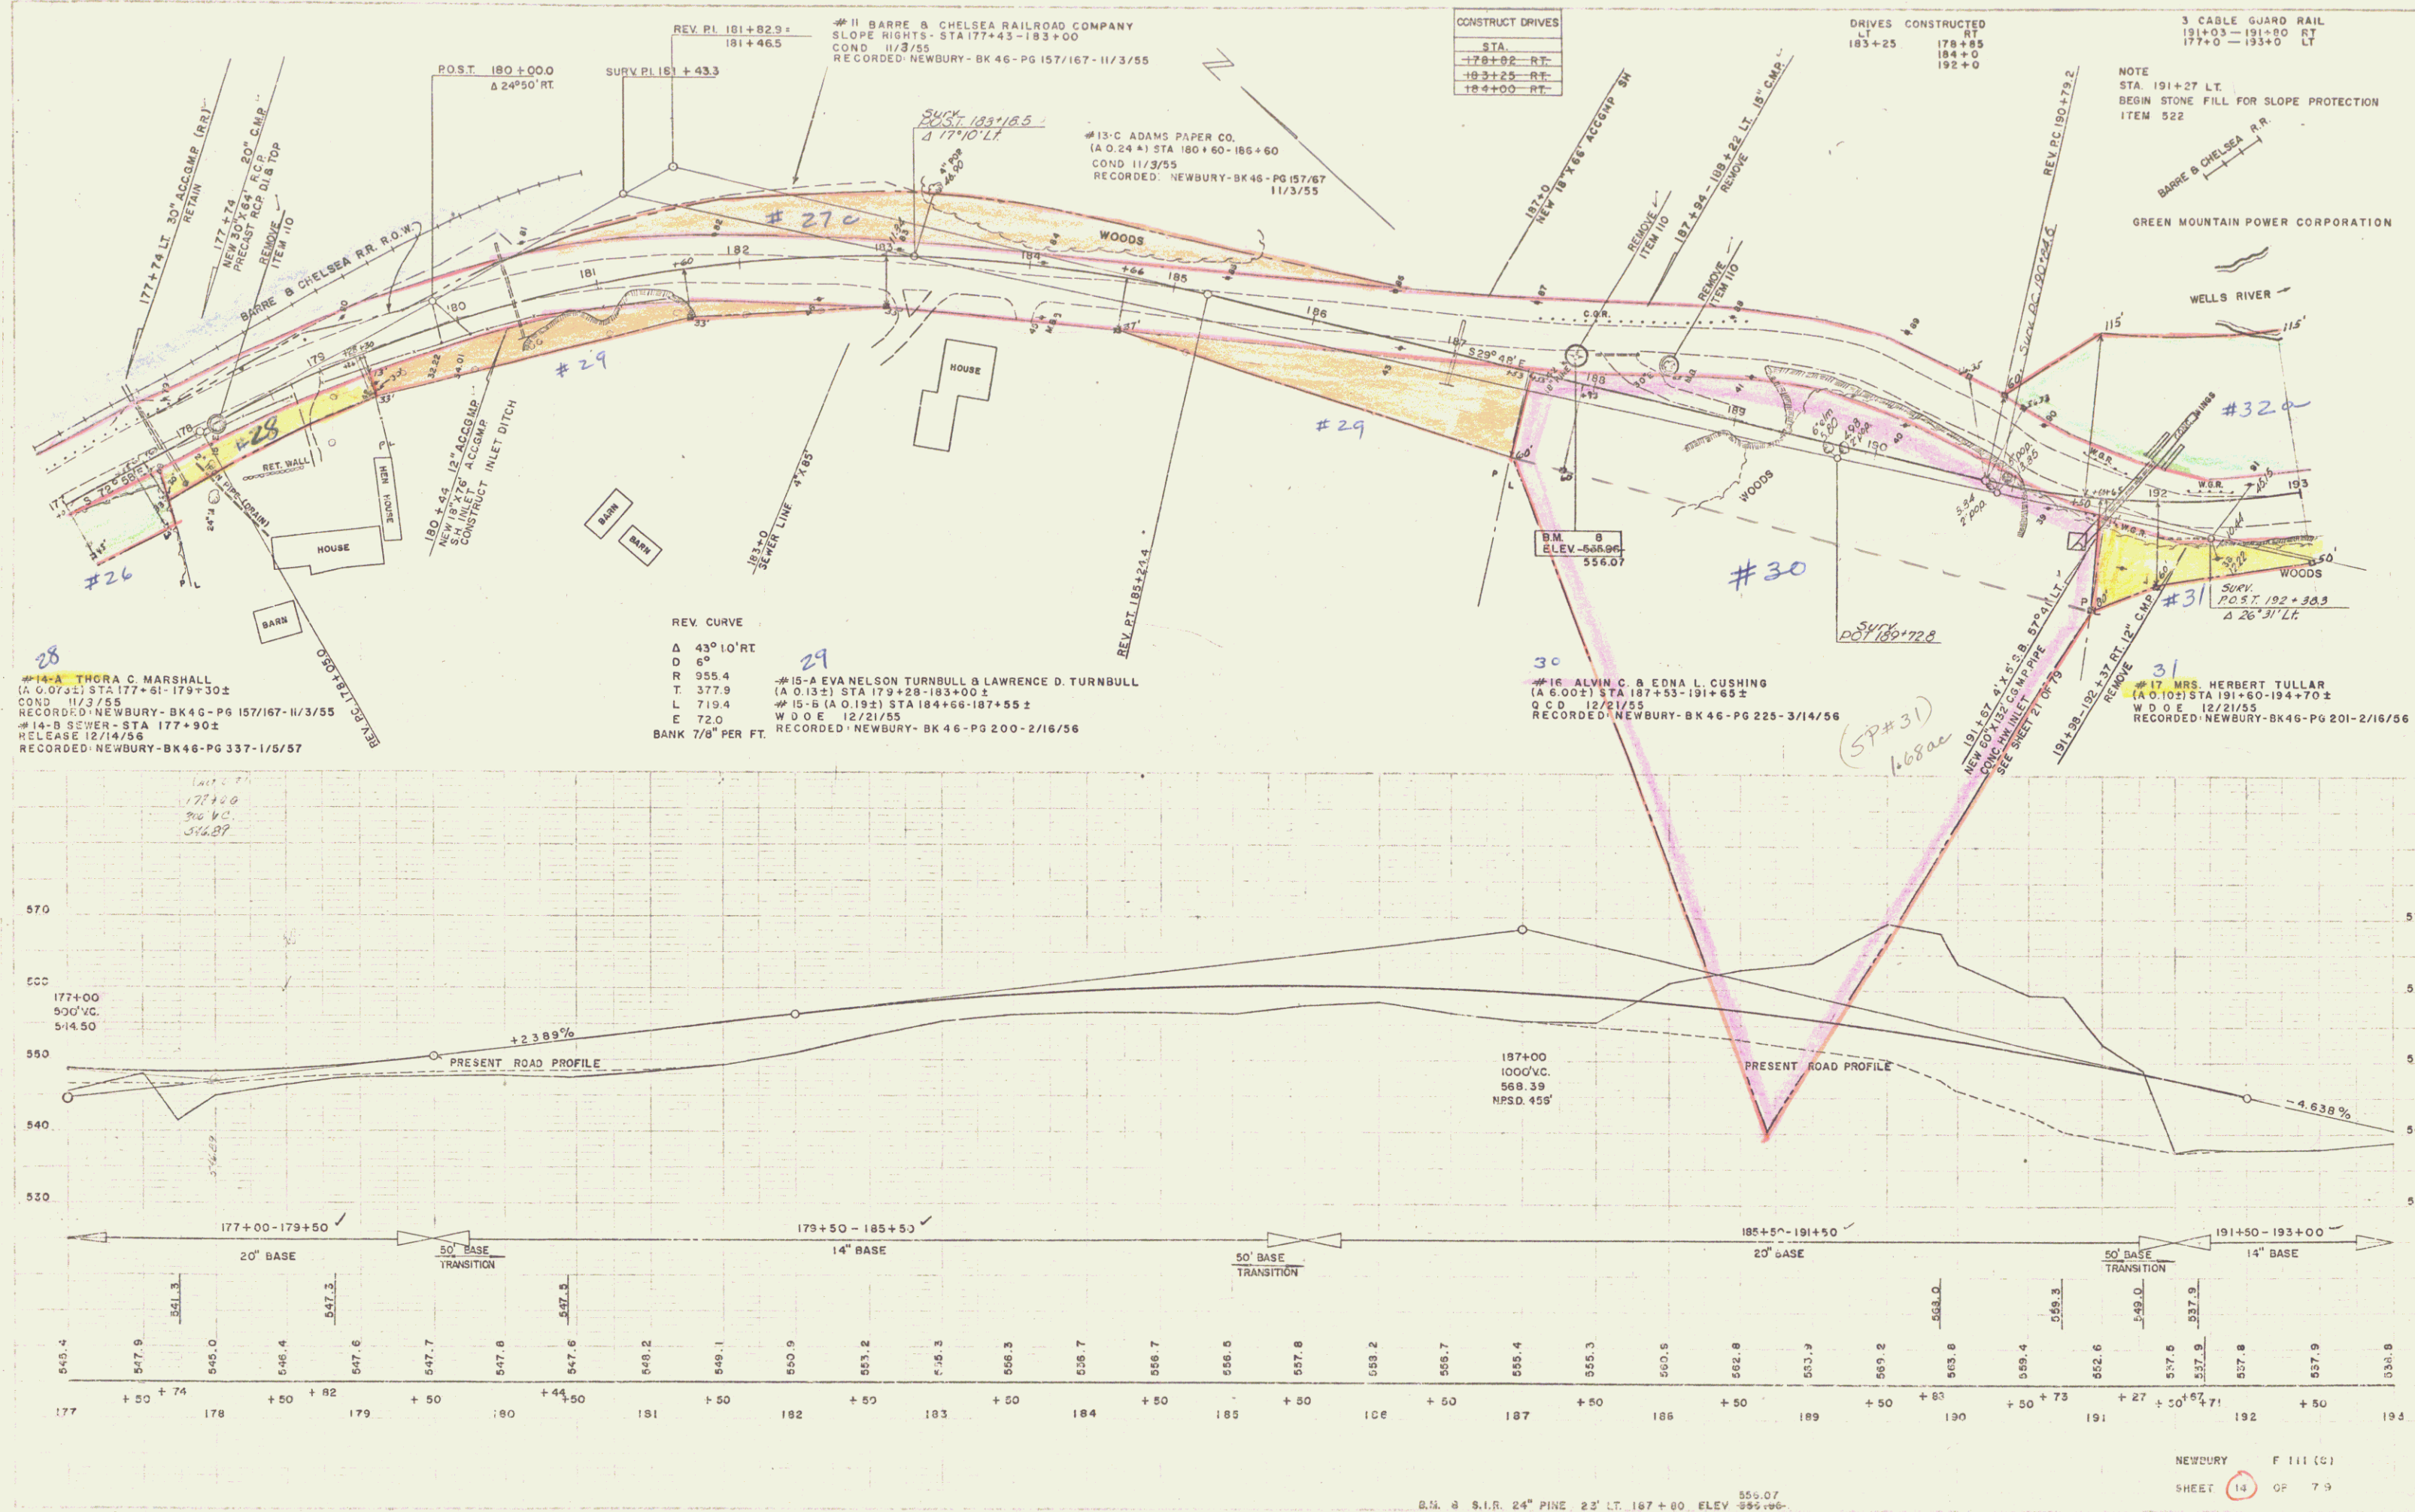


DRIVES CONSTRUCTED	ITEMS	ITEMS
235+0-229+50	RT	235+0
234+75-236+0	RT	


CONSTRUCT DRIVES	STA	POS
2-29+00-1T		
2-33+50-RT		
2-35+09-RT		
2-35+35-1T		
2-35+09-RT		
2-40+10-1T		

GRANITE SLOPE EDGING	ITEMS	ITEMS
238+60	239+01	RT
238+50	240+07	LT
239+17	239+73	RT
239+69	240+10	RT
239+77	239+90	RT
238+25	239+72	LT
238+25	240+10	RT
239+71	240+08	RT

TOPSOIL & SEEDING	ITEMS	ITEMS
238+50	239+01	RT
238+50	240+10	LT
239+17	239+90	RT
239+69	240+10	RT
239+77	239+90	RT
238+25	239+72	LT
238+25	240+10	RT
239+71	240+08	RT

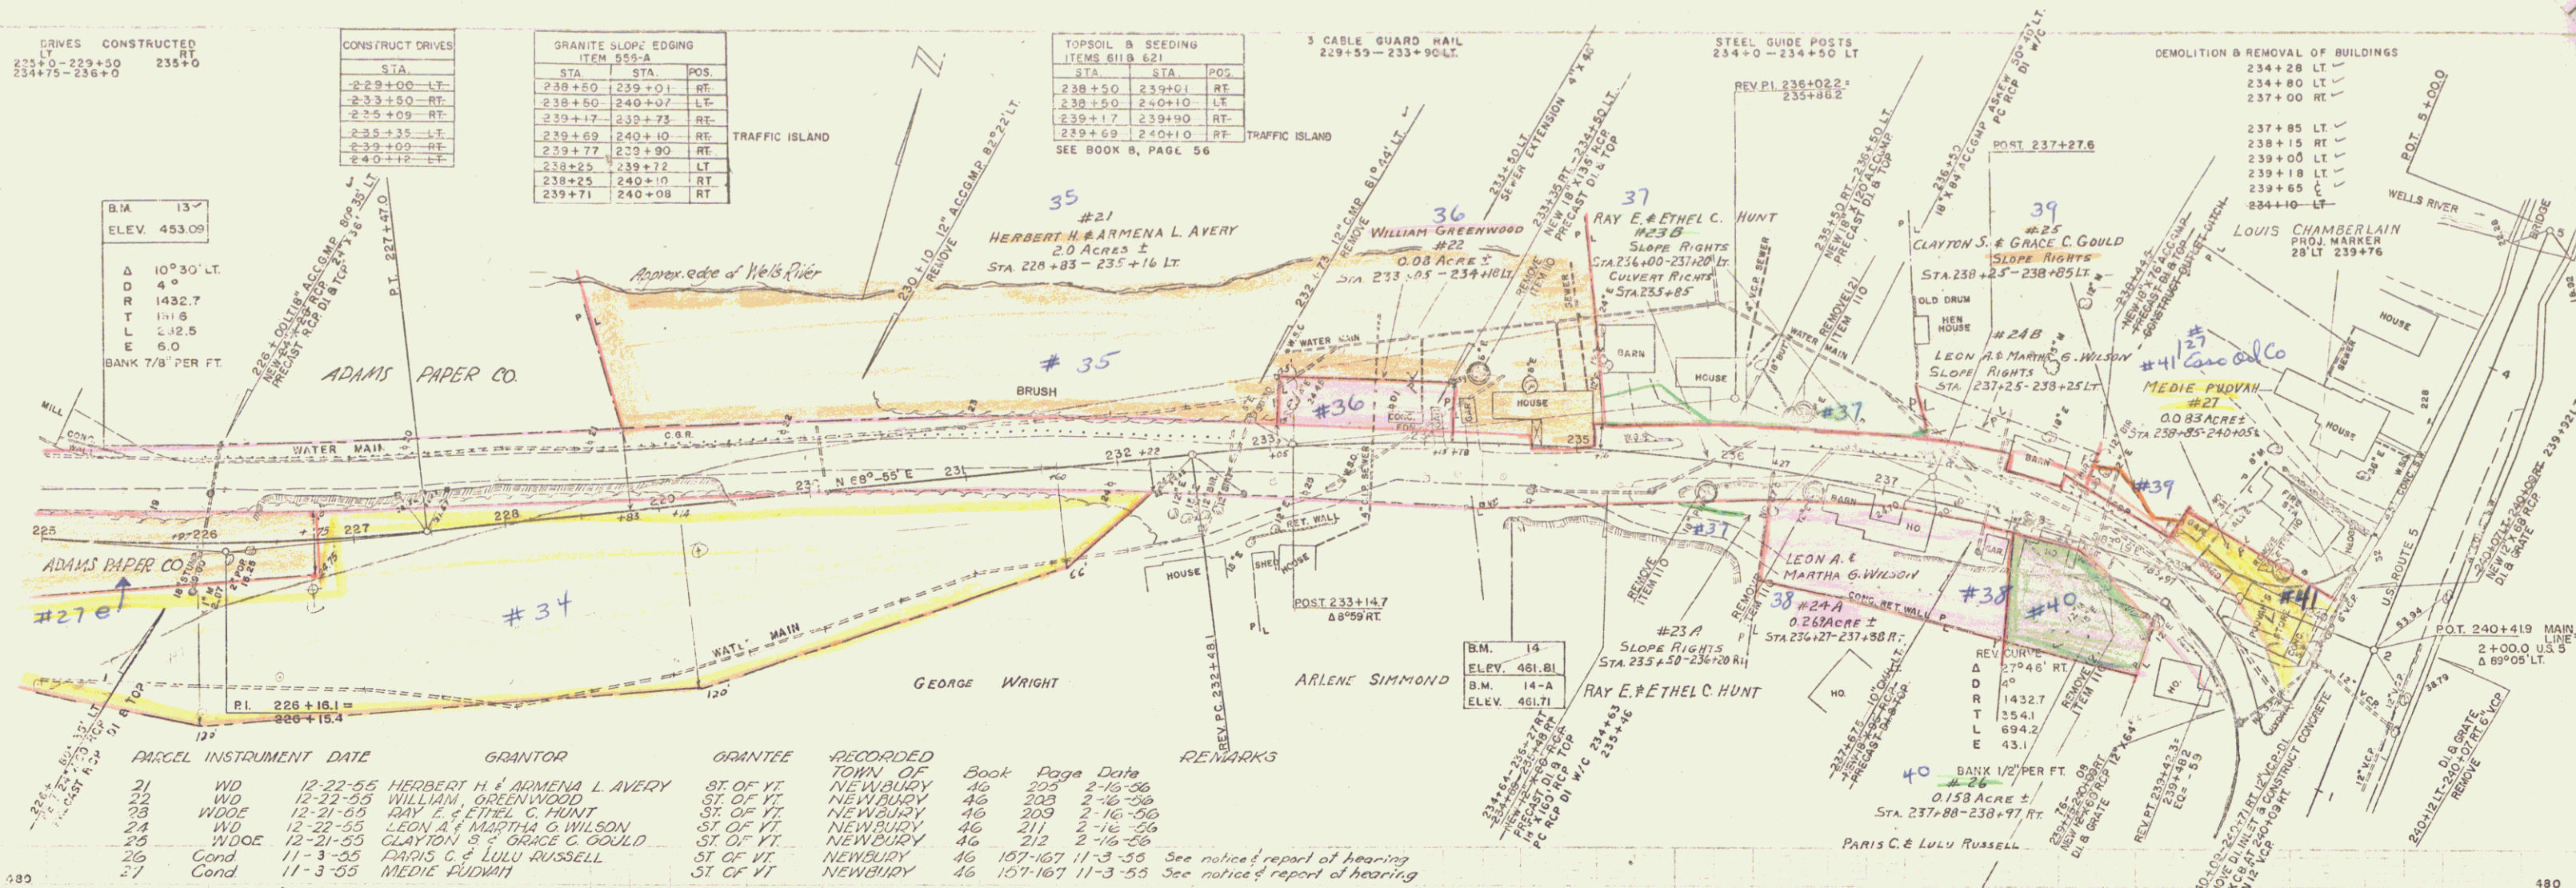

PARCEL	INSTRUMENT	DATE	GRANTOR	GRANTEE	RECORDED	BOOK	PAGE	DATE	REMARKS
21	WD	12-22-55	HERBERT H. & ARMINA L. AVERY	ST. OF VT.	NEWBURY	46	205	2-16-56	
22	WD	12-22-55	WILLIAM GREENWOOD	ST. OF VT.	NEWBURY	46	209	2-16-56	
23	WD	12-21-55	RAY E. & ETHEL C. HUNT	ST. OF VT.	NEWBURY	46	211	2-16-56	
24	WD	12-22-55	LEON A. & MARTHA G. WILSON	ST. OF VT.	NEWBURY	46	212	2-16-56	
25	WD	12-21-55	CLAYTON S. & GRACE C. GOULD	ST. OF VT.	NEWBURY	46	107-107	11-3-55	See notice & report of hearing
26	Cond	11-3-55	PARIS C. & LULU RUSSELL	ST. OF VT.	NEWBURY	46	107-107	11-3-55	See notice & report of hearing
27	Cond	11-3-55	MEDIE RUDMAN	ST. OF VT.	NEWBURY	46	107-107	11-3-55	See notice & report of hearing

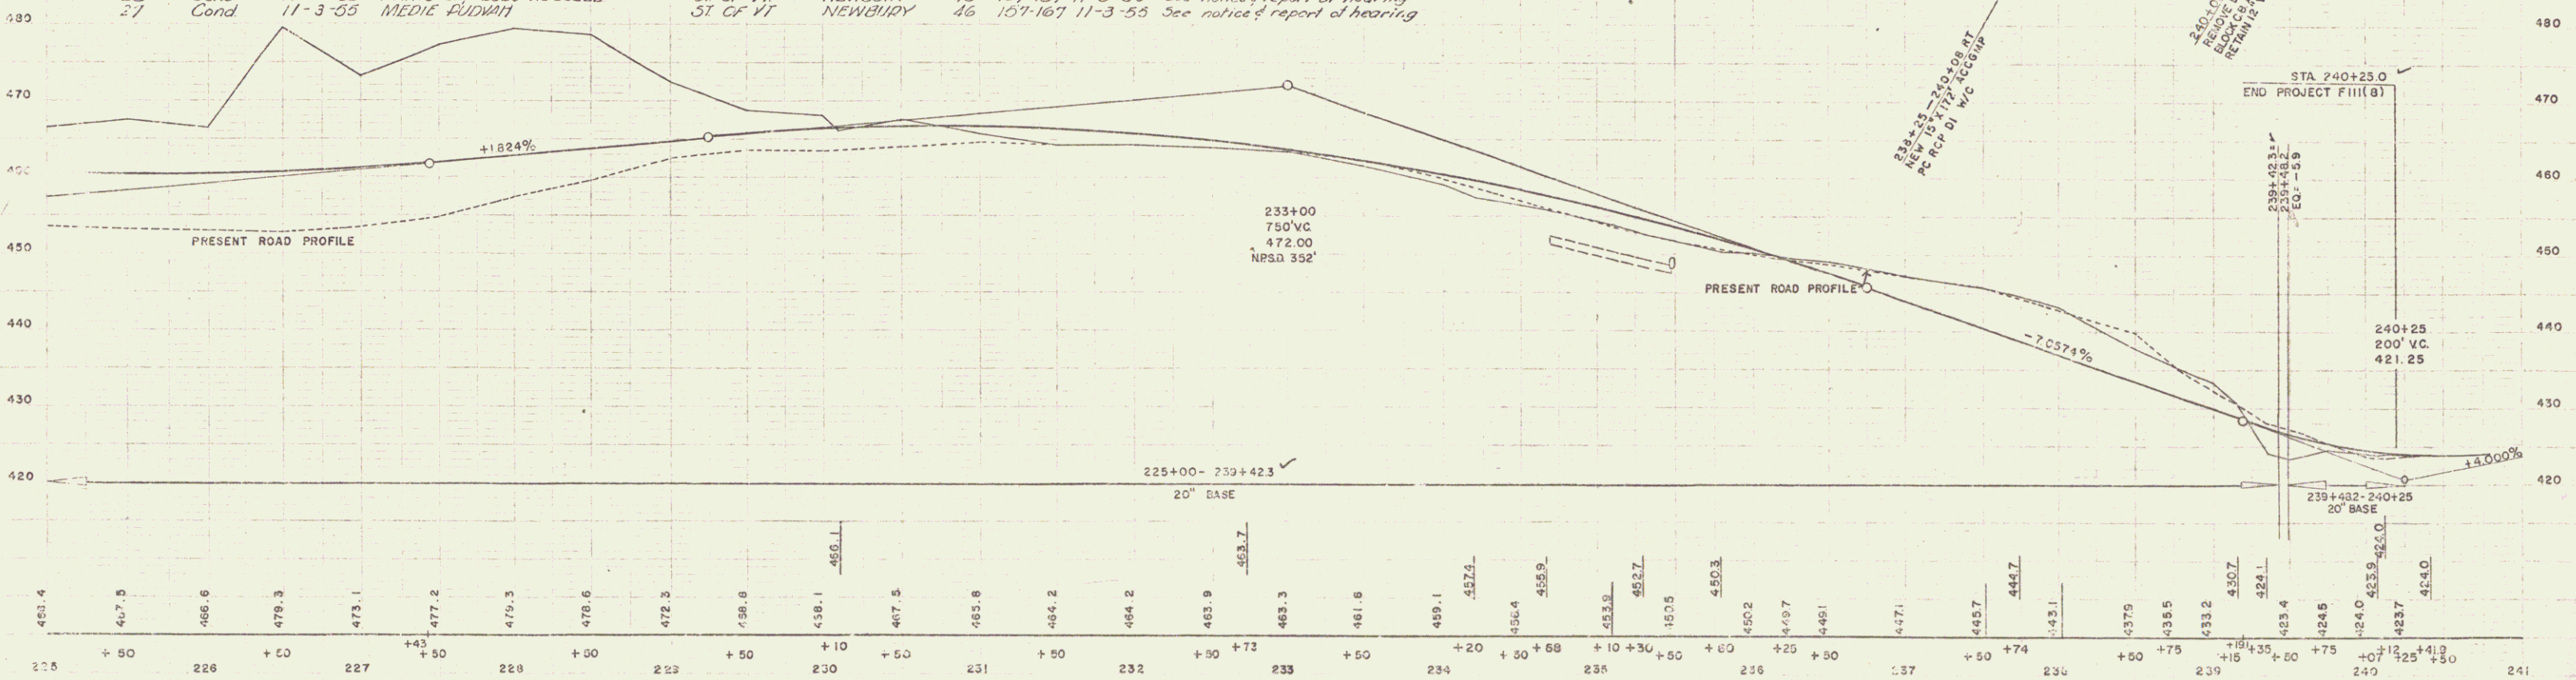

P.M. 13 SPOT ON CONCRETE WALL 62' LT. 225+38 ELEV. 453.09

B.M. 14-A SPOT ON LEDGE 48' RT. 234+48 ELEV. 461.71
B.M. 14 SPOT ON LEDGE 48' RT. 234+48 ELEV. 461.01

NEWBURY F 111 (8)
SHEET 17 OF 79

