


INDEX OF SHEETS	
SHEET NO.	TITLE PAGE
1	TITLE PAGE
2	TYPICAL CROSS SECTION OF IMPROVEMENT (SINGLE TACK COAT OF REFINED TAR AND BLADE MIX)
3	QUANTITY SHEET (ITEM)
4	QUANTITY SHEET (RAINAGE)
5-8	EARTHWORK SHEETS
9	STANDARD SHEET B-2 (BANKING TABLES)
10	STANDARD SHEET B-5 (TURNOUTS)
11	STANDARD SHEET B-6 (MUCK EXCAVATION)
12	STANDARD SHEET D-1 (PRECAST R.C.P. DROP INLET W/COVER)
13	STANDARD SHEET D-2 (C.R.M., HEADWALLS, AND UNDERDRAIN)
14-16	STANDARD SHEETS E-1 & E-9 (BARRICADES, SIGNS AND LIGHTS)
17	STANDARD SHEET G-2 (TWO CABLE GUARD RAIL)
18	STANDARD SHEET G-2 (CABLE END ANCHORAGE)
19	STANDARD SHEET G-4 (MARKER POSTS, GUIDE POSTS)
20	STANDARD SHEET J-1 (PROJECT MARKERS, BOUNDARY MARKERS)
21	CHANNEL SECTIONS
22-23	PLAN AND PROFILE SHEETS
24-52	CROSS SECTION SHEETS
53-54	BANKING TRANSITIONS

STATE OF VERMONT DEPARTMENT OF HIGHWAYS Proposed Improvement

TOWNS OF WESTON AND MOUNT HOLLY COUNTIES OF WINDSOR AND RUTLAND


VERMONT ROUTE #8 WESTON-MOUNT HOLLY ROAD

BEGINNING AT A POINT APPROXIMATELY 0.6 MILES SOUTHERLY OF THE INTERSECTION OF VT. RTE. 100 AND VT. RTE. 8 AND EXTENDING NORTHERLY 3.134 MILES.
LENGTH OF PROJECT 16,546.6 FEET = 3.134 MILES

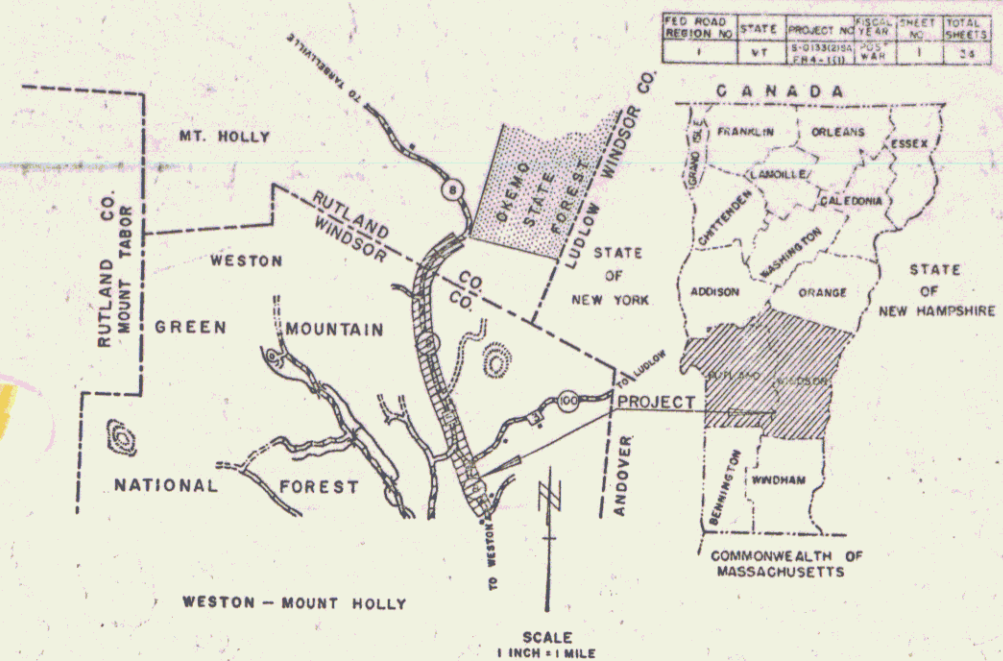

PROJECT NAME & NUMBER	TYPE	PAVEMENT AREA
WESTON-MT. HOLLY FH-4-1(I) & S-0133(2)SA	SINGLE TACK COAT OF REFINED TAR AND BLADE MIX PEA STONE SEAL WITH CUTBACK ASPHALT.	37,159 S.Y.
RECORD PLANS		
MATERIALS		
SUBBASE OF GRAVEL—JOHNSONS PIT—WESTON, VERMONT.		
REFINED TAR—OLD COLONY TAR CO.—WORCESTER, MASSACHUSETTS.		
CUTBACK ASPHALT—MOBIL OIL CO.—E. PROVIDENCE, RHODE ISLAND.		
PEA STONE FOR SEAL—WILLIAM E. DAILEY—MANCHESTER, VERMONT.		
REINFORCED CONCRETE PIPE—AMERICAN MARIETTA CO.—WINDSOR, VERMONT.		
ASPH. CTD. CORR. GALV. METAL PIPE—NEW ENGLAND METAL CULV. CO.—WHITE RIVER JCT., VT.		
CABLE GUARD RAIL, WOOD GUIDE & MARKER POSTS—S.T. GRISWOLD & CO. INC.—ESSEX JCT., VT.		
CONTR.—CALEDONIA SAND & GRAVEL CO. INC.		
ST. JOHNSBURY, VERMONT.		
RESIDENT ENGINEER—PAUL G. HORTON.		
INSPECTOR—A. J. COARSE		
RECORD PLANS—PAUL G. HORTON.		
DATED—MARCH 9, 1961.		
STARTED—MARCH 13, 1961.		
COMPLETED—OCTOBER 20, 1961.		
ACCEPTED—OCTOBER 20, 1961.		

1958	ADT	100
1960	ADT	150
1960	DHV	40
	V	50
	D	70 %
	T	8 %

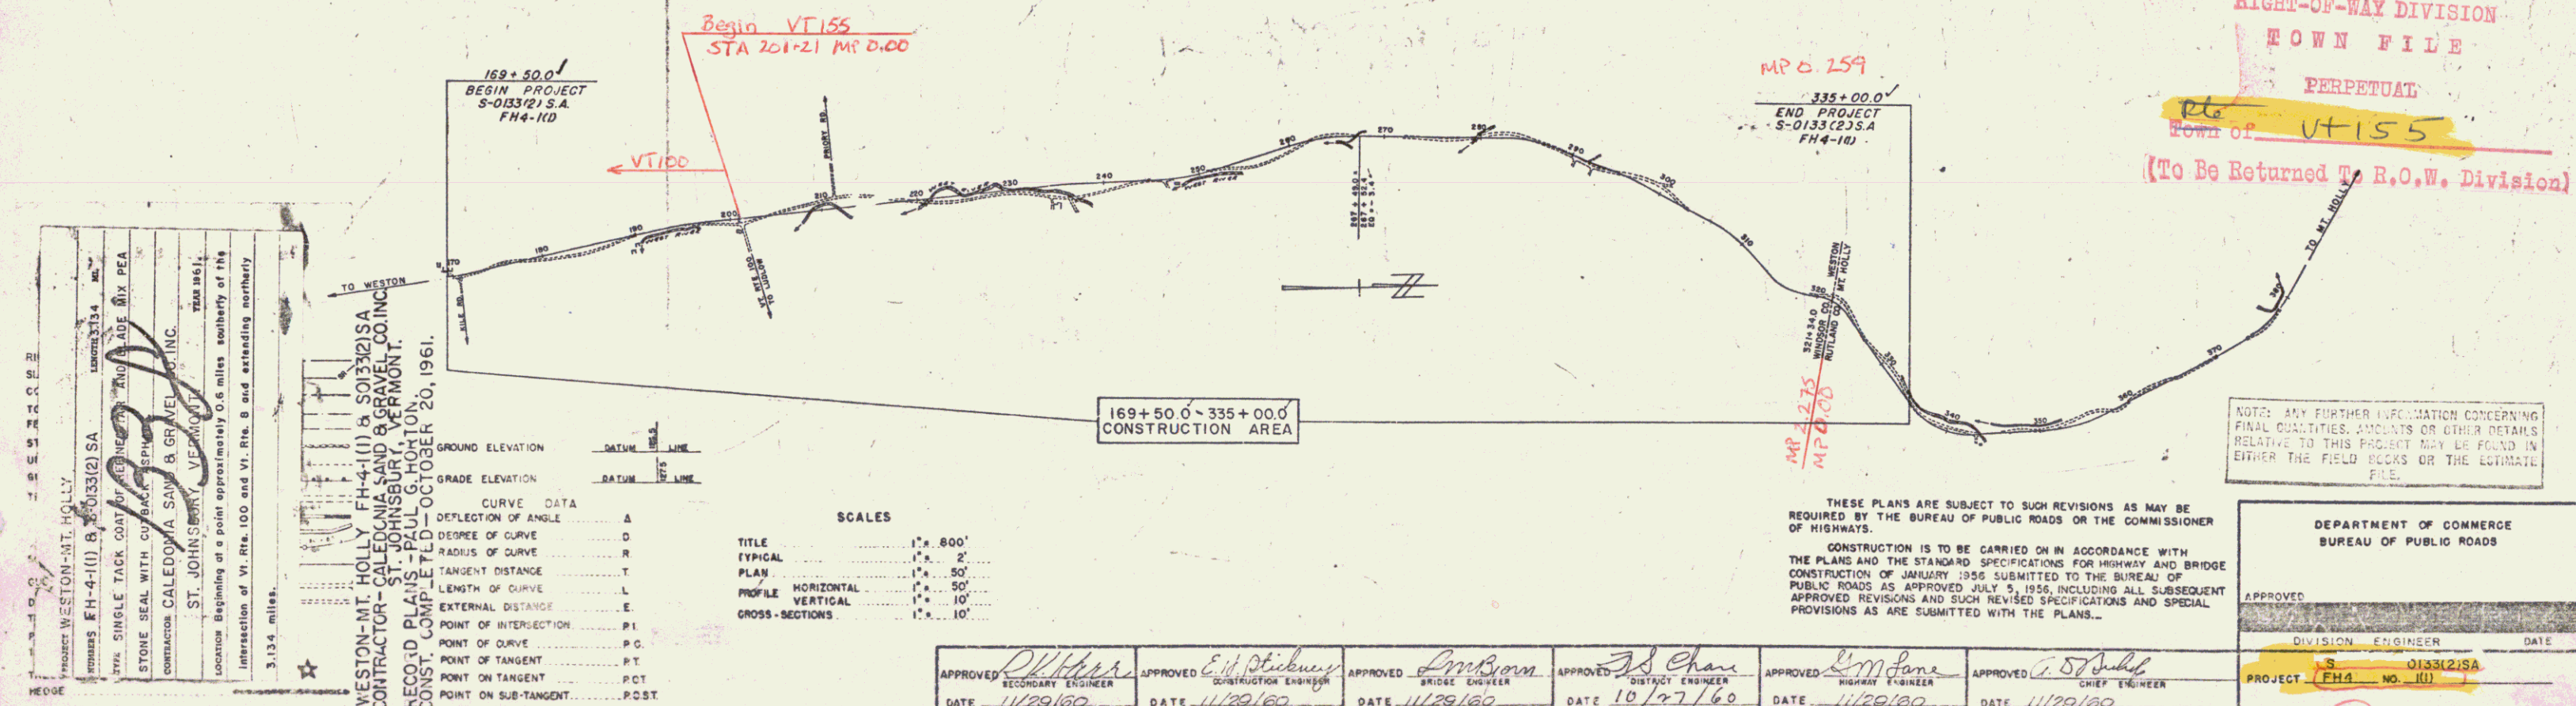

PROJECT WESTON-MT. HOLLY	LENGTH 3.134	MP
ITEMS FH-4-1(I) & S-0133(2)SA	16,546.6	169+50.0
TYPE SINGLE TACK COAT OF REFINED TAR AND BLADE MIX PEA STONE SEAL WITH CUTBACK ASPHALT.		
CONTRACTOR—CALEDONIA SAND & GRAVEL CO. INC.		
ST. JOHNSBURY, VERMONT.		
Location Beginning at a point approximately 0.6 miles southerly of the intersection of VT. Rte. 100 and VT. Rte. 8 and extending northerly 3.134 miles.		

WESTON-MT. HOLLY FH-4-1(I) & S-0133(2)SA	
CONTRACTOR—CALEDONIA SAND & GRAVEL CO. INC.	
ST. JOHNSBURY, VERMONT.	
COMPLETED OCTOBER 20, 1961.	
RECORD PLANS—PAUL G. HORTON.	
DATE—OCTOBER 20, 1961.	
LOCATION BEGINNING AT A POINT APPROXIMATELY 0.6 MILES SOUTHERLY OF THE INTERSECTION OF VT. RTE. 100 AND VT. RTE. 8 AND EXTENDING NORTHERLY 3.134 MILES.	
SCALE	
TITLE 1" = 800'	
TYPICAL 1" = 2'	
PLAN 1" = 50'	
PROFILE HORIZONTAL 1" = 10'	
GROSS SECTIONS 1" = 10'	
CURVE DATA	
DEFLECTION OF ANGLE	A
DEGREE OF CURVE	D
RADIUS OF CURVE	R
TANGENT DISTANCE	T
LENGTH OF CURVE	L
EXTERNAL DISTANCE	E
POINT OF INTERSECTION	P.I.
POINT OF CURVE	P.C.
POINT OF TANGENT	P.T.
POINT ON TANGENT	P.O.T.
POINT ON SUB-TANGENT	P.O.S.T.

APPROVED <i>[Signature]</i> DATE 11/29/60	APPROVED <i>[Signature]</i> DATE 11/29/60	APPROVED <i>[Signature]</i> DATE 11/29/60	APPROVED <i>[Signature]</i> DATE 10/27/60	APPROVED <i>[Signature]</i> DATE 11/29/60	APPROVED <i>[Signature]</i> DATE 11/29/60
SECONDARY ENGINEER	BRIDGE ENGINEER	DISTRICT ENGINEER	REGIONAL ENGINEER	CORRESPONDENT	
SUBMITTED BY ORDER OF THE STATE HIGHWAY BOARD					
DEPARTMENT OF COMMERCE BUREAU OF PUBLIC ROADS					
APPROVED <i>[Signature]</i> DATE 11/29/60					
PROJECT FH-4 NO. 1(I)					
SHEET 1 OF 54 SHEETS					


NOTES: ANY FURTHER INFORMATION CONCERNING FINAL QUANTITIES, AMOUNTS OR OTHER DETAILS RELATIVE TO THIS PROJECT MAY BE FOUND IN EITHER THE FIELD BOOKS OR THE ESTIMATE FILE.


RIGHT-OF-WAY DIVISION
TOWN FILE
PERPETUAL
To Be Returned To R.O.W. Division

THESE PLANS ARE SUBJECT TO SUCH REVISIONS AS MAY BE REQUIRED BY THE BUREAU OF PUBLIC ROADS OR THE COMMISSIONER OF HIGHWAYS.
CONSTRUCTION IS TO BE CARRIED ON IN ACCORDANCE WITH THE PLANS AND THE STANDARD SPECIFICATIONS FOR HIGHWAY AND BRIDGE CONSTRUCTION OF JANUARY 1956 SUBMITTED TO THE BUREAU OF PUBLIC ROADS AS APPROVED JULY 5, 1956 INCLUDING ALL SUBSEQUENT APPROVED REVISIONS AND SUCH REVISED SPECIFICATIONS AND SPECIAL PROVISIONS AS ARE SUBMITTED WITH THE PLANS.

PLAN
 DATE: 11/15/54
 DRAWN BY: J. S. GIBBS
 CHECKED BY: J. S. GIBBS
 PROJECT: WESTON-MT HOLLY
 SHEET: 23 OF 54



Profile
 DATE: 11/15/54
 DRAWN BY: J. S. GIBBS
 CHECKED BY: J. S. GIBBS
 PROJECT: WESTON-MT HOLLY
 SHEET: 23 OF 54

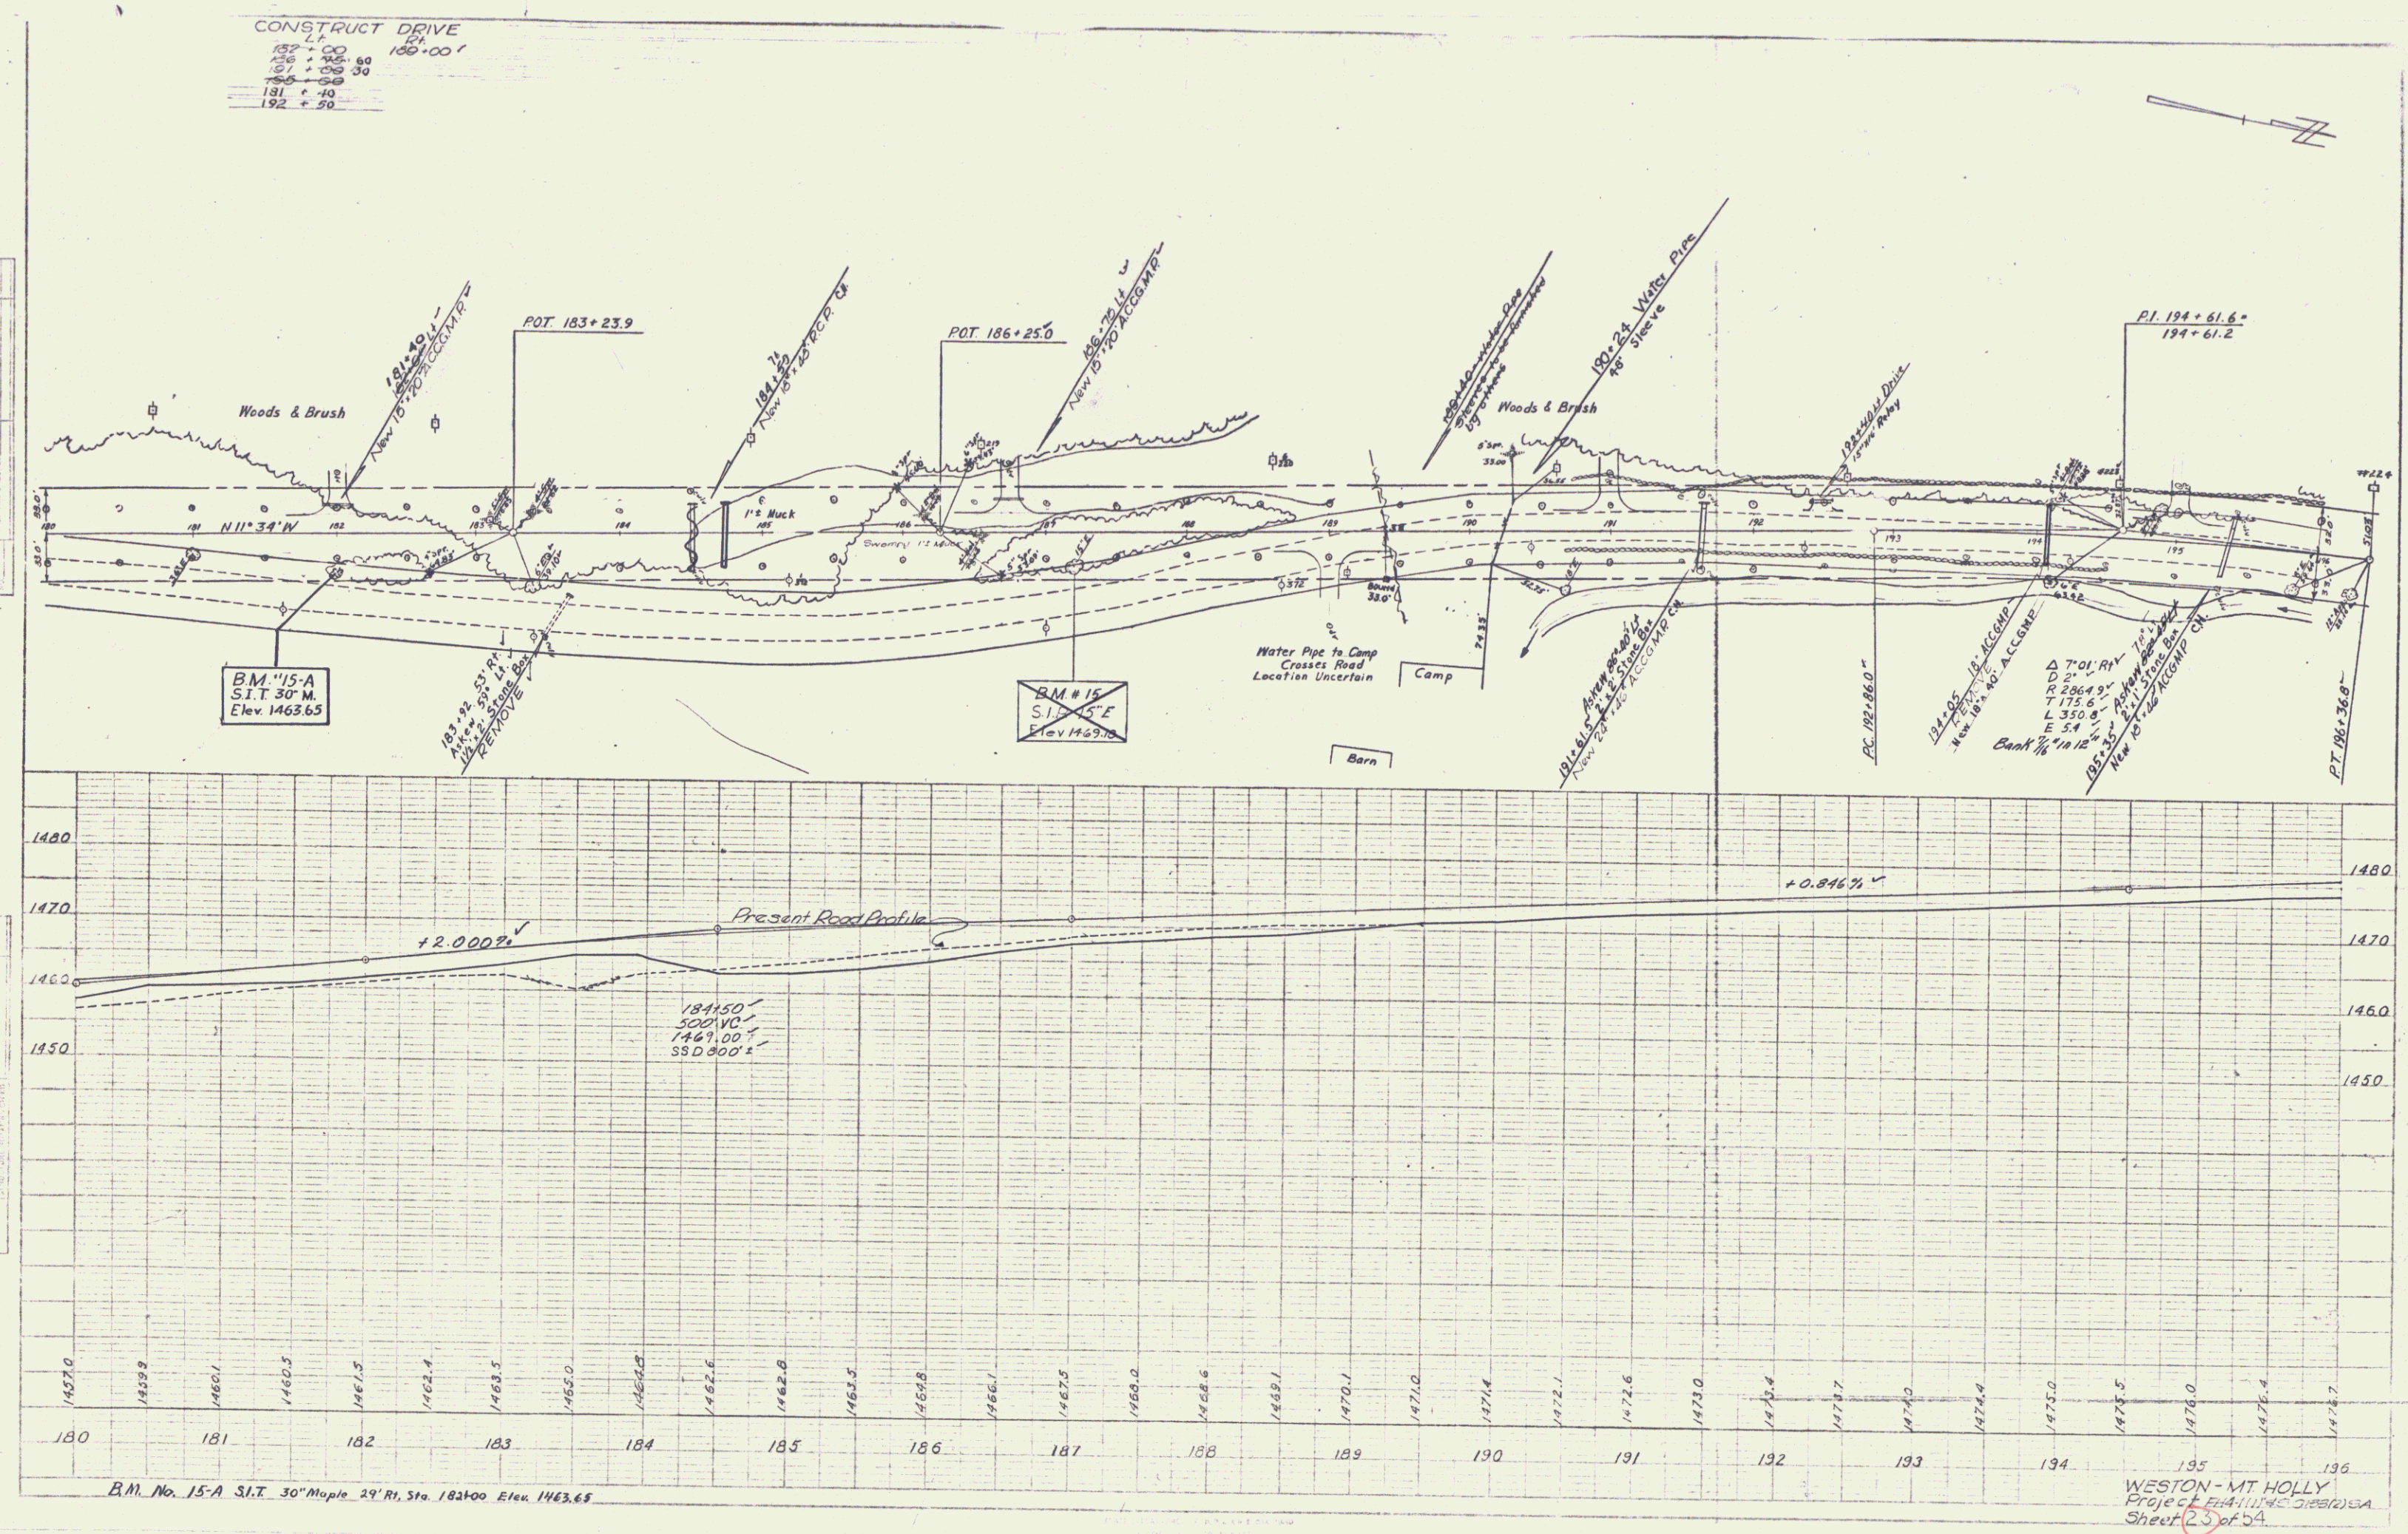

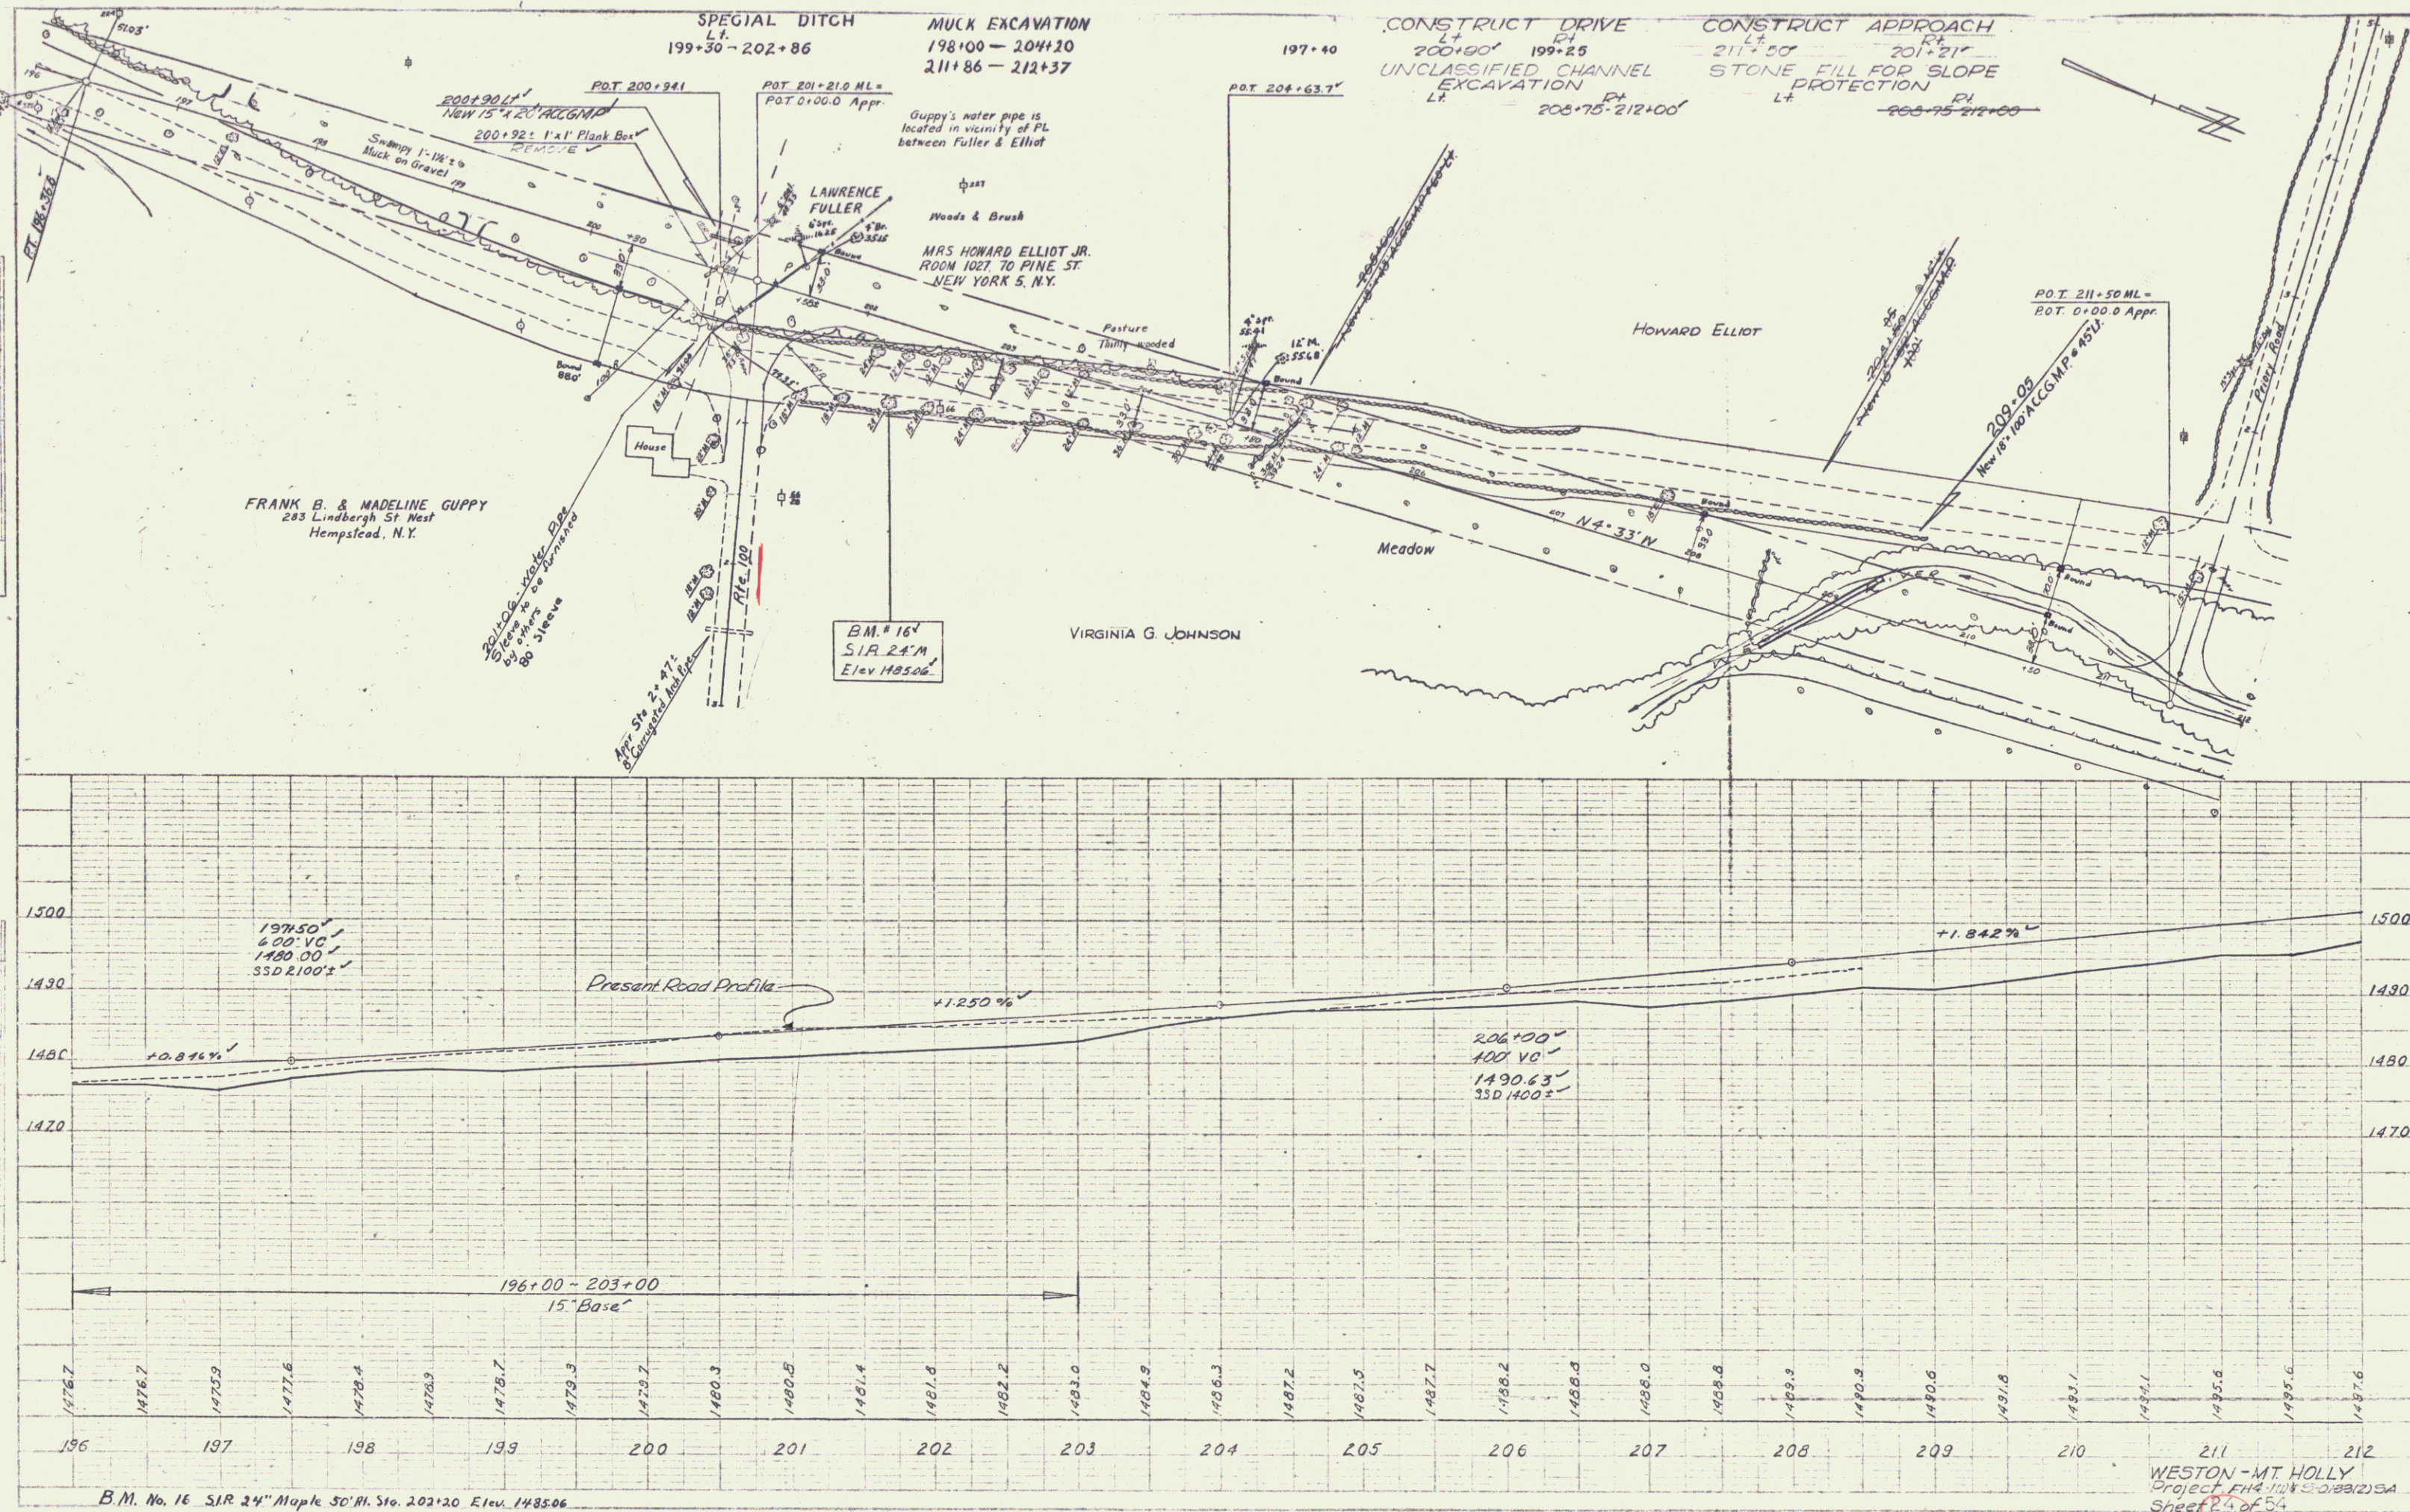


PLAN	DATE	BY	CHKD
DESIGNED			
PLOTTED			
CHECKED			
APPROVED			
NO.			

PROFILE	DATE	BY	CHKD
DESIGNED			
PLOTTED			
CHECKED			
APPROVED			
NO.			

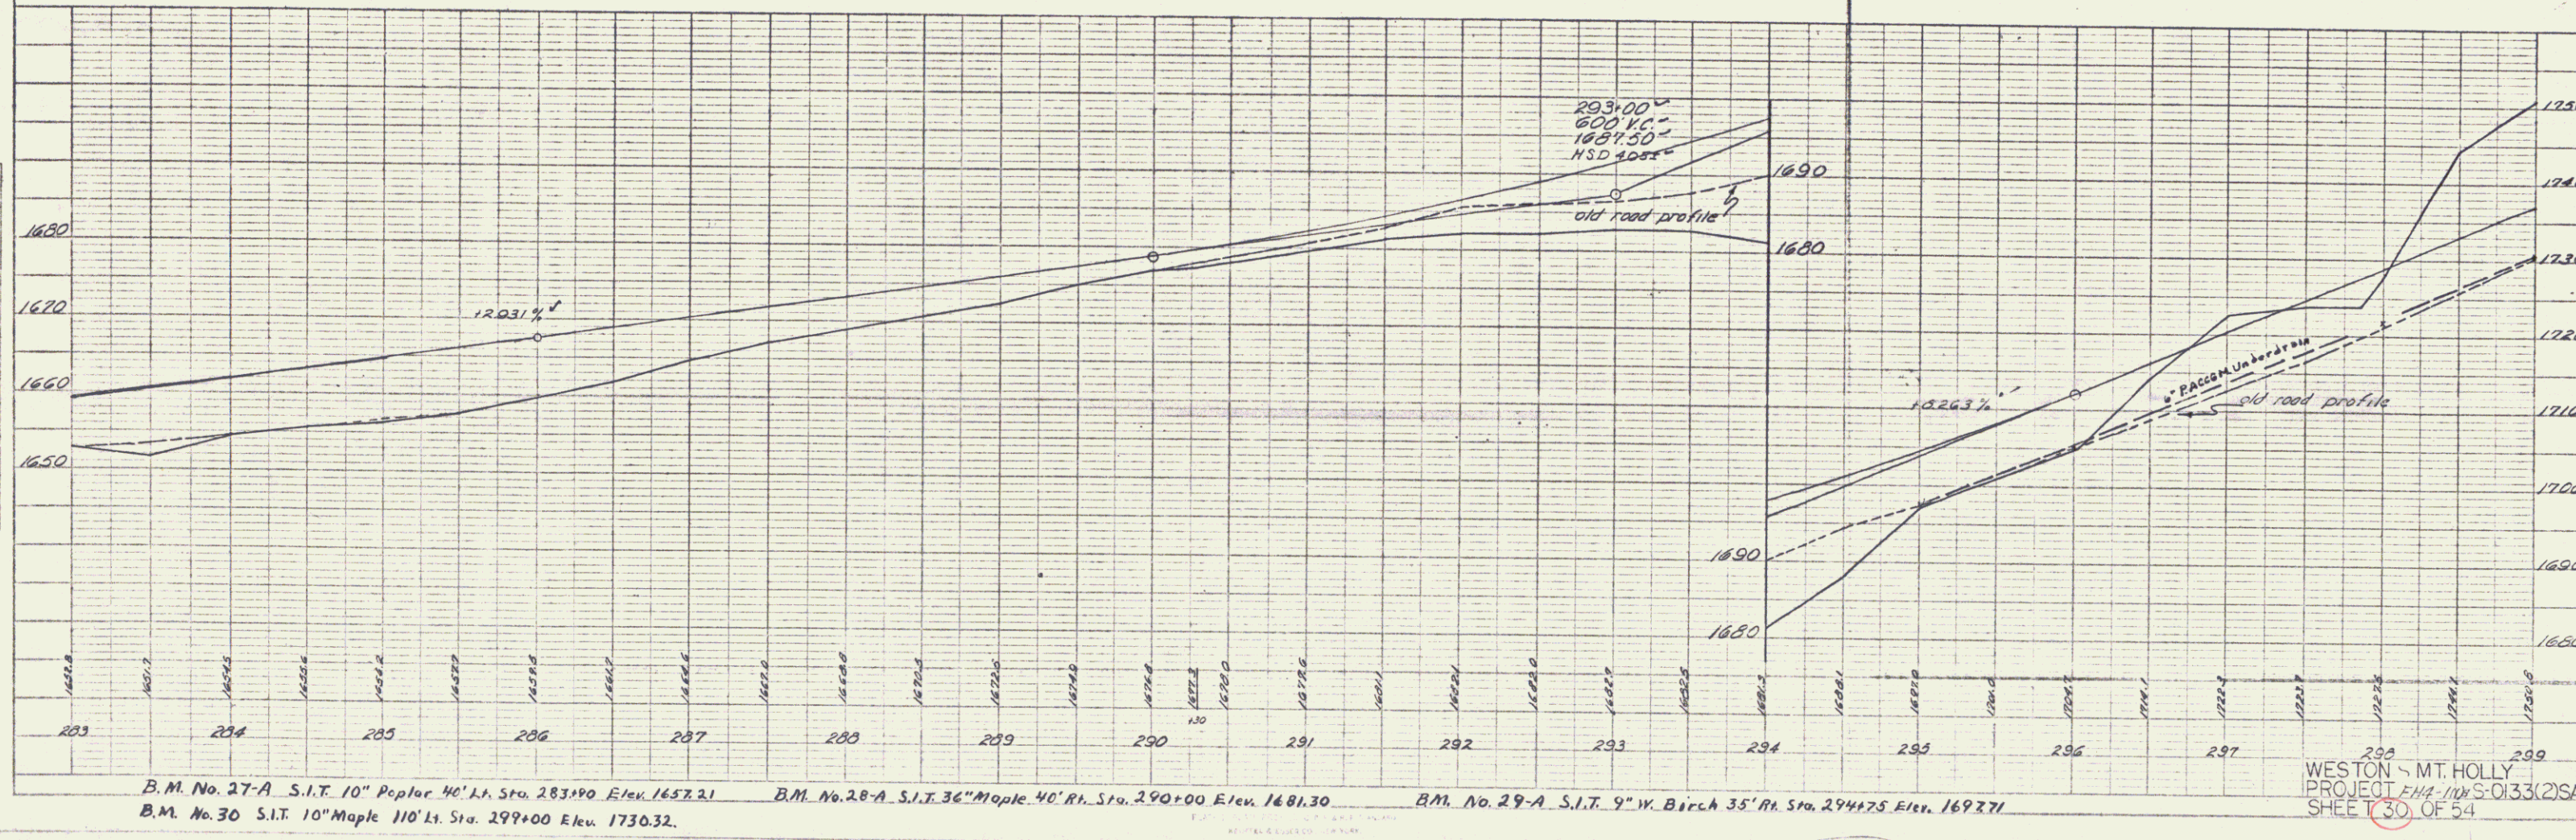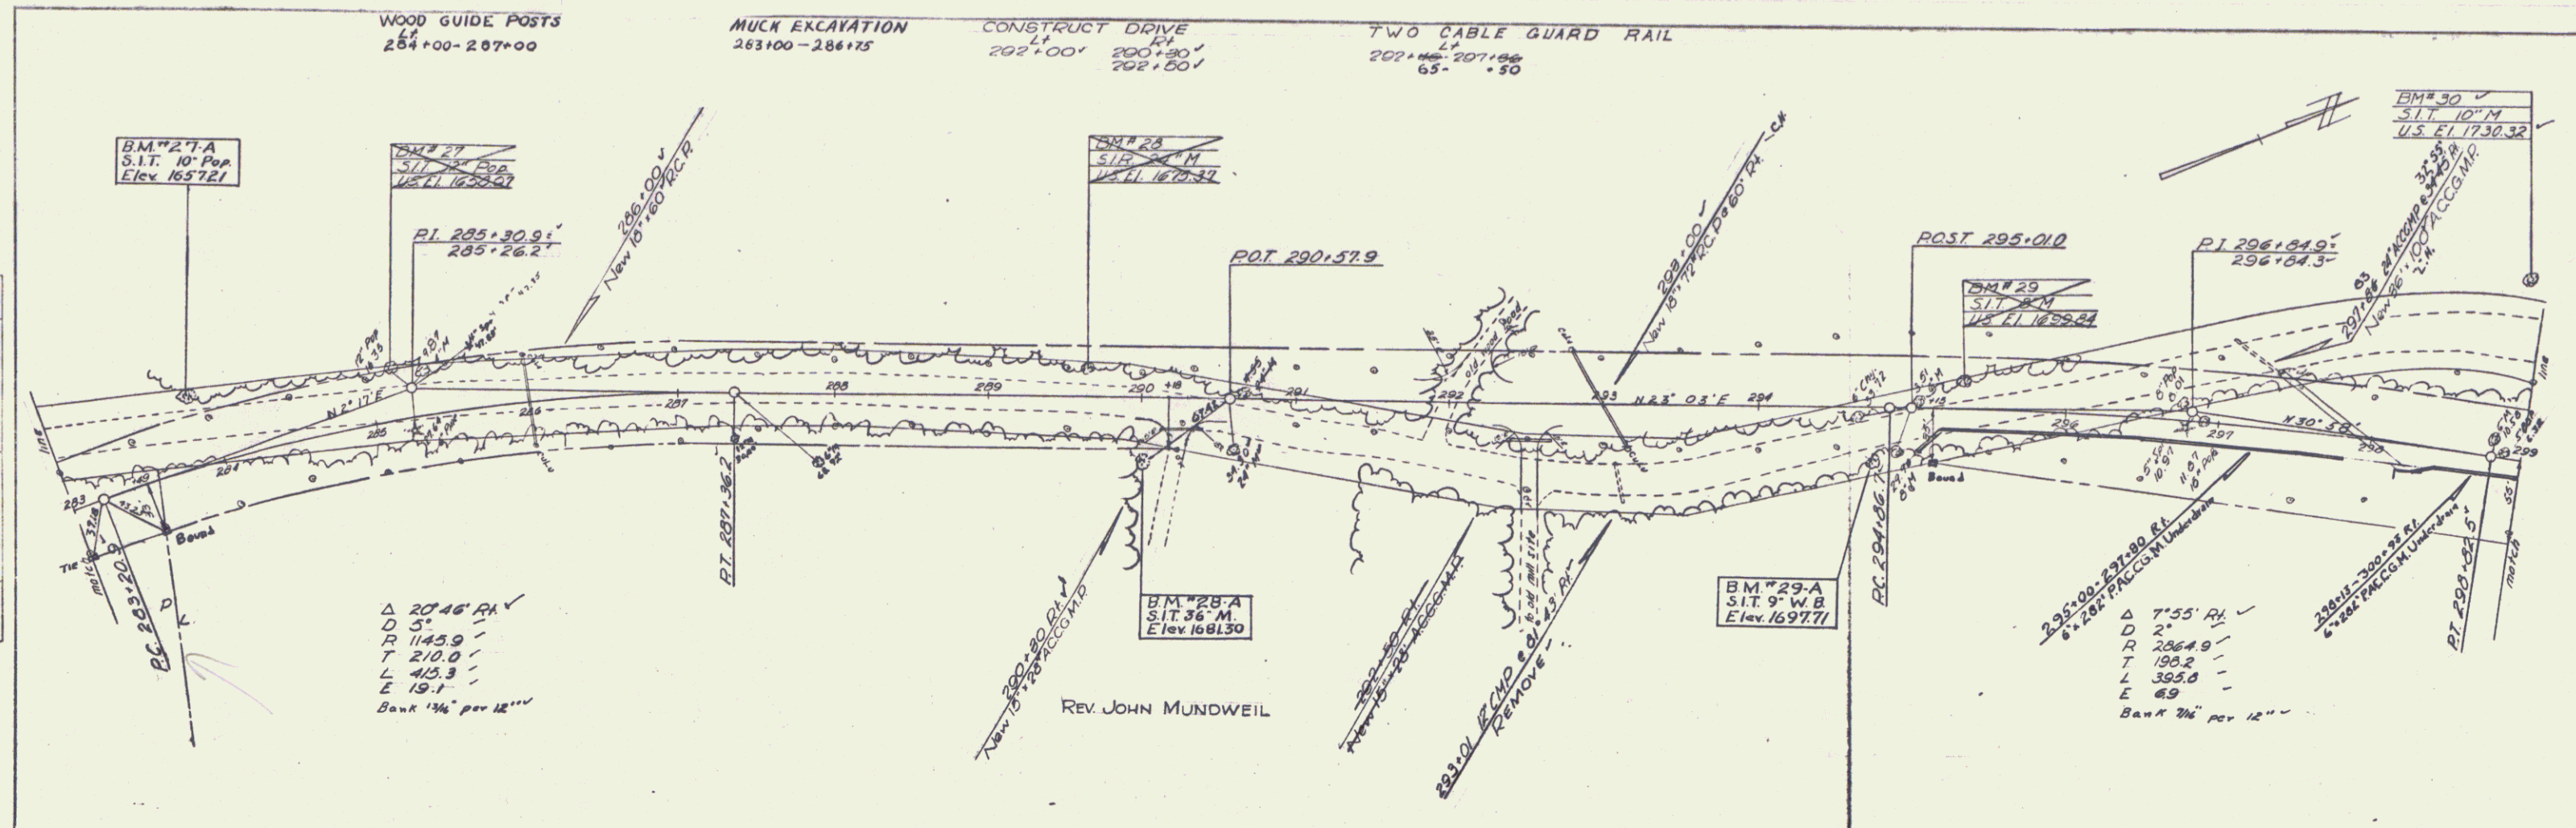


PLAN	DATE	BY	CHKD	APP'D
3/16	3/16	3/16	3/16	3/16
3/16	3/16	3/16	3/16	3/16
3/16	3/16	3/16	3/16	3/16
3/16	3/16	3/16	3/16	3/16



PROFILE	DATE	BY	CHKD	APP'D
3/16	3/16	3/16	3/16	3/16
3/16	3/16	3/16	3/16	3/16
3/16	3/16	3/16	3/16	3/16
3/16	3/16	3/16	3/16	3/16

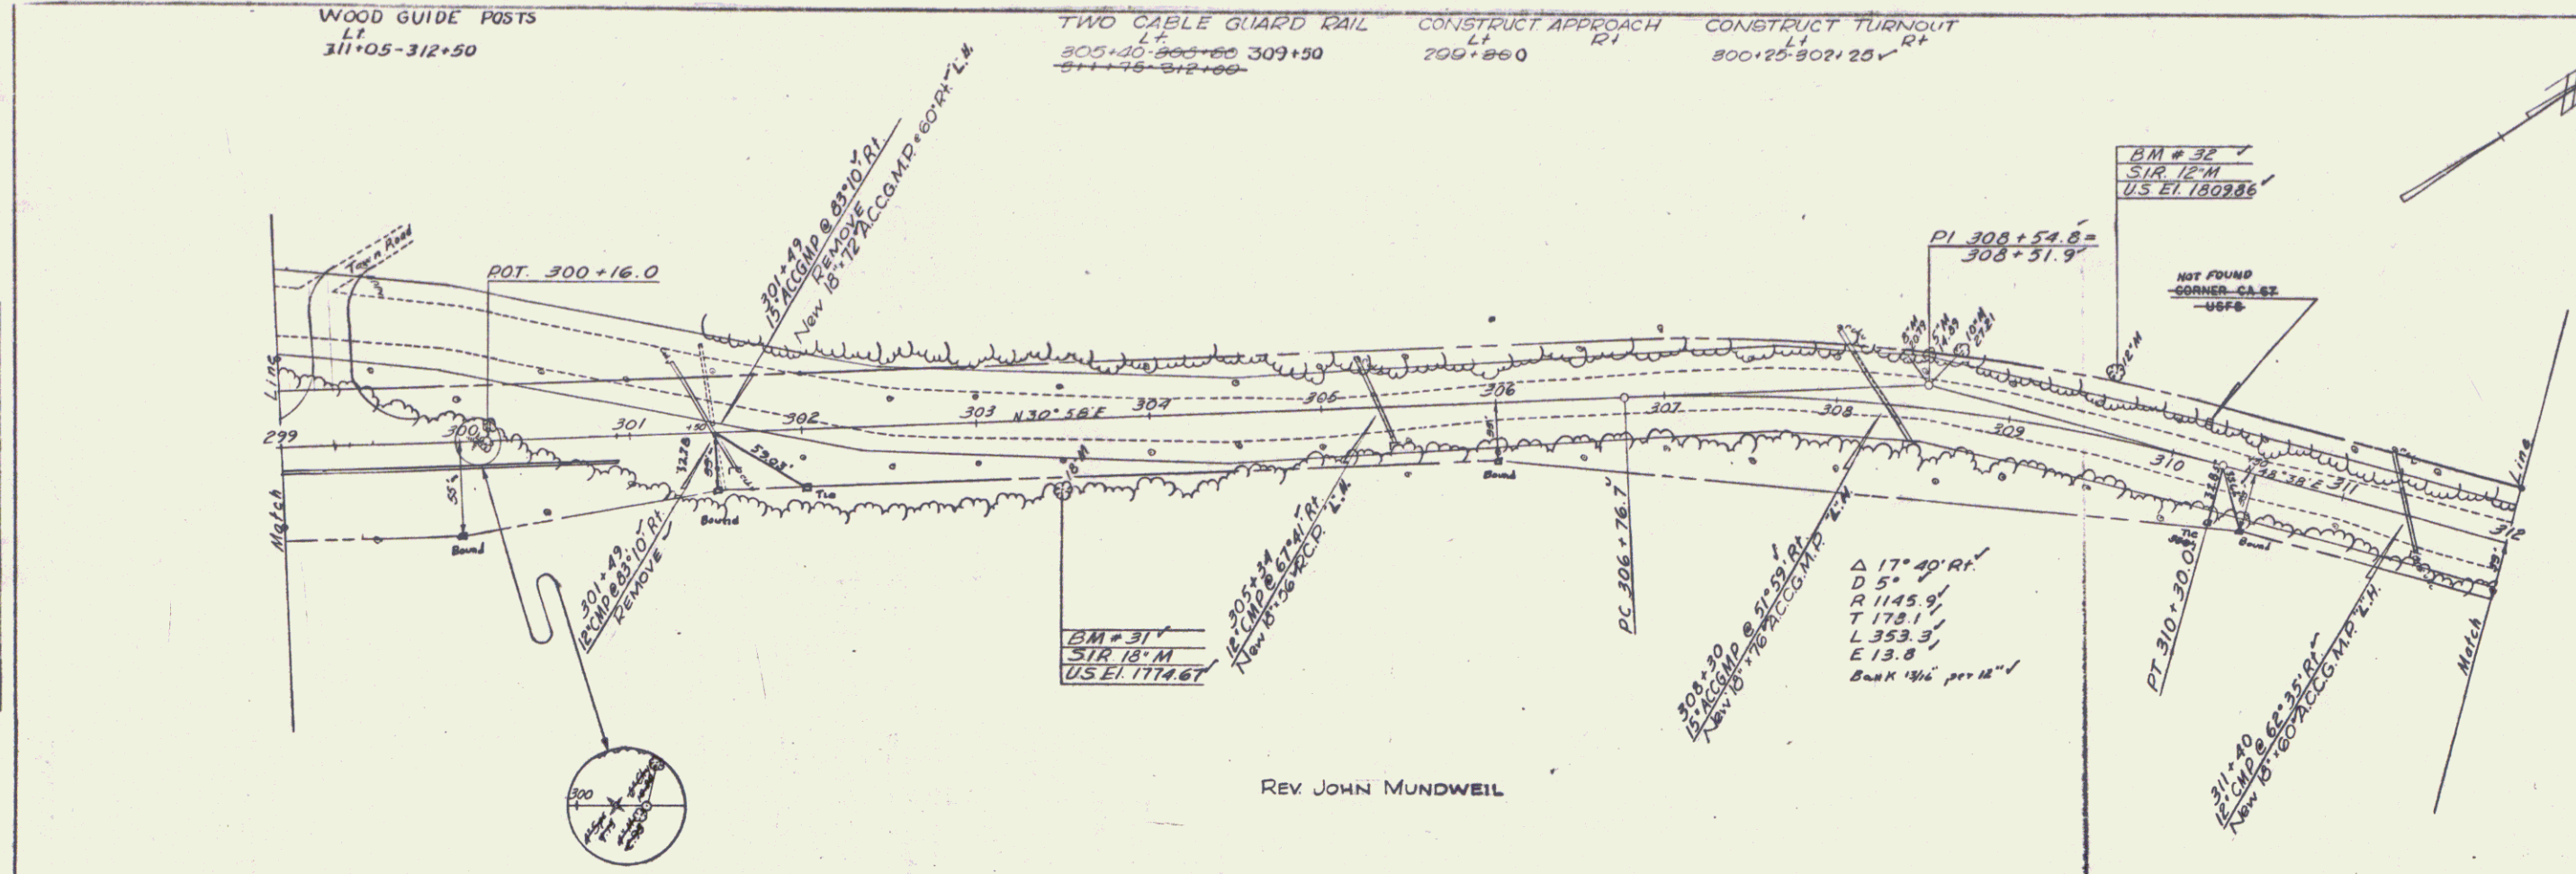

REV. JOHN MUNDWEIL

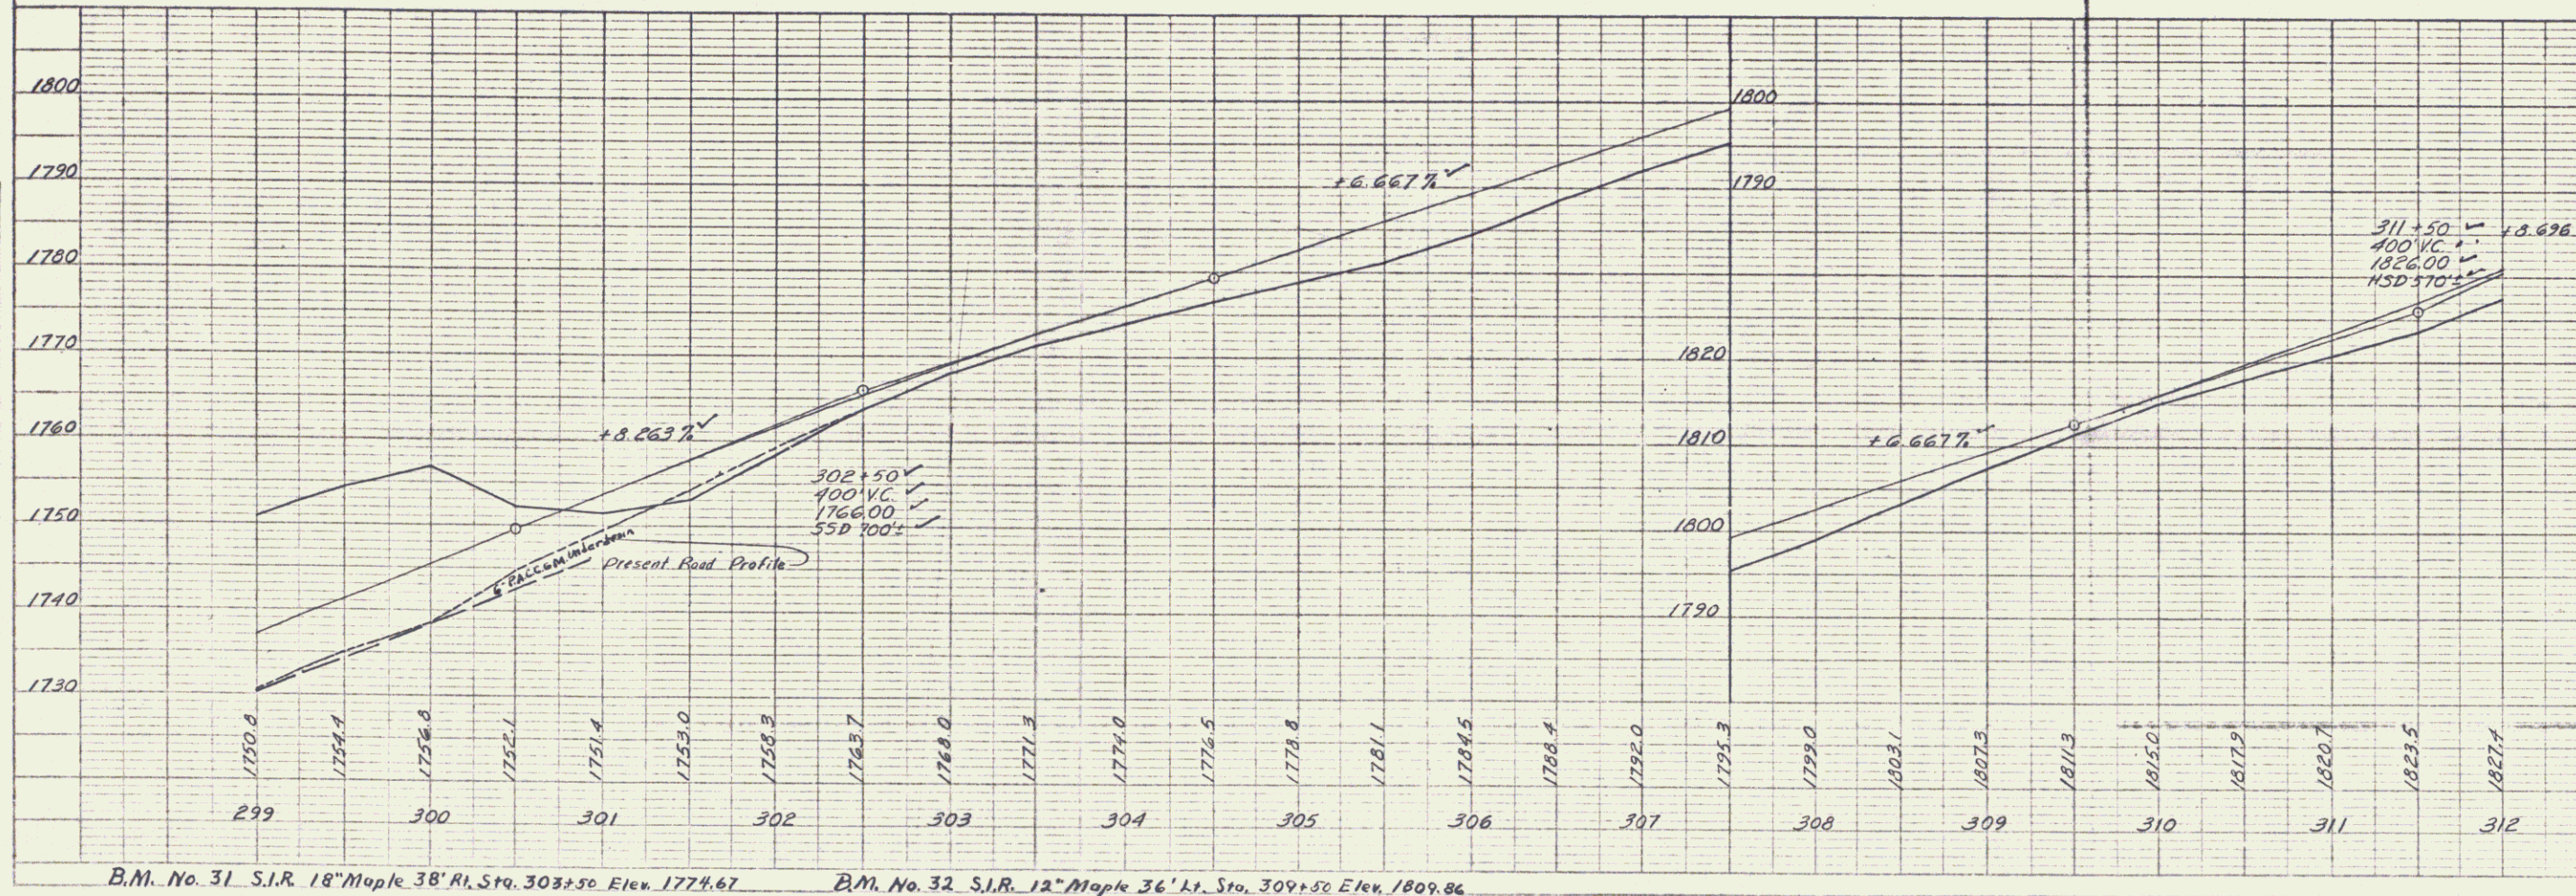


WESTON - MT. HOLLY
PROJECT FH-110-S-0133(2)SA
SHEET 31 OF 54

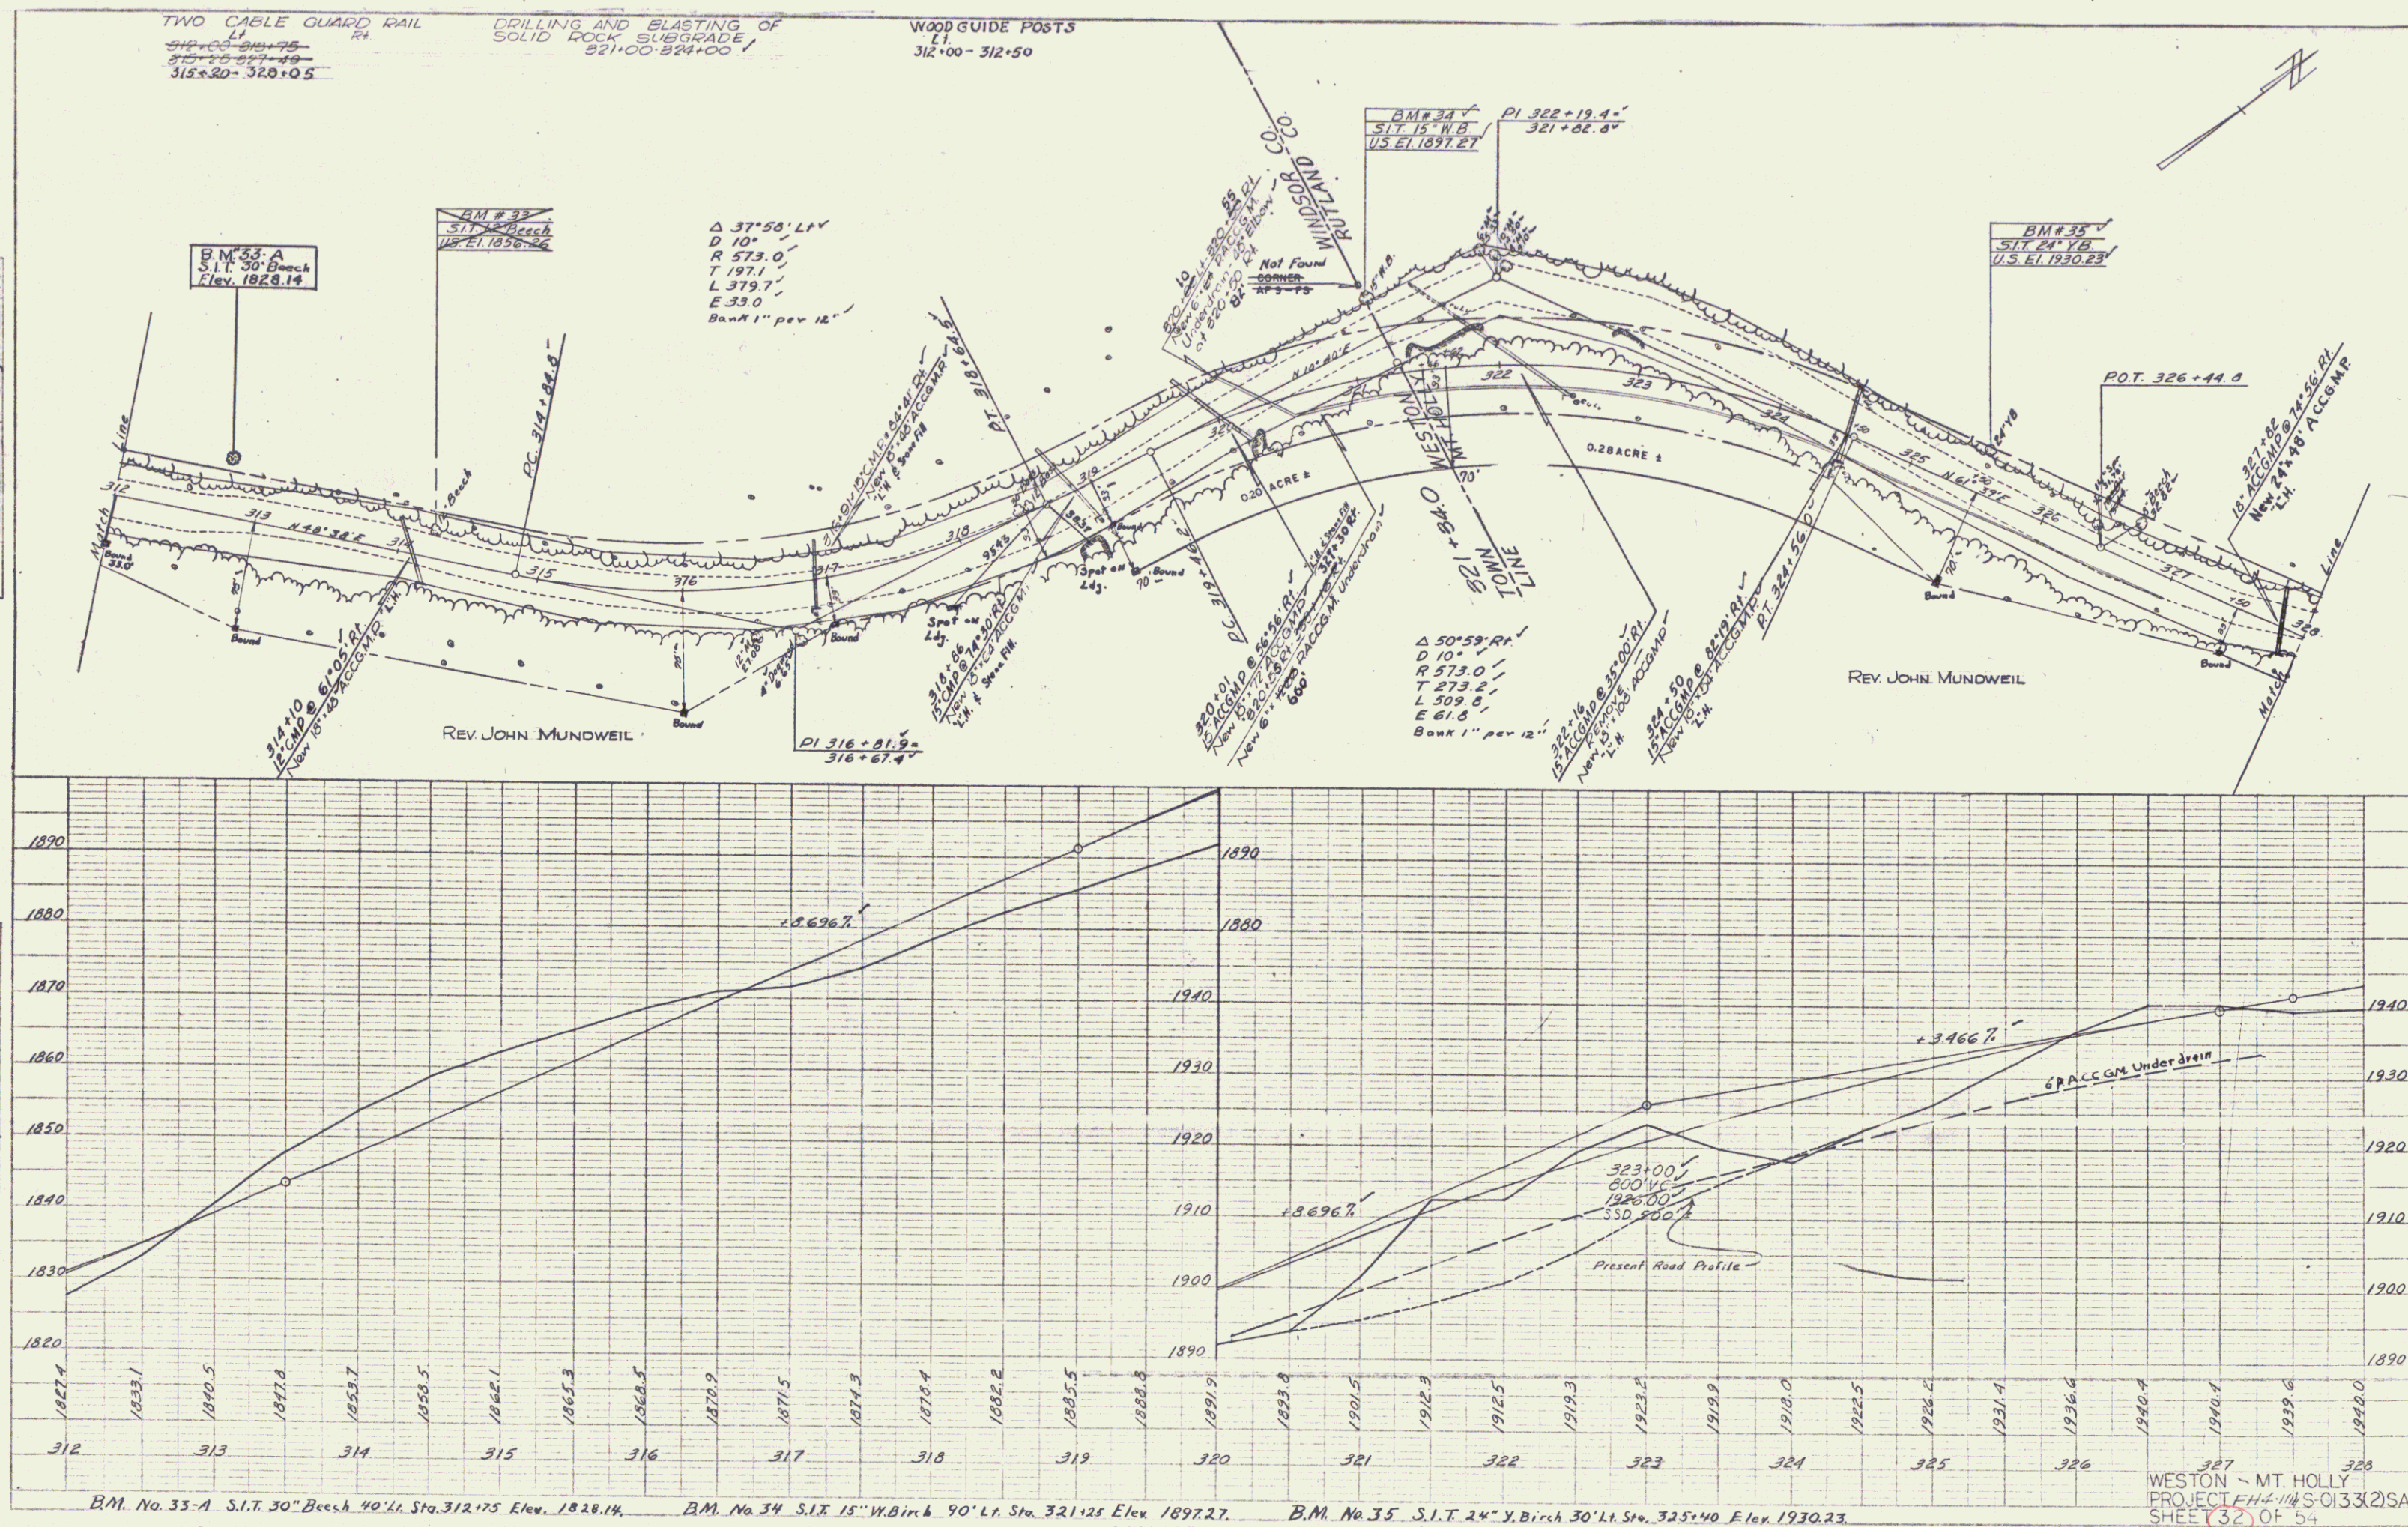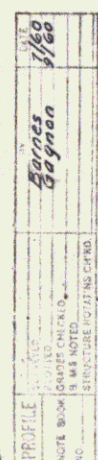

PLAN	DATE	BY	CHKD	APP'D
	8/60	Gagnon		
NOTE BOOK		Traced		

PROFILES	DATE	BY	CHKD	APP'D
	8/60	Gagnon		
NOTE BOOK				

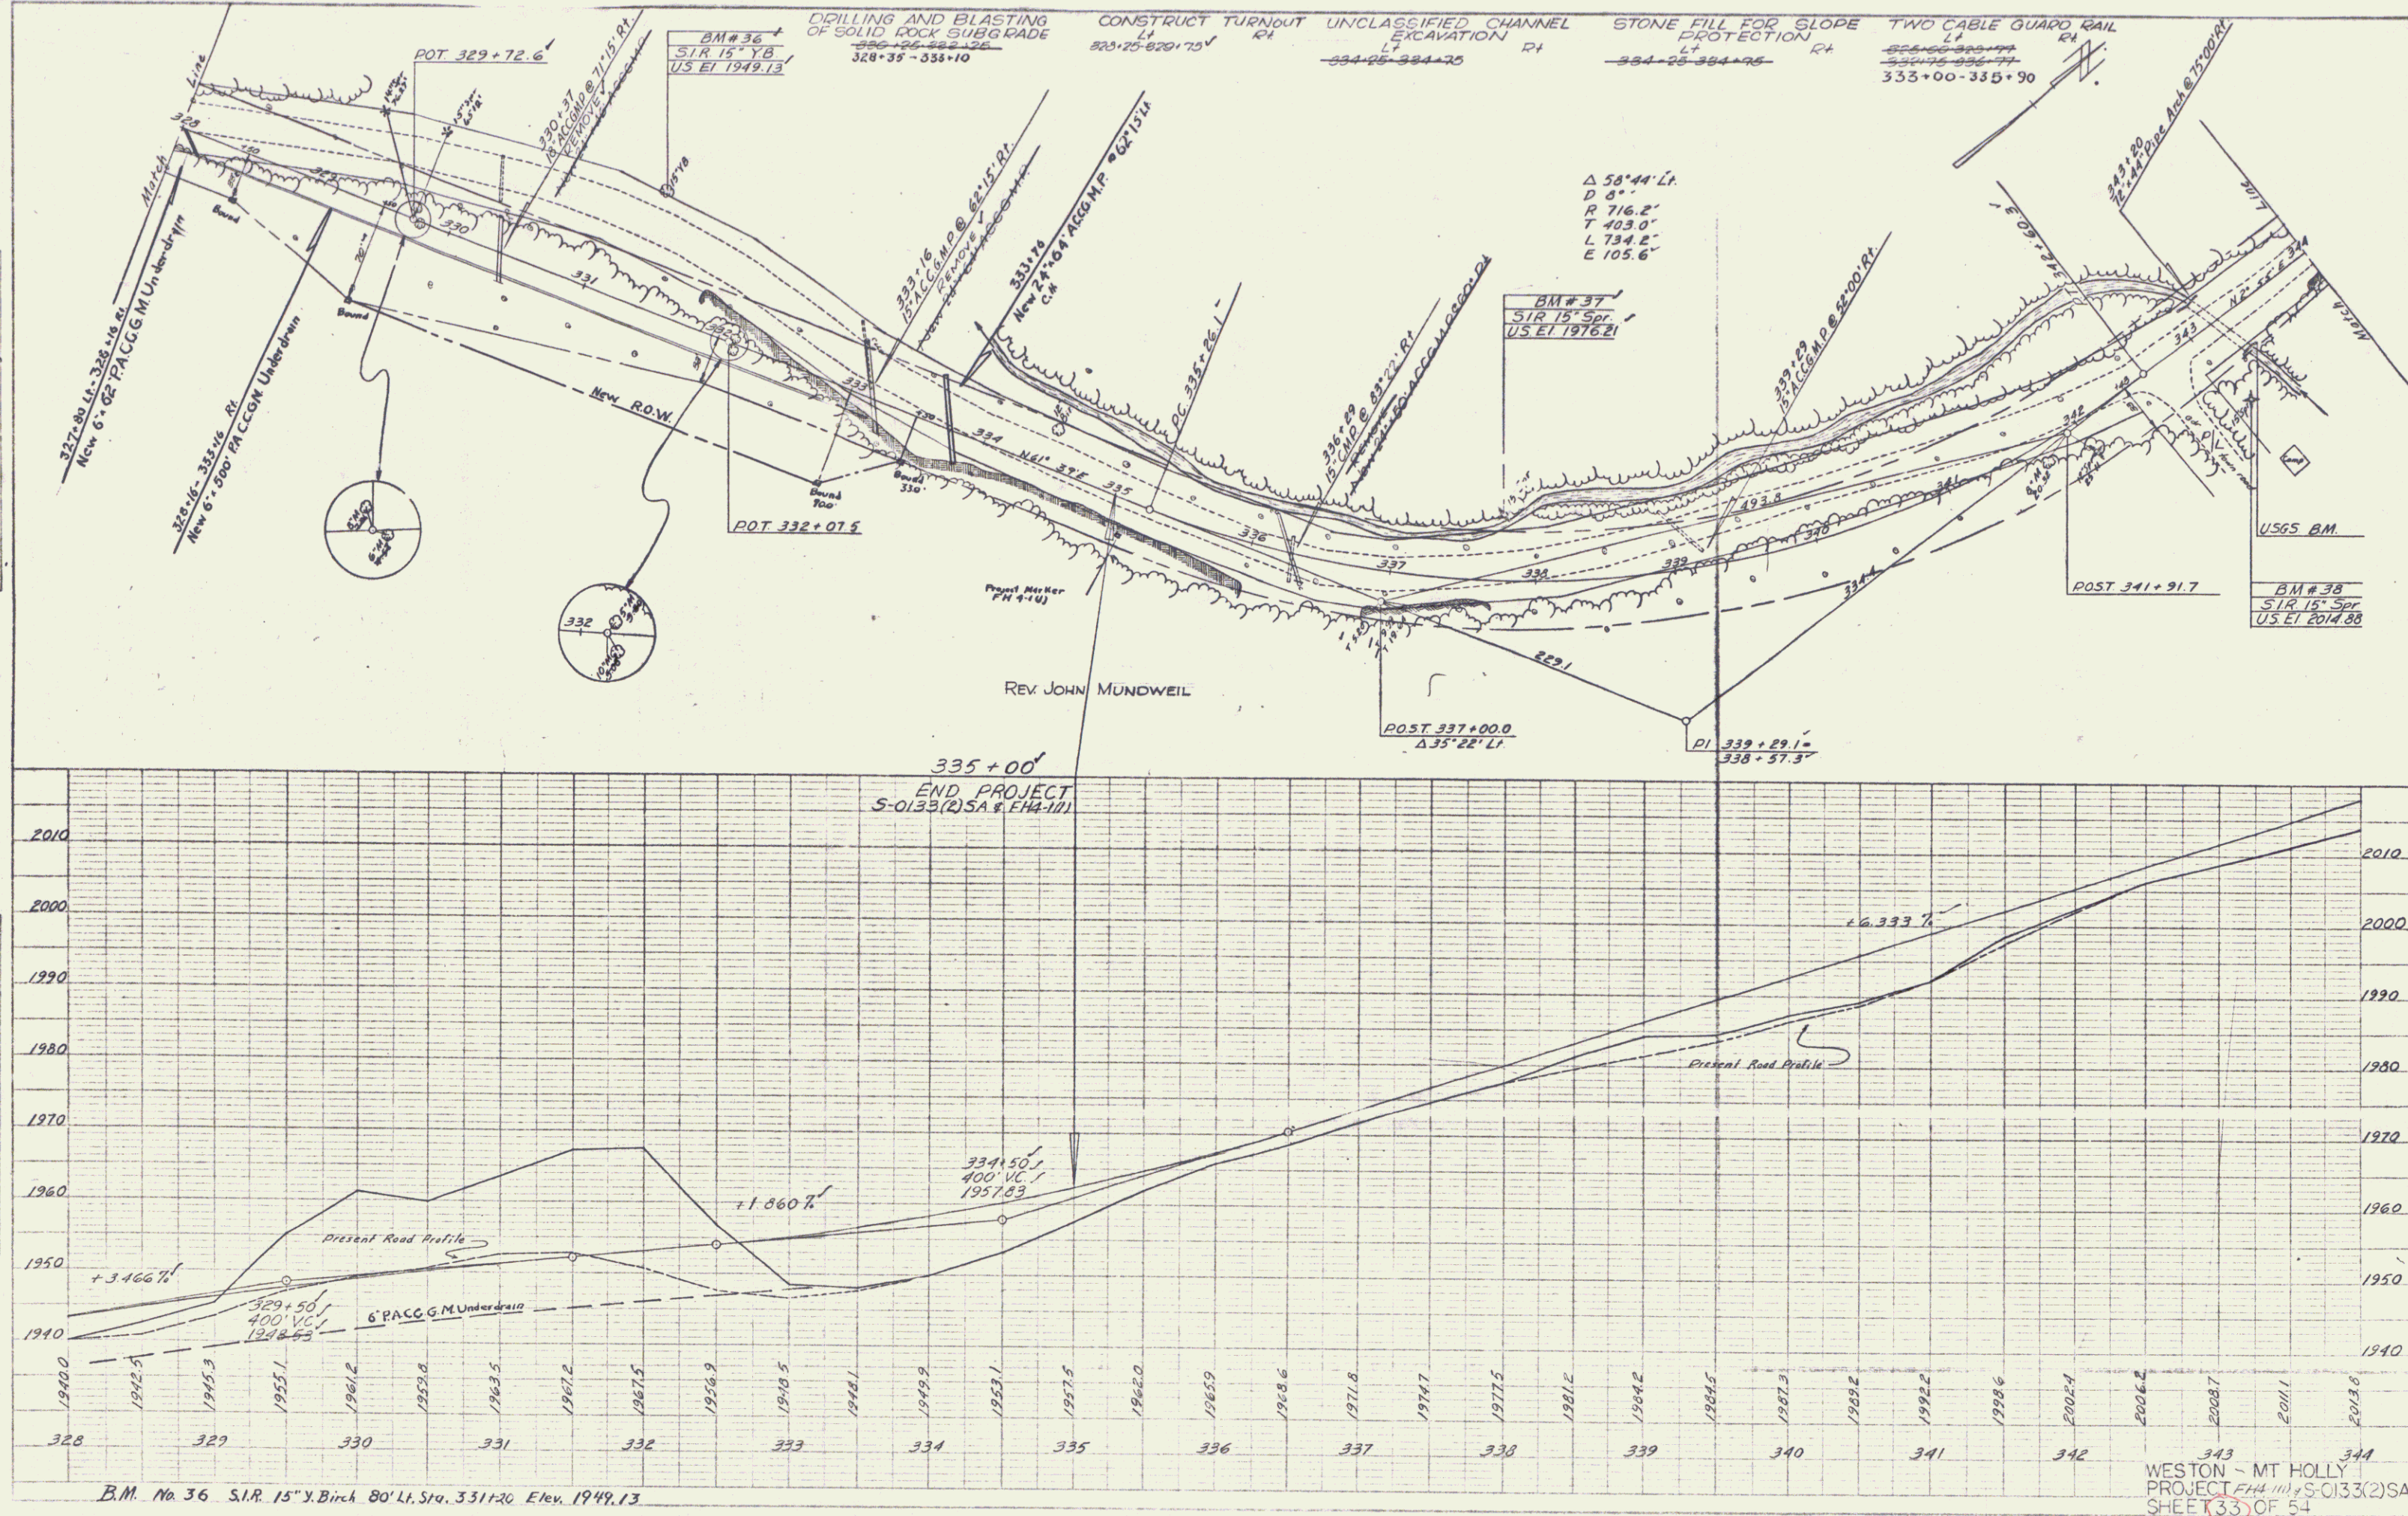

WESTON - MT HOLLY
PROJECT FH4 (111) S-0133(2)SA
SHEET 33 OF 54

13