



POOR ORIGINAL COPY

PLAN	DATE	BY	CHKD
NO.	7/12/87	7/12/87	7/12/87
NO.	7/12/87	7/12/87	7/12/87
NO.	7/12/87	7/12/87	7/12/87

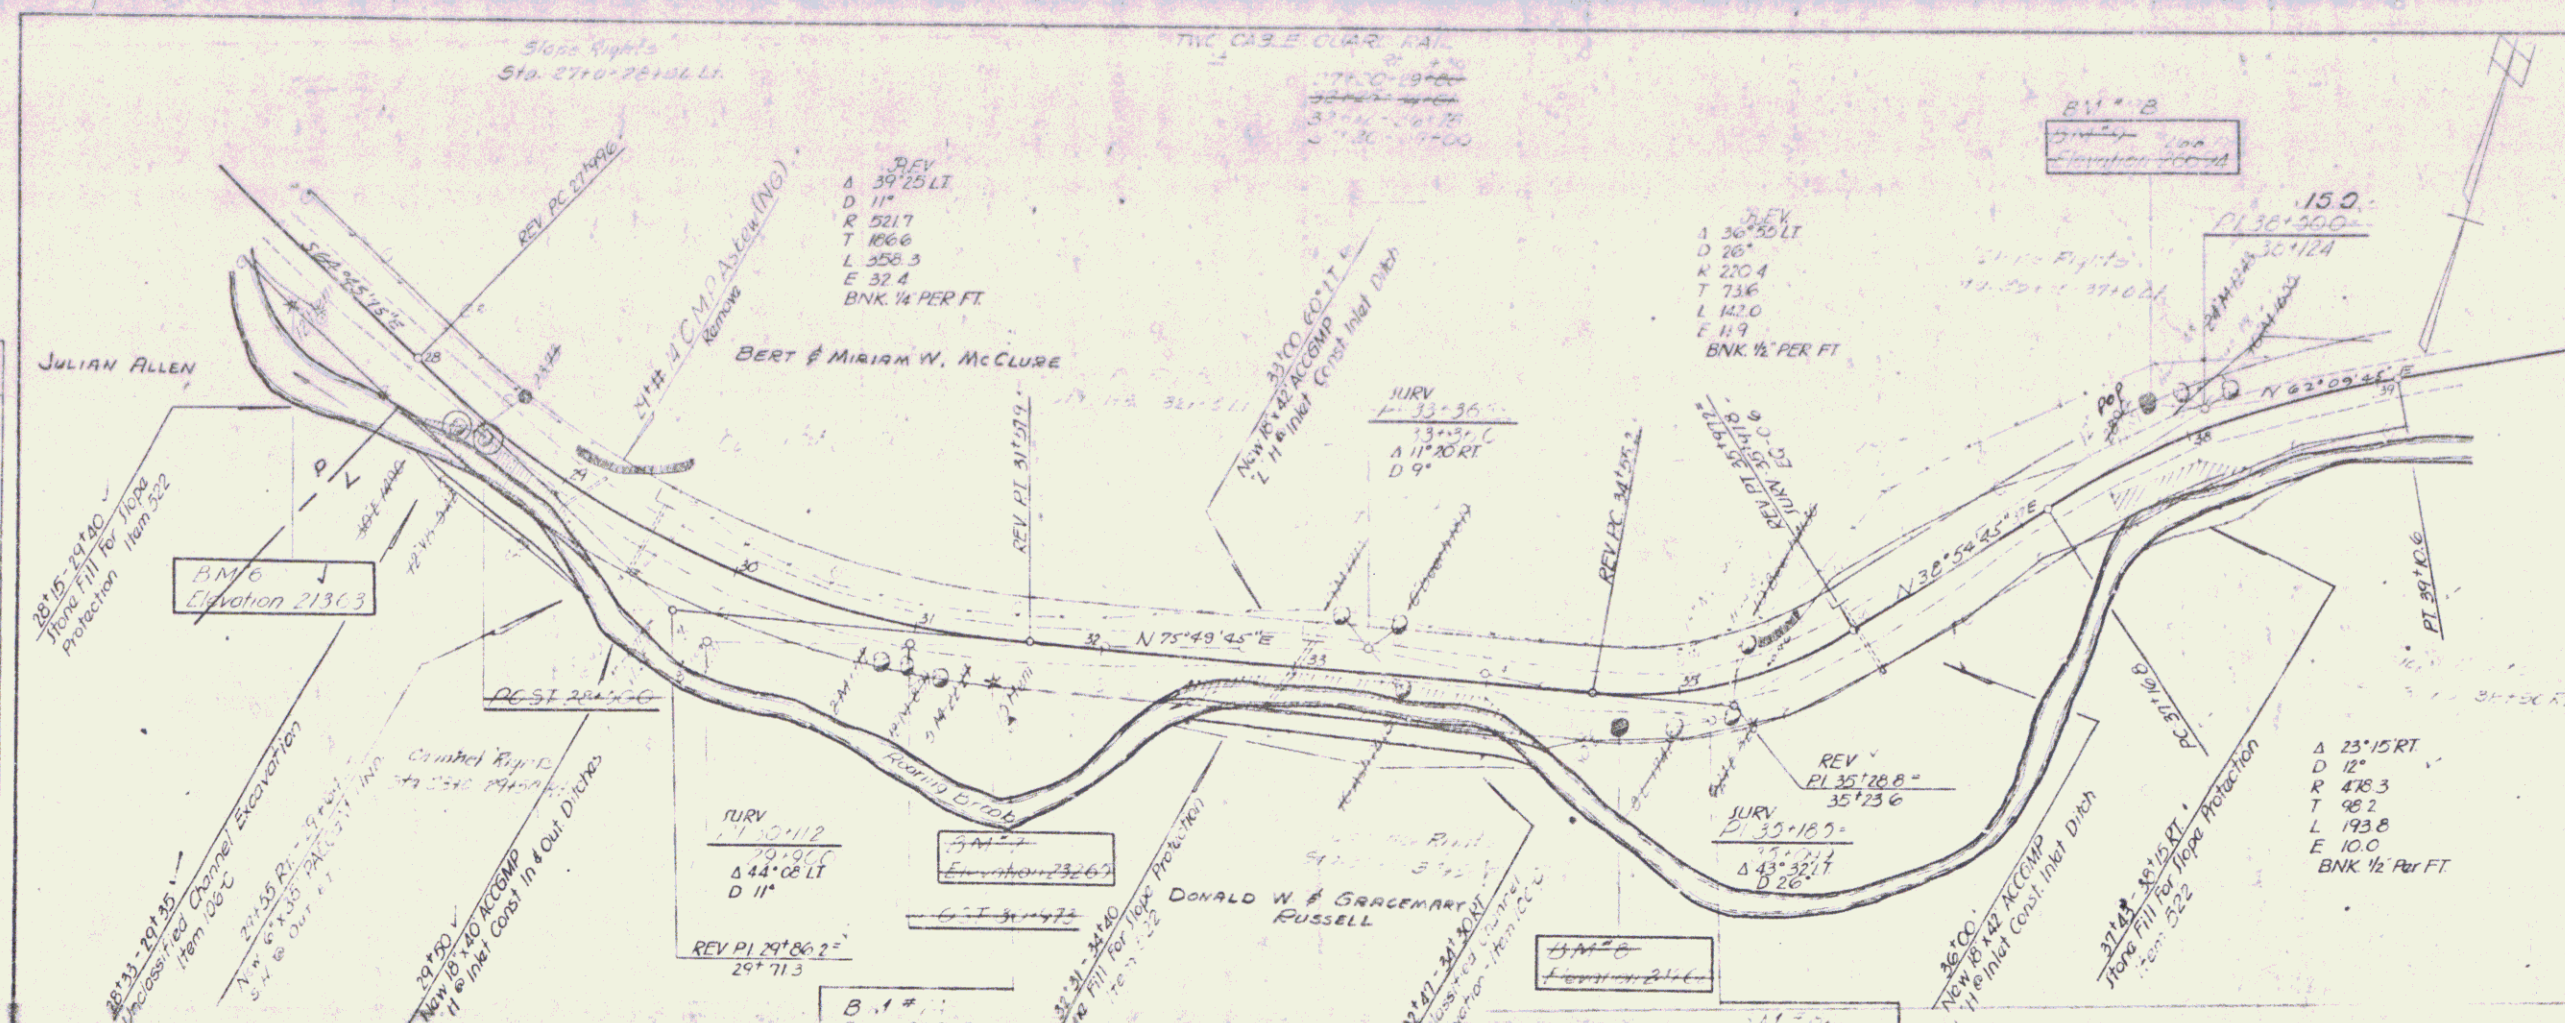

PLAN	DATE	BY	CHKD
NO.	7/12/87	7/12/87	7/12/87
NO.	7/12/87	7/12/87	7/12/87
NO.	7/12/87	7/12/87	7/12/87

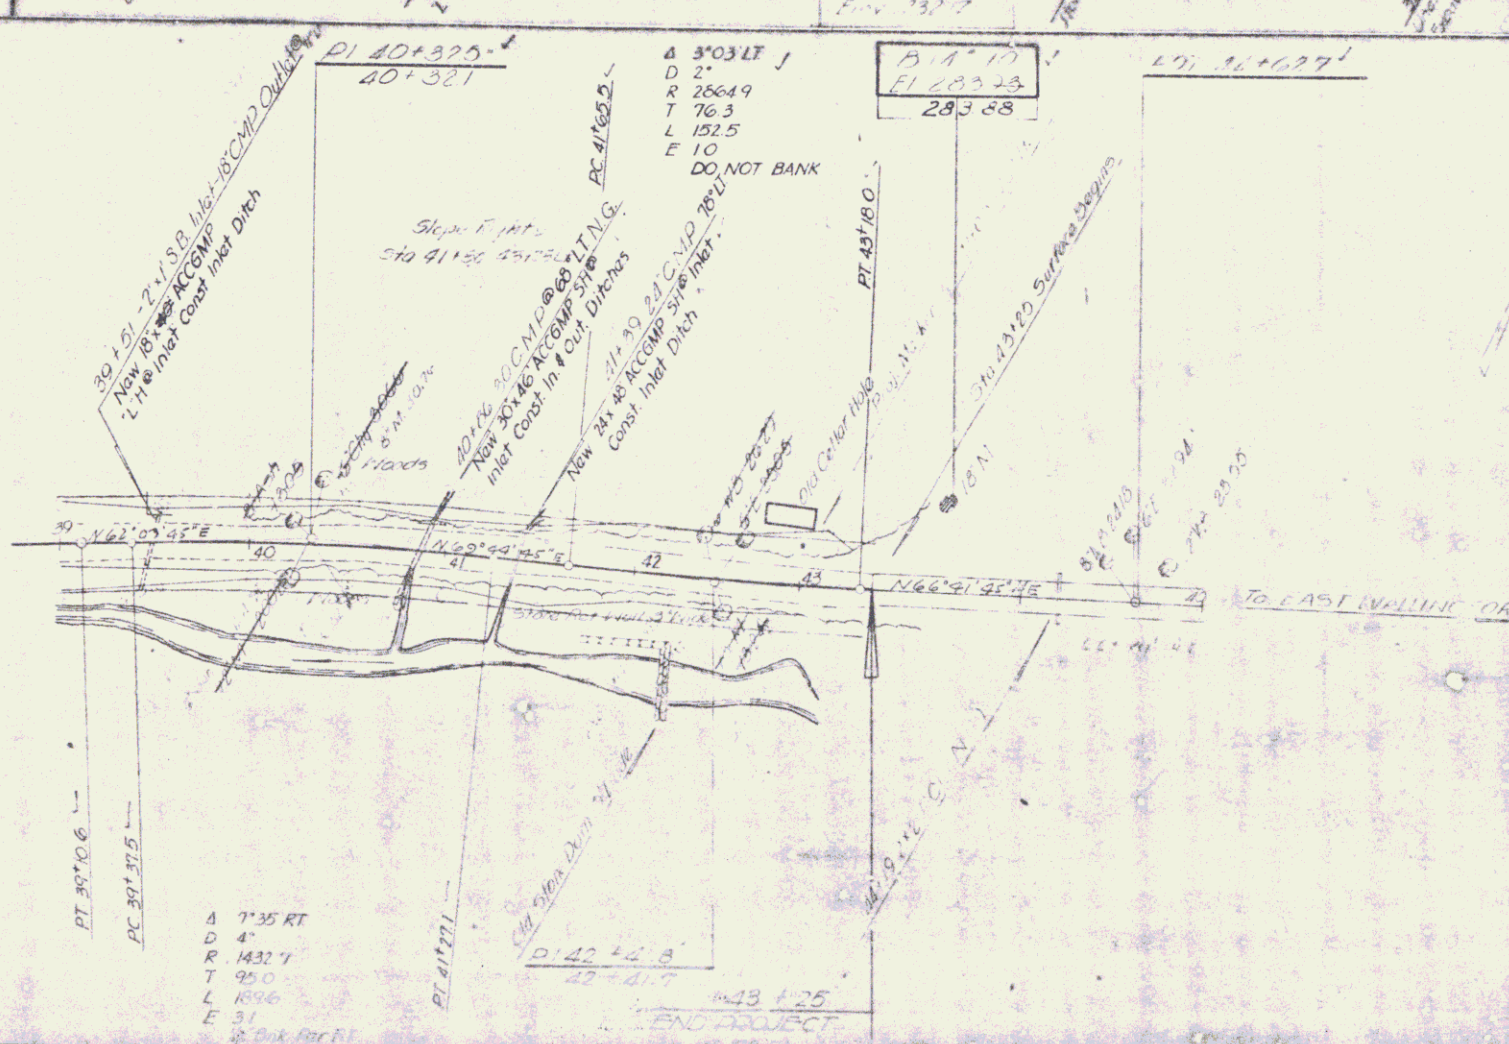

JUL 14 1987

SURVEYED BY: BOBIE DATE: 5-87
DRAWN BY: KYLE DATE: 5-87
TRACED BY: KYLE DATE: 5-87
WALLINGFORD V.P.R. 140

SHEET 9