

INDEX OF SHEETS

STATE OF VERMONT
AGENCY OF TRANSPORTATION




PROPOSED IMPROVEMENT
COUNTY OF RUTLAND

TOWNS OF PAWLET, DANBY, TINMOUTH
MIDDLETOWN SPRINGS, IRA, CLARENDON, WEST RUTLAND

VERMONT ROUTE 133


Pin # 99R656

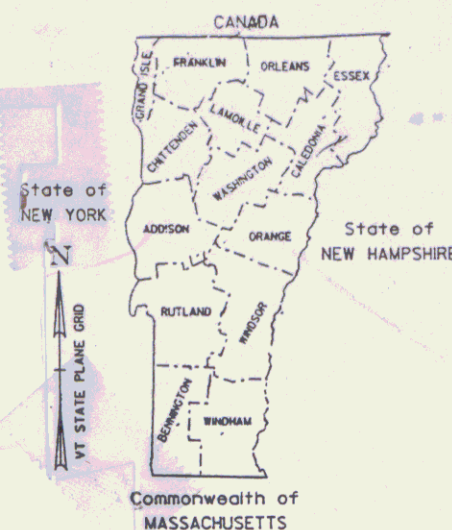

CONVENTIONAL SIGNS

LINE	---
FE	---
ACCESS	---
ACCESS	---
NE	---
ALL	---
D WAY	---
AL	---
LINE	---
OLE	---
HE POLE	---
OF ADJ	---
Y LINE	---
KING LINE	---
GHTS	---
UT	---
SLOPE	---

DATUM
VERTICAL
HORIZONTAL

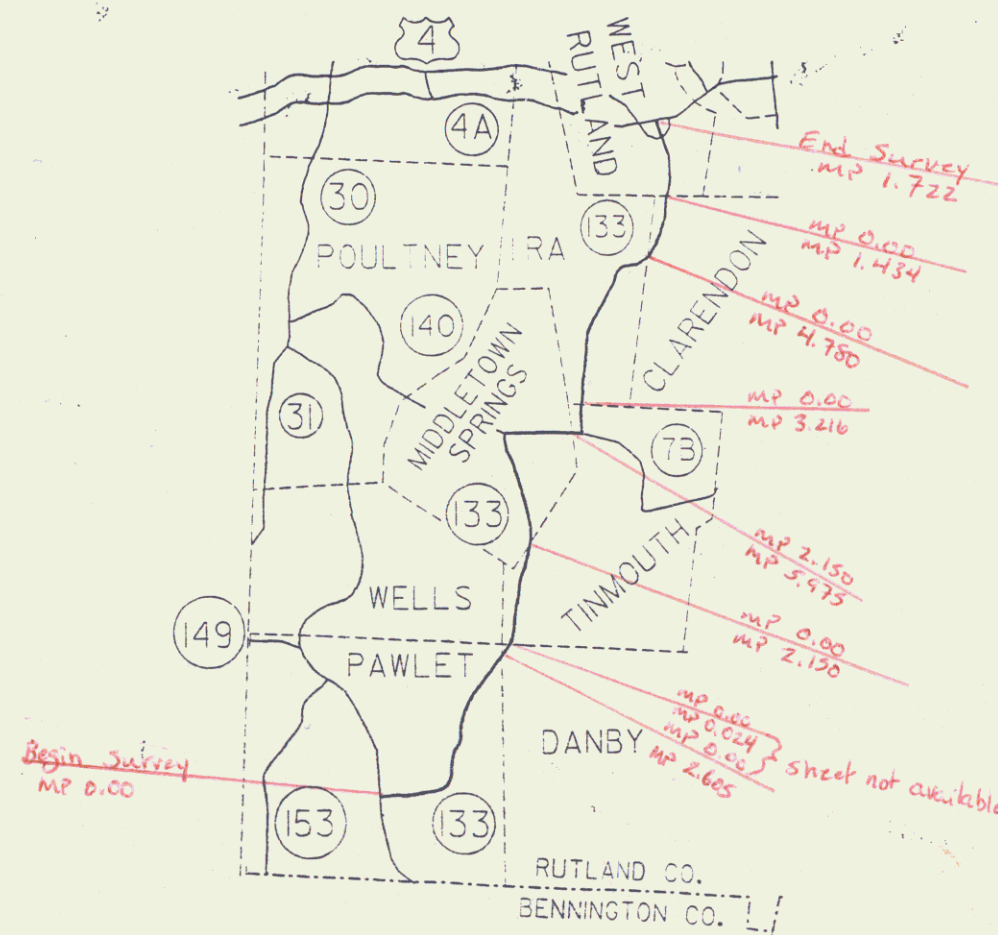

Preliminary resurvey

RIGHT-OF-WAY DIVISION
TOWN FILE
PERPETUAL

Town of _____
(To Be Returned To R.O.W. Division)

checked 3/8/00 ml

Date 1/1/1930

THESE PLANS ARE SUBJECT TO SUCH ENGINEERING
CHANGES AS MAY BE REQUIRED BY THE FEDERAL HIGHWAY
ADMINISTRATION OR THE AGENCY SECRETARY.
CONSTRUCTION IS TO BE CARRIED ON IN ACCORDANCE
WITH THESE PLANS AND THE STANDARD SPECIFICATIONS
FOR CONSTRUCTION DATED 1966, AS APPROVED BY THE
FEDERAL HIGHWAY ADMINISTRATION ON NOVEMBER 21, 1985
FOR USE ON THIS PROJECT, INCLUDING ALL SUBSEQUENT
REVISIONS AND SUCH REVISED SPECIFICATIONS AND
SPECIAL PROVISIONS AS ARE INCORPORATED IN THESE
PLANS.

SUBMITTED BY ORDER OF THE STATE TRANSPORTATION BOARD	
APPROVED _____	DATE _____
DIRECTOR OF ENGINEERING	
DEPARTMENT OF TRANSPORTATION FEDERAL HIGHWAY ADMINISTRATION	
APPROVED _____	DATE _____
DIVISION ADMINISTRATOR	
PROJECT MSA 7317	
SHEET 1 OF SHEETS	