


259
5-57
MAY 1957
MAY 1957
MAY 1957

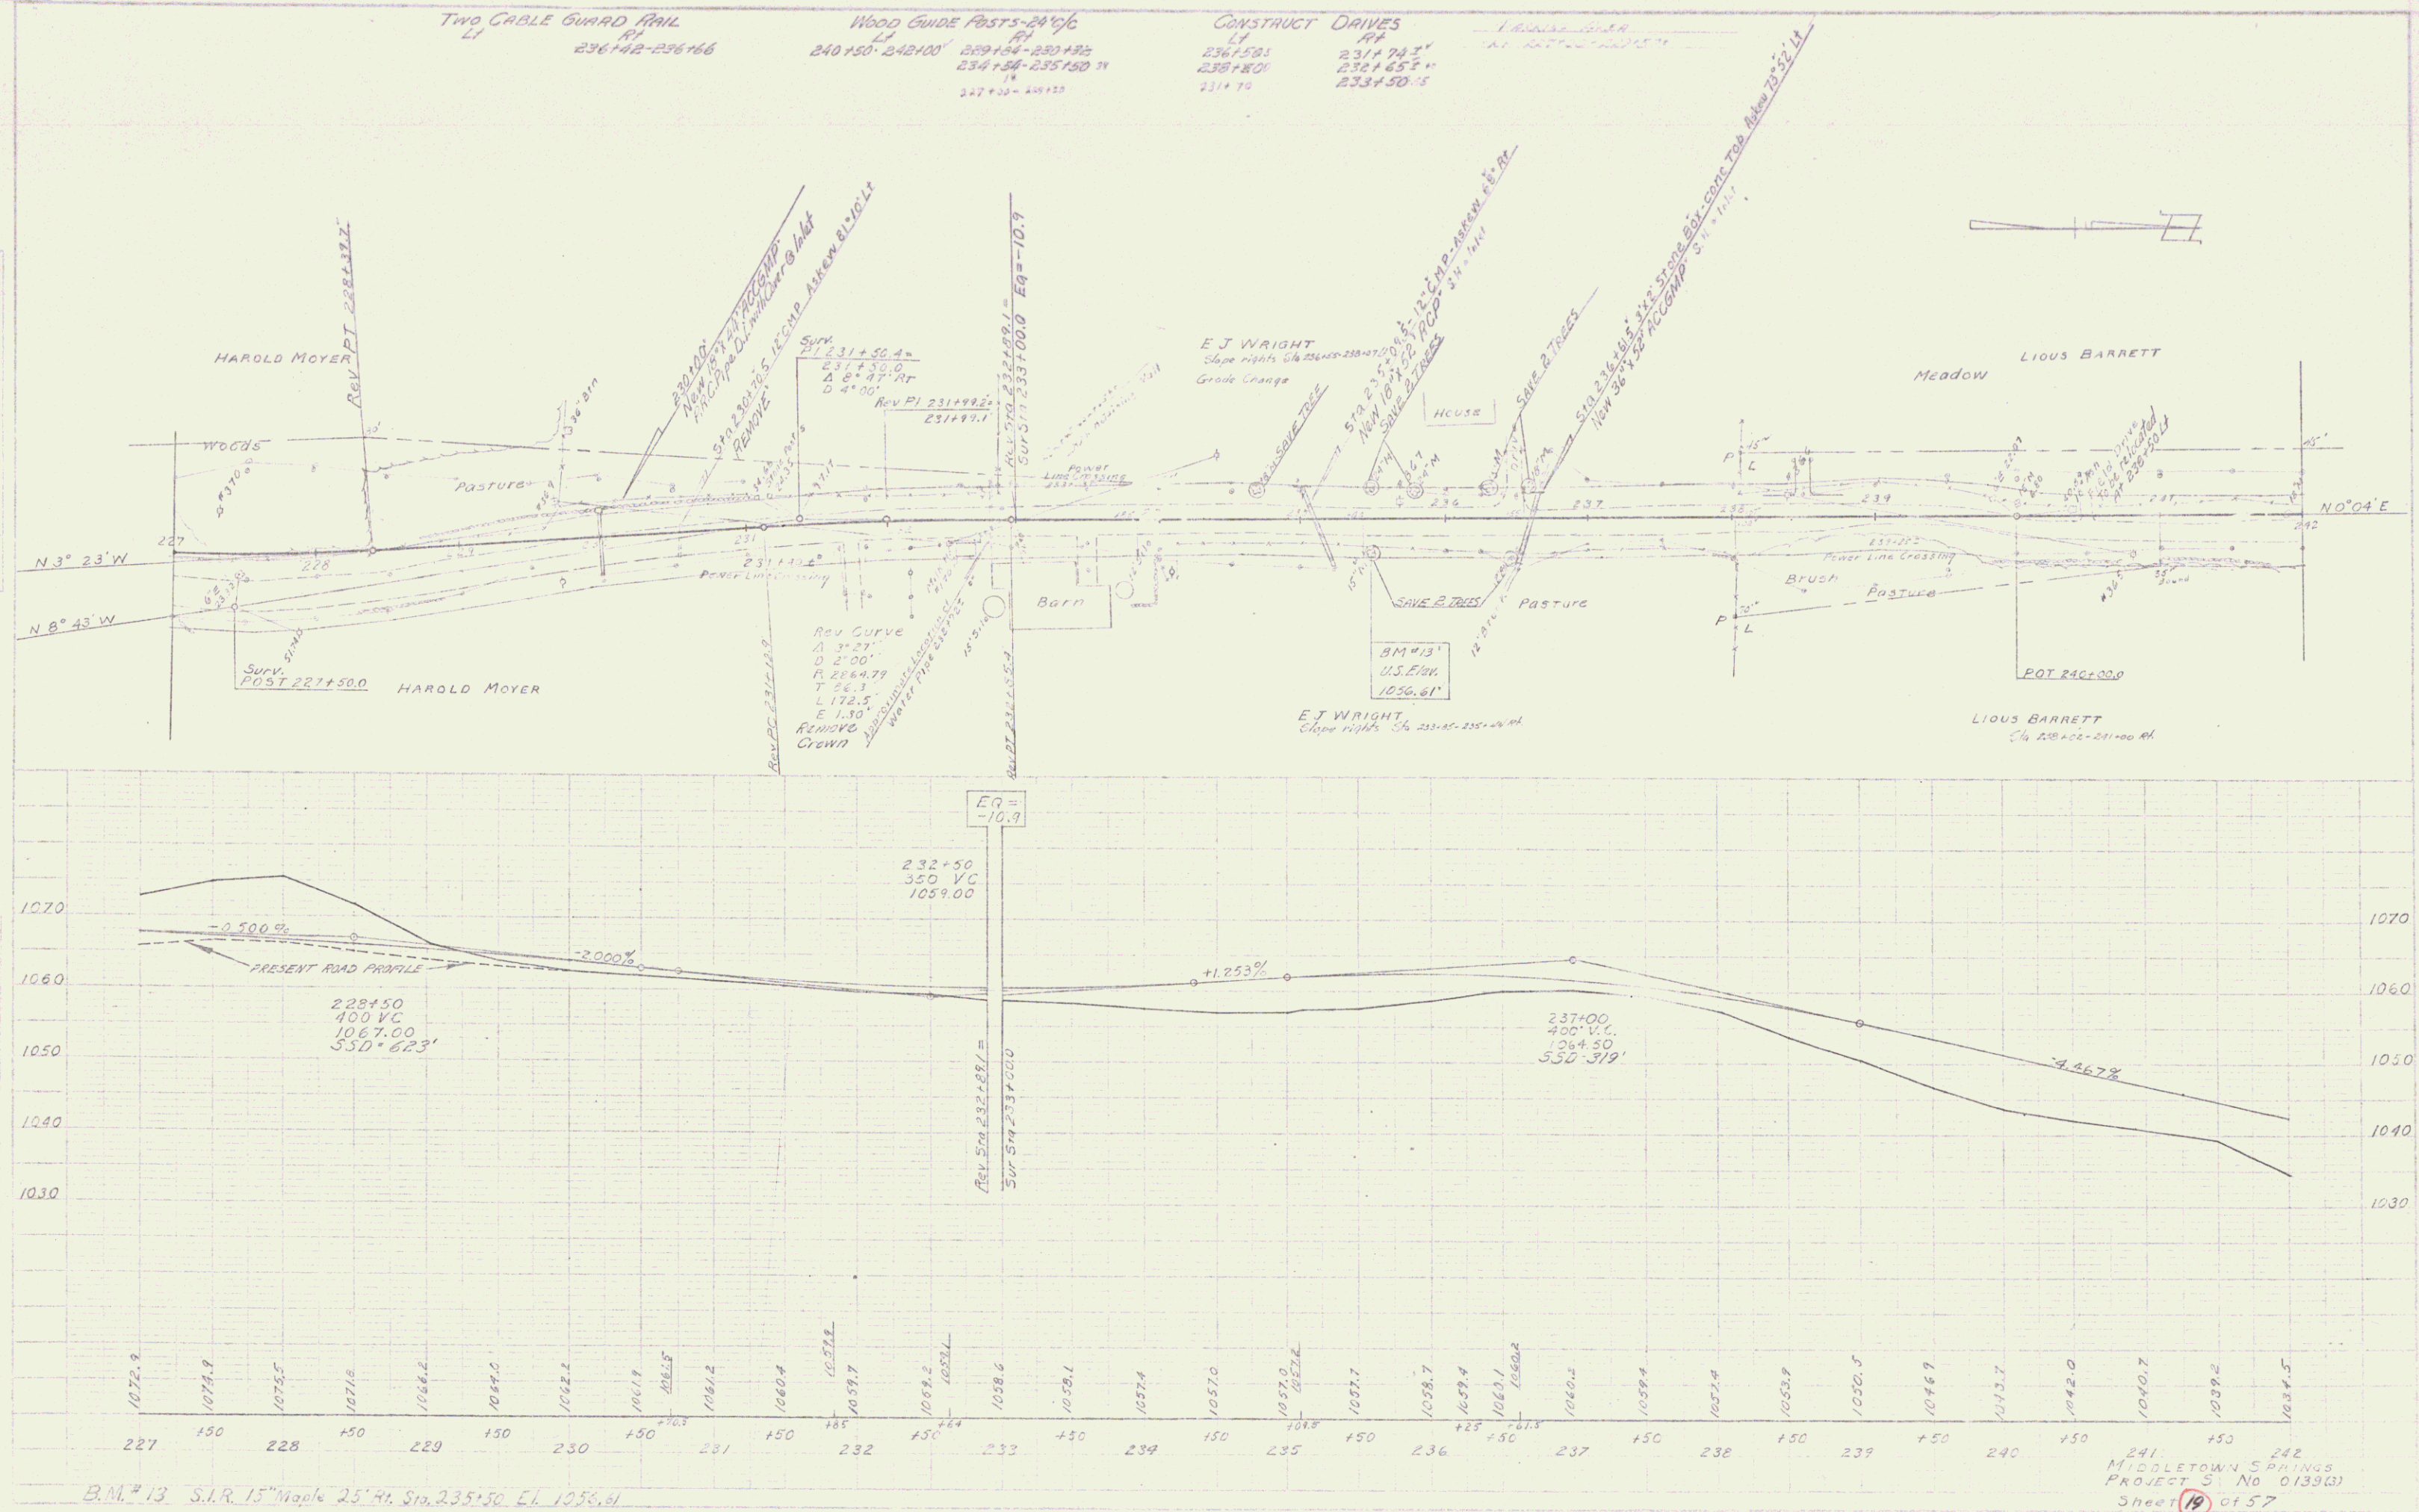

241
MIDDLETOWN SPRINGS
PROJECT 5, No 0139GJ
Sheet 19 of 57