





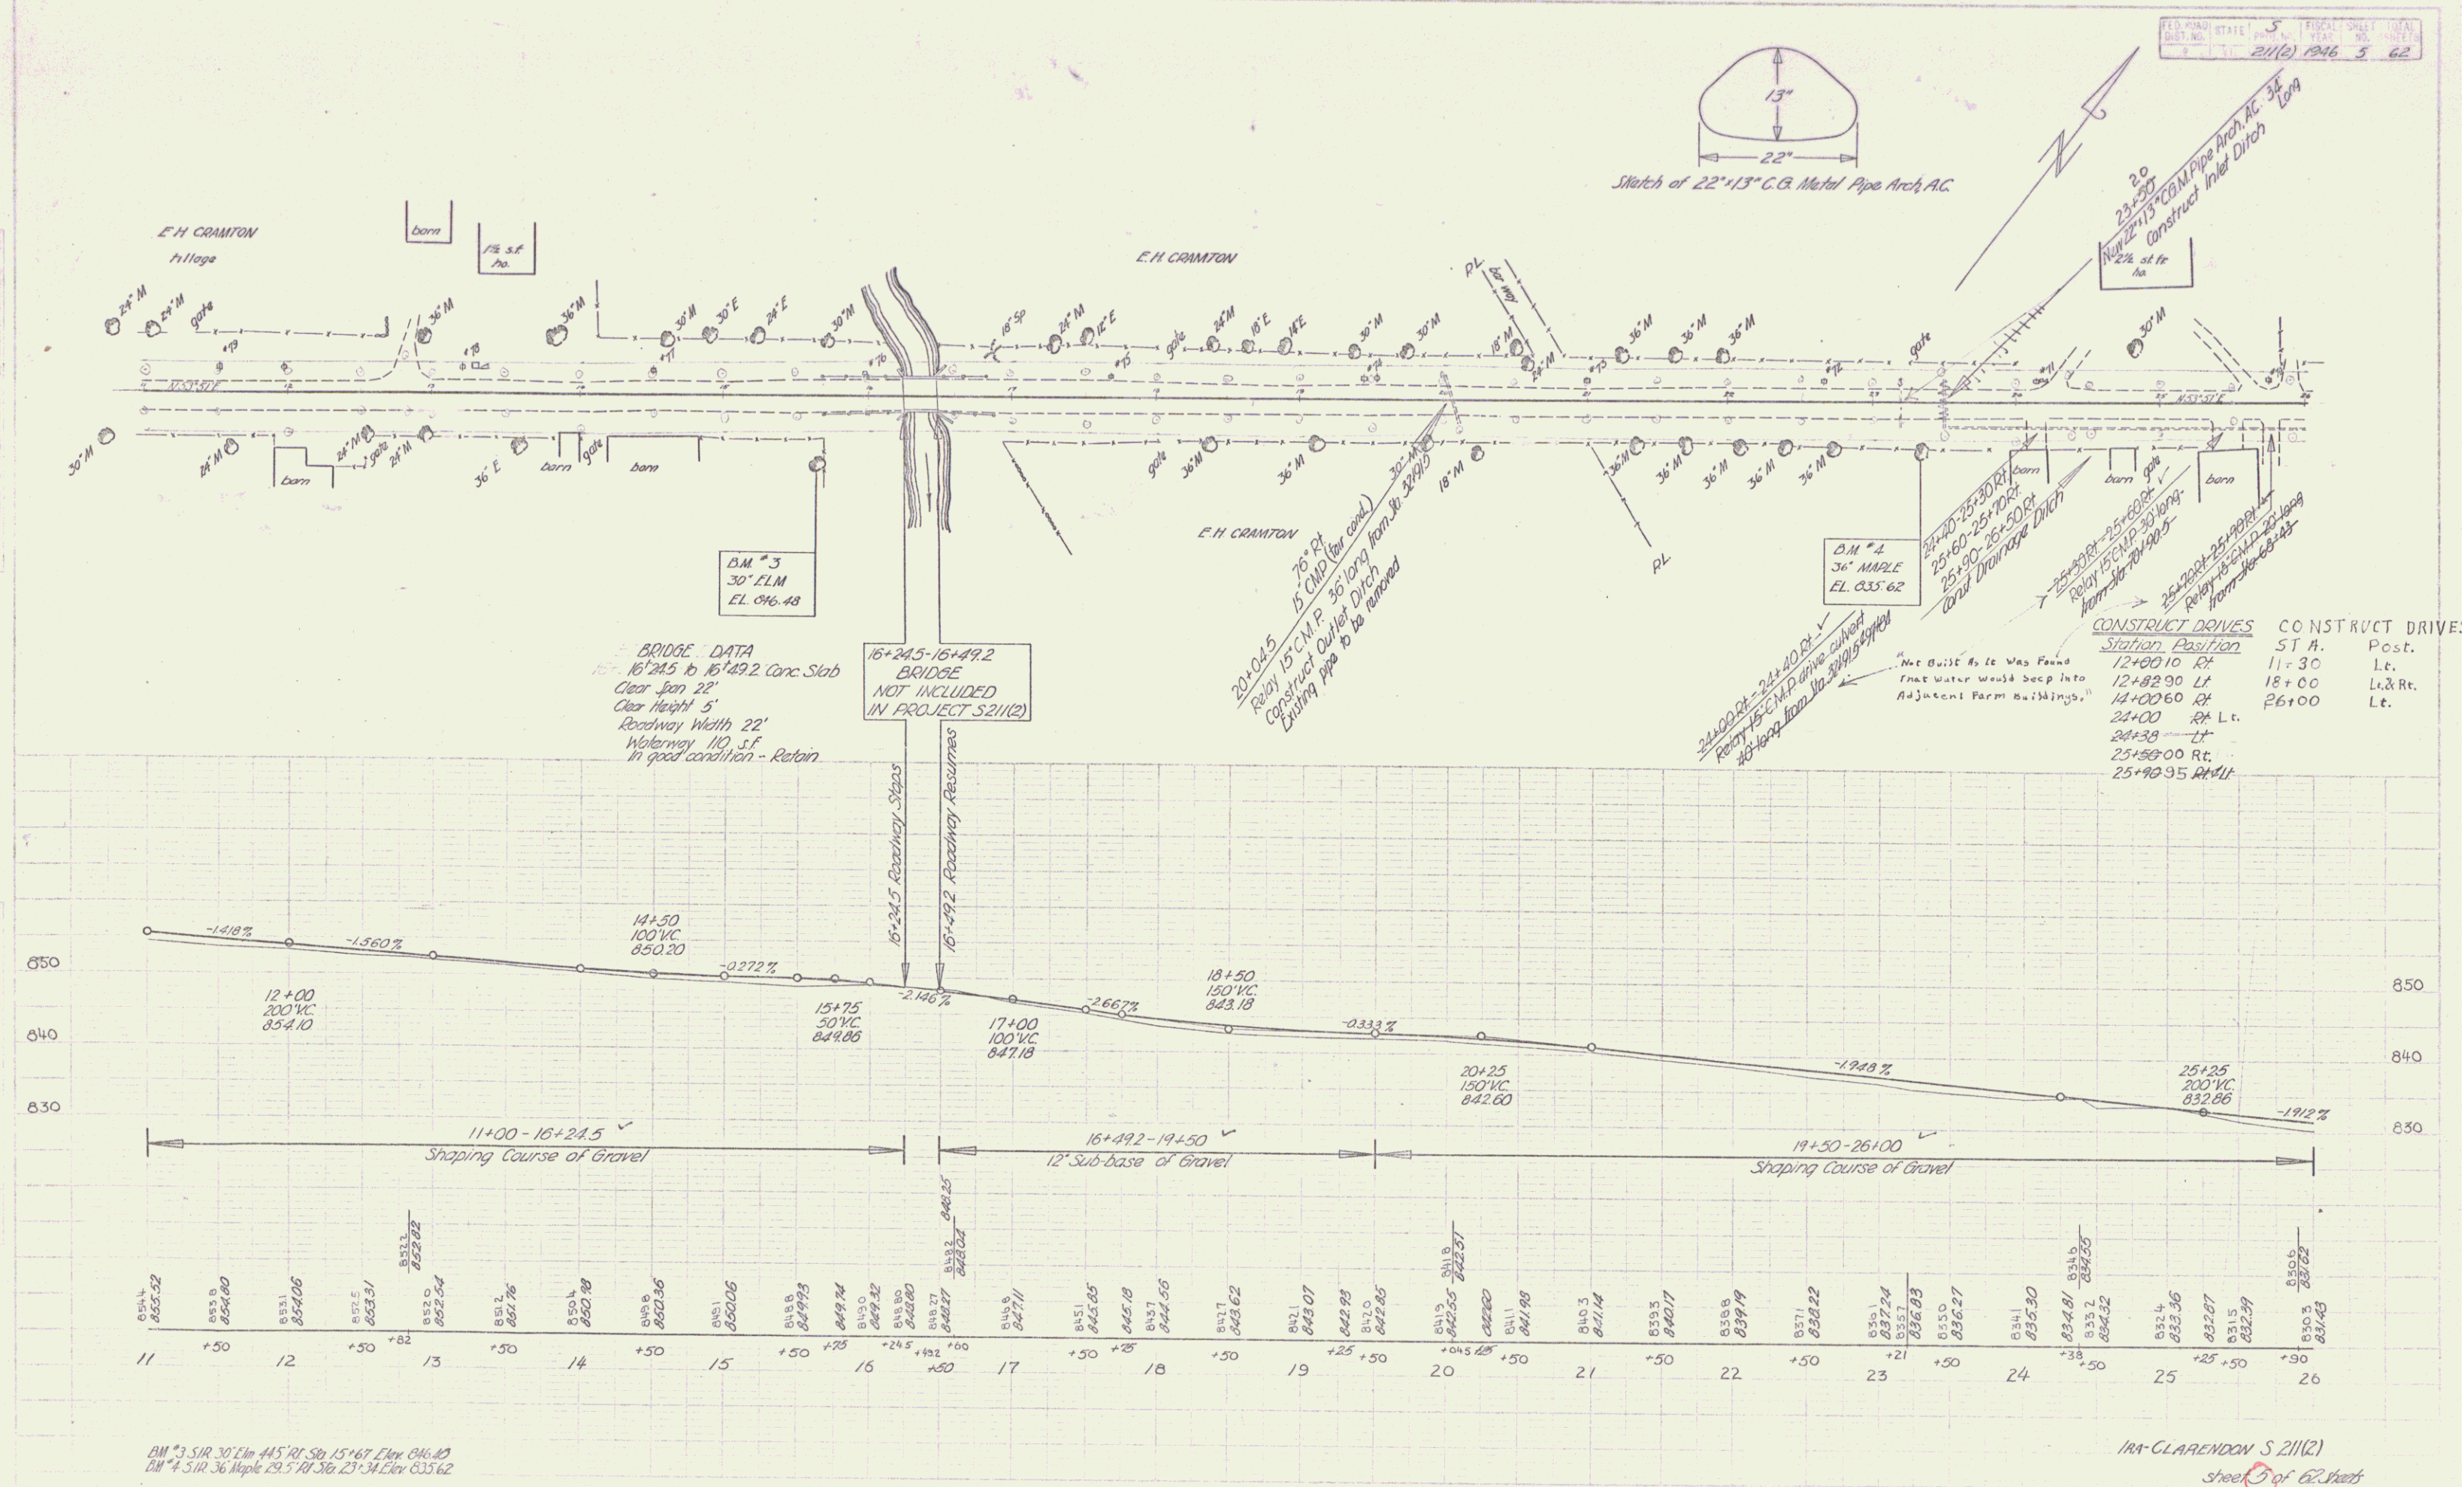

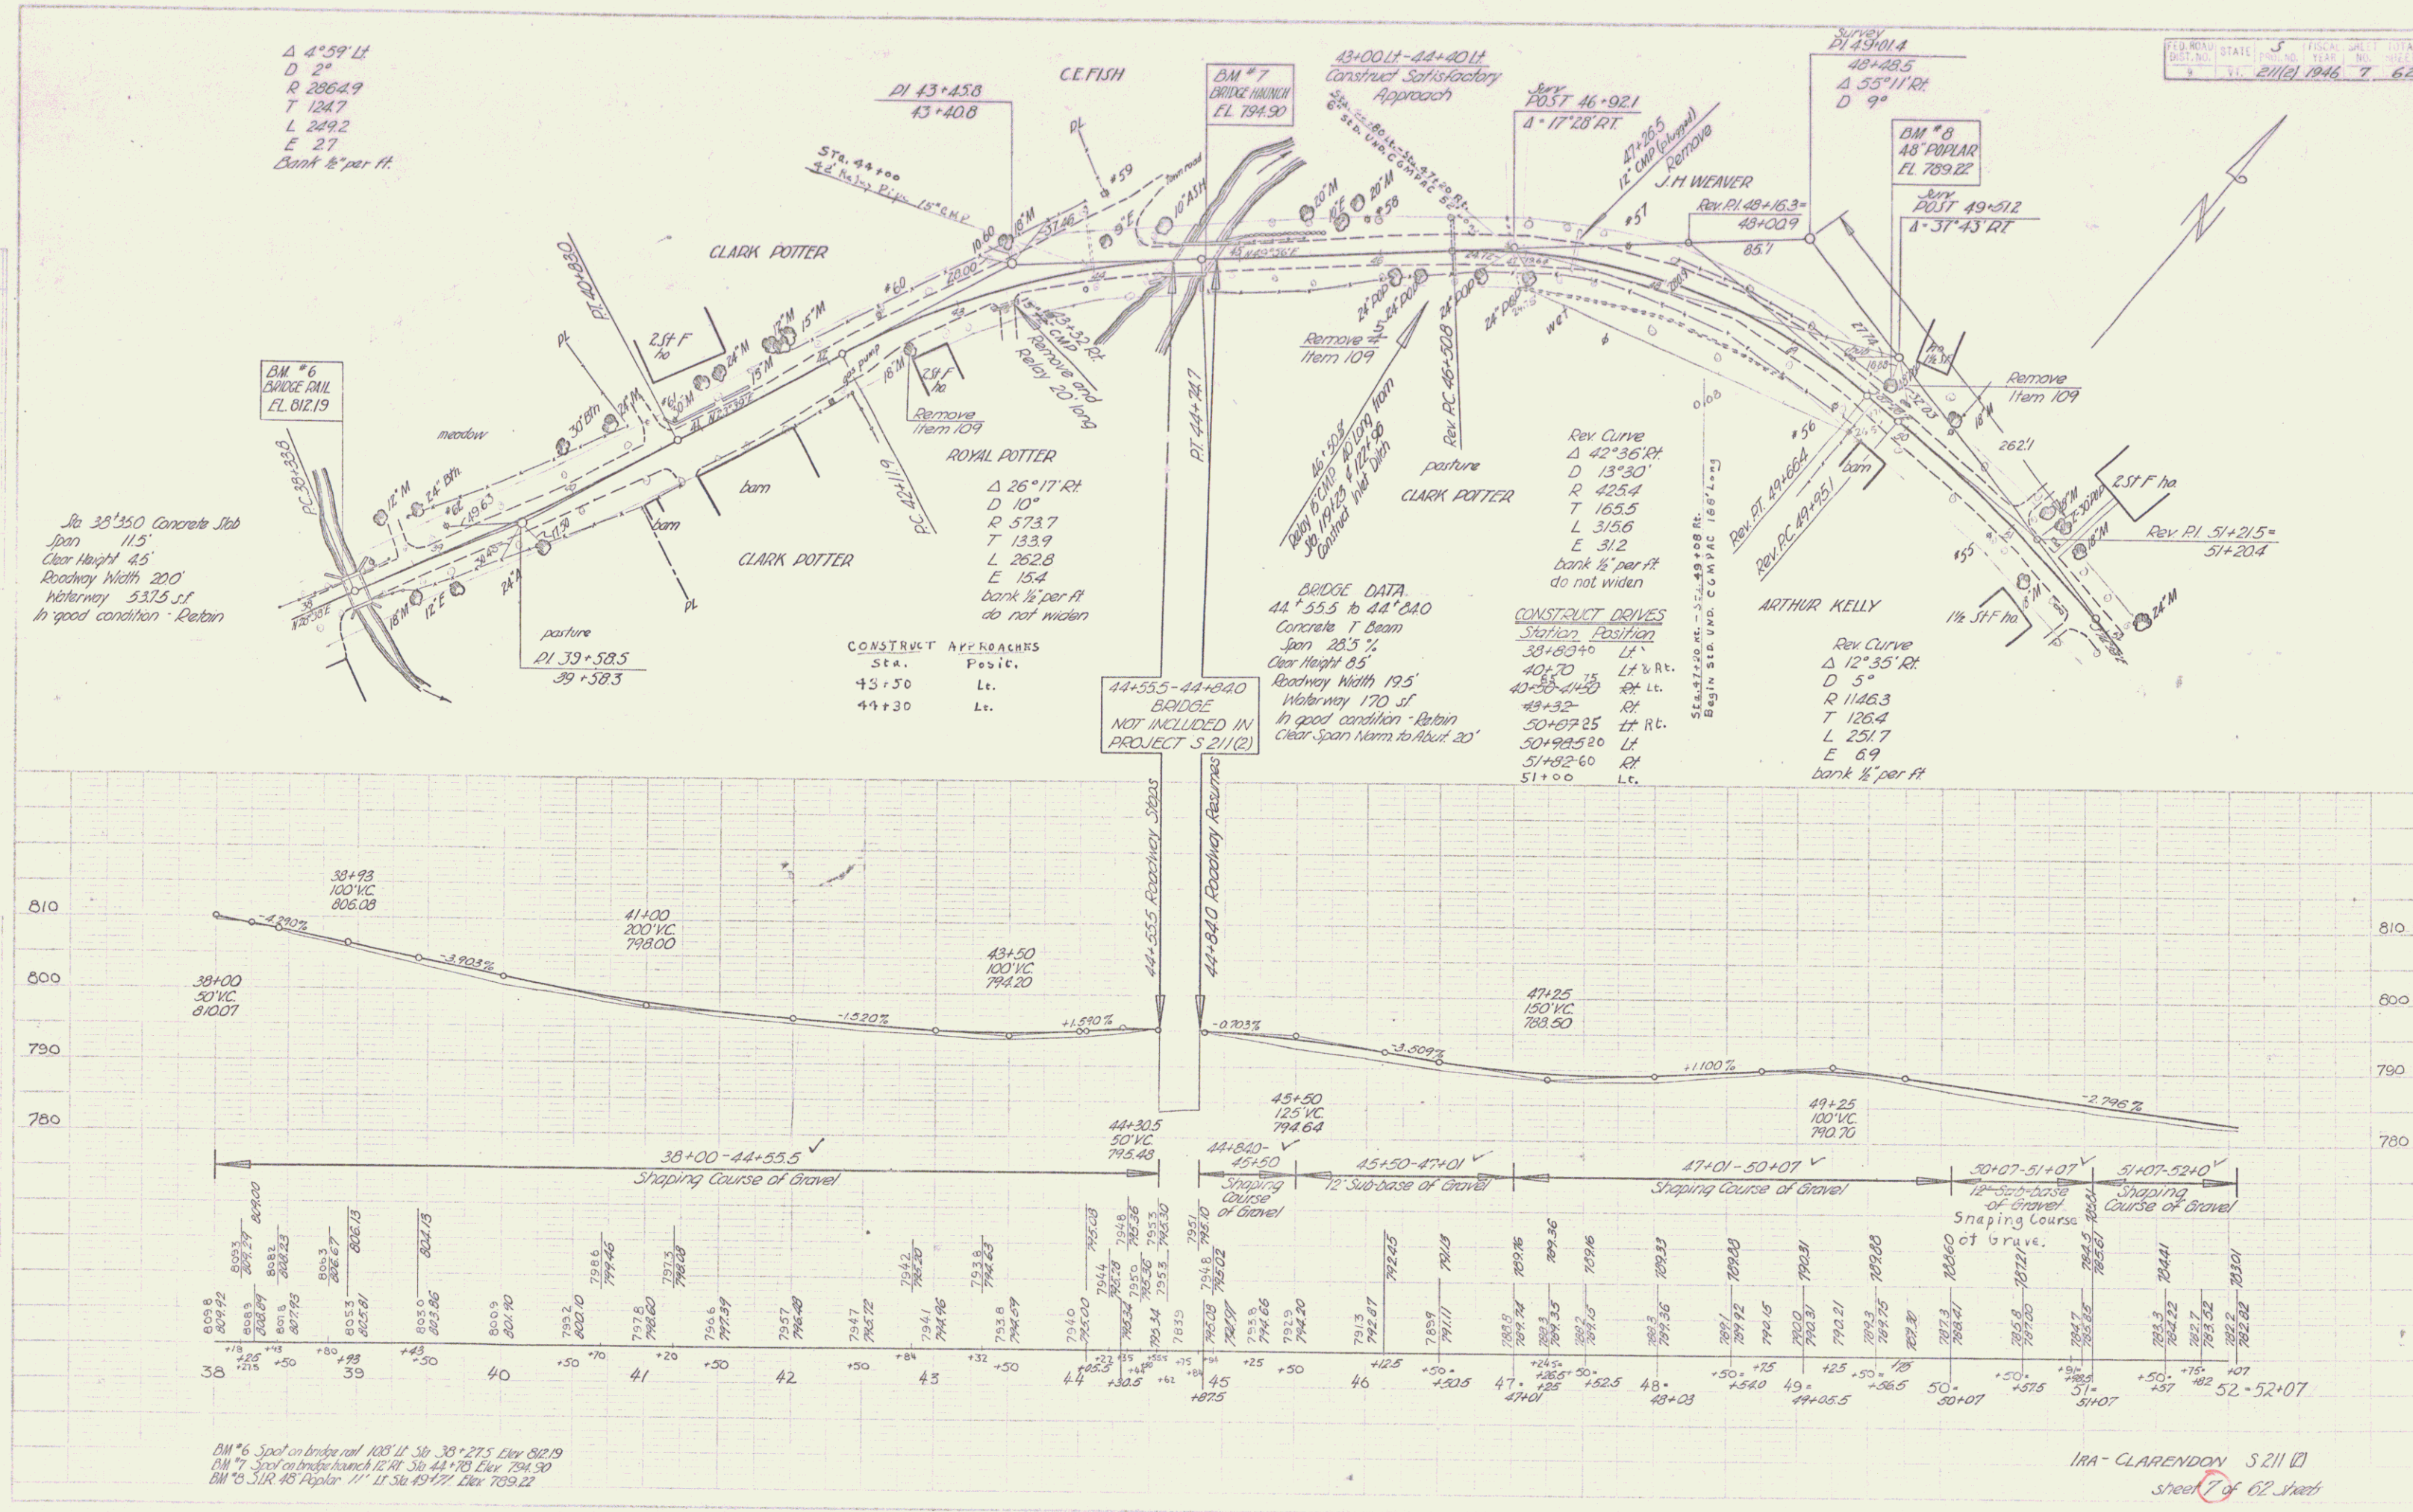

PROJ. NO.	STATE	FISCAL YEAR	SHEET NO.	TOTAL SHEETS
20121	1946	0	62	

CHANNEL EXCAVATION Item 15
65+00 LT - 68+00 LT
Excavated material to be placed
on left bank of new channel

Δ 65°05' LT
D 7°
R 819.0
T 522.6
L 929.8
E 152.5
bank 1/2 per ft
do not widen

Remove (5)
Item 109

CONSTRUCT DRIVES
Station Position
52+50.60 R/L
53+85.70 R/L
53+85.70 R/L
54+00.00 R/L
54+00.00 R/L
60+65.80 R/L
62+45.30 R/L
64+00.00 R/L

BM "11"
36" MAPLE
FL 755.42

BM "9" SUR 36" LIM 19" LT SUR 54" MAPLE FL 776.12
BM "10" SUR 18" MAPLE 25" LT SUR 61" 37" DUB 769.90
BM "11" SUR 30" LIM 24" LT SUR 66" 69" DUB 755.42

IRA - CLARENDON S211 (2)
Sheet 6 of 62 sheets



Rev Curve Data
 Δ 21° 11' Lt
D 4' 30"
R 1273.6
T 238.1
L 470.7
E 22.1
Bank 1/4 per ft

Rev Curve Data
 Δ 9° 13' 30" L
D 4'
R 1432.7
T 115.5
L 230.4
E 4.7
Bank 1/2° per ft

