



SEEDING COMMERCIAL FERTILIZER
FOR GRASSES AND TOPSOIL IN MEDIAN
530+34.2 - 533+00.0

THREE CABLE GUARD RAIL
WITH STEEL POSTS
530+34 - 533+00 LT
2-A MONTPELIER & BARRE RAILROAD CO.
A. 0742 STA 530+34 - 536+20
SLOPE RIGHTS -
STA 530+34 - 531+28 ±
STA 531+28 - 537+90 ±
STA 537+90 - 538+42 ±
STA 538+42 - 540+23 ±
CULVERT RIGHTS STA 530+64 ±
COND. 1/19/59
RECORDED: MONTPELIER - BK 90 - PG 373/80 - 1/19/59

GRANITE SLOPE EDGING
(MEDIAN)
530+34.2 - 533+00

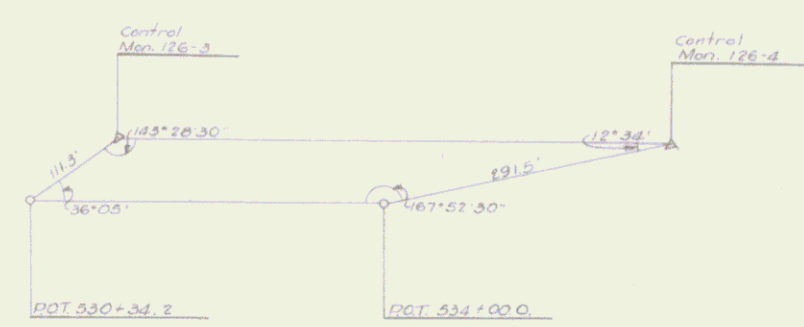

CROSS TIES to PHOTO CONTROL

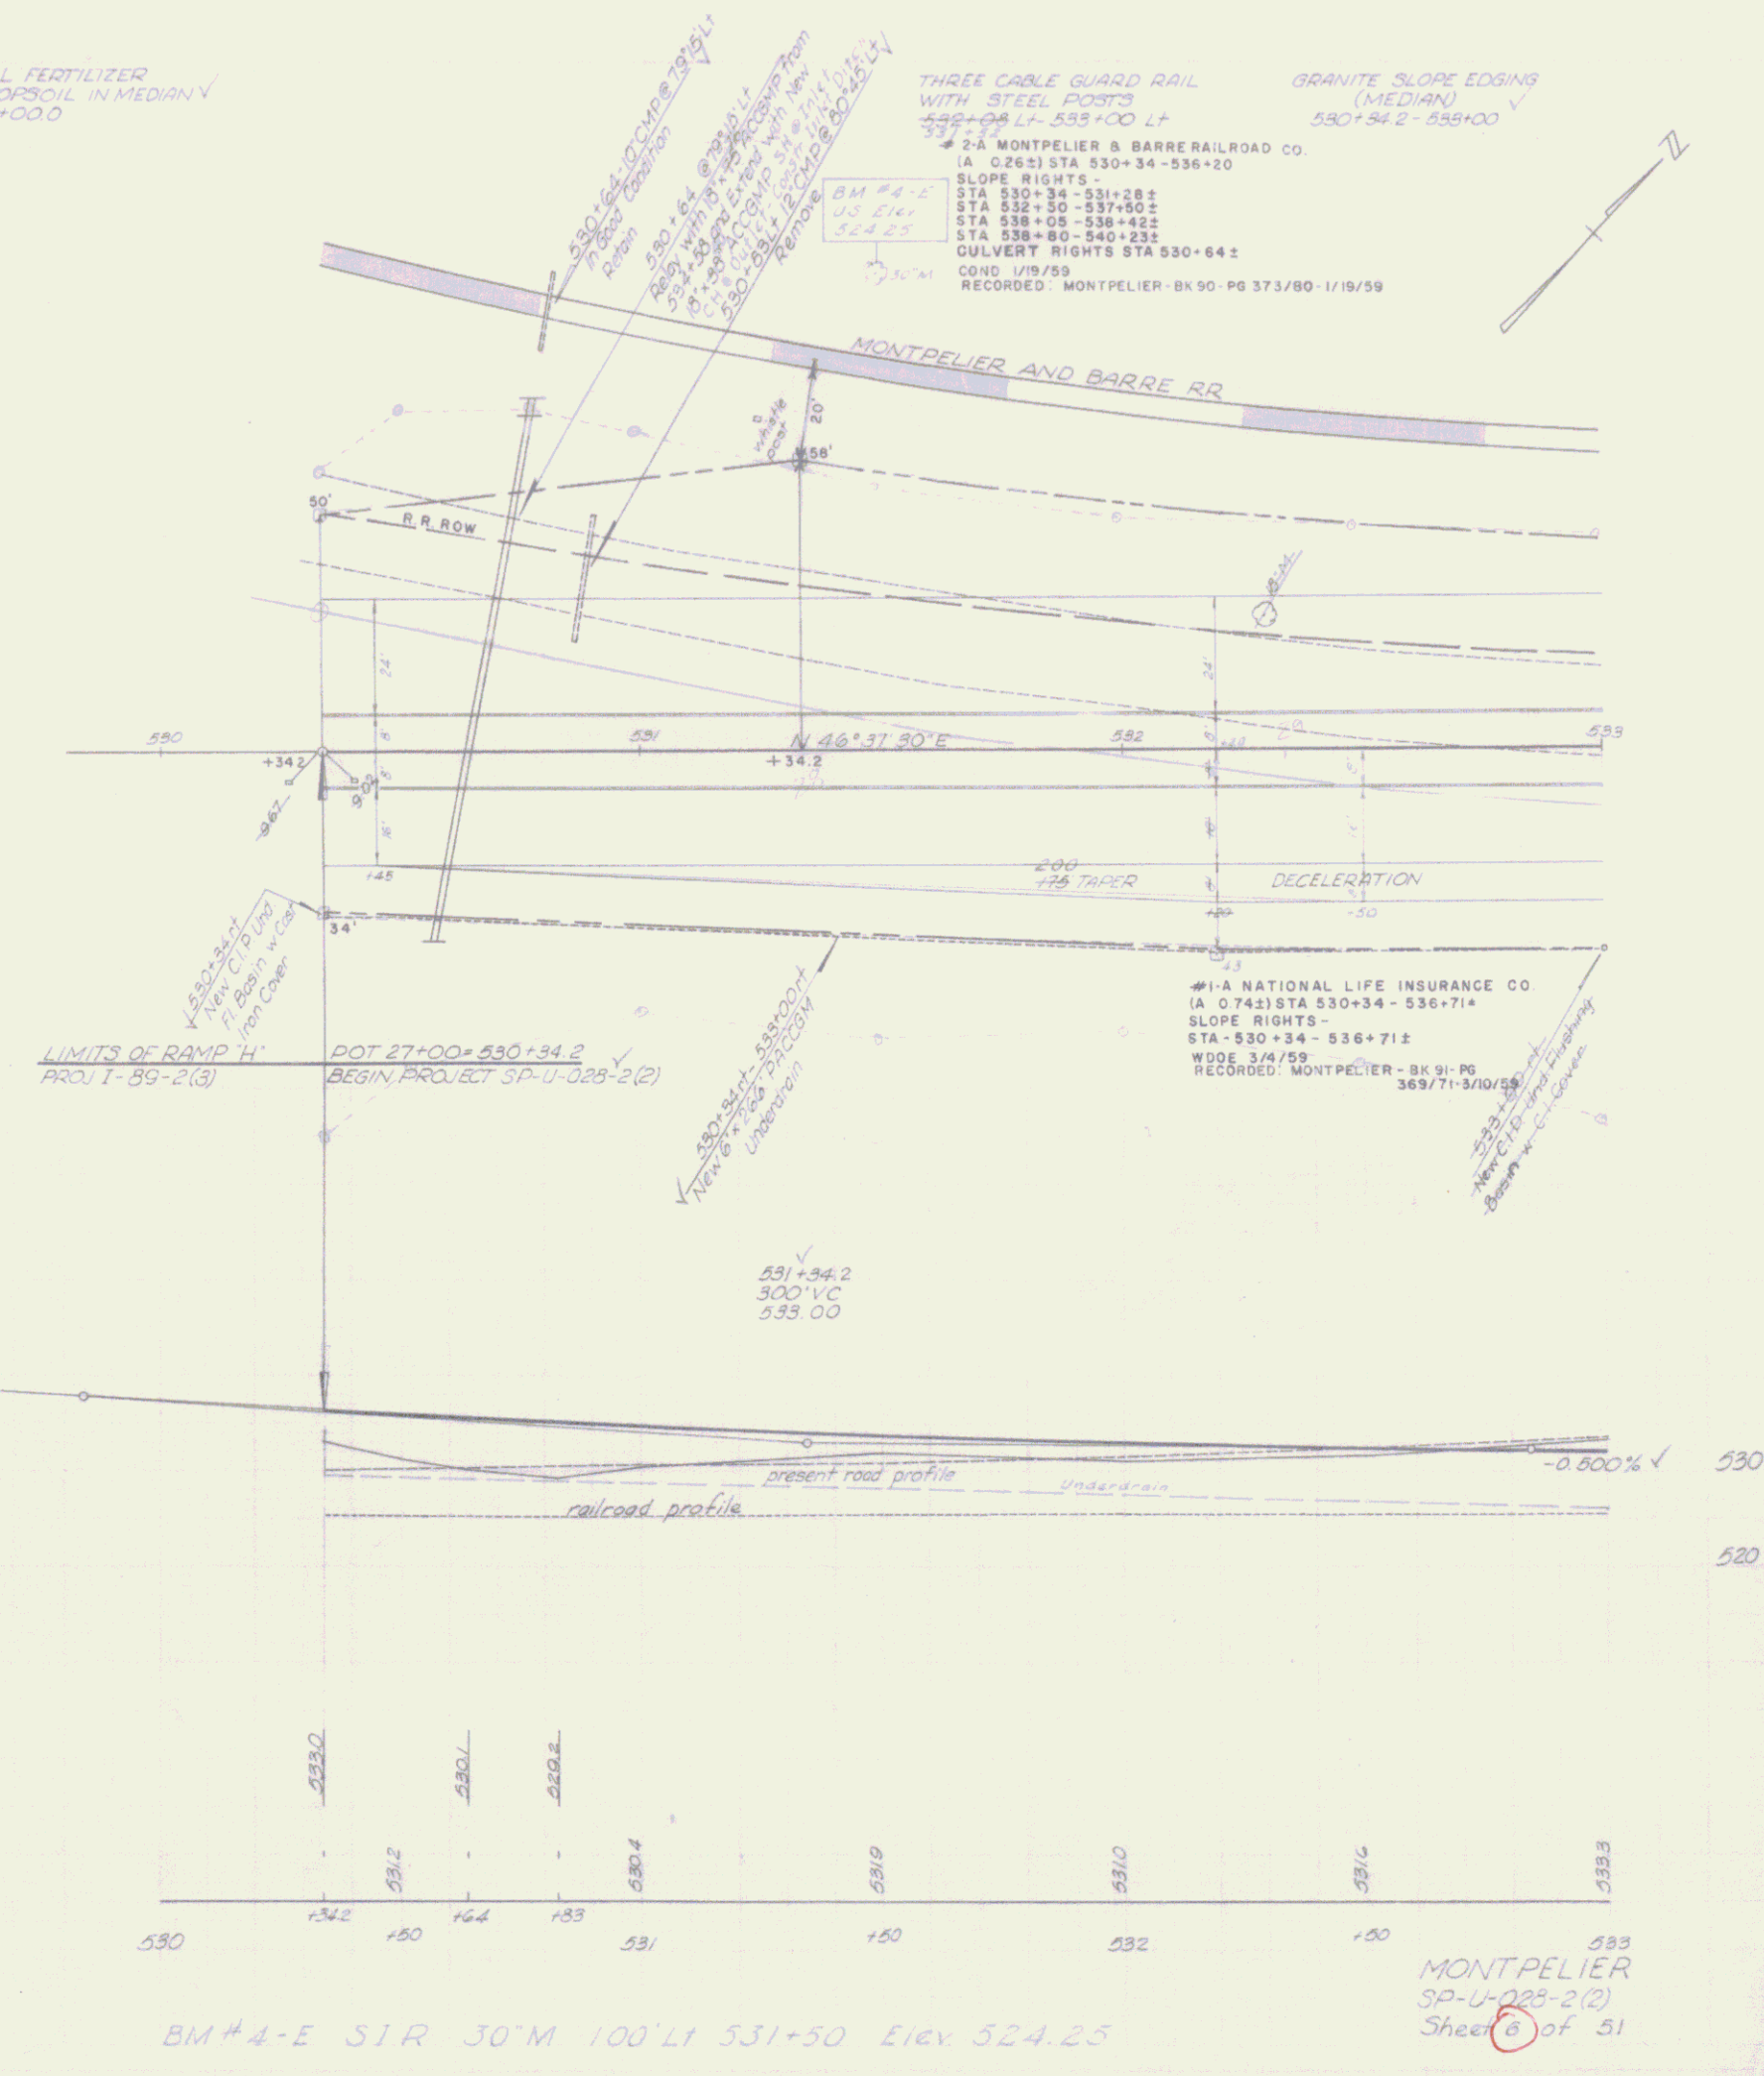

BM #4-E SIR 30" M 100' LI 531+50 Elev 524.25

MONTPELIER
SP-U-028-2(2)
Sheet 6 of 51