


Date 9/17/1965

Sta 18+00
Begin Project

MP
RIGHT-OF-WAY DIVISION
TOWN FILE
PERPETUAL
R.O.W. 242
Return of
(To Be Returned To R.O.W. Division)

SHEET 1

1997, 1998, 1999, 2678, 26

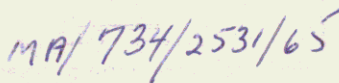

2