


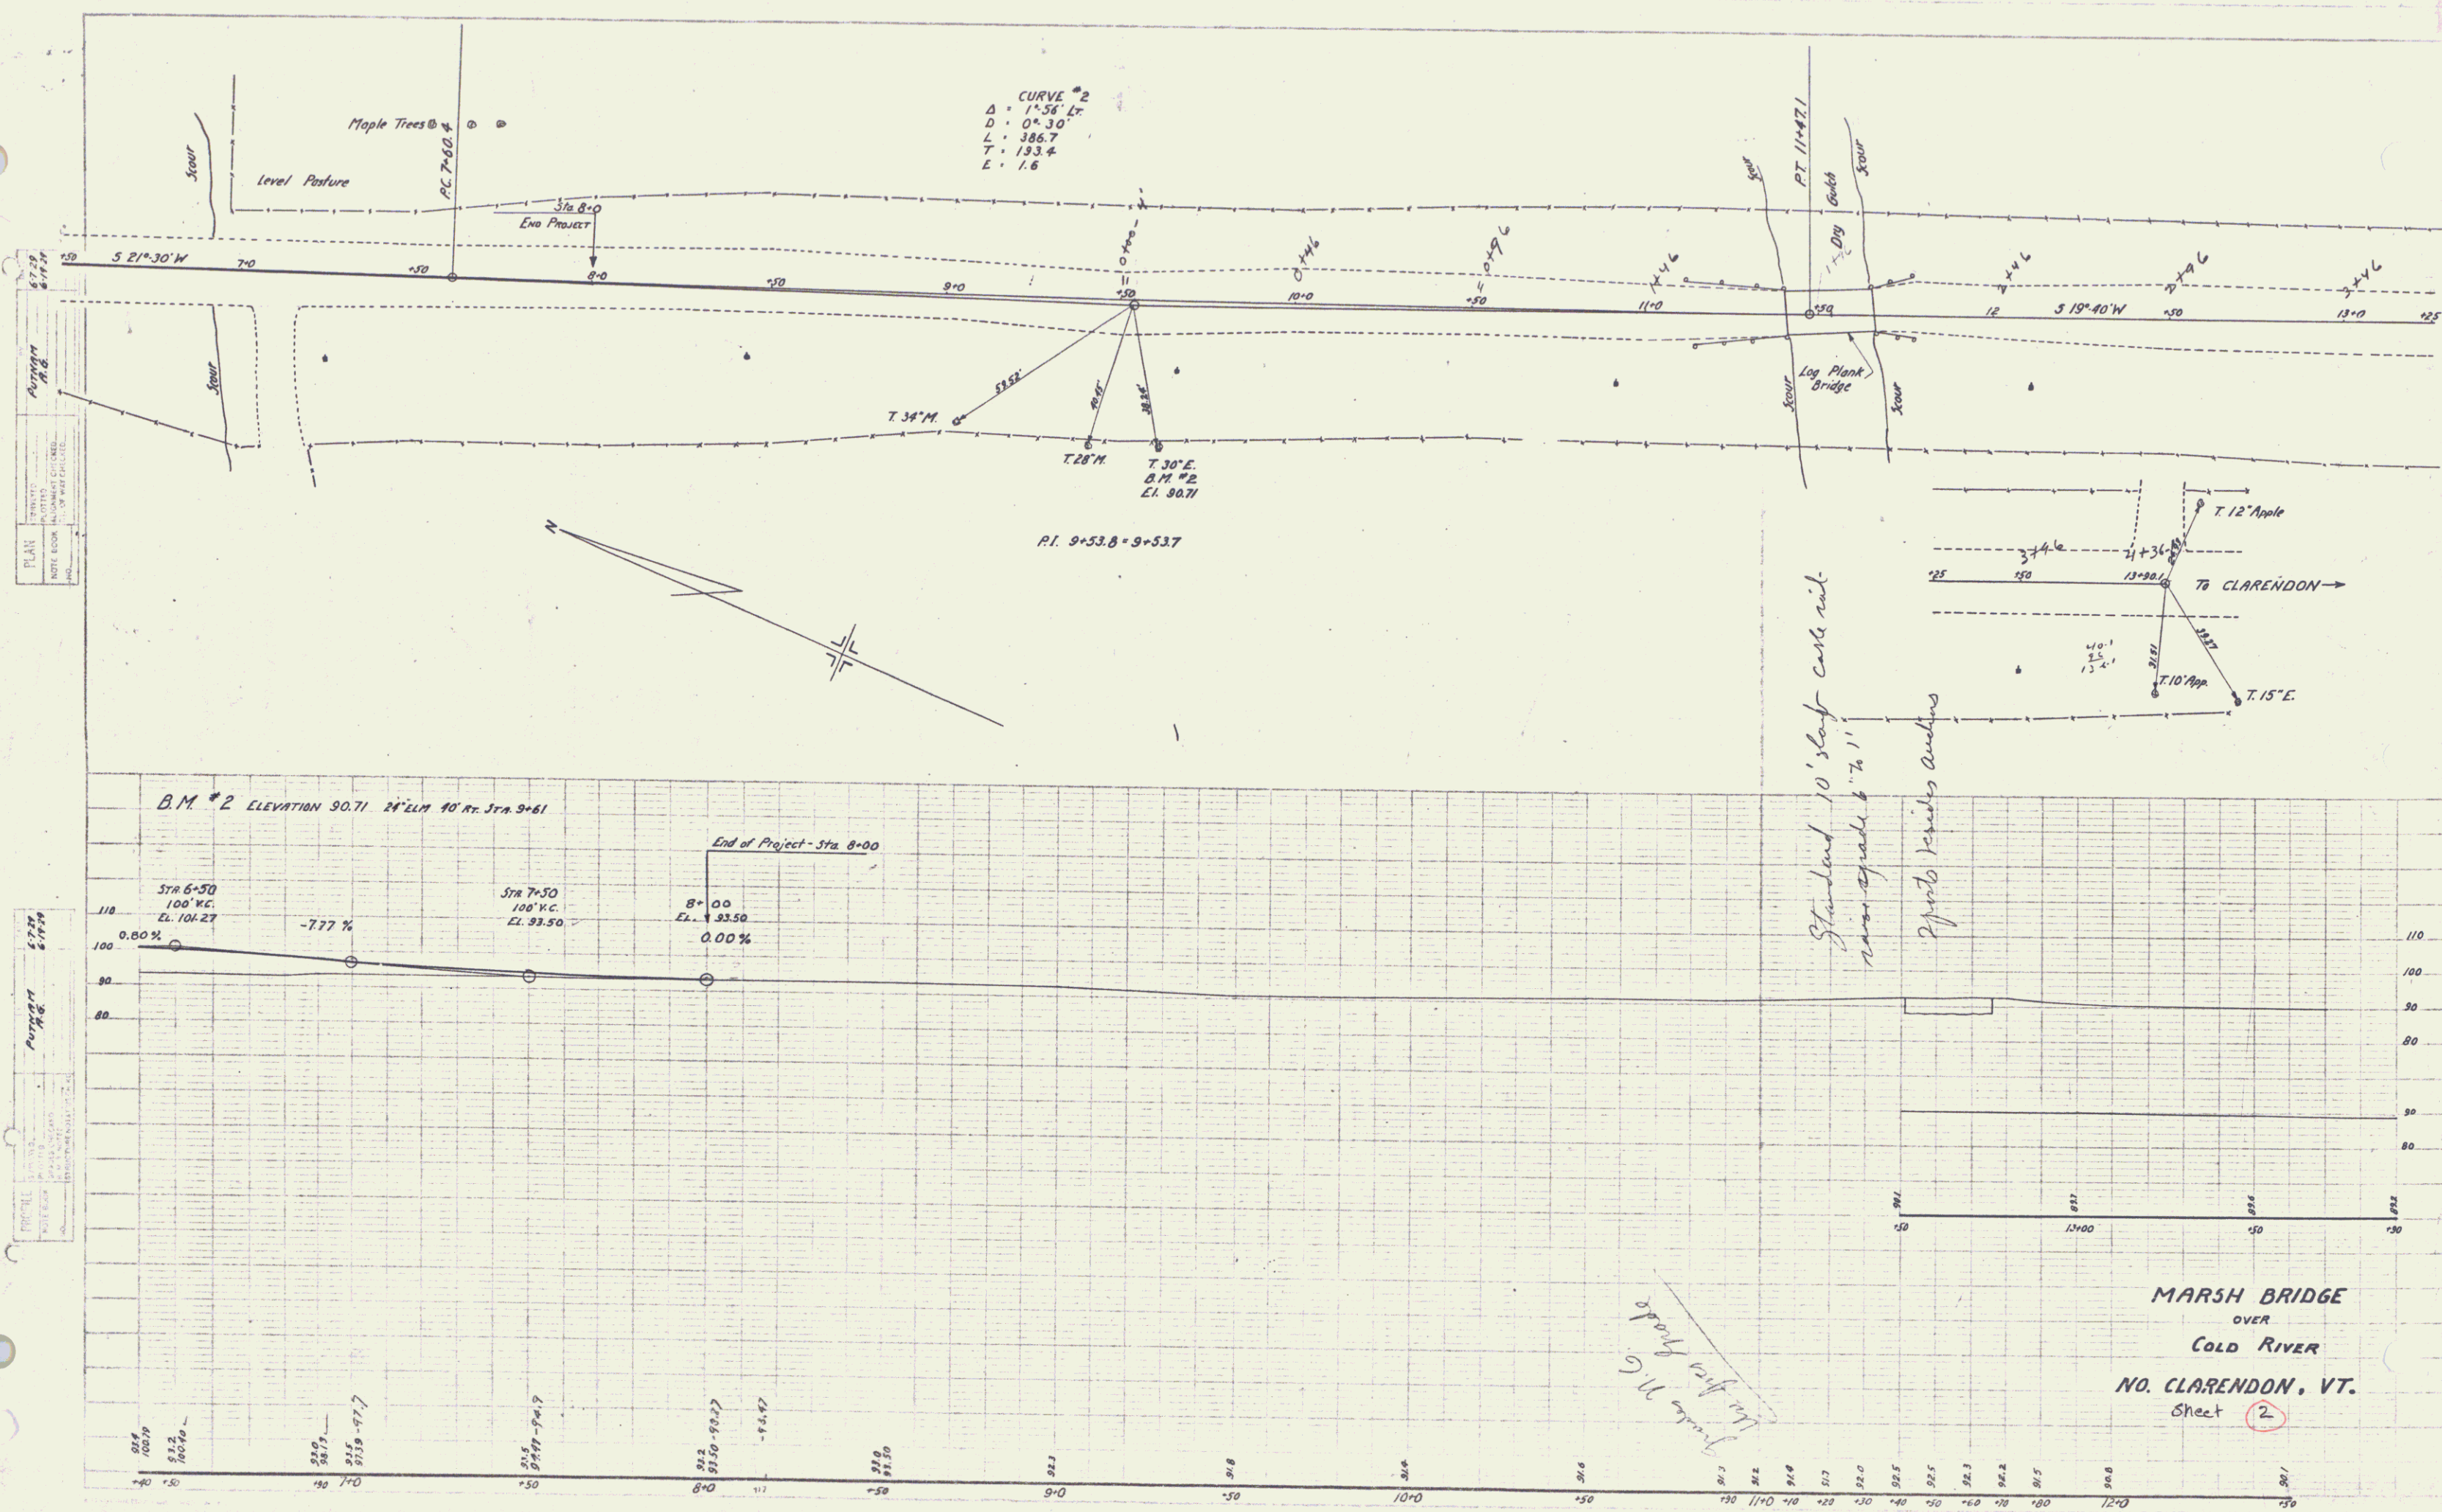

MARSH BRIDGE
OVER
COLD RIVER
NO. CLARENDON, VT.
Sheet 2

2