




PARCEL	INSTRUMENT	DATE	GRANTOR	GRANTEE	RECORDED	REMARKS
A	Q.C.D.	5-5-38	ORVILLE J. & AGNES A. YANDON	STOFV.	BOOK PAGE DATE OF RECORD 8-2-38 5-5-38	

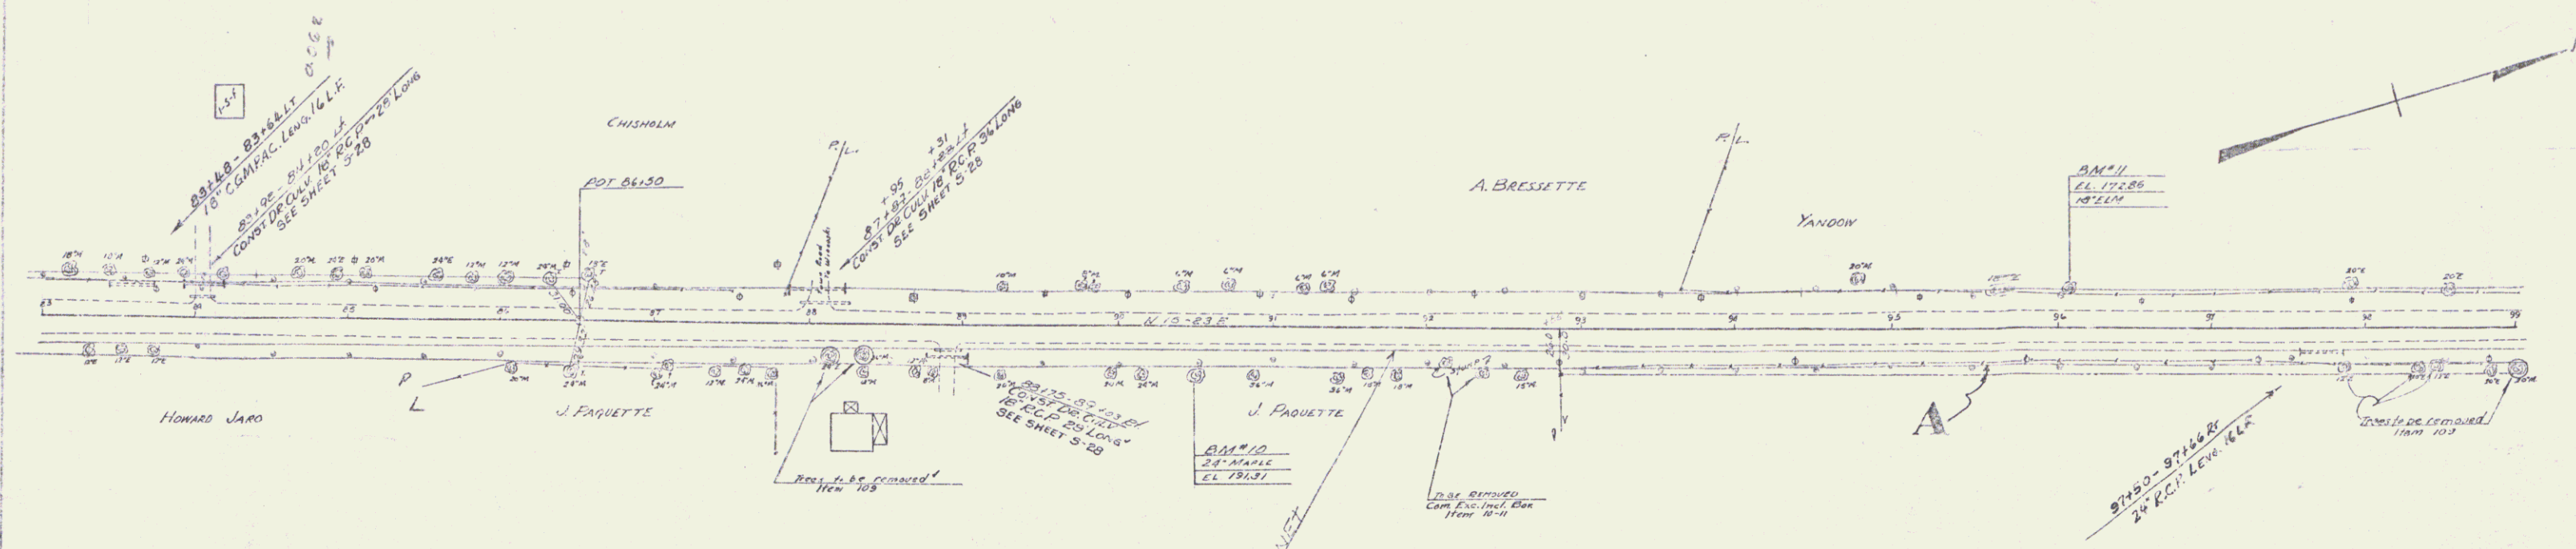