

INDEX OF SHEETS

SHEET NO.	TITLE PAGE
1	2 TYPICAL CROSS-SECTION OF IMPROVEMENT
2	3 BANKING & WIDENING TABLES
3	4-12 PLAN & PROFILE SHEETS
4	13 STANDARD STRUCTURE SHEET
5	14
6	15
7	16
8	17-39 CROSS SECTIONS

STANDARD STRUCTURE SHEETS 528-529 APPROVED BY THE CHIEF ENGINEER ON JULY 11, 1933.
STANDARD STRUCTURE SHEET 530 APPROVED BY THE CHIEF ENGINEER ON AUGUST 15, 1933.

STATE OF VERMONT STATE HIGHWAY DEPARTMENT

PLAN AND PROFILE OF PROPOSED STATE HIGHWAY

NATIONAL RECOVERY SECONDARY PROJECT

TOWNS OF ESSEX & COLCHESTER

ESSEX JCT.-COLCHESTER ROAD


FROM A POINT 100 FT. SOUTH OF THE RESIDENCE OF EUGENE PARISEAU NORTHERLY 2.091 MI. TO A POINT 200 FT. SOUTH OF THE RESIDENCE OF HENRY CROSS.

LENGTH OF PROJECT-11,040.9 FT.
= 2.091 MILES


Pin # 99R727

Route: VT-2A

Project: NRS 165

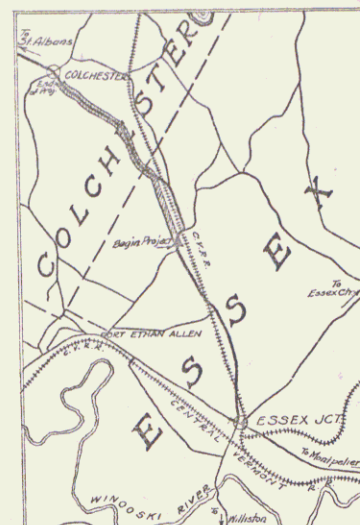

RECORD PLANS

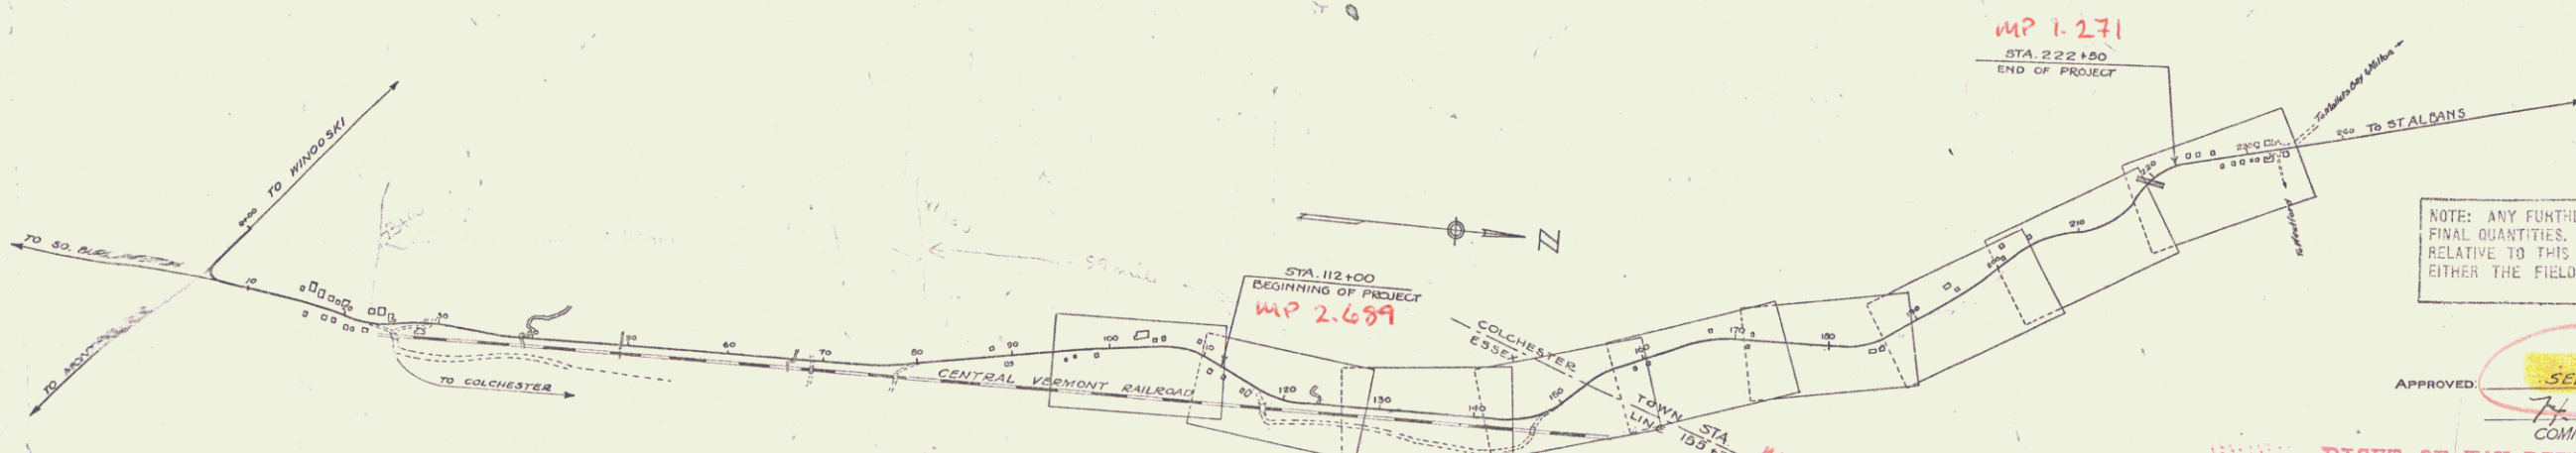

NOTE: ANY FURTHER INFORMATION CONCERNING FINAL QUANTITIES, AMOUNTS OR OTHERS RELATIVE TO THIS PROJECT MAY BE FOUND EITHER THE FIELD BOOKS OR THE RECORD PLANS.

APPROVED: *[Signature]*
COMMISSIONER OF HIGHWAYS

RIGHT-OF-WAY DIVISION
TOWN FILE

PERPETUAL

VT-2A

(To Be Returned To R.O.W. Division)

These plans are subject to such revisions as may be required by the Bureau of Public Roads or the Commissioner of Highways.
Construction is to be carried on in accordance with the Standard Road & Bridge Specifications of 1930 with all subsequent approved revisions and such specifications and special provisions as are submitted with the plans.

CONVENTIONAL SIGNS

COUNT	TOWN	FENCE
VT-2A		

SCALES

TITLE	SCALE
PLAN	1" = 100 FT.

CURVE DATA

RECORD PLANS BY ROUTE	RECORD PLANS BY ROUTE
ESSEX - COLCHESTER	ESSEX - COLCHESTER
165	165
(1935)	(1935)

RECOMMENDED FOR APPROVAL

CHIEF ENGINEER BUREAU OF HIGHWAYS

APPROVED

DIRECTOR BUREAU OF PUBLIC ROADS

CORRECT



SERIES 165, F. (1935)

SHEET 1 OF 39



DIST. #5 PLANS


Pence	Kind of Instrument	Date of Instrument	Grantor	Grantee	Recorded	Remarks
B1	C.C.D.	10-21-35	Henry Conno	St. J. H.	41 35	10-24-35
A. G. W. H. D.		10-21-35	Gilbert Parizo	"	41 40	10-25-35 Cult. Stn. 10703.411111

W.P.S.S.	165D	1936	5	16
W.P.S.S.	165D	1936	5	16

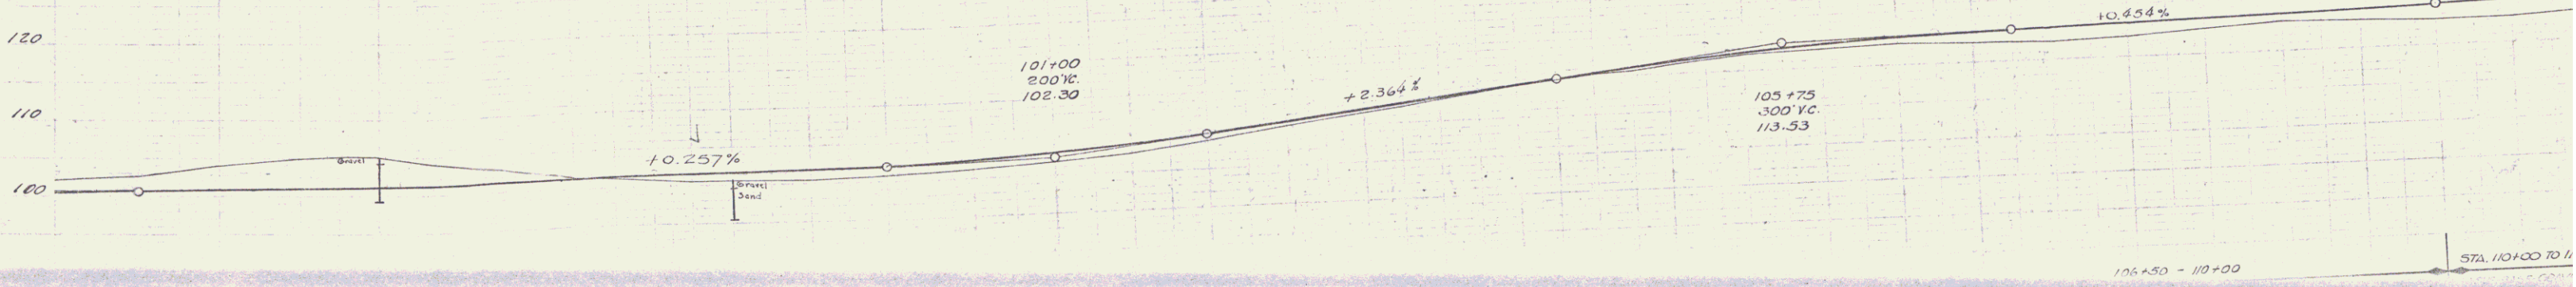
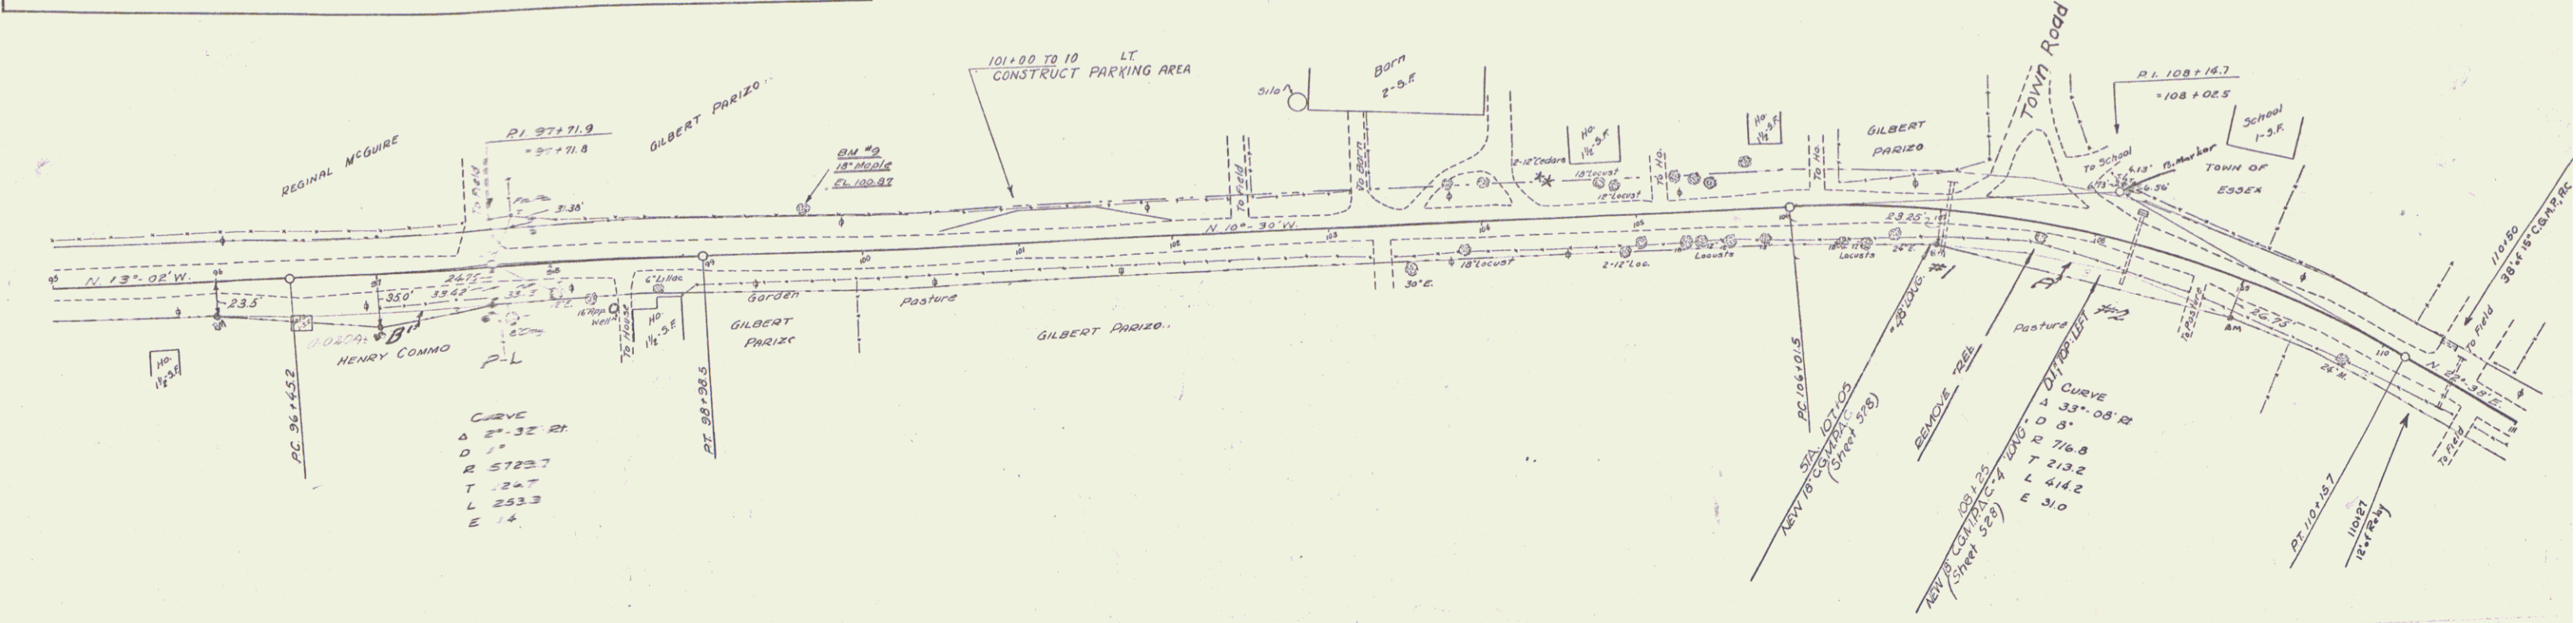


571.93.00 TO 93.00										SWAMP COURSE OF GRAVEL										12' SW/3 3.22 - GRAVEL										SHIPPING COURSE																																																																																																																																																																																																																																																																																																																																																																																																																																																																																																																																																																																																																																																																																																																																																																																																																																																														
12' SUB-BASE OF GRAVE																																																																																																																																																																																																																																																																																																																																																																																																																																																																																																																																																																																																																																																																																																																																																																																																																																																																																												
126.1	100.69									101.4	100.69	100.92	100.92	104.0	101.01		105.0	101.14	105.2	105.2	105.1	105.1	104.27		104.5	101.53		106.6	101.66	106.6	106.6	
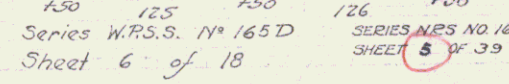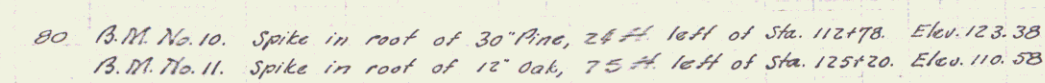


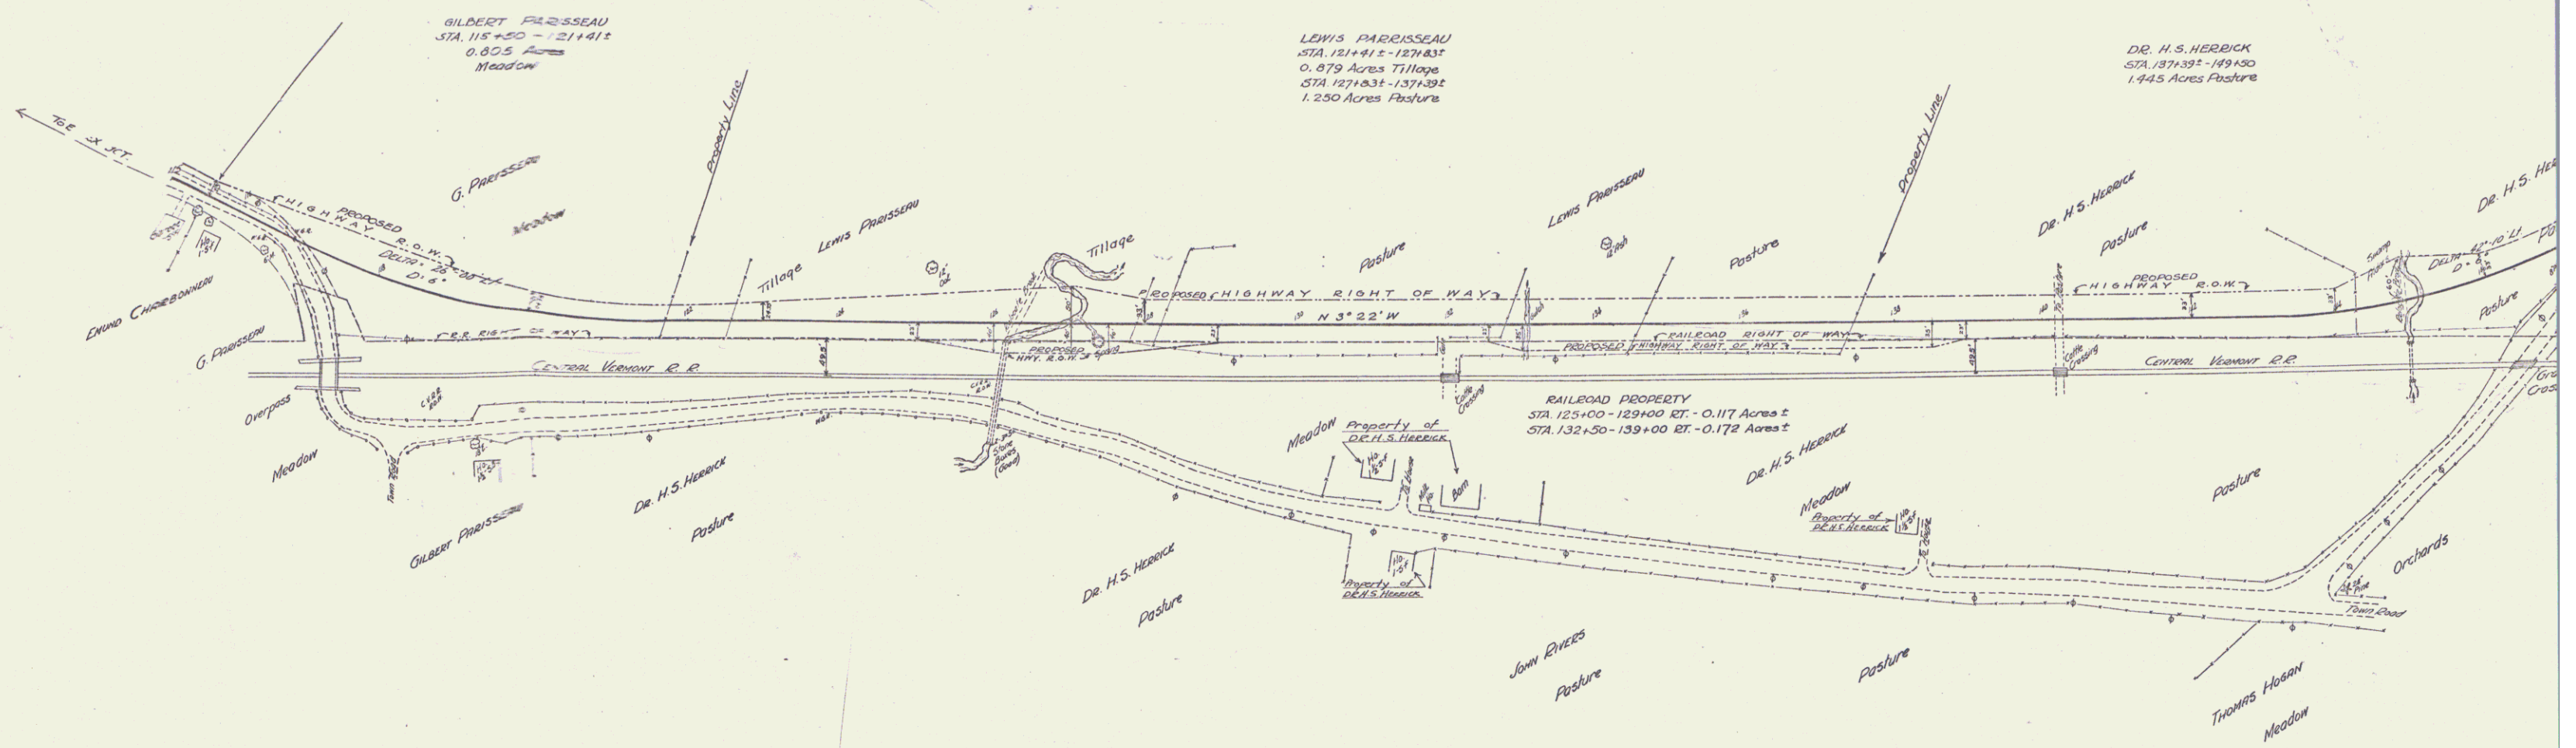


Sheet 5A

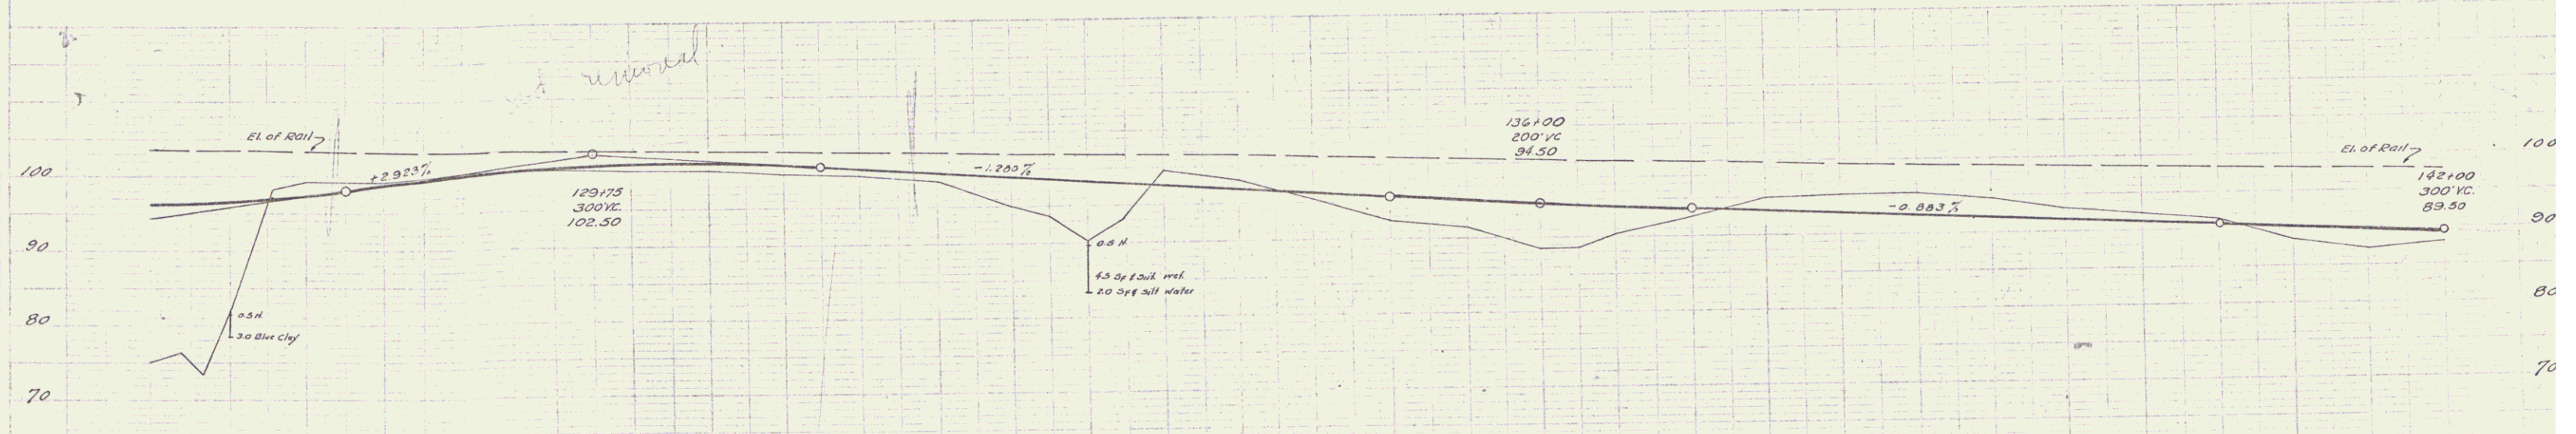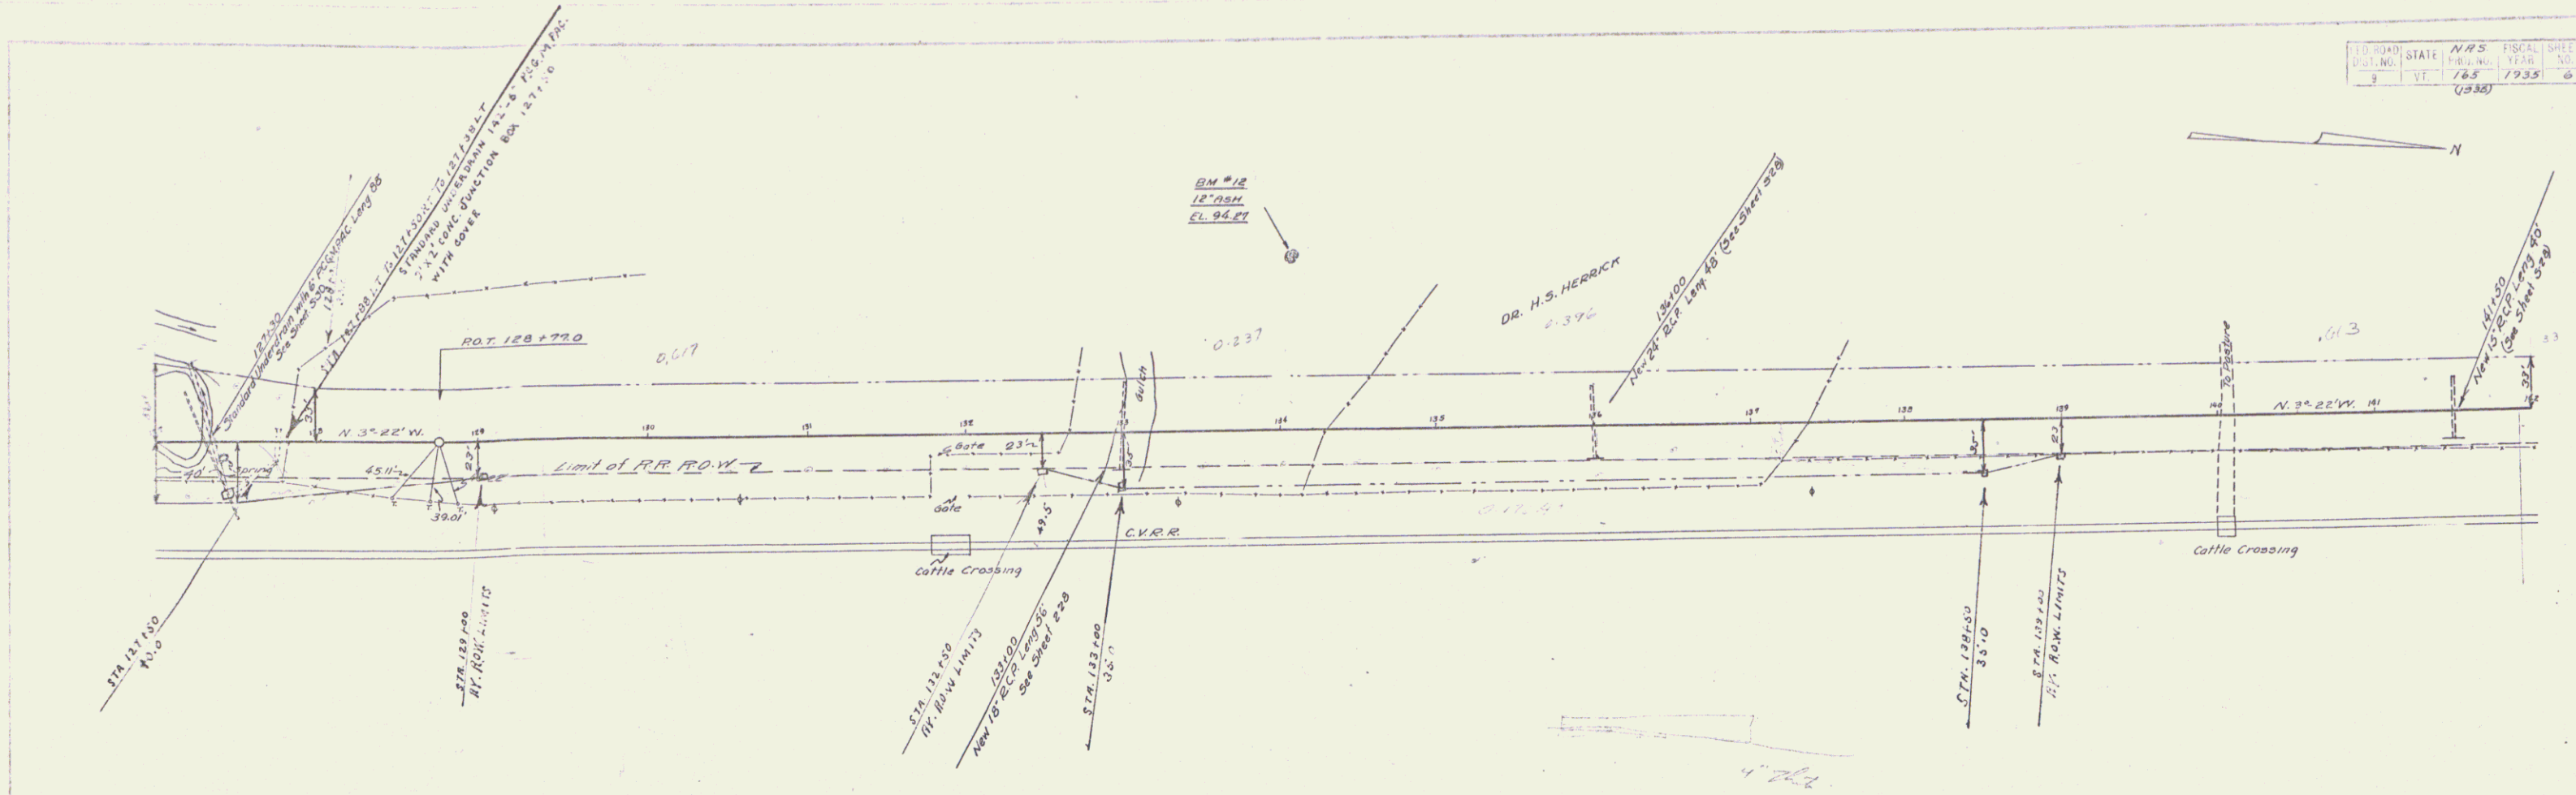


B.M. No. 12. Spike in root of 12' Ash, 110 ft. left of Sta. 126+16. Elev 94.27

127	128	129	130	131	132	133	134	135	136	137	138	139	140	141	142
94.20	94.25	94.30	94.35	94.40	94.45	94.50	94.55	94.60	94.65	94.70	94.75	94.80	94.85	94.90	94.95
94.20	94.25	94.30	94.35	94.40	94.45	94.50	94.55	94.60	94.65	94.70	94.75	94.80	94.85	94.90	94.95

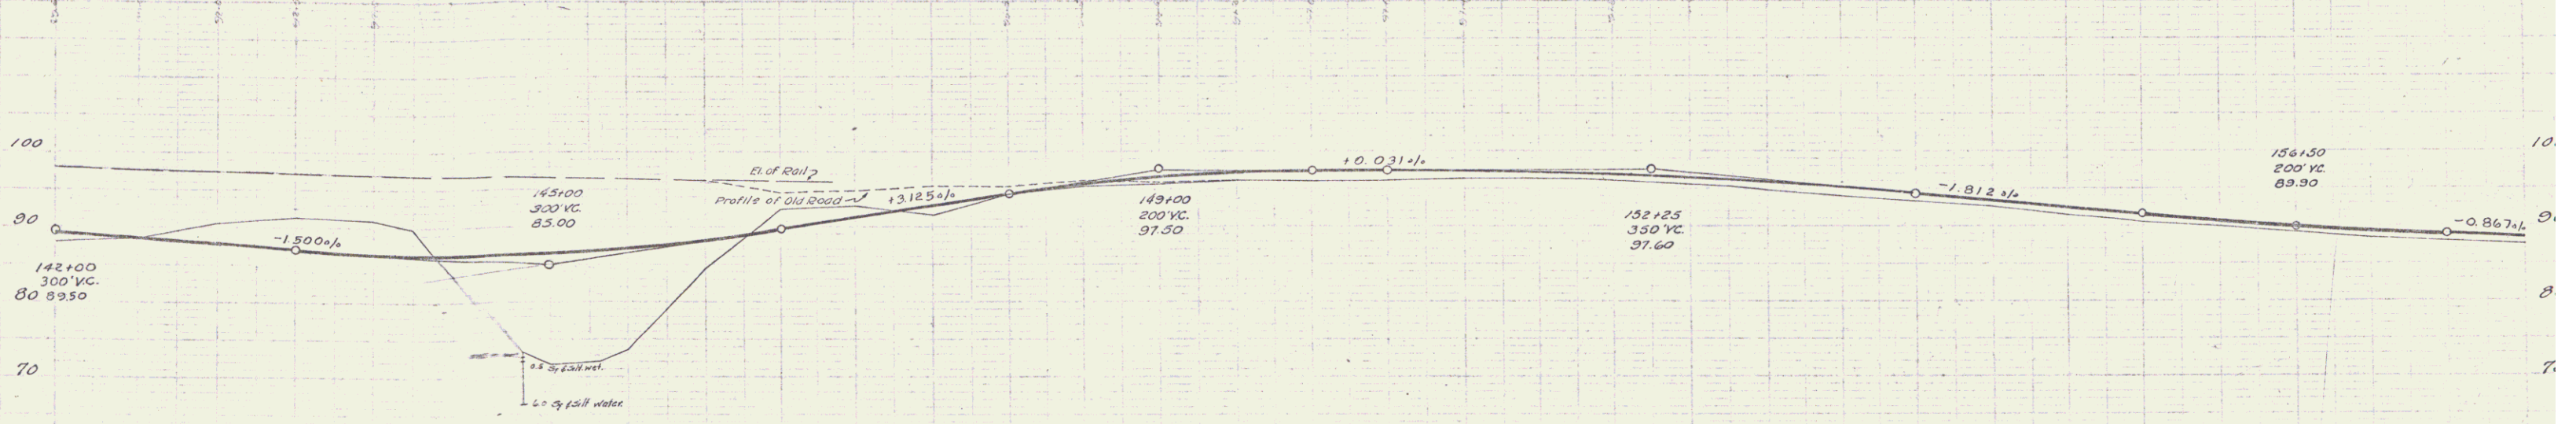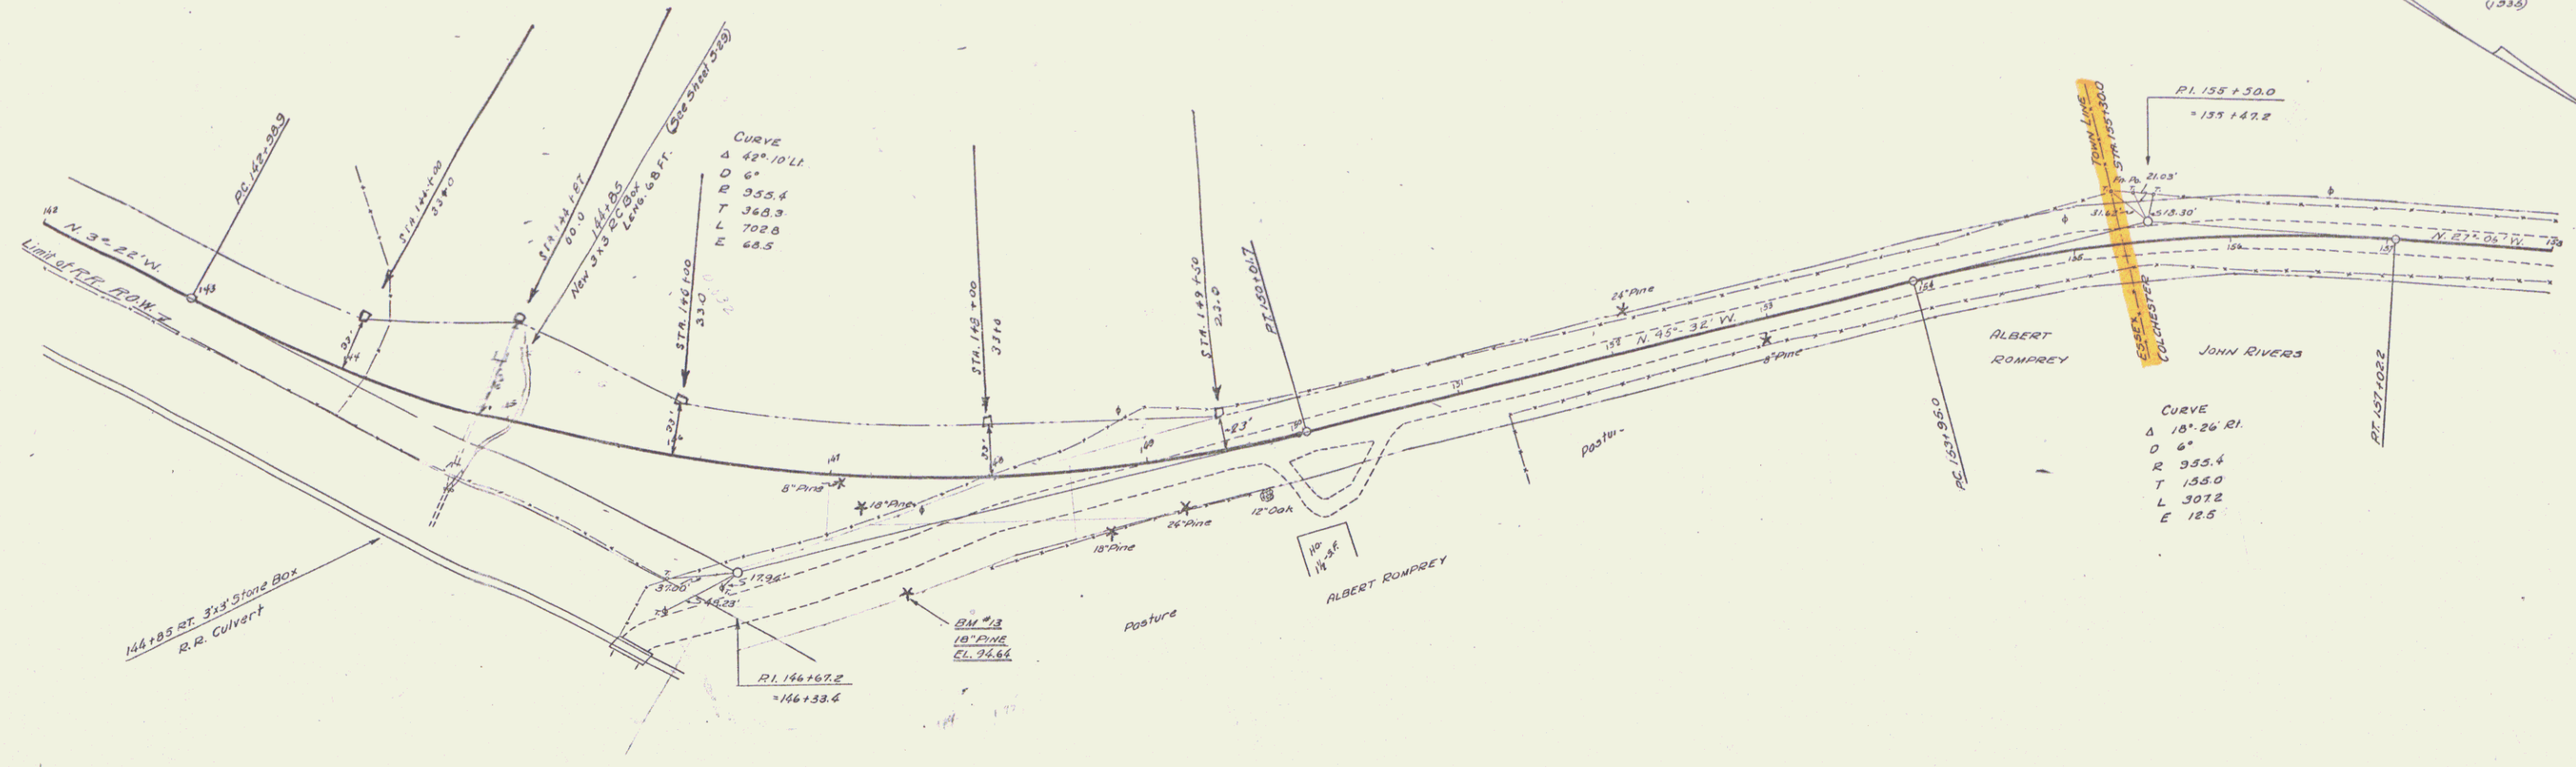

88.0	88.25	88.5	383.5	383.7
------	-------	------	-------	-------	--------	-------	--------	-------	-------

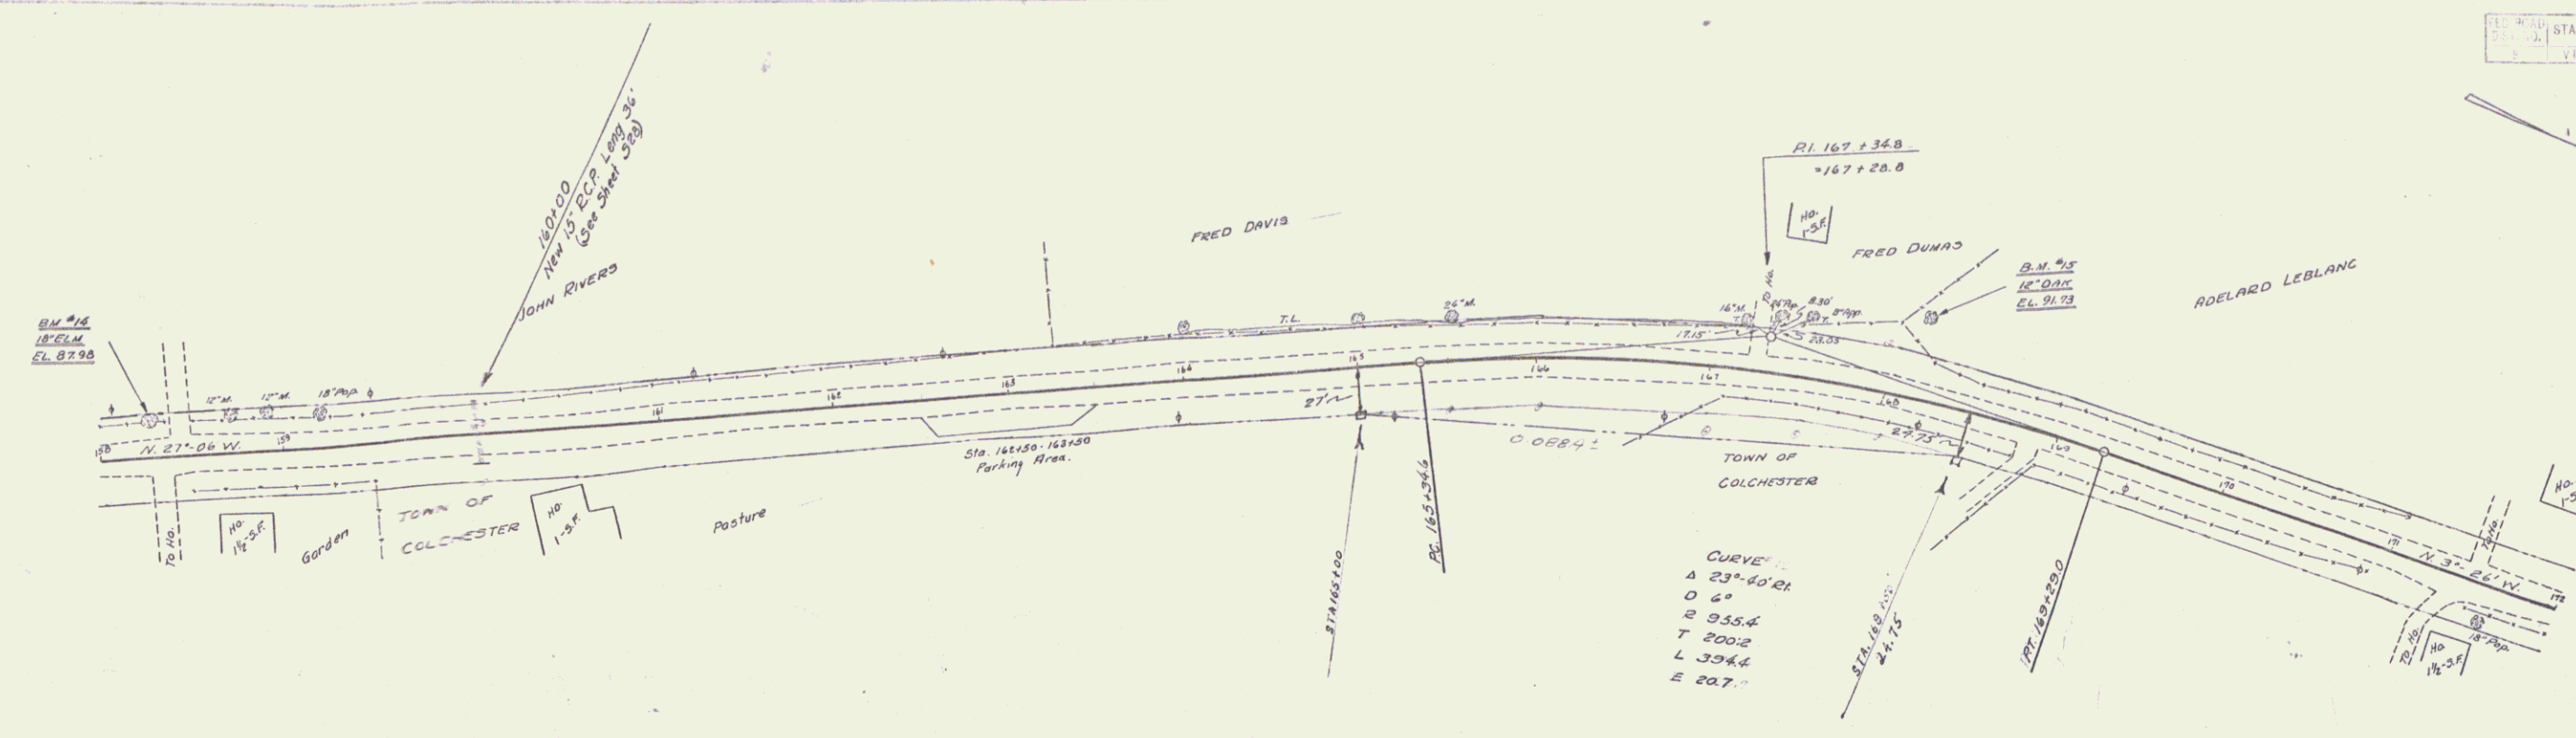



1954
 PLANNING
 TRACED
 1954

1954
 PLANNING
 TRACED
 1954



A.M. N. 16. Spike in cut 15' E. of Sta. 158+25. Elev. 87.98

87.6	87.5	87.4	0.0	-0.1	-0.2	-0.3	-52.1
------	------	-----	-----	------	------	-------	-------	
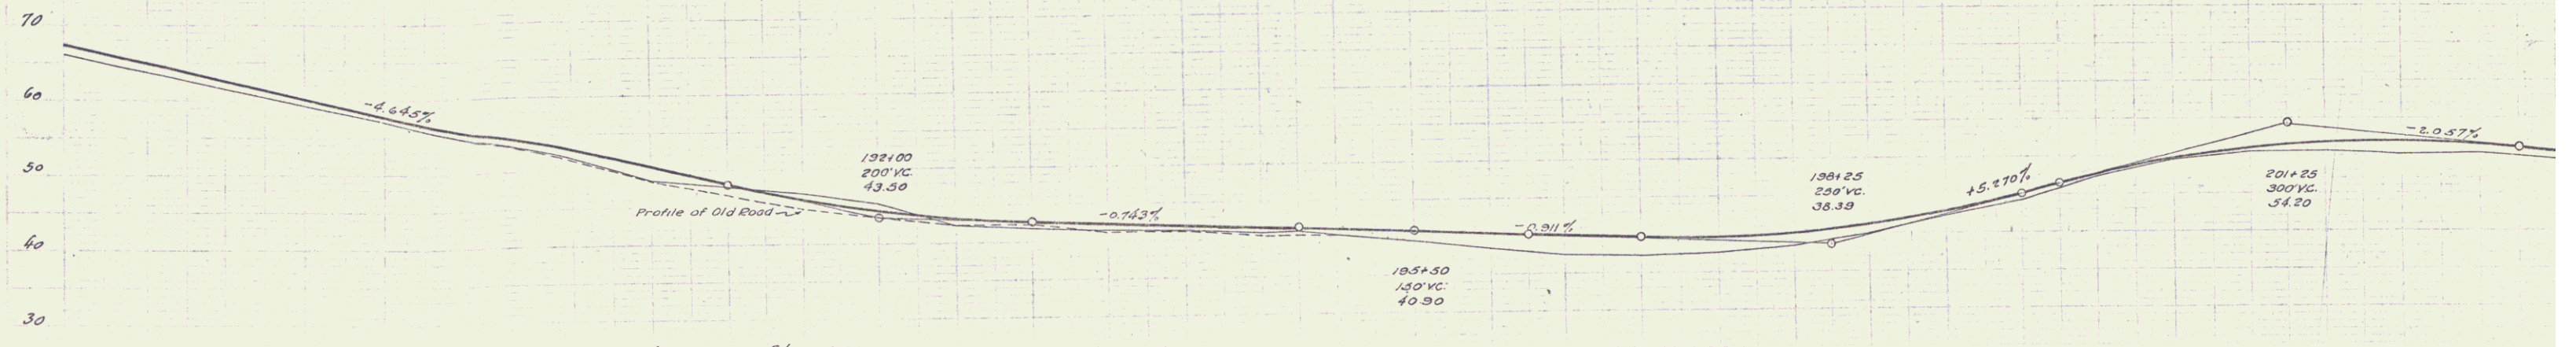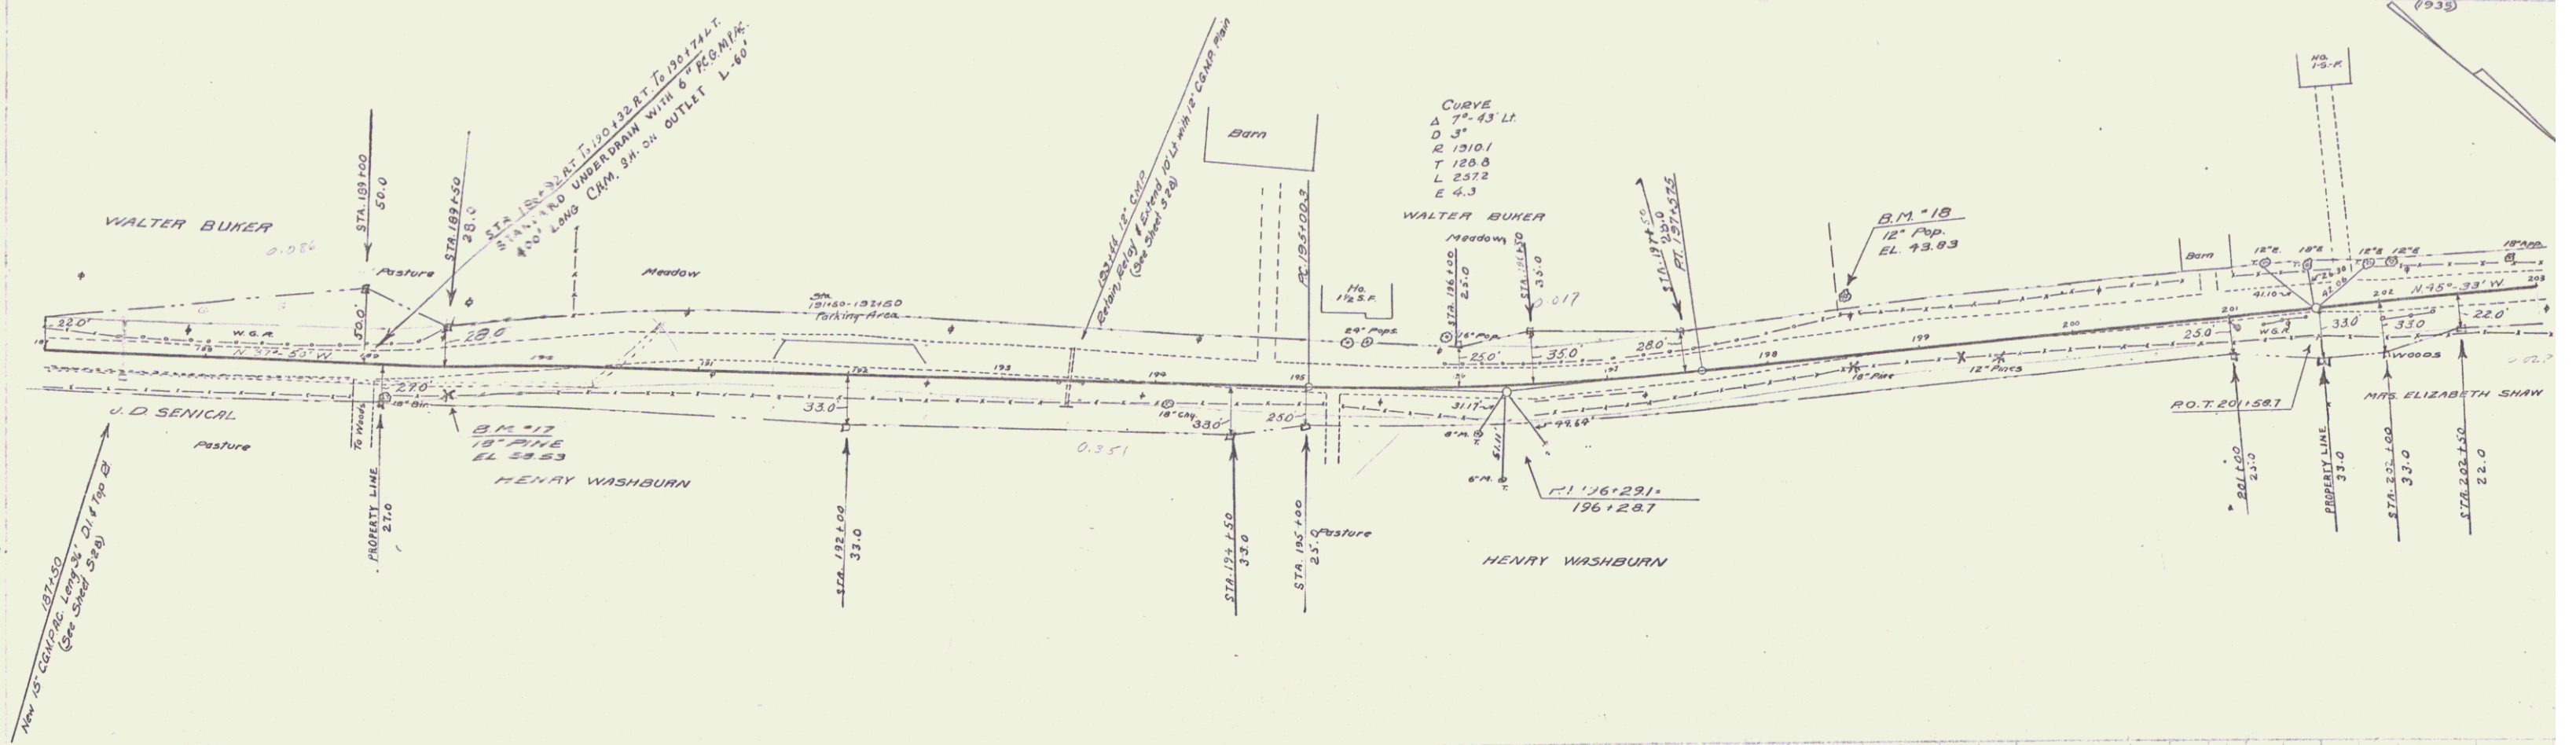

187	188	189	1652
-----	-----	------	------	
