

INDEX OF SHEETS		
SHEET NO.	TITLE PAGE	
2	TYPICAL CROSS-SECTION OF IMPROVEMENT	
3	PLAN AND PROFILE STA. 0+00 to 13+00	
4	" " " " 13+00 to 29+00	
5	" " " " 29+00 to 45+00	
6	" " " " 45+00 to 61+00	
7	" " " " 61+00 to 75+00	
8	" " " " 75+00 to 91+00	
9	" " " " 91+00 to 107+00	
10	" " " " 107+00 to 123+00	
11	" " " " 123+00 to 138+00	
12	" " " " 138+00 to 151+00	
13	" " " " 151+00 to 167+00	
14	" " " " 167+00 to 179+00	
15	" " " " 179+00 to 194+00	
16	" " " " 194+00 to 209+00	
17	" " " " 209+00 to 223+00	
18	" " " " 223+00 to 237+00	
19	" " " " 237+00 to 251+00	
20	" " " " 251+00 to 267+00	
21	APPROACH SLAB FOR BRIDGES	
22-28	DETAILS OF BRIDGE	
29	" " " " 171+70.5	
30-72	CROSS SECTIONS	
30	BEGINNING OF PROJECT	
31	STA. 0+00	
32	MP 2.231	


STATE OF VERMONT
STATE HIGHWAY DEPARTMENT

PLAN AND PROFILE OF PROPOSED
STATE HIGHWAY

TOWNS OF CASTLETON - FAIR HAVEN *Route Vt 4A*
GATEWAY ROAD *Pin# 99R742* *Project F-65D*

BEGINNING AT THE EASTERN END OF CONCRETE PAVEMENT IN FAIRHAVEN VILLAGE AND
EXTENDING EASTERLY TO FIRST CONCRETE BRIDGE EAST OF CASTLETON VILLAGE
LENGTH 4.8 MILES

SCALES
PLAN 1" = 50'
PROFILE (HORIZ. 1" = 50'
VERT. 1" = 10')
SECTIONS 1" = 5'

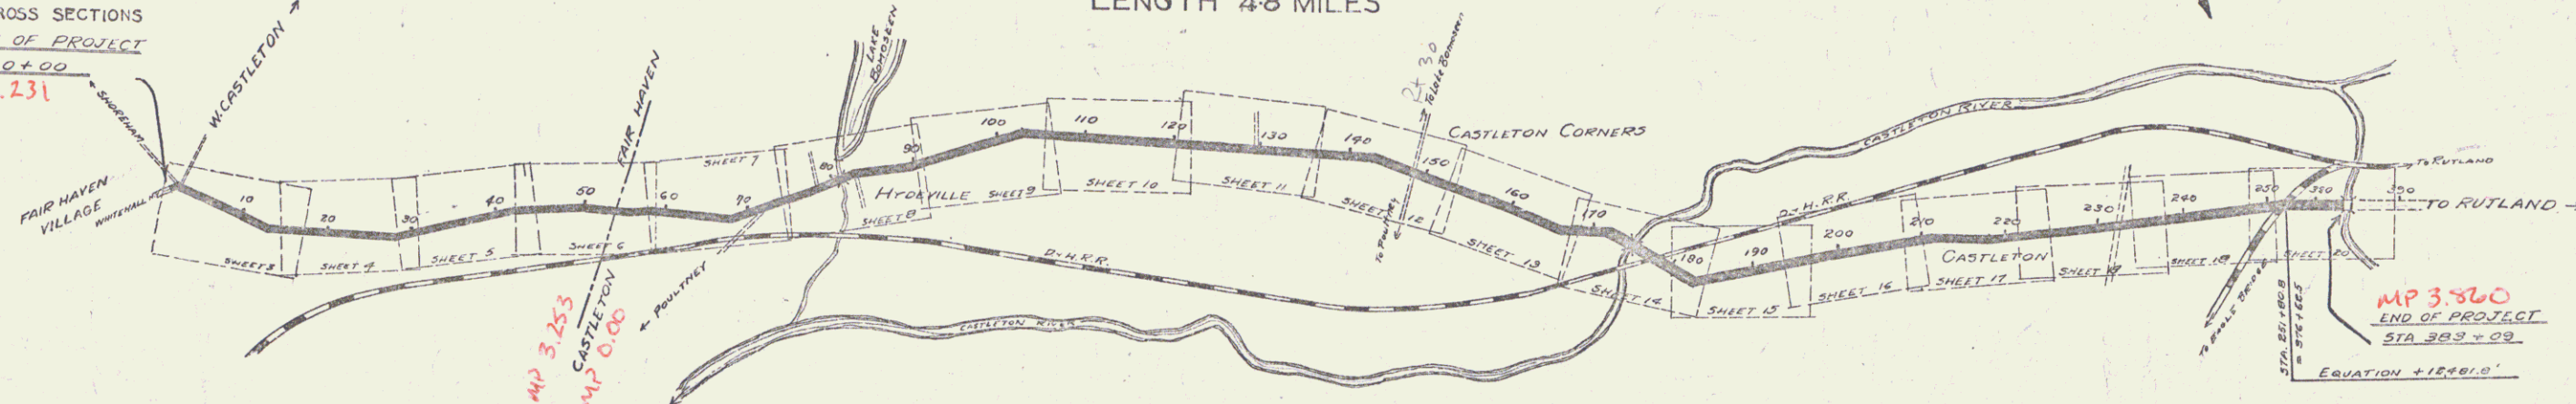

LAYOUT

SCALE ~ 1000 FEET = 1 INCH

PROJECT	Castleton - Fair Haven
NUMBER	65-D
TYPE	Concrete
CONTRACTOR	D. J. Holland
LOCATION	See Plan and Profile
YEAR	1927

CONVENTIONAL SIGNS

GROUND ELEVATION	DATUM	LINE
GRADE ELEVATION	DATUM	LINE
CURVE DATA		
DEFLECTION ANGLE	Δ	
DEGREE OF CURVE	D.	
RADIUS OF CURVE	R.	
TANGENT DISTANCE	T.	
LENGTH OF CURVE	L.	
EXTERNAL DISTANCE	E.	
POINT OF INTERSECTION	P.I.	
POINT OF CURVE	P.C.	
POINT OF TANGENT	P.T.	

NOTE: These Plans (as revised in red) form a part of
the Record Plans for Project F-65(D) 1927 as
well as the original Plans for F-65(D) 1927.

RECORD PLANS

APPROVED: *H.E. Sargent*
AUGUST 23, 1927
CHIEF ENGINEER

SUBMITTED BY ORDER OF THE STATE HIGHWAY BOARD
AUGUST 23, 1927

L. B. Bates
COMMISSIONER OF HIGHWAYS

NOTE: ANY FURTHER INFORMATION CONCERNING
THIS PROJECT MAY BE FOUND IN
EITHER THE FIELD BOOKS OR THE ESTIMATE
FILE.

RIGHT-OF-WAY DIVISION

TOWN FILE

PERPETUAL

Town of *U 4 A*

(To Be Returned To R.O.W. Division)

SERIES No. FILED
SHEET 1 OF 72