
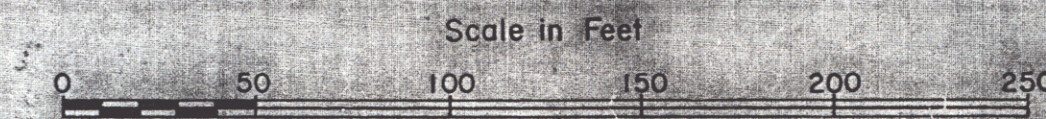


Acquired by State of Vermont
WD, 10-19-71, Bk. O-195, Pg. 74

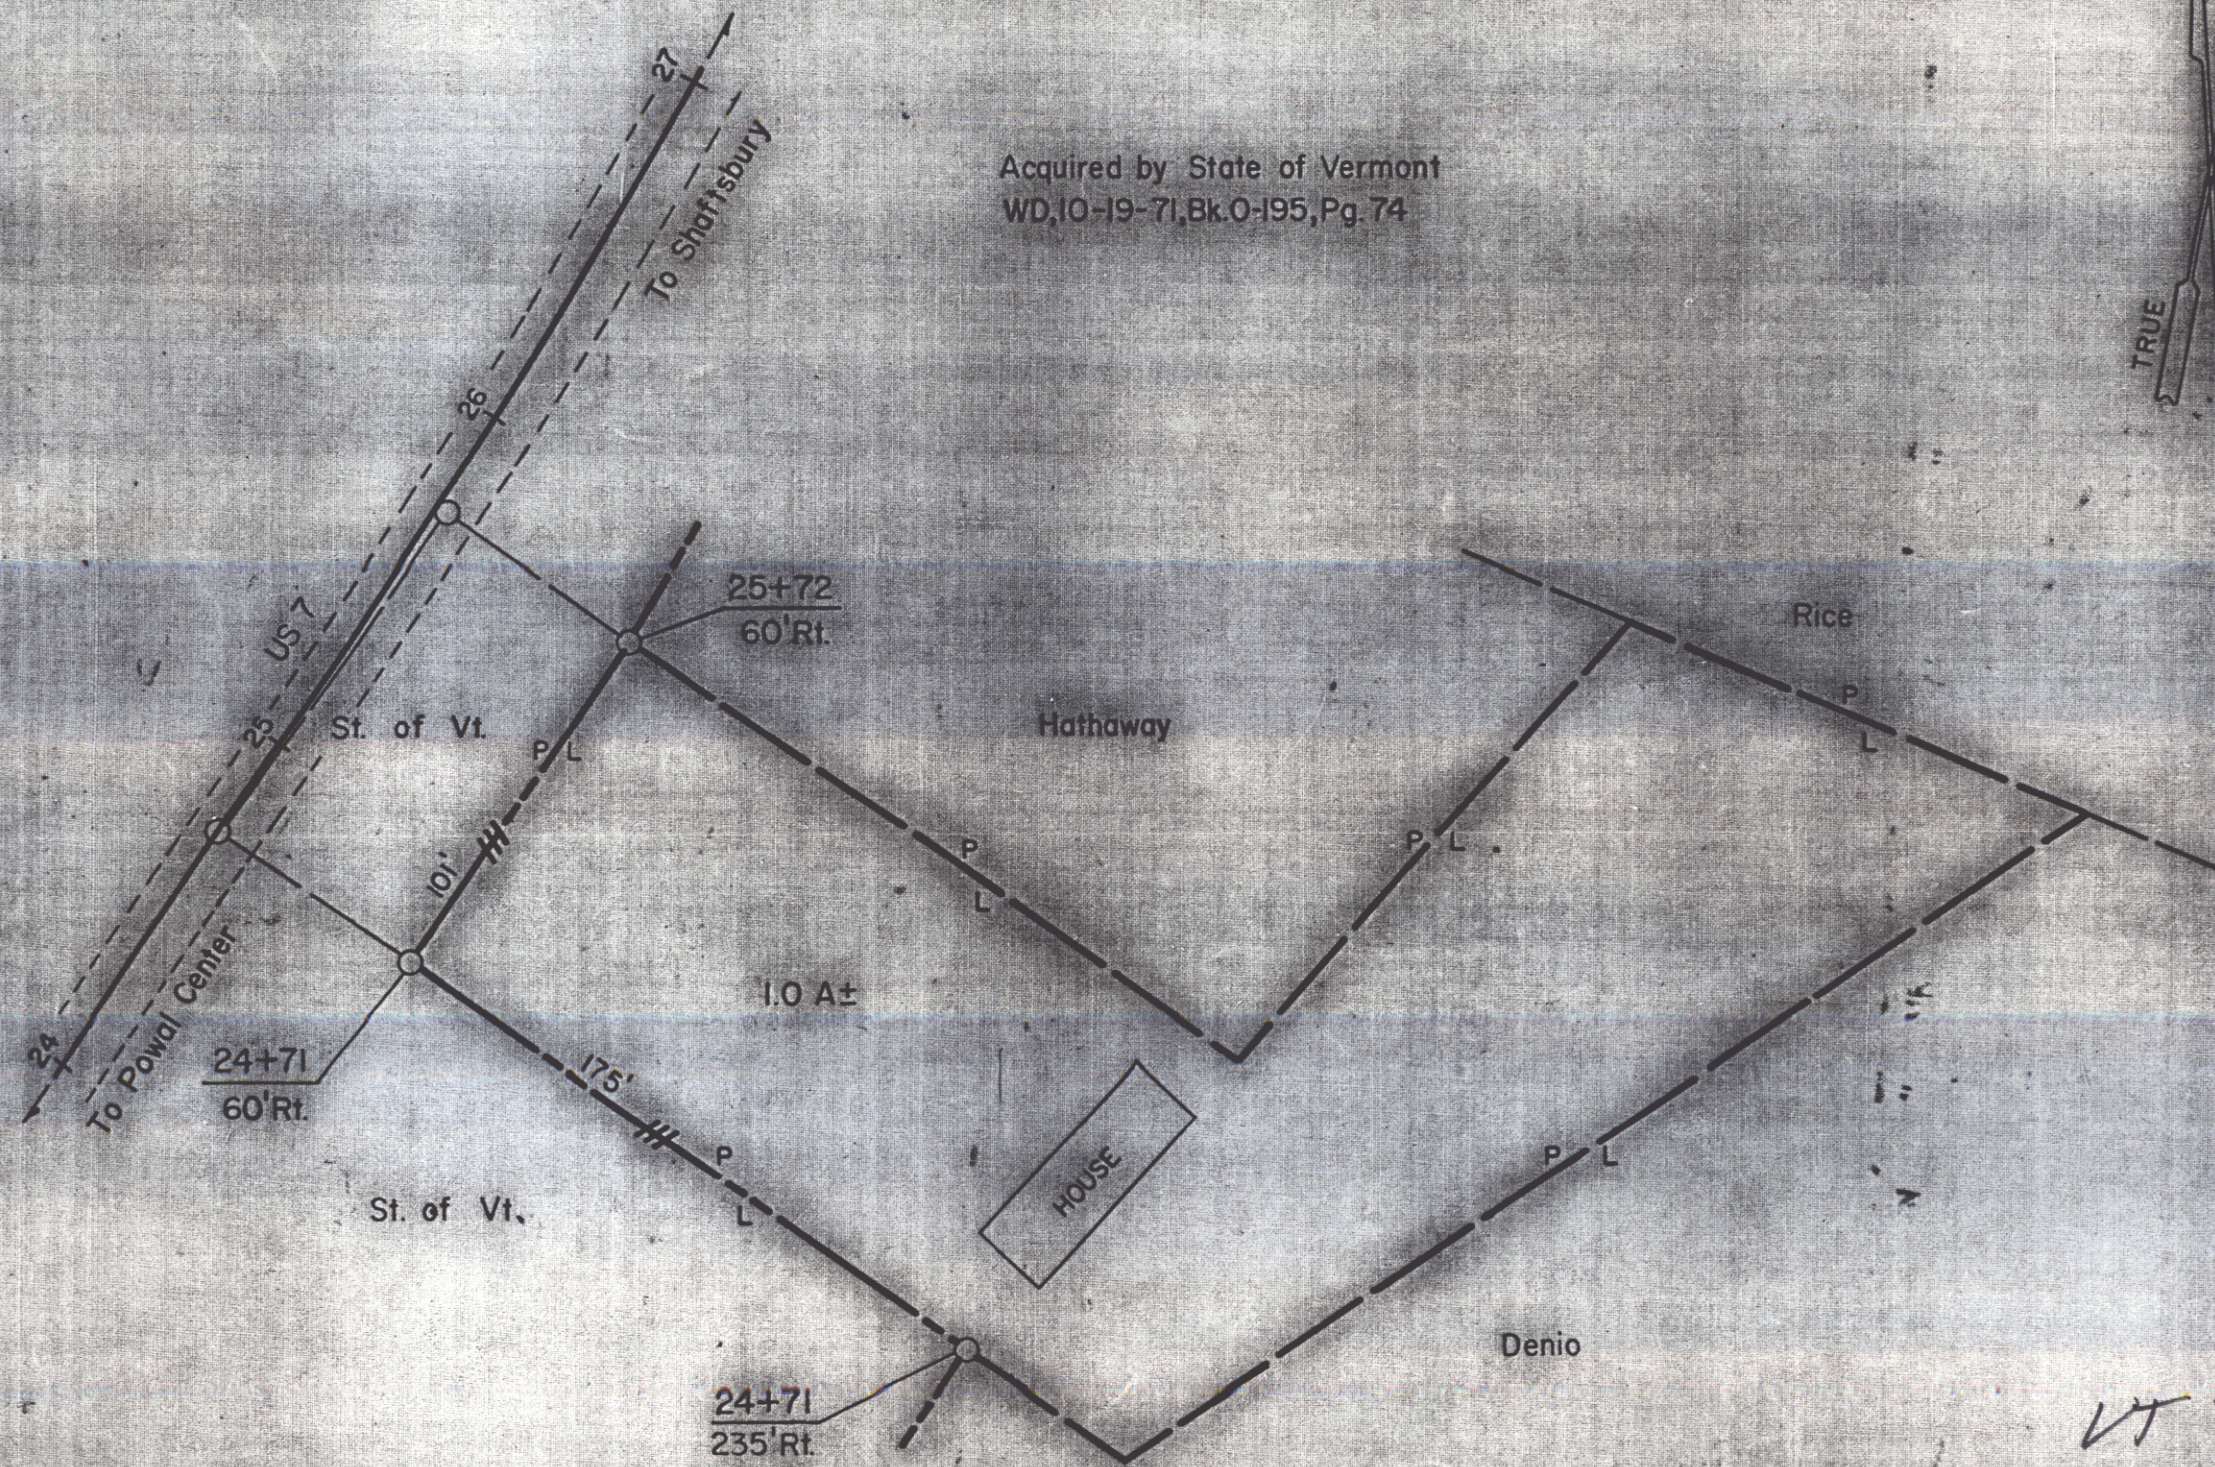

STATE OF VERMONT DEPT. OF HIGHWAYS		
TOWN OF BENNINGTON		
PROJECT BENNINGTON	AP0137 (50)	SA
APPROX. SCALE 1" = 50'	DATE 5-15-75	DRAWN BY ROD