

INDEX OF SHEETS

Searsburg BP 010-1-7506


Sheet #		
1.	Title Sheet	
2.	Typical Sections	
3.	Summary of Quantities & Item Detail Sheet	
4.	Item Detail & Drainage Sheet	
5.	Earthworks	
10.	R.O.W. Plan Sheets	
11-13.	Plan Profile Sheets	
14-15.	Blank	
16.	A-61 Typical For Slopes in Solid Rock Excavation and Drilling and Blasting of Solid Rock Subgrade	4/23/79 R
17.	B-1 Banking Tables	12/08/71
18.	B-5 Slope Rounding	12/06/71
19.	D-2 Headwalls and Underdrain	3/04/79 R
20.	D-4 Flushing Basins & Extension Service Box and Curb Stop	7/17/72 R
21.	D-6 RCDI (Use in Ditches)	4/04/79
22.	Blank	
23.	D-11 Cast Iron Grate w/Frame Type A	4/25/72 R
24.	E-2 Construction Approach Signs	5/14/79 R
25.	E-5 Betterment Project Signs	9/11/79 R
26.	E-7 Delineation and Barricades for Construction Areas	9/19/79 R
27.	G-3 Guard Rail, Three Cable w/Steel Posts and Anchors for Three Cable Guard Rail w/Steel Posts	5/23/79 R
28.	T-2 Temporary Erosion Control Details	7/05/72
29.	Blank	
30-42.	Cross Sections	

STATE OF VERMONT
DEPARTMENT OF HIGHWAYS




PROPOSED IMPROVEMENT

TOWN OF SEARSBURG
COUNTY OF BENNINGTON
VERMONT ROUTE 9 - BENNINGTON - BRATTLEBORO ROAD

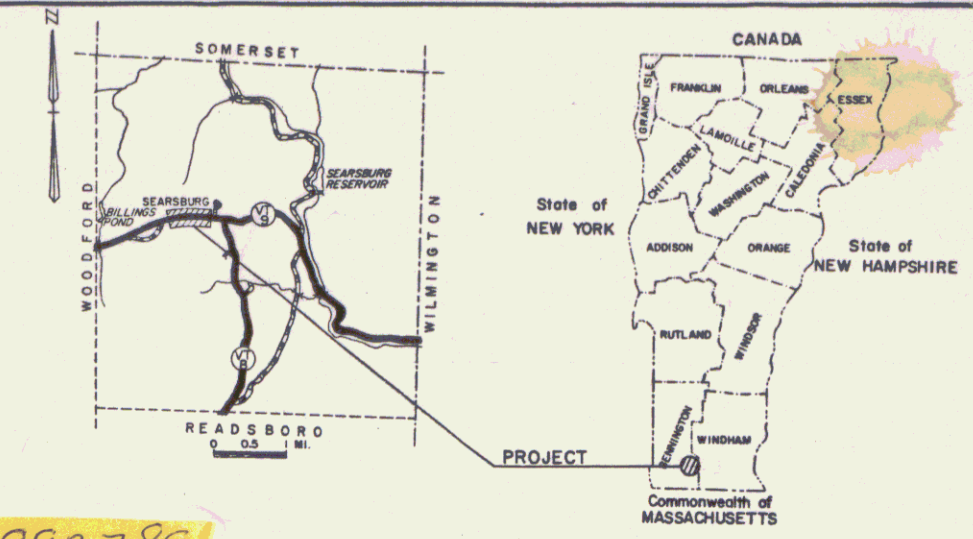

RECORD PLANS-MATERIALS
SEARSBURG BP 010-1-7506
CONTRACTOR-W.H.MORSE-BENNINGTON,VT.
CONTRACT DATED 1 JULY 1975
CONSTRUCTION BEGAN-9 JULY 1975
CONSTRUCTION SUSPENDED 7 NOVEMBER 1975
CONSTRUCTION RESUMED 17 MAY 1976
CONSTRUCTION COMPLETED AND ACCEPTED 30 JUNE 1976
RES. ENGR. NELSON E. BLANCHARD
RECORD PLANS-PAUL E. SINGLETON

BEGINNING AT A POINT APPROXIMATELY 1.085 MILES EASTERLY
OF THE WOODFORD-SEARSBURG TOWN LINE AND EXTENDING
IN AN EASTERLY DIRECTION 0.615 MILES.
LENGTH OF ROADWAY 3246.8 FEET = 0.615 MILES
LENGTH OF PROJECT 3246.8 FEET = 0.615 MILES

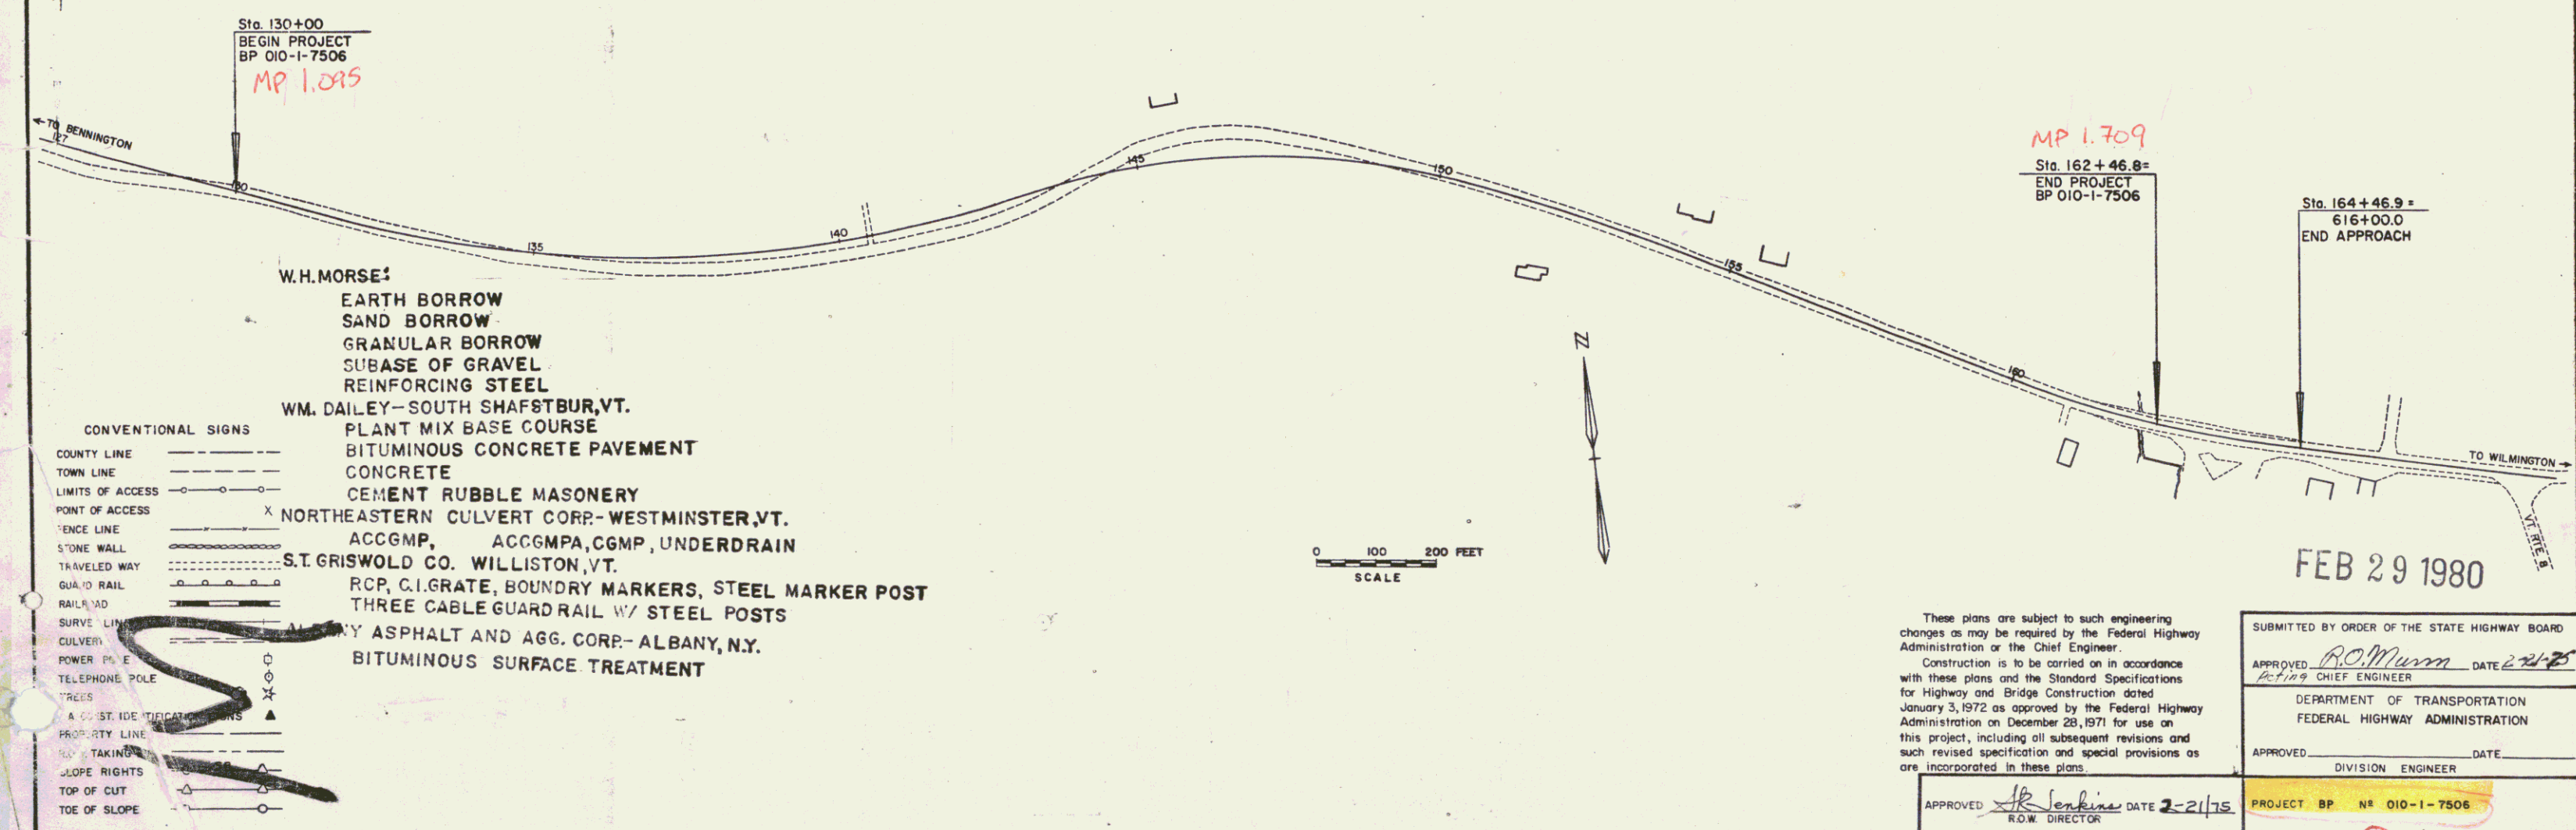

These plans are subject to such engineering changes as may be required by the Federal Highway Administration or the Chief Engineer.

Construction is to be carried on in accordance with these plans and the Standard Specifications for Highway and Bridge Construction dated January 3, 1972 as approved by the Federal Highway Administration on December 28, 1971 for use on this project, including all subsequent revisions and such revised specification and special provisions as are incorporated in these plans.

APPROVED *R. Jenkins* DATE 2-21/75 R.O.W. DIRECTOR


APPROVED *R.O. Munn* DATE 2-24/75 CHIEF ENGINEER

DEPARTMENT OF TRANSPORTATION
FEDERAL HIGHWAY ADMINISTRATION

PROJECT BP NR 010-1-7506

SHEET 1 OF 42 SHEETS

SRS 12/17/70

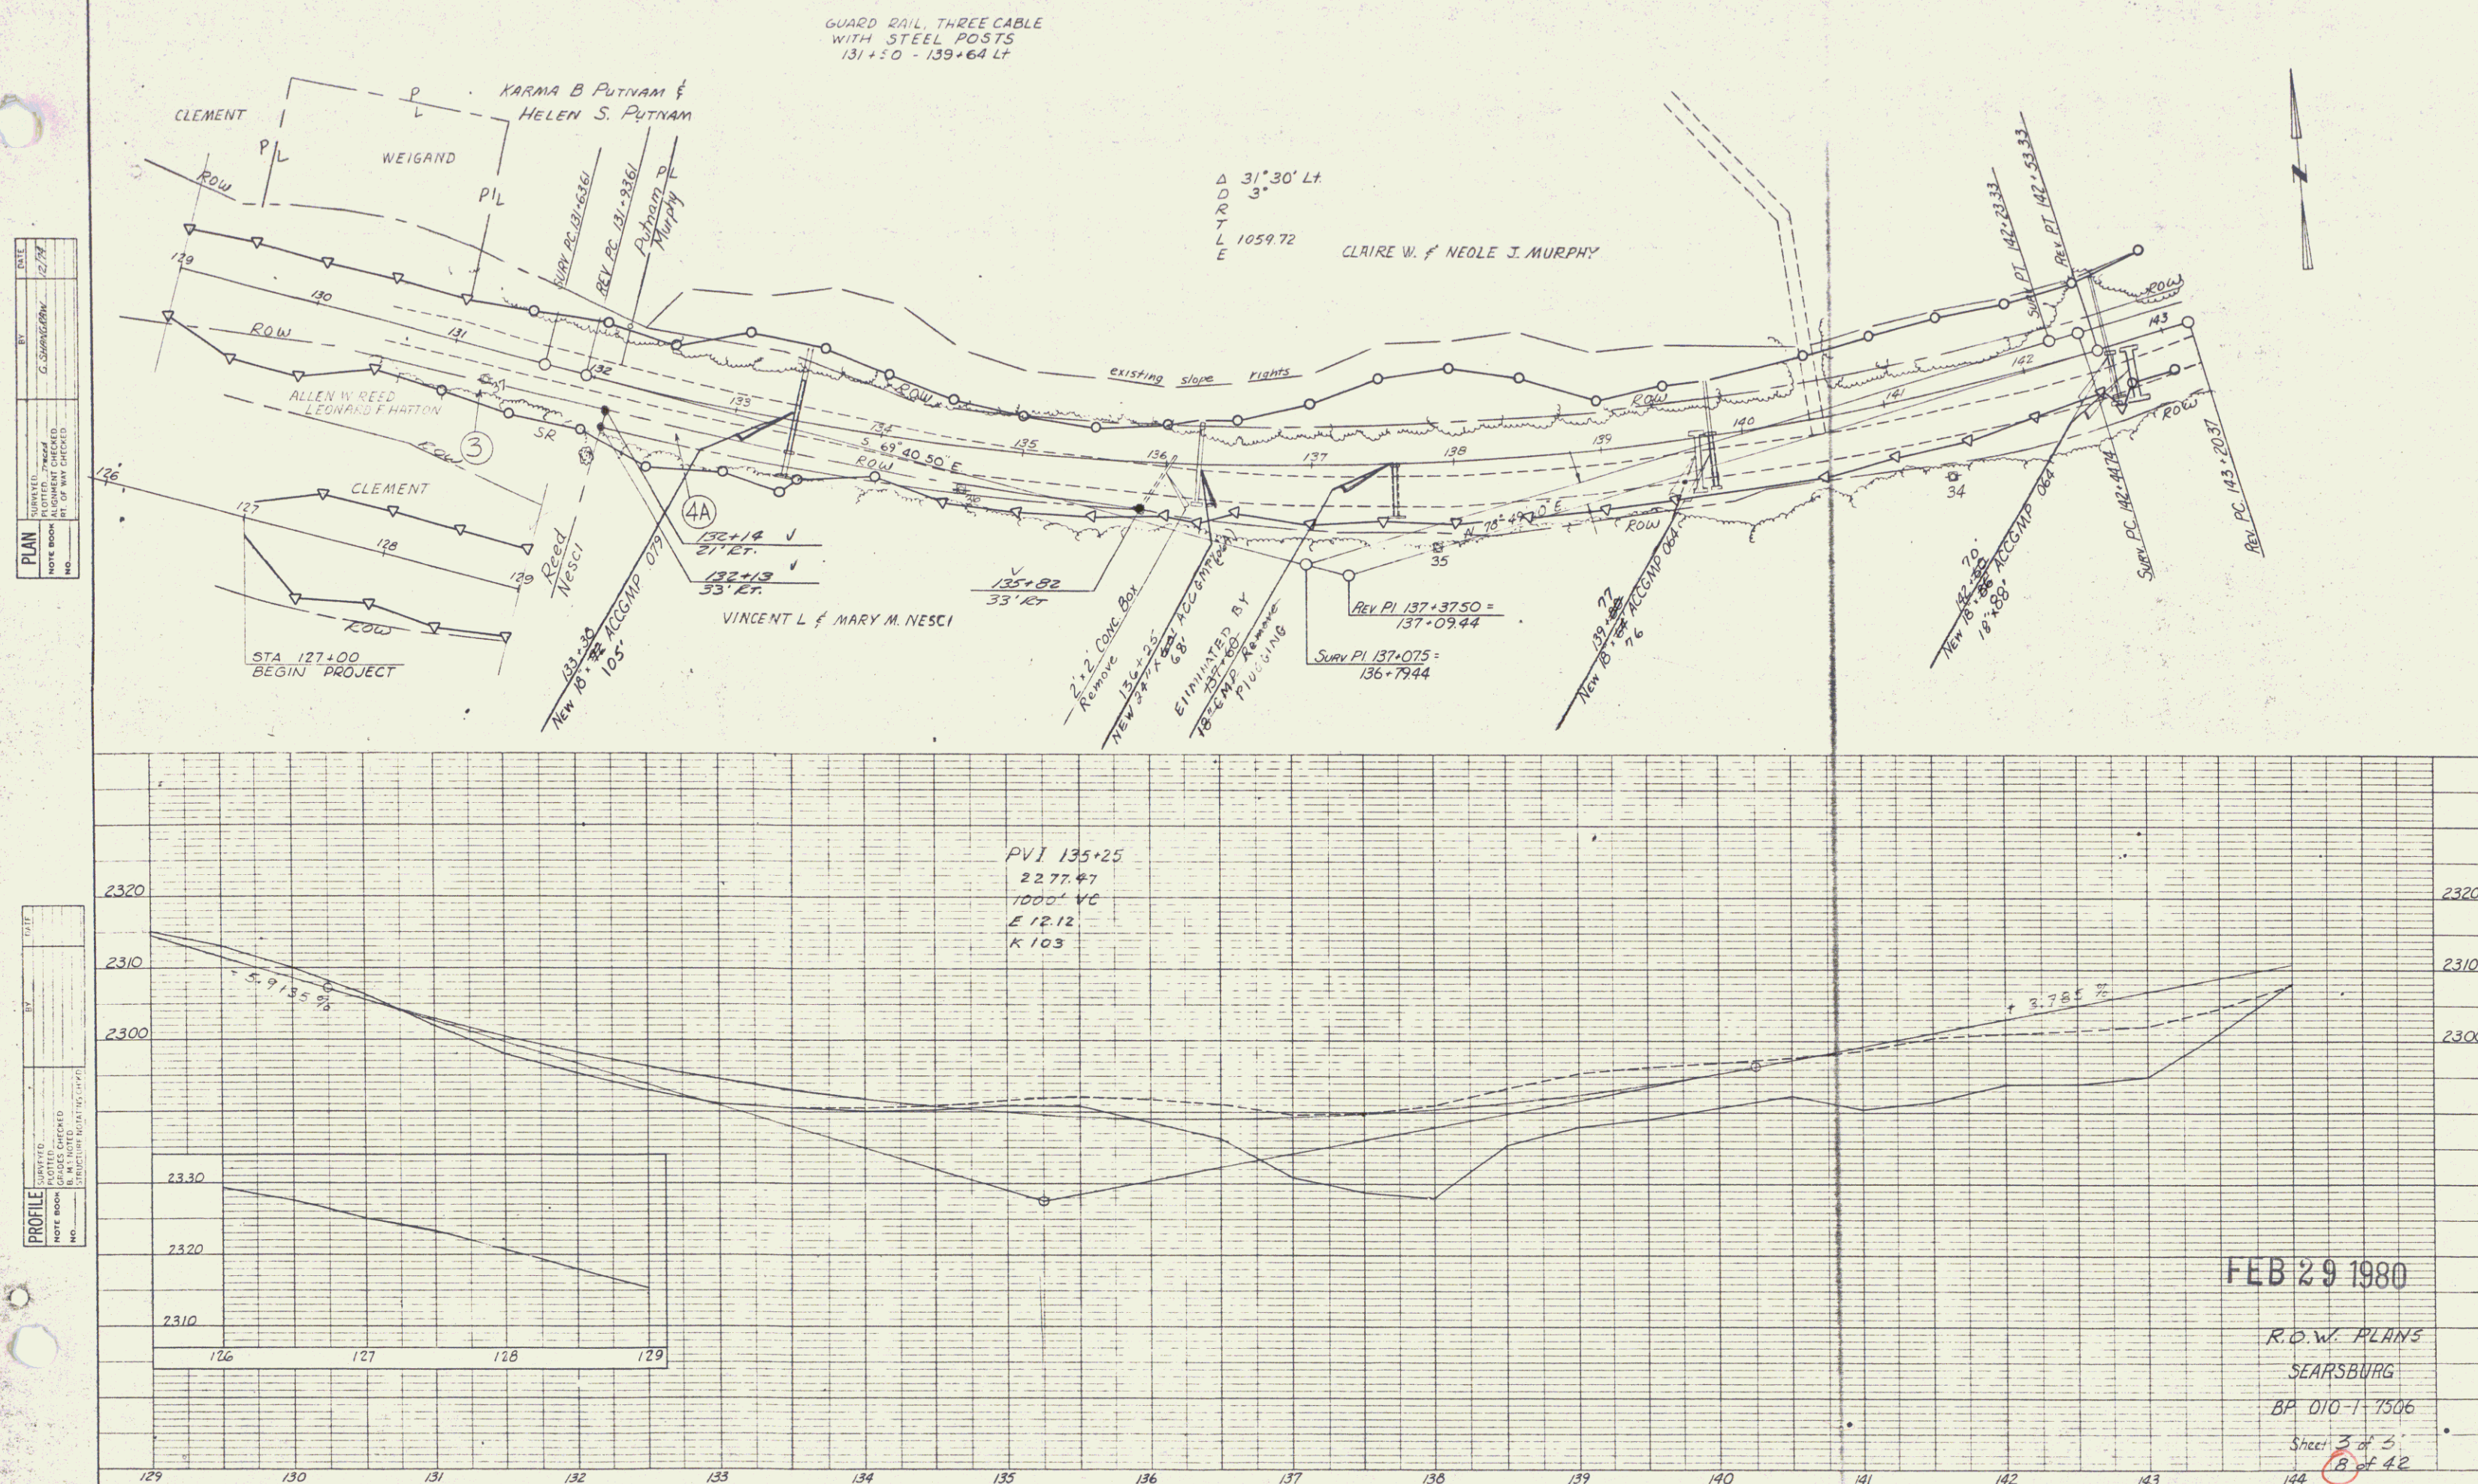

FEB 29 1980

R.O.W. PLANS

SEARSBURG

BP 010-1-7506



Sheet 3 of 3

8 of 4


144

PLAN
 DATE: 1/27/80
 BY: S. J. [unclear]
 CHECKED: [unclear]
 NO. 1472

PROFILE
 DATE: 1/27/80
 BY: S. J. [unclear]
 CHECKED: [unclear]
 NO. 1472

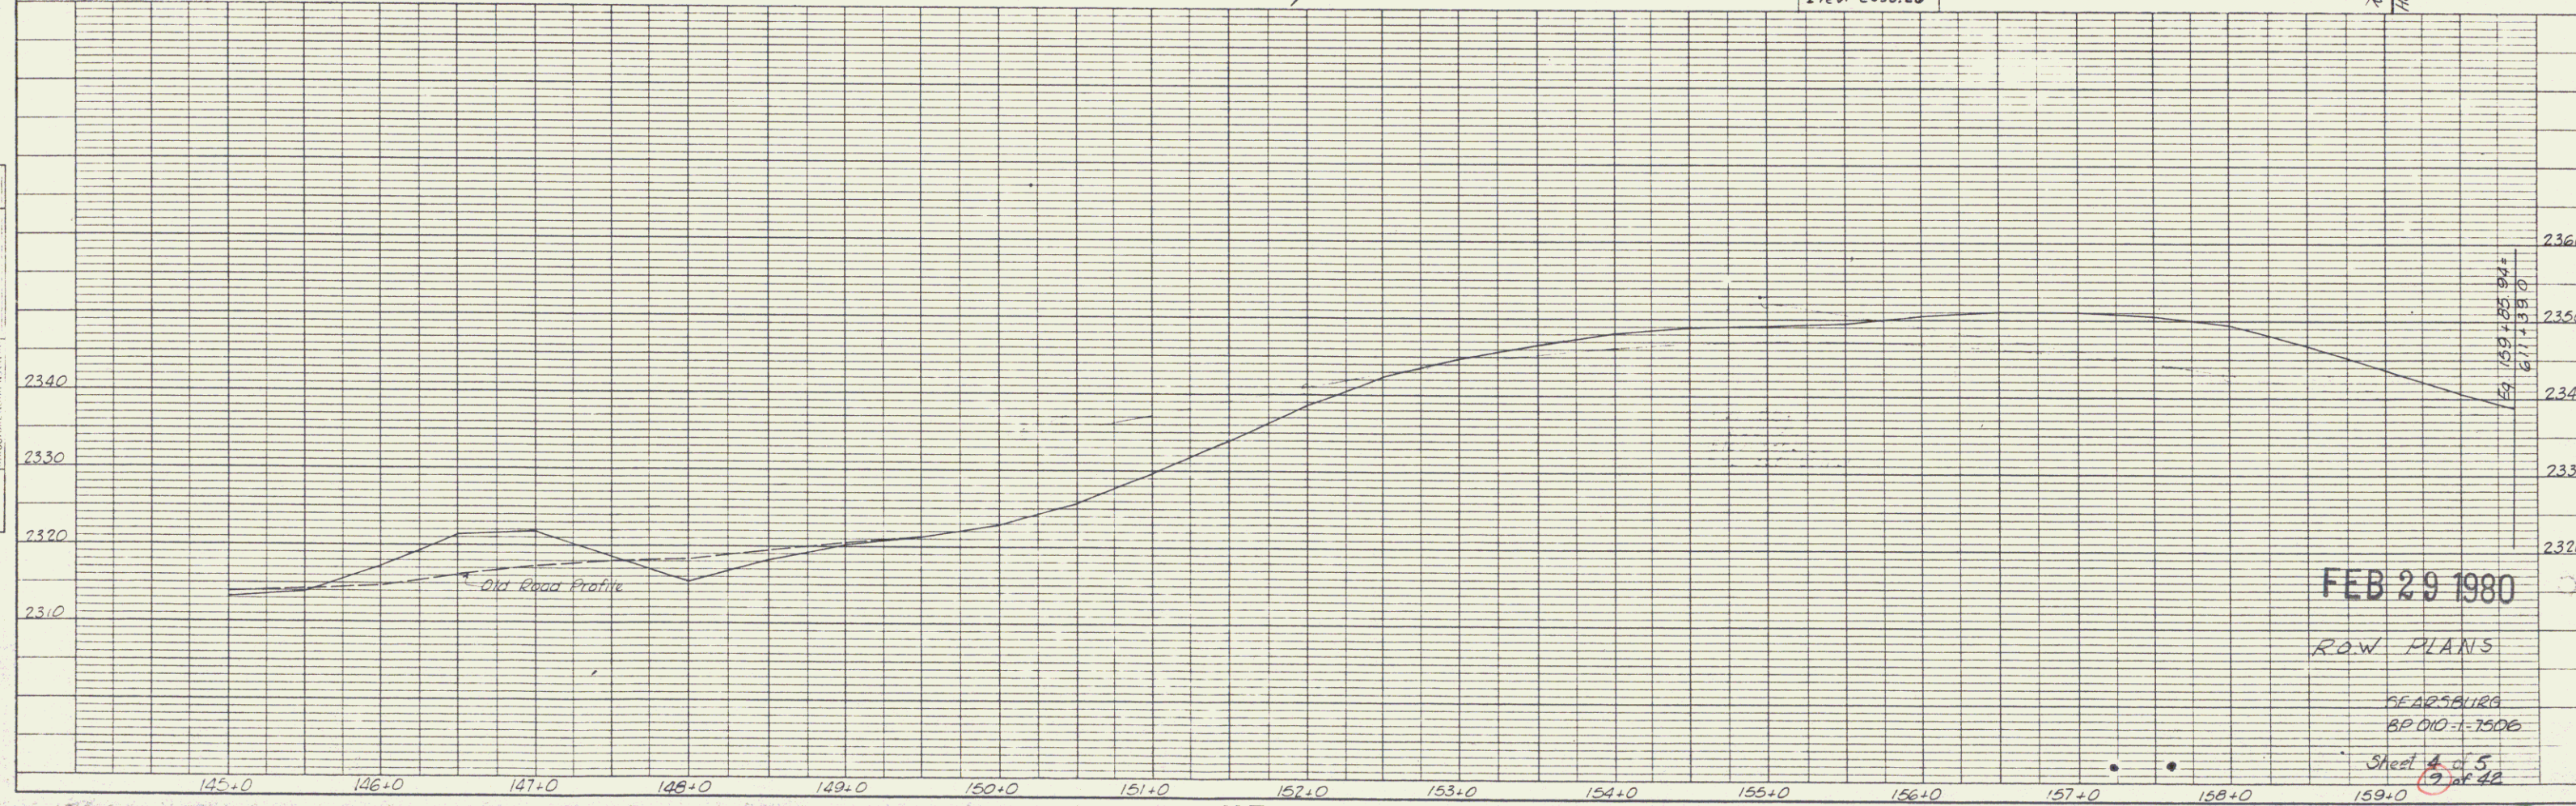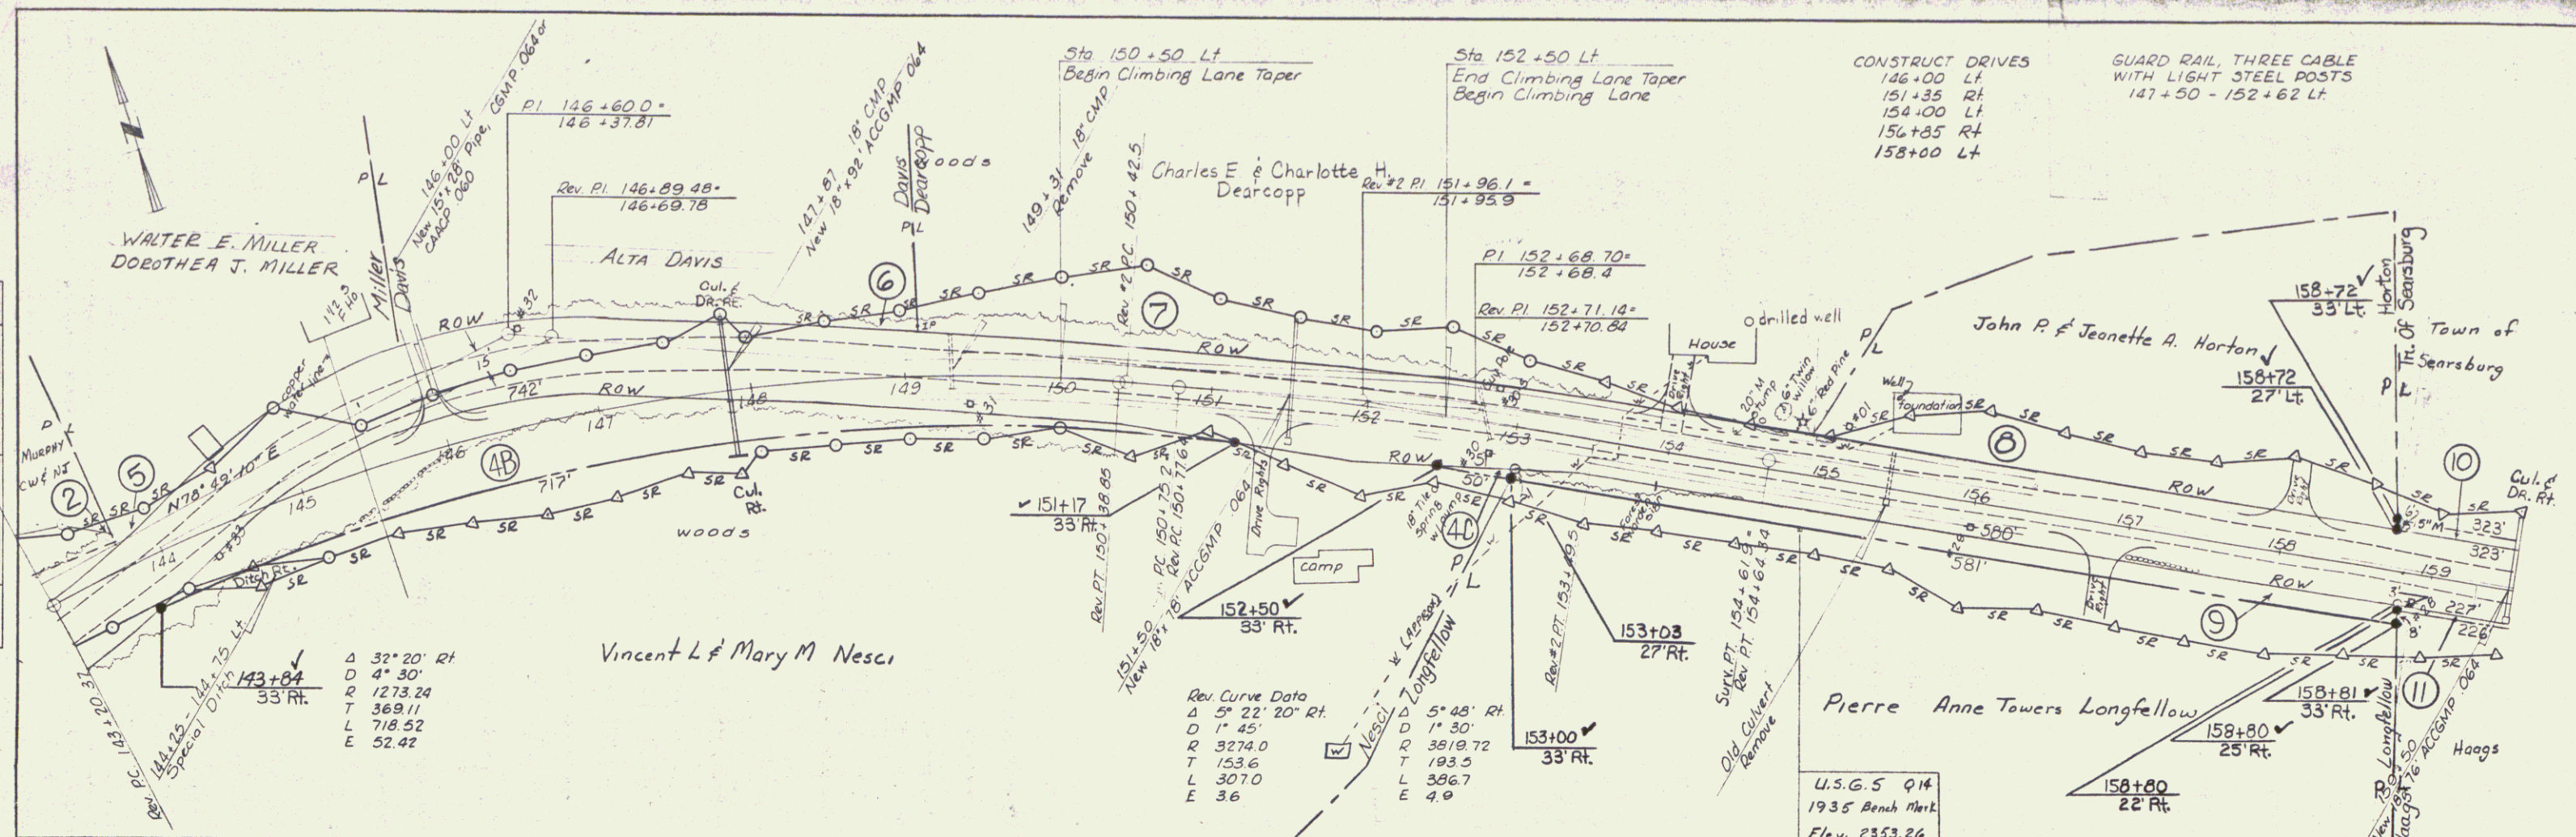

NO.	SURVEYED	BY	DATE
NOTE BOOK	PLOTTED		
	GRADES CHECKED		
	B. M. NOTED		
	STRUCTURE NOTATIONS CHECKED		

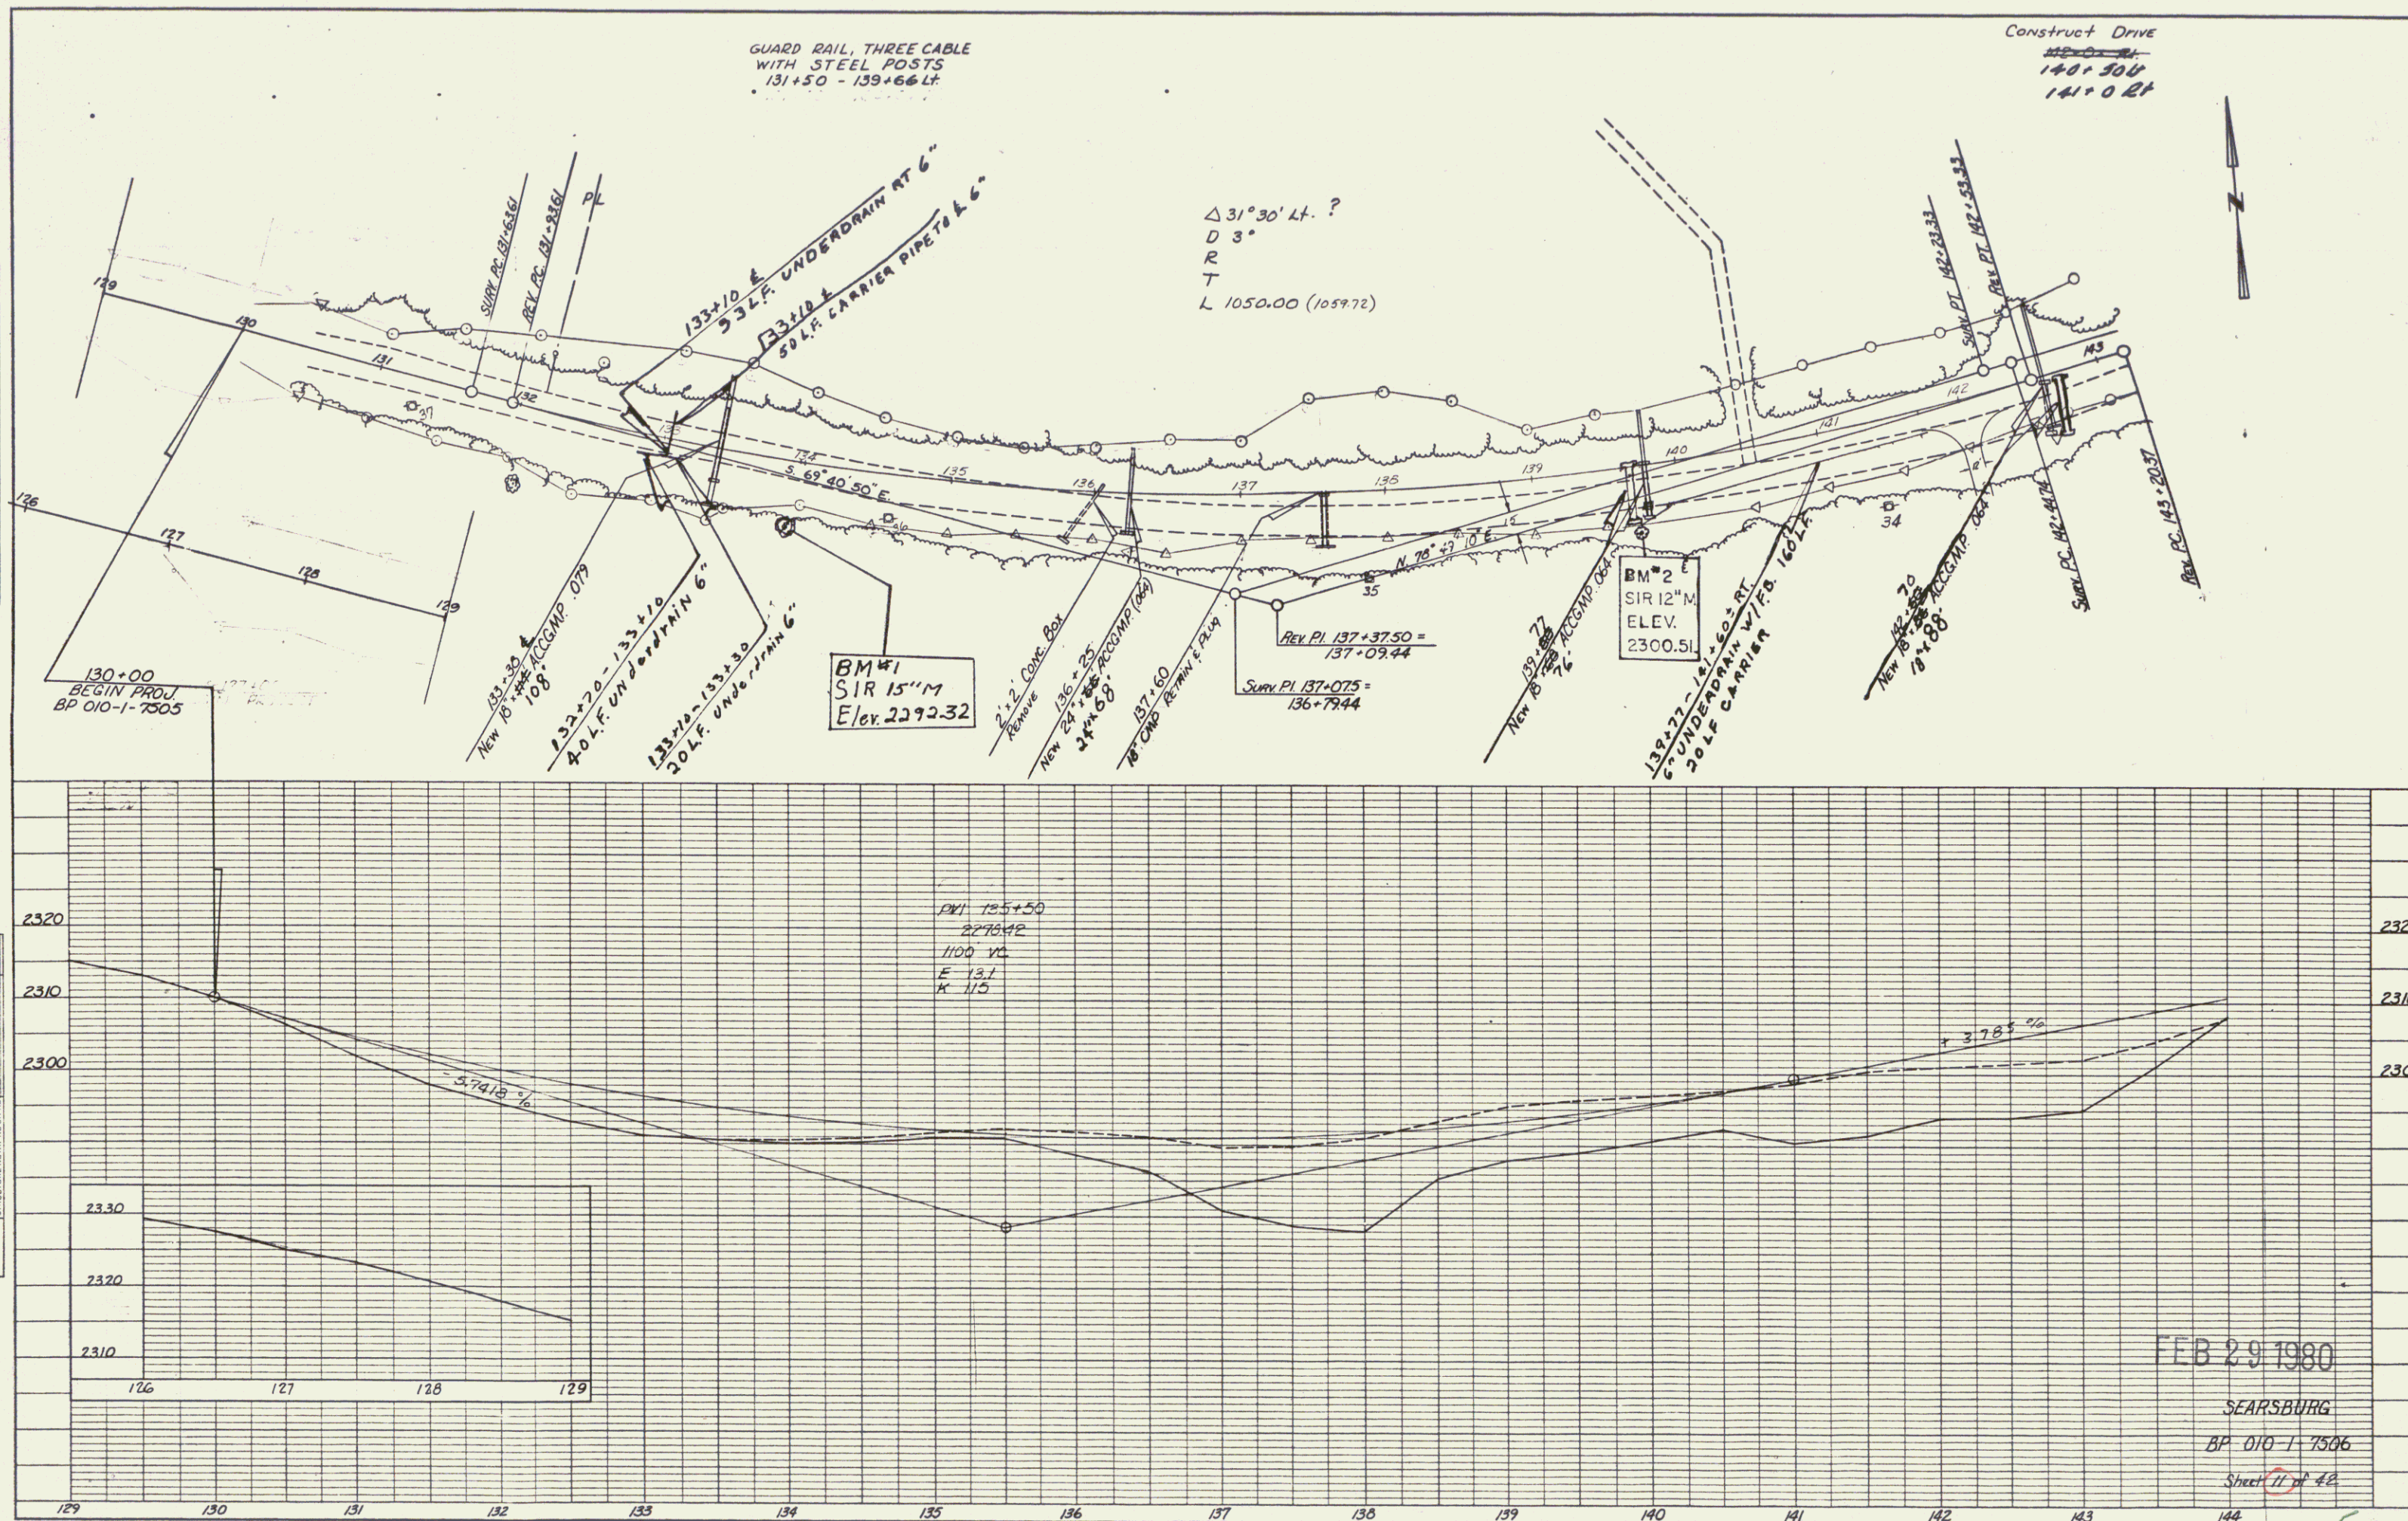

FEB 29 1980
SEARSBURG
BP 010 1-7506
Sheet 11 of 42

100

