

STATE OF VERMONT
STATE HIGHWAY DEPARTMENT

PLAN AND PROFILE OF PROPOSED STATE HIGHWAY

STATE PROJECT

[illegible]


SCALE 1" = 4'

BENNINGTON-BRATTLEBORO ROAD

FROM 4365 FEET WEST OF THE
WOODFORD-SEARSBURG TOWN LINE
EAST 5.074 MILES TO THE BRIDGE
OVER MOSS GLEN BROOK

LENGTH OF PROJECT 26 792.0 FT. 5.074 MI.

PROJECT	Winfield Sapping
NUMBERS	105 - M
TYPE	Macadam
CONTRACTOR	Lane Construction Corp.
LOCATION	See File Card
YEAR	1932
LENGTH	MI.

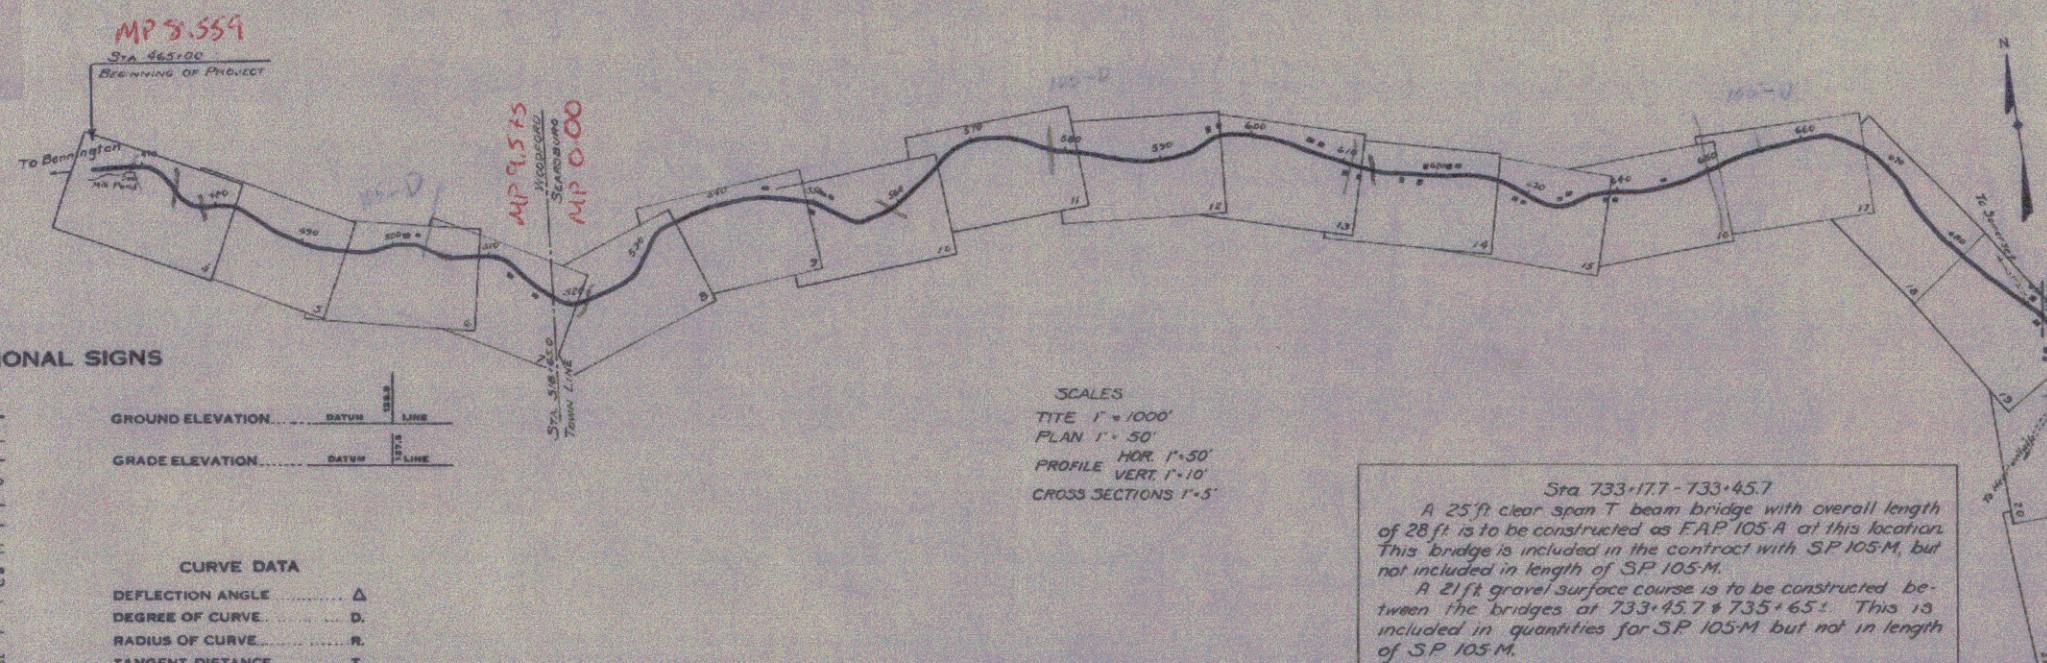

APPROVED: MAY 27 1937

ED. MAY 27, 1932
J. H. Egan
COMMISSIONER OF H.

SUBMITTED BY ORDER OF THE STATE HIGHWAY BOARD

Pin # 992791

Route VT9


Date 1/1/1932

CORRECT MAY 27 193

C. J. Guerra
ROAD ENGINE

SERIES S No. 105-M FILED
SHEET 1 OF 55

POTNAM
D. WACCHI
D. WACCHI

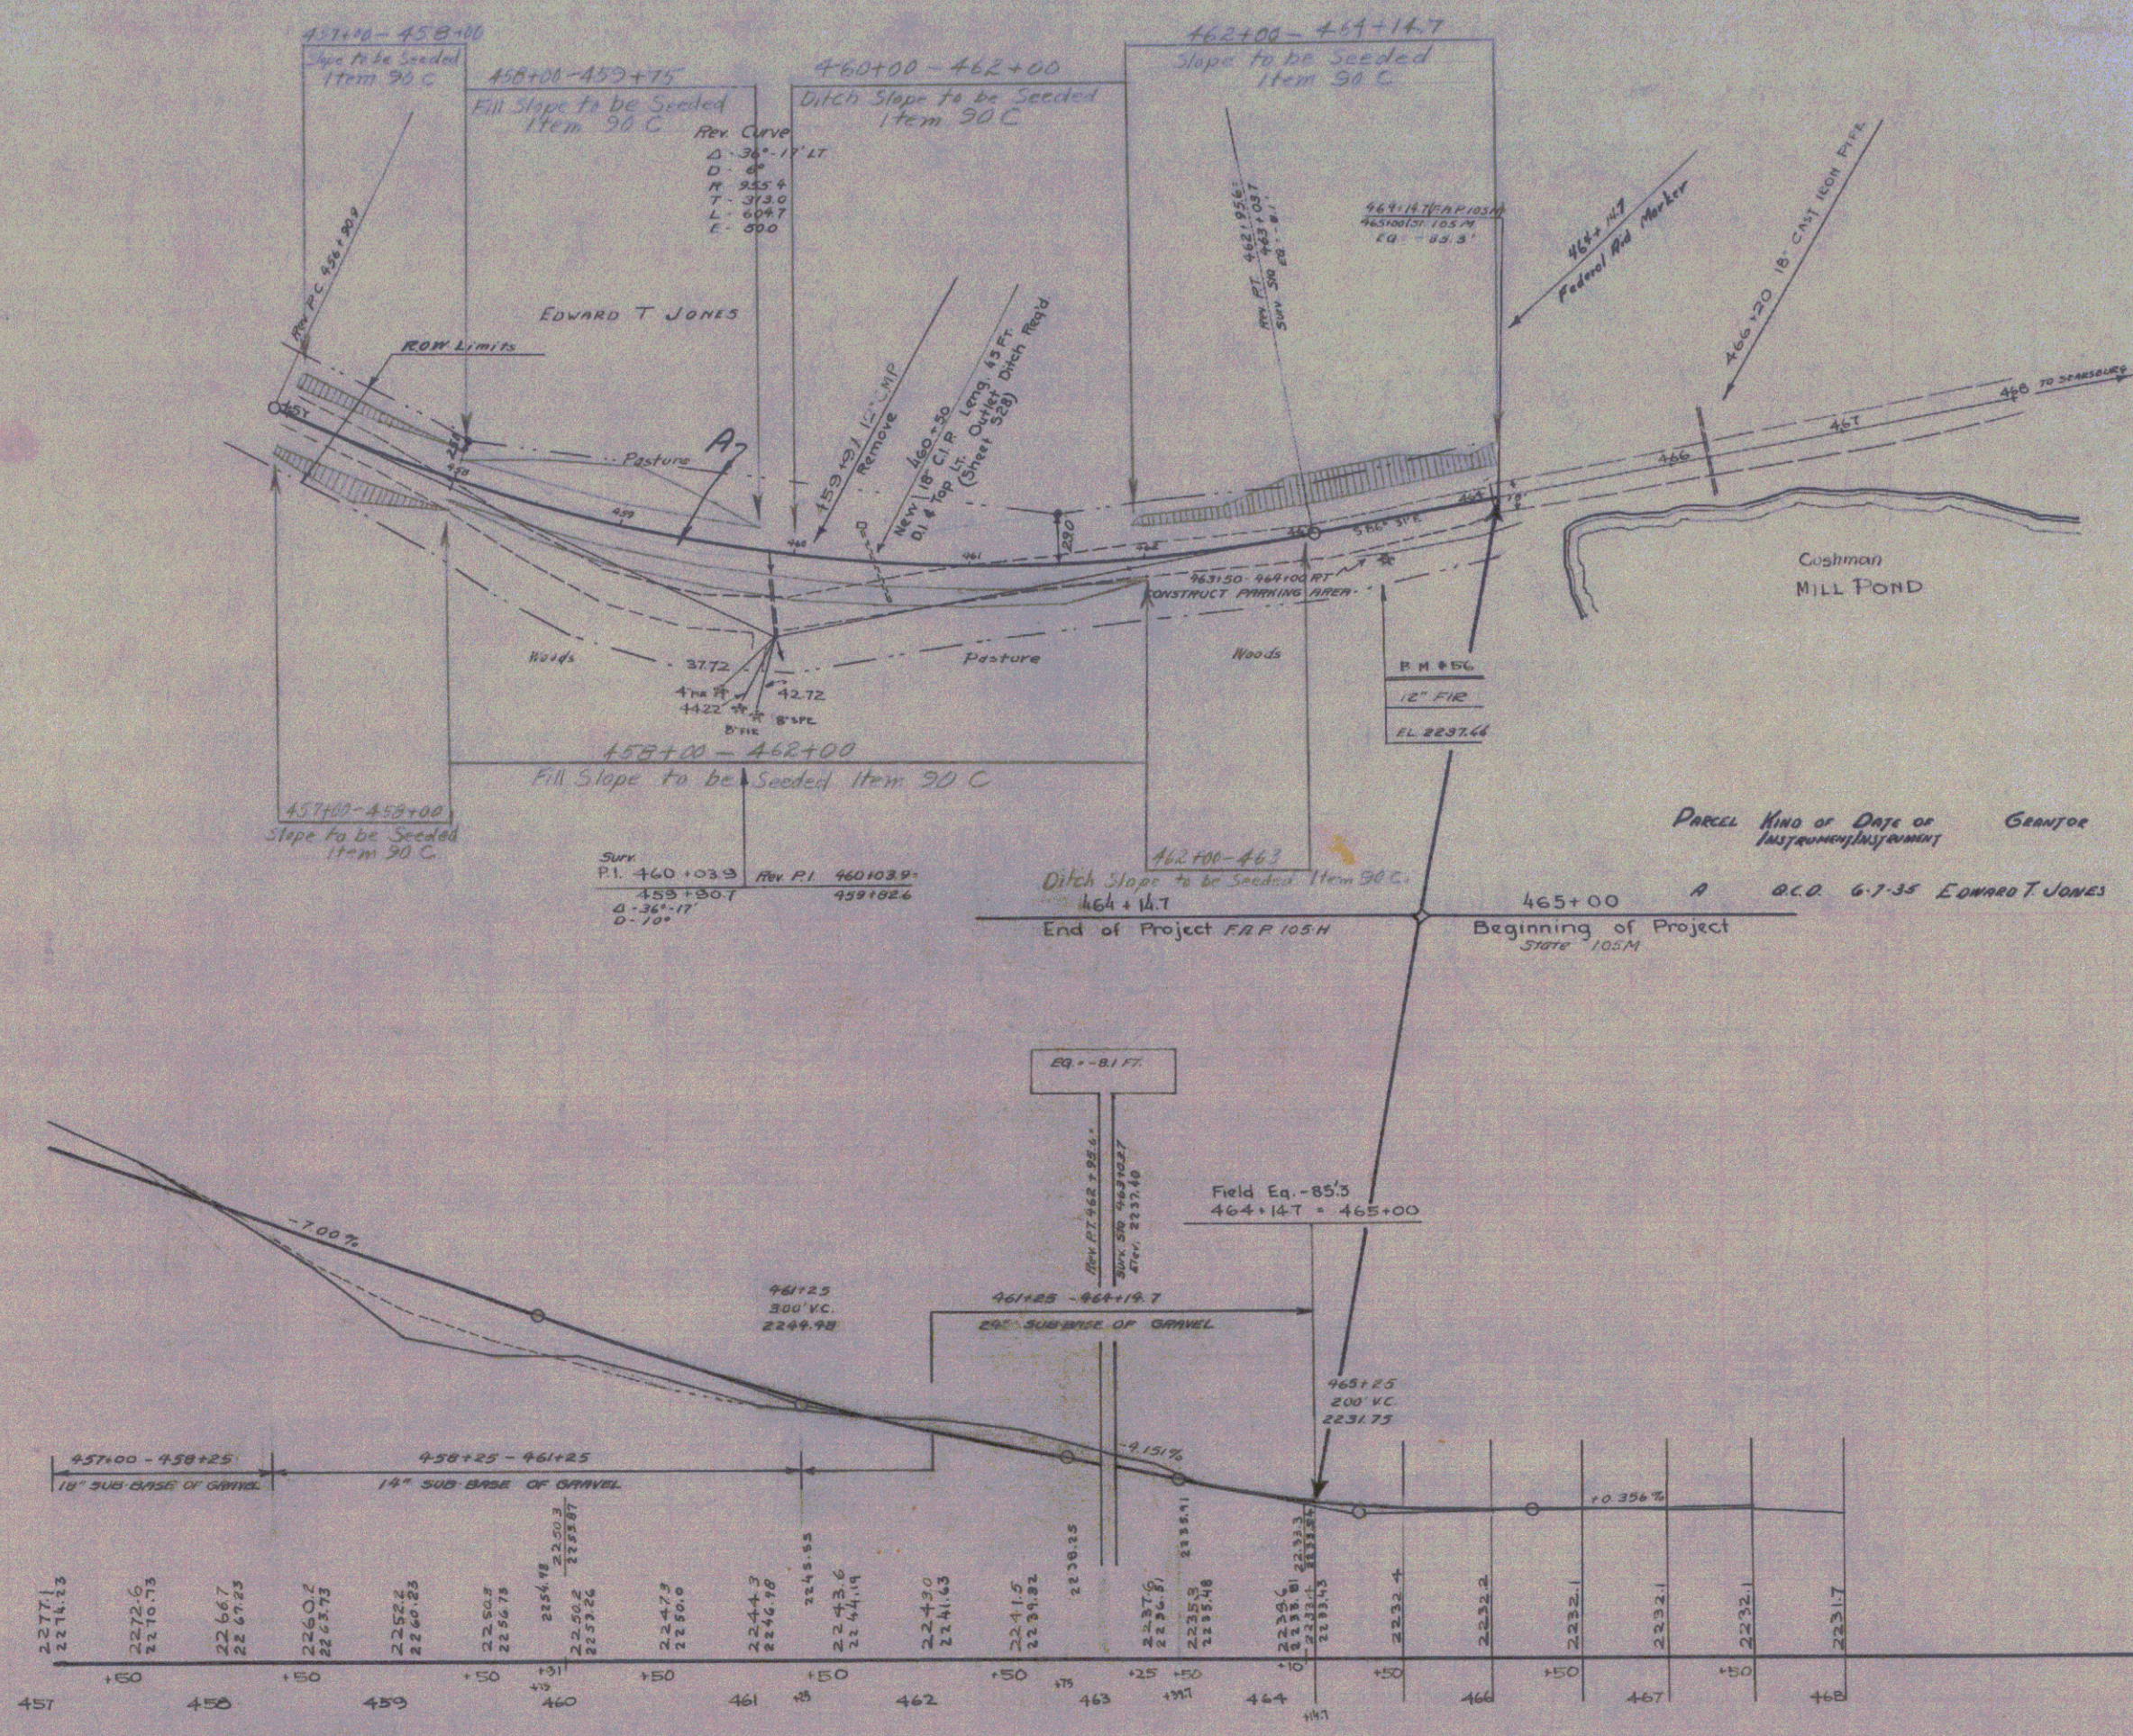

PARCEL	KIND OF INSTRUMENT	DATE OF INSTRUMENT	GRANTOR	GRANTEE	RECORDED WOODWARD
A	O.C.O.	6-7-35	EDWARD T. JONES	STAFF	BOOK PAGE DATE 18 359 6-13-35

Series
Sheet 03
No
of 45


WOOD GUARD RAIL		
STATION	LEFT	RIGHT
464+20	~	26

GUIDE POSTS OF WOOD		
STATION	LEFT	RIGHT
464+20	1	~
474+00	1	1
477+22	1	1

CABLE GUARD RAIL				
STA. TO STA.	LEN. R.	LEN. L.	CONST.	PAY LEN.
463+12	17.6 ft	36	80	176
473+53	17.6 ft	36	80	176

DRIVEWAY PIPE CULVERTS				
STATION	LEN. R.	PIPE SIZE	LEN. L.	CONV.
472+70	AT	18"	20'	22' 6"

PLAN NO.	STATE	DATE	BY	NO. SHEETS
105M	VT	1932	4	55

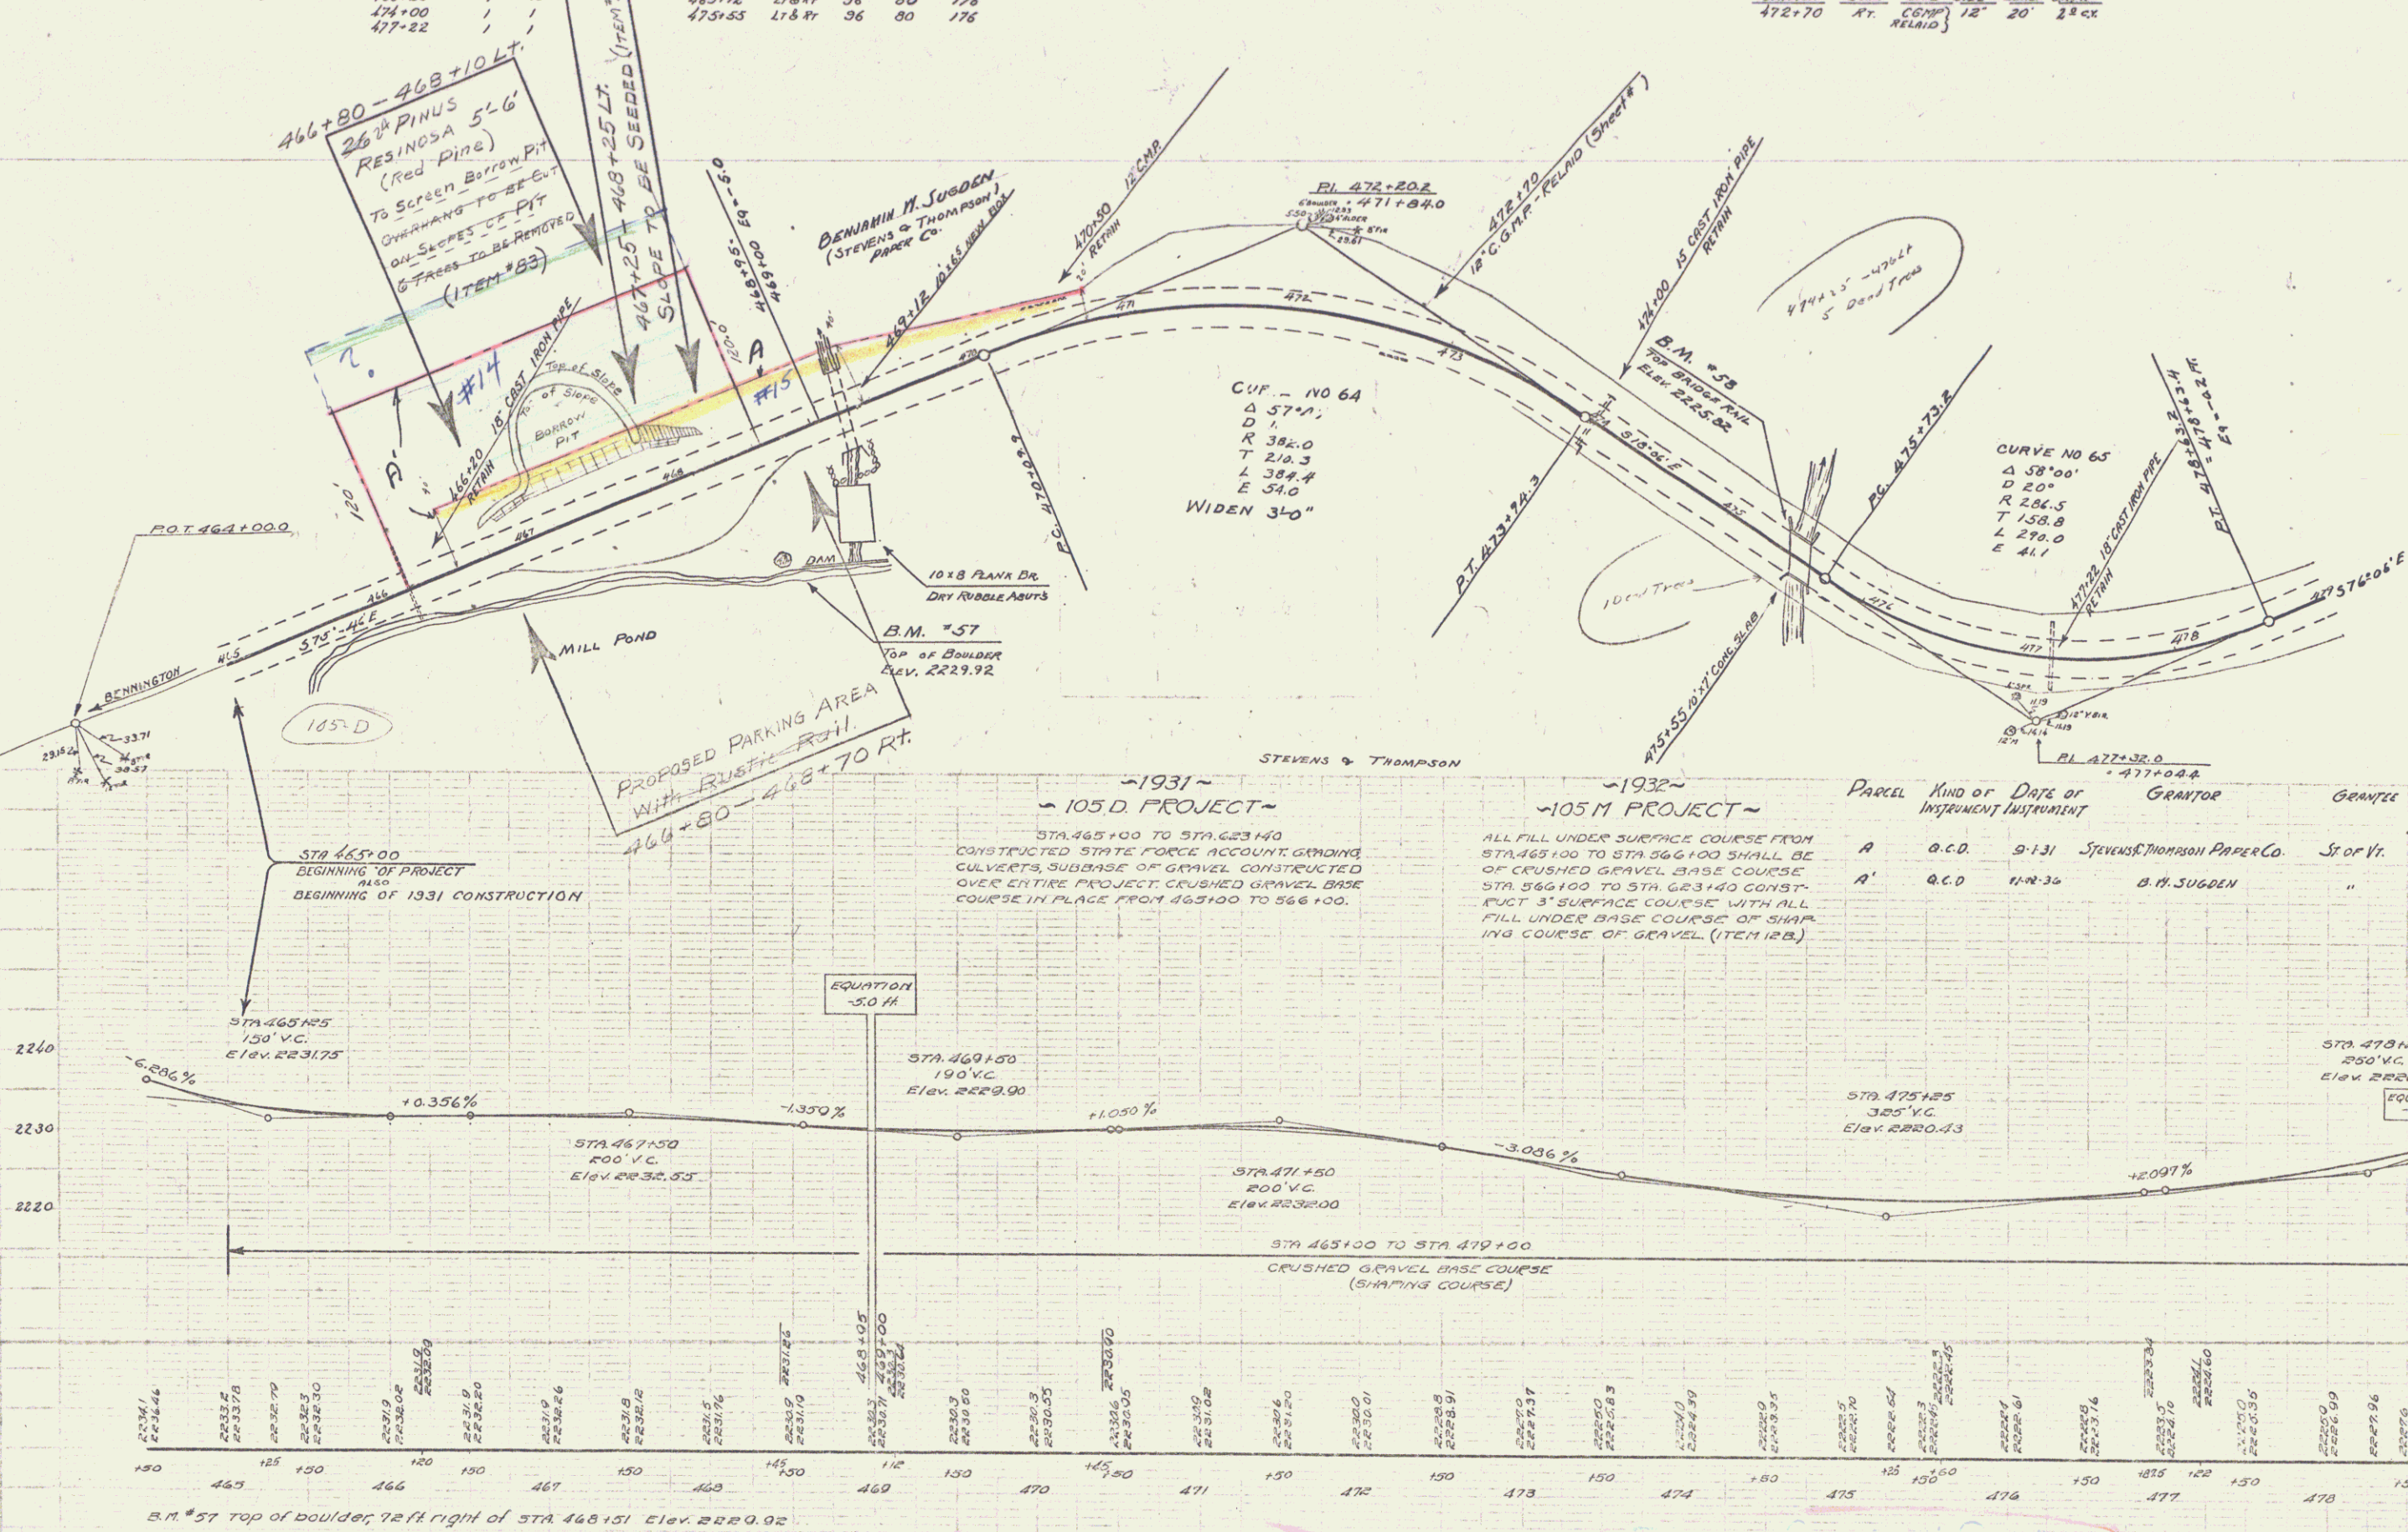



PARCEL	KIND OF INSTRUMENT	DATE OF INSTRUMENT	GRANTOR	GRANTEE	RECORDED BOOK PAGE DATE
A	O.C.D.	9-13-31	STEVENS & THOMPSON PAPER CO.	ST OF VT.	18 123 1-9-32
A'	O.C.D.	11-12-36	B. H. SUGDEN	"	11 485 11-20-36

SERIES-S NO 105 M
SHEET 4 OF 55

GUIDE POSTS OF WOOD		
STATION	LEFT	RIGHT
483+05	1	1
482+26	1	1

CABLE GUARD RAIL				
STATION	LOP R.	LENGTH	CONST.	AV. LANE.
483+78	1+5 R	36	80	176

PROJ. NO.	STATE	ROAD DIST.	SHEET
105M	VT	105M	5

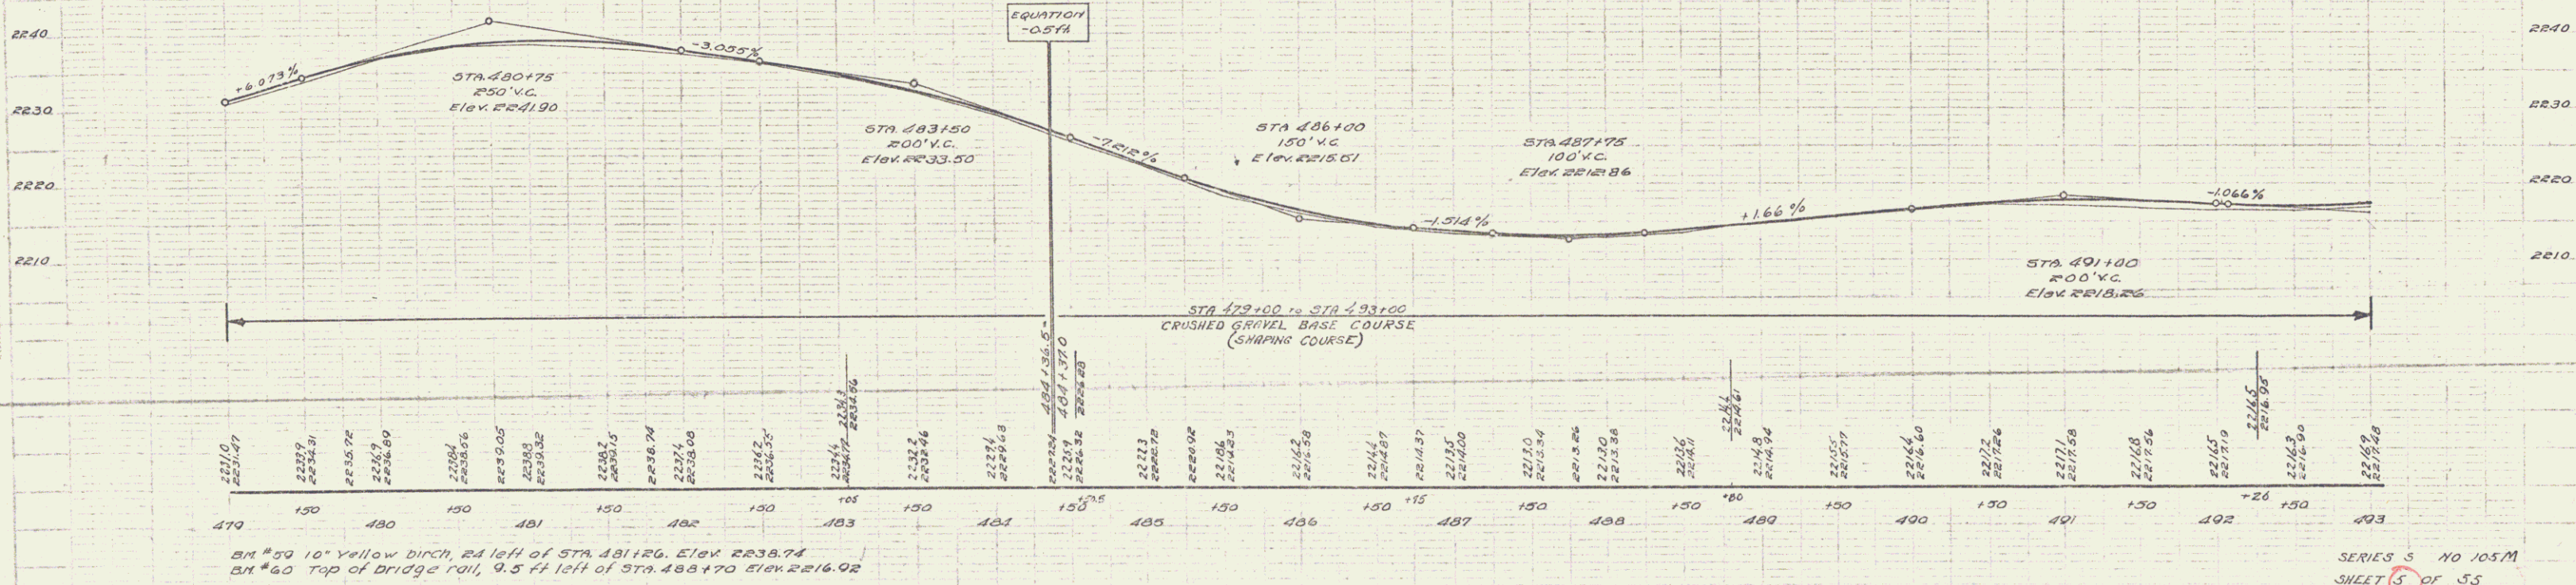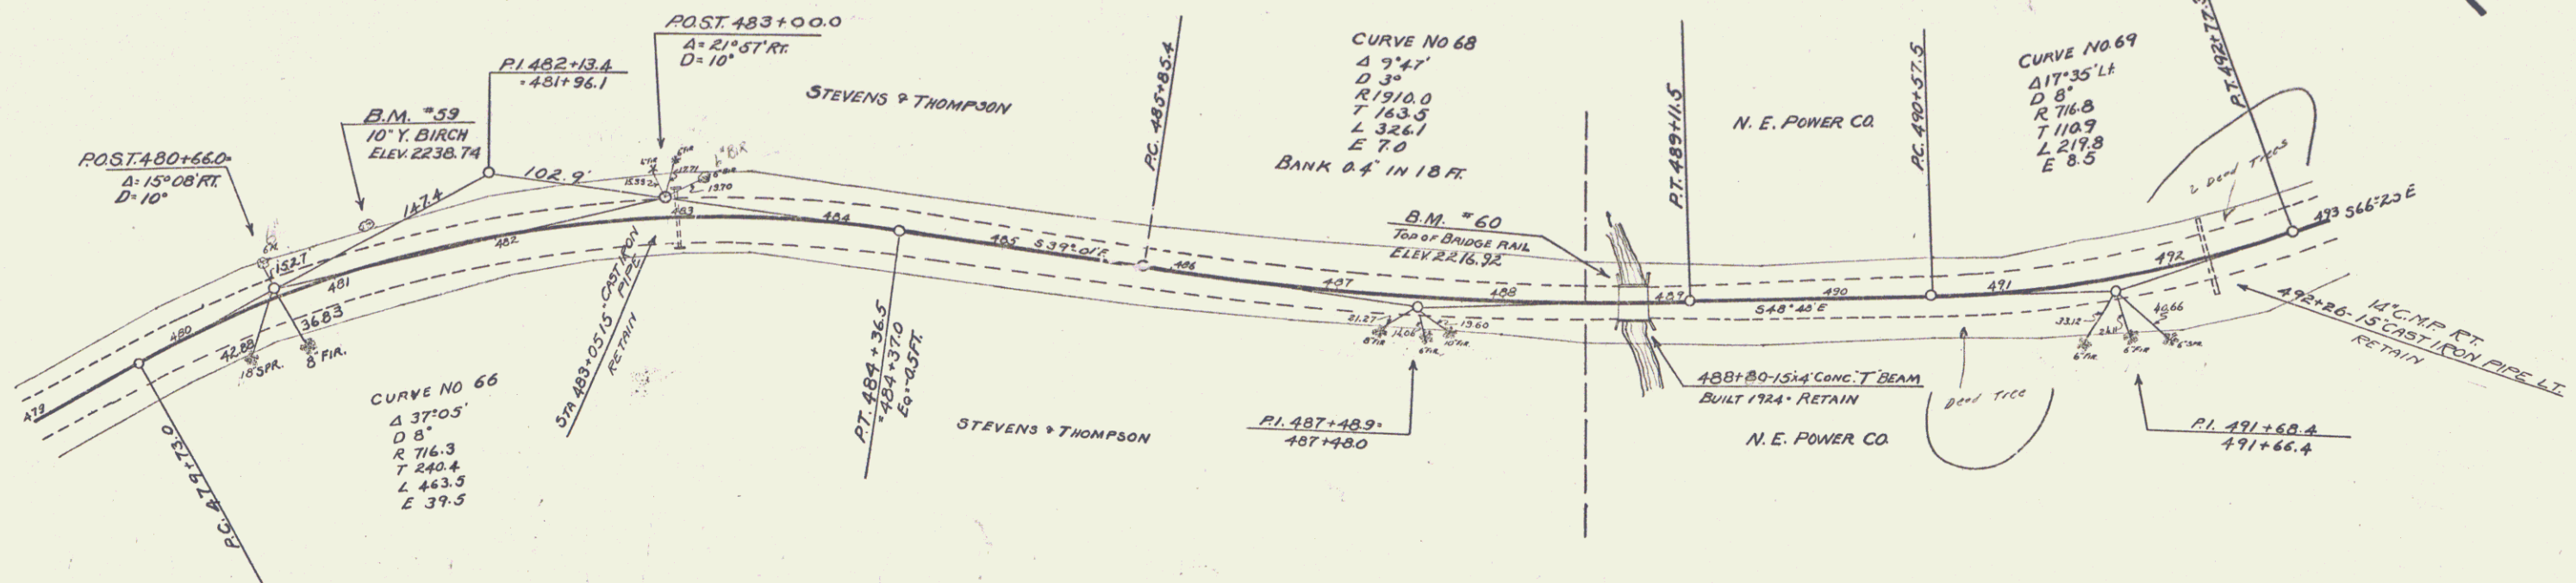

BM #59 10" Yellow Birch, 24' left of STA 481+26, Elev. 2238.74
 BM #60 Top of Bridge Rail, 9.5' left of STA 488+70 Elev. 2216.92


SERIES S NO 105M
 SHEET 5 OF 55

STATION	LEFT	RIGHT
496+30	1	1
499+87	1	1
500+70	1	1
503+70	1	1

<u>CABLE GUARD RAIL</u>				
STA	TO STA	LONG.	CONC.	PIPE LENS
	496+50	17	40'	88'
	500+70	17	48'	88
505+17	507+00	17	183'	20' 203
505+65	507+00	RT	135'	20' 135'

STA TO STA	LONG. CONC. PIPE	PI	STATION
505+00	17	200	3-0
505+00-507+00	RT	200	3-0

105.M.1932 6 55

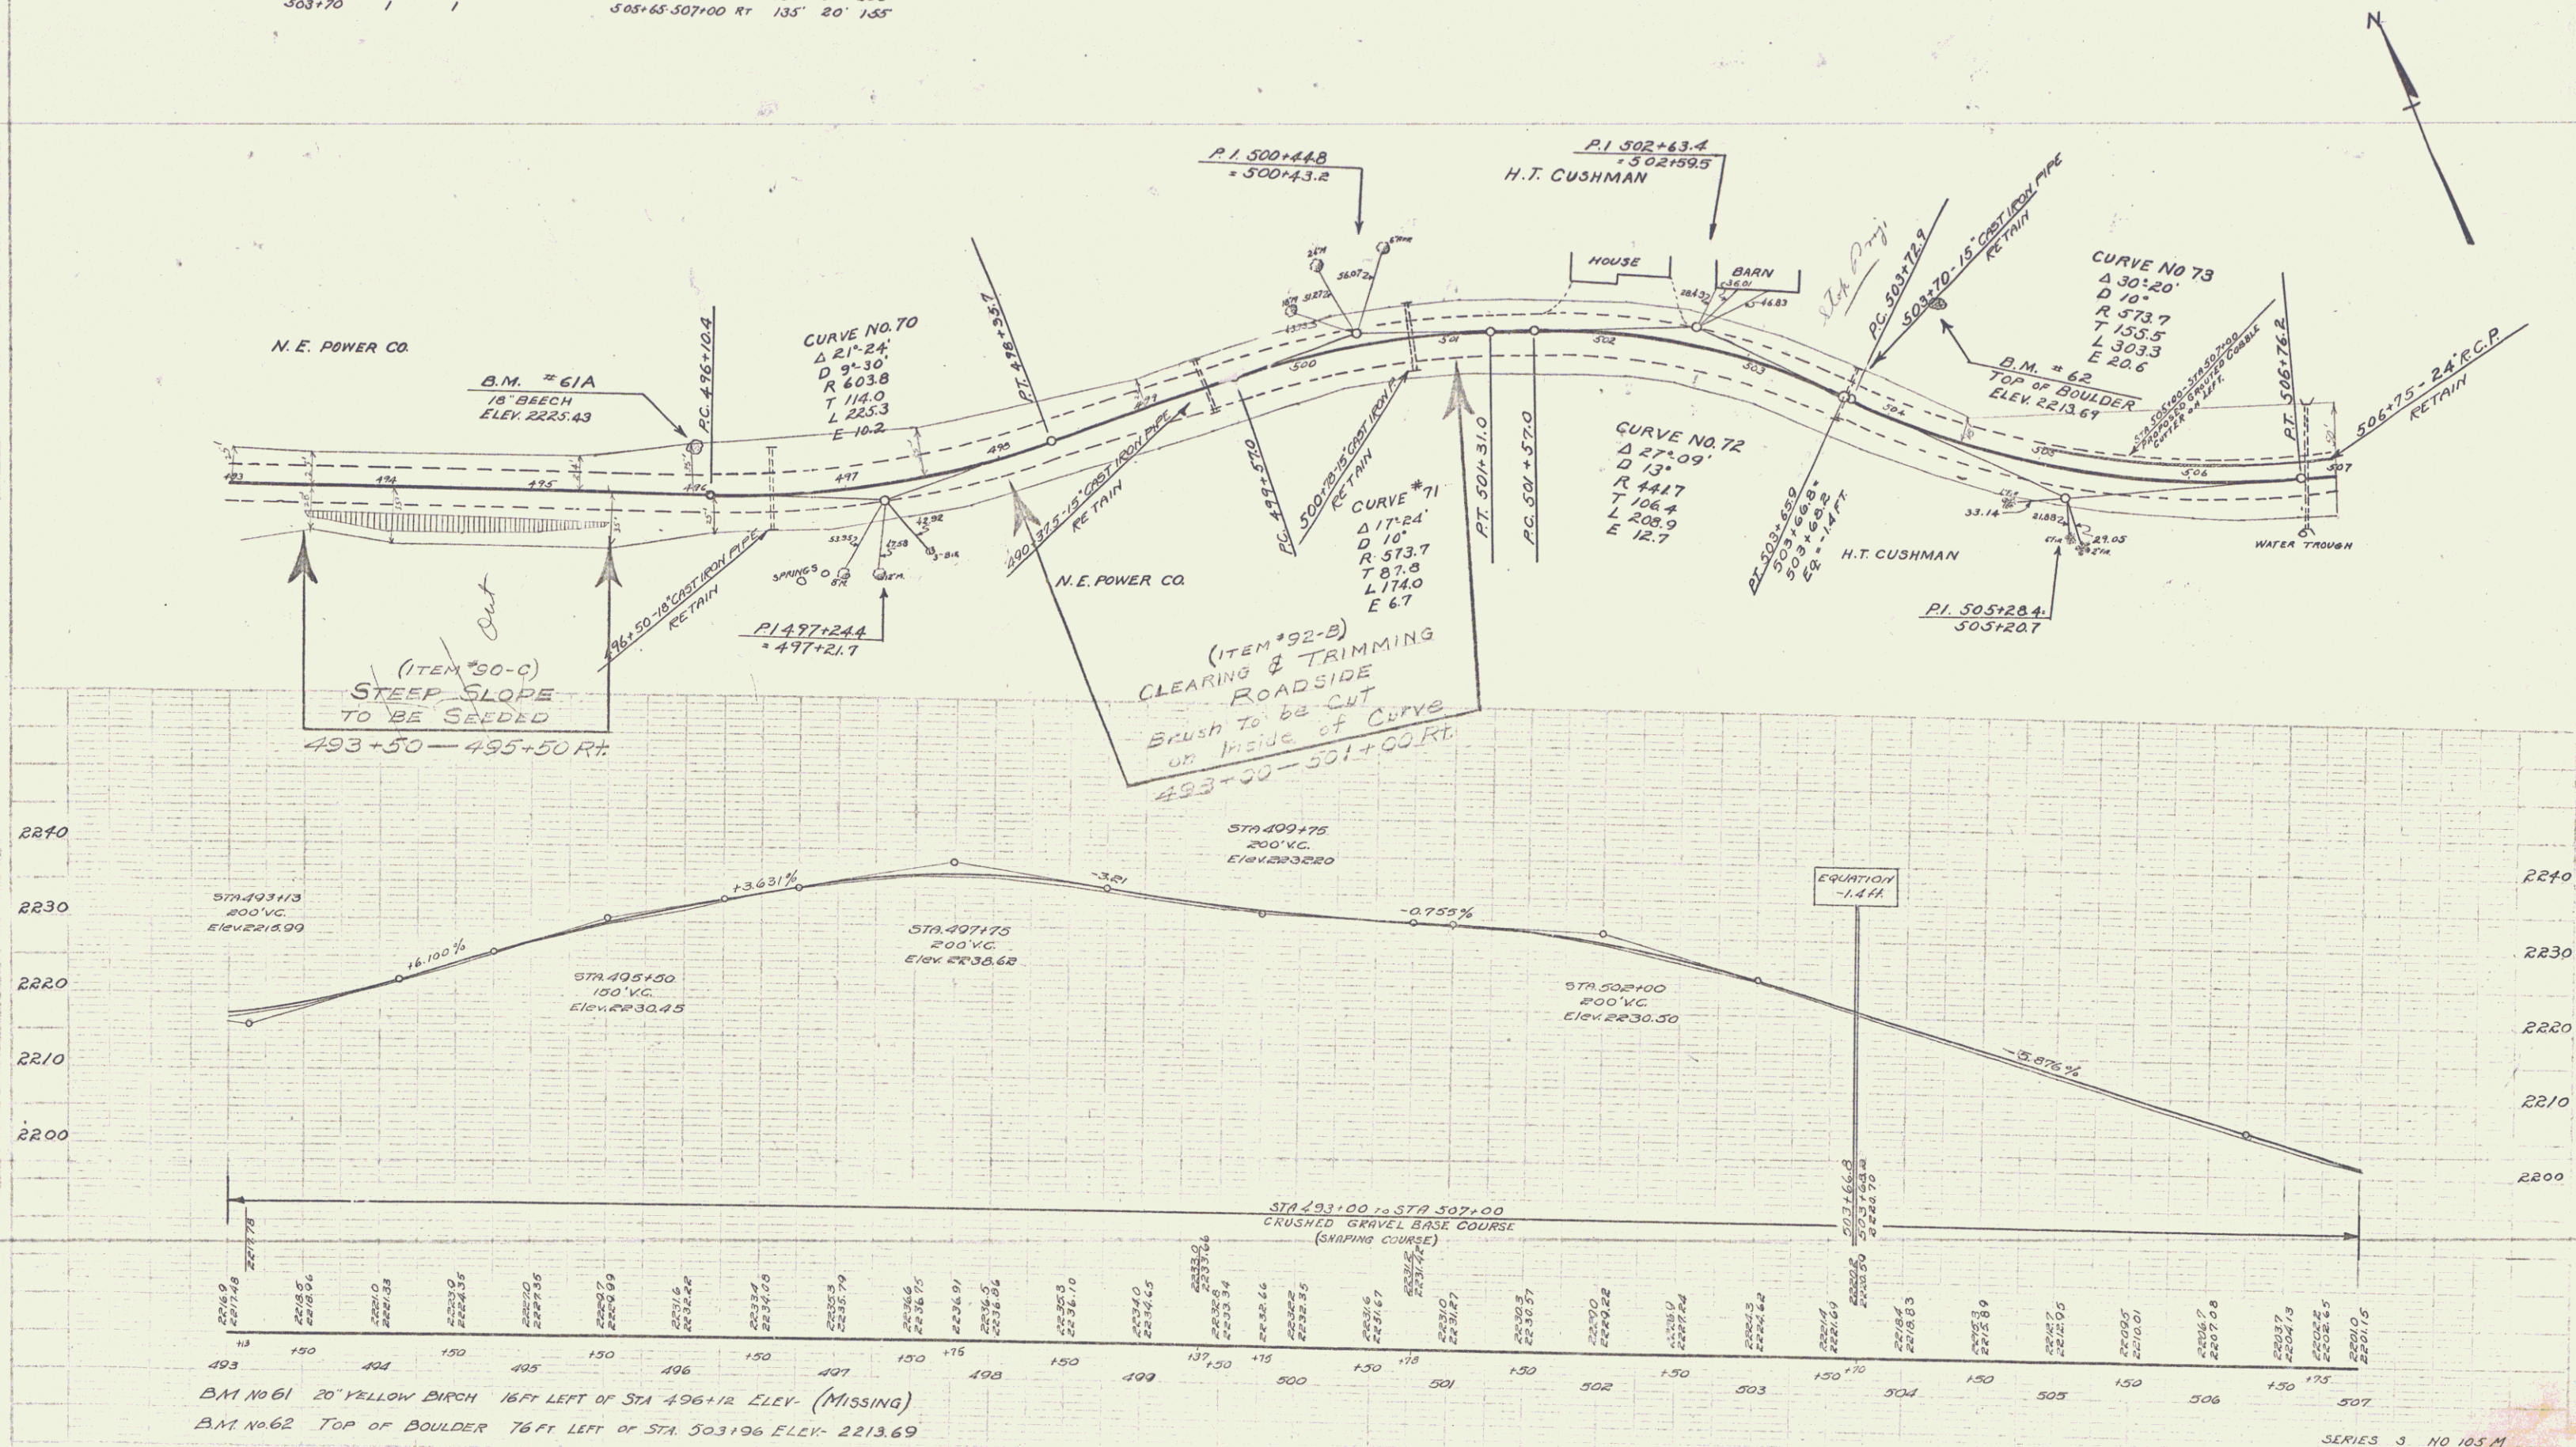


SHEET 6 OF 55


GUIDE POST OF WOOD		
STATION	LEFT	RIGHT
512+67	~	1

CABLE GUARD RAIL			
STA TO STA	LENG.	CHAS.	PAVING
507+00 507+25	25'	20'	45'
507+00 507+25	25'	20'	45'
512+67	24'	20'	64'

105 M 1932 7 55

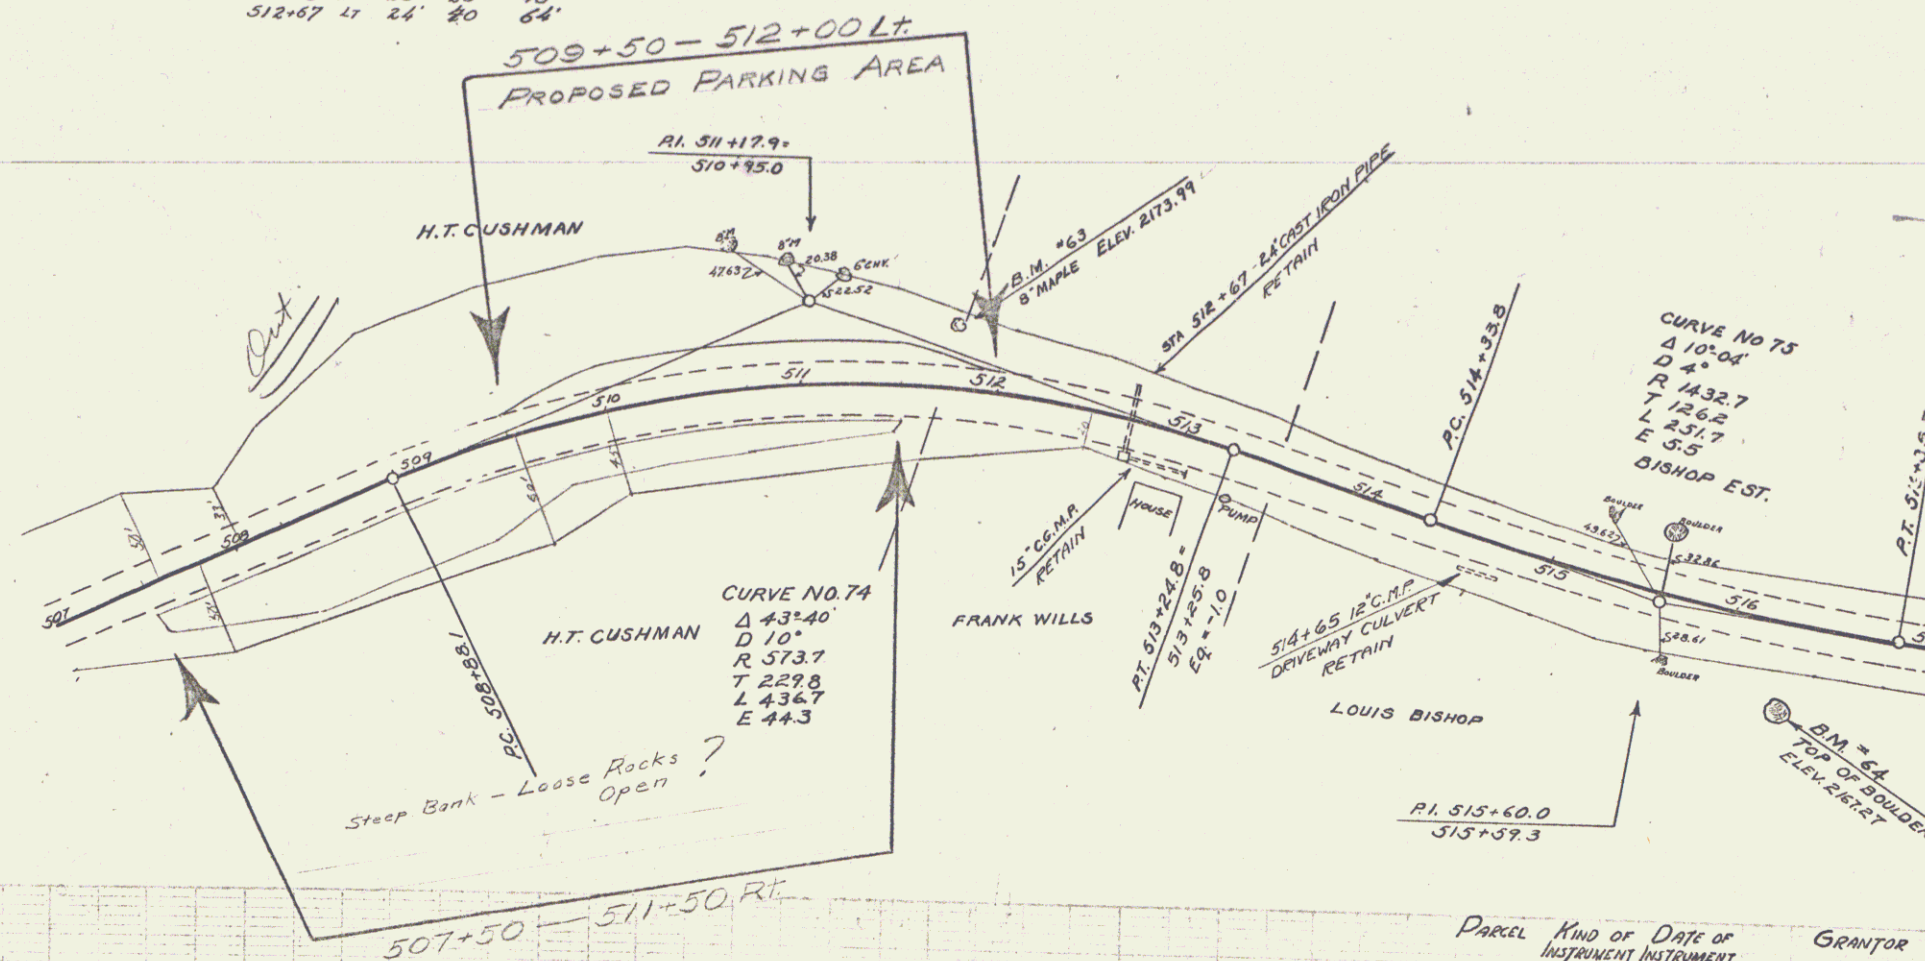

2200
2190
2180
2170
2160

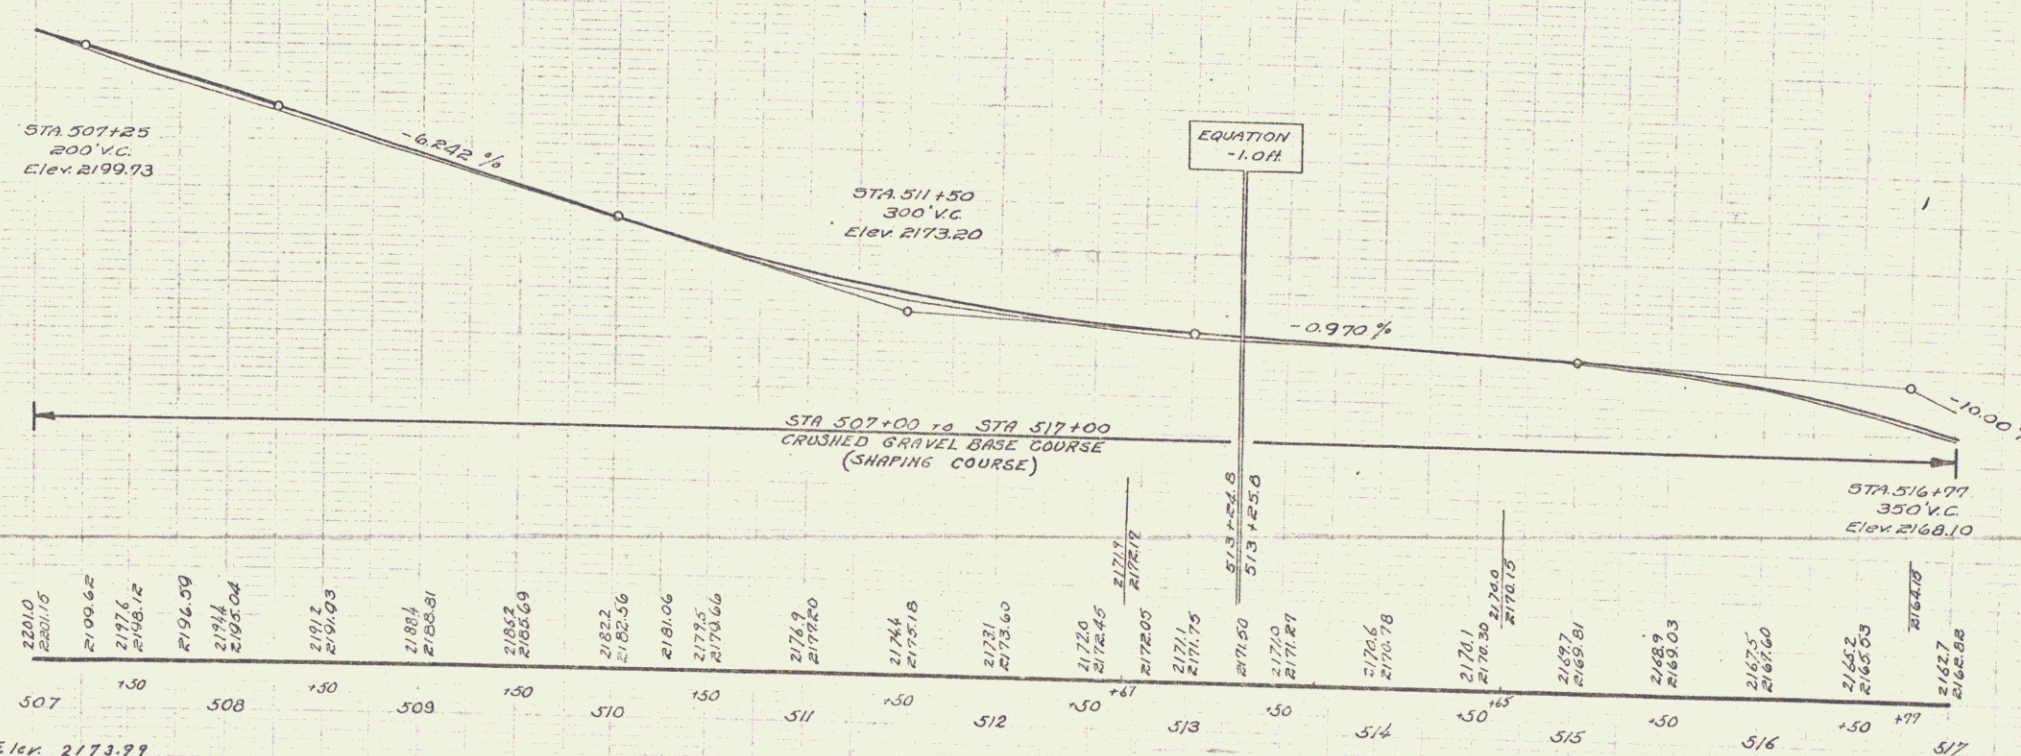



2200
2190
2180
2170
2160

B.M. 63 8" Maple 32' left of Sta 511+78 Elev. 2173.99
B.M. 64 Top of boulder 47th right of Sta 516+31 Elev. 2167.27

SERIES S NO 105 M
SHEET 7 OF 55

GUIDE POSTS OF WOOD		
STATION	LEFT	RIGHT
525+00	1	1
527+21	1	1
529+00	1	1
531+50	1	1

CABLE GUARD RAIL			
STATION	LEN	WIDTH	CONST. PAVING
522+35	17.6 FT	36"	80' 176"
527+21	27	24	40' 64"

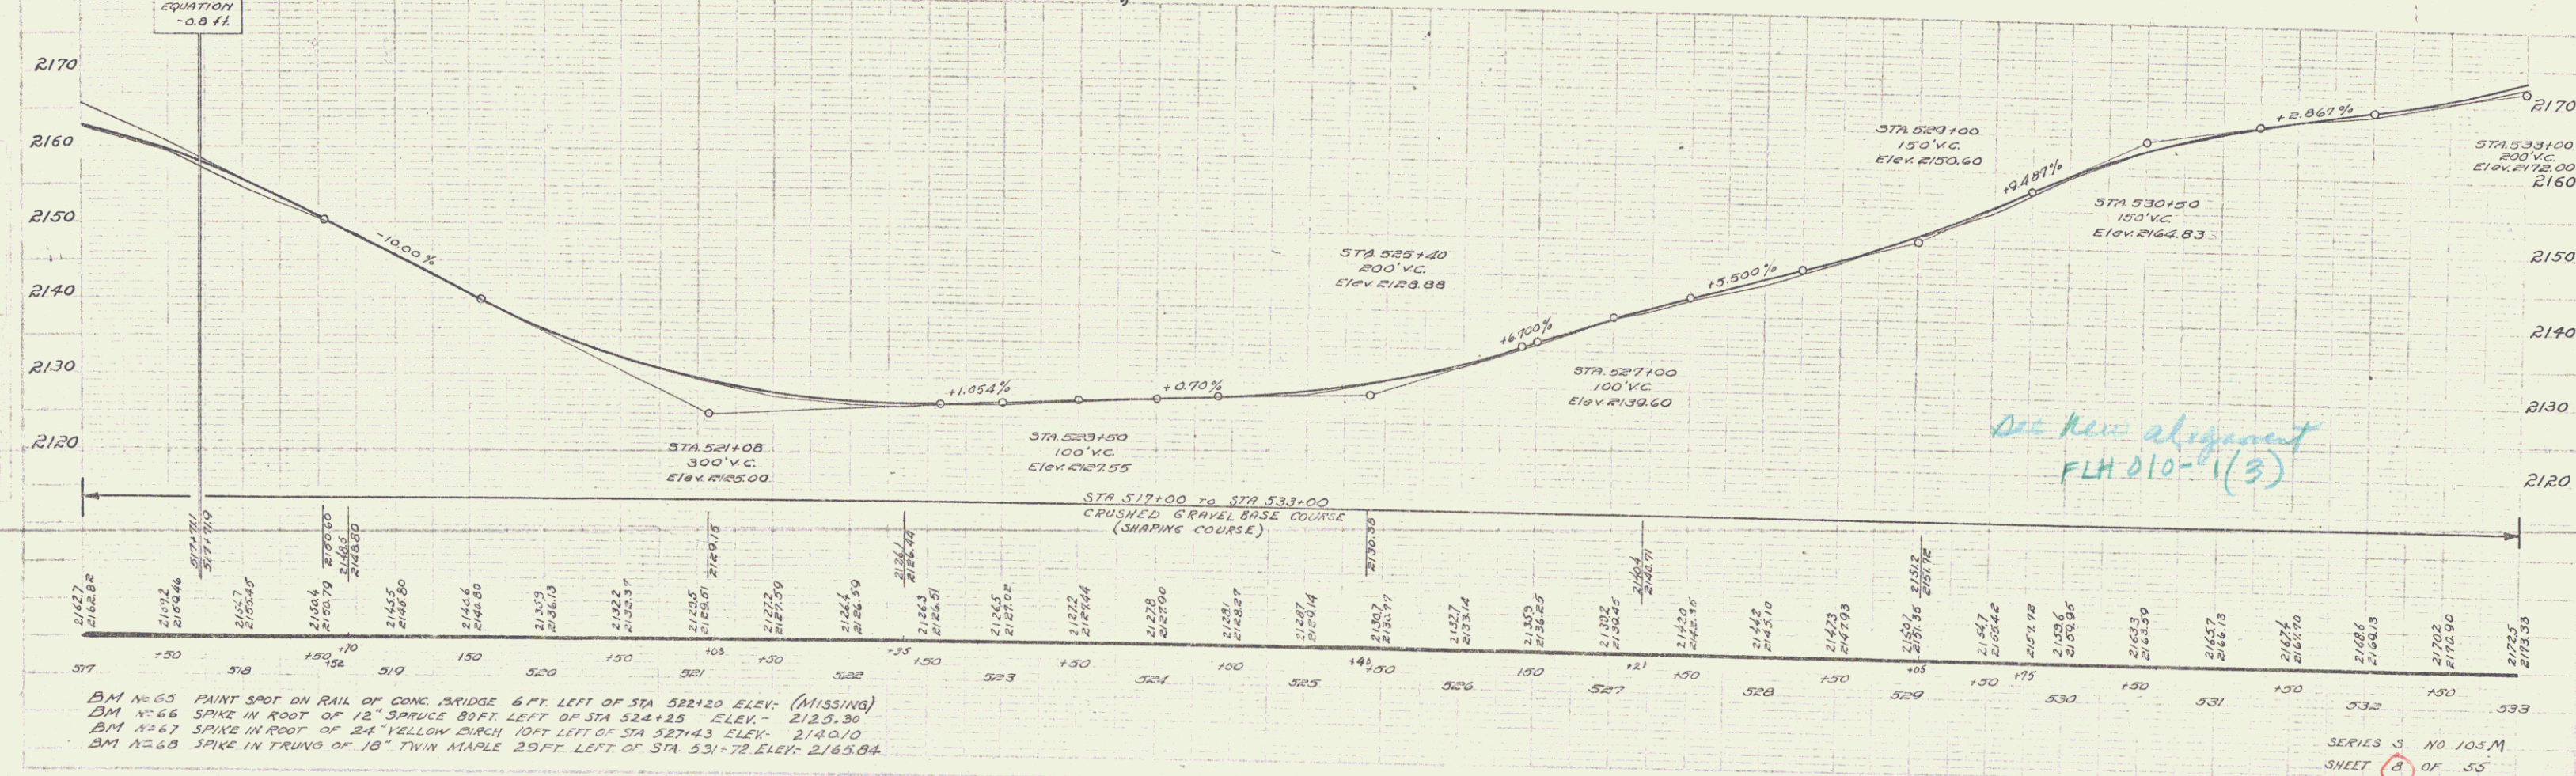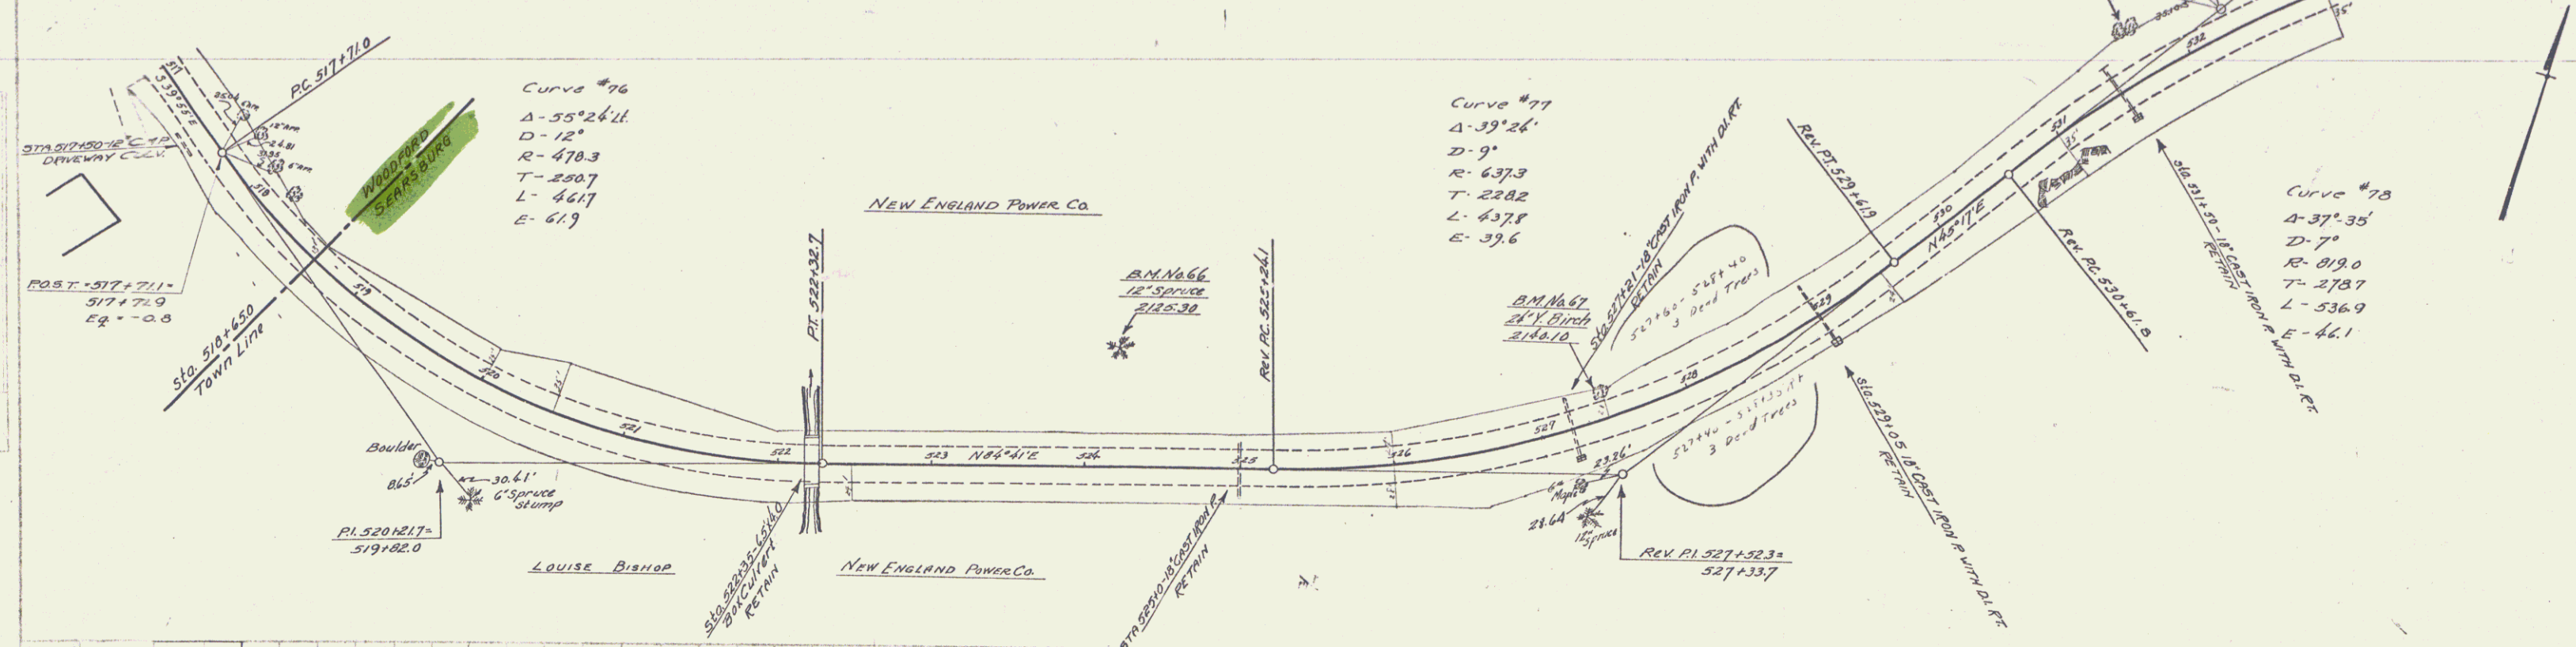


BM #65 PAINT SPOT ON RAIL OF CONC. BRIDGE 6 FT. LEFT OF STA 522+20 ELEV. (MISSING)
 BM #66 SPIKE IN ROOT OF 12" SPRUCE 80 FT. LEFT OF STA 524+25 ELEV. 2123.30
 BM #67 SPIKE IN ROOT OF 24" YELLOW BIRCH 10 FT. LEFT OF STA 527+43 ELEV. 2140.10
 BM #68 SPIKE IN TRUNK OF 18" TWIN MAPLE 29 FT. LEFT OF STA 531+72 ELEV. 2165.84

GUIDE POSTS OF WOOD		
STATION	LEFT	RIGHT
534+00	1	1
536+30	1	1
540+50	1	1
546+57	1	1

CABLE GUARD RAIL			
STATION	Dist	Left	Right
534+00	1r	48'	75' 08"
536+30	1r	48'	40' 08"


105 M 1932 9 55

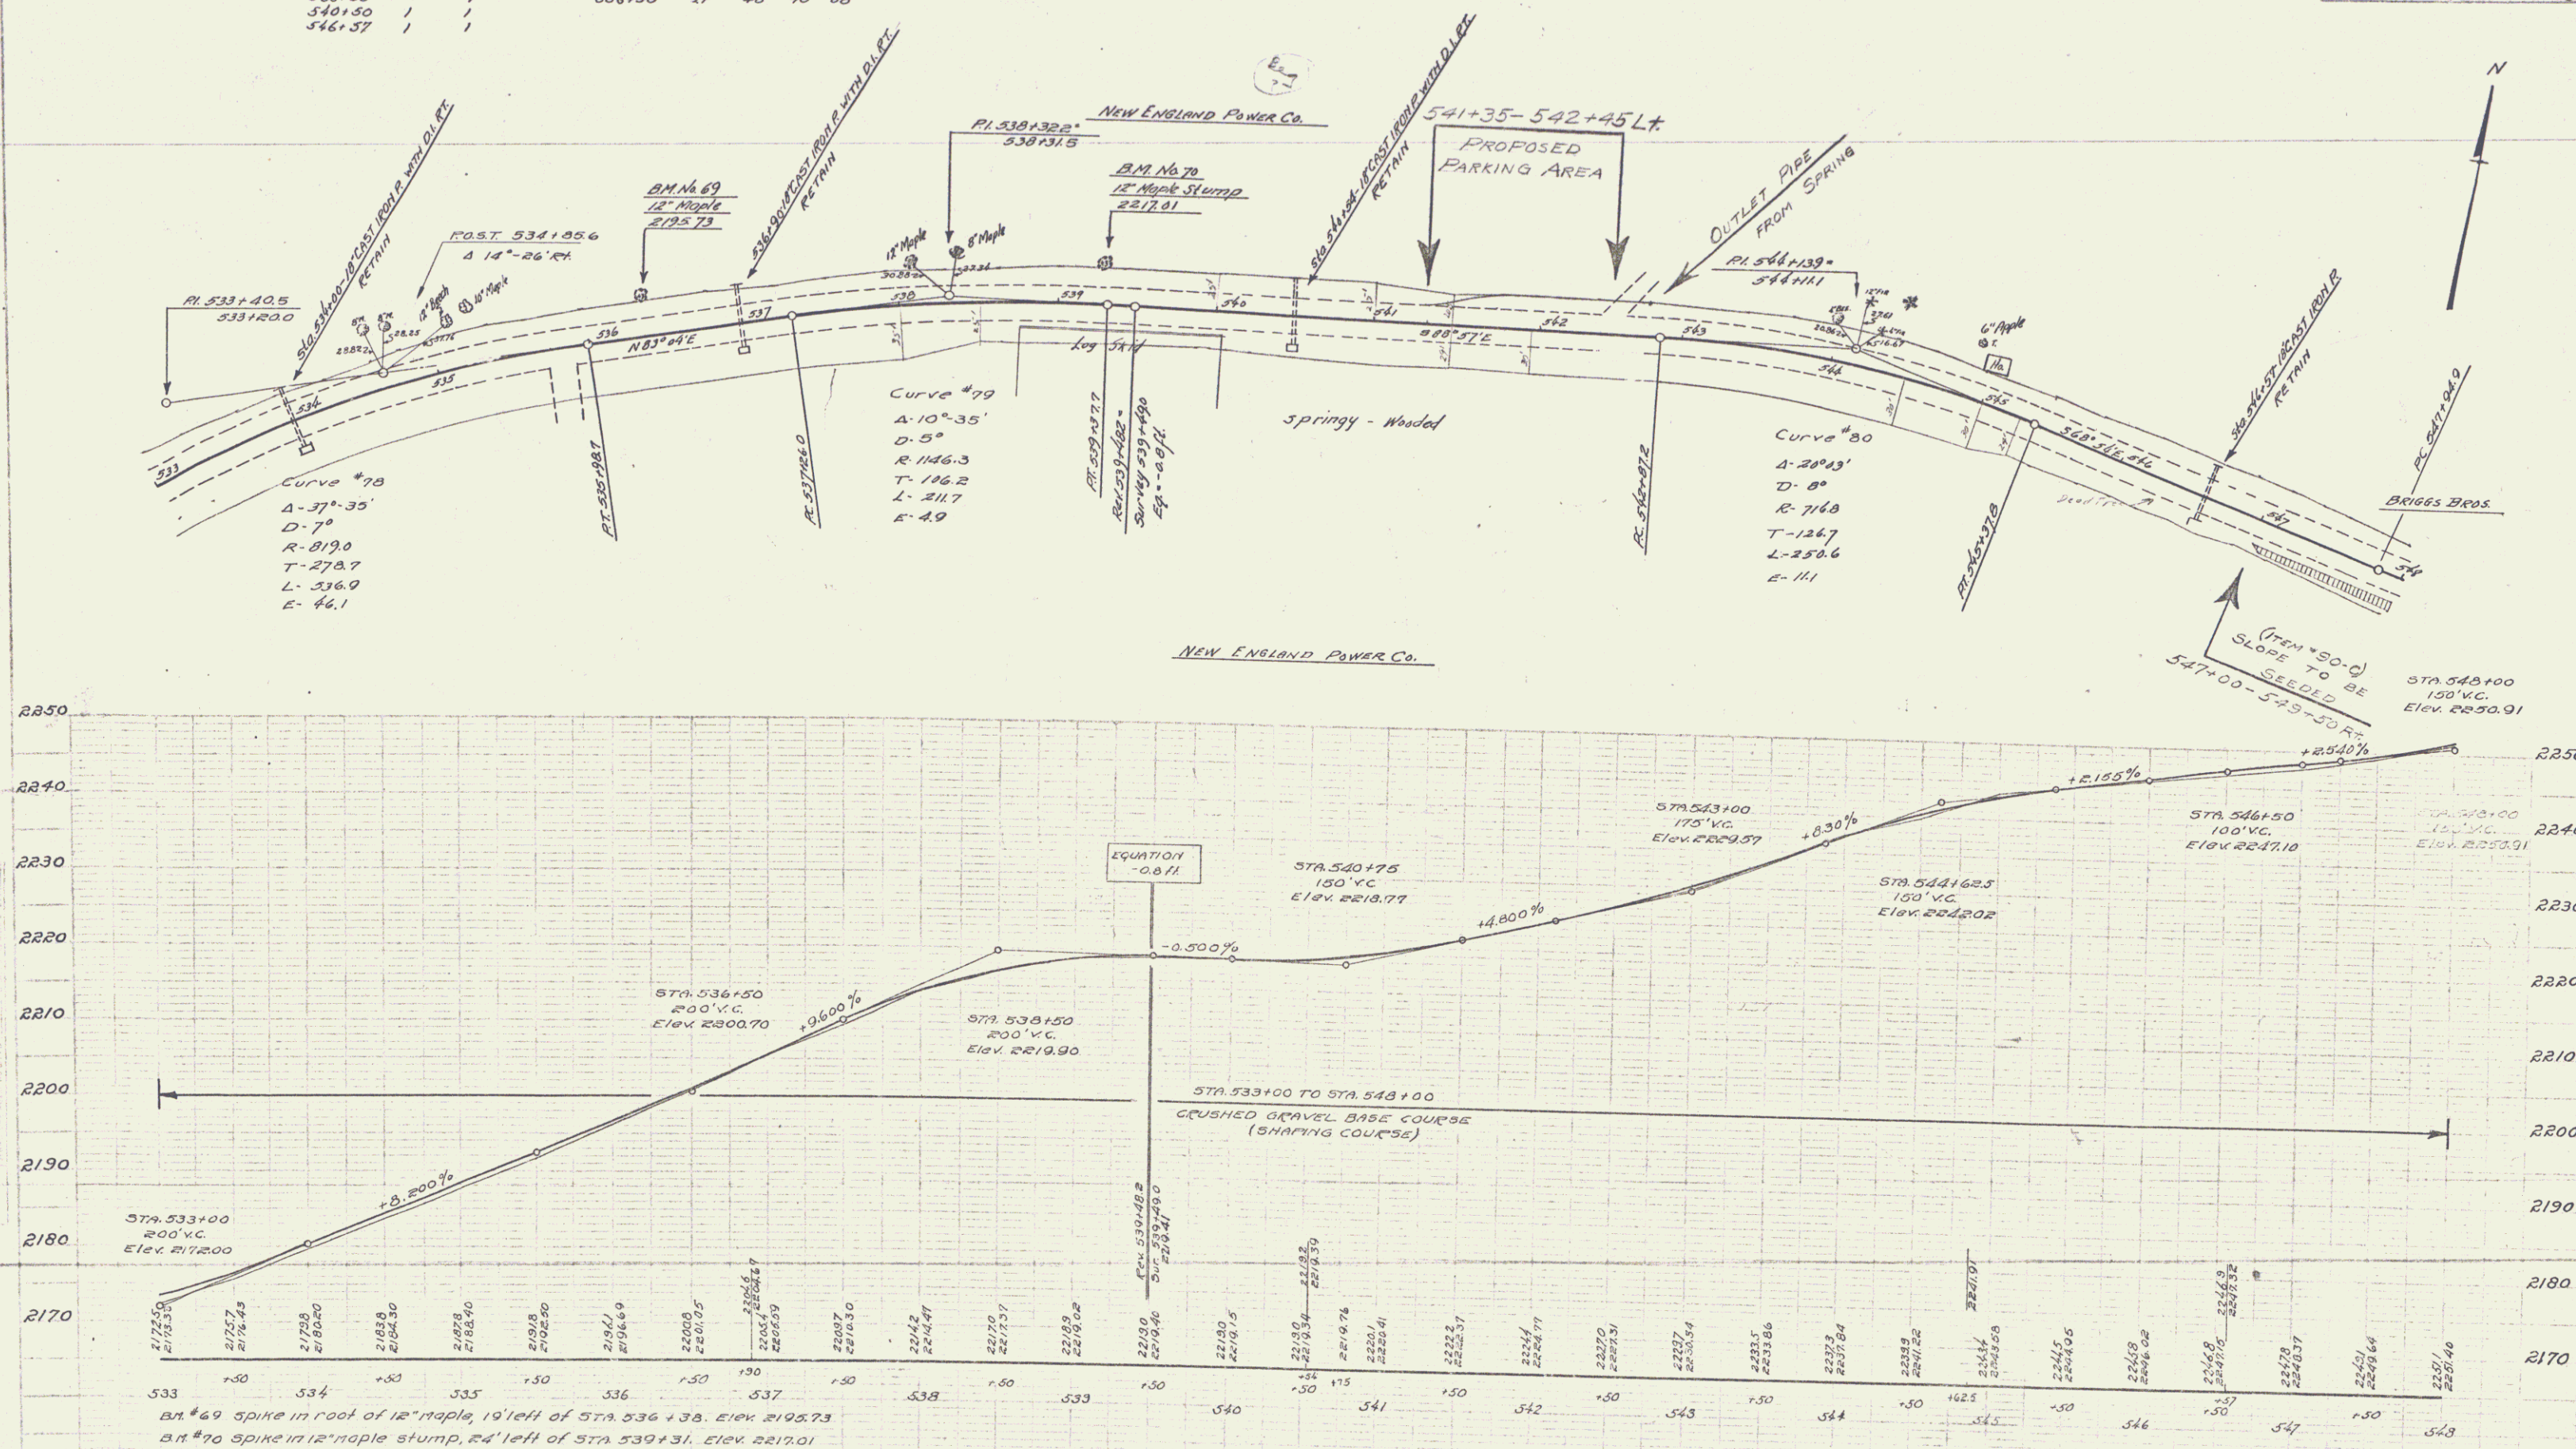

SERIES S NO 105 M
SHEET 9 OF 35

WOOD GUARD RAIL		GUIDE POSTS OF WOOD		CABLE GUARD RAIL	
STATION	LEFT RIGHT	STATION	LEFT RIGHT	STATION	LEFT RIGHT
568+27	24' ~	568+03	~	578+14	48' 40' 88'
575+40	24' ~	568+27	~		
579+93	24' 24'	575+40	~		
		578+14	~		

FEED ROAD	STATE	FEED NO.	SHEET	TOTAL
9	VT	105 M	1932 II	33

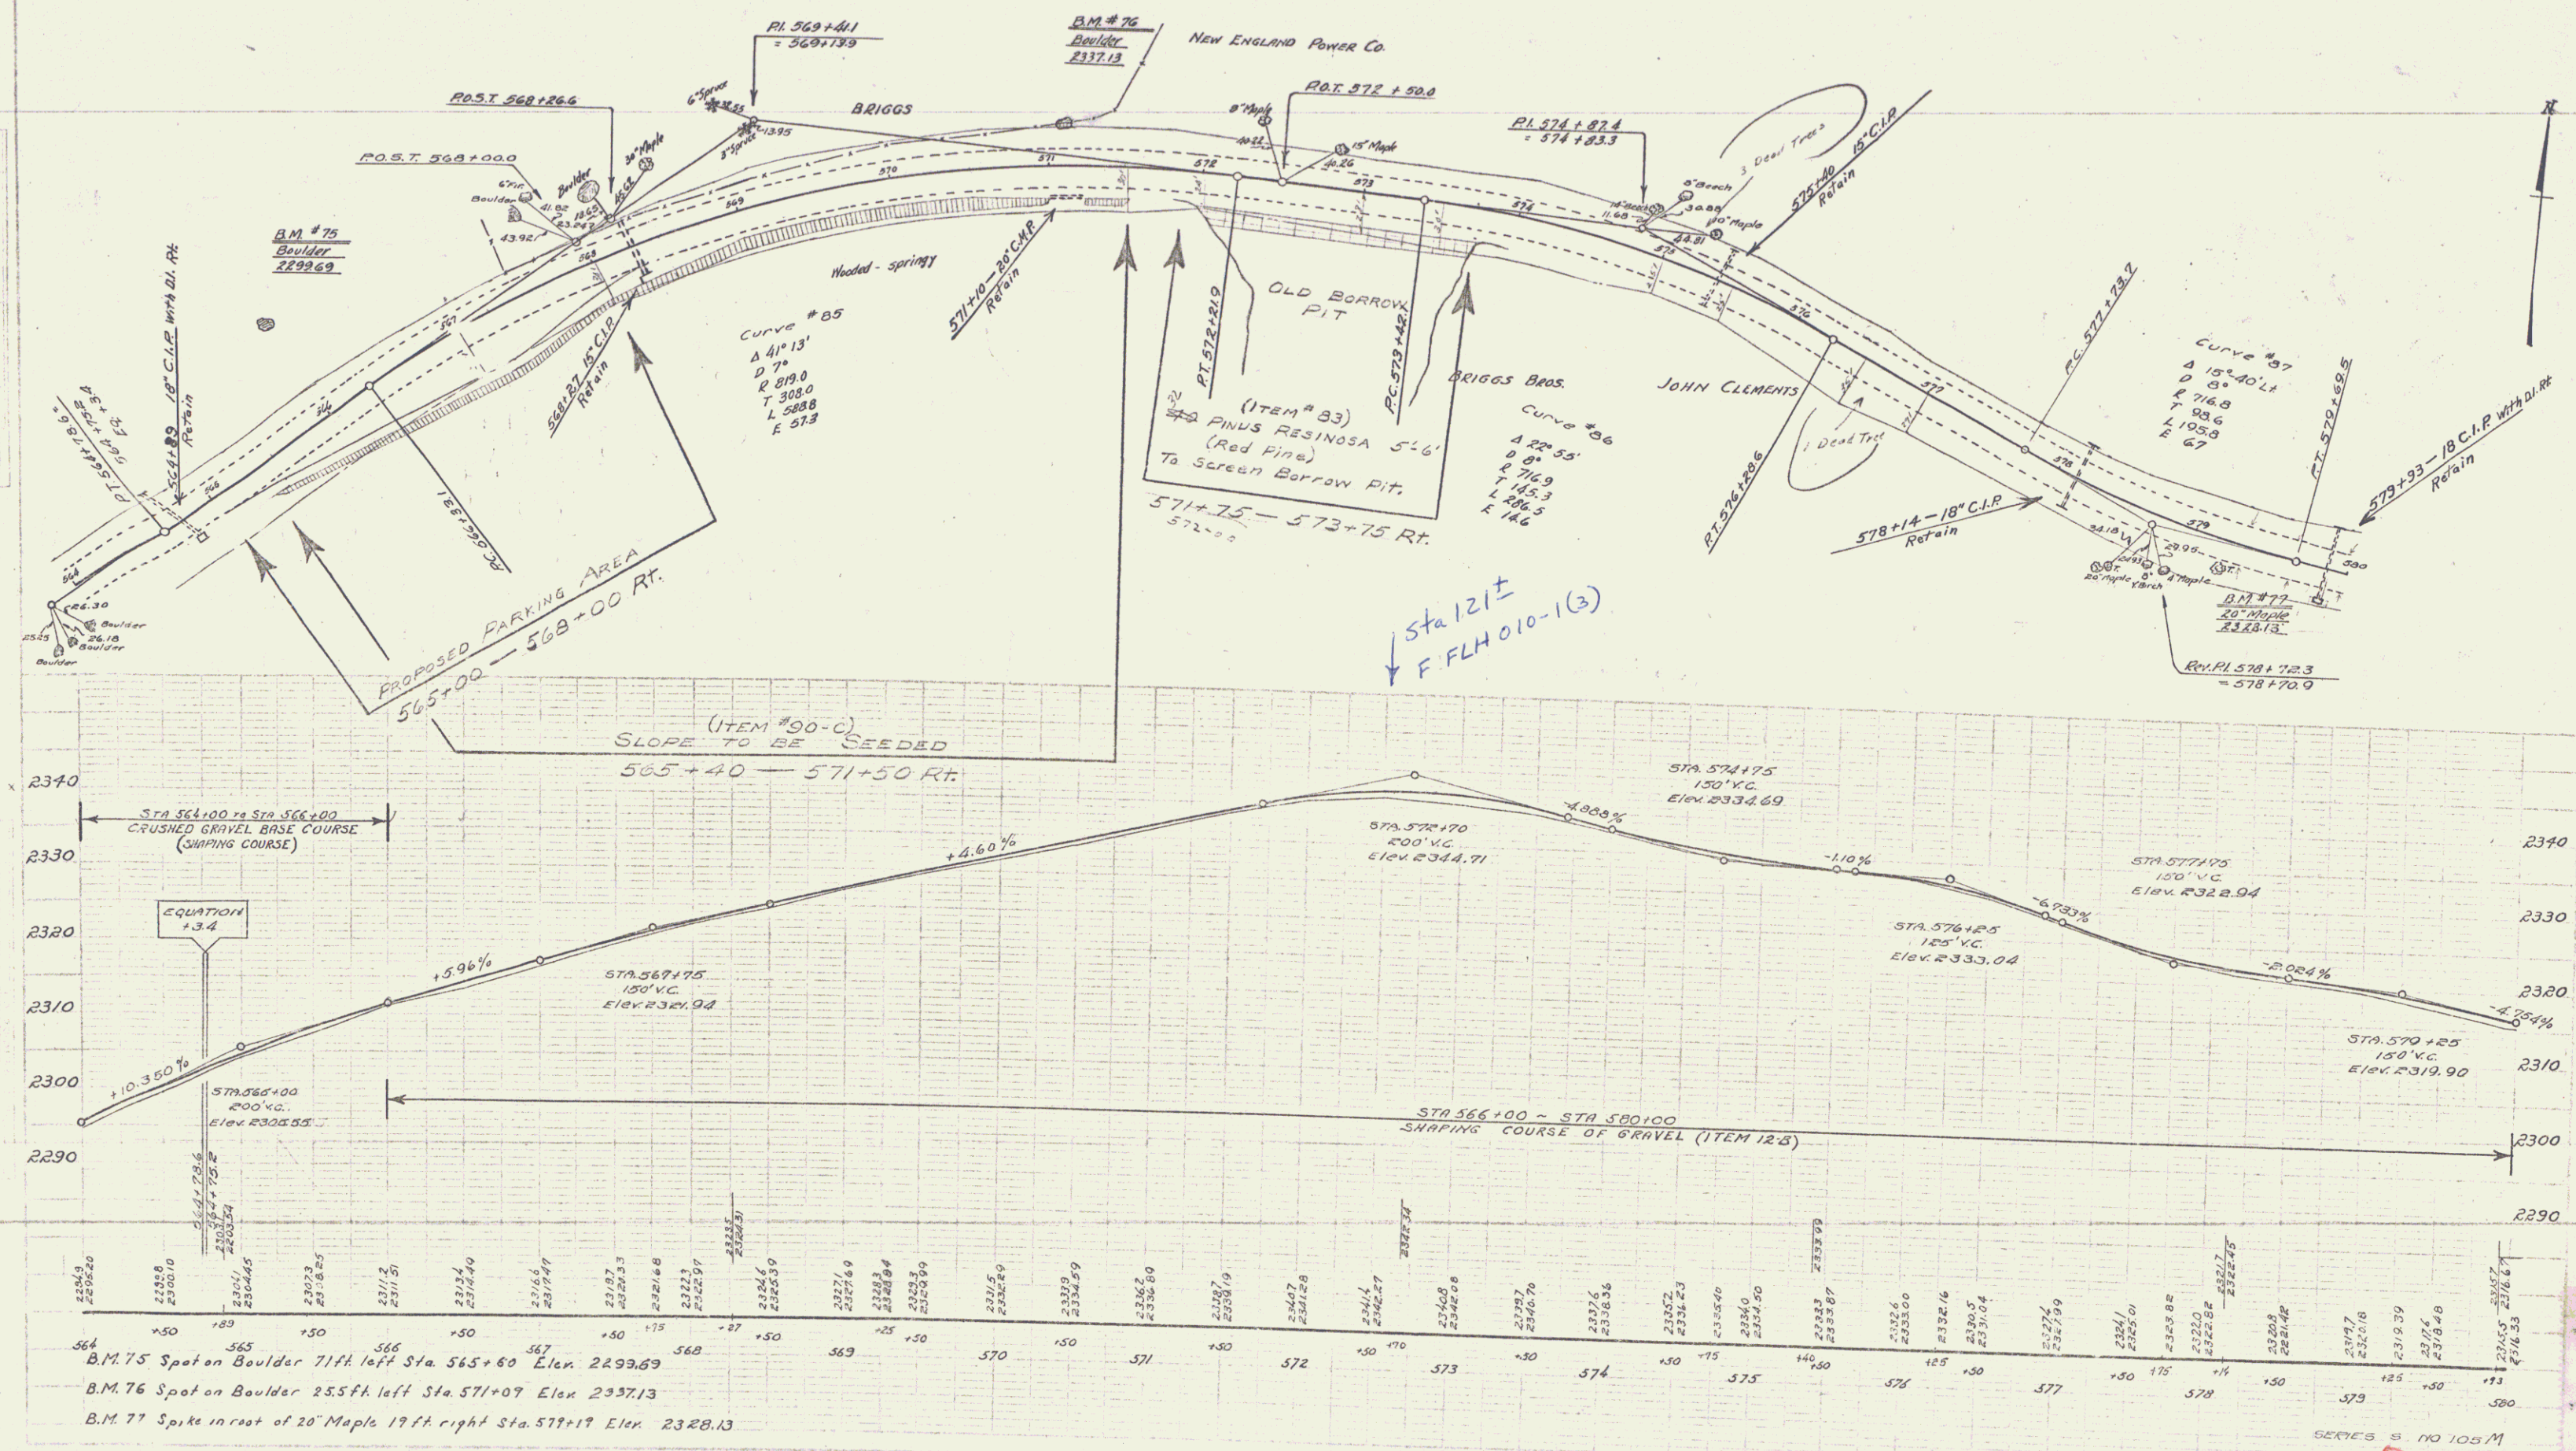



SERIES B NO 105 M
SHEET 11 OF 55

WOOD GUARD RAIL
STATION LEFT RIGHT
613+75 24' 24'

GUIDE POSTS OF WOOD
STATION LEFT RIGHT
623+65 1' 1'


REINFORCED CONCRETE PIPE CULVERTS
STATION SIZE LENGTH C.R.M.
623+65 15" 32' 3.00K

105 M 1932 14

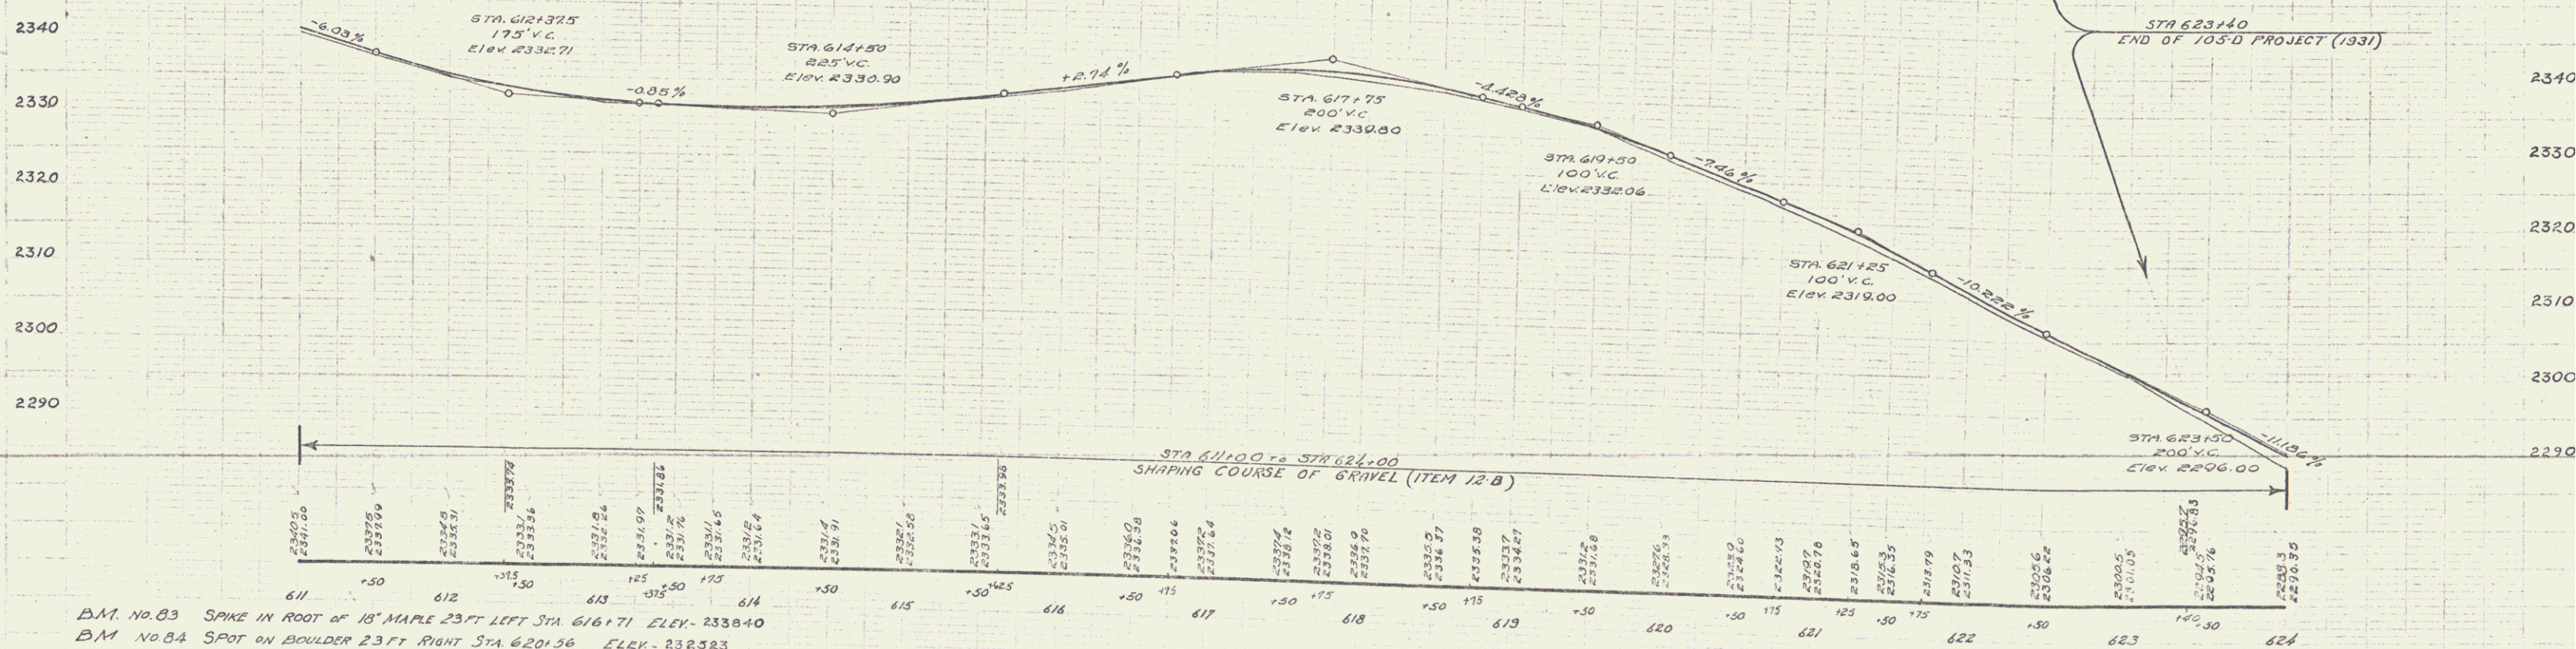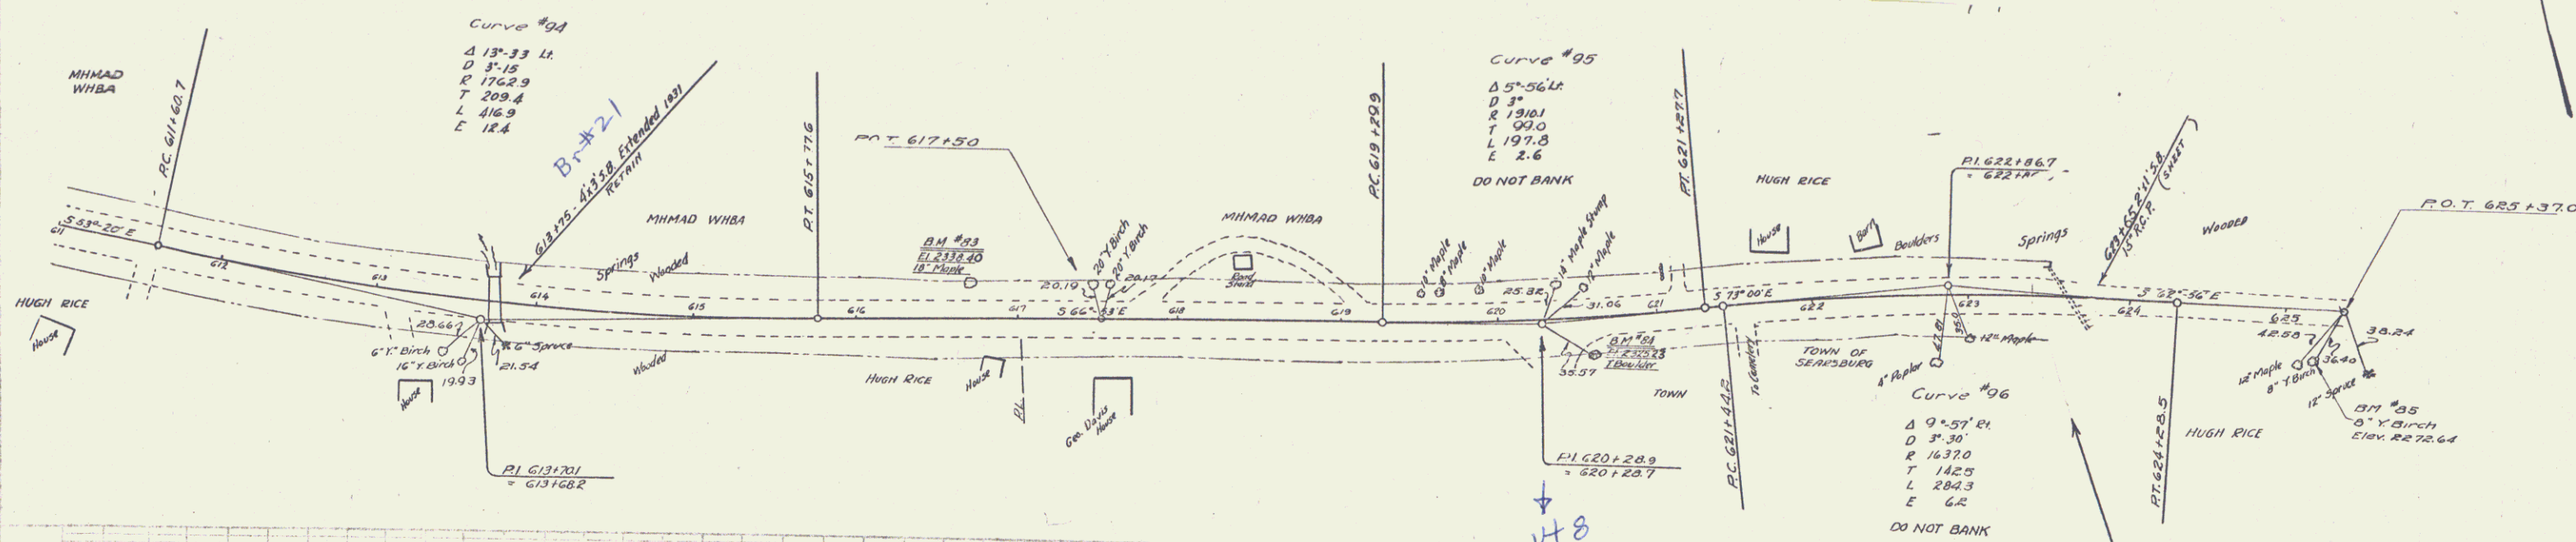

B.M. NO. 83 SPIKE IN ROOT OF 18" MAPLE 23 FT LEFT STA. 616+71 ELEV. 2338+40
B.M. NO. 84 SPOT ON BOULDER 23 FT RIGHT STA. 620+36 ELEV. 2325+23
B.M. NO. 85 SPIKE IN ROOT OF 8" BIRCH 30 FT RIGHT STA. 626+00 ELEV. 2272+64



SERIES 8 NO 105 M
SHEET 14 OF

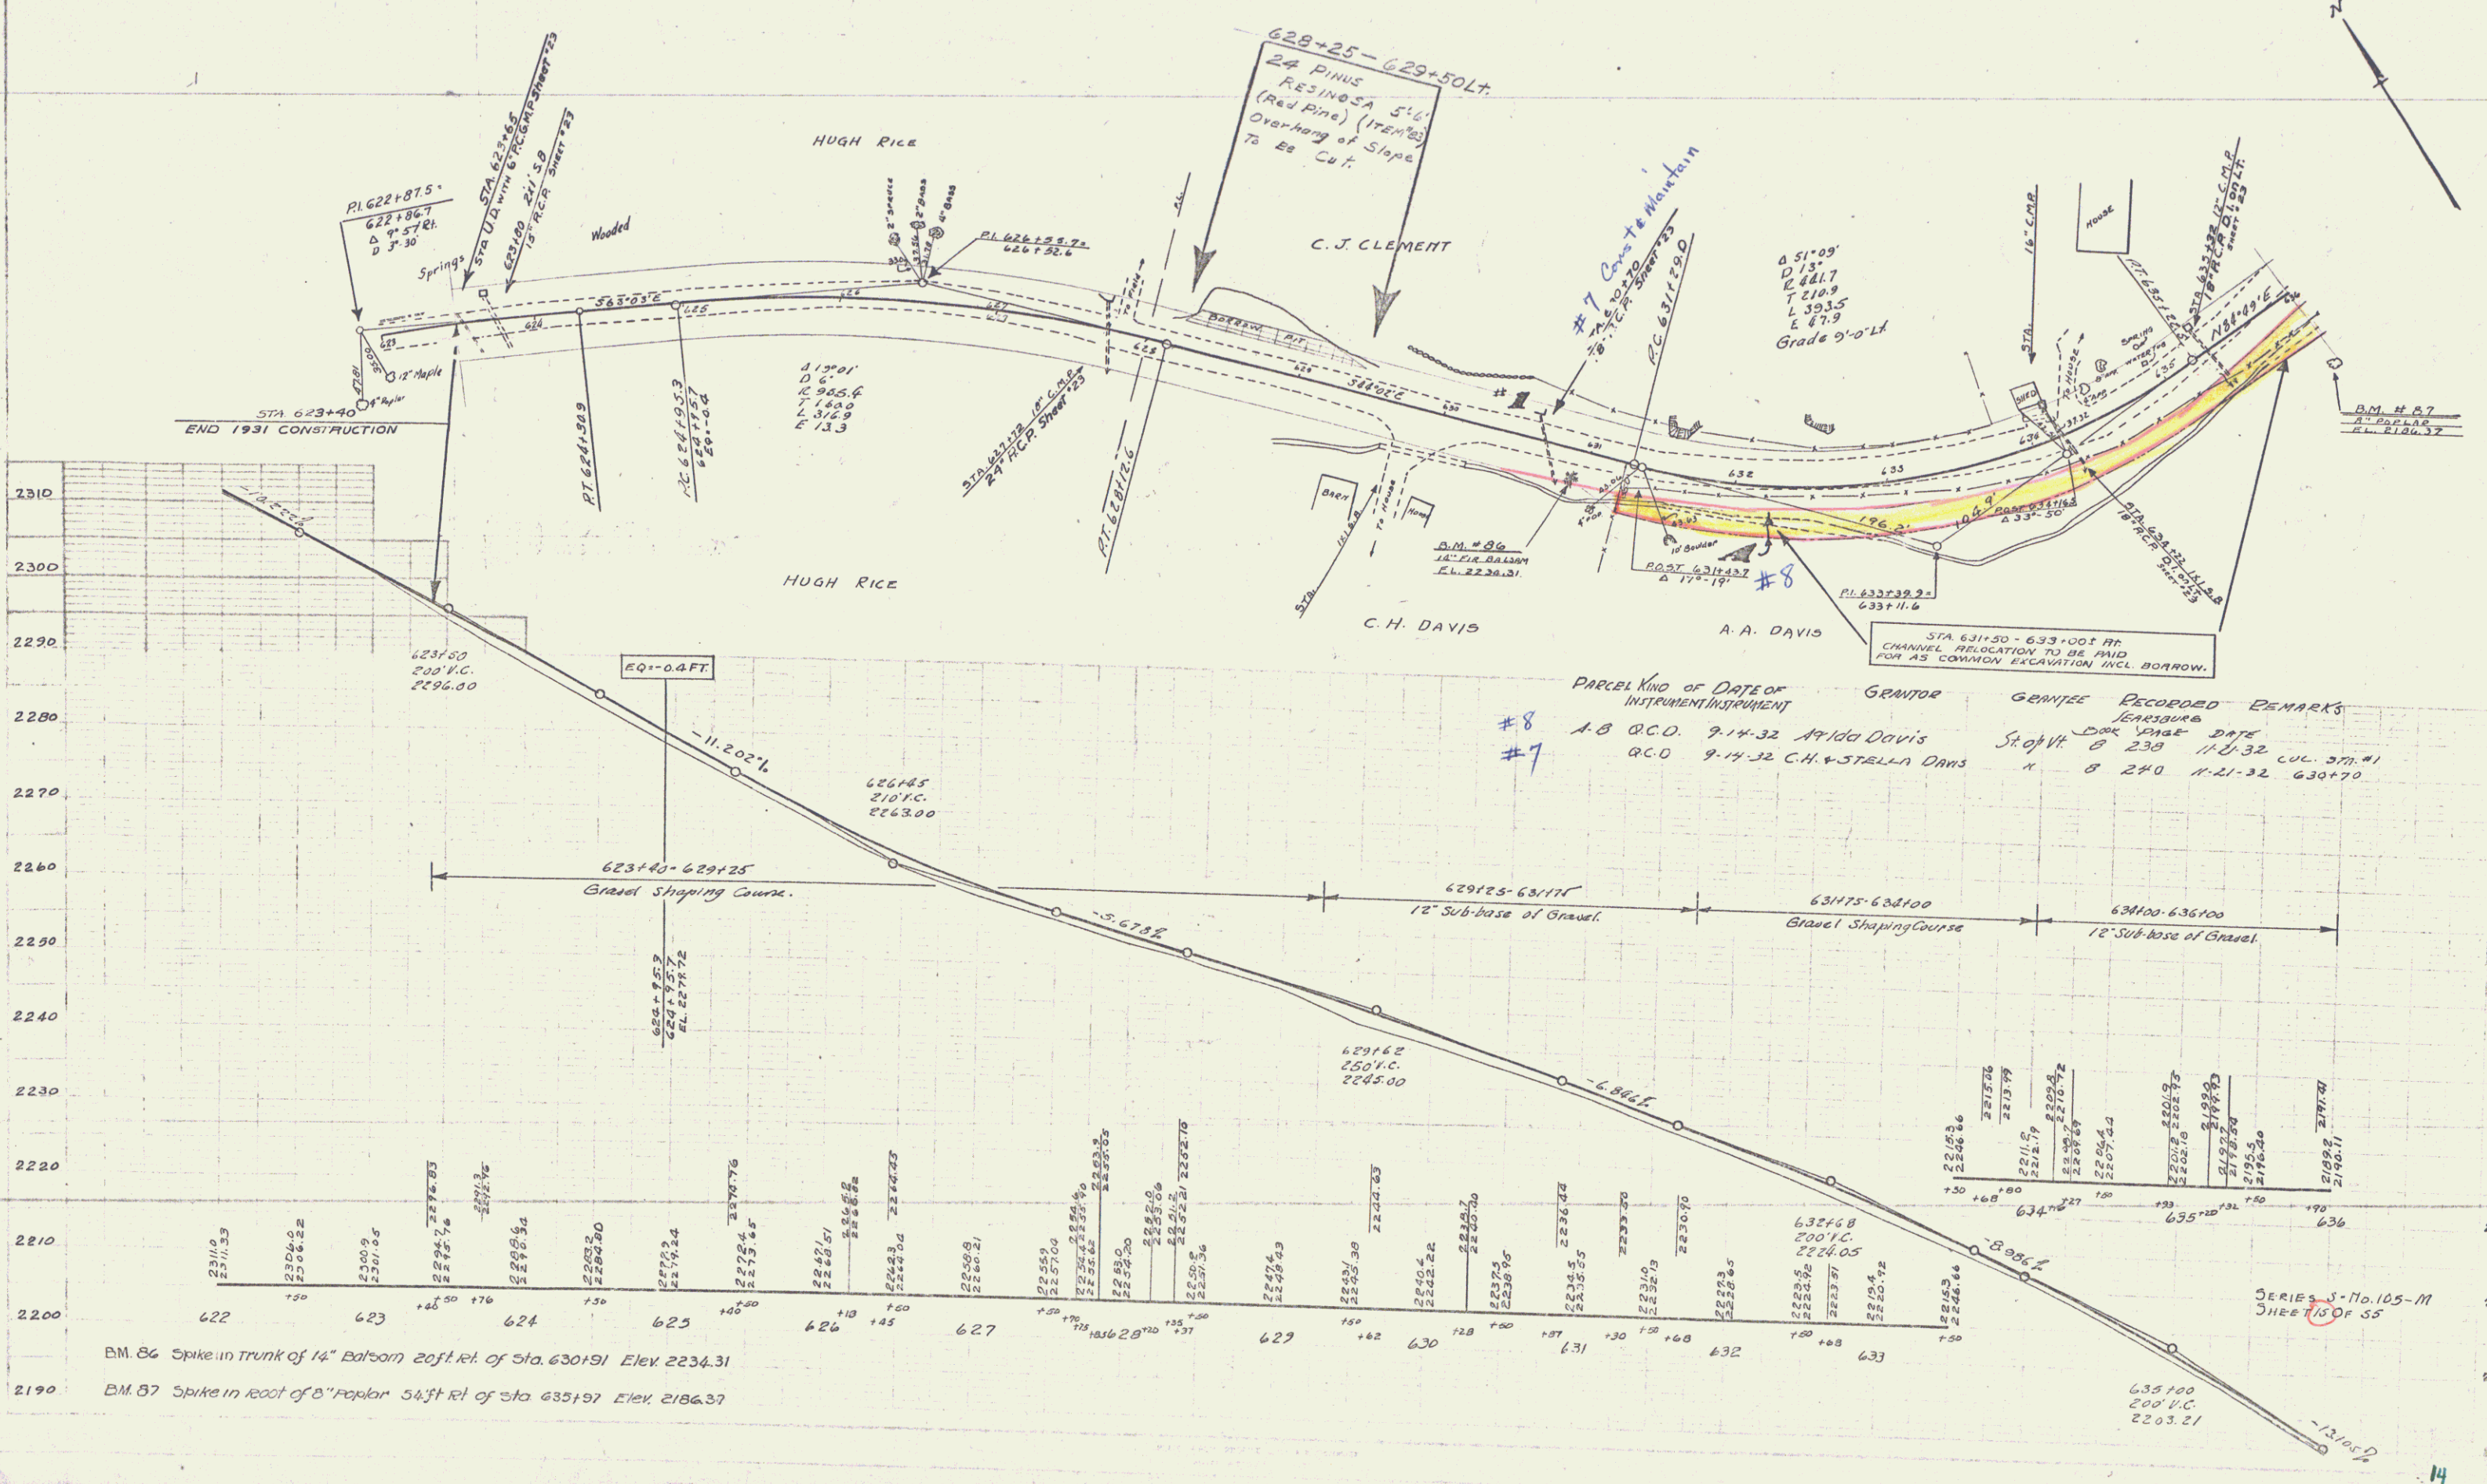

BM 86 Spike in trunk of 14" Balsam 20 ft. N. of Sta. 630+91 Elev. 2234.31
BM 87 Spike in root of 8" Poplar 54 ft. N. of Sta. 635+97 Elev. 2186.37

PARCEL	KIND OF DATE OF INSTRUMENT	GRANTOR	GRANTEE	RECORDED	REMARKS
#8	A.B. R.C.D.	9-14-32	A. J. Davis	11-10-32	See page 11
#7	R.C.D.	9-14-32	C.H. & Stella Davis	11-21-32	See page 11

SERIES No. 105-M
SHEET 15 OF 55

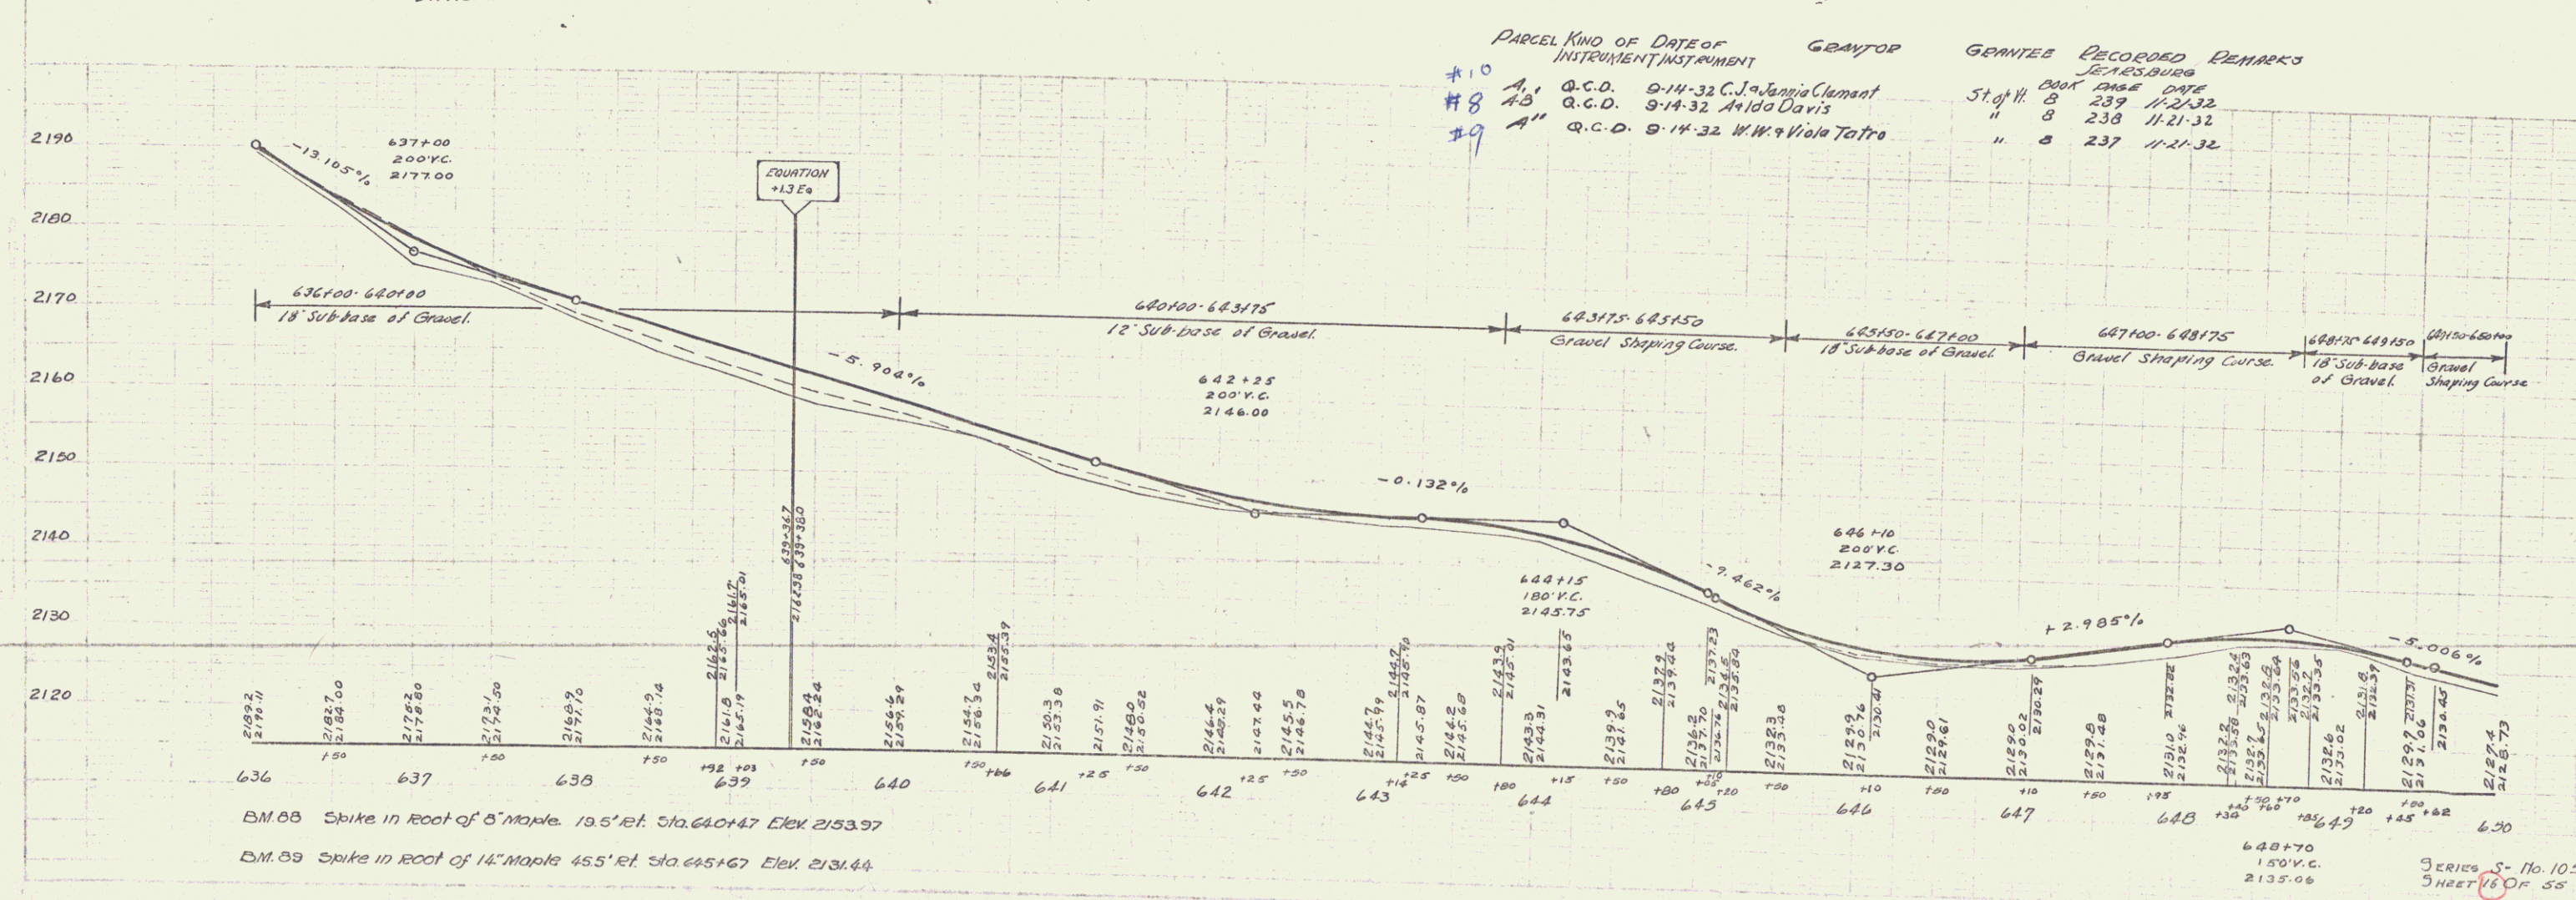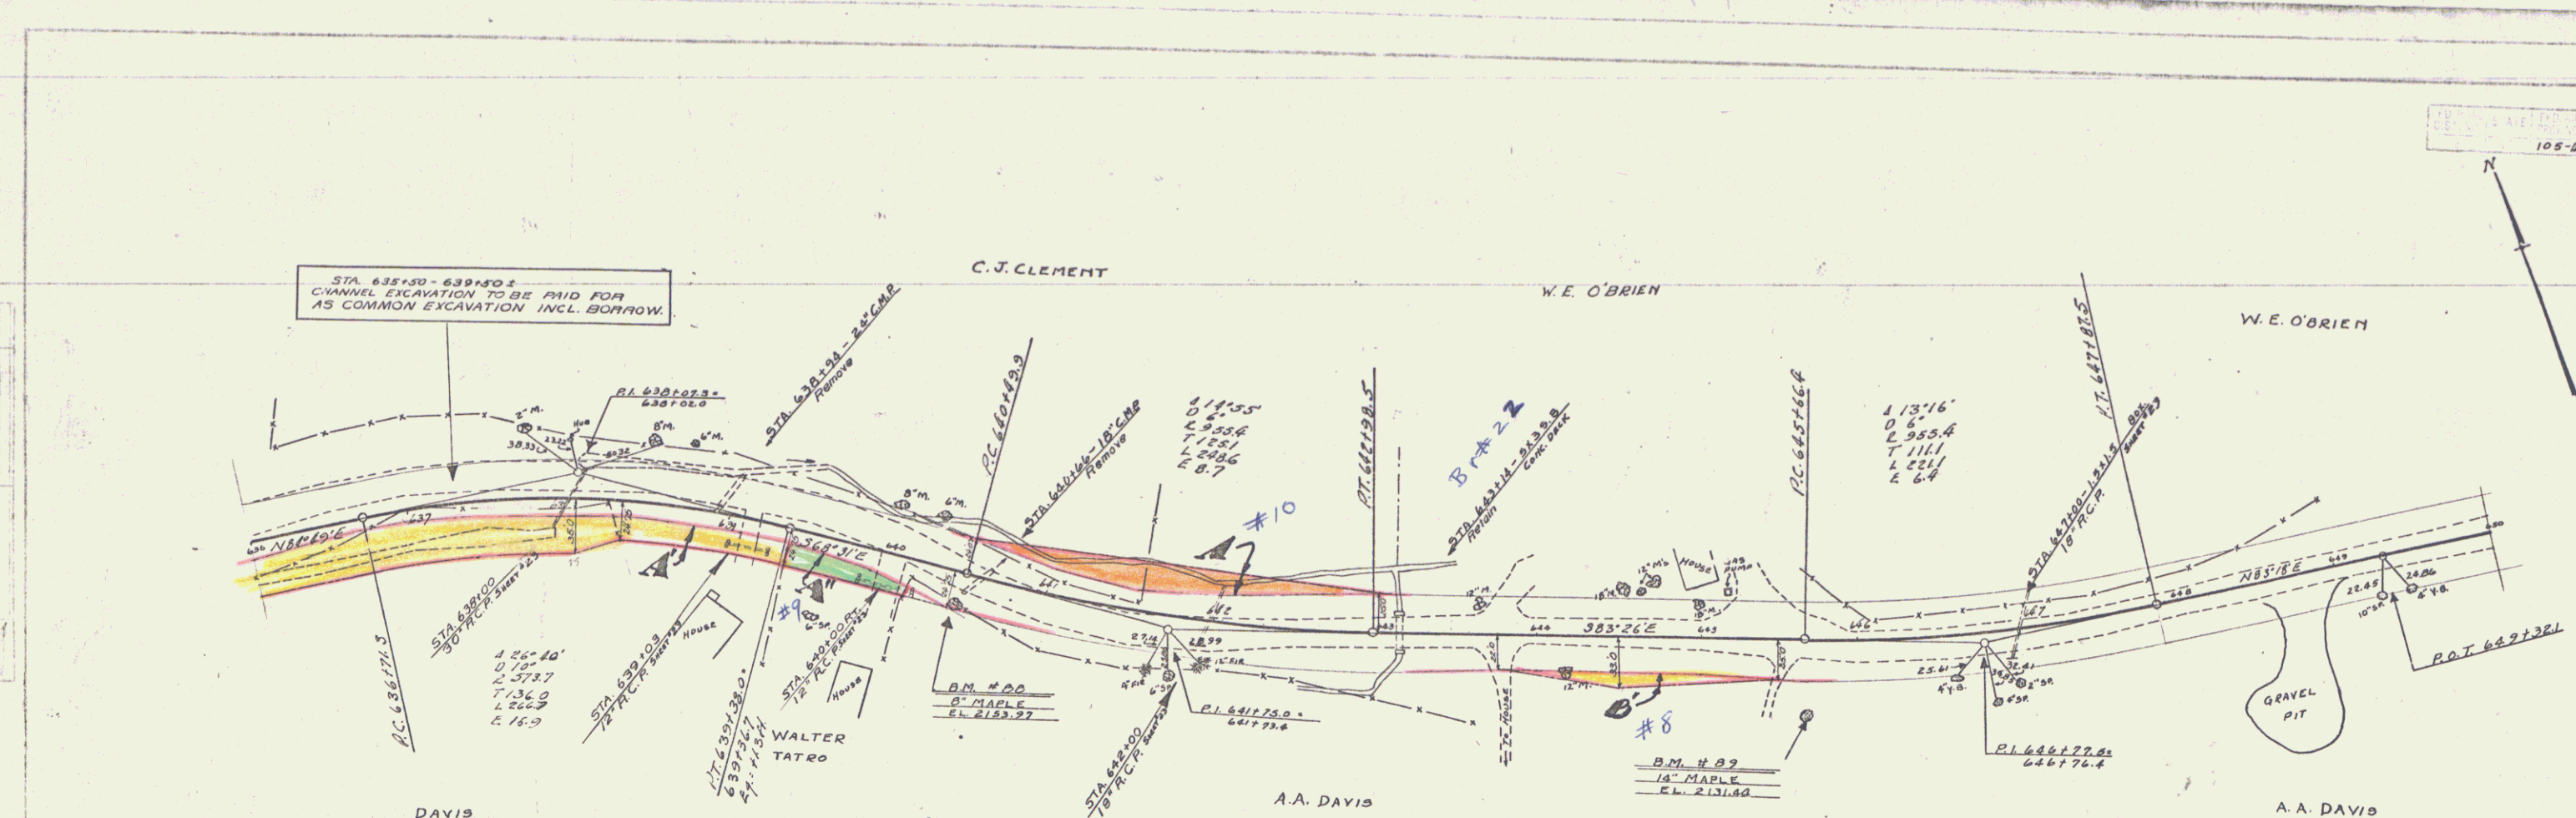


PARCEL	KIND OF INSTRUMENT	DATE OF INSTRUMENT	GRANTOR	GRANTEE	RECORDED	REMARKS
#10	A	Q.C.D.	9-14-32 C.J. Clement	St. of H. B	239	11-2-32
#8	A	Q.C.D.	9-14-32 A.A. Davis	" B	238	11-21-32
#9	A	Q.C.D.	9-14-32 W.W. & Viola Tatiro	" B	237	11-21-32

BM. 88 Spike in root of 8" maple 19.5' et. Sta. 640+47 Elev. 2153.97
 BM. 89 Spike in root of 14" maple 45.5' et. Sta. 645+67 Elev. 2134.44


SERIES S- No. 105-11
 SHEET 16 OF 55

11/19
BARETT
1/1/24

11/19
BARETT
1/1/24

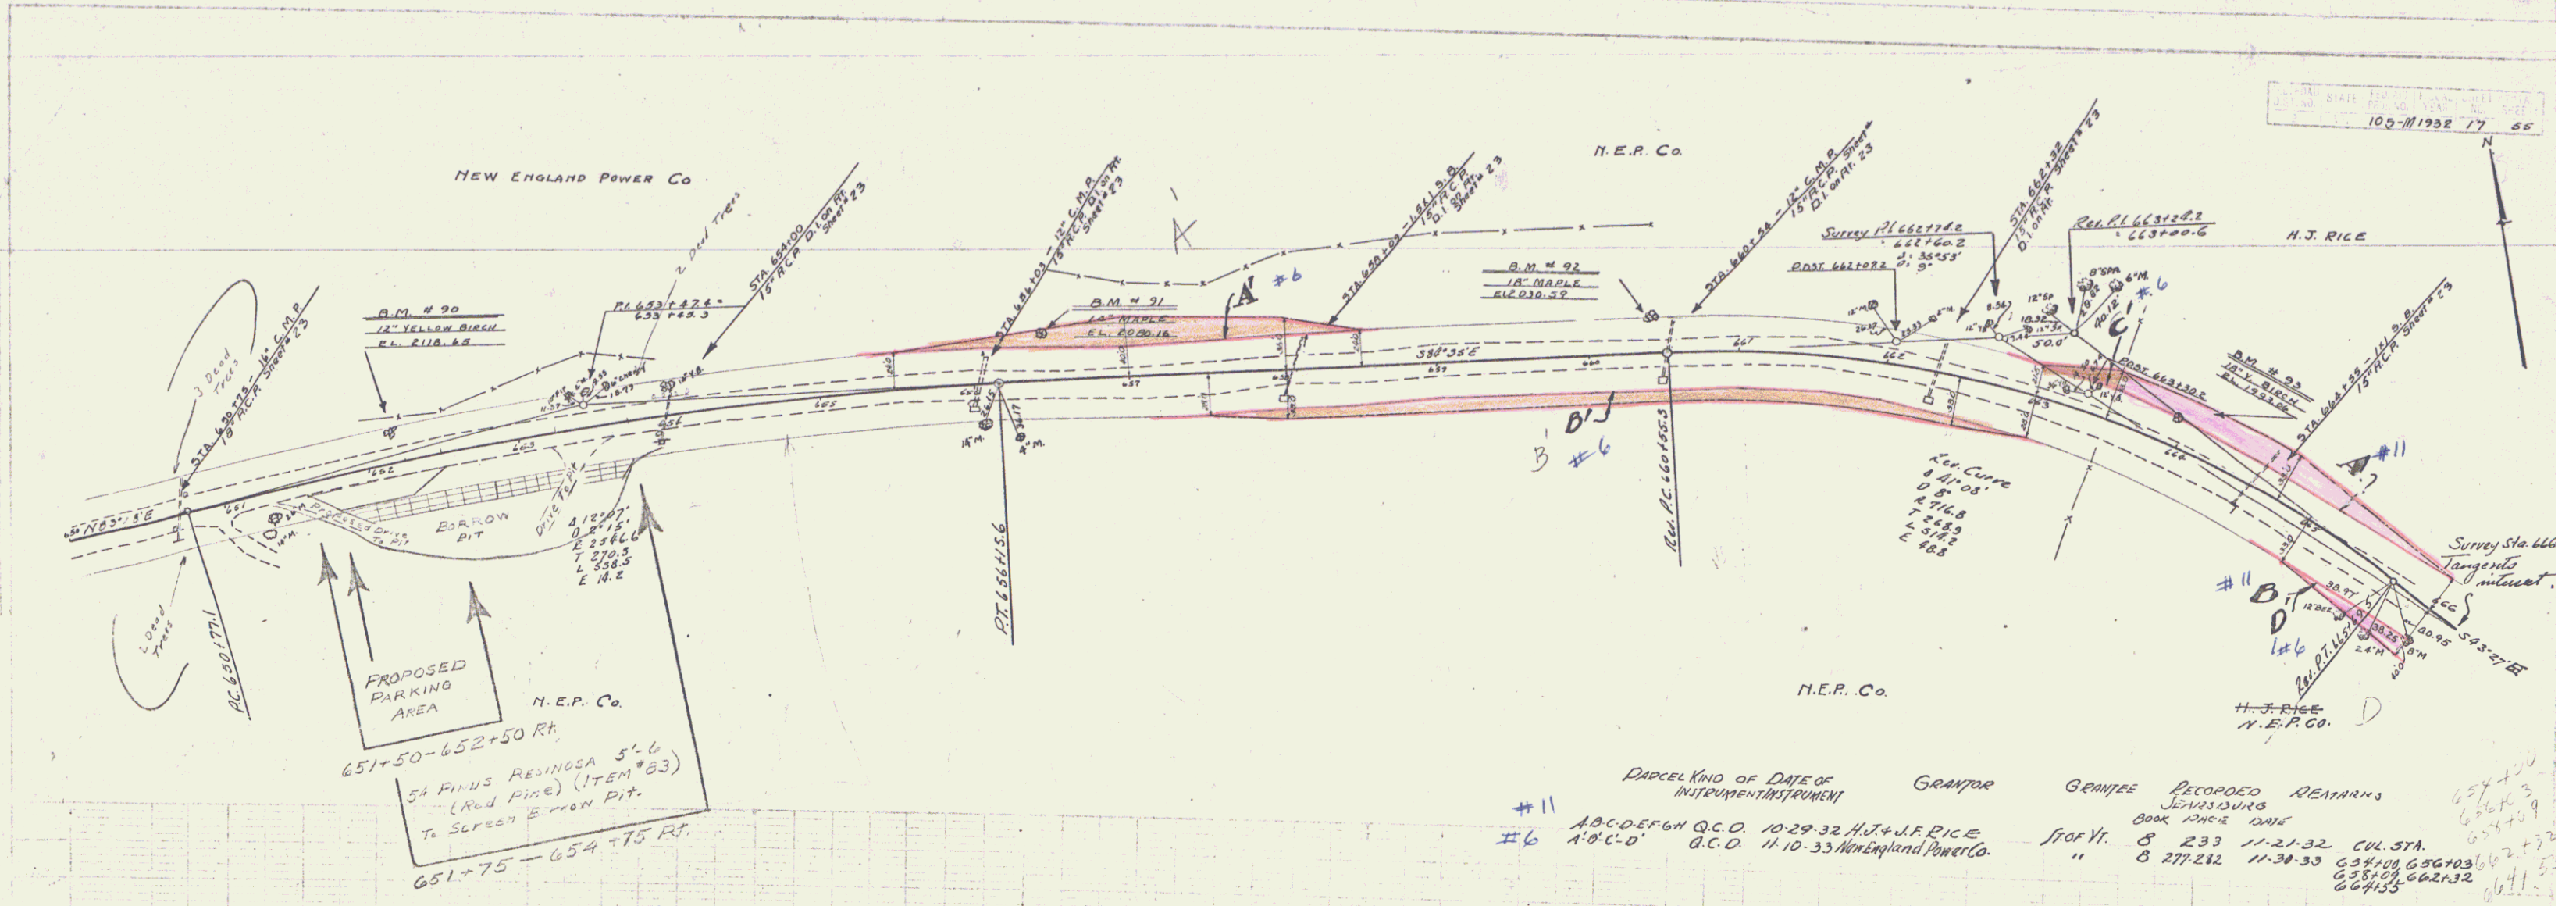

105-M 1932 18 35

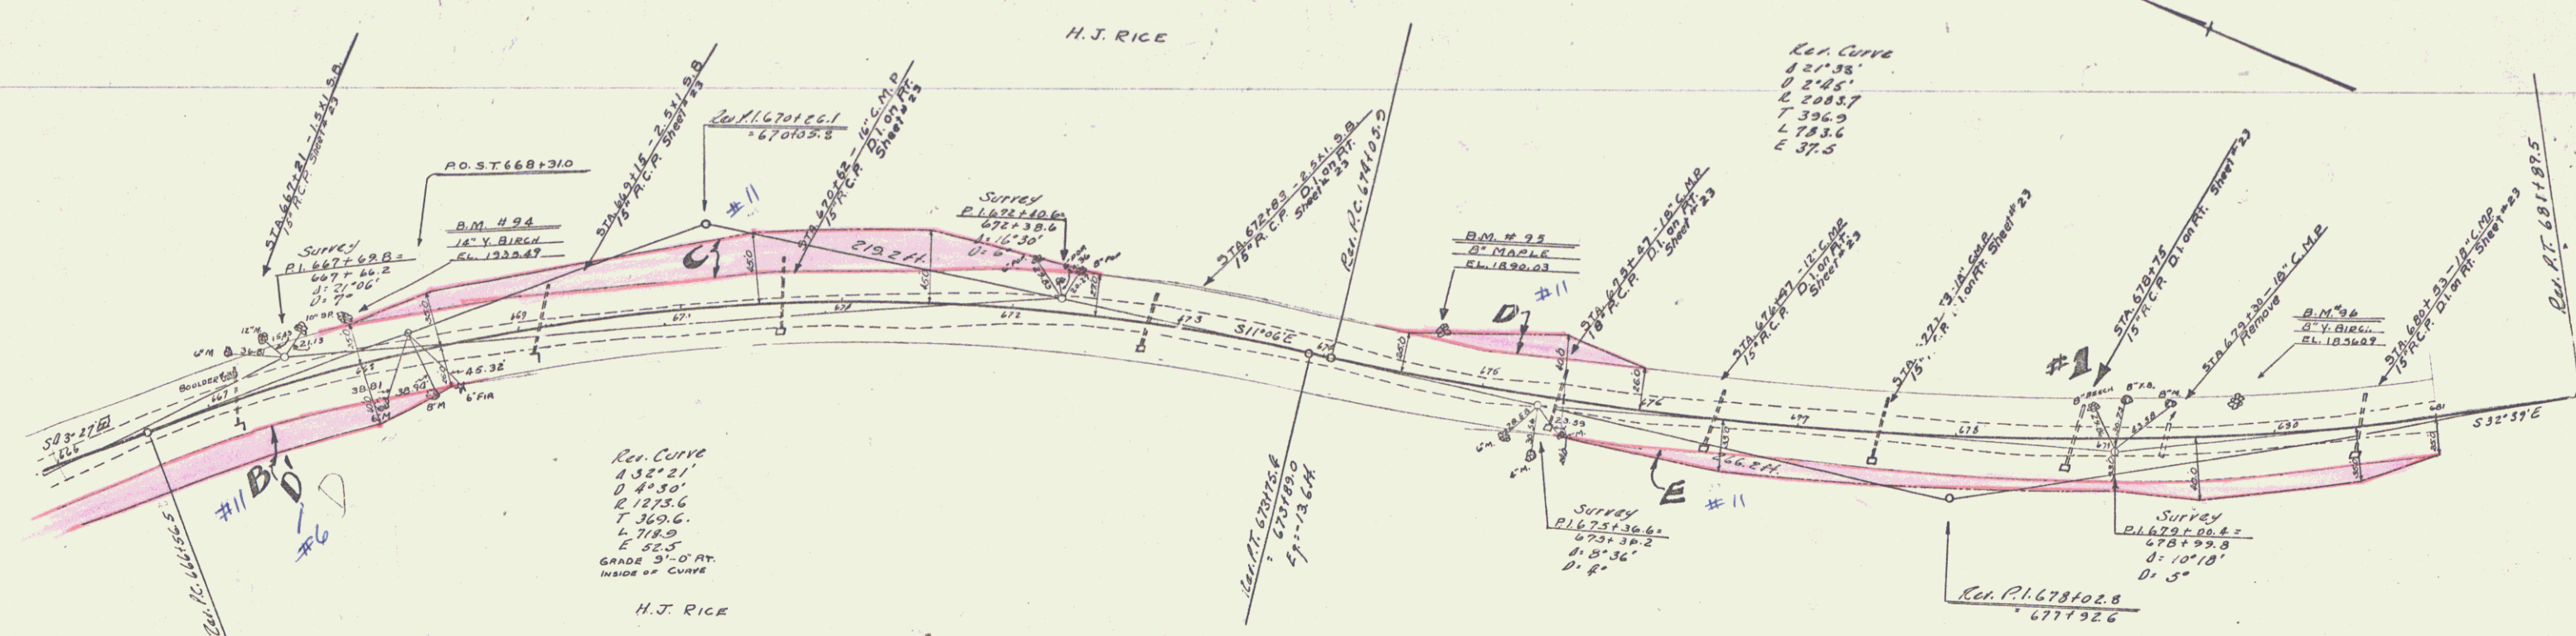


PARCEL	KIND OF INSTRUMENT	DATE OF INSTRUMENT	GRANTOR	GRANTEE	RECORDED	REMARKS
ABCD EFGH	G.C.D.	10-29-32	H.J. RICE	JEANESBURG	BOOK PAGE DATE	CUL. STA. #1
D	G.C.D.	11-10-33	New England Power Co.	JEANESBURG	233 11-21-32	678+75
					3 277+22 11 30-33	

BM 94 Spike in Root 14" Bir. 27' Lt. Sta. 668109 Elev. 1935.49
 B.M. 95 Spike in Root 5" Map. 32' Lt. Sta. 674167 Elev. 1890.03
 B.M. 96 Spike in Root 8" Bir. 22' Lt. Sta. 679176 Elev. 1856.09

SERIES S- 110.105-M
 SHEET 18 OF 55

POOR ORIGINAL COPY


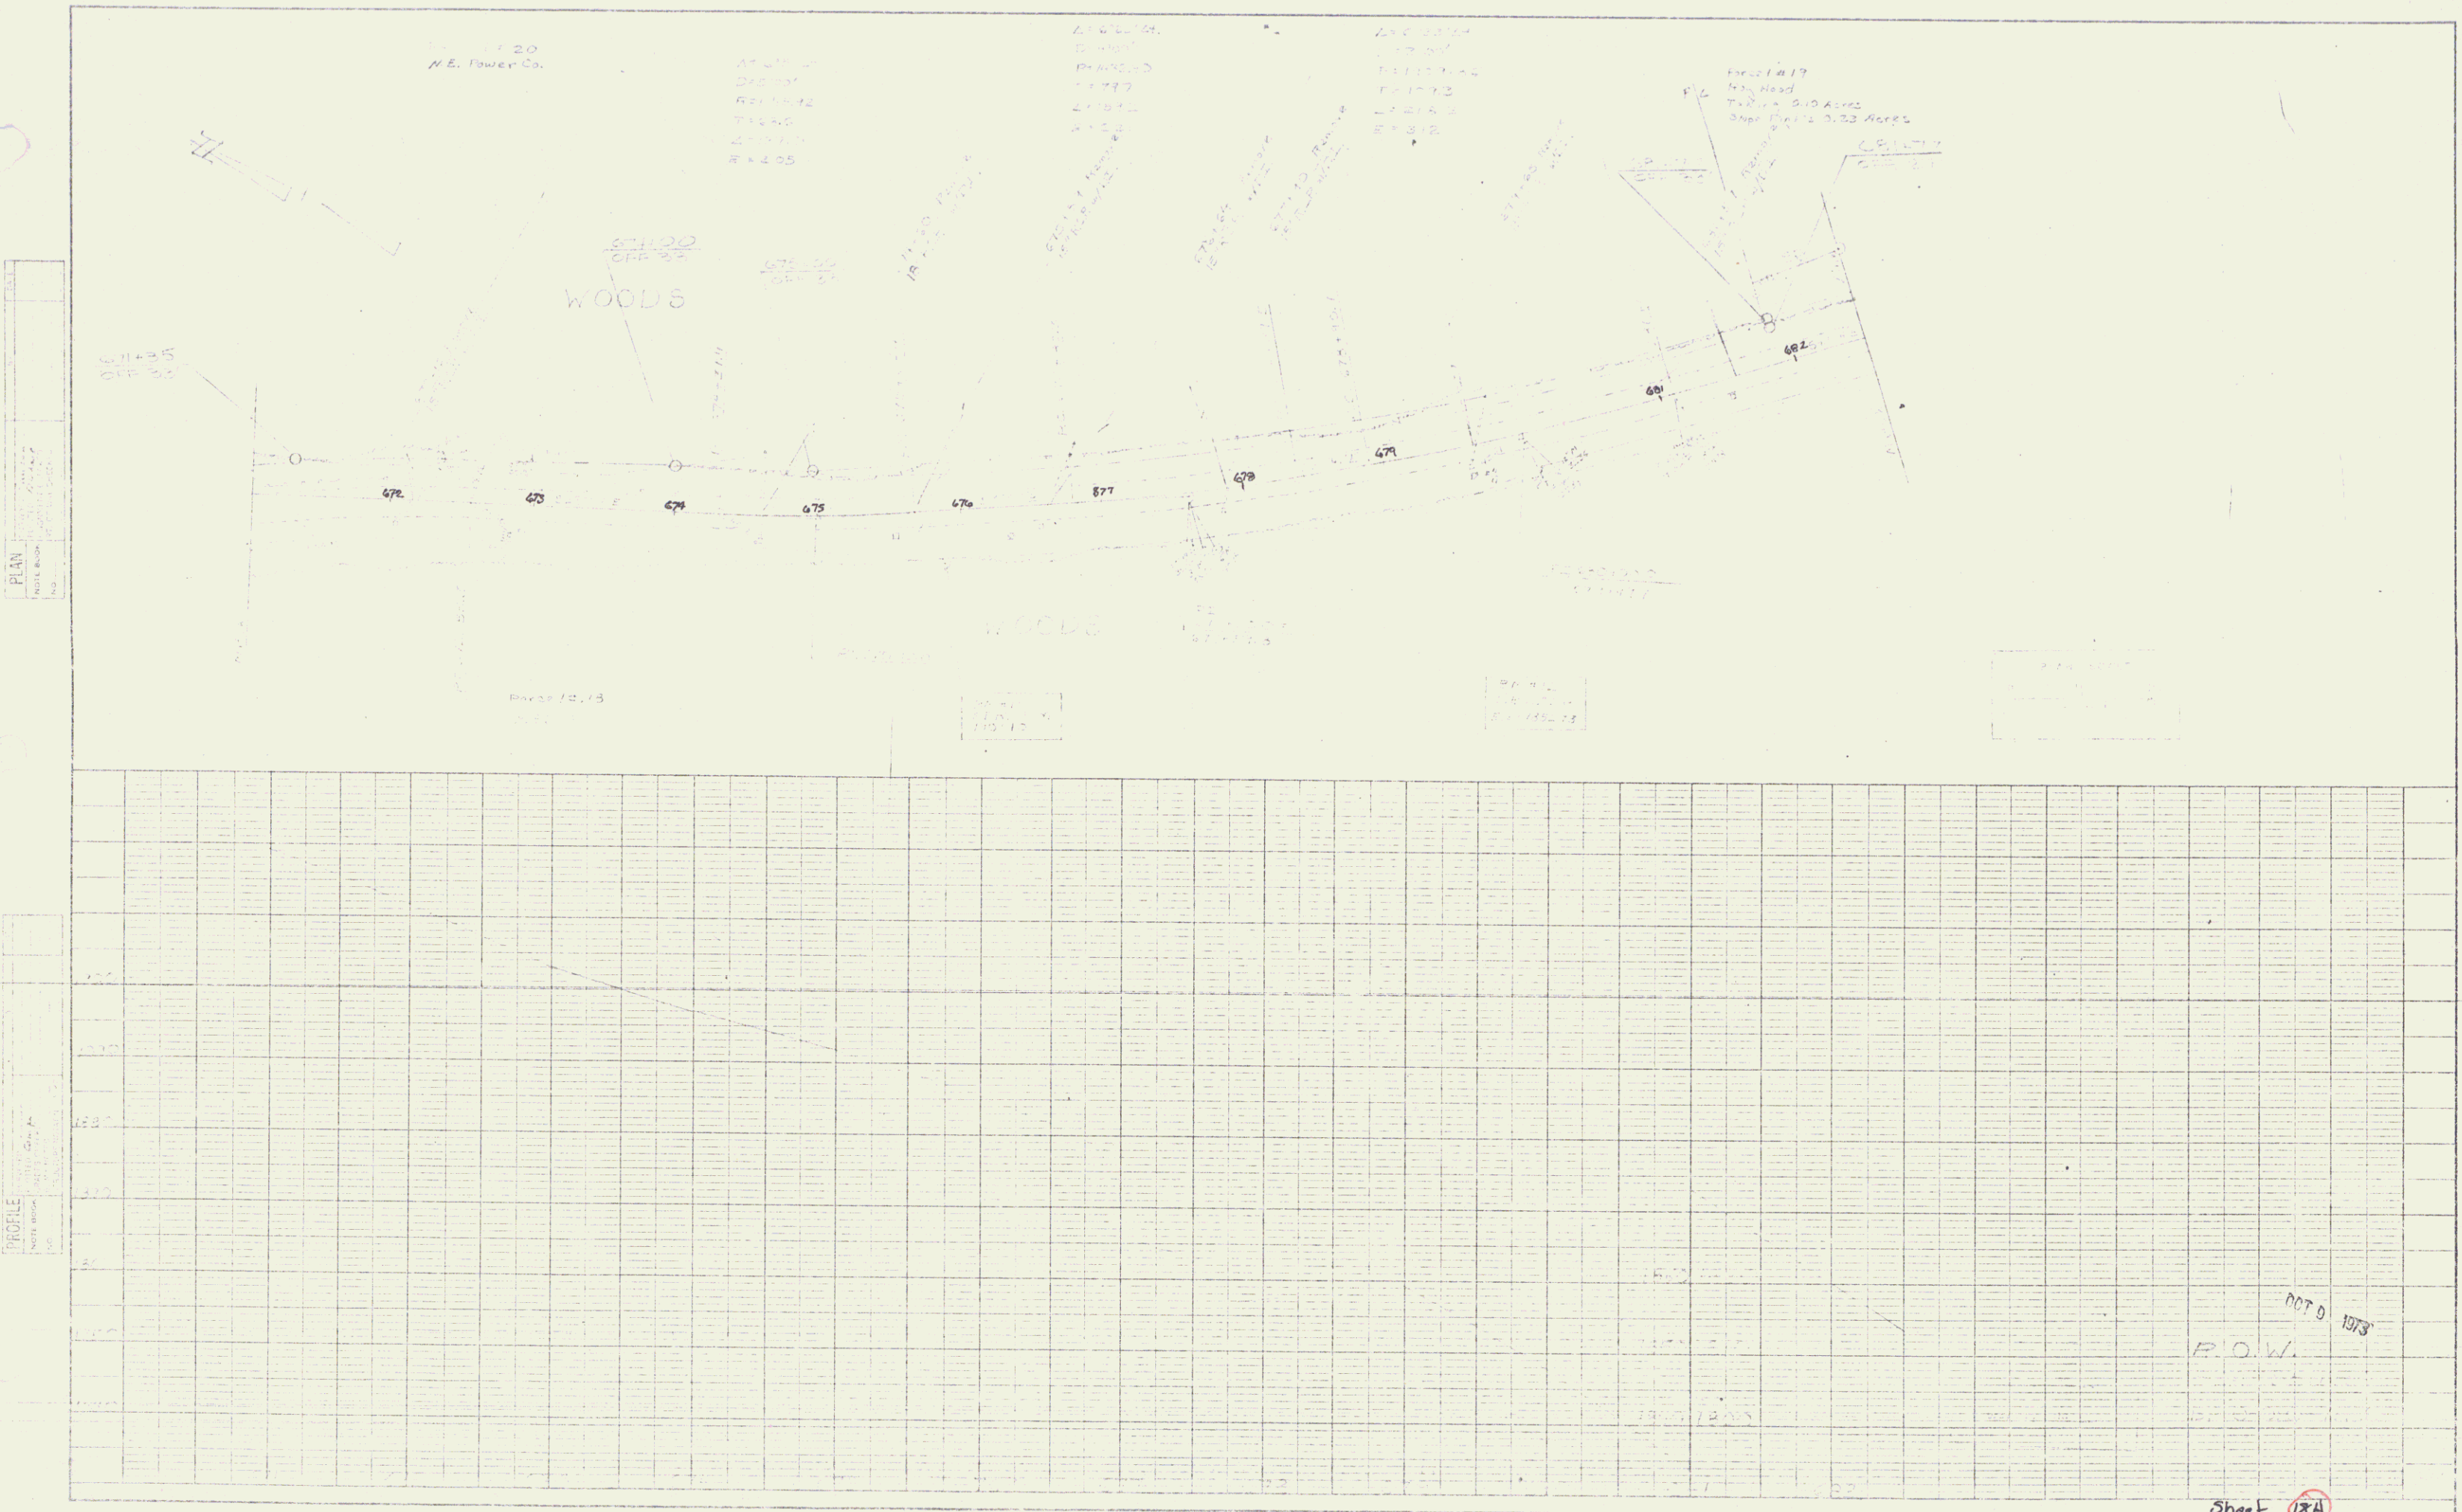


NOT D. 1973
P.O.W.
Sheet 18A


POOR ORIGINAL COPY



Sheet 188

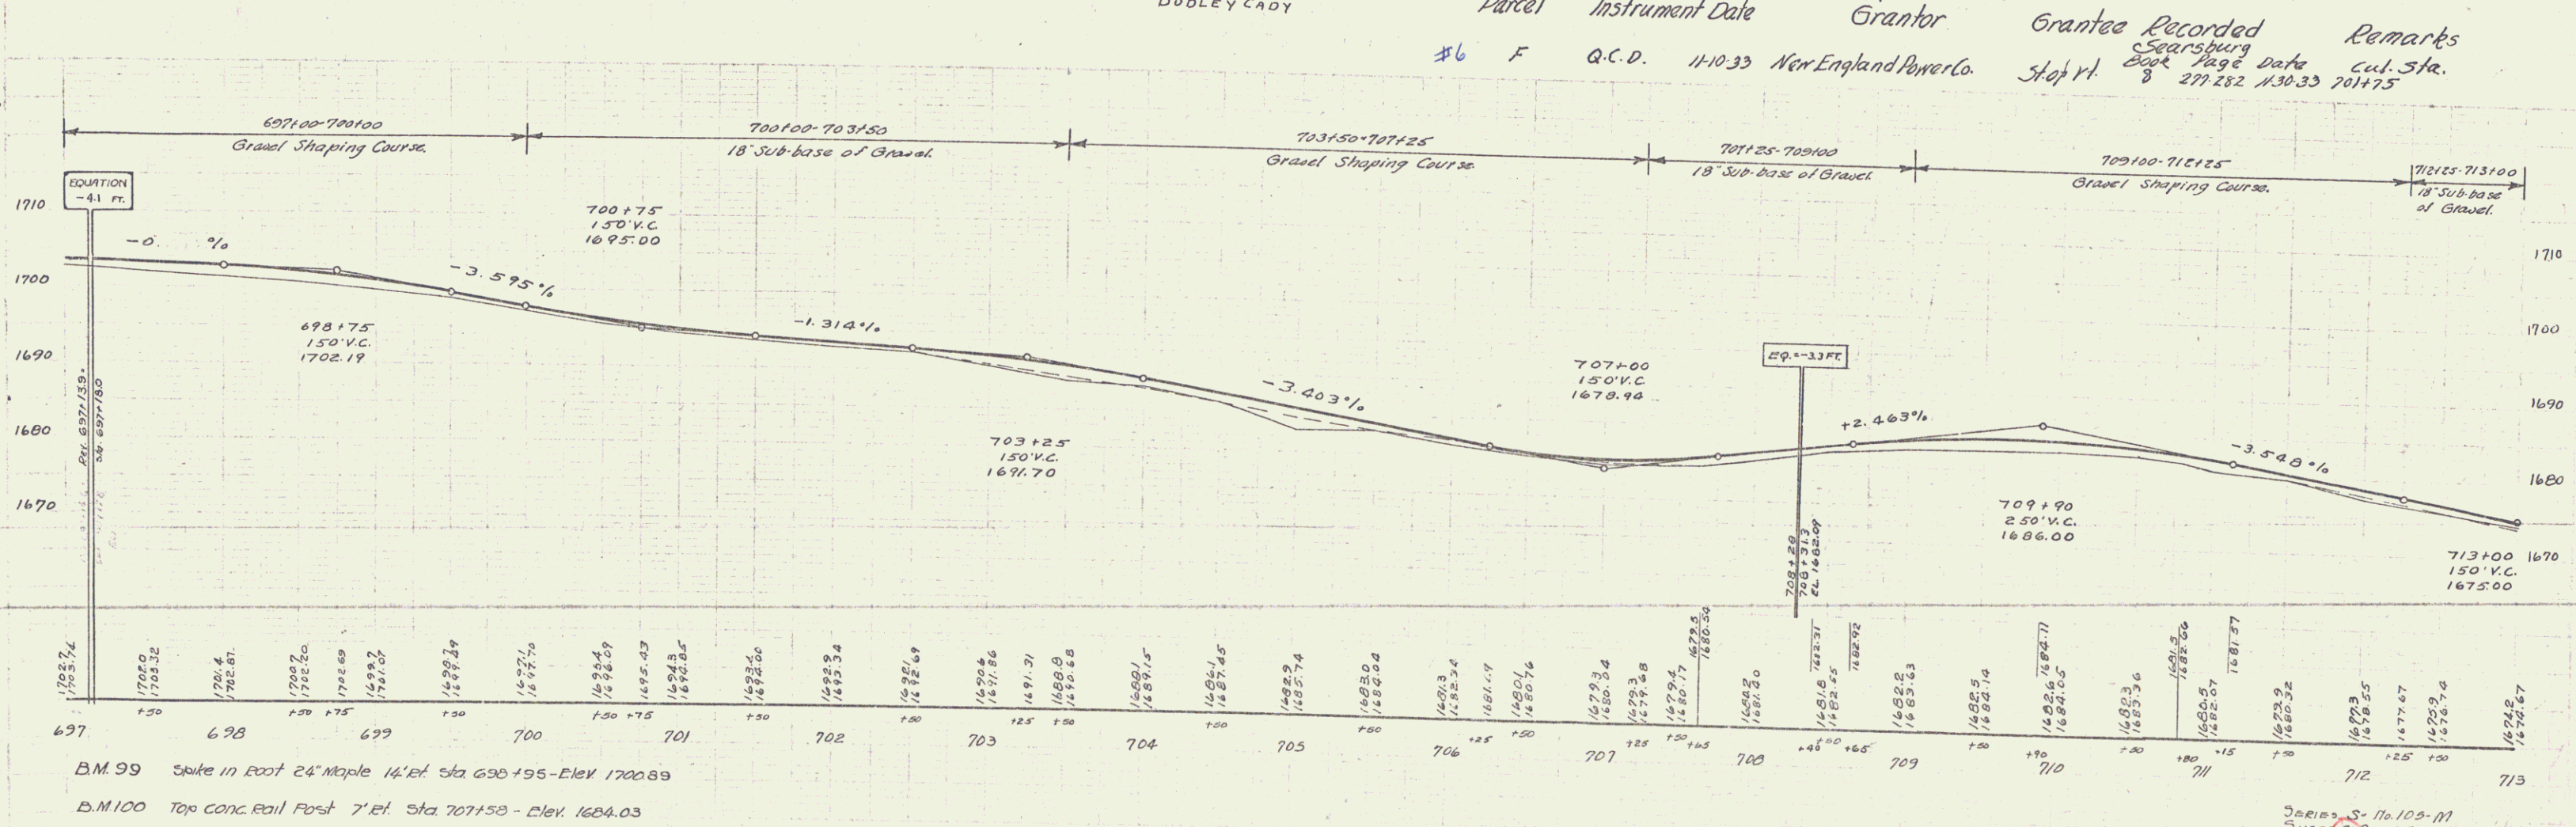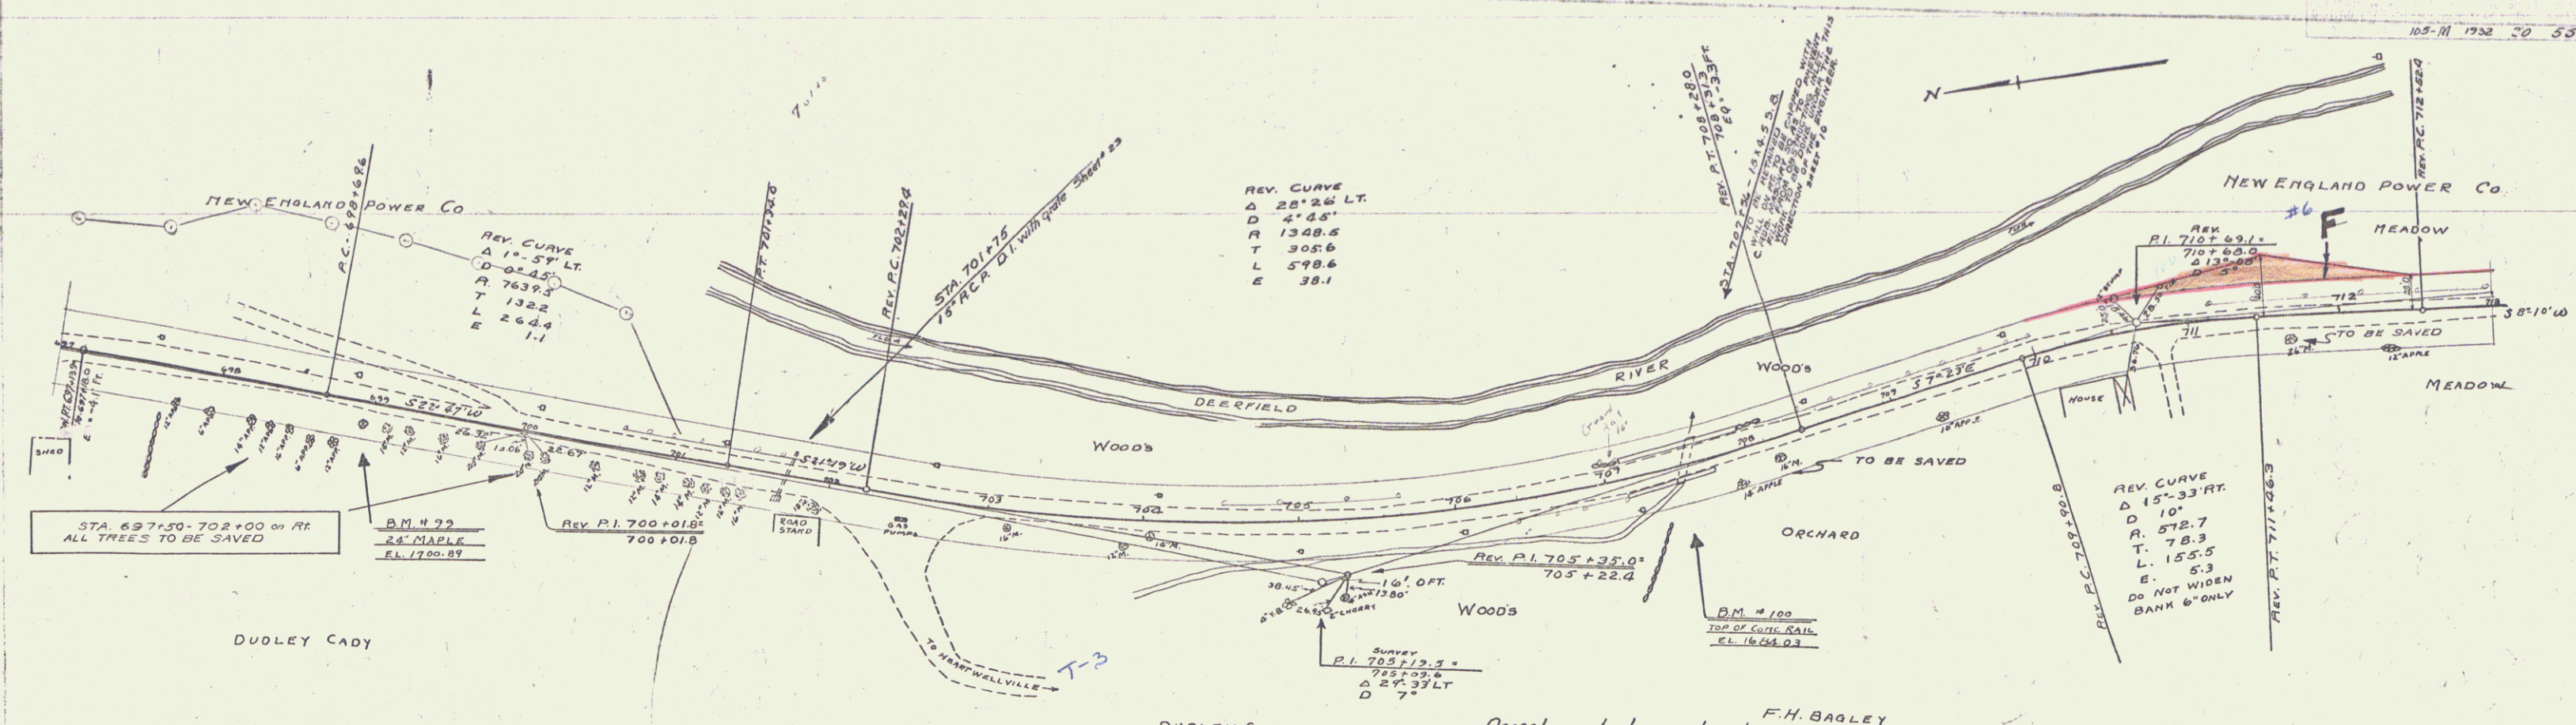

Parcel #6 F
 Instrument Date 11-10-33
 Grantor New England Power Co.
 Grantee Recorded
 Remarks 277.282 11-30-33 701+75

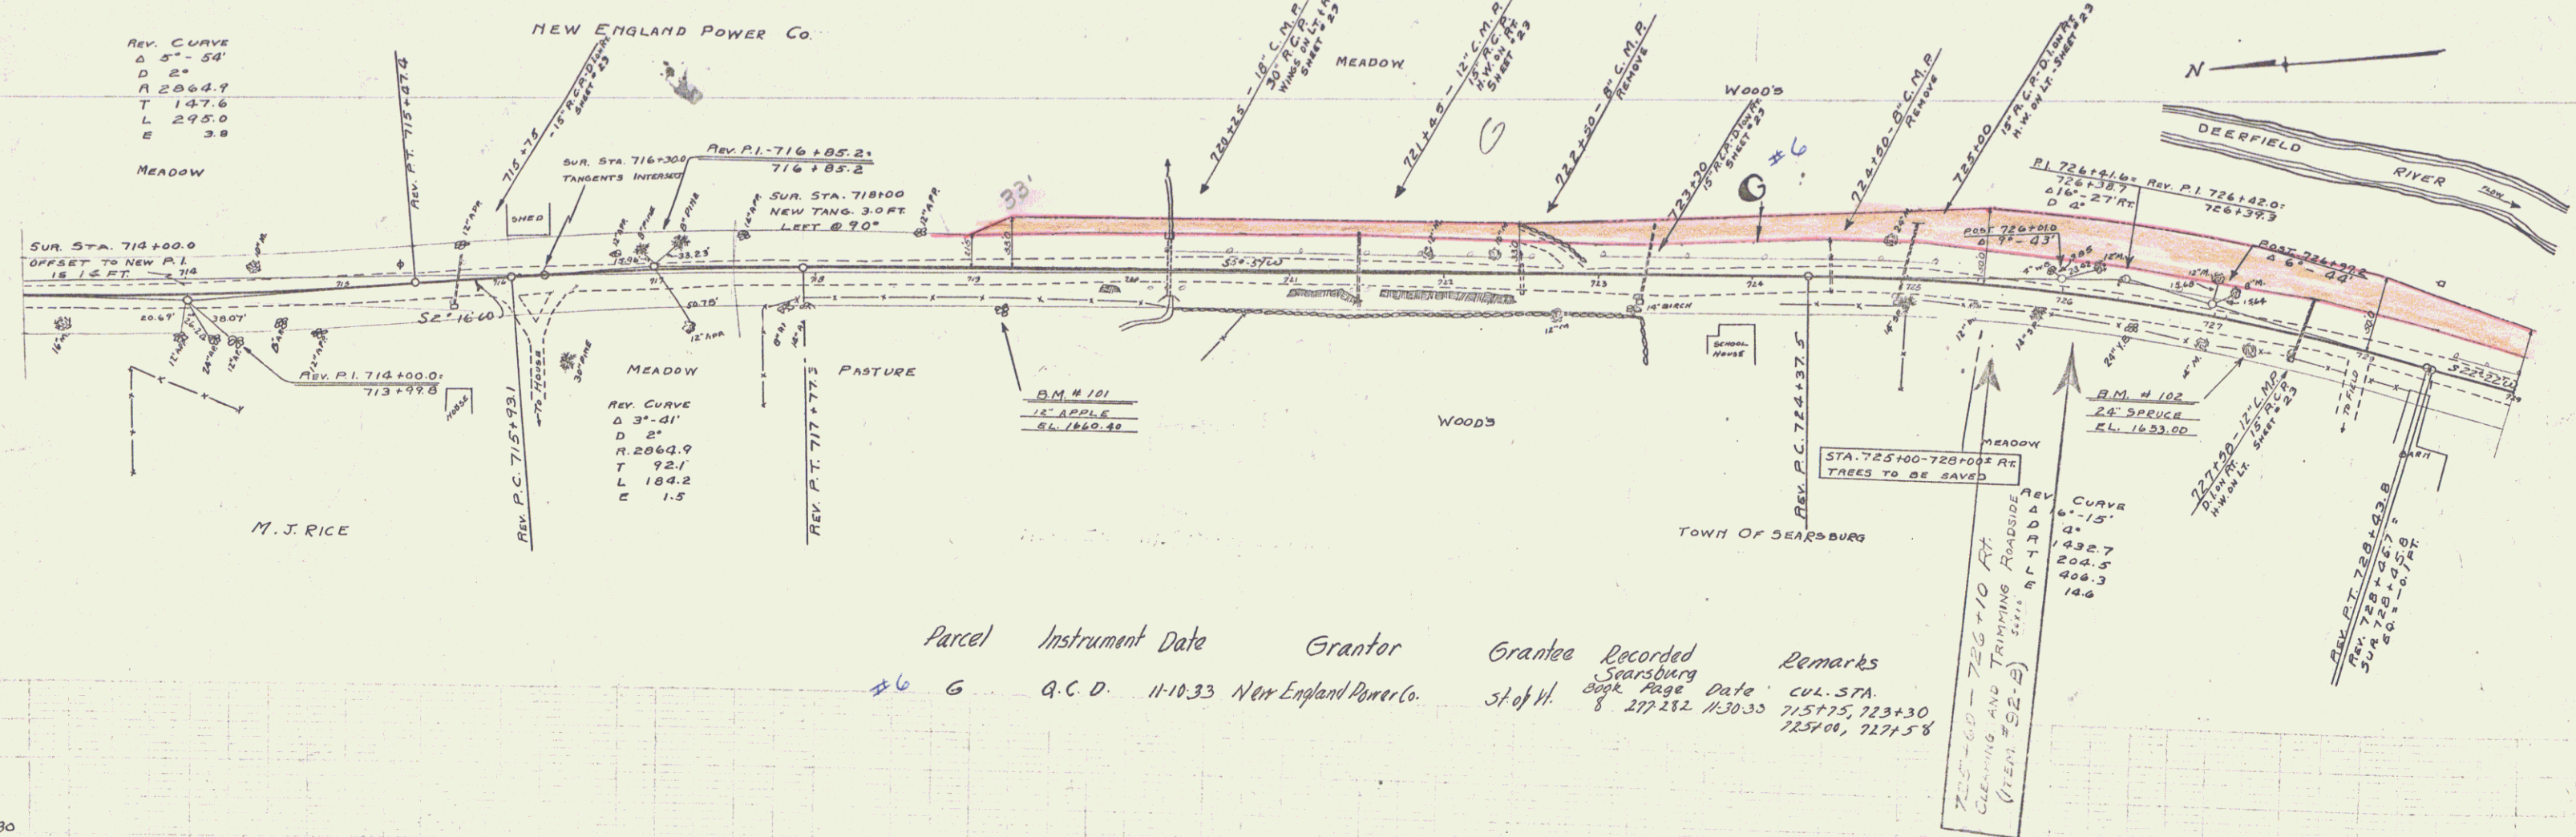

Parcel	Instrument Date	Grantor	Grantee	Recorded	Remarks
#6 G	Q.C.D.	11-10-33	New England Power Co.	St of W.	8 277282 11-30-33

