



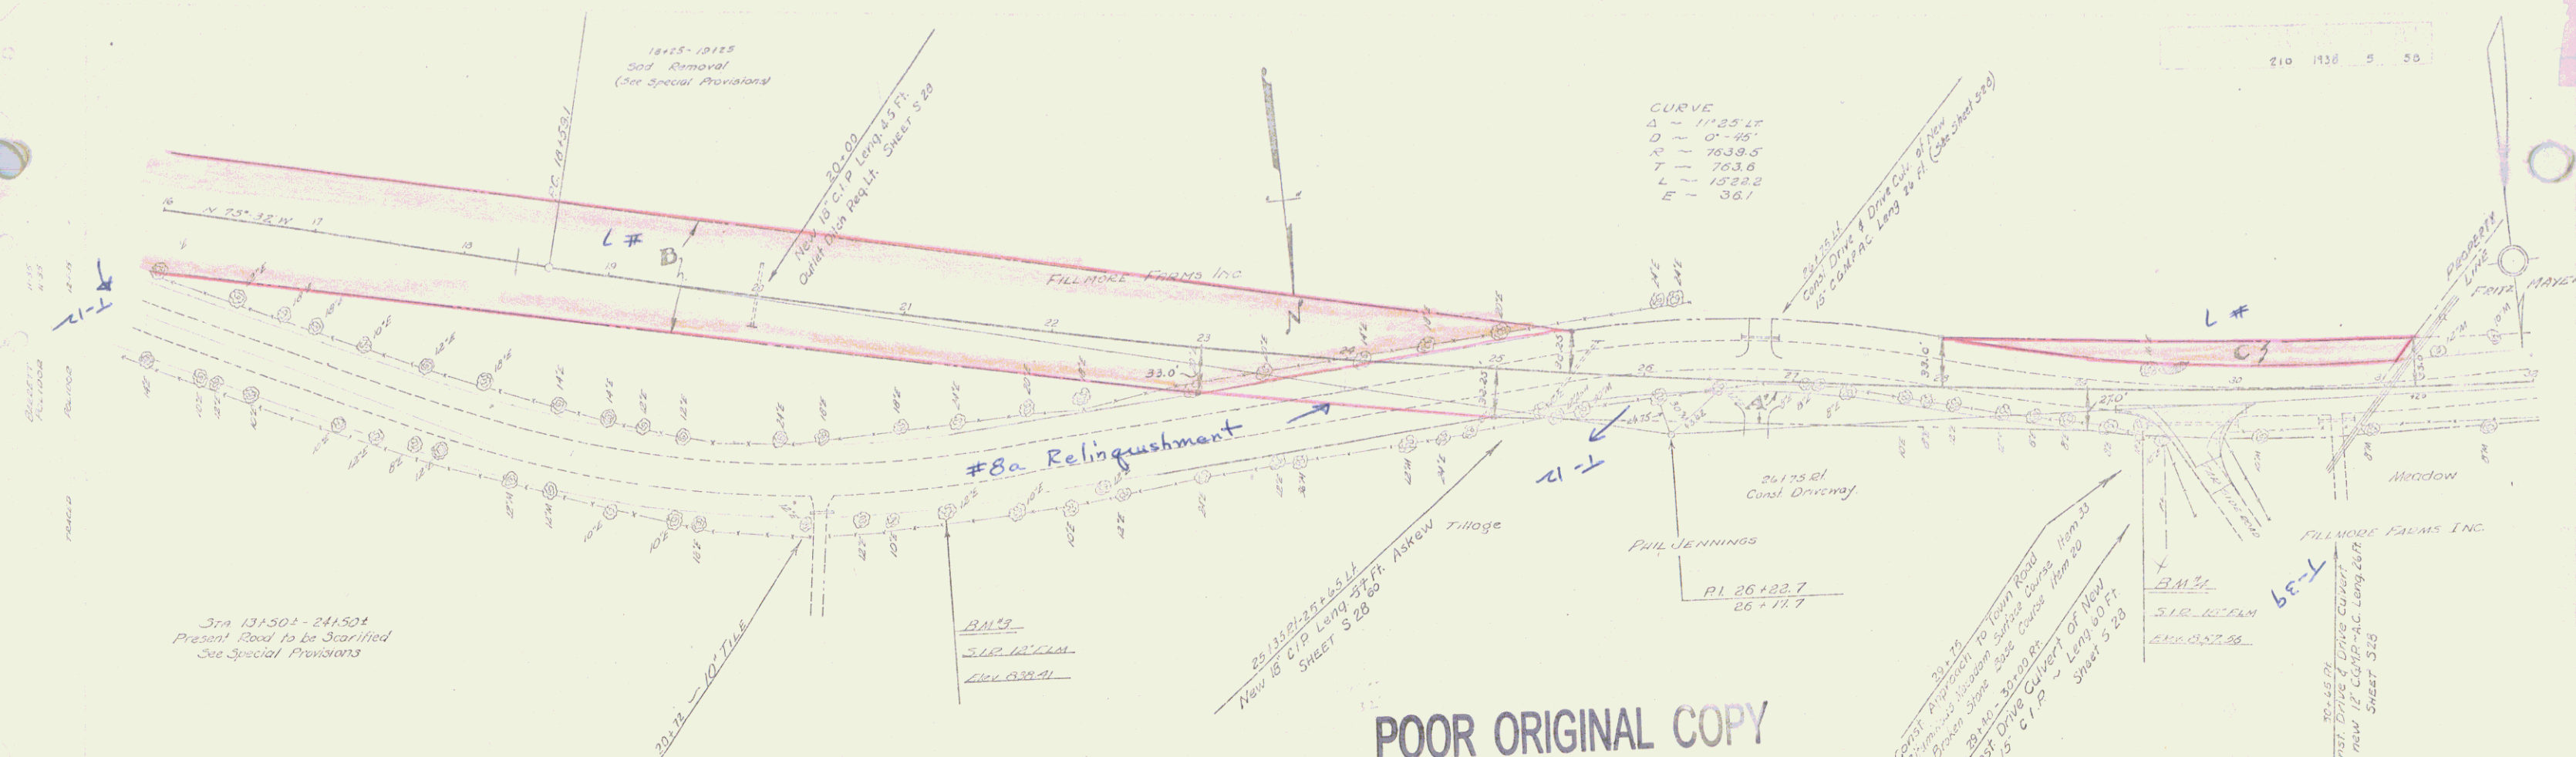

POOR ORIGINAL COPY

PARCEL	INSTRUMENT	DATE	GRANTOR	GRANTEE	RECORDED	REMARKS
					BOOK PAGE DATE	CUL. STA.
ADLOFSKI	G.C.D.	6-28-37	FILLMORE FARMS INC.	STOFFE	468 6-29-37	7470, 13+23, 20+00, 25+50, 45+10, 50+50, 53+37, 61+00, 71+03, 77+10
A'	G.C.D.	6-24-37	PHILLIP D. JENNINGS	"	1 465 6-24-37	

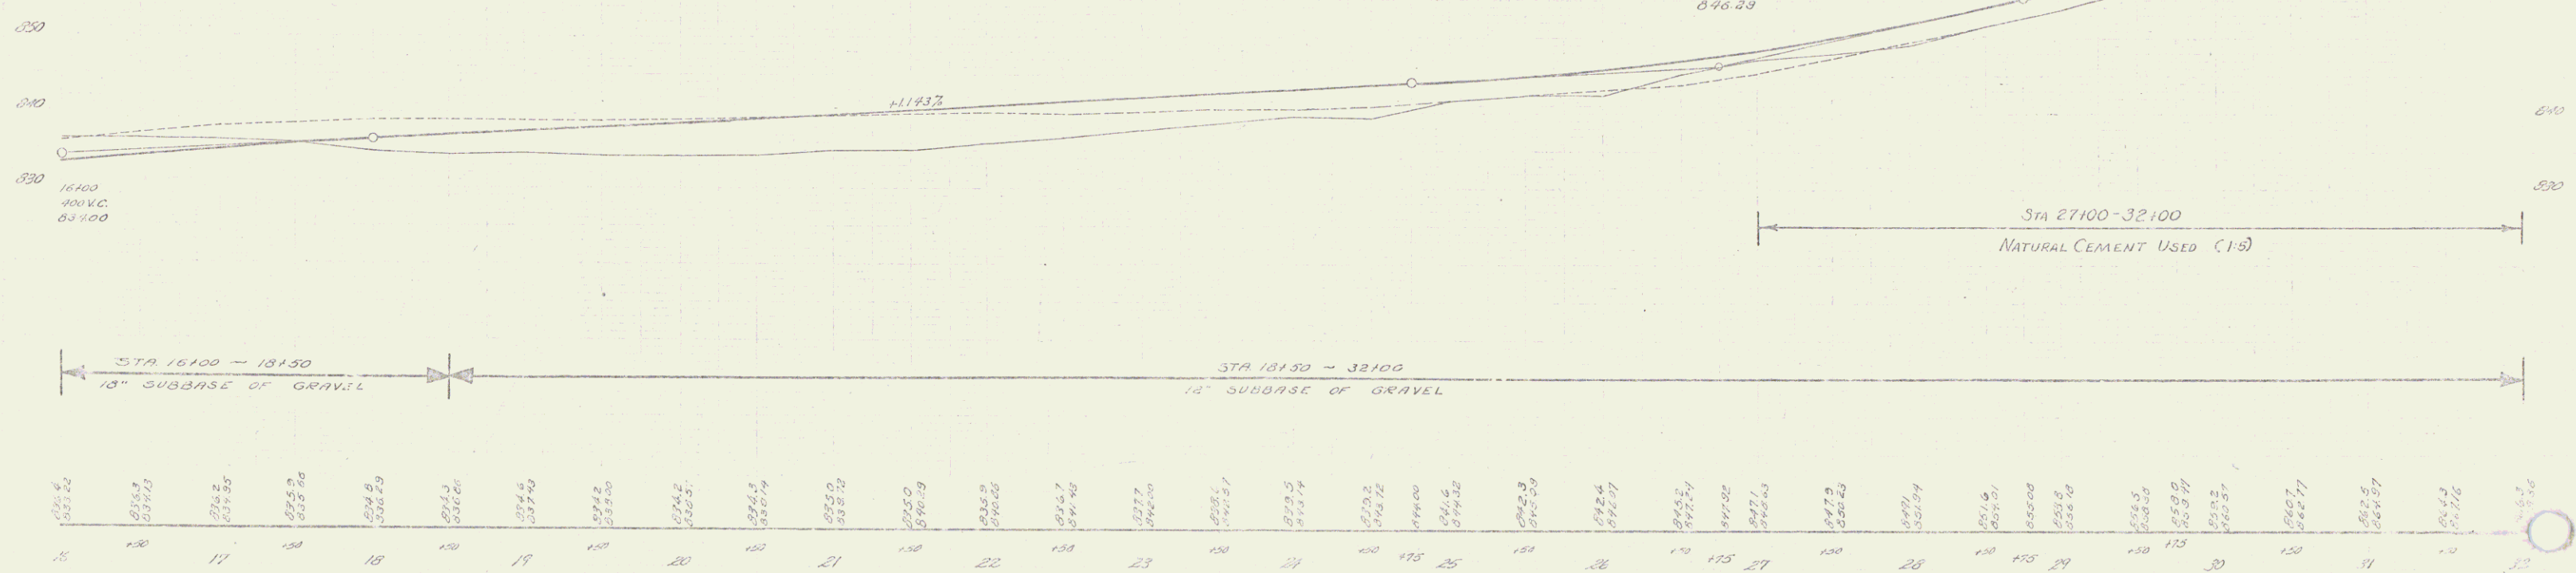

BM 3 SPIKE IN ROOT OF ELM 135' BY STA 2195 Elev 839.41
 BM 4 SPIKE IN ROOT OF ELM 20' BY STA 2490 Elev 857.38

SERIES CAP NO 210
 SHEET 5 OF 30