
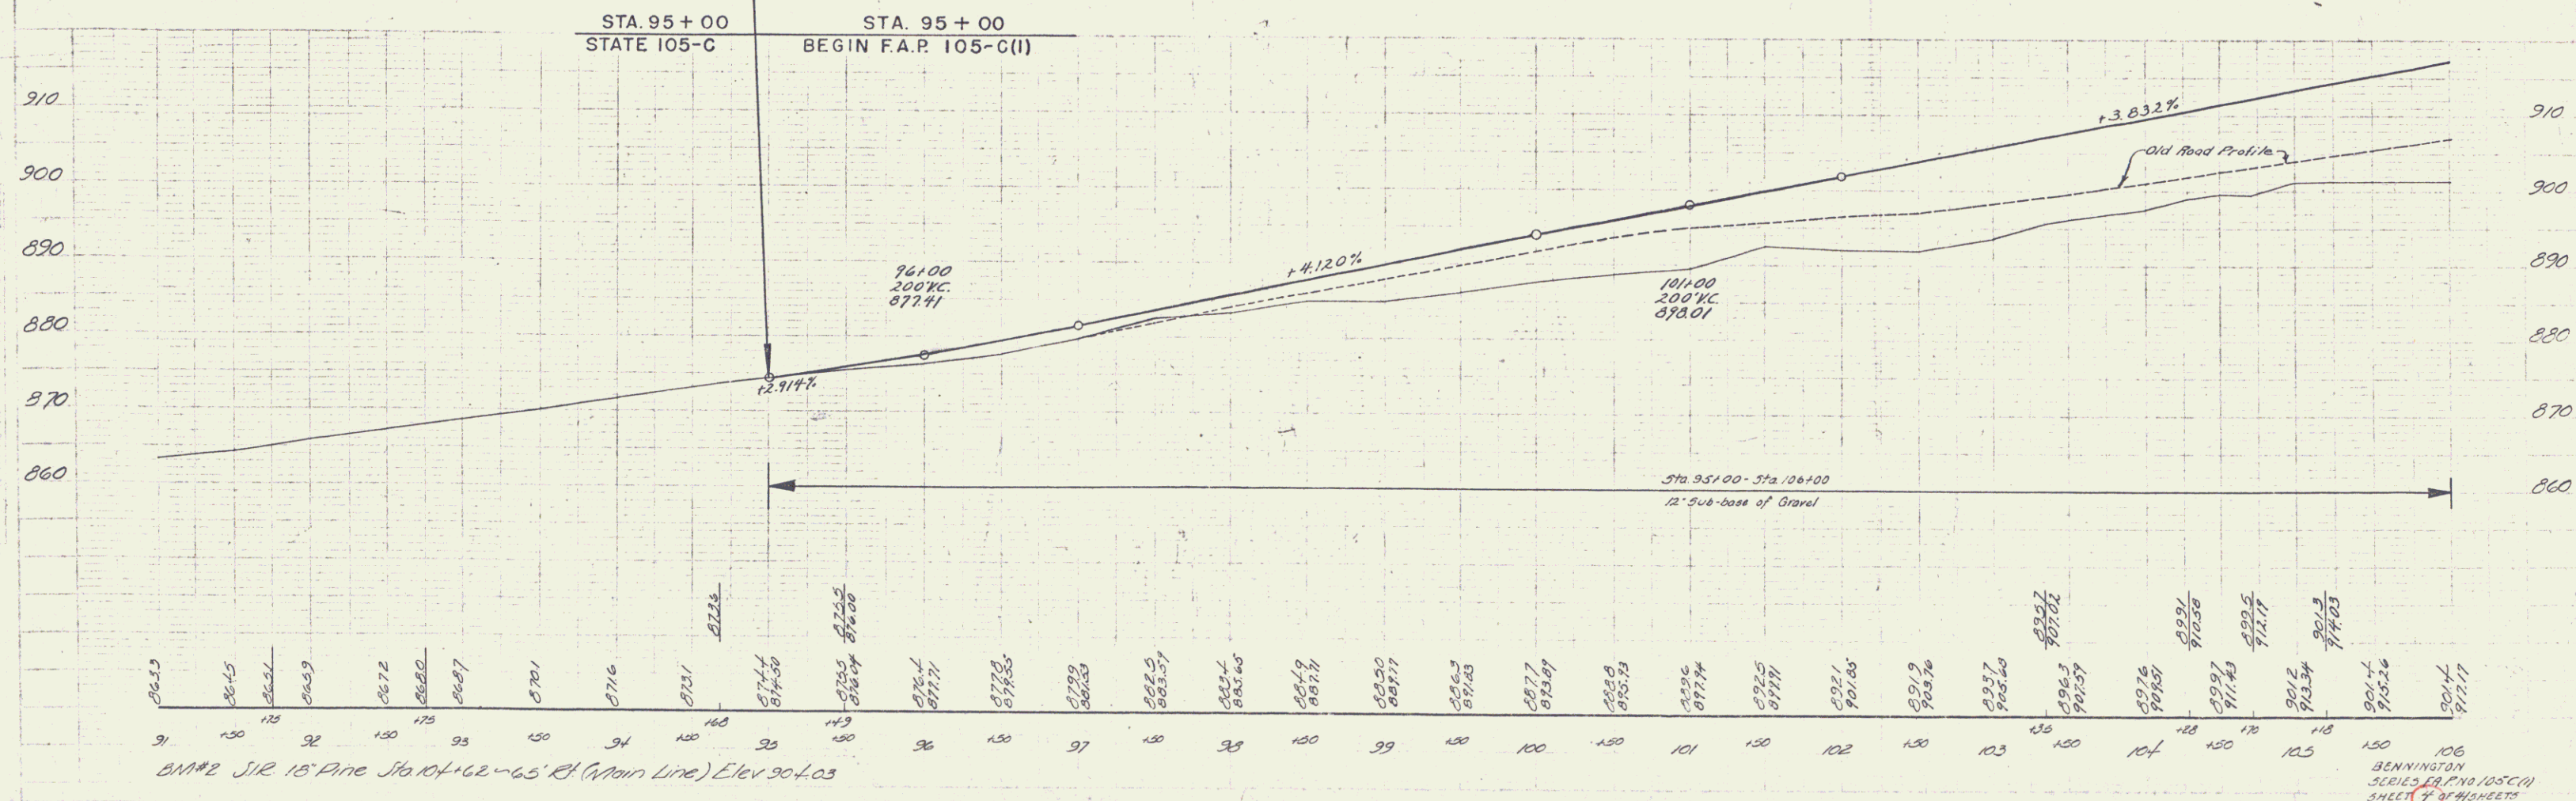


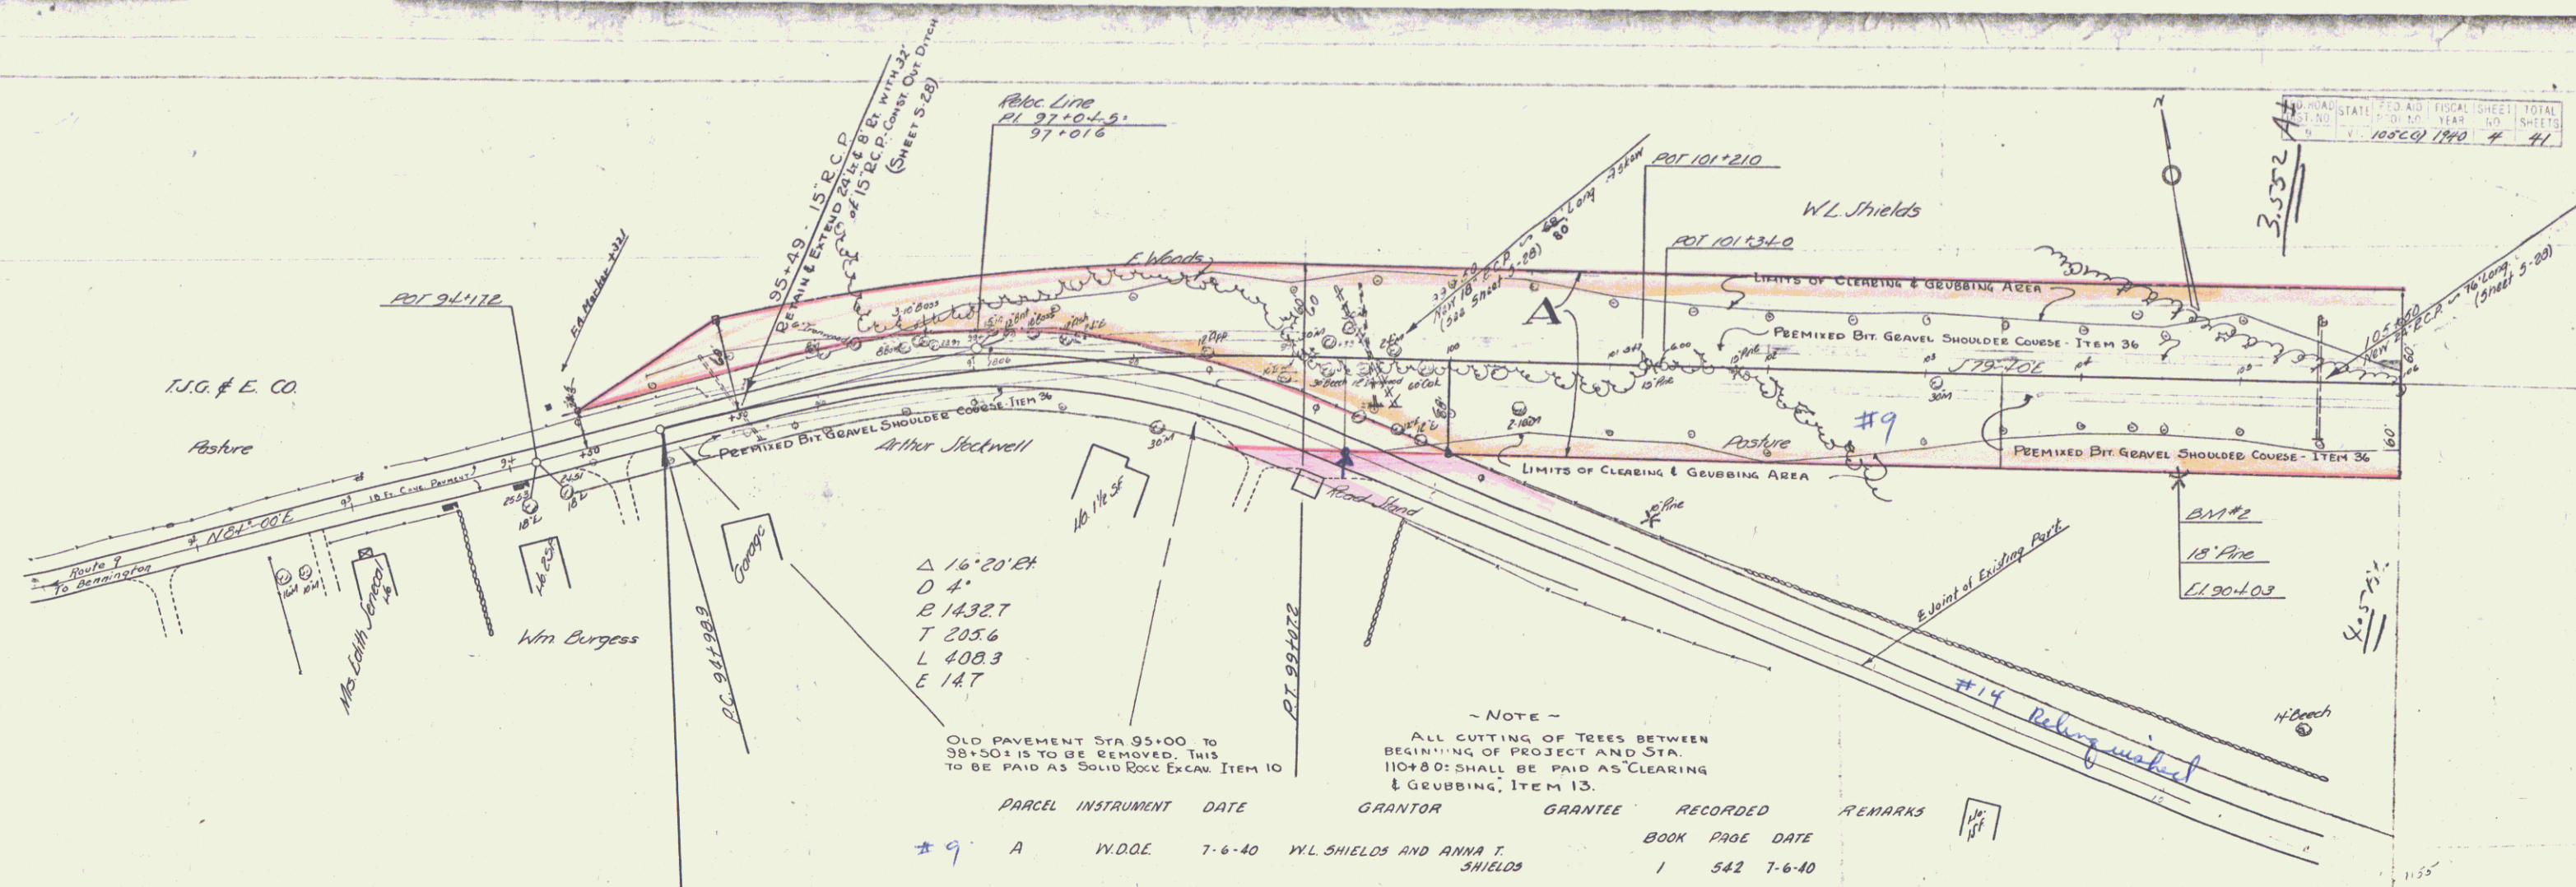

Original Lane
2 Lanes
1 Lane

2 Lanes
1 Lane

BM#2 SJR 18" Pine 16' x 14' 62'-65' E (Main Line) Elev 904.03

BENNINGTON
SERIES 18710/105C(II)
SHEET 4 OF 4