
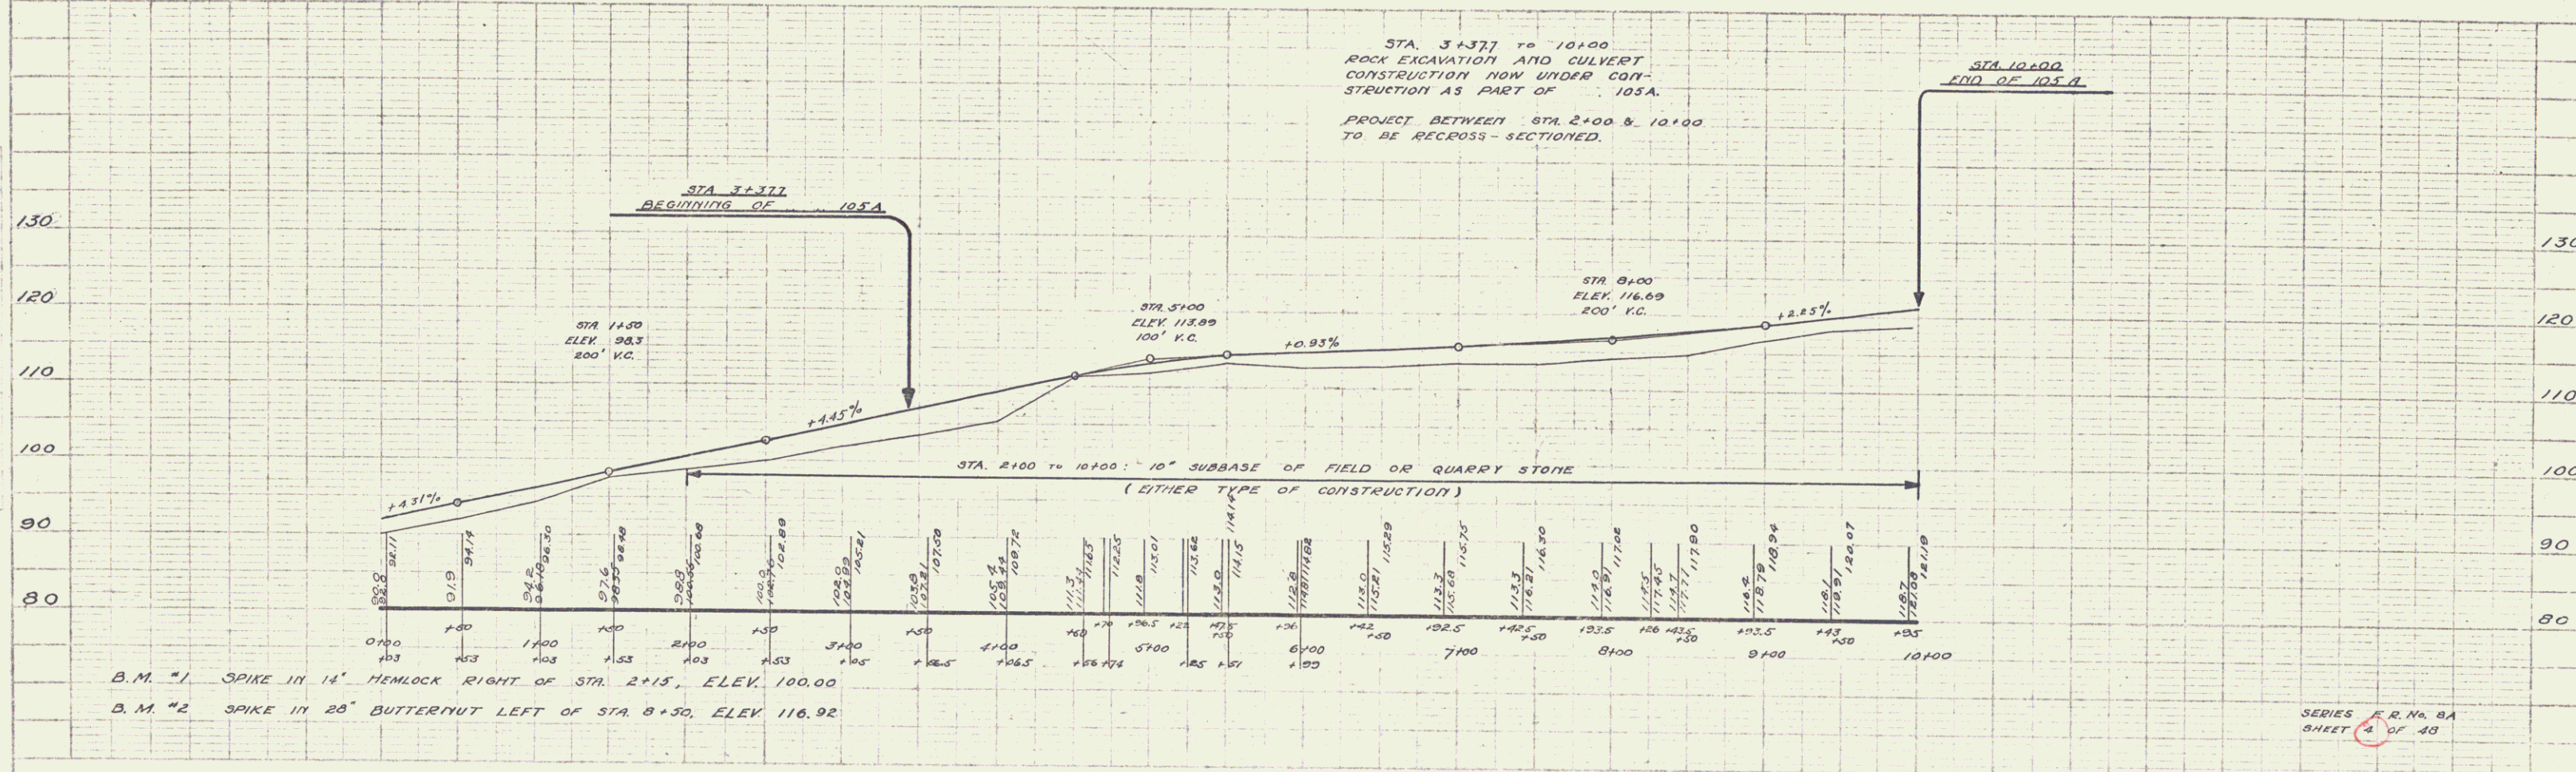


CABLE GUARD RAIL REQUIRED
 STA 1+53 TO 4+25 LENGTH 272 FT
 STA 4+25 TO 10+00 LENGTH 575 FT
 TOTAL FOR SHEET LENGTH 847 FT

WOOD GUARD RAIL REQUIRED
 STA 6+50 TO 6+58 LENGTH 8 FT
 STA 7+38 TO 7+66 LENGTH 28 FT
 TOTAL FOR SHEET LENGTH 36 FT

FRBA 1928 4 48

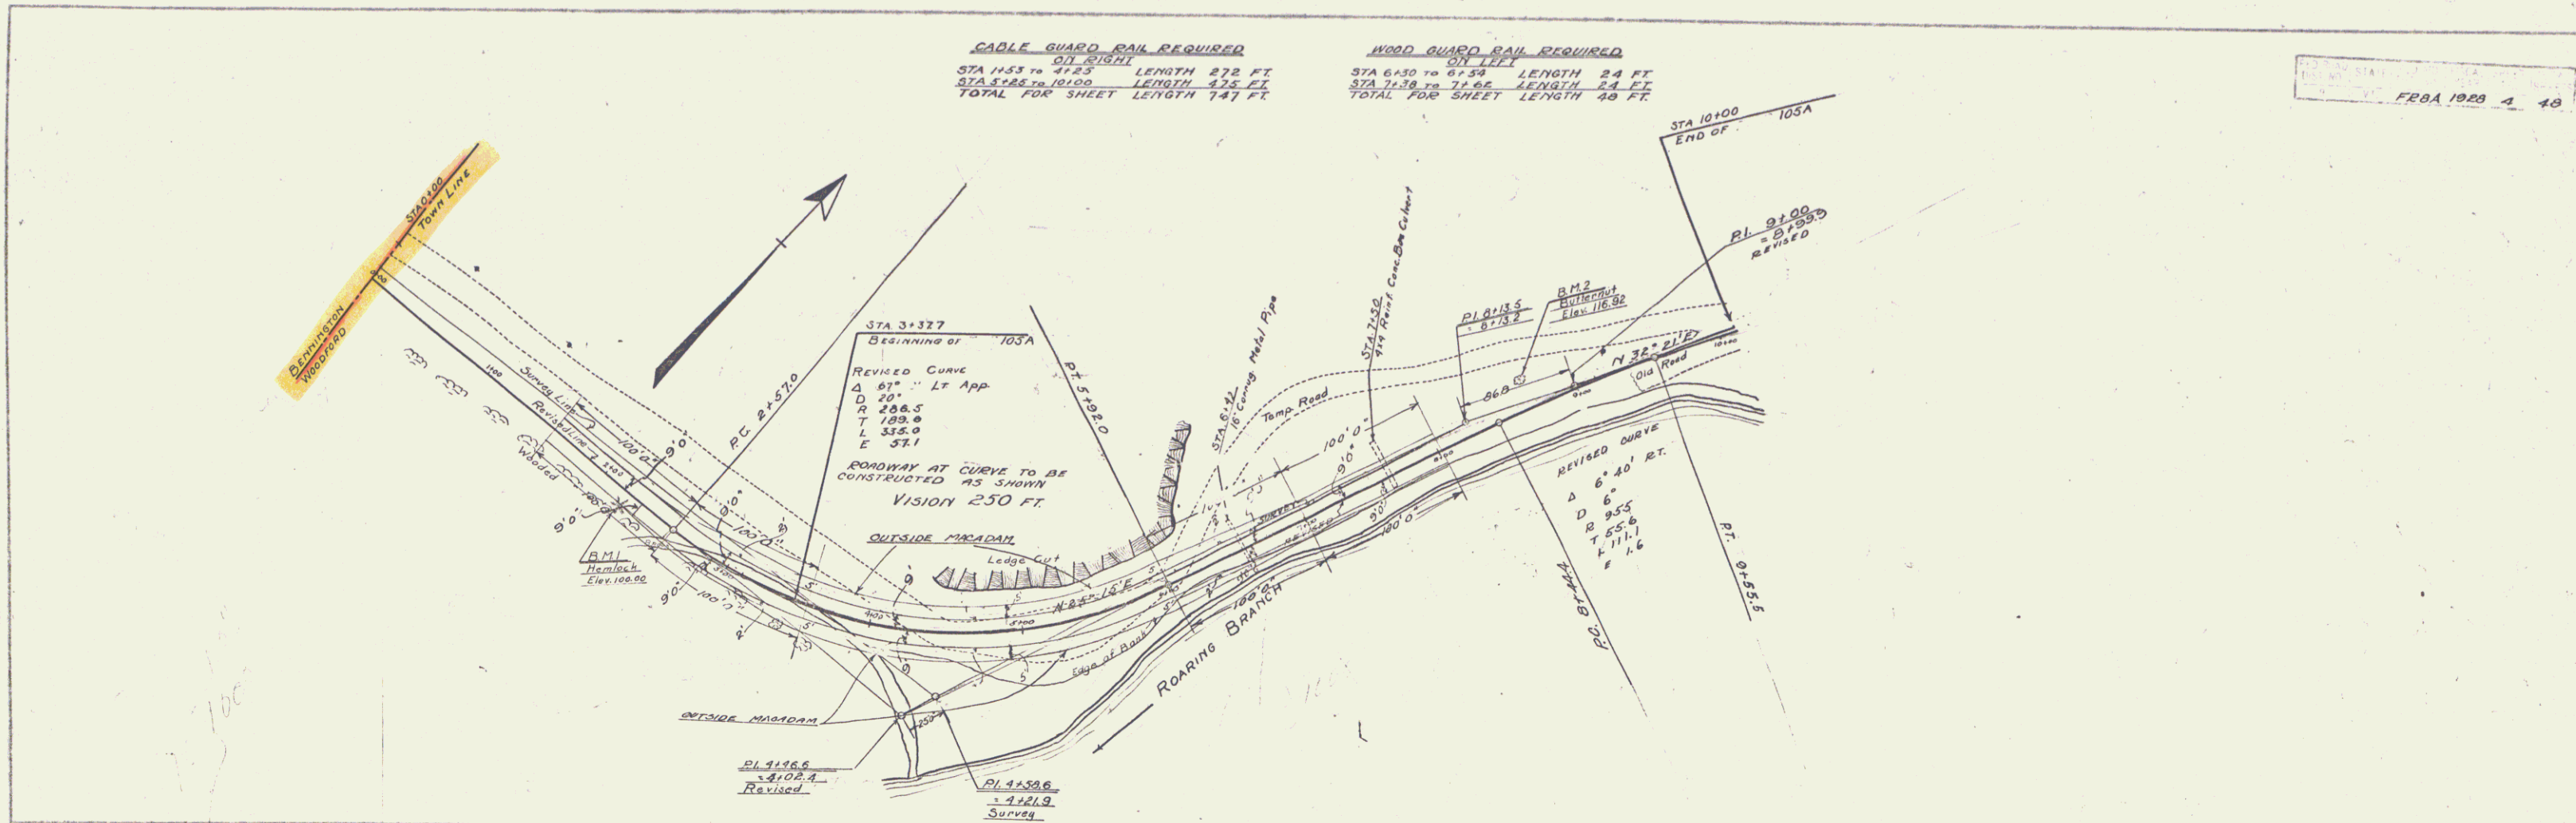

SERIES F.R. No. 8A
 SHEET 4 OF 48