

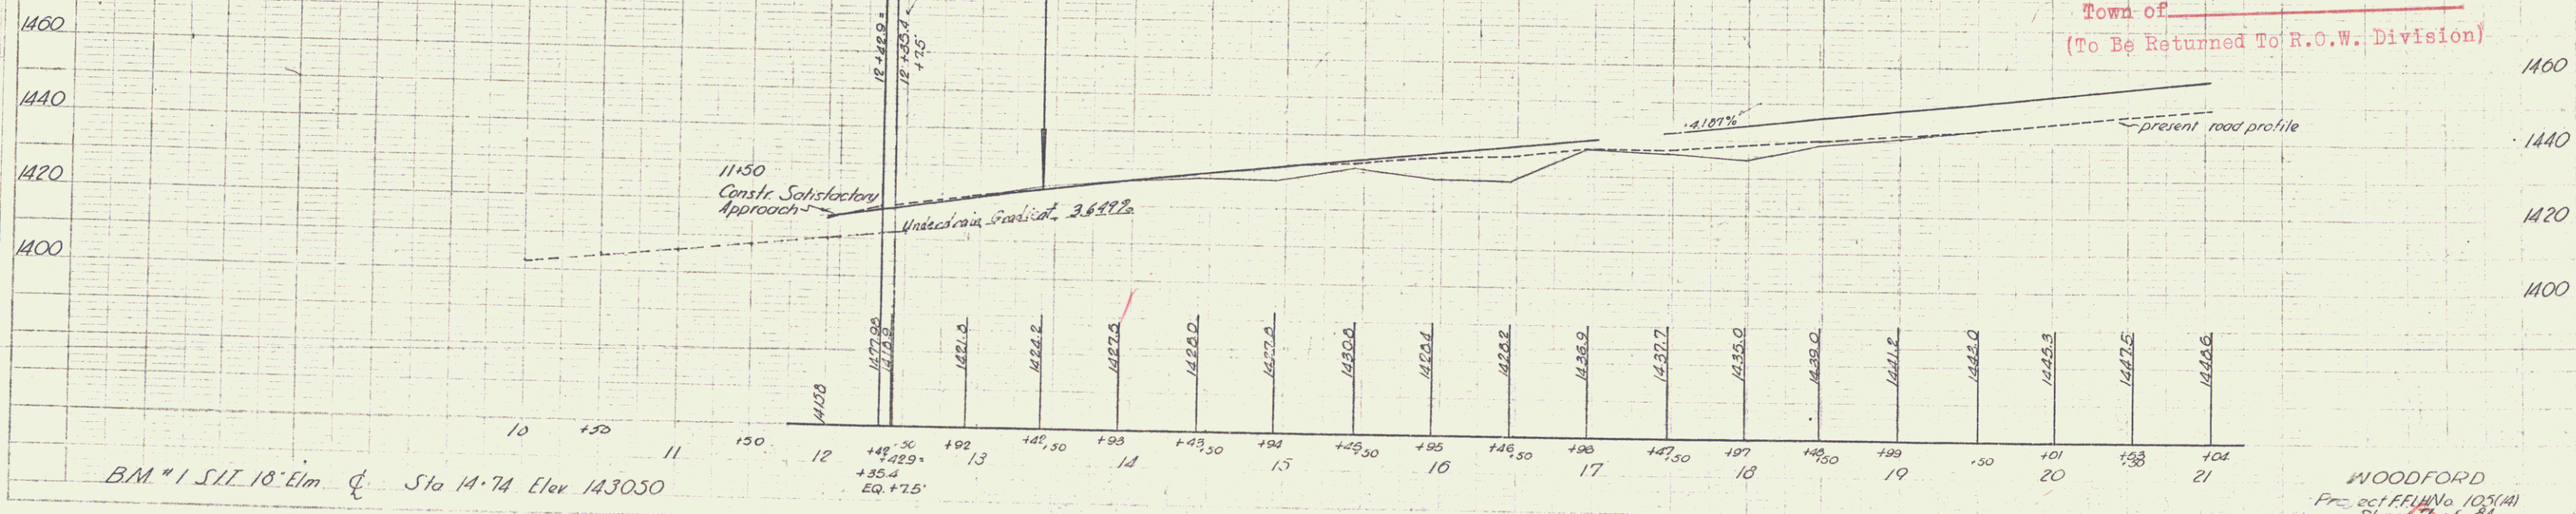



PLAN	1/2" = 30'
SECTION	1" = 10'
DATE	2/25/58
BY	W.D. DEWEY
CHECKED	W.D. DEWEY
DATE	2/25/58

WOODFORD F-FLH 105(14)

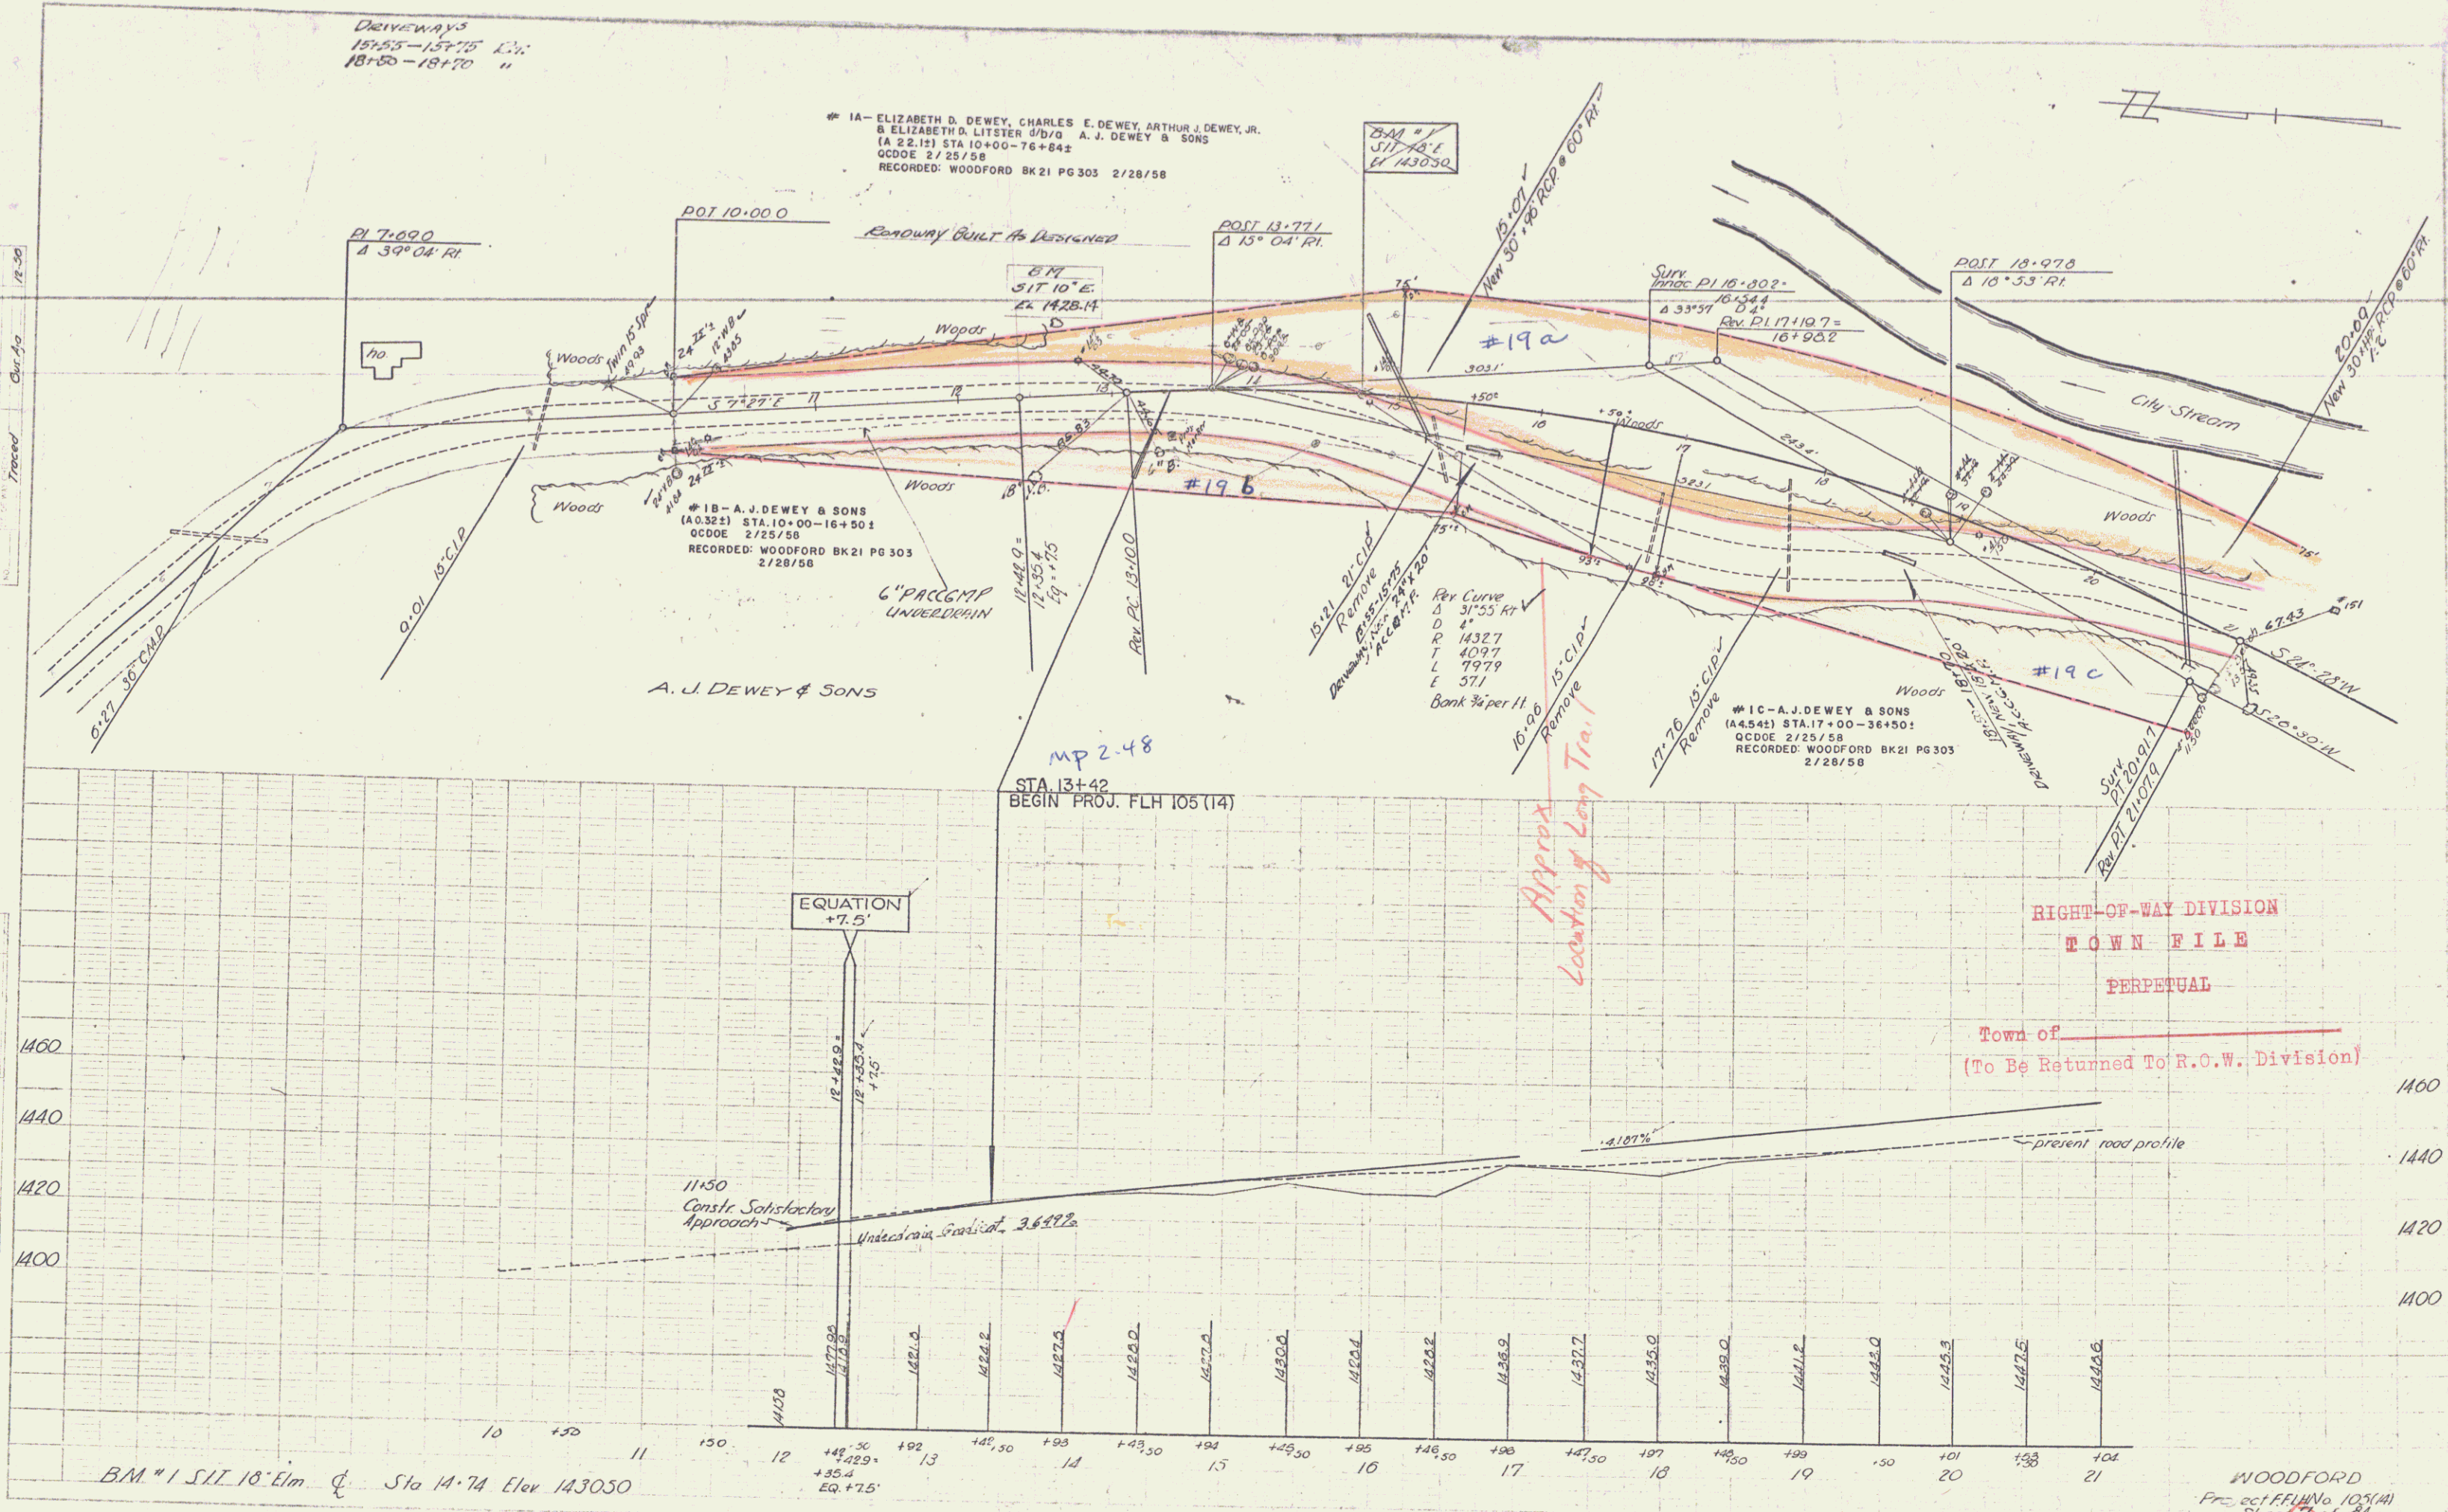

WOODFORD
Project File No. 105(14)
Sheet 7 of 84

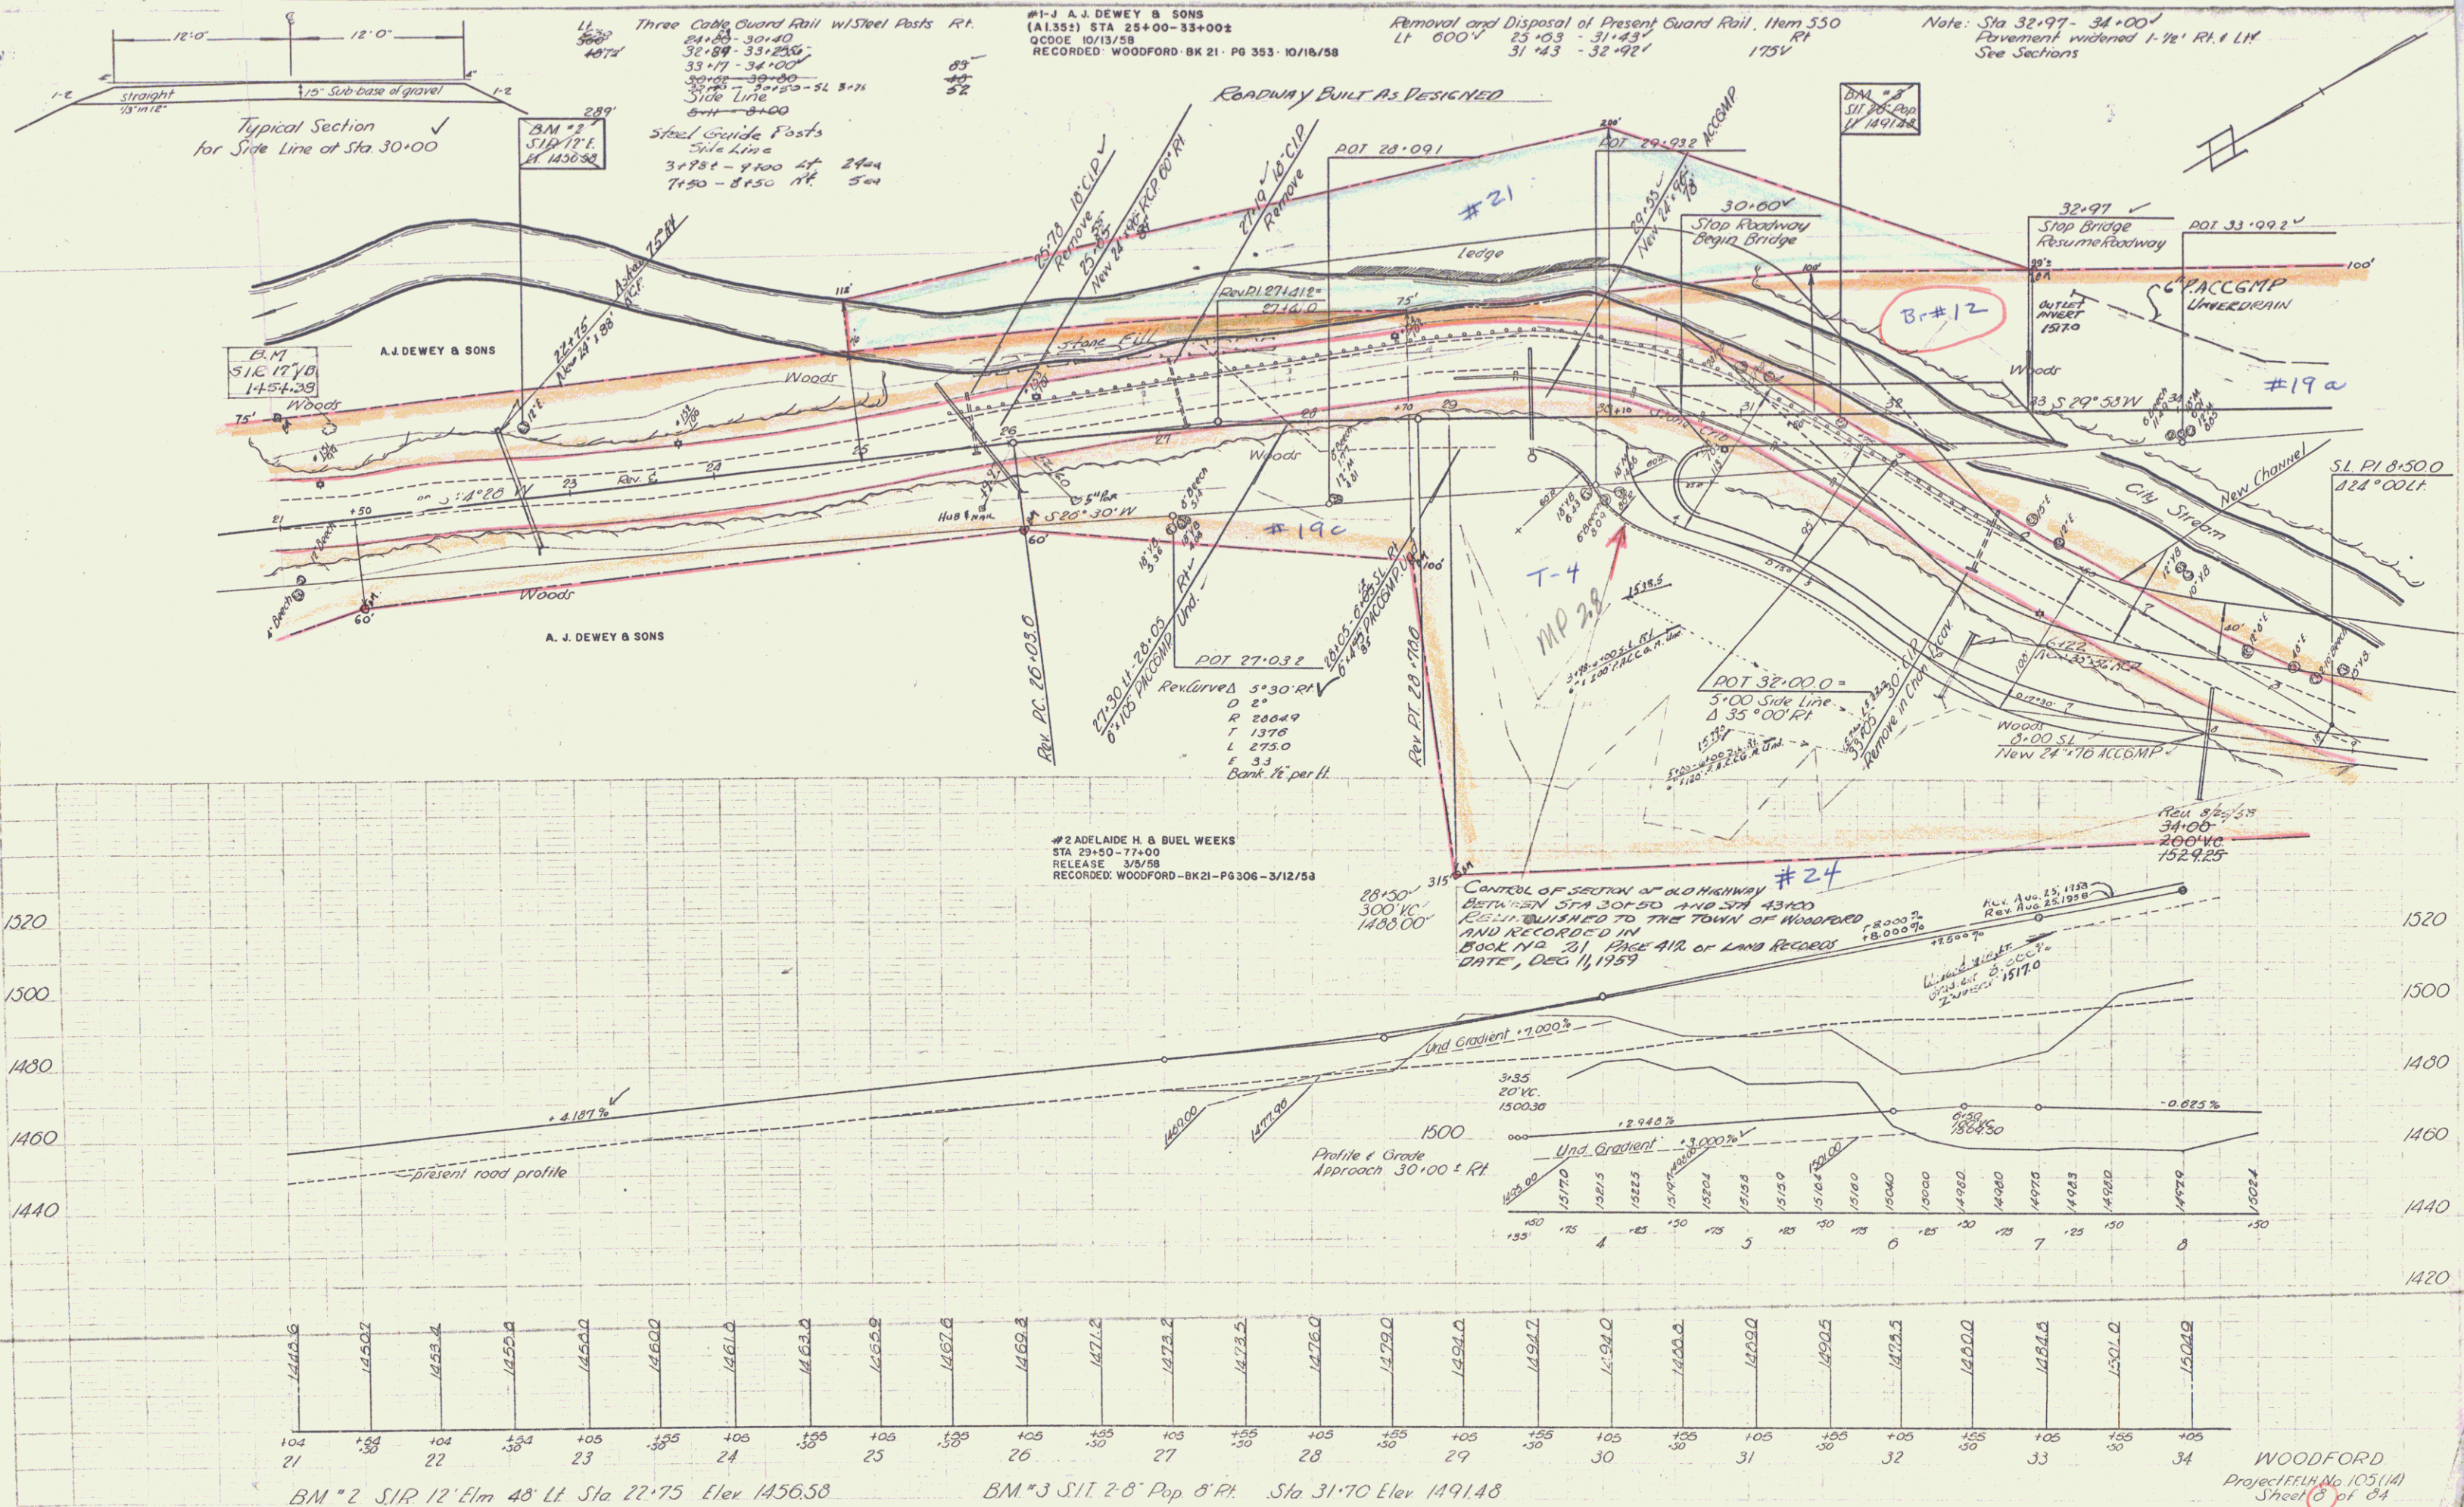

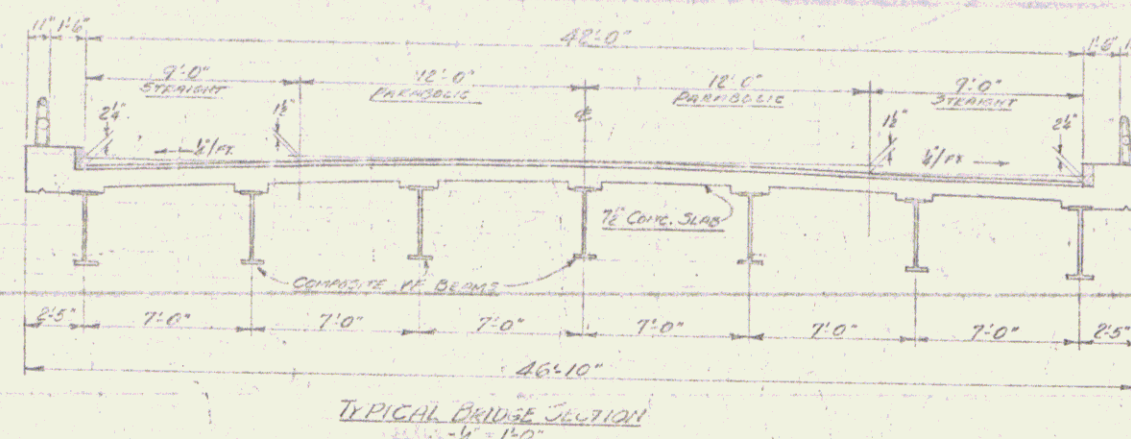[illegible]

1538
 1549
 1538
 1551
 240 ft.
 224
 Grot + Boulders
 Yes

1. 7' x 10' x 10' concrete deck 3 Spans @ 79.78
 2. 7' x 10' x 10' concrete deck 3 Spans @ 79.78
 3. 7' x 10' x 10' concrete deck 3 Spans @ 79.78
 4. 7' x 10' x 10' concrete deck 3 Spans @ 79.78

[illegible]

10000 Acres
No
11 H/sec
2450 sf.
Heavy
250 sf.
Medium
Slight

103 2 #

No

Btl. Conc. on Conc. Deck.

103

2

No

2 more

BORING #1

EL. 1624.5

Gravel

Sand

Hardpan

EL. 1623.5

EL. 1622.5

EL. 1621.5

EL. 1361.5


[illegible]

21	NEW YORK STATE	50
23	NEW YORK STATE	77
25	NEW YORK STATE	78
26	NEW YORK STATE	79
	NEW YORK STATE	80

FRS. PAGES 1-146250

NOTE:
 WEIGHT OF
 CUB OF C
 CUB OF C
 THICKNESS

8/1/57
H.E. Sargent.
PROJECT NO. 1
SHEET (21)

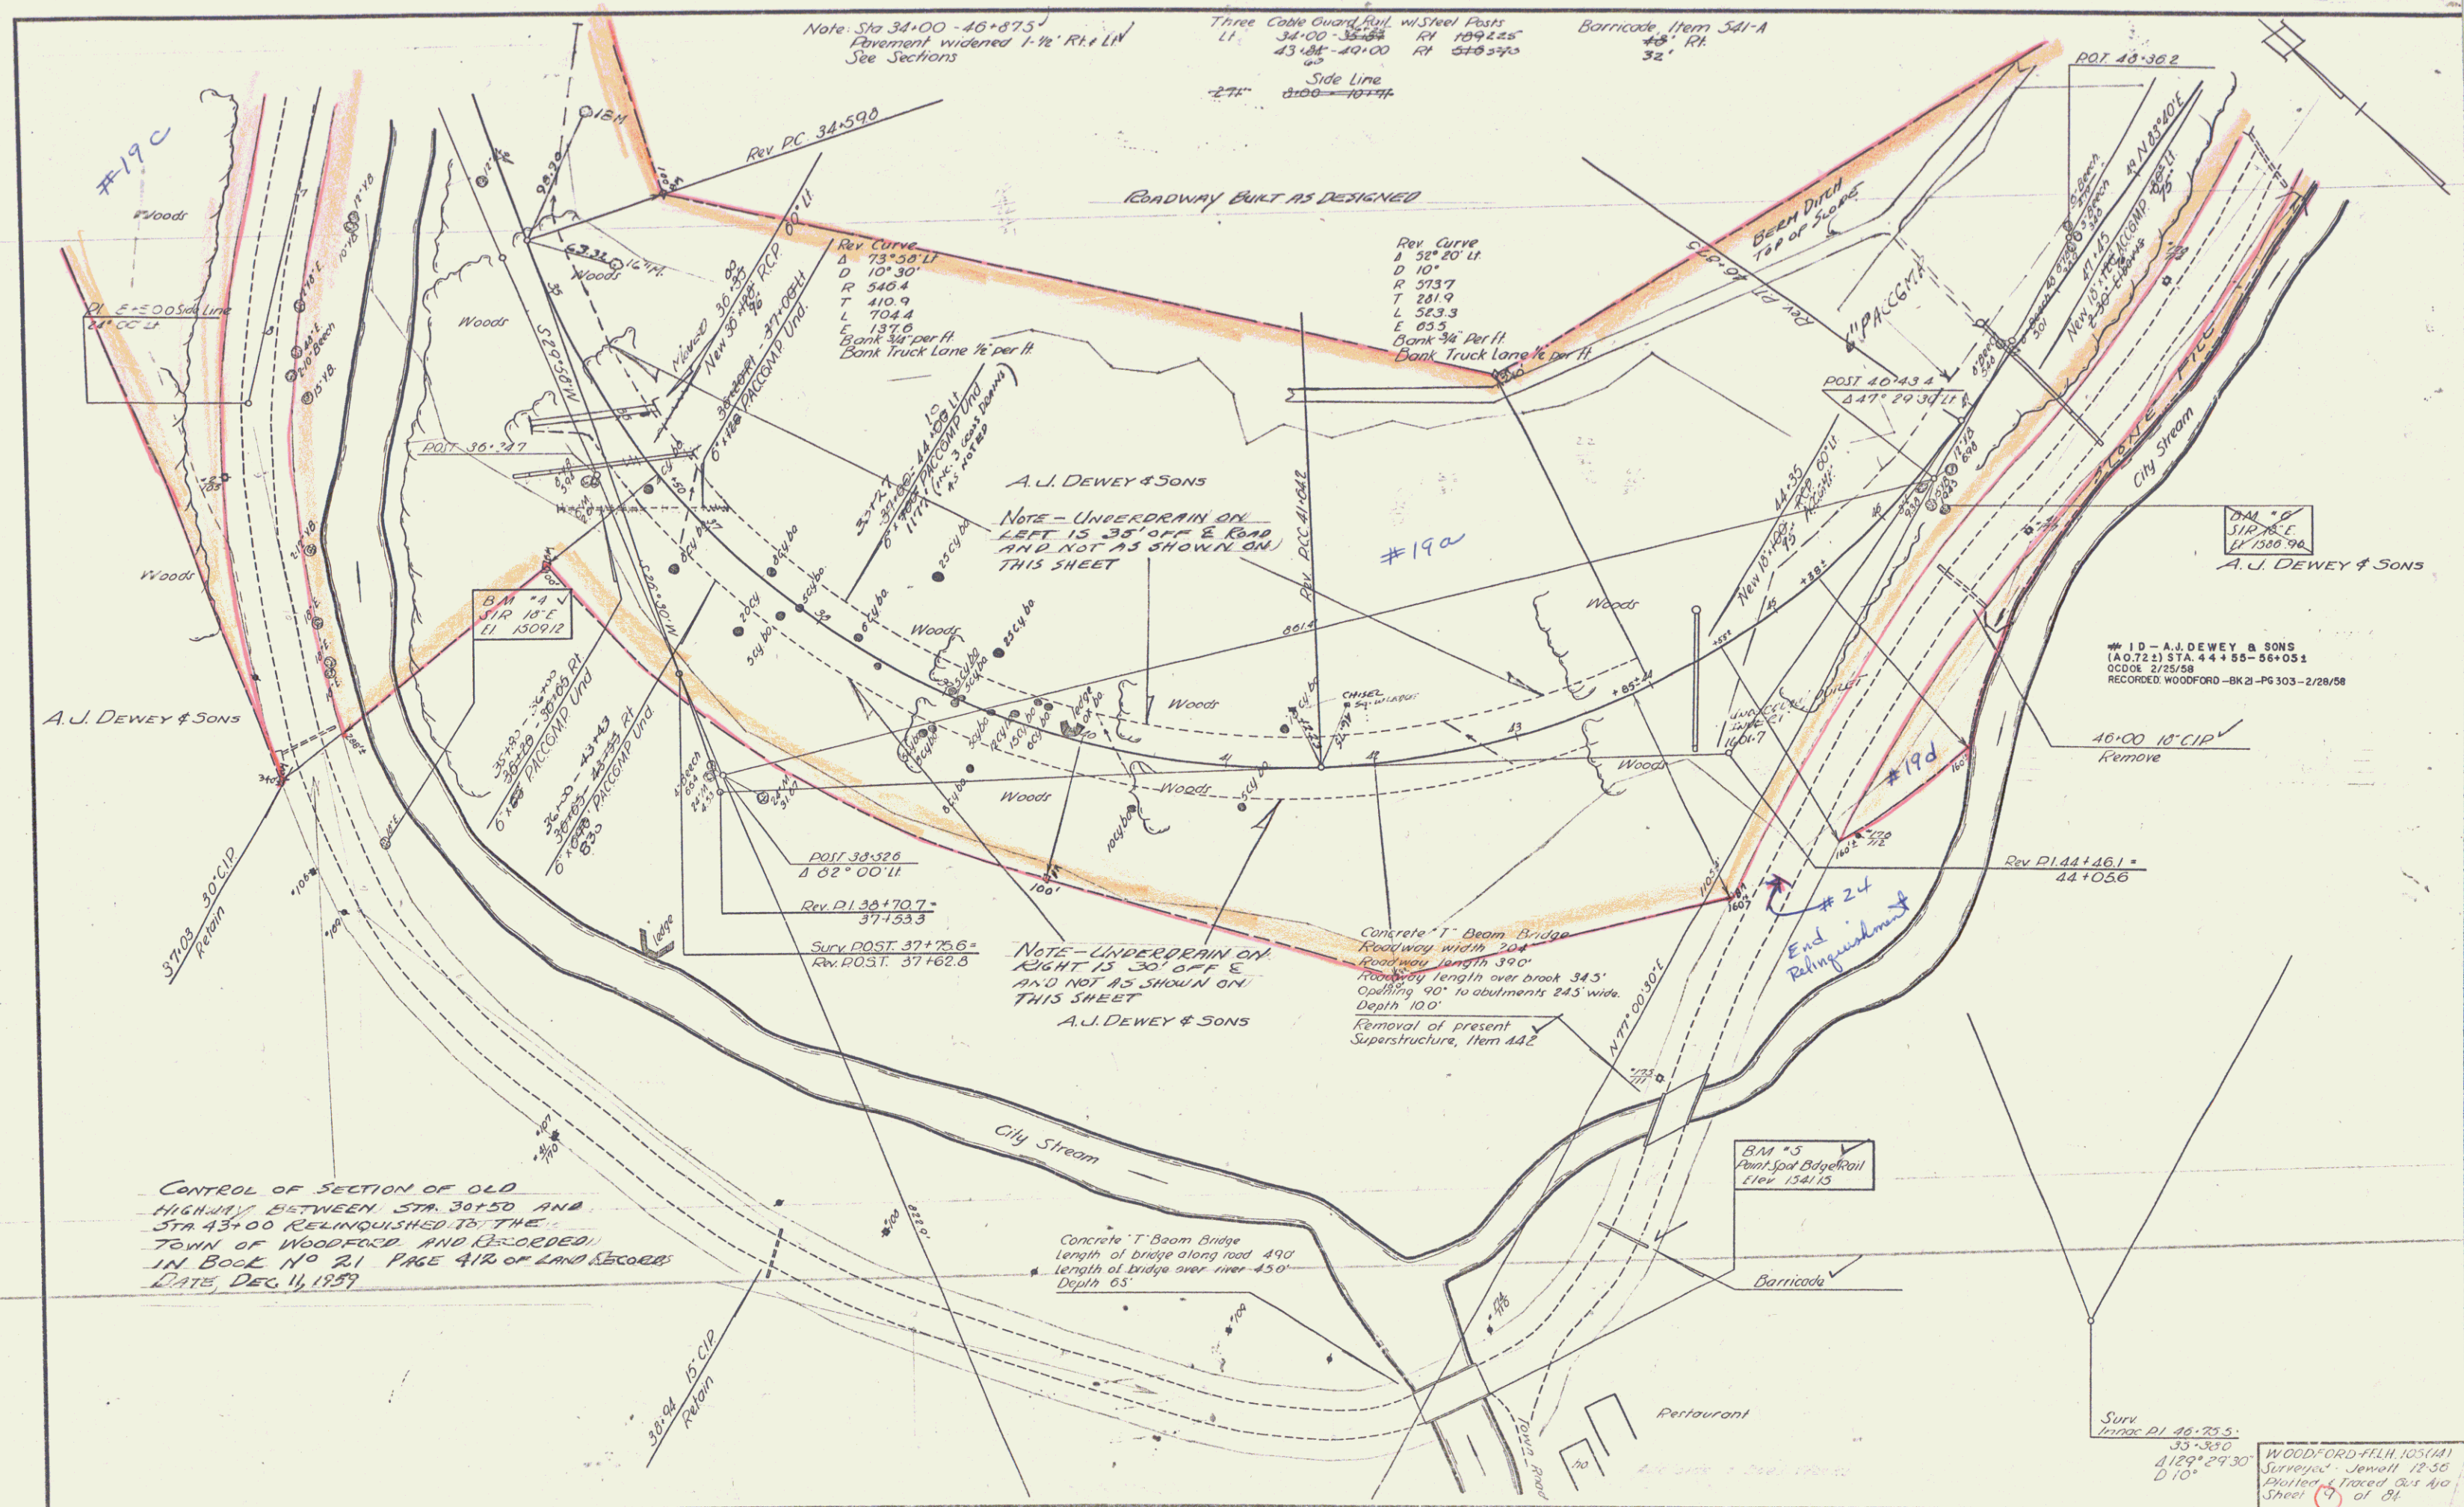

Date 12/30
 Out 12/30
 Traced

