


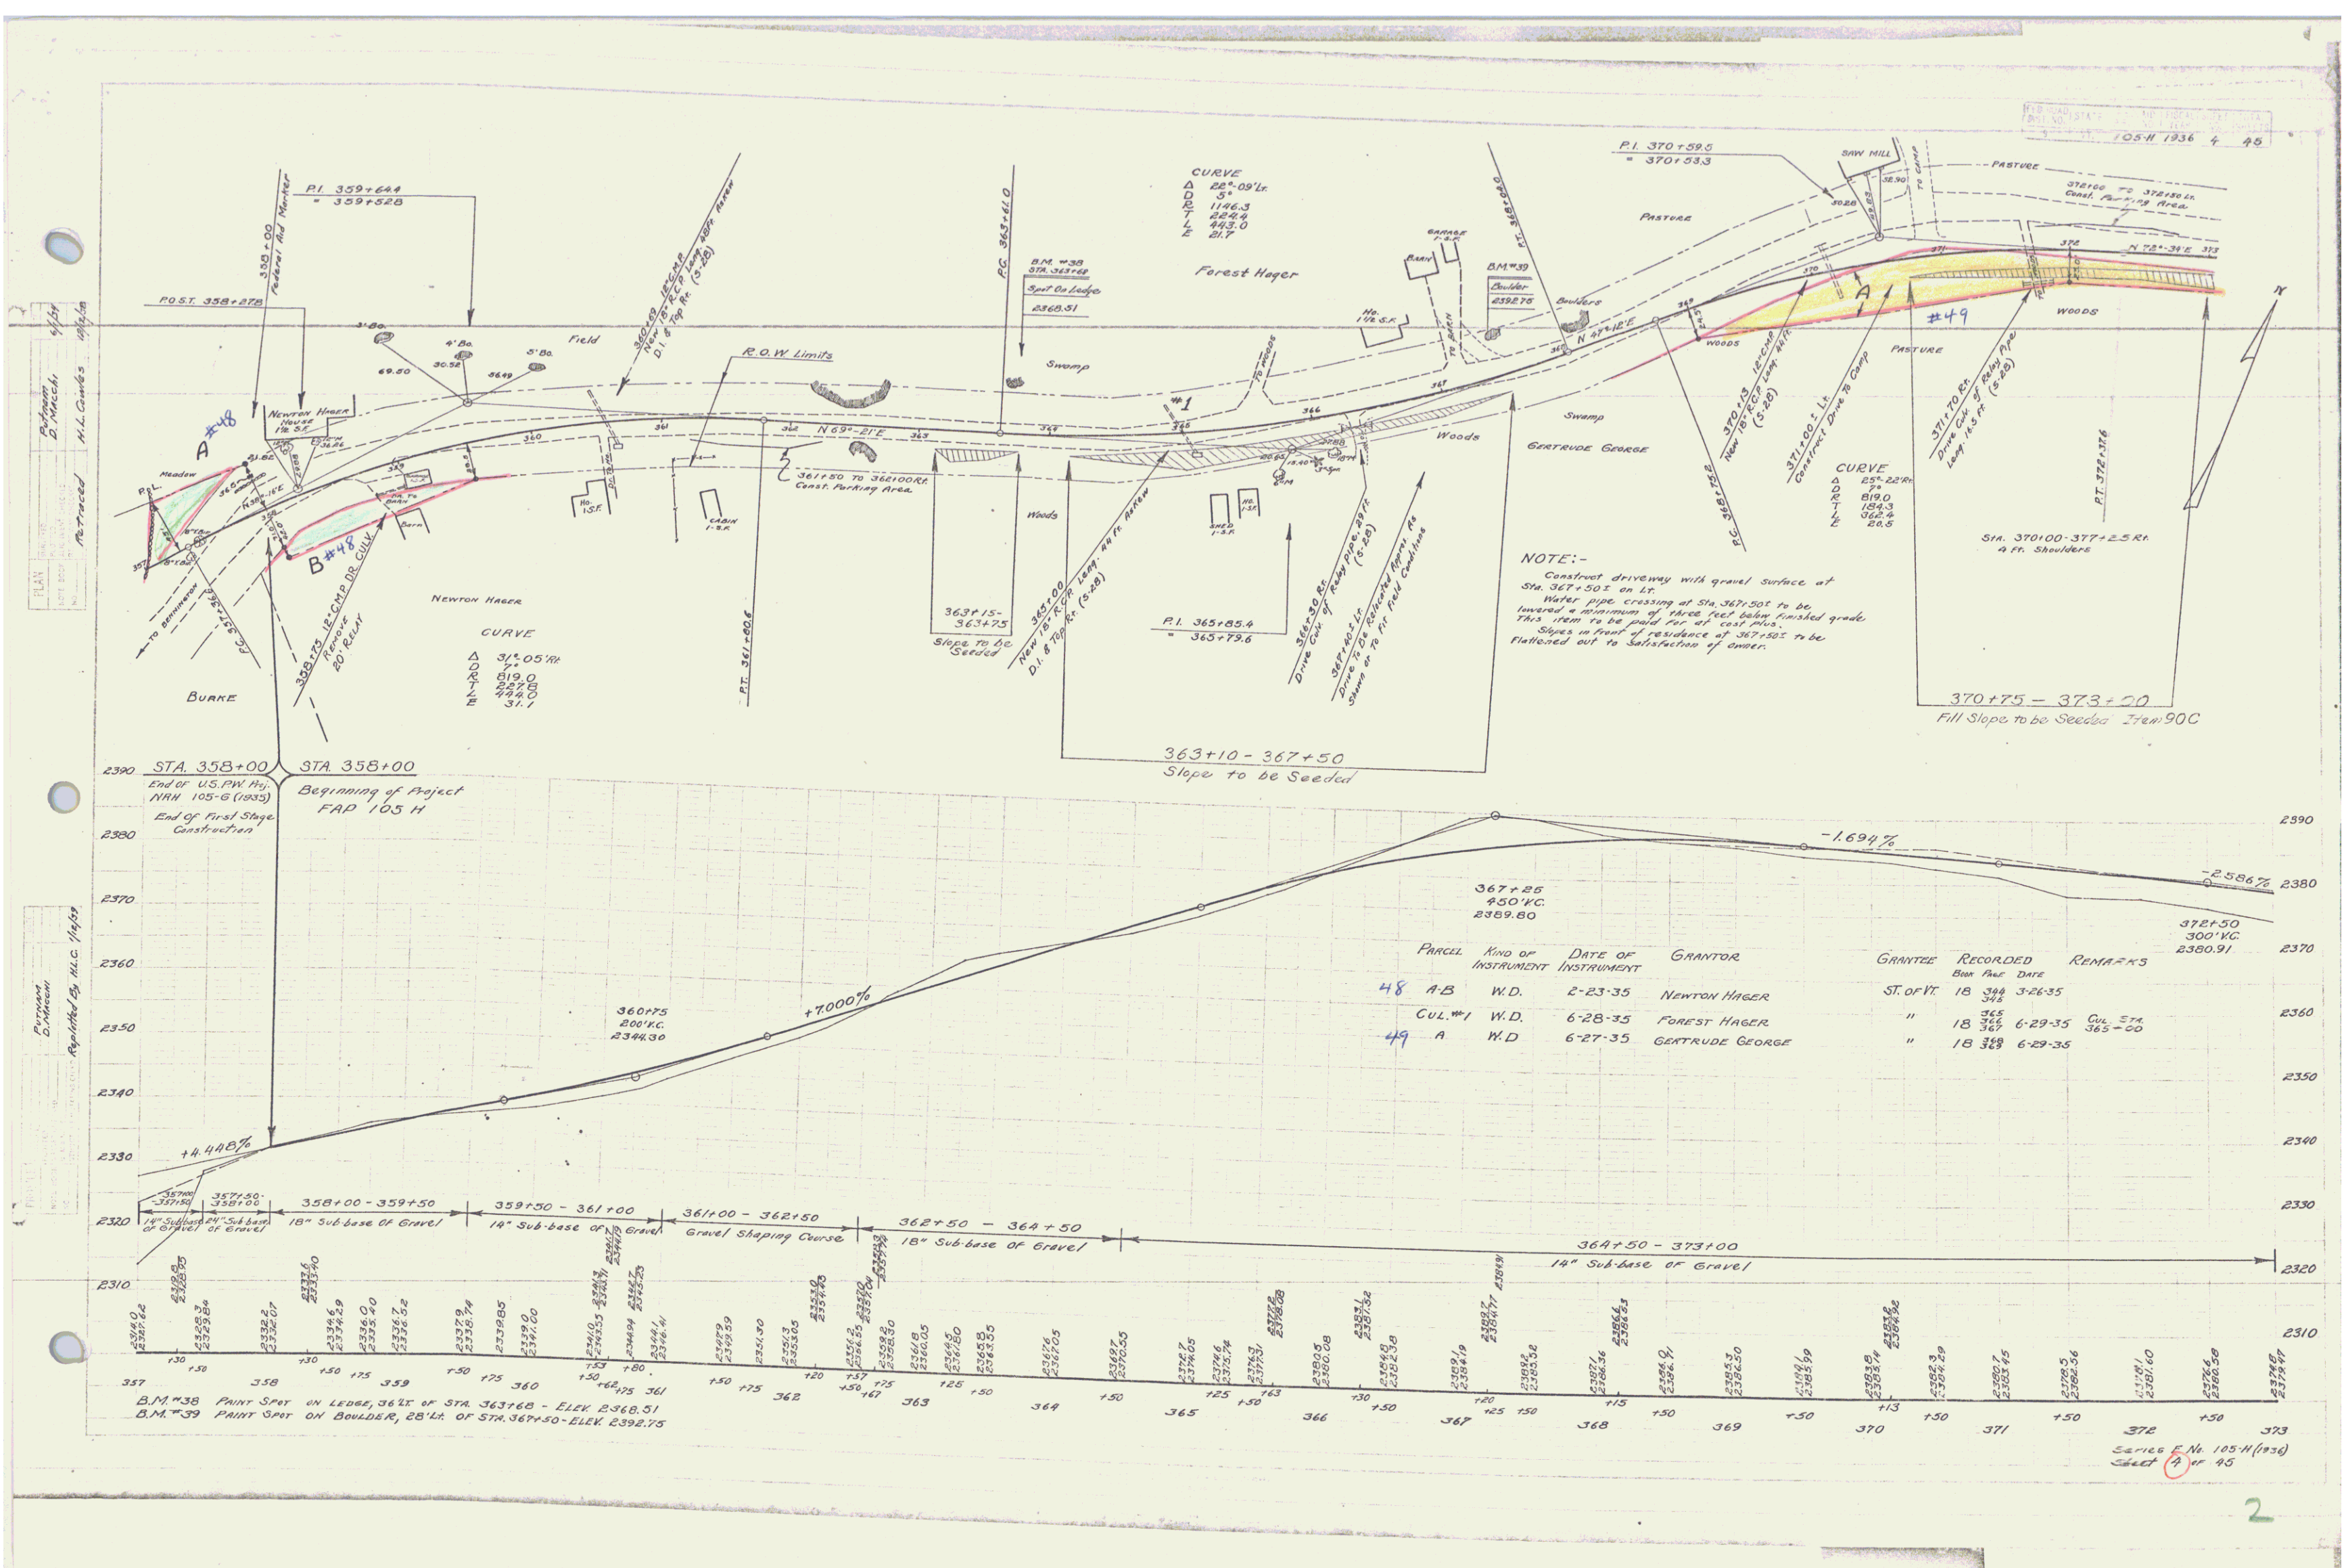

PLAN
Scale 1" = 100'
Date 10/1/35
By H.L. Gaudes
Checked H.L. Gaudes

Profile
Scale 1" = 10'
Date 10/1/35
By H.L. Gaudes
Checked H.L. Gaudes

CURVE
Δ 20° 09' 12"
D 5"
L 1746.3
E 224.4
Z 463.0
T 21.7

CURVE
Δ 31° 05' 11"
D 5"
L 819.0
E 224.4
Z 463.0
T 21.7

CURVE
Δ 25° 22' 11"
D 5"
L 819.0
E 224.4
Z 463.0
T 21.7

NOTE:-
Construct driveway with gravel surface at Sta. 367+50 on L.
Water pipe crossing at Sta. 367+50 to be lowered a minimum of three feet below finished grade. This item to be paid for at cost plus.
Slopes in front of residence at 367+50 to be flattened out to satisfaction of owner.

PARCEL	KIND OF INSTRUMENT	DATE OF INSTRUMENT	GRANTOR	GRANTEE	RECORDED	REMARKS
48	A.B.	2-23-35	NEWTON HAGER	ST. OF VT.	18 398 343	3-26-35
CUL. #1	W.D.	6-28-35	FOREST HAGER	"	18 365 366	6-29-35
49	A	6-27-35	GERTUDE GEORGE	"	18 368 369	6-29-35

B.M. #38 PRINT SPOT ON LEDGE, 361' E. OF STA. 363+68 - ELEV. 2348.51
B.M. #39 PRINT SPOT ON BOULDER, 28' E. OF STA. 367+50 - ELEV. 2392.75

SERIES E. N. 105-H (1936)
Sheet 4 of 45